SUITE 617

ORIGINAL LAYOUT

Montauk

988 SQ FT *plus 61 sq. ft. of balcony area*

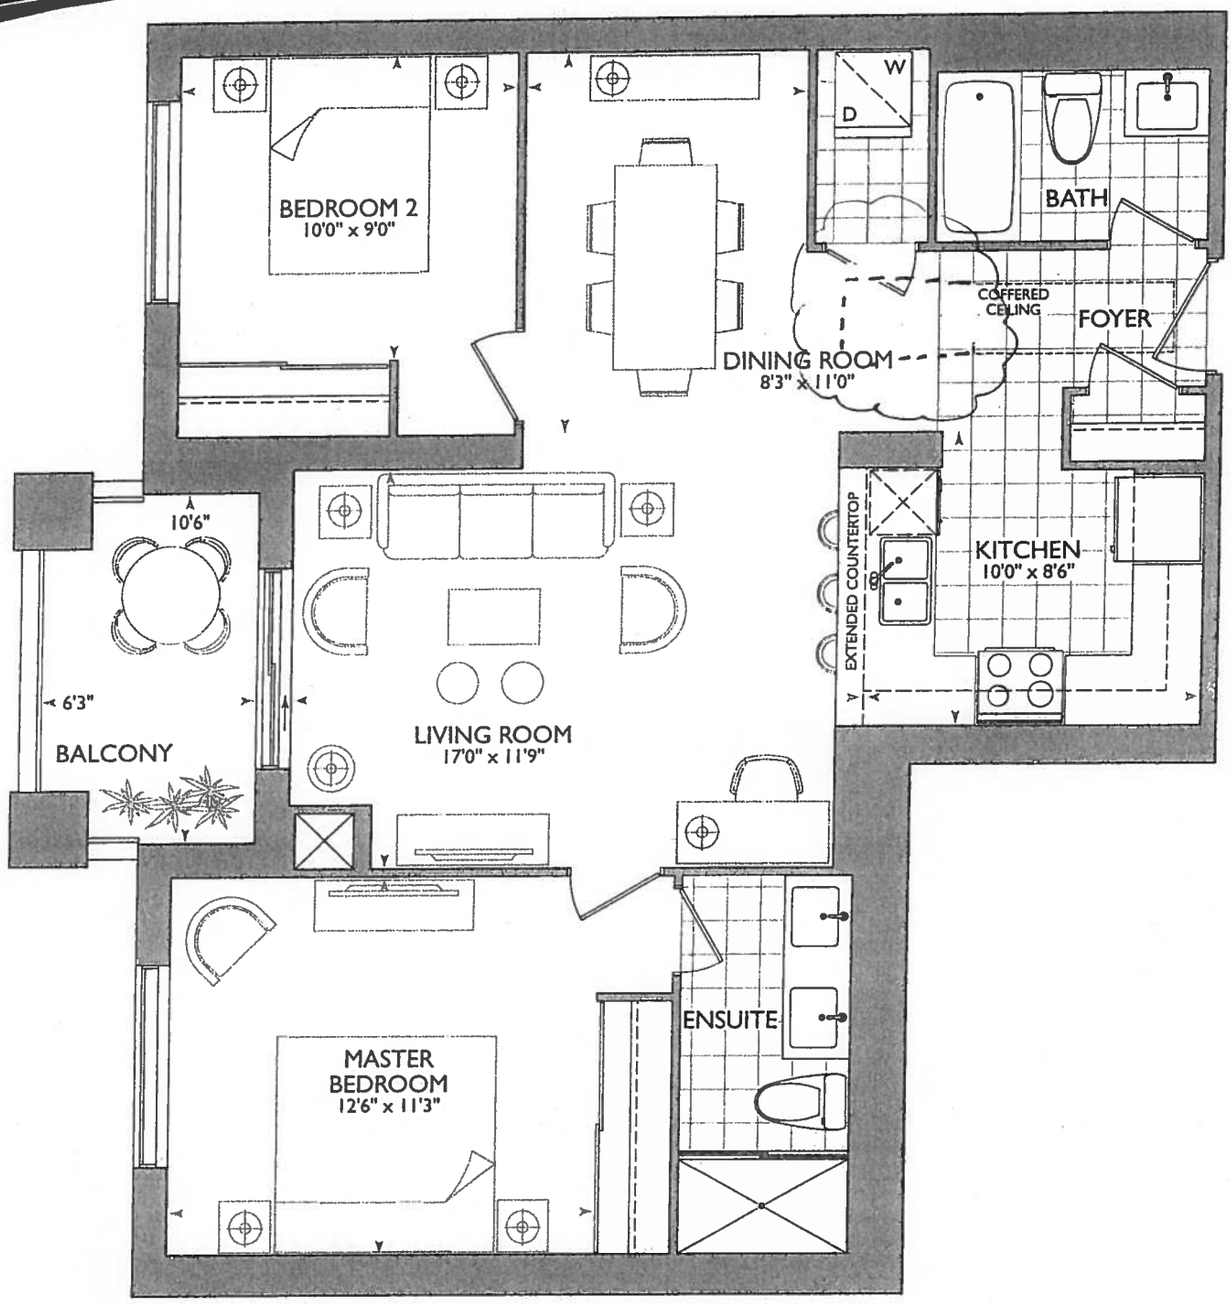

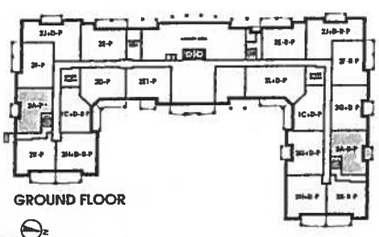

GROUND FLOOR

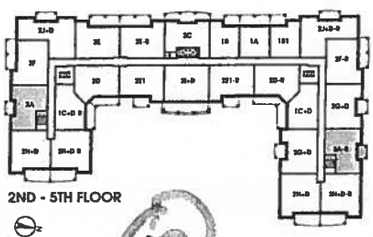

2ND - 5TH FLOOR

(12)

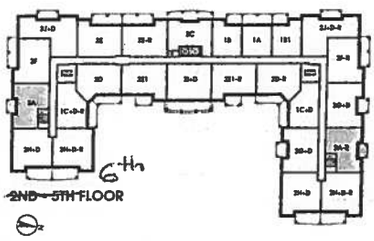

~~2ND - 5TH FLOOR~~ 6th

March 16, 2018

3

* REVISED FOYER COFFERED CIELING AS PER THIS BROCHURE

KITCHEN

- STD KITCHEN LAYOUT
- STD APPLIANCE PACKAGE
- (x4) = PUCK LIGHTS
- (x1) = PLUG ON WALL ABOVE DISHWASHER FOR PENINSULA
- 67" STOVE PIPE CENTER
- 115" SINK PIPE CENTER

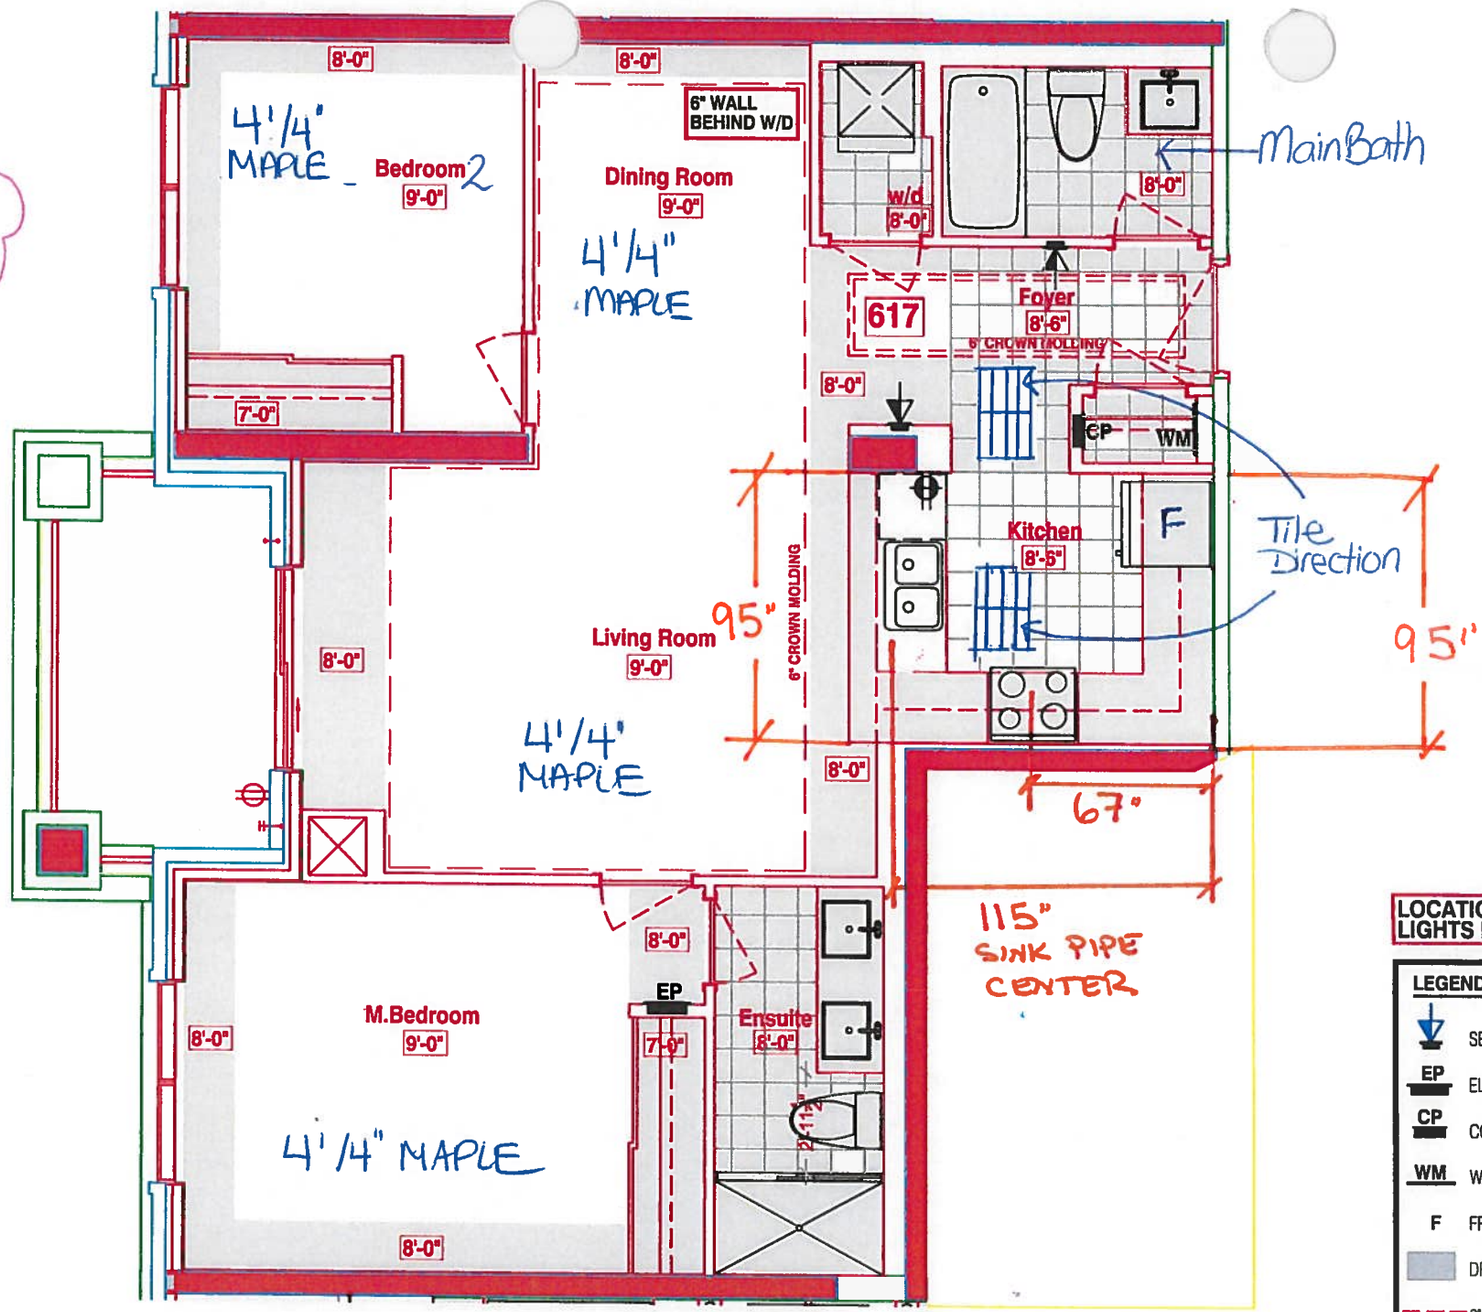

LOCATION OF KITCHEN LIGHTS REFER TO QTK. DWG.

LEGEND:

- SECURITY PANEL
- EP ELECTRICAL PANEL
- CP COMMUNICATION PANEL
- WM WATER METER
- F FRIDGE
- DROPPED AREA
- 6" CROWN MOLDING

RECEIVED Jan 10, 2018

SUITE 617 - MONTAUK

Royal Pine Homes ▪ 25 Baker Hill Blvd – Stouffville, ON ▪ Jan 10, 2018

Book

SITE COPY

CONSTRUCTION SUMMARY

Hampton Place

PURCHASERS: MAN LI WU and YI PING ZHANG **TEL:** RES.: 647-699-9138

LOT NUMBER	PHASE	HOUSE TYPE	CLOSING DATE	
617	1	MONTAUK	06-Nov-18	

Date Added: 16-Mar-18 **Invoice Number: 7143**

660 - HARDWOOD FLOORING - Install prefinished 4 1/4" x 1/2" Maple Stained Lock Floating Floor in lieu of builders standard laminate flooring. To be installed throughout; Living Room, Dining Room, Master Bedroom & Bedroom #2 (See Sketch)

1 - DISCLAIMER - MAPLE FLOORING;
LivingRoom / DiningRoom / MasterBedroom / Bedroom#2 - The purchaser(s) is advised that the hardwood flooring chosen is classified as "porous flooring".
Note: The purchaser(s) hereby releases Royal Pine Homes from all liability as it relates to imperfections that may occur as a result as maple hardwood flooring being installed in these areas.

1 - KITCHEN & BATHROOMS - Purchaser has DECLINED All Upgrades offered during decor appointment at the decor centre for kitchen & bathroom cabinetry. Standard Kitchen Layout & Standard Bathroom Vanities to be installed as per standard plan. (See Sketch)
Note:

1 - KITCHEN - Install Standard Stone Countertop - ASPEN CYRUS GREY - To be installed throughout kitchen, where applicable (does not include stone backsplash) (See Sketch)
Note:

1 - KITCHEN - COUNTERTOP EDGING - Install UPGRADE " I " EDGING - To be installed throughout kitchen countertop, where applicable. (See Sketch)
Note:

1 - DISCLAIMER - STONE COUNTERTOP;
KITCHEN - Stone slabs vary in size & all seams are visible & the fabricator reserves the right to position the seams as necessary.
Note:

1 - KITCHEN - Kitchen Backsplash - Install Standard 3x6 SUBWAY WHITE Kitchen Backsplash Tile in UPGRADE BRICK PATTERN - To be installed throughout kitchen, where applicable (does not include behind the fridge or stove) (See Sketch)
Note:

1 - KITCHEN - Kitchen Sink - Install Standard Undermount Sink - BLANCO Horizon Plus U2 Undermount Sink (8") - Model # 401234
Note:

1 - KITCHEN - Kitchen Faucet - Install Standard Faucet - DELTA Chrome Pull-Out Kitchen Faucet (Single Hole) - Model # 469-LF - Chrome
Note:

1 - APPLIANCE PACKAGE - Install STANDARD APPLIANCE PACKAGE - To be installed throughout suite, where applicable (See Sketch)
Note:

1 - MAIN BATH - COUNTERTOP EDGING - Install UPGRADE " I " EDGING - To be installed throughout main bath vanity countertop, where applicable. (See Sketch)
Note:

1 - MASTER ENSUITE - COUNTERTOP EDGING - Install UPGRADE " I " EDGING - To be installed throughout master ensuite vanity countertop, where applicable. (See Sketch)
Note:

1 - CLARIFICATION;
MAIN BATH & MASTER ENSUITE - Install Standard 3" Splash throughout Main Bath and Master Ensuite Vanity Countertop, where applicable (See Sketch)
Note:

1 - DISCLAIMER - STONE COUNTERTOP;
MAIN BATH & MASTER ENSUITE - Stone slabs vary in size & all seams are visible & the fabricator reserves the right to position the seams as necessary.
Note:

SITE COPY

CONSTRUCTION SUMMARY

Hampton Place

PURCHASERS: MAN LI WU and YI PING ZHANG **TEL:** RES.: 647-699-9138

LOT NUMBER	PHASE	HOUSE TYPE	CLOSING DATE	
617	1	MONTAUK	06-Nov-18	

Date Added: 16-Mar-18 **Invoice Number: 7143**

1 - MAIN BATH & MASTER ENSUITE - Install Standard Plumbing Fixtures throughout Main Bath and Master Ensuite, where applicable. (See Sketch)
See Below Items for Upgrade Toilets at; Main Bath and Master Ensuite

1 - MAIN BATH - TOILET - Install Upgrade Toilet - CONTRAC CALI One Piece Elongated Toilet - Model # 4710-BOVU - White (See Sketch)
Note:

1 - MASTER ENSUITE - TOILET - Install Upgrade Toilet - CONTRAC CALI One Piece Elongated Toilet - Model # 4710-BOVU - White (See Sketch)
Note:

1 - CLARIFICATION;
MASTER ENSUITE - Purchaser accepts & acknowledges the standard glass at master ensuite shower stall will NOT touch the ceiling and will receive a Standard Chrome Header. (See Sketch)
Note:

1 - BONUS PACKAGE - PURCHASER HAS APPLIED $5,000.00 (Includes Taxes) WORTH OF UPGRADE PROMOTIONAL PACKAGE TOWARDS THE PURCHASE OF UPGRADES COMPLETED AT THE DECOR CENTRE.
Note:

1 - PURCHASER HAS ATTENDED A COLOR APPOINTMENT AT THE DECOR CENTRE AND HAS DECLINED ANY ADDITIONAL UPGRADES Purchaser accepts and acknowledges that there will be no further changes/additions/deletions to be made upon signing on March 16,2018
Note:

1 - PURCHASER AWARE AND ACCEPTS THAT ANY CHANGES MADE TO UPGRADES AFTER SIGNING THIS PURCHASERS EXTRA ARE SUBJECT TO A MINIMUM ADMINISTRATION FEE OF $1,000 PLUS A 10% HOLDBACK FEE.
Note:

This Document is Extremely Time Sensitive - Printed 10 Apr 18 at 14:13

* INTERIOR COLOUR SCHEME *

Purchasers	Decor Consultant	Model Type	Telephone Res. / Bus	Project	Closing Date	Unit
MAN LI WU & YI PING ZHANG	Melissa Di Marino	MONTAUK	(647) 699-9138 /	Hampton Place	06/11/2018	617

Flooring

	Description
MASTER ENSUITE	13x13 RUSTIC GREY (STD)
MAIN BATHROOM	13x13 RUSTIC GREY (STD)
POWDER ROOM	N/A
KITCHEN / DINETTE	12x24 H-STONE LIGHT GREY (STRAIGHT)(STD)
FOYER	12x24 H-STONE LIGHT GREY (STRAIGHT)(STD)
LAUNDRY	8x8 IHLARA PINK (STD)
LIVING ROOM	4 1/4" Mirage Maple Charcoal (Semi-Gloss) (UPG)
DINING ROOM	4 1/4" Mirage Maple Charcoal (Semi-Gloss) (UPG)
DEN	N/A
MASTER BEDROOM	4 1/4" Mirage Maple Charcoal (Semi-Gloss) (UPG)
BEDROOM 2	4 1/4" Mirage Maple Charcoal (Semi-Gloss) (UPG)A
BEDROOM 3	N/A

Wall Tile

Main	Accent/Insert	Pattern
8x10 GOLF GRIGIO (STD)	NONE	NONE
8x10 GOLF GRIGIO (STD)	NONE	NONE
N/A	N/A	N/A
3x6 SUBWAY WHITE (BrickPattern)(Upg)	NONE	NONE
N/A	N/A	N/A
N/A	N/A	N/A

Notes

Consultant: Melissa Di Marino

Purchaser: MAN LI WU

Purchaser: YI PING ZHANG

Vendor: ~~Hampton Place~~

.ot: 617 Project: Hampton Place Model: MONTAUK

Printed Mar 16, 2018 11:44 am

* INTERIOR COLOUR SCHEME *

Purchasers	Decor Consultant	Model Type	Telephone Res. / Bus	Project	Closing Date	Unit
MAN LI WU & YI PING ZHANG	Melissa Di Marino	MONTAUK	(647) 699-9138 /	Hampton Place	06/11/2018	617

CABINETRY, VANITIES AND COUNTERTOPS

	Style	Countertop	Counter Edge	Handle / Knob
MAIN BATHROOM	CATEGORY 1 - LP LAMINATE - CHILL QT 1022 (STD)	ASPEN TERRA WHITE (STD)	"I" EDGE (UPG)	16338-195
MASTER ENSUITE	CATEGORY 1 - LP LAMINATE - CHILL QT 1022 (STD)	ASPEN TERRA WHITE (STD)	"I" EDGE (UPG)	16338-195
POWDER ROOM	N/A	N/A	N/A	N/A
KITCHEN / DINETTE	CATEGORY 2 - LP LAMINATE - SKYE QT 1022 (STD)	ASPEN CYRUS GREY (STD)	"I" EDGE (UPG)	3487-128
LAUNDRY ROOM	N/A	N/A	N/A	N/A

APPLIANCE PACKAGE

Standard Package

Std 31in Opening

PLUMBING FIXTURES

KITCHEN
- Sink Model: STANDARD
- Sink Faucet: STANDARD

TOILETS
- Master Ensuite: UPGRADE - Contrac Cali #4710-BOVU
- Main Bathroom: UPGRADE - Contrac Cali #4710-BOVU
- Powder Room: N/A

VANITY FAUCETS
- Master Ensuite: STANDARD
- Main Bathroom: STANDARD
- Powder Room: N/A

VANITY SINKS
- Master Ensuite: STANDARD
- Main Bathroom: STANDARD
- Powder Room: N/A

SHOWER STALL / TUBS
- Master Ensuite Shower Stall: STANDARD
- Master Ensuite Tub: N/A
- Main Bathroom Tub: STANDARD

Trim

Baseboard & Casing	STANDARD	Levers	STANDARD
Interior Doors	STANDARD - CARRARA,SMOOTH	Door Height	STANDARD

Cornice Moulding / Medalion

Foyer	STANDARD - #CTR-611
Living Room	STANDARD - #CTR-611
Dining Room	STANDARD - #CTR-611
Den	N/A
Master Bedroom	NONE
Bedroom 2	NONE
Bedroom 3	N/A

Fireplace

Fireplace	N/A
Location Flooring	N/A
Style	N/A
Finish	N/A
Marble	N/A
Hearth	N/A

MISC. INSTALLATIONS

Ceramic Accessories (installed by Vendor): (●) Yes ( ) No

Bathroom Mirrors (installed by Vendor): (●) Yes ( ) No

Wire Shelving - Closet (installed by Vendor): (●) Yes ( ) No

Paint Throughout

Walls	Trim
STANDARD - OYSTER WHITE	STANDARD - WHITE

Page 2 of 3

Decor Consultant: Melissa Di Marino

Purchaser: MAN LI WU

Purchaser: YI PING ZHANG

Vendor: Hampton Place

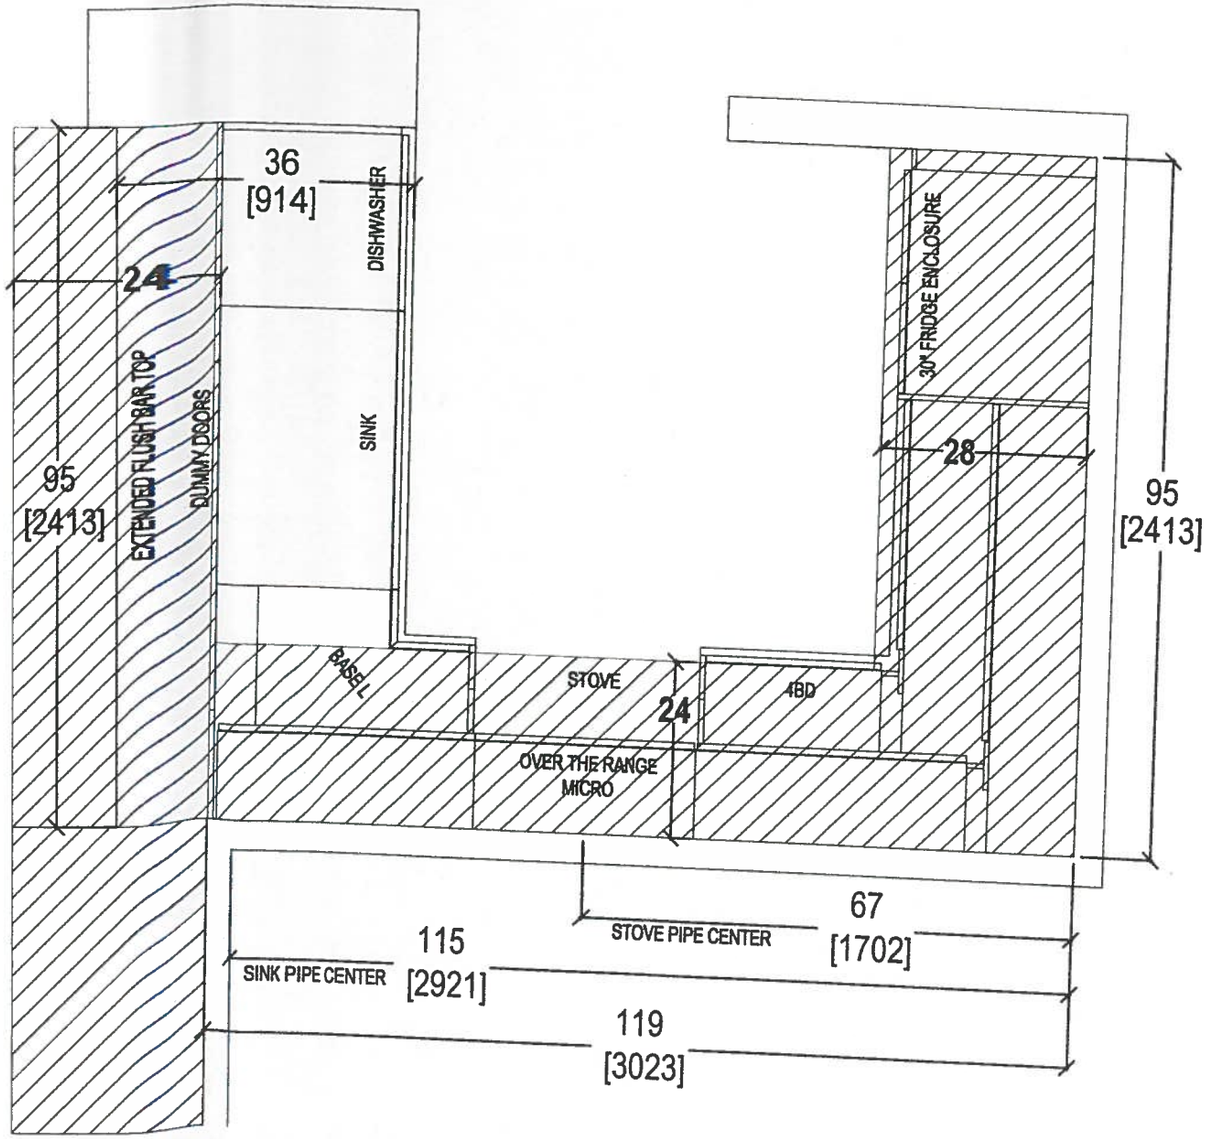

QTK
your kitchen. your taste.
80 SANTE DRIVE, VAUGHAN, ON L4K 3C4.
T: 416.746.1811 F:905.761.5901

CLIENT: ROYAL PINE HOMES	JOB NAME: UNIT 617 HMP	ROOM: KITCHEN -BULKHEAD PLAN	DRAWN BY: SK	COMMENTS:
SITE: HAMPTON PLACE	DOOR STYLE: —	DOOR HANDLE: —	SCALE: 1/2" = 1' - 0"	
PHONE: —	FINISH: —	DRW HANDLE: —	DATE: MAY 1,2018	
EMAIL: —	SPECIES: —	TOP: —	PAGE: —	

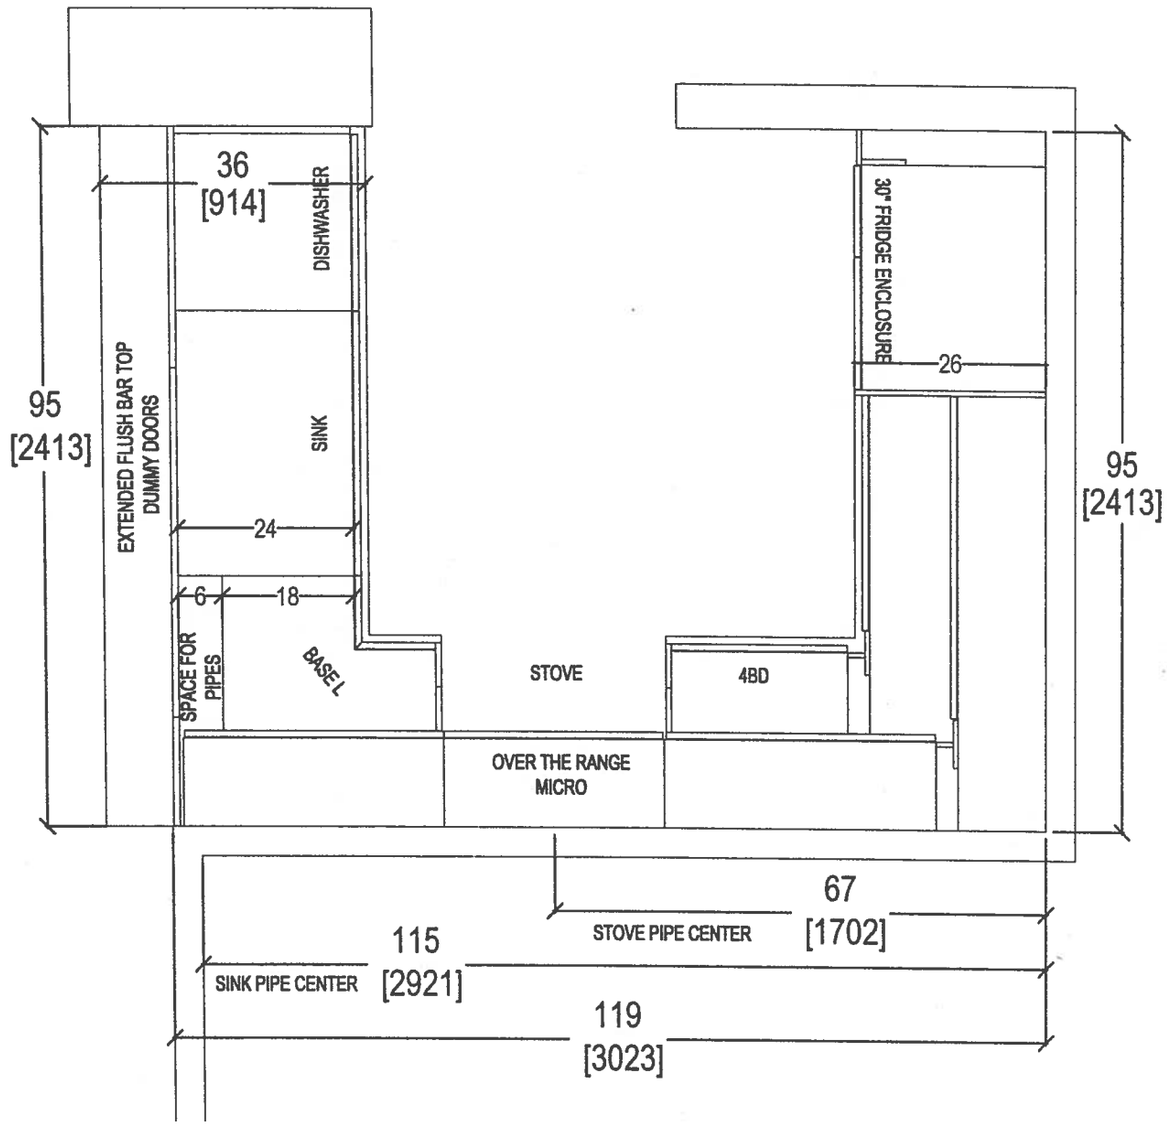

QTK
your kitchen. your taste.
80 SANTE DRIVE, VAUGHAN, ON L4K 3C4,
T: 416.746.1811 F:905.761.5901

CLIENT: ROYAL PINE HOMES	JOB NAME: UNIT 617 HMP	ROOM: KITCHEN FLOOR PLAN	DRAWN BY: SK	COMMENTS:
SITE: HAMPTON PLACE	DOOR STYLE: __	DOOR HANDLE: __	SCALE: 1/2" = 1' - 0"	
PHONE: __	FINISH: __	DRW HANDLE: __	DATE: MAY 1,2018	
EMAIL: __	SPECIES: __	TOP: __	PAGE:	

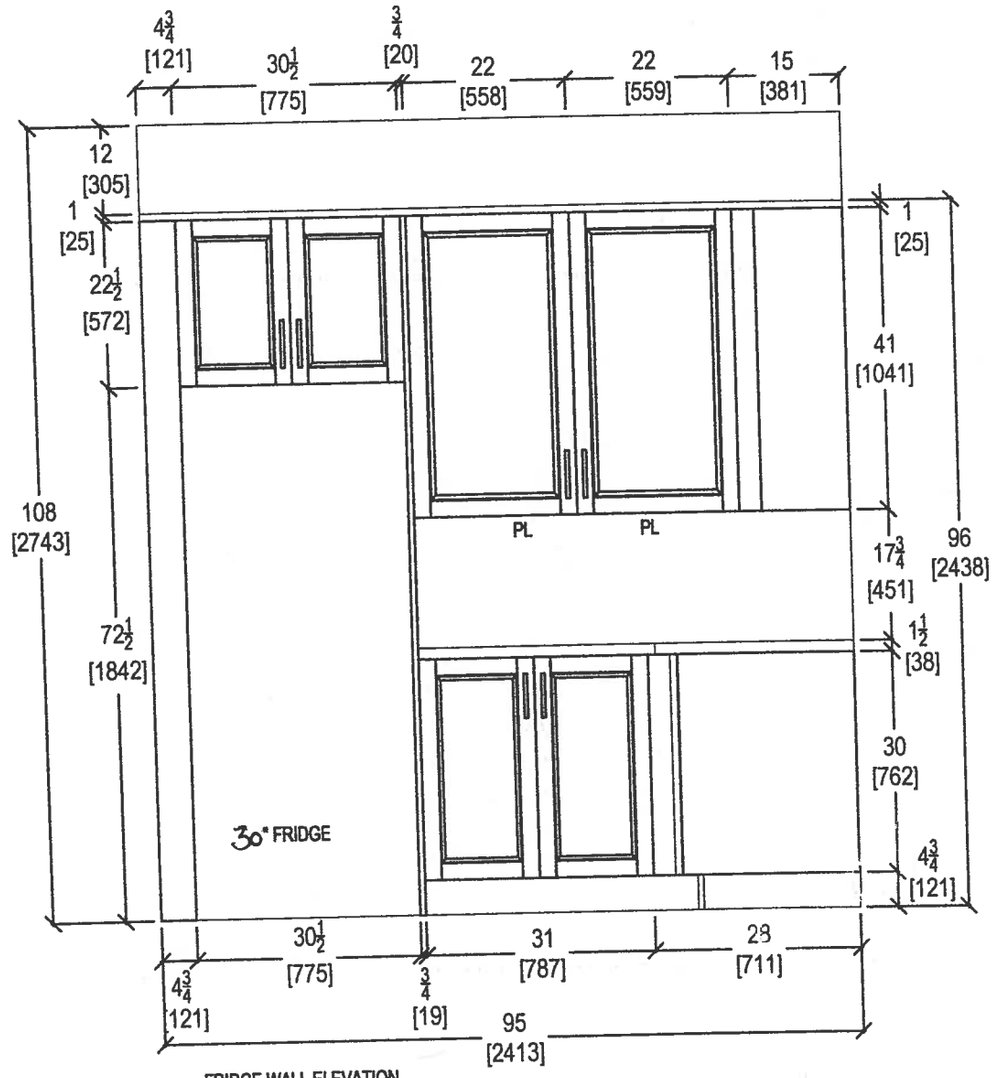

FRIDGE WALL ELEVATION

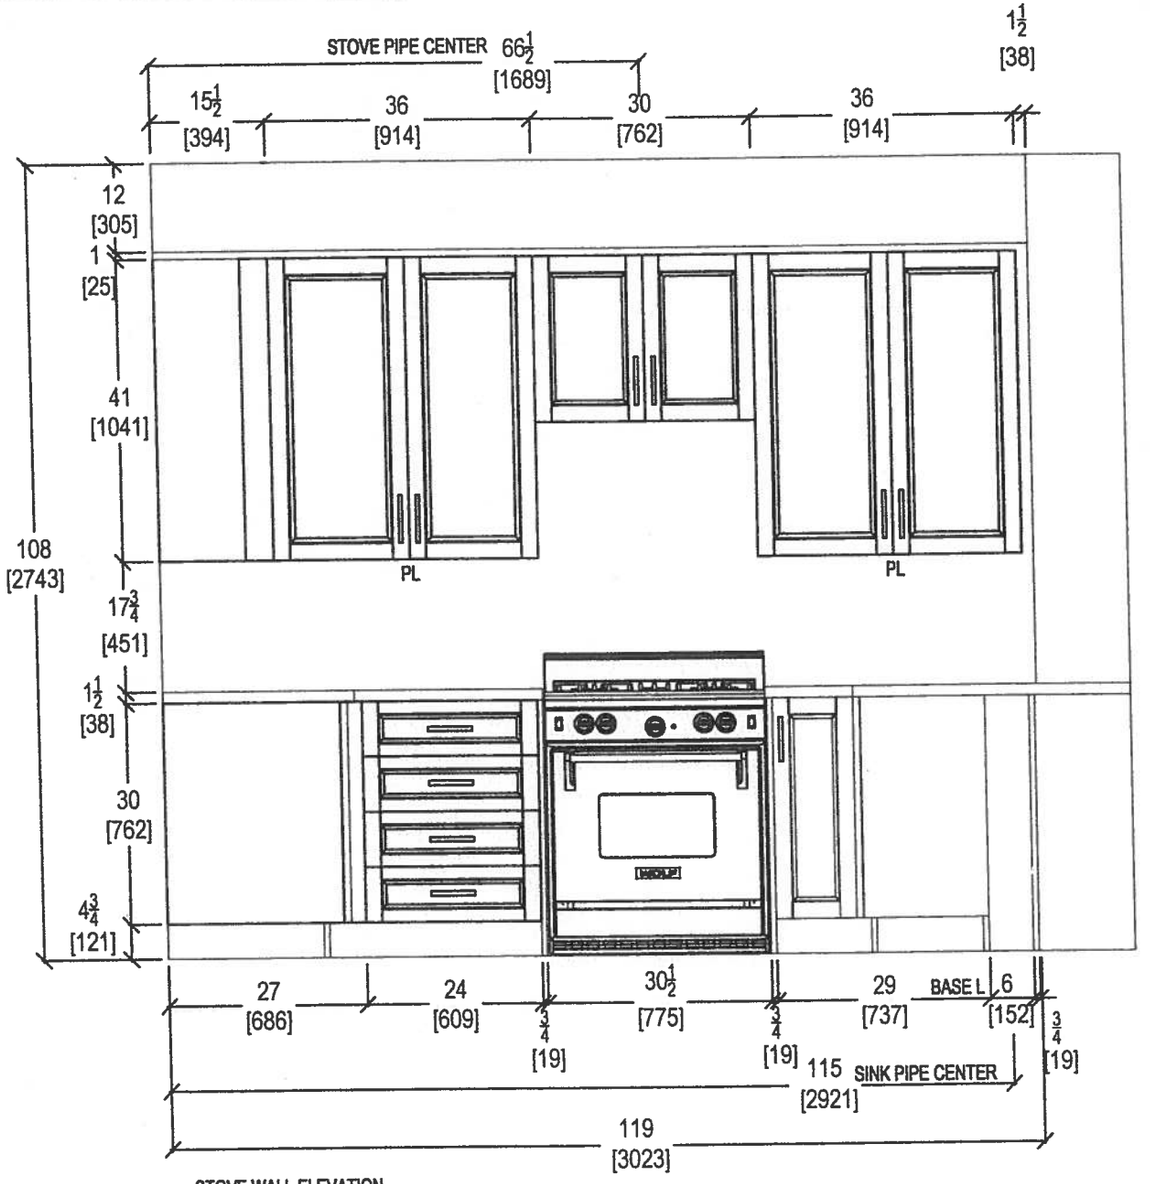

STOVE WALL ELEVATION

QTK your kitchen. your taste. 80 SANTE DRIVE, VAUGHAN, ON L4K 3C4, T: 416.746.1811 F:905.761.5901	CLIENT: ROYAL PINE HOMES	JOB NAME: UNIT 617 HMP	ROOM: KITCHEN	DRAWN BY: SK
	SITE: HAMPTON PLACE	DOOR STYLE: —	DOOR HANDLE: —	SCALE: 1/2" = 1' - 0"
	PHONE: —	FINISH: —	DRW HANDLE: —	DATE: MAY 1,2018
	EMAIL: —	SPECIES: —	TOP: —	PAGE: —

COMMENTS:

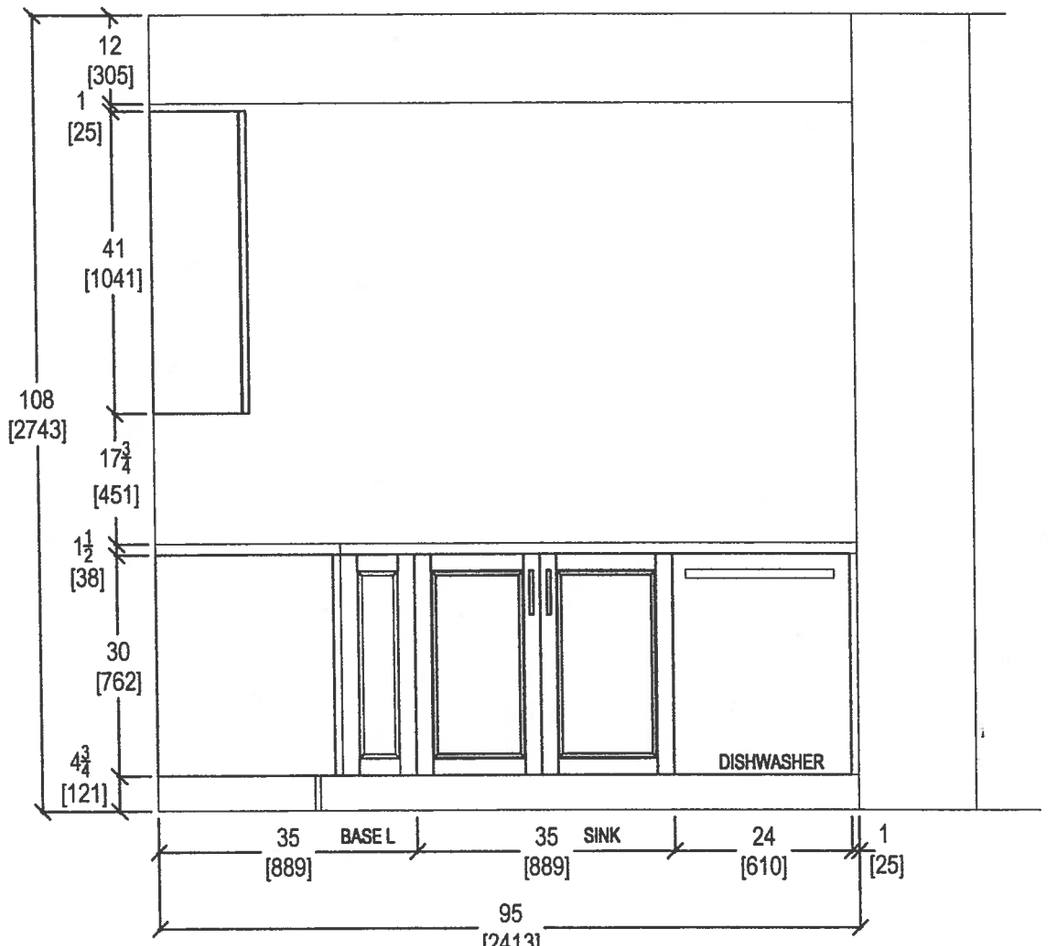

KITCHEN PENINSULA ELEVATION
FRONT VIEW

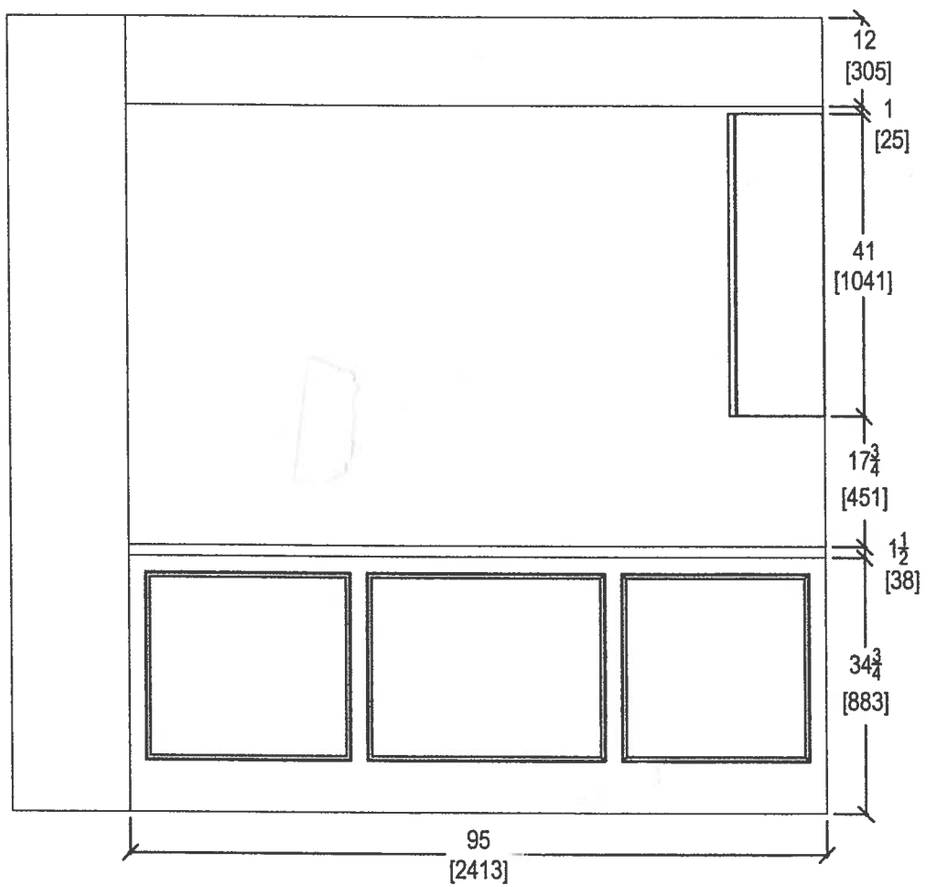

KITCHEN PENINSULA ELEVATION
REAR VIEW

QTK
your kitchen. your taste.
80 SANTE DRIVE, VAUGHAN, ON L4K 3C4,
T: 416.746.1811 F:905.761.5901

CLIENT: ROYAL PINE HOMES	JOB NAME: UNIT 617 HMP	ROOM: KITCHEN	DRAWN BY: SK	COMMENTS:
SITE: HAMPTON PLACE	DOOR STYLE: __	DOOR HANDLE: __	SCALE: 1/2" = 1' - 0"	
PHONE: __	FINISH: __	DRW HANDLE: __	DATE: MAY 1 ,2018	
EMAIL: __	SPECIES: __	TOP: __	PAGE: __	

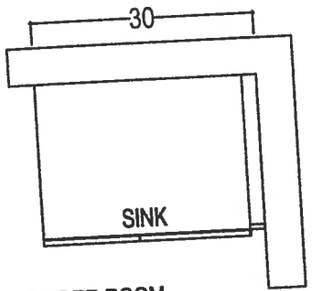

POWDER ROOM

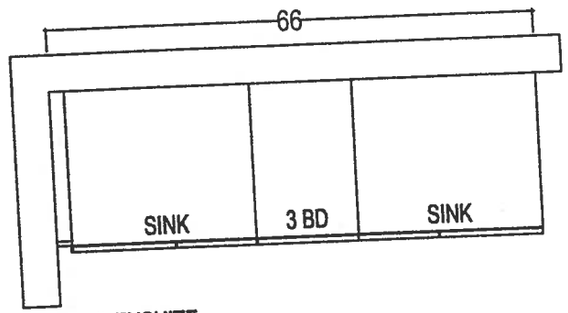

MASTER ENSUITE

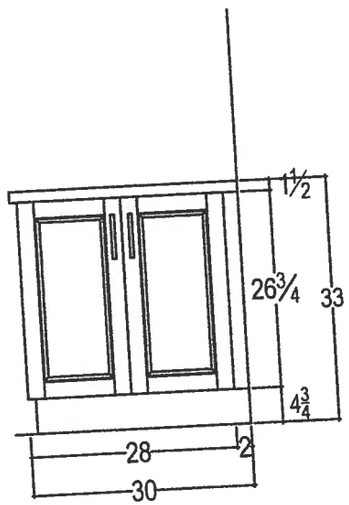

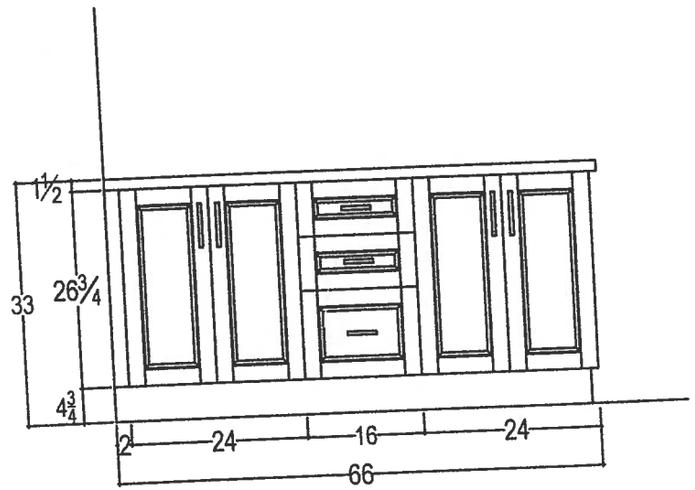

QTK
your kitchen. your taste.
80 SANTE DRIVE, VAUGHAN, ON L4K 3C4,
T: 416.746.1811 F:905.761.5901

CLIENT: ROYAL PINE HOMES	JOB NAME: UNIT 617 HMP	ROOM: VANITIES	DRAWN BY: SK
SITE: HAMPTON PLACE	DOOR STYLE: —	DOOR HANDLE: —	SCALE: 1/2" = 1' - 0"
PHONE: —	FINISH: —	DRW HANDLE: —	DATE: MAY 1,2018
EMAIL: —	SPECIES: —	TOP: —	PAGE: —

COMMENTS:

Suite 617
Hampton

Standard

WRT318FZDM

30-inch Wide Top-Freezer Refrigerator with Flexi-Slide™ Bin - 18.2 cu. ft.

Whirlpool HOME APPLIANCES

http://www.whirlpool.com

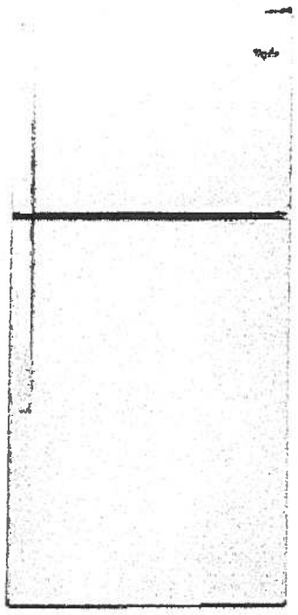

Key Features:

- Flexi-Slide™ Bin
- Frameless Glass Shelves
- Electronic Temperature Control
- Clear, Humidity Controlled Crispers

Product Dimensions:

Height: 65 7/8
Width: 29 3/4
Depth: 33 1/2

Additional Information:

Use And Care Guide
Dimension Guide
Energy Guide
Warranty Certificate

Available in:

- Black
- Monochromatic Stainless Steel
- White

ENERGY STAR

ADA Compliant

®Registered trademark/TM Trademark of Whirlpool, U.S.A. © 2013 Whirlpool Corporation. All Rights Reserved
All other trademarks are owned by their respective companies
Because Whirlpool Corporation policy includes a continuous commitment to improve our products, we reserve the right to change materials and specifications without notice. We also reserve the right to discontinue or transition products without notice.
Manufacturer's Suggested Retail Price (MSRP) and Minimum Advertised Price (MAP) provided for reference purposes only. Dealer alone determines advertised and retail prices.
Created On: Monday, March 14, 2016 12:09:07

Suite 617
Hampton Standard

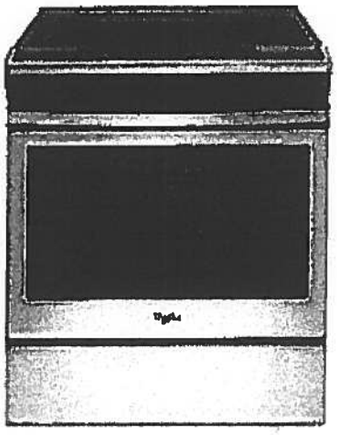

WEE510S0FS

Whirlpool® 4.8 cu. ft. Guided Electric Front Control Range With The Easy-Wipe Ceramic Glass Cooktop

MSRP: $1,149 00

Available Colors	
■	Black Model: WEE510S0FB MAJOR APPLIANCE
	Black-on-Stainless Model: WEE510S0FS MAJOR APPLIANCE
☐	White Model: WEE510S0FW MAJOR APPLIANCE

Dimensions	
Depth	28 15/16 Inches
Width	29 7/8 Inches
Gross Weight	172 LB

Dimensions shown are for planning purposes only. For complete information, see installation instructions packed with product.

Specifications	
Cooktop Features	
Cooktop Element Style	Smoothtop
Cooktop Surface Color	Color Coordinated Black on Stainless
Cooktop Surface Material	Glass
Number of Cooking Element-Burners	4
Left Front Element-Burner Power	3000W
Left Front Element-Burner Size	9"/6"
Left Front Element-Burner Type	Dual
Left Rear Element-Burner Power	1200W
Left Rear Element-Burner Size	6"
Left Rear Element-Burner Type	Radiant
Right Front Element-Burner Power	3000W
Right Front Element-Burner Size	9"/6"
Right Front Element-Burner Type	Dual
Right Rear Element-Burner Power	1200W
Right Rear Element-Burner Size	6"
Right Rear Element-Burner Type	Radiant
Oven Features	
Number of Oven Lights	1
Hot Surface Indicator Light	Yes
Power On Indicator Light	Yes
Light Type	Incandescent
Oven Rack Type	Standard (Both)
Controls	
Drawer Type	Storage Drawer
Selections	Clock; Timer; Warm Hold; Delay Start; Cook Time Indicator; Control Lock; Automatic Door Latch; Audible Signal; Sabbath Mode; Frozen Bake
ADA Compliant	ADA Height and Operation Compliant
Dimensions	
Depth	28 15/16 Inches
Width	29 7/8 Inches
General	
ADA Compliant	ADA Height and Operation Compliant

Key Features
Frozen Bake™ Technology
Guided Cooktop Controls
FlexHeat™ Dual Radiant Elements
Adjustable Self-Cleaning
Easy-Wipe Ceramic Glass Cooktop
Temperature Sensor
4.8 Cu. Ft. Capacity
Keep Warm Option
Closed Door Broiling
Delay Cook
Sabbath Mode
Star-K Certified
ADA Compliant
#1 Selling Appliance Brand in the U.S.A.

Product Literature
Warranty(33.12 KB) Owners Manual(502.10 KB) Installation Instructions(995.40 KB) Dimension Guide(124.36 KB)
You may need to install Adobe Acrobat Reader to view these documents.

UPC Listing
Model "WEE510S0FB" UPC: 883049391939 Model "WEE510S0FS" UPC: 883049391946 Model "WEE510S0FW" UPC: 883049391922

Standard
Suite 617
Hampton

WMH31017FS

Whirlpool®

http://www.whirlpool.com

1.7 cu. ft. Microwave Hood Combination with Electronic Controls

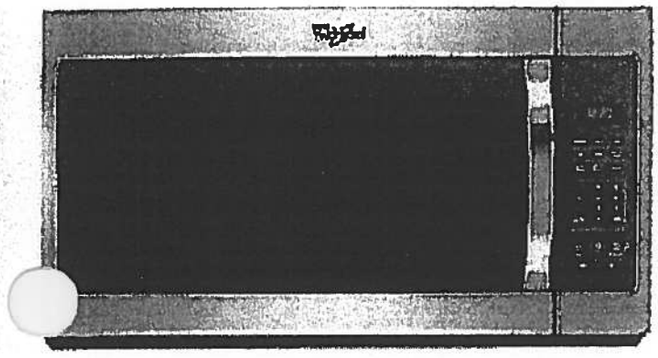

Key Features:

- Microwave Presets
- Electronic Touch Controls
- Dishwasher-Safe Turntable Plate
- 2-Speed, 300 CFM Vent Fan
- Add 30 Seconds Option
- Adjustable Cooktop Lighting
- #1 Selling Appliance Brand in the U.S.A.

Product Dimensions:

Height: 17 1/4
Width: 29 15/16
Depth: 17 7/8

Additional Information:

Use And Care Guide
Dimension Guide
Installation Guide
Warranty Certificate

Available in:

- ● Black
- ◎ Silver
- ◎ Stainless Steel
- ○ White

®Registered trademark/TM Trademark of Whirlpool, U S A. © 2016 Whirlpool Corporation All Rights Reserved
All other trademarks are owned by their respective companies.
Because Whirlpool Corporation policy includes a continuous commitment to improve our products, we reserve the right to change materials and specifications without notice. We also reserve the right to discontinue or transition products without notice.
Manufacturer's Suggested Retail Price (MSRP) and Minimum Advertised Price (MAP) provided for reference purposes only. Dealer alone determines advertised and retail prices
Created On Tuesday, February 07, 2017 12:20:03

Standard
Suite 617
Hampton

WDF330PAHS

Whirlpool®

Heavy-Duty Dishwasher with 1-hour Wash Cycle

http://www.whirlpool.com

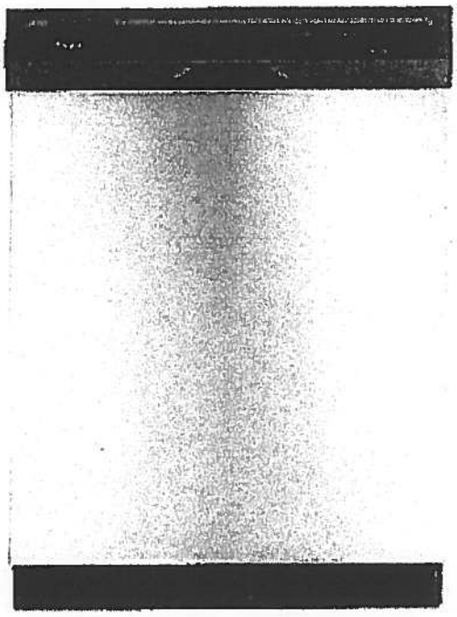

Key Features:

- 1-Hour Wash Cycle
- No One Has Fewer Repairs 20 Years in a Row
- Soil Sensor
- Normal Cycle
- Heavy Cycle
- High Temperature Wash Option
- Heated Dry Option
- Designed, Engineered and Assembled in the U.S.A. with American Pride

Product Dimensions:

Height: 34 1/2

Width: 23 7/8

Depth: 24 1/2

Additional Information:

Use And Care Guide

Dimension Guide

Installation Guide

Energy Guide

Warranty Certificate

INVESTED IN AMERICA

ENERGY STAR

®Registered trademark/TM Trademark of Whirlpool, U.S.A. © 2016 Whirlpool Corporation. All Rights Reserved.
All other trademarks are owned by their respective companies.
Because Whirlpool Corporation policy includes a continuous commitment to improve our products, we reserve the right to change materials and specifications without notice. We also reserve the right to discontinue or transition products without notice.
Manufacturer's Suggested Retail Price (MSRP) and Minimum Advertised Price (MAP) provided for reference purposes only. Dealer alone determines advertised and retail prices.
Created On: Wednesday, April 19, 2017 10:48:05

Standard
Suite 617
Hampton

7

WET4027EW

Whirlpool® HOME APPLIANCES

http://www.whirlpool.com

Combination Washer/Electric Dryer

Key Features:

- HE Agitator with Fabric Softener Cap
- White Porcelain Basket
- AutoDry™ Drying System
- 3 Drying Temperatures
- 2.5 Cu. Ft. Washer Capacity
- 5.9 Cu. Ft. Dryer Capacity
- Fabric Softener Dispenser
- Bleach Dispenser

Product Dimensions:

Height: 71 3/4
Width: 27 1/2
Depth: 32

Electrical Requirements:

30.

Additional Information:

Use And Care Guide
Dimension Guide
Installation Guide
Energy Guide
Warranty Certificate

Available in:

○White

INVESTED IN AMERICA

ENERGY STAR

®Registered trademark/TM Trademark of Whirlpool, U.S.A. © 2013 Whirlpool Corporation. All Rights Reserved
All other trademarks are owned by their respective companies.
Because Whirlpool Corporation policy includes a continuous commitment to improve our products, we reserve the right to change materials and specifications without notice. We also reserve the right to discontinue or transition products without notice.
Manufacturer's Suggested Retail Price (MSRP) and Minimum Advertised Price (MAP) provided for reference purposes only. Dealer alone determines advertised and retail prices
Created On: Friday, March 11 2016 12:26.17

Suite 617
Hampton

Main Bath
Master Ensuite

CALI®

4.8Lpf / 1.28Gpf 1PC 16⅞" HIGH ELONGATED

☐ ~~4710BOV Lined Tank~~

☐ 4710BOVU Unlined Tank

Product Specs:

- High efficiency toilet
- 4.8Lpf/1.28Gpf
- Elongated bowl with concealed skirted trapway
- Vitreous china
- 16⅞" Plus Height bowl
- Soft white tank lever
- 12" (305mm) Rough-in
- 2" Fully glazed ball pass trapway
- 3" Flapper
- Siphon jet flush action
- Water surface (240mm x 170mm) 9½" x 6⅝"
- Decorative chrome and soft white side caps included
- Smooth close toilet seat included

Overall Dimensions:

392mm (W) x 725mm (D) x 760mm (H)
15½" (W) x 28½" (D) x 29⅞" (H)

Compliance Certifications:

Meets or exceeds the following:

- IAPMO cUPC
- US EPA WaterSense
- ASME A 12.19.2 / CSA B45.1-2013
- ADA Guidelines & ANSI A117.1
- **MaP Tested 1000g**
- LEED Compliant

Shipping:

Cube	9.39
GW	92.50lbs

Notes:

This toilet is designed to rough-in at a minimum dimension of 305mm (12") from finished wall to C/L of outlet. Supply line not included with fixture and must be ordered separately.
Important: Dimensions of fixtures are nominal and may vary within the range of tolerances establishedby ASME standard A112.19.2. These measurements are subject to change or cancellation. No responsibility is assumed for use of superseded or voided pages.
Products are designed to comply ADA/ANSI A117.1 Standard. It shall be the responsibility of the installer to comply with the local disability codes and standards prior to installing the product.

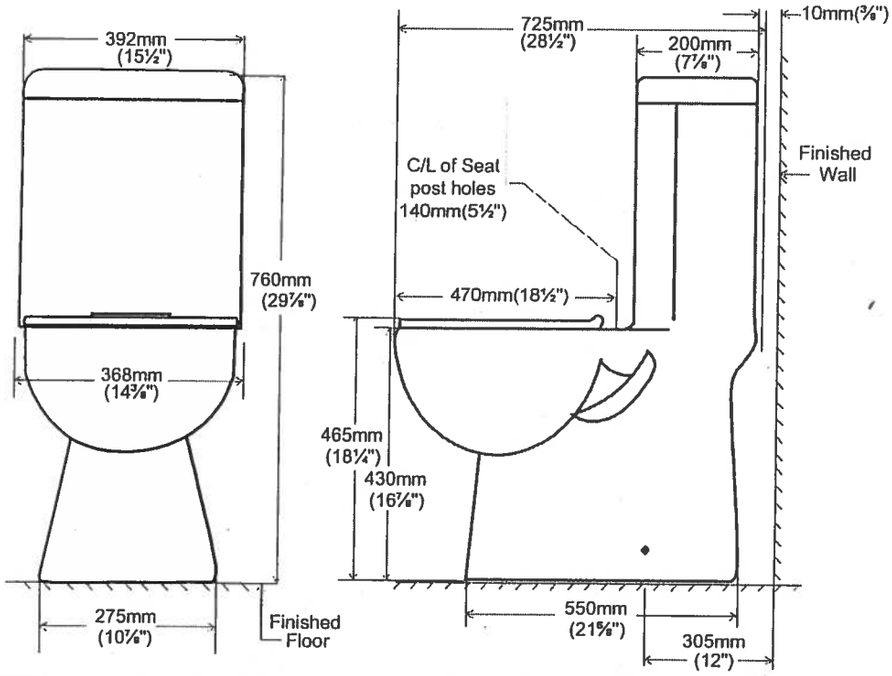

Countertop Edges
Suite 617
Hampton

CONNOLLY Marble & Granite Ltd.

EDGE DETAILS

004

A.

STRAIGHT EDGE
(STANDARD - 3/4")

Upgrade:

Kitchen
Main Bath
Master Ensuite

I.

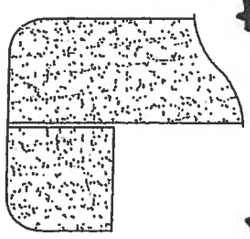

DOUBLE TOP "D" EDGE
(STANDARD - 1 1/2")

II.

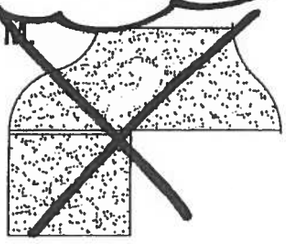

OGEE - SQUARE EDGE
(MED./HIGH - 1 1/2")

EDGING UP-GRADE OPTIONS