



## Site Instruction

Royal Pine Homes  
3550 Langstaff Road, Suite 200  
Woodbridge, Ontario  
L4L 9G3

SI 19

**PROJECT** : Hampton Manor  
**PROJECT No** : 1136.13  
**DATE** : May 28, 2018

Attn: Vince Staffieri

Site instructions/memos and Addendums are issued only for the purpose of recording any clarification or interpretation of the contract documents or giving direction on problems resulting from field conditions. These memos are subject to the provisions of the contract documents and unless reviewed with and authorized by the Client, will not affect the contract. Should the Contractor require a change in the contract price or project schedule, he shall submit to the Client, prior to commencement of work outlined in this memo, an itemized proposal for approval.

Title: 6<sup>th</sup> Floor Terrace Curb wall overlap Revision

### CS304 – 6<sup>th</sup> Floor CS Plan

- Revising terrace curb wall overlap by Gridlines 1 and X, U and gridlines 4 and J, C.

Reason: **As per precast panel installer request.**

References: **CS304.**

**GRAZIANI + CORAZZA**  
ARCHITECTS INC


**G. Colangelo** Diploma Arch. Technology  
Associate. Director of Contract Documents

### Distribution:

Royal Pine Homes  
Dineen Construction  
Dineen Construction  
Dineen Construction

Cinzia Caruso  
Dominic Salvati  
Jeff Ellis  
Eric Wright

cinzia@royalpinehomes.com  
dsalvati@dineen.com  
jellis@dineen.com  
rwright@dineen.com

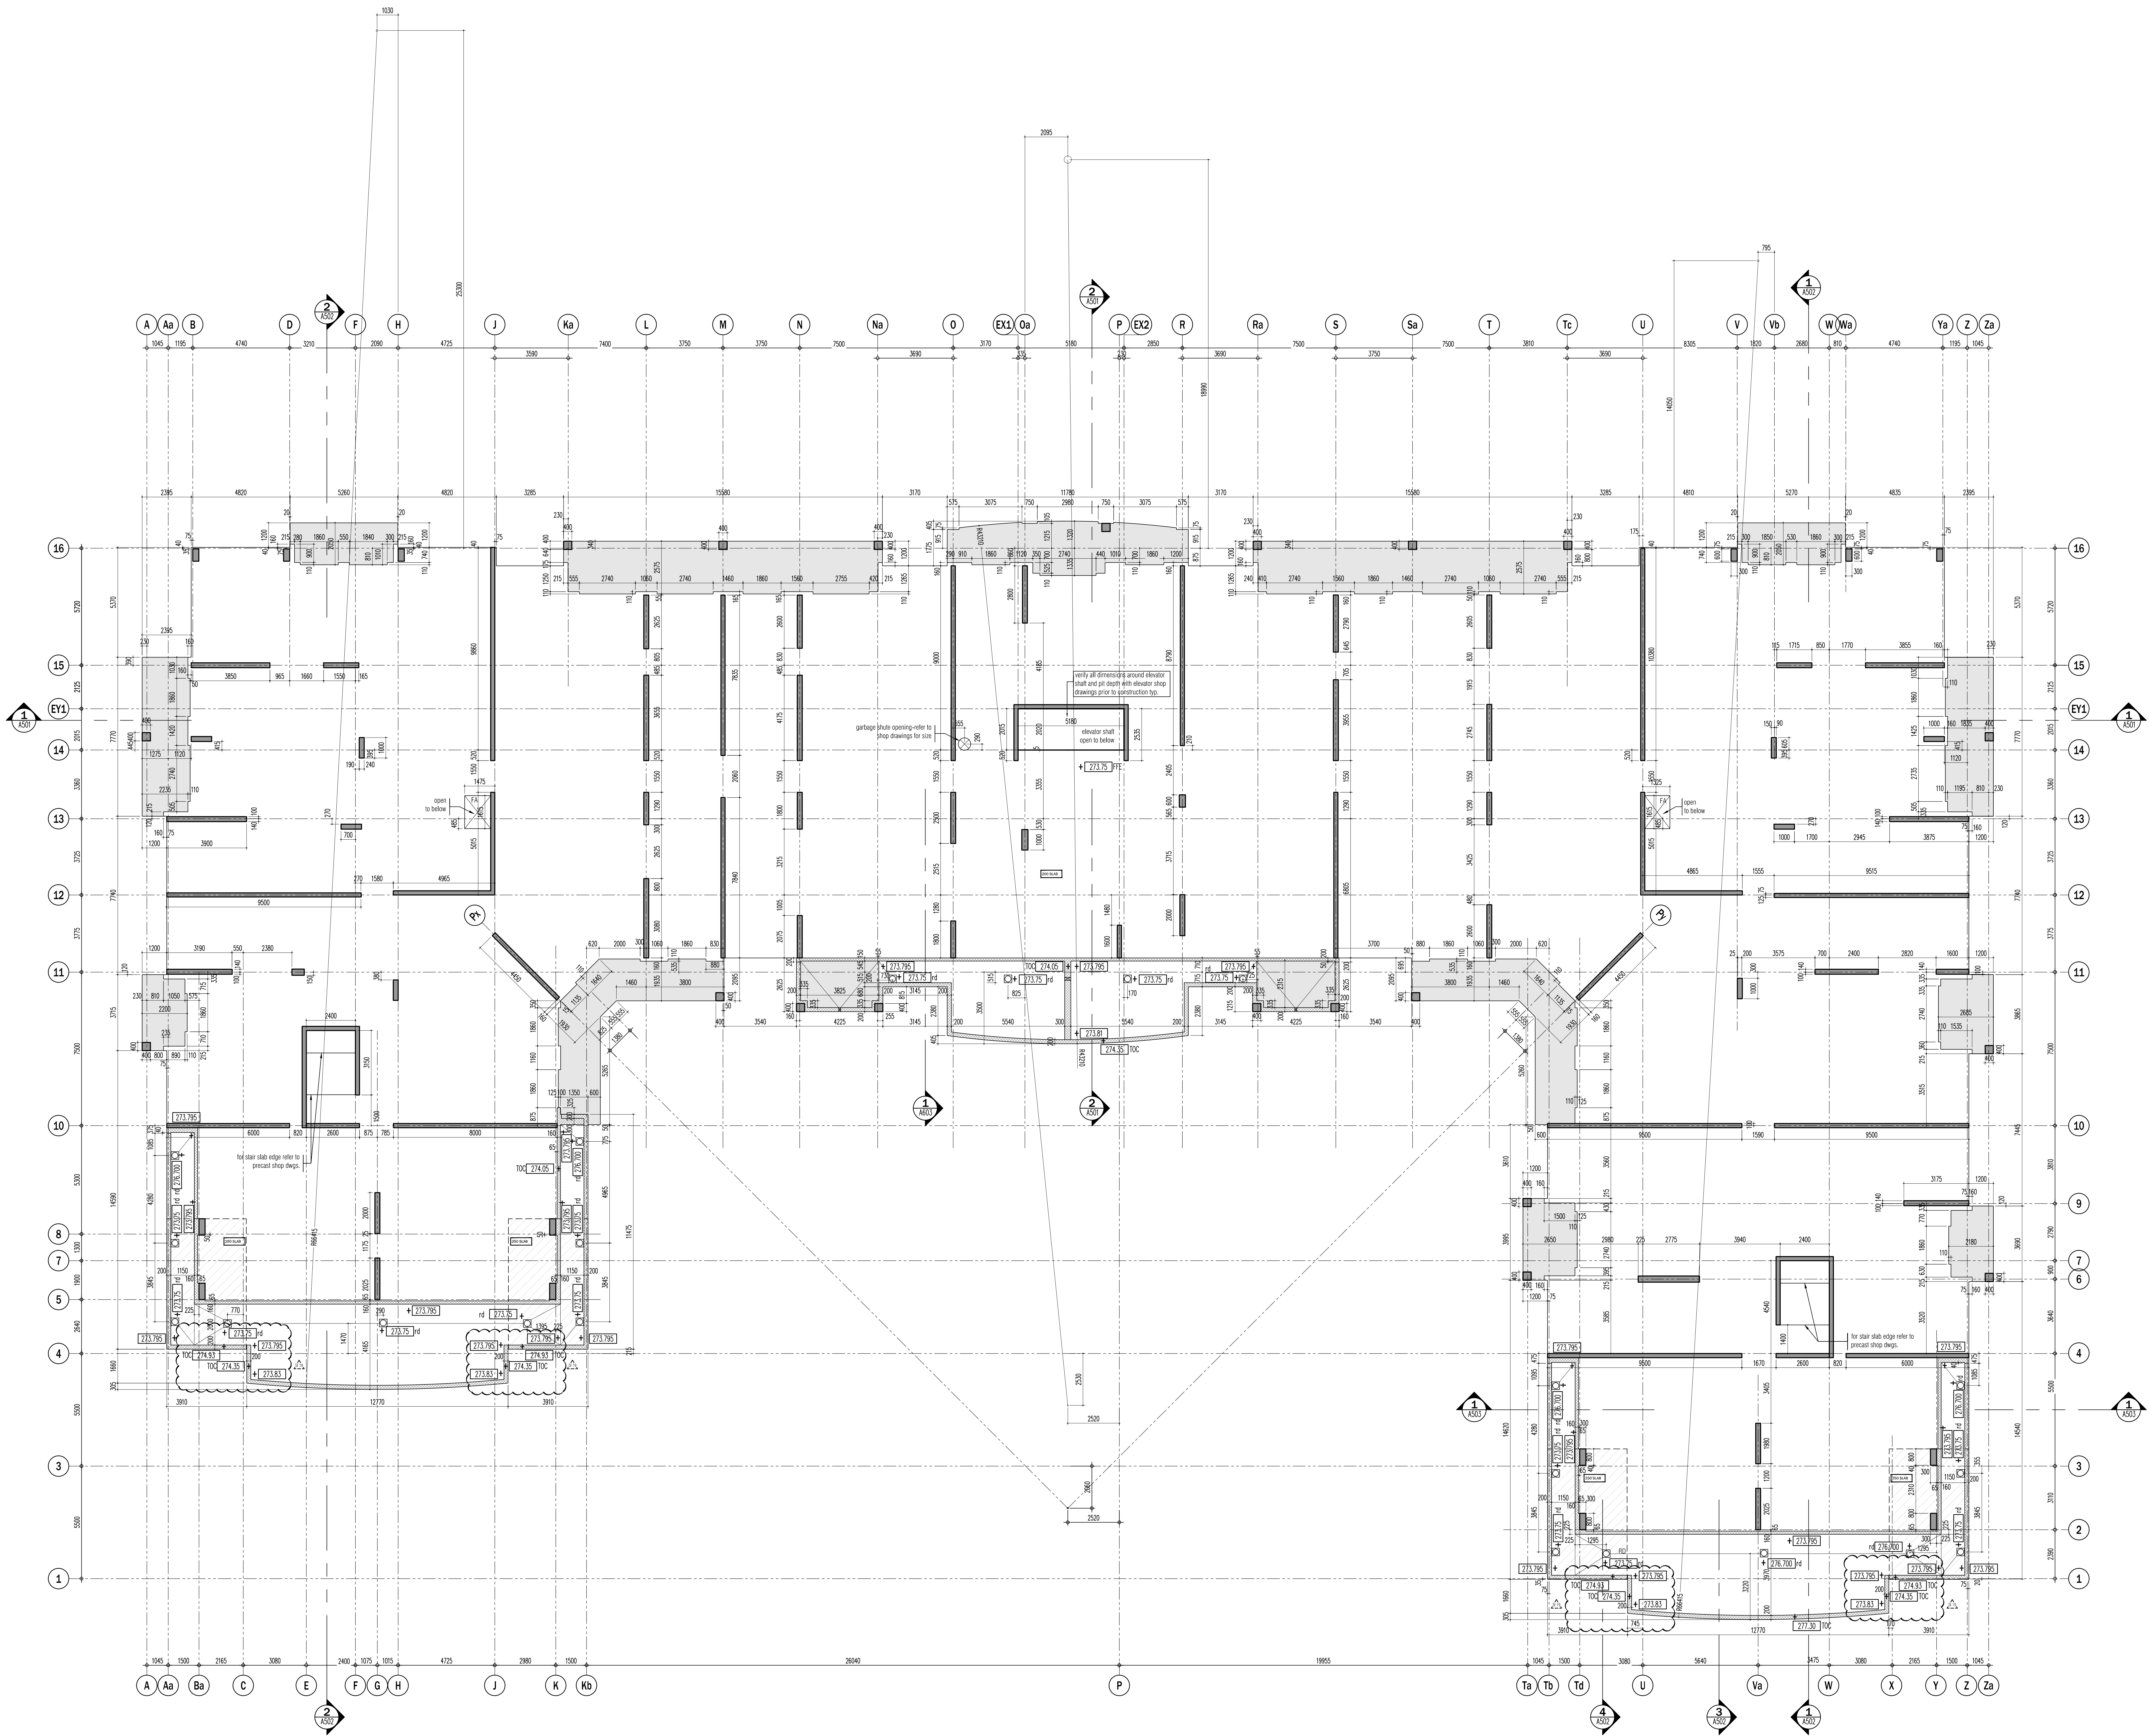



This drawing is not to be used for construction purposes until counterchecked by the Architect.

Rev.	Date	Description	By
01.	FEB.18.2014	issued to city for SPA	B.G.
02.	JUL.9.2014	re-issued to city for SPA	B.G.
03.	SEP.11.2014	re-issued to city for SPA	B.G.
04.	JAN.15.2015	re-issued to city for SPA	B.G.
05.	MAR.15.2015	issued for tender	B.G.
06.	DEC.28.2016	issued for building permit	B.G.
07.	MAY.10.2017	re-issued for building permit	B.G.
08.	MAY.10.2017	issued for Footings and Foundation Permit	B.G.
09.	JUL.11.2017	issued for Construction	B.G.
10.	JUL.11.2017	Progress for Construction	B.G.
11.	OCT.25.2017	Revision to Envelope	B.G.
12.	NOV.08.2017	Added Dimensions	B.G.

1. MAY.28.2017 3110 TERRACE CORB WALL REVISION B.G.  
issued for revisions

**GRAZIANI**  
**CORAZZA**  
ARCHITECTS INC.  
1135 Steeles Road, Suite 100, Markham, Ontario  
Phone: 905.709.3800 Fax: 905.709.3844 www.g-corp.com

PROPOSED RESIDENTIAL DEVELOPMENT

25 BAKER HILL BLVD.

ROYAL PINES HOMES

STOUFFVILLE ONTARIO

Project Architect: B. GRAZIANI

Assistant Designer: R. LINCOLN

Drawn By: S.G.

Checked By: G. COLANGELO/D.BIASE

Plot Date: Nov. 8, 2017

Job #: 1136.13

6TH FLOOR CS PLAN

1:100 CS 304  
TITLE BLOCK SIZE: 915 x 1400