



Site Instruction

Royal Pine Homes
3550 Langstaff Road, Suite 200
Woodbridge, Ontario
L4L 9G3

SI 28

PROJECT	: Hampton Manor
PROJECT No	: 1136.13
DATE	: November 08, 2018

Attn: Vince Staffieri

Site instructions/memos and Addendums are issued only for the purpose of recording any clarification or interpretation of the contract documents or giving direction on problems resulting from field conditions. These memos are subject to the provisions of the contract documents and unless reviewed with and authorized by the Client, will not affect the contract. Should the Contractor require a change in the contract price or project schedule, he shall submit to the Client, prior to commencement of work outlined in this memo, an itemized proposal for approval.

Title: Stair D Door Swing.

A701 – Stair Drawings

- Stair D door to swing out.

Reason: **As per Architect Instruction and clarification**

References: **A701.**

GRAZIANI + CORAZZA
ARCHITECTS INC






G. Colangelo Diploma Arch. Technology
Associate, Director of Contract Documents

Distribution:

Royal Pine Homes
Dineen Construction
Dineen Construction
Dineen Construction

Cinzia Caruso
Dominic Salvati
Jeff Ellis
Eric Wright

cinzia@royalpinehomes.com
dsalvati@dineen.com
jellis@dineen.com
rwright@dineen.com

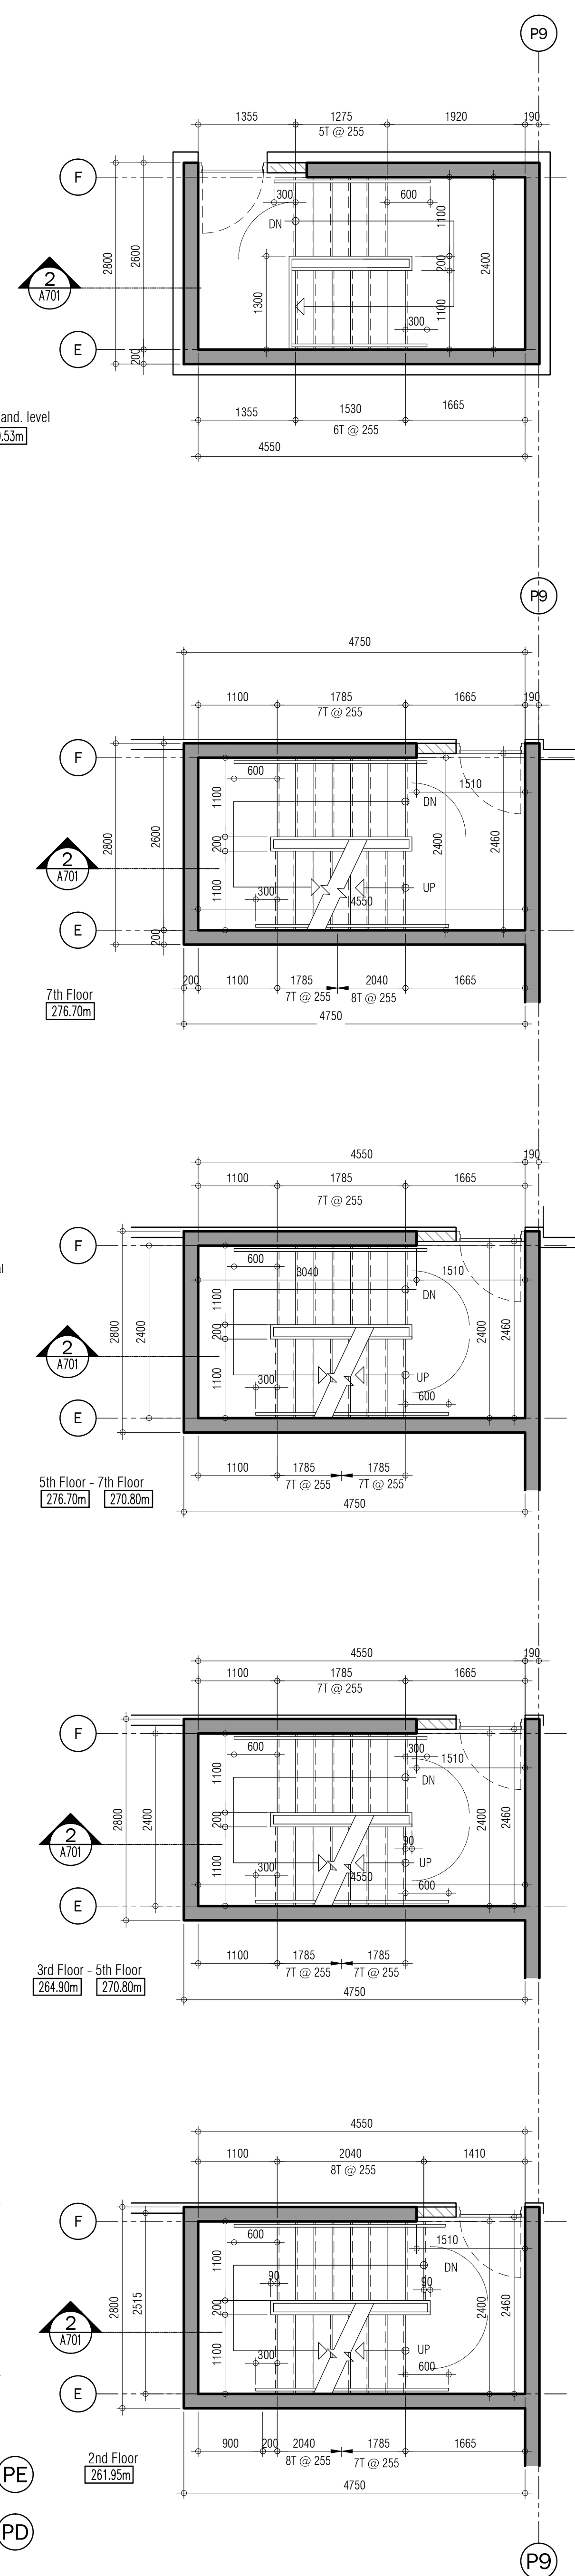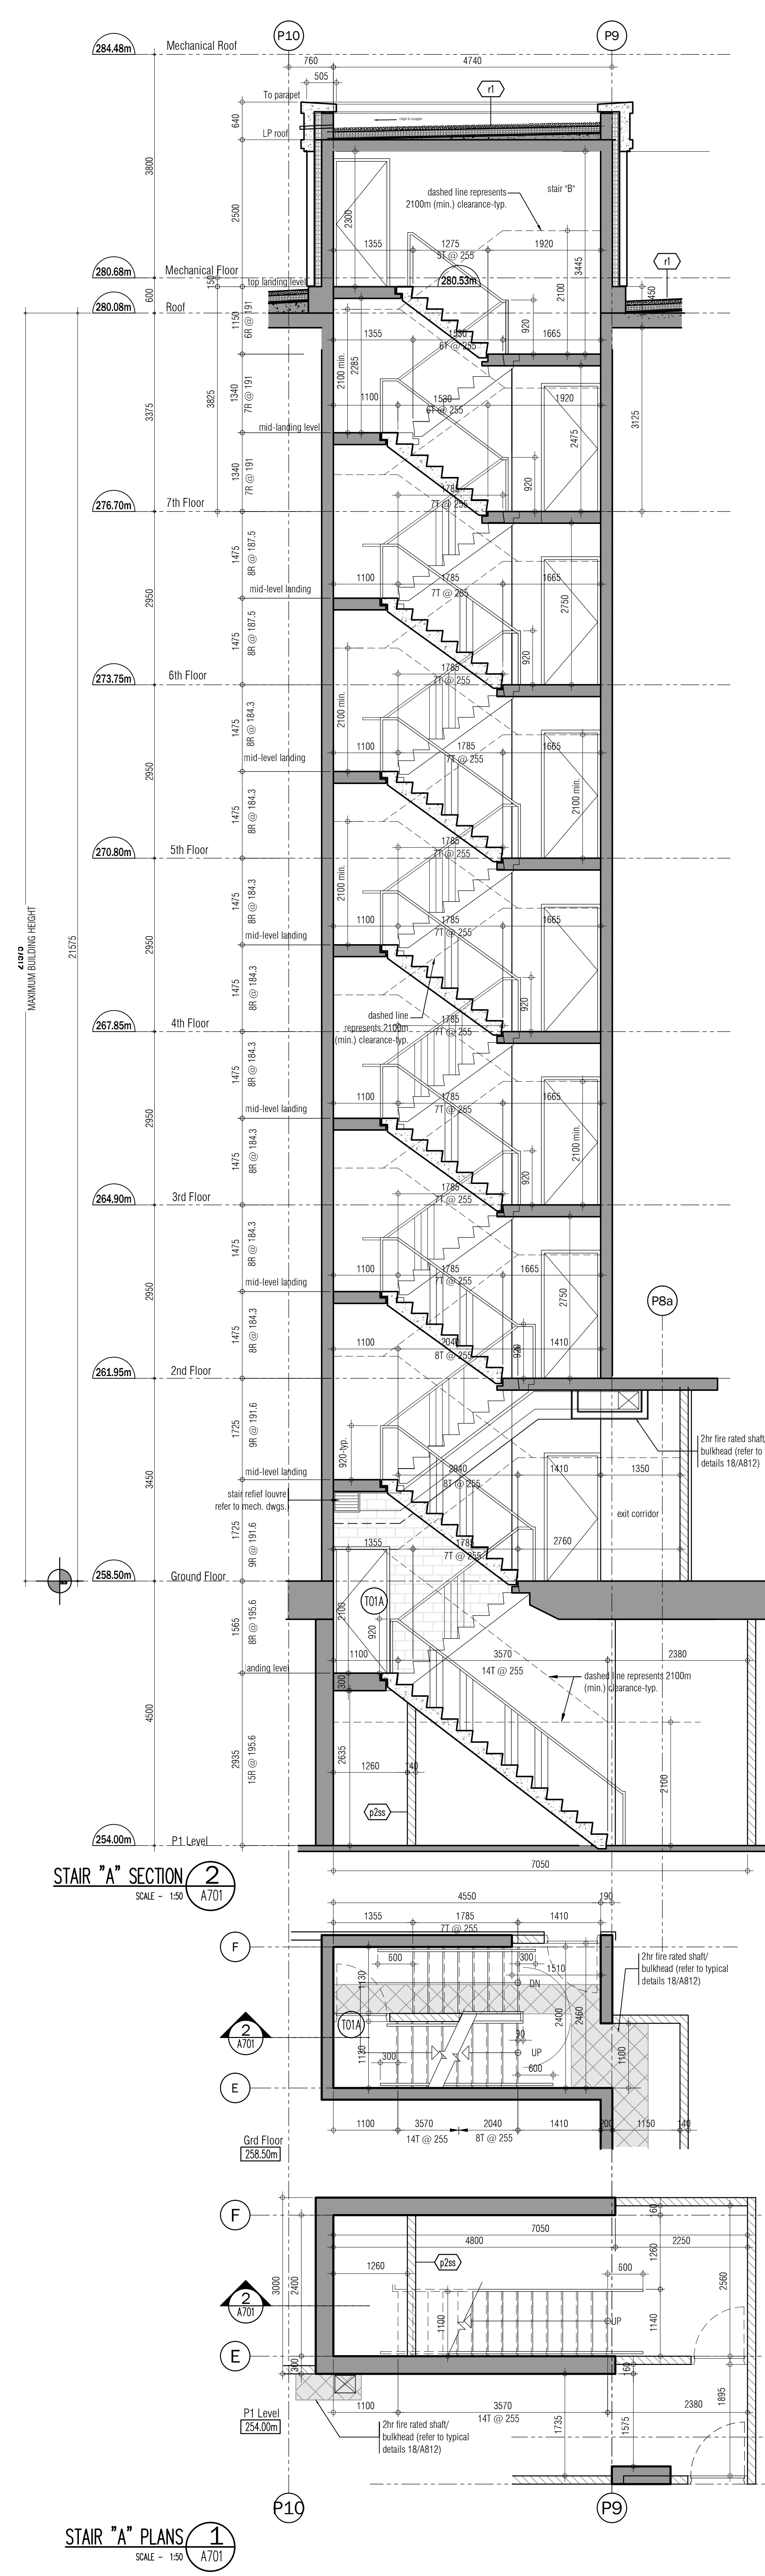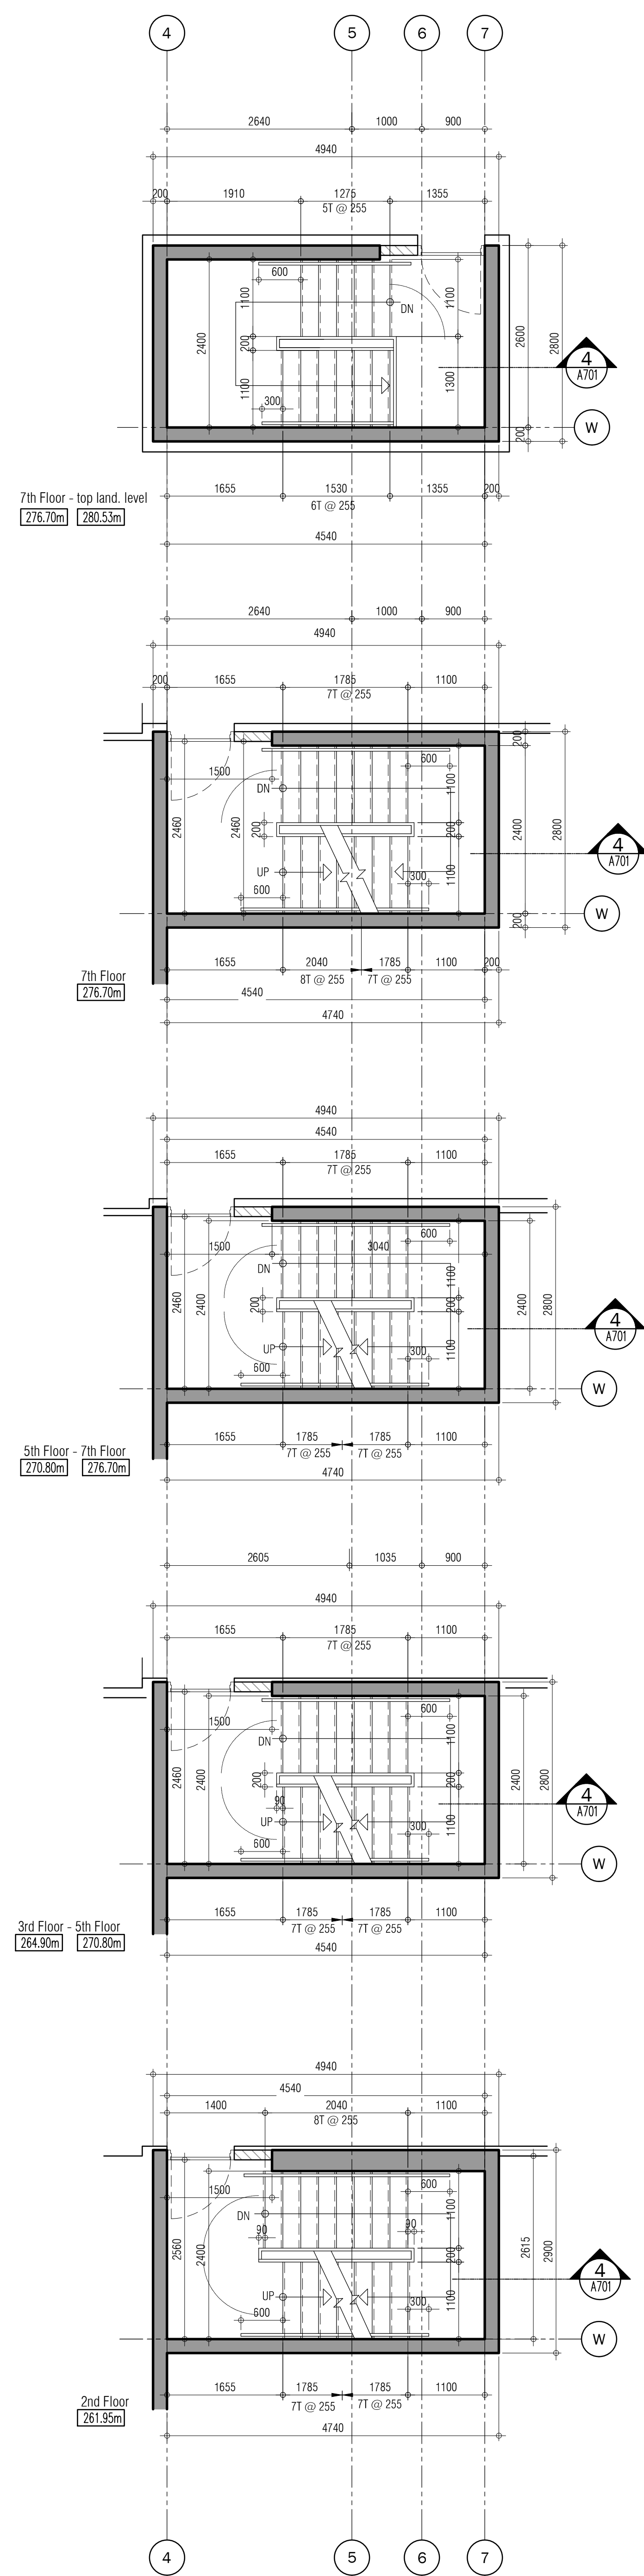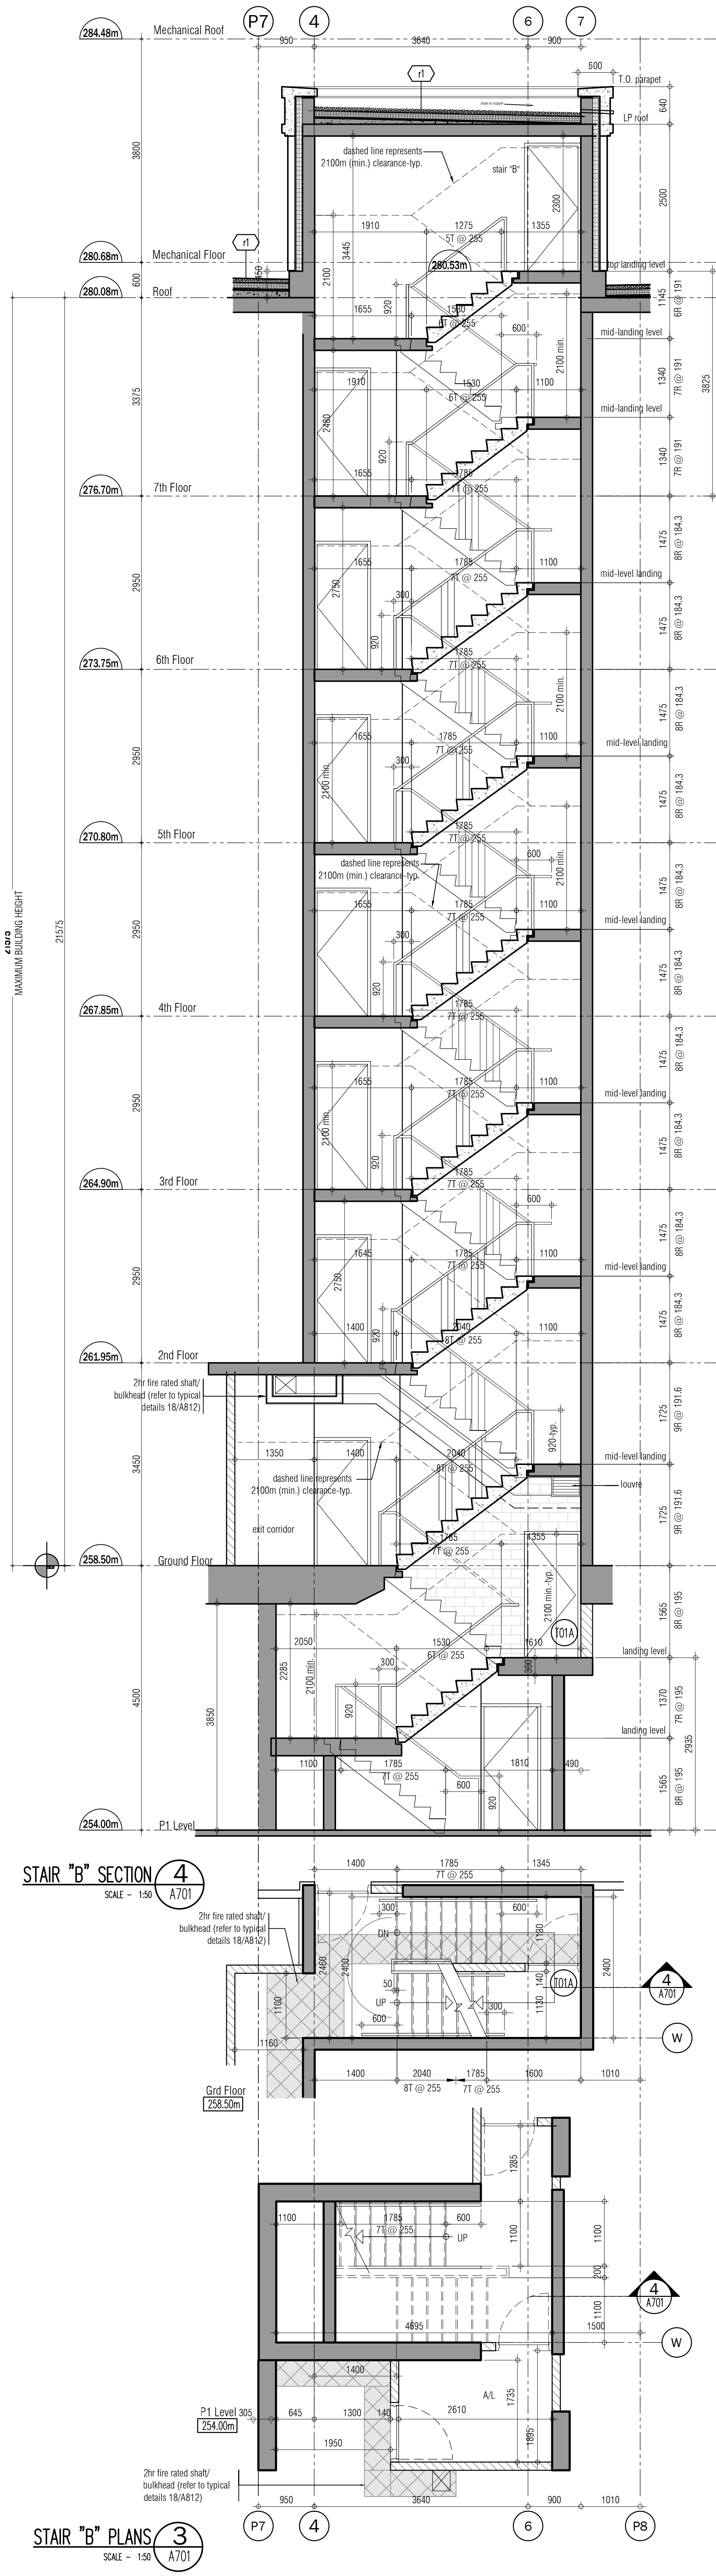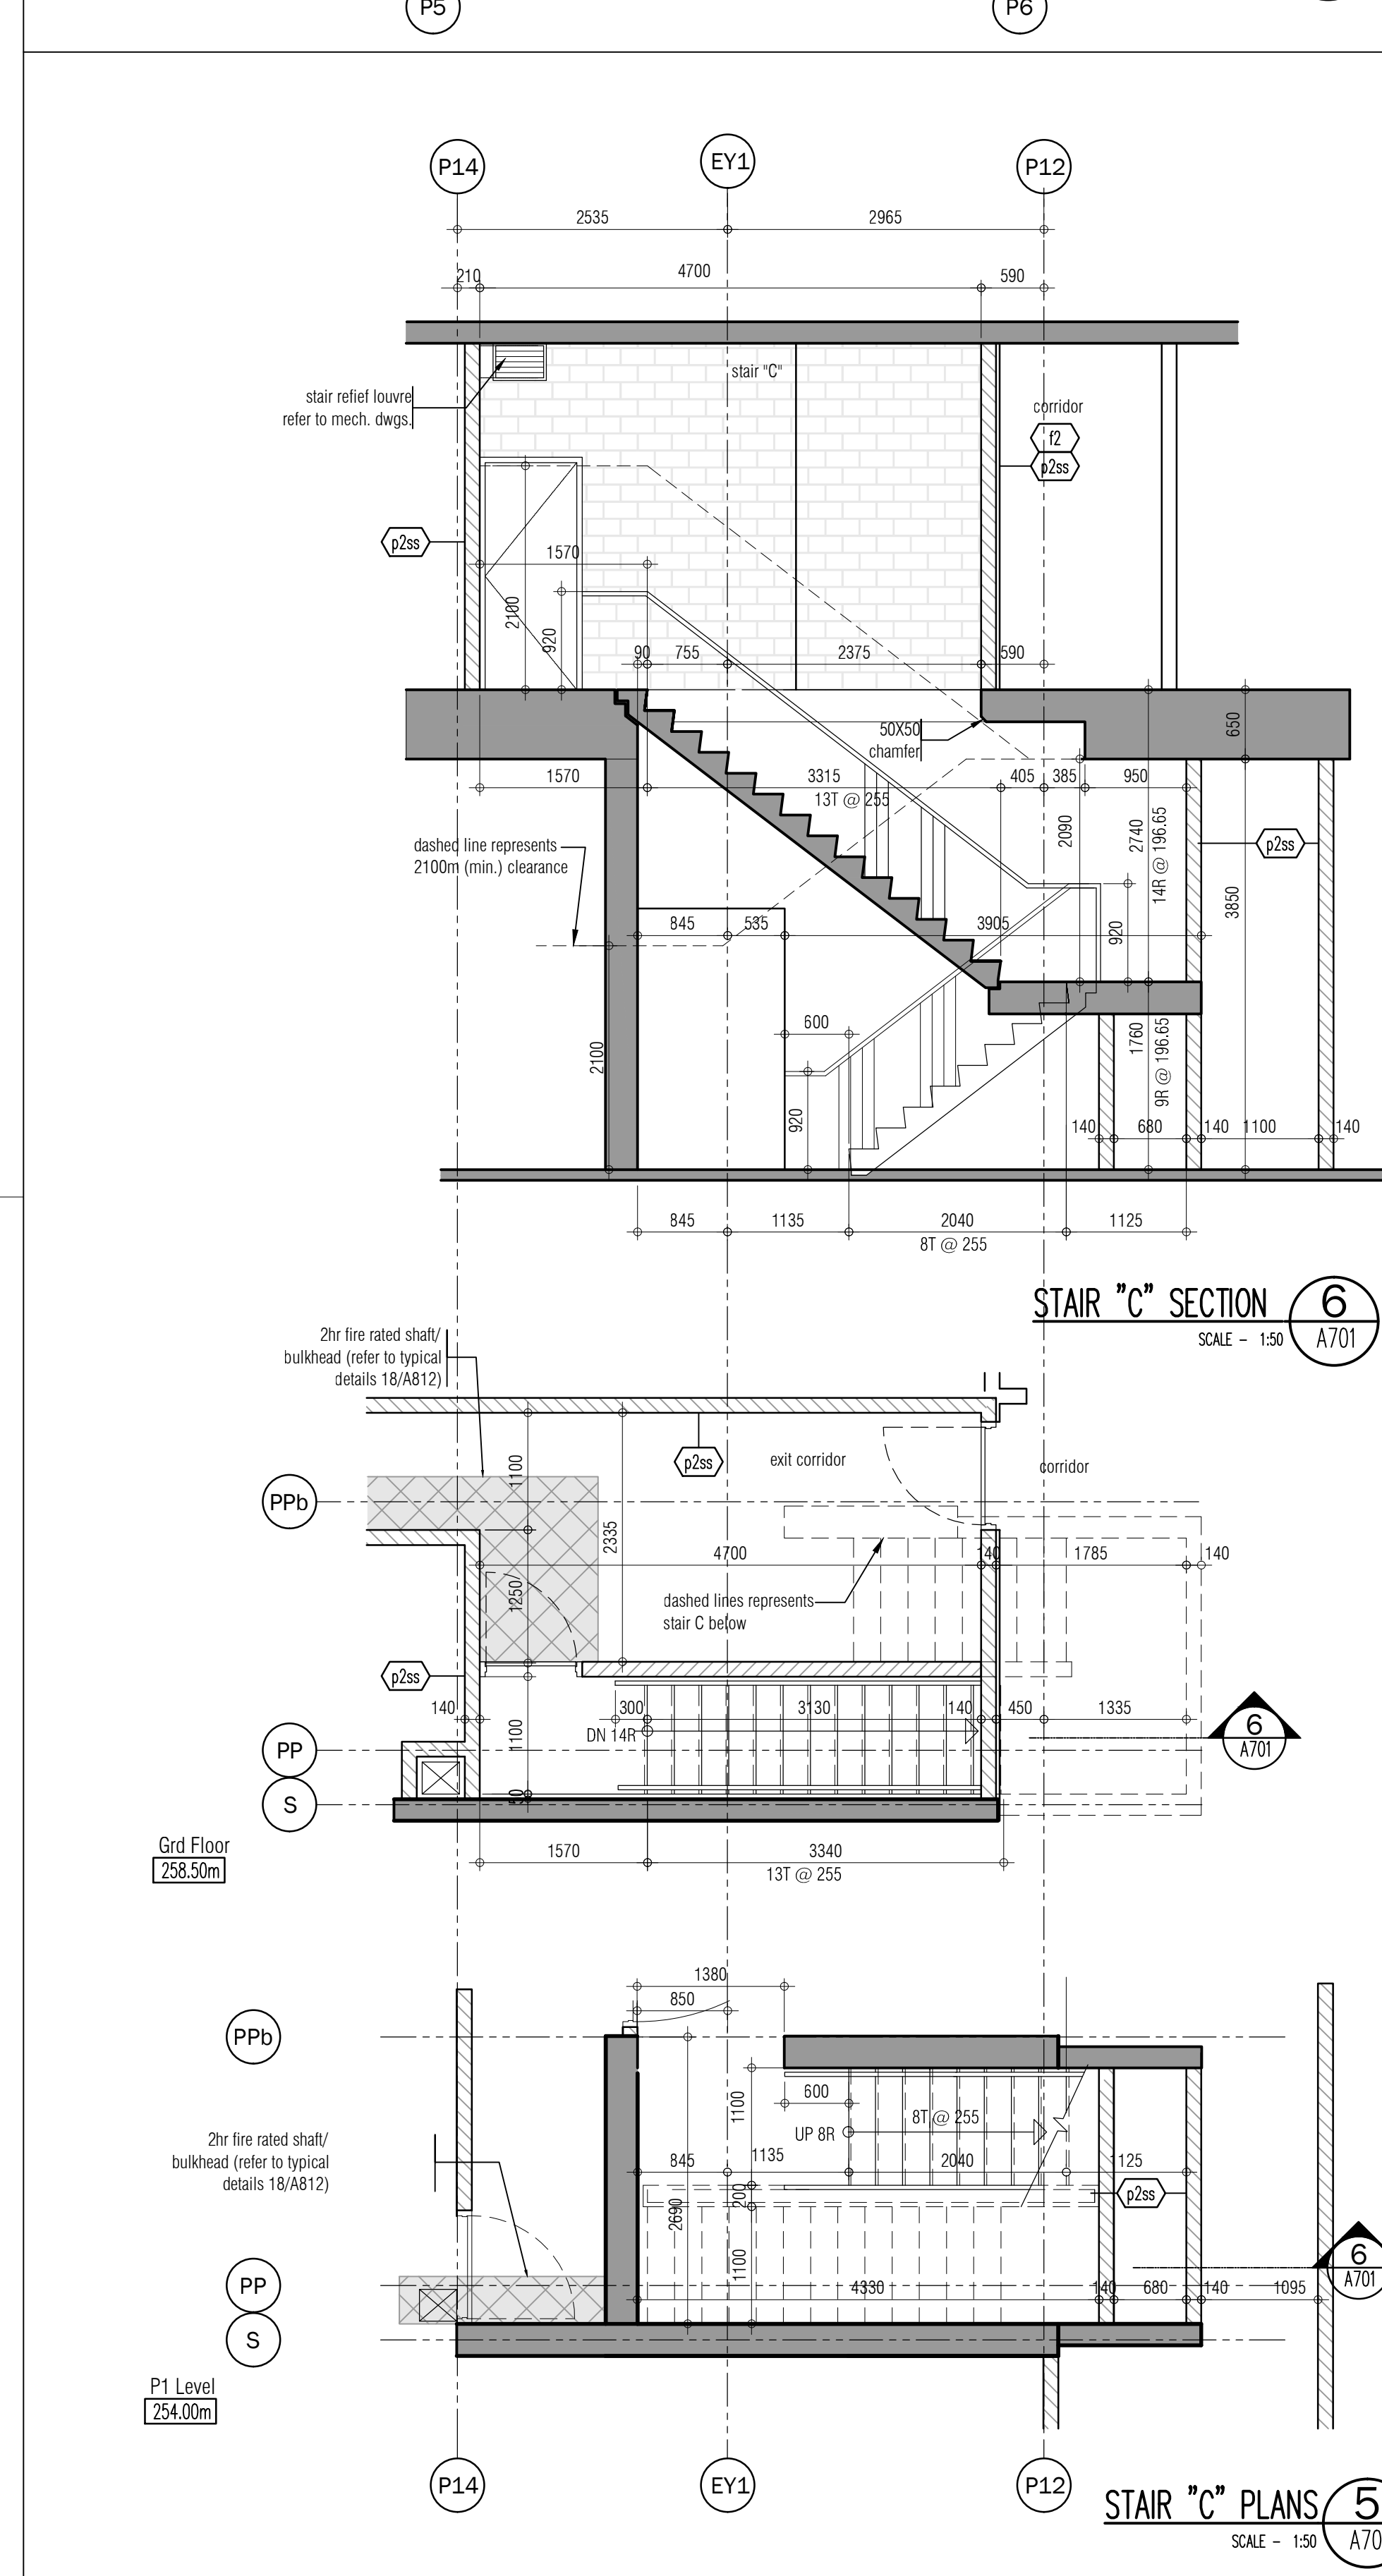

Construction must conform to all applicable codes and requirements of the authority having jurisdiction. Verify otherwise noted. No exception has been undertaken or reported on by this office in regards to the environmental condition of this site.


This drawing is not to be used for construction purposes until countersigned by the Architect.

This drawing is not to be scaled. All architectural symbols indicated on this drawing or graphic representations only.

01.	FEB.28.2014	issued to city for SPA	B.G.
02.	JUL.3.2014	re-issued to city for SPA	B.G.
03.	SEP.1.2014	re-issued to city for SPA	B.G.
04.	JAN.15.2015	re-issued to city for SPA	B.G.
05.	MAR.15.2015	issued for tender	B.G.
06.	DEC.2.2016	issued for building permit	B.G.
07.	MAY.10.2017	re-issued for building permit	B.G.
08.	MAY.10.2017	Issued for Footings and Foundation Permit	B.G.
10.	JULY.19.2017	Progress for Construction	B.G.
11.	AUG.09.2017	Issued for Construction	B.G.
12.	OCT.25.2017	Revision to Envelope	B.G.
13.	APR.04.2018	Re-issued for Building Permit	B.G.

03.	NOV.08.2018	SI 28 STAIR D DOOR SWING	BG
02.	JUNE.14.2018	SI 20 MECHANICAL FL PRECAST UPDATE	BG
01.	DEC.11.2017	SI11 REVISE GRID/ADD DIMS AT STAIR C	BG

issued for revisions

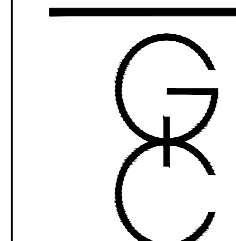

**GRAZIANI
+
CORAZZA
ARCHITECTS INC.** +

1520 Sheppard Ave. Suite 100 Woodbridge Ontario L4W 1W7
Phone: 905.795.2601 Fax: 905.795.2844 www.gc-architects.com

PROPOSED RESIDENTIAL DEVELOPMENT

25 BAKER HILL BLVD.

ROYAL PINES HOMES

STOUFFVILLE ONTARIO

Project Architect: B. GRAZIANI

Assistant Designer: R. LINCOLN

Drawn By: S.G.

Checked By: G. COLANGELO/D.BIASE

Plot Date: JUL 4, 2018

Job #: 1136.13

Stair "A" - "D" Drawings
Plans & Sections

1:50 A701

TITLEBLOCK SIZE: 915 x 1400