



ADDENDUM

Forestside Estates
Attmar & Palleschi Drive
Brampton, Ontario
Attn: **Vince Staffieri**

AM 01

PROJECT : Forestside
PROJECT # : 1331.15
DATE : September 18, 2019

Site instructions/memos and Addendums are issued only for the purpose of recording any clarification or interpretation of the contract documents or giving direction on problems resulting from field conditions. These memos are subject to the provisions of the contract documents and unless reviewed with and authorized by the Client, will not affect the contract. Should the Contractor require a change in the contract price or project schedule, he shall submit to the Client, prior to commencement of work outlined in this memo, an itemized proposal for approval.

Title: Updated drawings

[illegible]




Reason: **Design changes as directed by client.**

GRAZIANI + CORAZZA
ARCHITECTS INC

D. Biase C.E.T.
Principal

Distribution:

Royal Pine Homes	Vince Staffieri Cinzia Caruzo	vince@royalpinehomes.com Cinzia@royalpinehomes.com
Jablonski Engineering	Kevin Deonaraine	kdeonaraine@astint.on.ca
United Engineering	Rene Cuales Leonard Matthews Susan Pan Mark Giorgi	rene@u-eng.ca Lenard@u-eng.ca susan@u-eng.ca mark@u-eng.ca
Candevcon Limited	Diarmund Hogan Dudister Damnaraigh	dhorgan@candevcon.com dude@candevcon.com
Starfire Sprinkler Systems	Elite Novosselova Peter Adrian	elitecanada@hotmail.com Peter@starfiresystems.biz
Strybos Barron King Ltd.	Bryn Barron Kaleigh Gills Sydney Martel	bbarron@strybos.com kgillis@strybos.com smartel@strybos.com
Graziani + Corazza Architects	Domenic Biase Gino Colangelo Fernando Croatto	dbiase@gc-architects.com gcolangelo@gc-architects.com FCroatto@gc-architects.com

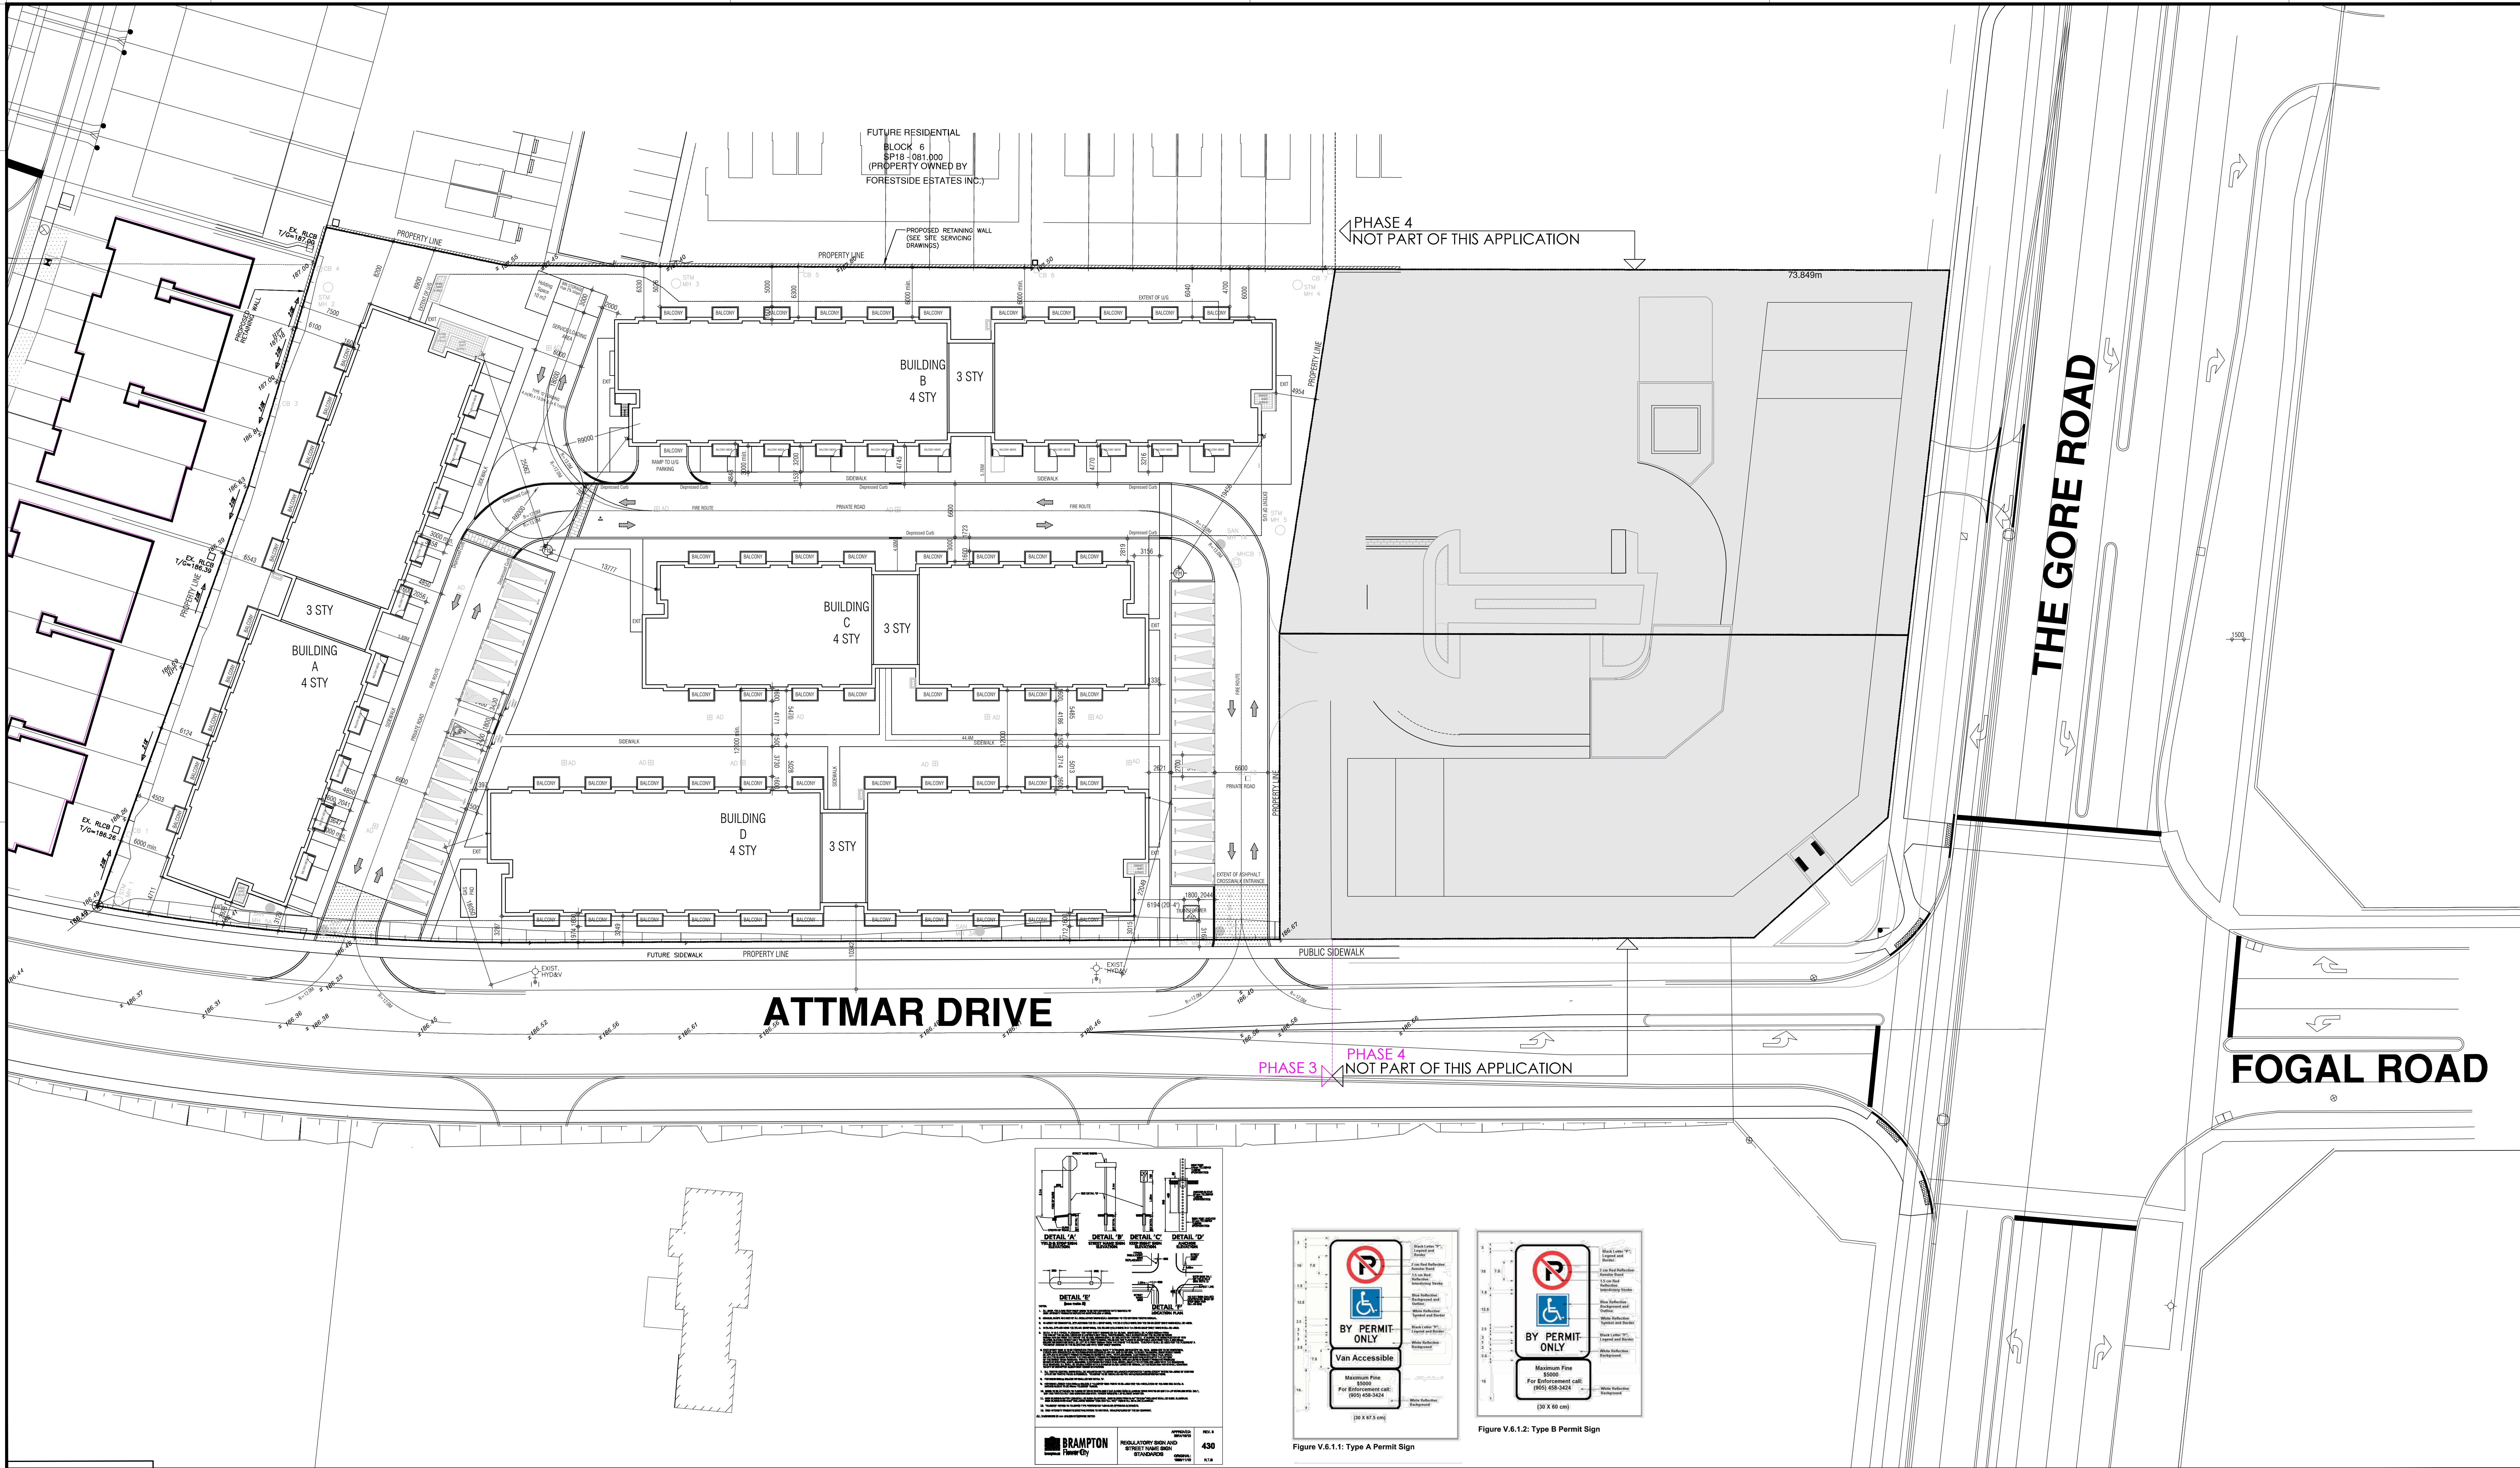

THIS DRAWING, AS AN INSTRUMENT OF SERVICE, IS PROVIDED BY AND IS THE PROPERTY OF GRAZIANI-CORAZZANI ARCHITECTS INC. THE CONTRACTOR MUST VERIFY AND ACCEPT RESPONSIBILITY FOR ALL DIMENSIONS AND CONDITIONS ON SITE AND MUST KEEP GRAZIANI-CORAZZANI ARCHITECTS INC. OF ANY VARIATIONS FROM THE SUPPLIED INFORMATION. GRAZIANI-CORAZZANI ARCHITECTS INC. IS NOT RESPONSIBLE FOR THE ACCURACY OF SURVEY, STRUCTURAL, MECHANICAL, ELECTRICAL, AND OTHER ENGINEERING INFORMATION SHOWN ON THIS DRAWING. HEREIN TO THE APPROPRIATE ENGINEERING DRAWING BEFORE PROCEEDING WITH THE WORK. CONSTRUCTION MUST CONFORM TO ALL APPLICABLE CODES AND REQUIREMENTS OF THE AUTHORITIES HAVING JURISDICTION. ANALYSIS CHANGES NOTED: NO INVESTIGATION HAS BEEN UNDERTAKEN OR REPORTED ON BY THE OFFICE IN REGARD TO THE ENVIRONMENTAL CONDITION OF THE SITE.

THIS DRAWING IS NOT TO BE SCALED. ALL ARCHITECTURAL DIMENSIONS INDICATED ON THIS DRAWING ARE GRAPHIC REPRESENTATIONS ONLY.


CONDITIONS FOR ELECTRONIC INFORMATION TRANSFER:

ELECTRONIC INFORMATION IS SUPPLIED TO THE OTHER ASSOCIATED PARTS TO ASSIST THEM IN THE EXECUTION OF THEIR WORK. REVEREND PARTS MUST DETERMINE THE APPROPRIATE APPROPRIATE REVEREND OF THE INFORMATION IN RESPECT TO THEIR PARTICULAR RESPONSIBILITY.

GRAZIANI-CORAZZANI ARCHITECTS INC. SHALL NOT BE RESPONSIBLE FOR:

1. ERRORS, OMISSIONS, INADEQUACIES DUE TO LOSS OF INFORMATION IN WHOLE OR PART WHEN INFORMATION IS TRANSFERRED.
2. TRANSMISSION OF ANY INFO OR CHANGE TO THE RECEIVING ELECTRONIC SYSTEM WHEN INFORMATION IS TRANSFERRED.


01. Aug 02 2019 Issued for tender

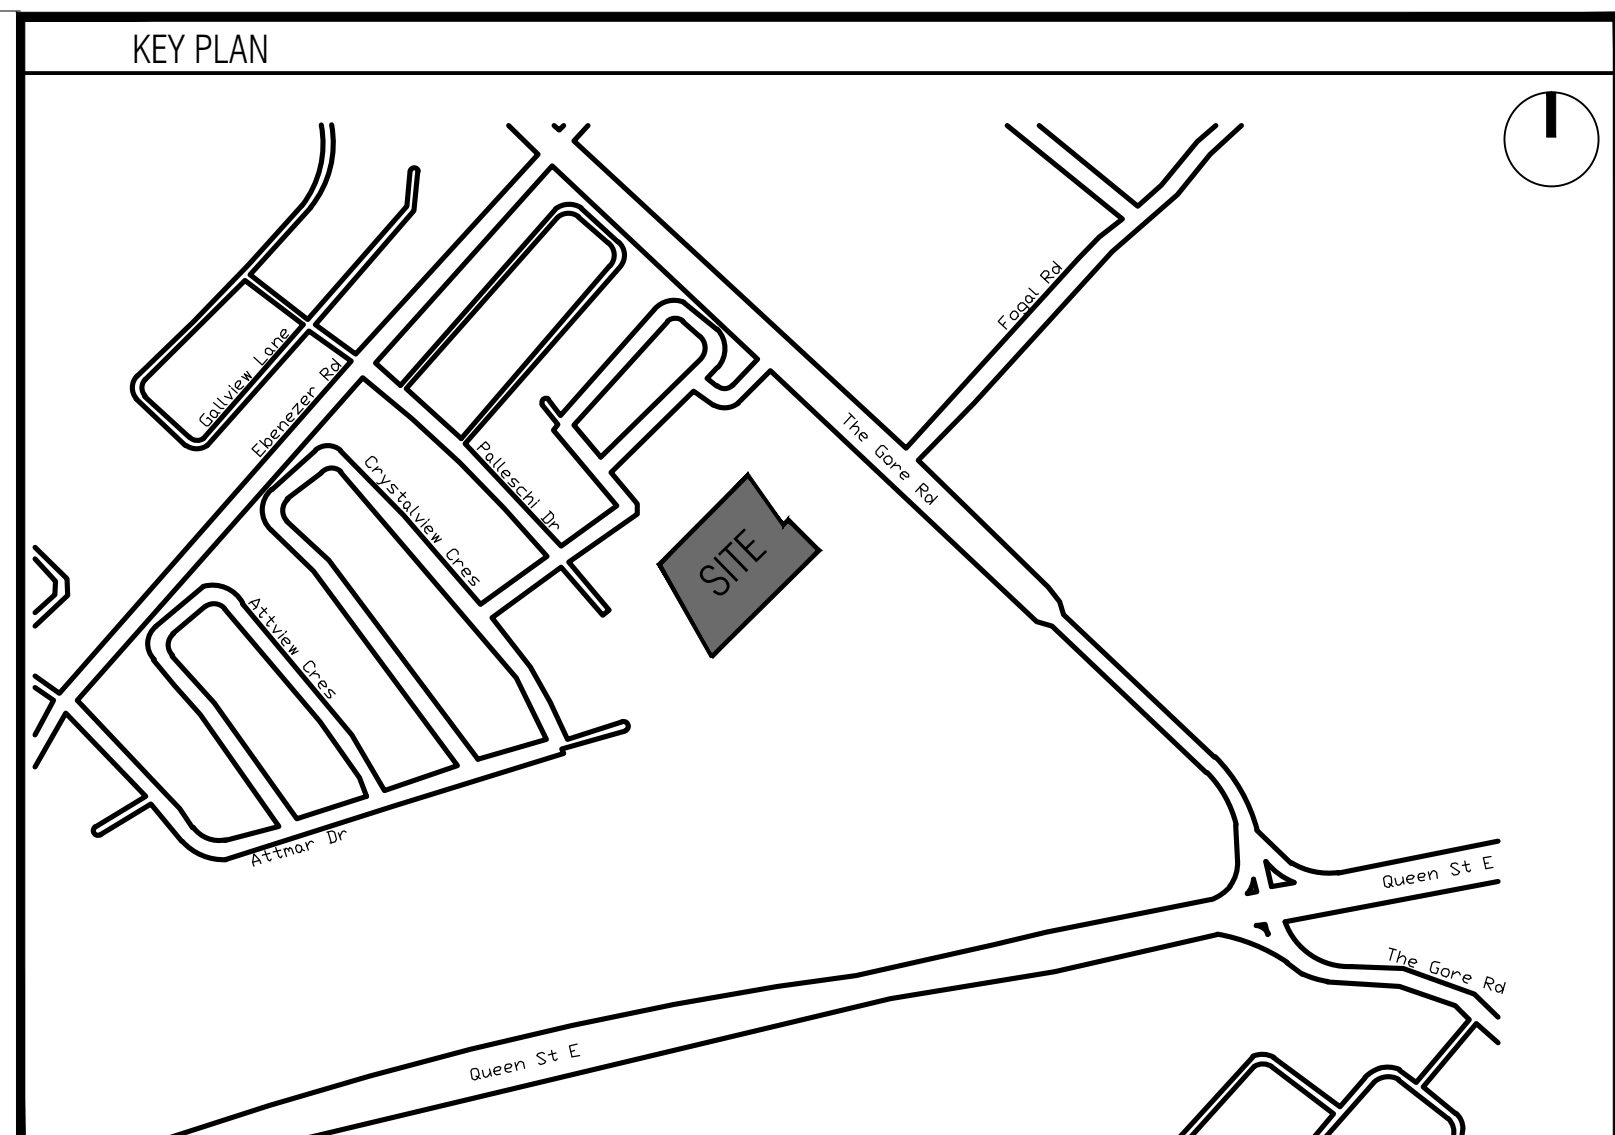

- GENERAL NOTES
1. For landscaping, refer to landscape drawings.
 2. For proposed grading, refer to landscape drawings and approved grading plan.
 3. All perimeter existing information indicated taken from survey.
 4. All work to be done in conformance with the 2012 Ontario Building Code (O.B.C., as amended)

OBC CLASSIFICATION

Group C, Residential Occupancy, 4 Storey, Part 3.2.2.45, Part 9.10.4, Building is Sprinklered, Standpipe is required

 

- GENERAL NOTES
1. THE APPLICANT WILL BE RESPONSIBLE FOR THE COST OF ANY UTILITY RELOCATIONS NECESSITATED BY THE SITE PLAN.
 2. ALL ENTRANCES, WALKWAYS, RAMPS, CURB CUTS, ETC. HAVE FLUSH THRESHOLDS AND/ OR CAN BE ACCESSIBLE BY A LOCATED PERSONS ACCESS (O.B.C. 2006 SECTION 9.8).
 3. ALL EXCESS EXCAVATED MATERIAL WILL BE REMOVED FROM THE SITE.
 4. AT ENTRANCES TO THE SITE, THE MUNICIPAL CURB AND SIDEWALK WILL BE CONTINUOUS THROUGHOUT THE DRIVEWAY AND CURB DEPRESSION WILL BE PROVIDED FOR EACH ENTRANCE.
 5. IF THE FINAL COURSE OF THE DRIVEWAY ASPHALT PAVING IS DELAYED, INSTALL A TEMPORARY LIFT OF ASPHALT AT RAMPS OR CURB CUTS TO PROVIDE BARRIER-FREE ACCESS.
 6. ALL WORK TO BE DONE IN CONFORMANCE WITH THE 2012 ONTARIO BUILDING CODE (O.B.C. as amended).
 7. PRIOR TO ANY CONSTRUCTION TAKING PLACE, STRUCTURALLY CERTIFIED OVERHEAD HOARDING WITHIN THE RIGHT-OF-WAY AS SHOWN ON THE SITE PLAN (AS APPLICABLE) HANGING ADJACENT TO EXISTING PROPERTIES TO PROTECT FROM CONSTRUCTION ACTIVITY, AND ALL REQUIRED HOARDING IN ACCORDANCE WITH THE ONTARIO OCCUPATIONAL HEALTH AND SAFETY ACT AND REGULATIONS FOR CONSTRUCTION PROJECTS MUST BE ERECTED AND MAINTAINED THROUGHOUT ALL PHASES OF CONSTRUCTION.
 8. A LETTER IS REQUIRED FROM A PROFESSIONAL ENGINEER LICENSED BY PROFESSIONAL ENGINEER OF ONTARIO STATING THAT THE STRUCTURE BELOW CAN SAFELY SUPPORT A FULLY LOADED WASTE COLLECTION VEHICLE WEIGHING 25 TONNES.

SURVEY INFORMATION

PLAN OF SUBDIVISION OF ALL OF BLOCKS 186, 187, 190 AND 191 AND PART OF BLOCK 188 REGISTERED PLAN 43M-1709 AND PART OF LOT 5, CONCESSION 9, NORTHERN DIVISION

(CONVEYOR OF THIRD-CORNER COURT OF PEEL)



CITY OF BRAMPTON REGIONAL MUNICIPALITY OF PEEL

Schaeffer Dzialdov Bennet Limited
64 Jardin Drive
Concord, Ontario L4K 3P3
Ph: (416) 987-0101 Fax: 905-761-0119

CLIENT INFORMATION

FORETSIDE ESTATES INC.
3550 LANGSTAFF RD, SUITE 200
WOODBIDGE, ON L4L 9G3

Ph: 905-856-2150
Email: m.papco@royalpinehomes.com

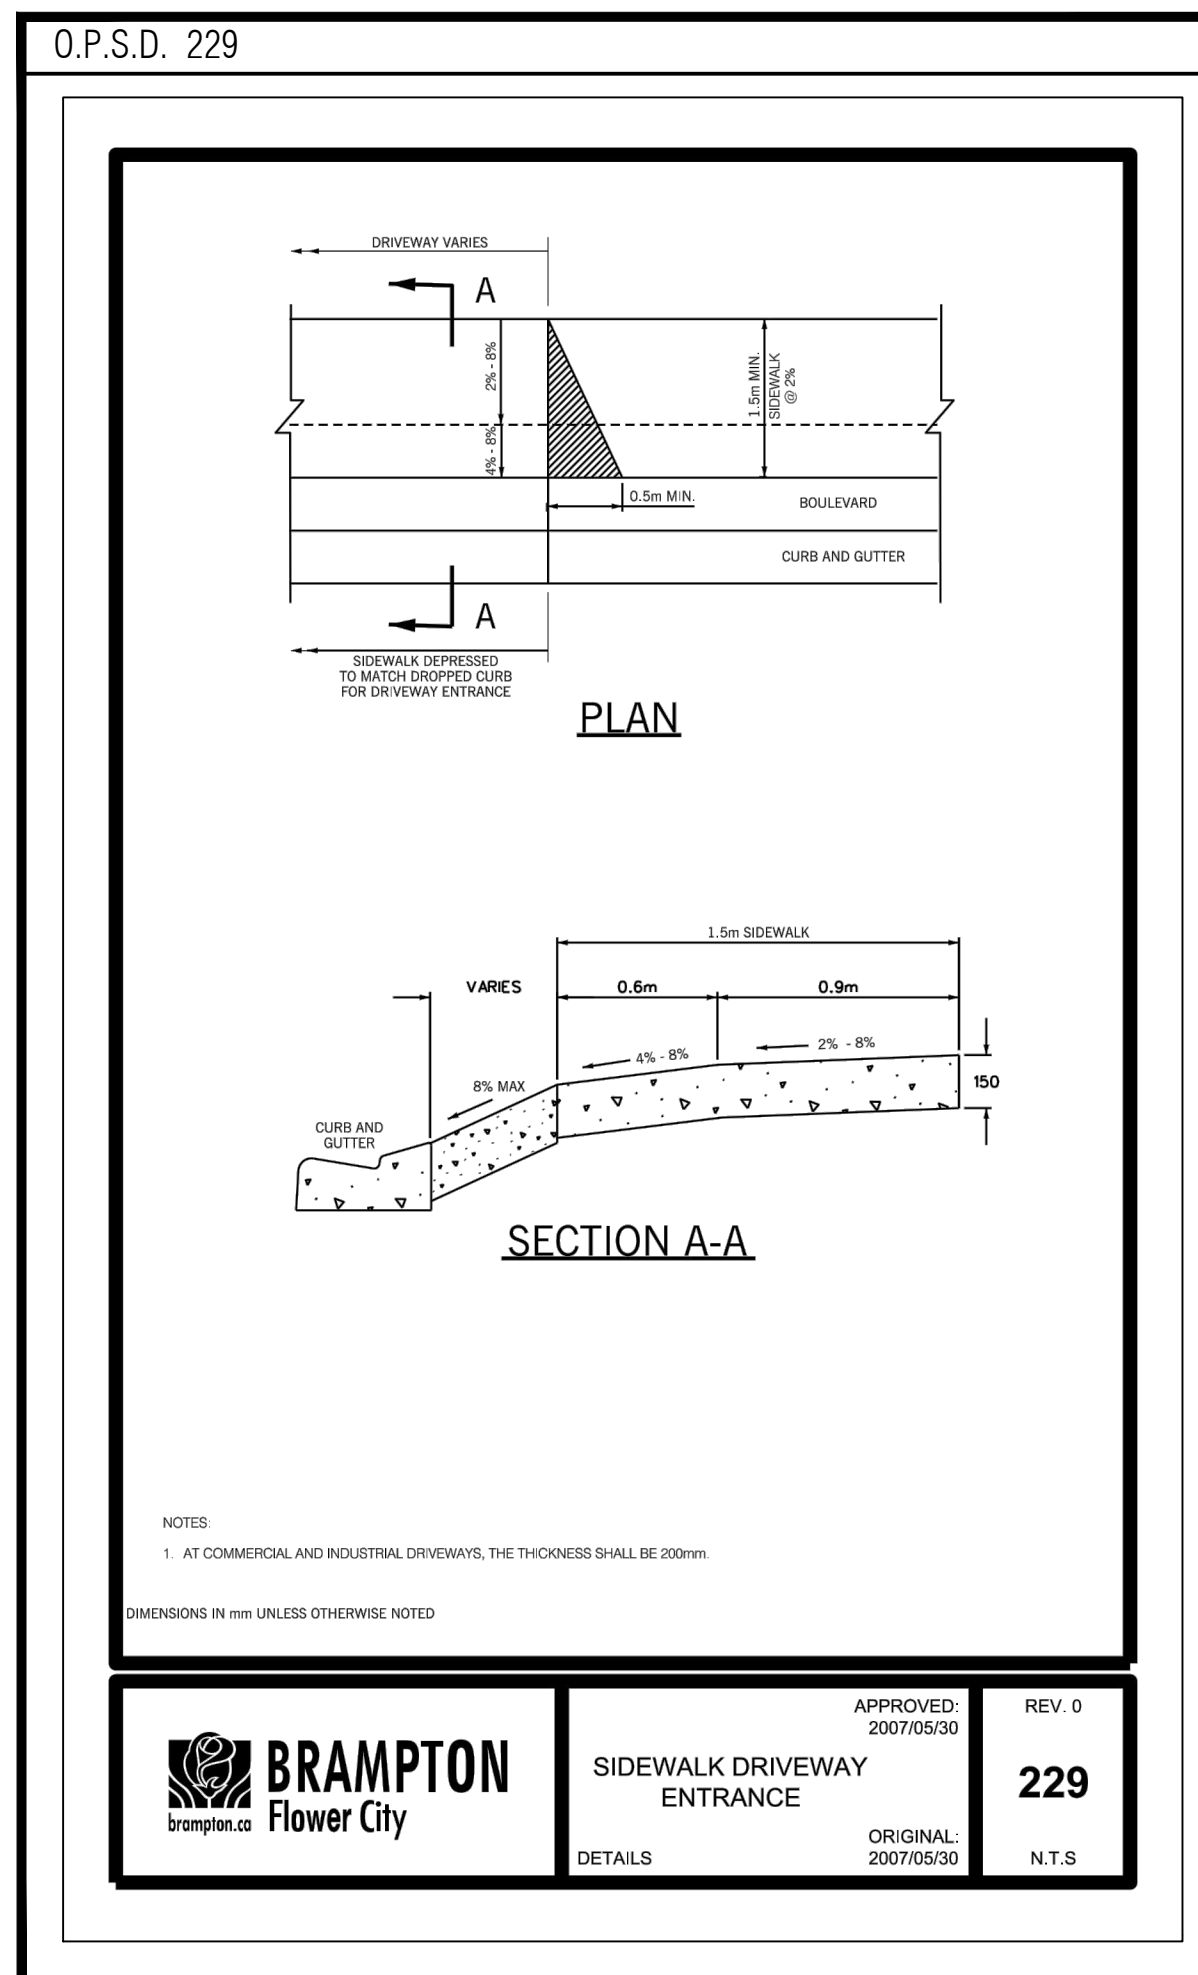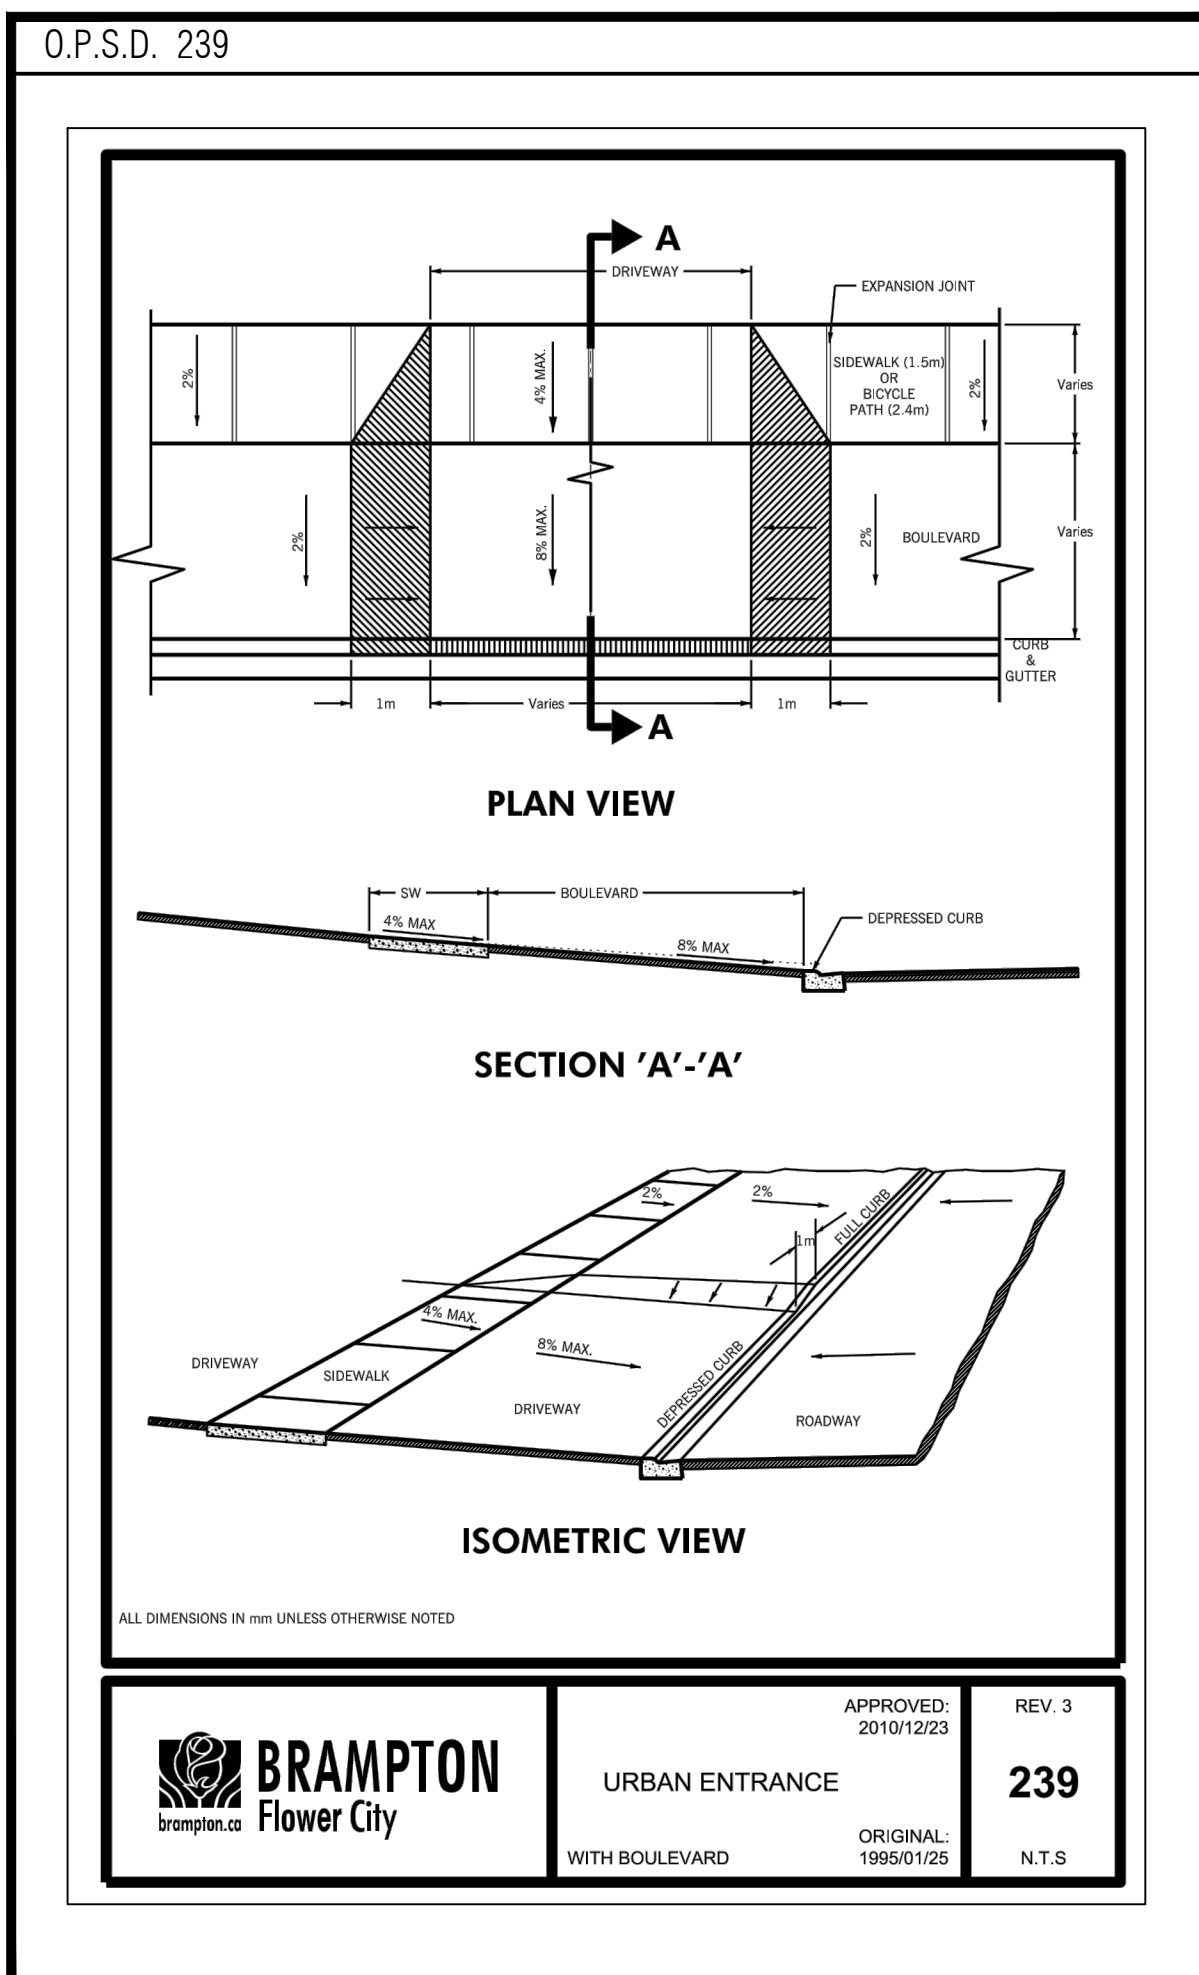


FILE NUMBER AND MUNICIPAL ADDRESS

SP18-118.000
ATTMAR & PALLESCHI DRIVE
BRAMPTON, ONTARIO
XXX-XXX

LIST OF DRAWINGS

A100	COVER SHEET
A101	LEGEND PLAN
A102	LEGENDS & SCHEDULES (WALL TYPES)
A103	LEGENDS & SCHEDULES (DOOR TYPES)
A104	FIRE SEPARATION PLAN - FIRST FLOOR
A105	FIRE SEPARATION PLAN - SECOND FLOOR
A106	FIRE SEPARATION PLAN - THIRD FLOOR
A107	FIRE SEPARATION PLAN - FOURTH FLOOR

01. Aug.02.2019 issued for tender

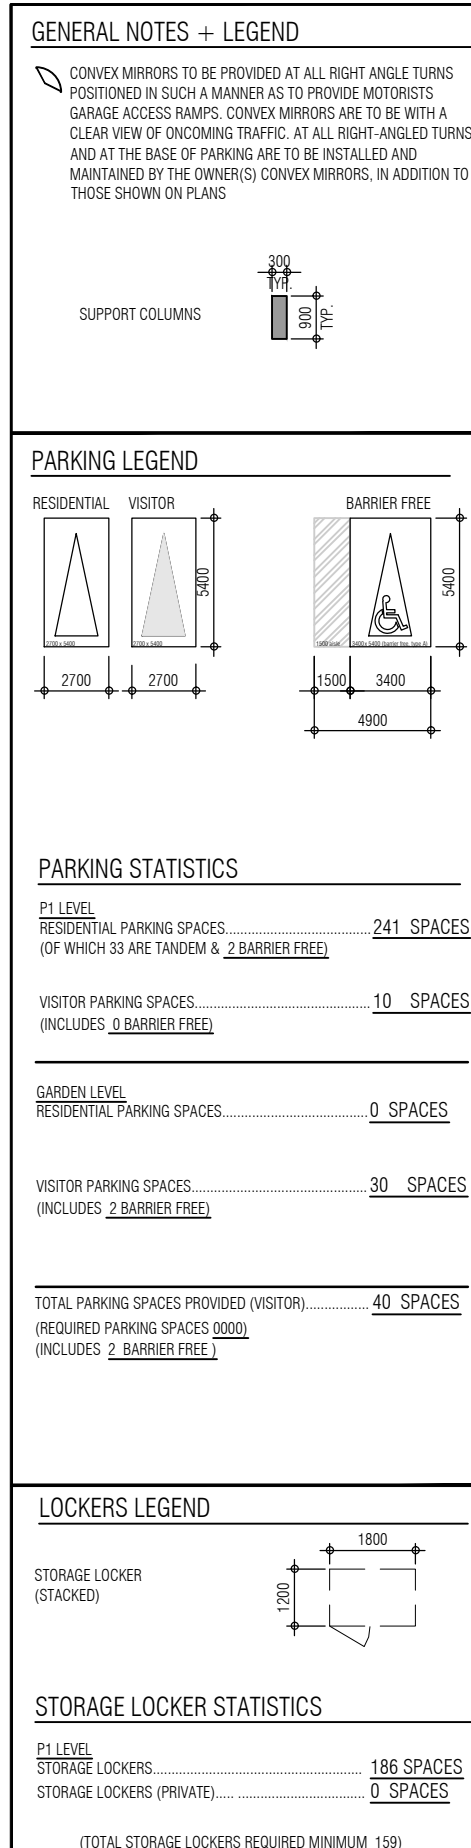

issued for revision




PROJECT ARCHITECT:	B. GRAZIANI
ASSISTANT DESIGNER:	R. LINCOLN
DRAWN BY:	F. C./M.B.
CHECKED BY:	D. BIASE/G. COLANGELO
PLOT DATE:	SEP. 18. 2019
JOB #	1331.15



1:200

A211

TITLEBLOCK SIZE: 915 x 120

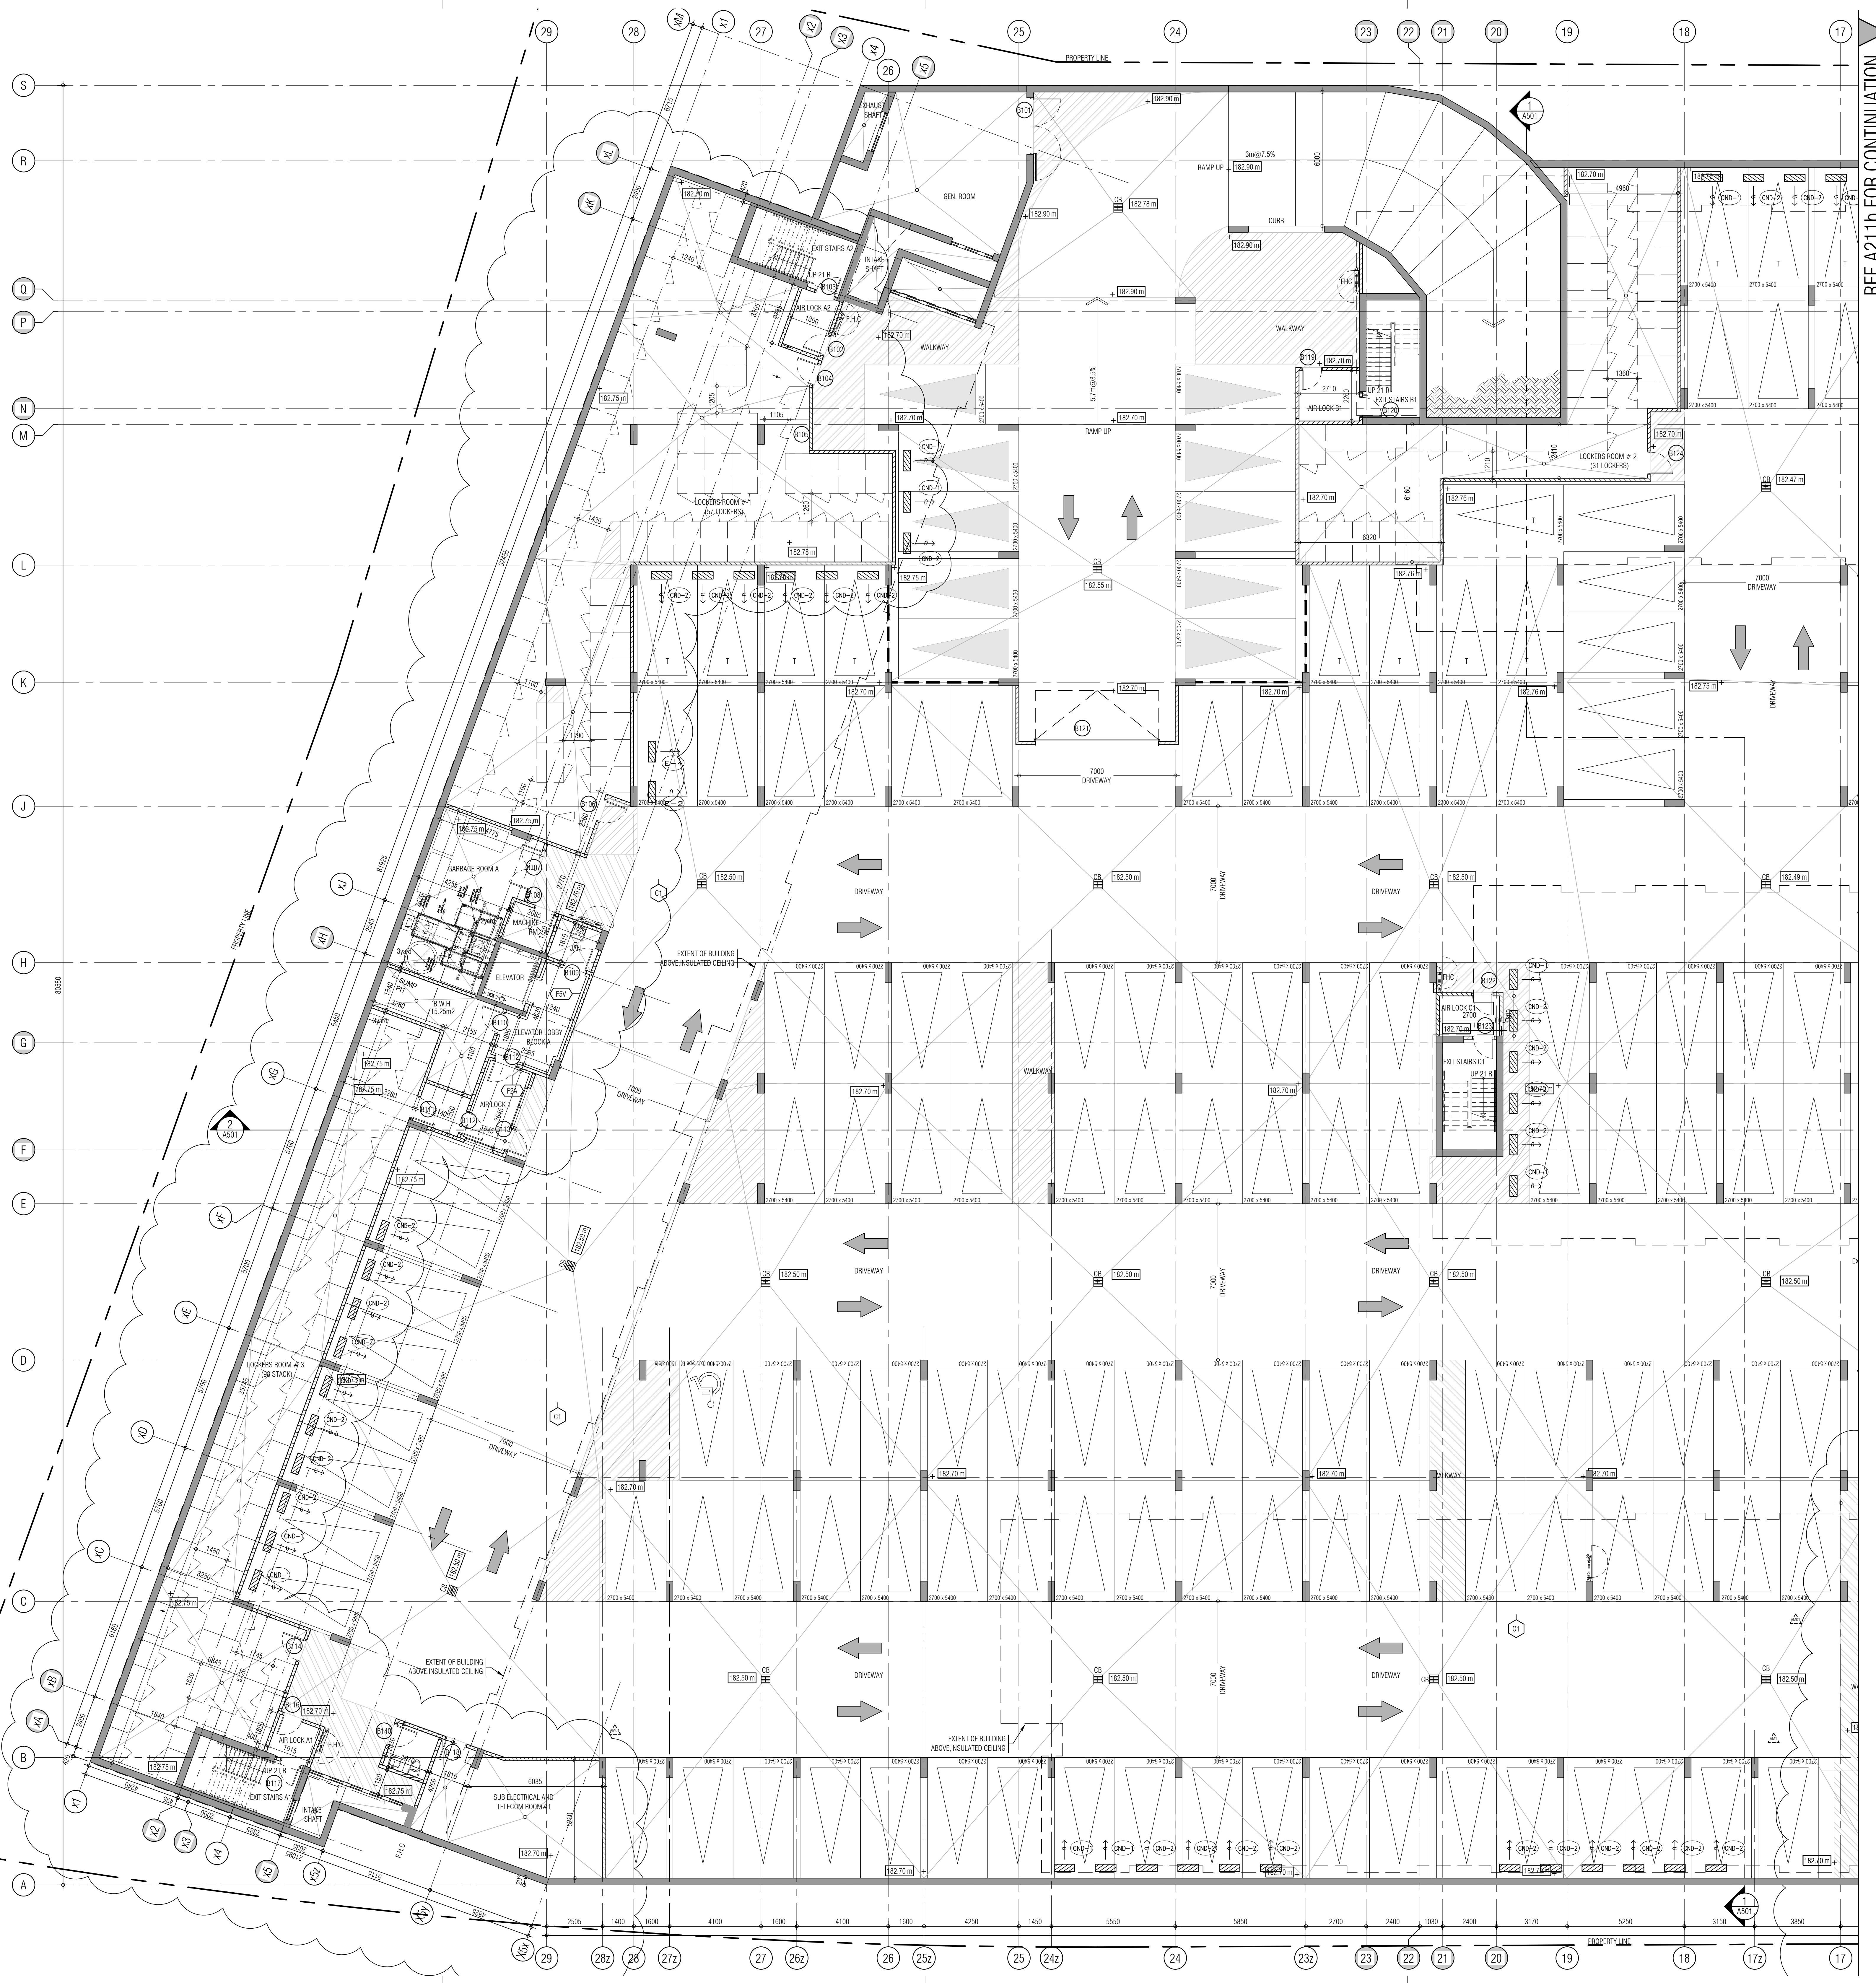

REF. A211b FOR CONTINUATION

THIS DRAWING, AS AN INSTRUMENT OF SERVICE, IS PROVIDED BY AND IS THE PROPERTY OF GRAZIAZI-CORAZZANI ARCHITECTS INC. THE CONTRACTOR MUST VERIFY AND ACCEPT RESPONSIBILITY FOR ALL DIMENSIONS AND CONDITIONS ON SITE AND MUST KEEP GRAZIAZI-CORAZZANI ARCHITECTS INC. OF ANY VARIATIONS FROM THE SUPPLIED INFORMATION. GRAZIAZI-CORAZZANI ARCHITECTS INC. IS NOT RESPONSIBLE FOR THE ACCURACY OF SURVEY, STRUCTURAL, MECHANICAL, ELECTRICAL, AND OTHER ENGINEERING INFORMATION SHOWN ON THIS DRAWING. HEREIN TO THE APPROPRIATE ENGINEERING DRAWING BEFORE PROCEEDING WITH THE WORK. CONSTRUCTION MUST CONFORM TO ALL APPLICABLE CODES AND REQUIREMENTS OF THE APPLICABLE ENGINEERING, ARCHITECTURAL, AND SURVEYING. NO MODIFICATION HAS BEEN MADE OR CHANGED TO THE ORIGINAL DRAWING. THIS SPECIFIC IN REGARD TO THE DIMENSIONAL, CONDITION OF THIS SITE.

THIS DRAWING IS NOT TO BE SCALED. ALL ARCHITECTURAL SYMBOLS INDICATED ON THIS DRAWING ARE GRAPHIC REPRESENTATIONS ONLY.

CONSENT FOR ELECTRONIC INFORMATION TRANSFER:

ELECTRONIC INFORMATION IS SUPPLIED TO THE OTHER ASSOCIATED FIRMS TO ASSIST THEM IN THE EXECUTION OF THEIR WORK. REVERA THE RECEIPT FIRMS MUST EXAMINE THE COMPLETENESS APPROPRIATE RELEVANCE OF THE INFORMATION IN RESPECT TO THEIR PARTICULAR RESPONSIBILITY.

GRAZIAZI-CORAZZANI ARCHITECTS INC. SHALL NOT BE RESPONSIBLE FOR:

1. ERRORS, OMISSIONS, INADEQUACIES DUE TO LOSS OF INFORMATION IN WHOLE OR PART WHEN INFORMATION IS TRANSMITTED.

2. TRANSMISSION OF ANY INFO OR CHANGE TO THE RECEIVING ELECTRONIC SYSTEM WHEN INFORMATION IS TRANSMITTED.

01. Aug.02.2019 issued for tender

GENERAL NOTES + LEGEND

COVER MEMBERS TO BE PROVIDED AT ALL RIGHT ANGLE CORNERS AND INTERSECTIONS AS SHOWN IN SECTION DETAIL.

COVER ACCESS MEMBERS COVER MEMBERS ARE TO BE WITH A COVER FIVE (5) MINIMUM THICKNESS AT ALL RIGHT ANGLE CORNERS AND INTERSECTIONS.

THE COVER FIVE (5) MINIMUM THICKNESS IS TO BE MAINTAINED BY THE TENDER. COVER APPROVAL IS REQUIRED TO THESE POINTS IN PLAN.

SUPPORT COLUMN

PARKING LEGEND

PARKING STATISTICS

TYPE	QUANTITY
STANDARD PARKING SPACES	241 SPACES

LOCKERS LEGEND

STORAGE LOCKER STATISTICS

TYPE	QUANTITY
STANDARD LOCKERS	18 SPACES
STANDARD LOCKERS (EXCLUDING 18 SPACES)	0 SPACES
TOTAL STORAGE LOCKERS PROVIDED (TOTAL)	18 SPACES

01. SEP.18.2019 issued for Adendum 1

issued for revisions



BRAMPTON

PROJECT ARCHITECT: B. GRAZIANI

ASSISTANT DESIGNER: F. LINCOLN

DRAWN BY: F. LINCOLN

CHECKED BY: D. BIAISE (G. COLANGELO)

JOB DATE: SEP.18.2019

PROJECT #1331.15

P1 UNDERGROUND PLAN

(ENLARGE PLAN)

1:100

A211a

TITLE BLOCK SIZE: 915 x 1200

[illegible]

01. Aug.02.2019 issued for tender

[illegible]

01. SEP 18, 2019 Issued for Addendum 1
issued for revisions



ATTMAR + PALLESCI DRIVE		ONTARIO
BRAMPTON		
PROJECT ARCHITECT:	B. GRAZIANI	
ASSISTANT DESIGNER:	R. LINCOLN	
DRAWN BY:	F.C./M.B.	
CHECKED BY:	D. BIASE/G. COLANGELO	
PLOT DATE:	SEP. 18. 2019	
JOB #	1331.15	

P1 UNDERGROUND PLAN
(ENLARGE PLAN)

 1:100 **A211b**

TITLEBLOCK SIZE: 915 x 1200

THIS DRAWING, AS AN INSTRUMENT OF SERVICE, IS PROVIDED BY AND IS THE PROPERTY OF GRAZIANI-CORAZZA ARCHITECTS INC. THE CONTRACTOR MUST VERIFY AND ACCEPT RESPONSIBILITY FOR ALL DIMENSIONS AND CONDITIONS ON SITE AND MUST KEEP GRAZIANI-CORAZZA ARCHITECTS INC. OF ANY VARIATIONS FROM THE SUPPLIED INFORMATION. GRAZIANI-CORAZZA ARCHITECTS INC. IS NOT RESPONSIBLE FOR THE ACCURACY OF SURVEY, STRUCTURAL, MECHANICAL, ELECTRICAL, AND OTHER ENGINEERING INFORMATION SHOWN ON THIS DRAWING. REFER TO THE APPROPRIATE ENGINEERING DRAWINGS BEFORE PROCEEDING WITH THE WORK. CONSTRUCTION MUST CONFORM TO ALL APPLICABLE CODES AND REQUIREMENTS OF THE AUTHORITIES HAVING JURISDICTION. DURING CONSTRUCTION, NO INVESTIGATION HAS BEEN UNDERTAKEN OR REPORTED ON BY THE OFFICE IN RELATION TO THE ENVIRONMENTAL CONDITION OF THIS SITE. THIS DRAWING IS NOT TO BE SCALED. ALL ARCHITECTURAL SYMBOLS INDICATED ON THIS DRAWING ARE GRAPHIC REPRESENTATIONS ONLY.

CONDITIONS FOR ELECTRONIC INFORMATION TRANSFER:


ELECTRONIC INFORMATION IS SUPPLIED TO THE OTHER ASSOCIATED PARTS TO ASSIST THEM IN THE EXECUTION OF THEIR WORK. REVIEW THE RECEIVED PARTS MUST DETERMINE THE COMPLETENESS, APPROPRIATENESS, RELEVANCE OF THE INFORMATION IN RESPECT TO THEIR PARTICULAR RESPONSIBILITY.

1. ENGINEERING INFORMATION: ENGINEERS ARE NOT RESPONSIBLE FOR THE INFORMATION IN THIS DRAWING. 

2. TRANSMISSION OF ANY INFO OR CHANGE TO THE RECEIVING ELECTRONIC SYSTEM WHEN INFORMATION IS TRANSFERRED.

01. Aug 02, 2019 Issued for tender

REF. A301a2 FOR CONTINUATION

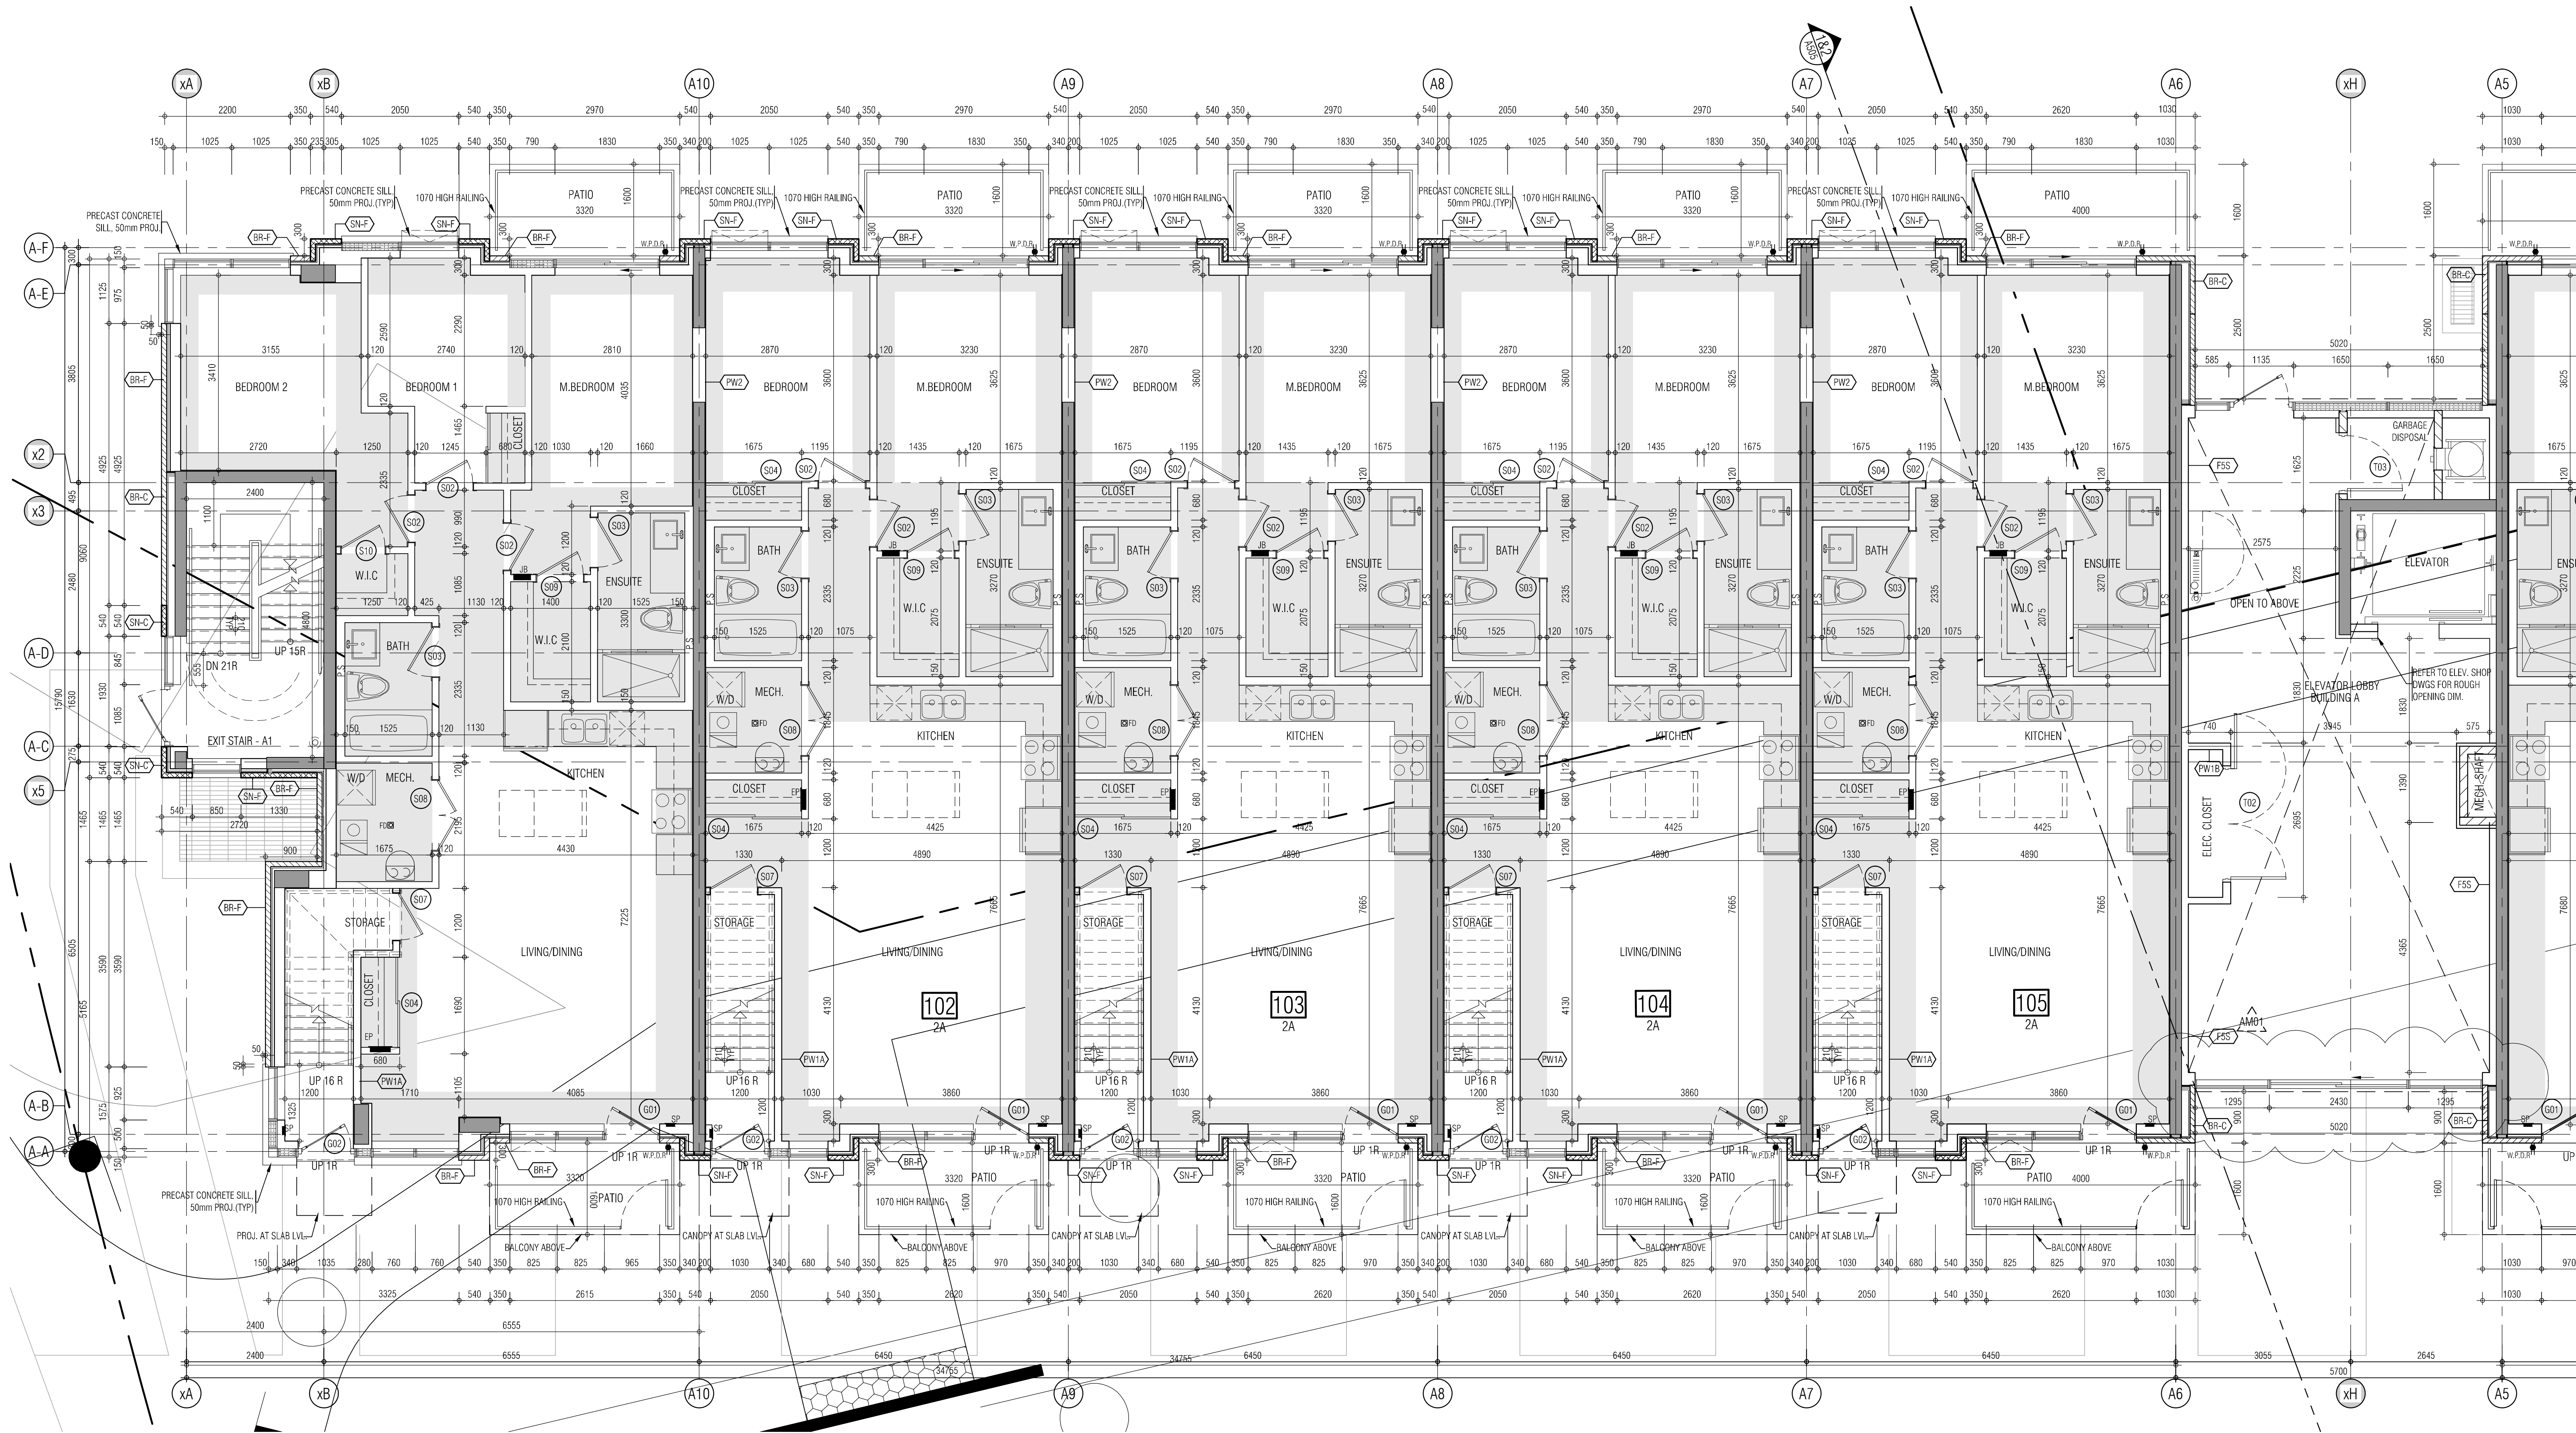

01. SEP 18, 2019 Issued for Addendum 1

Issued for revisions:

+

**GRAZIANI
CORAZZA
ARCHITECTS**


ATTIMAR + PALLESCHI DRIVE ONTARIO

PROJECT ARCHITECT: B. GRAZIANI
ASSISTANT DESIGNER: R. LINCOLN
DRAWN BY: F.C./M.B.
CHECKED BY: D. BIASI (G. COLANGELO)
PLOT DATE: SEP 18, 2019
JOB #: 1331.15

**GROUND FLOOR PLAN
BUILDING A (PARTIAL PLAN)**

1:50 A-301a1

TITLE BLOCK SIZE: 915 x 1200

THIS DRAWING, AS AN INSTRUMENT OF SERVICE, IS PROVIDED BY AND IS THE PROPERTY OF GRAZIANI-CORAZZANI ARCHITECTS INC. THE CONTRACTOR MUST VERIFY AND ACCEPT RESPONSIBILITY FOR ALL DIMENSIONS AND CONDITIONS ON SITE AND MUST KEEP GRAZIANI-CORAZZANI ARCHITECTS INC. OF ANY VARIATIONS FROM THE SUPPLIED INFORMATION. GRAZIANI-CORAZZANI ARCHITECTS INC. IS NOT RESPONSIBLE FOR THE ACCURACY OF SURVEY, STRUCTURAL, MECHANICAL, ELECTRICAL, AND OTHER ENGINEERING INFORMATION SHOWN ON THIS DRAWING. REFER TO THE APPROPRIATE ENGINEERING DRAWINGS BEFORE PROCEEDING WITH THE WORK. CONSTRUCTION MUST CONFORM TO ALL APPLICABLE CODES AND REQUIREMENTS OF THE AUTHORITIES HAVING JURISDICTION. DURING CONSTRUCTION, NO INVESTIGATION HAS BEEN UNDERTAKEN OR REPORTED ON BY THE OFFICE IN RELATION TO THE ENVIRONMENTAL CONDITION OF THIS SITE.

THIS DRAWING IS NOT TO BE SCALED. ALL ARCHITECTURAL SYMBOLS INDICATED ON THIS DRAWING ARE GRAPHIC REPRESENTATIONS ONLY.

CONDITIONS FOR ELECTRONIC INFORMATION TRANSFER:


ELECTRONIC INFORMATION IS SUPPLIED TO THE OTHER ASSOCIATED FRAMES TO ASSIST THEM IN THE EXECUTION OF THEIR WORK. REVIEW THE RECEIPT FRAMES MUST DETERMINE THE COMPLETENESS APPROPRIATENESS RELEVANCE OF THE INFORMATION IN RESPECT TO THEIR PARTICULAR RESPONSIBILITY.

1. OTHER ENGINEERING INFORMATION DUE TO USE OF INFORMATION IN WHOLE OR PART WHEN INFORMATION IS TRANSFERRED.

2. TRANSMISSION OF ANY INFO OR CHANGE TO THE RECEIVING ELECTRONIC SYSTEM WHEN INFORMATION IS TRANSFERRED.

01. Aug.02.2019 Issued for tender

REF.A301b2 FOR CONTINUATION

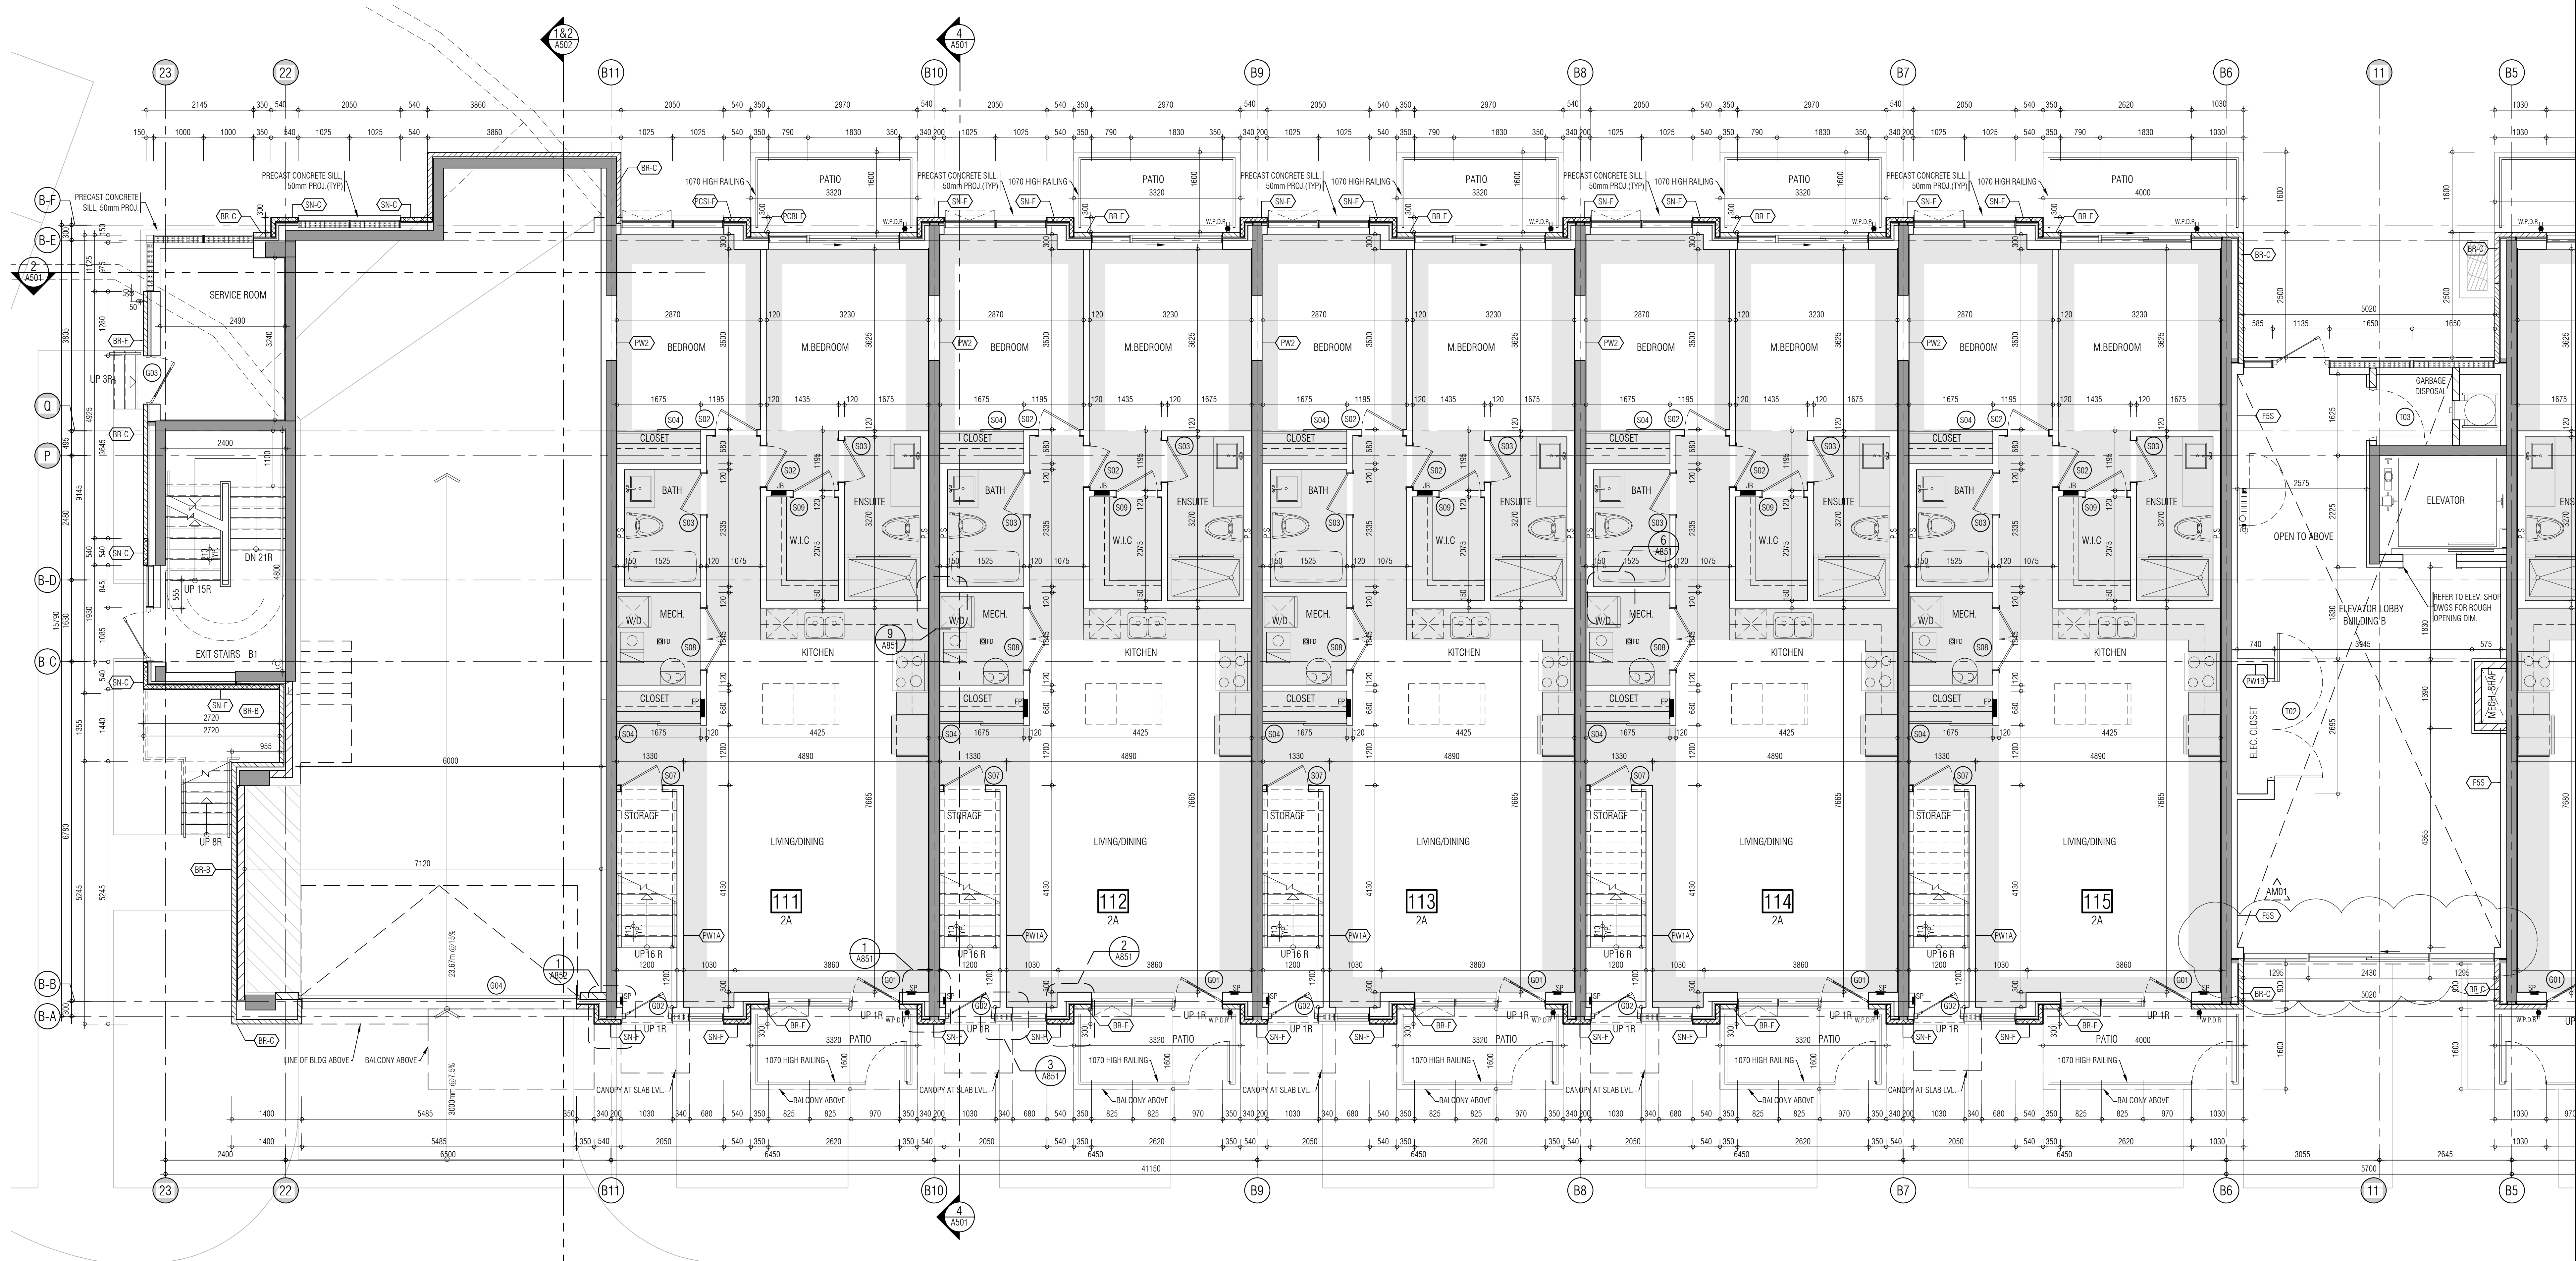

01. SEP.18.2019 Issued for Addendum 1

Issued for revisions:

+

**GRAZIANI
CORAZZANI
ARCHITECTS**

1000 SHEPPARD AVENUE, SUITE 100 MISSISSAUGA, ONTARIO L4W 1G1
TEL: 905.276.2600 FAX: 905.276.2644 WWW.GC-ARCHITECTS.COM

RESIDENTIAL



PROJECT ARCHITECT: B. GRAZIANI
ASSISTANT DESIGNER: R. LINCOLN
DRAWN BY: F.C./M.B.
CHECKED BY: D. BIASI (G. COLANGELO)
PLOT DATE: SEP.18.2019
JOB #: 1331.15

**GROUND FLOOR PLAN
BUILDING B (PARTIAL PLAN)**

1:50 A-301b1

TITLEBLOCK SIZE: 915 x 1200

REF.A301b1 FOR CONTINUATION

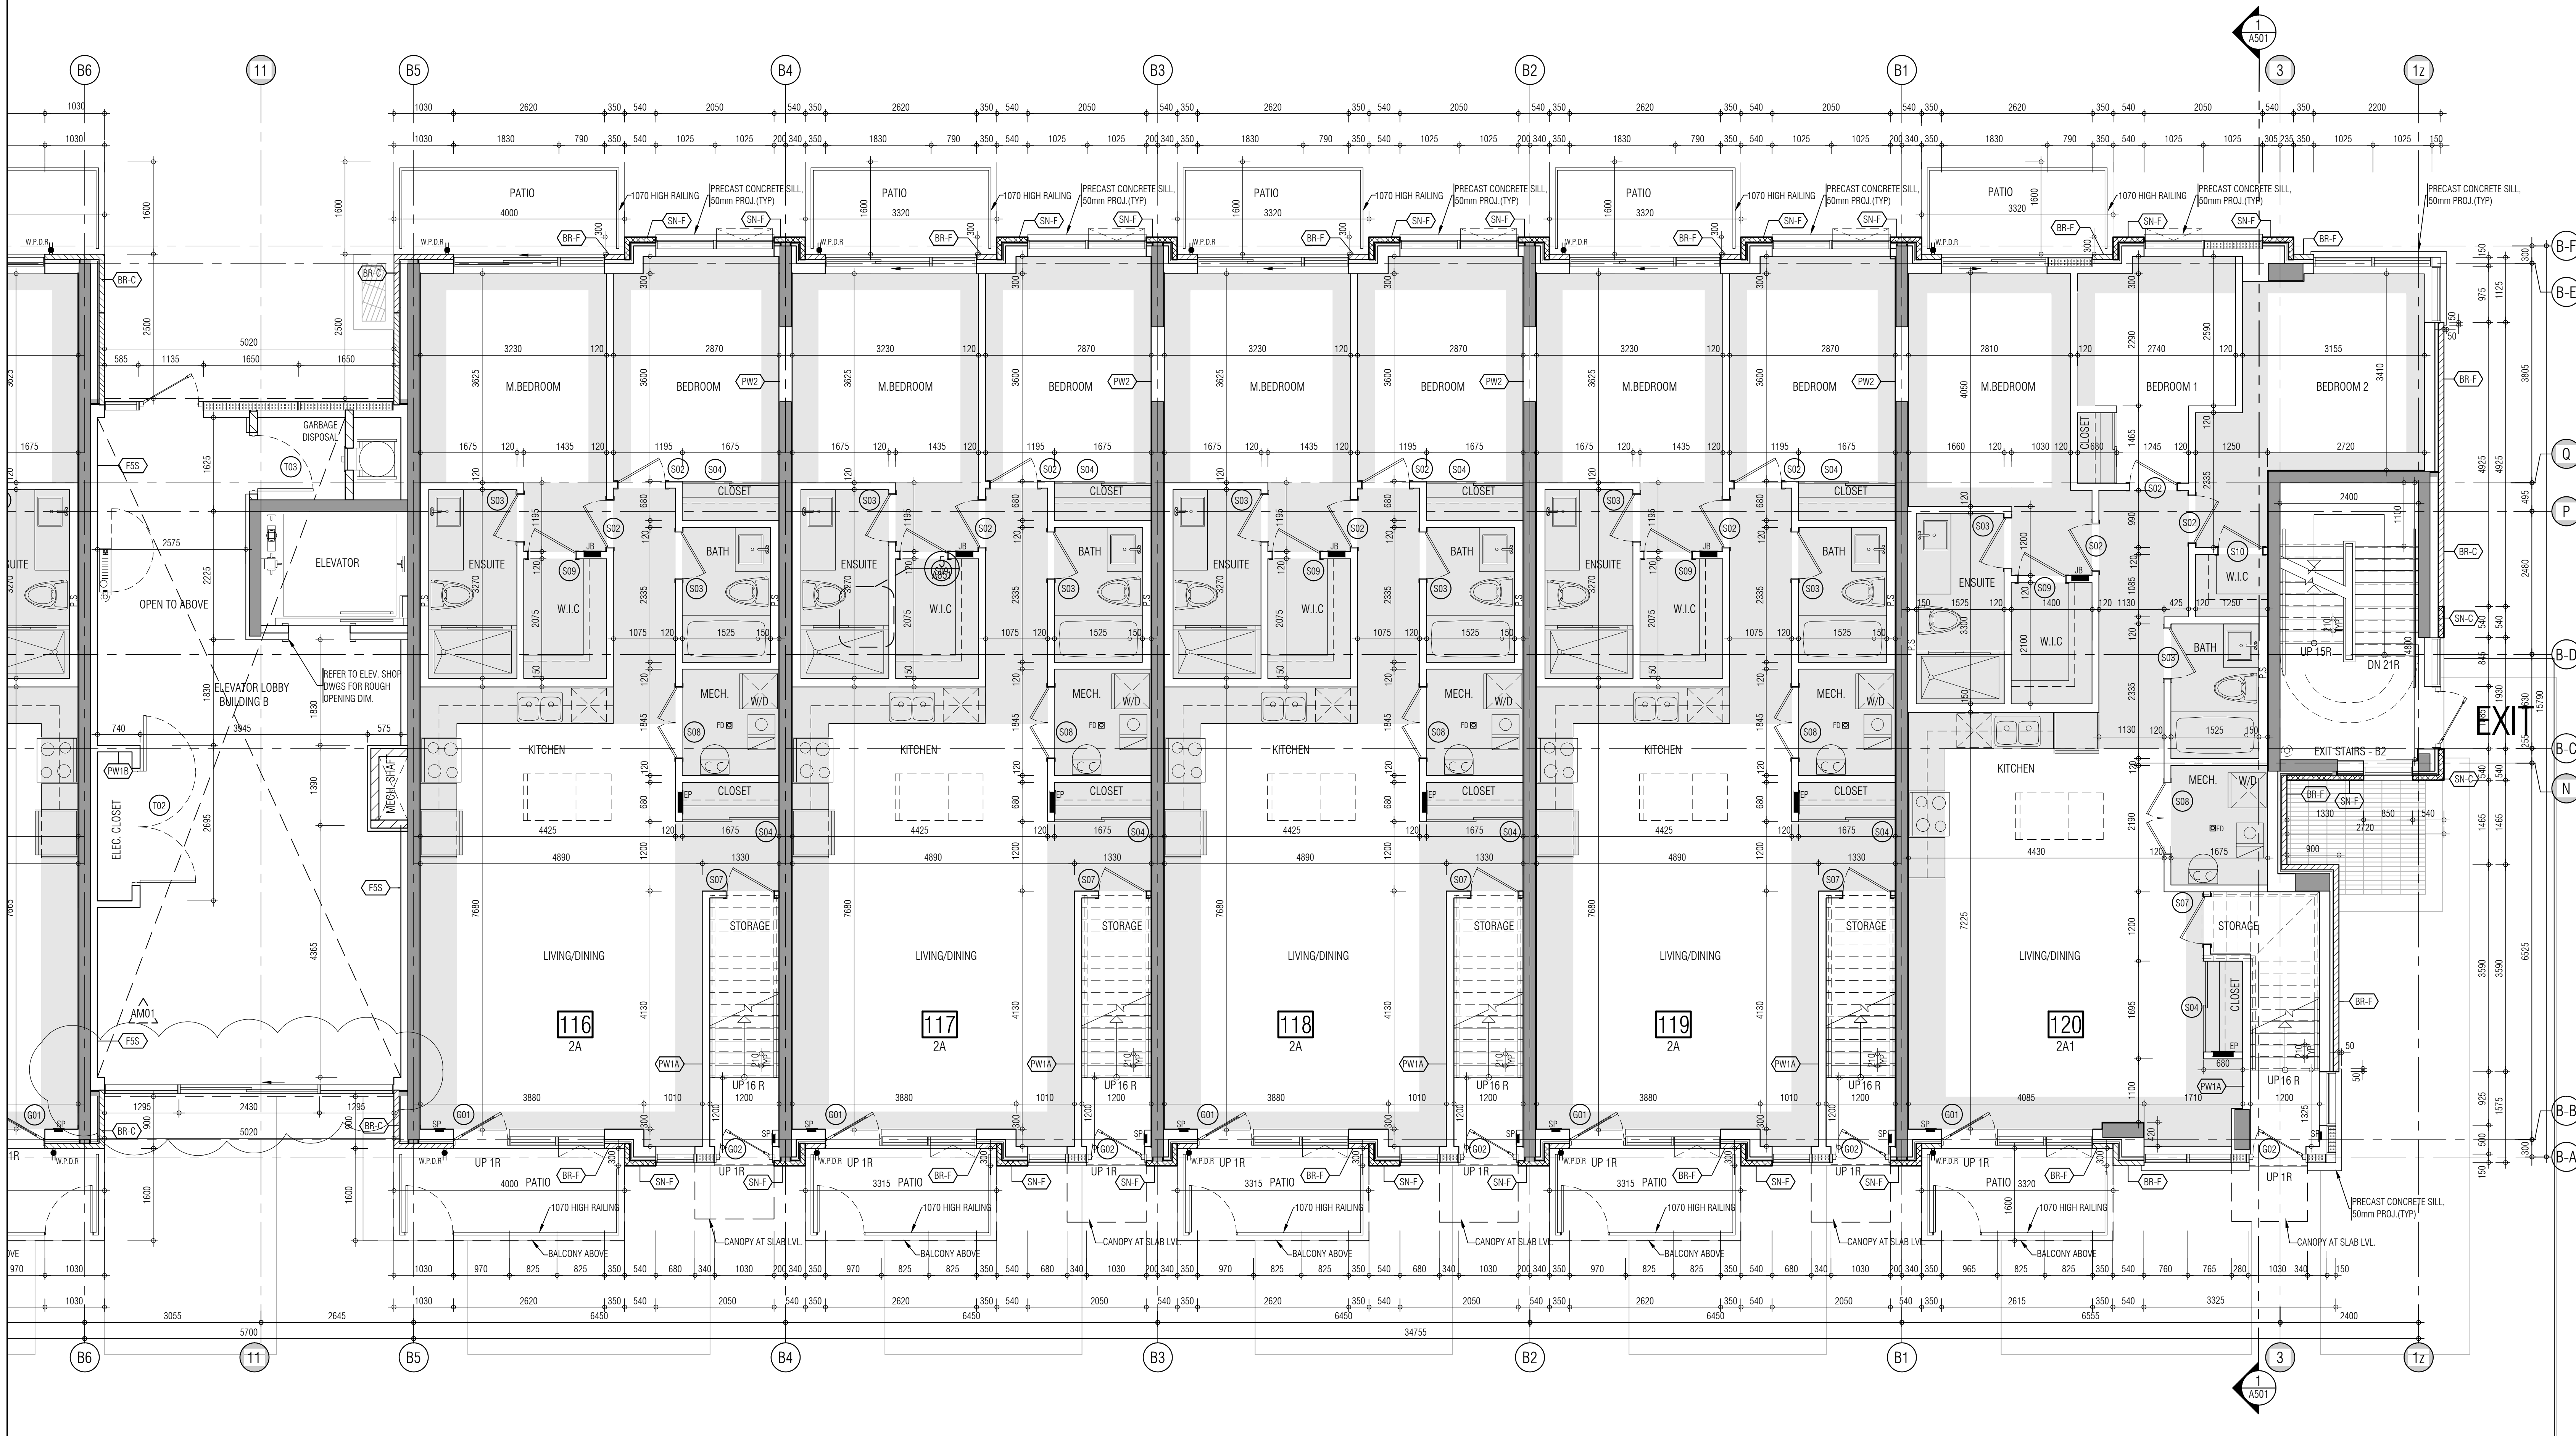

KEY PLAN



THIS DRAWING, AS AN INSTRUMENT OF SERVICE, IS PROVIDED BY AND IS THE PROPERTY OF GRAZIANI-CORAZZA ARCHITECTS INC. THE CONTRACTOR MUST VERIFY AND ACCEPT RESPONSIBILITY FOR ALL DIMENSIONS AND CONDITIONS ON SITE AND MUST KEEP GRAZIANI-CORAZZA ARCHITECTS INC. OF ANY VARIATIONS FROM THE SUPPLIED INFORMATION. GRAZIANI-CORAZZA ARCHITECTS INC. IS NOT RESPONSIBLE FOR THE ACCURACY OF SURVEY, STRUCTURAL, MECHANICAL, ELECTRICAL, AND OTHER ENGINEERING INFORMATION SHOWN ON THIS DRAWING. REFER TO THE APPROPRIATE ENGINEERING DRAWINGS BEFORE PROCEEDING WITH THE WORK. CONSTRUCTION MUST CONFORM TO ALL APPLICABLE CODES AND REQUIREMENTS OF THE AUTHORITIES HAVING JURISDICTION. ANALYSIS CONDUCTED BY THE ENGINEER HAS BEEN UNDERTAKEN ON THE BASIS OF THE INFORMATION PROVIDED BY THE CLIENT. NO INVESTIGATION HAS BEEN UNDERTAKEN OR REPORTED ON BY THE OFFICE IN RELATION TO THE ENVIRONMENTAL CONDITION OF THIS SITE.

THIS DRAWING IS NOT TO BE SCALED. ALL ARCHITECTURAL SYMBOLS INDICATED ON THIS DRAWING ARE GRAPHIC REPRESENTATIONS ONLY.

CONDITIONS FOR ELECTRONIC INFORMATION TRANSFER:

ELECTRONIC INFORMATION IS SUPPLIED TO THE OTHER ASSOCIATED PARTS TO ASSIST THEM IN THE EXECUTION OF THEIR WORK. REVIEW THE RECEIVED PARTS MUST DETERMINE THE COMPLETENESS, APPROPRIATENESS, RELEVANCE OF THE INFORMATION IN RESPECT TO THEIR PARTICULAR RESPONSIBILITY.

GRAZIANI-CORAZZA ARCHITECTS INC. SHALL NOT BE RESPONSIBLE FOR:

1. ERRORS, OMISSIONS, INADEQUACIES DUE TO LOSS OF INFORMATION IN WHOLE OR PART WHEN INFORMATION IS TRANSFERRED.
2. TRANSMISSION OF ANY LOSS OF CHANGE TO THE RECEIVING ELECTRONIC SYSTEM WHEN INFORMATION IS TRANSFERRED.

01. Aug.02.2019 Issued for tender

01. SEP.18.2019 Issued for Addendum 1

Issued for revisions:




PROJECT ARCHITECT: B. GRAZIANI
ASSISTANT ARCHITECT: R. LINCOLN
DRAWN BY: F.C./M.B.
CHECKED BY: D. BIASI (G. COLANGELO)
PLOT DATE: SEP.18.2019
JOB #: 1331.15

GROUND FLOOR PLAN
BUILDING B (PARTIAL PLAN)


1:50
A-301b2
TITLEDRAW SIZE: 915 x 1200

01. Aug.02.2019 issued for tender

01 SEP 18 2019 Issued for Addendum 1

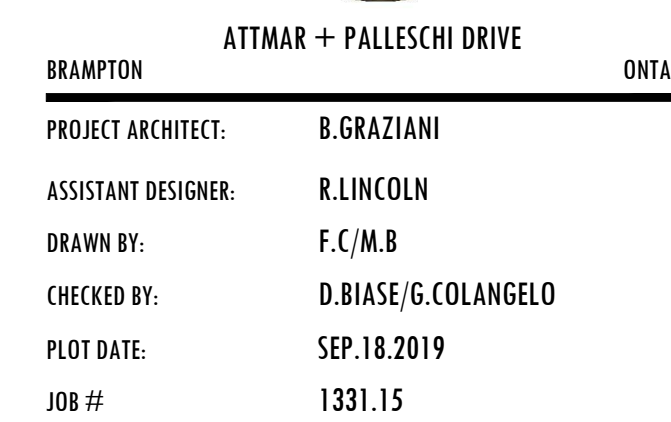


TITLEBLOCK SIZE: 915 x 120

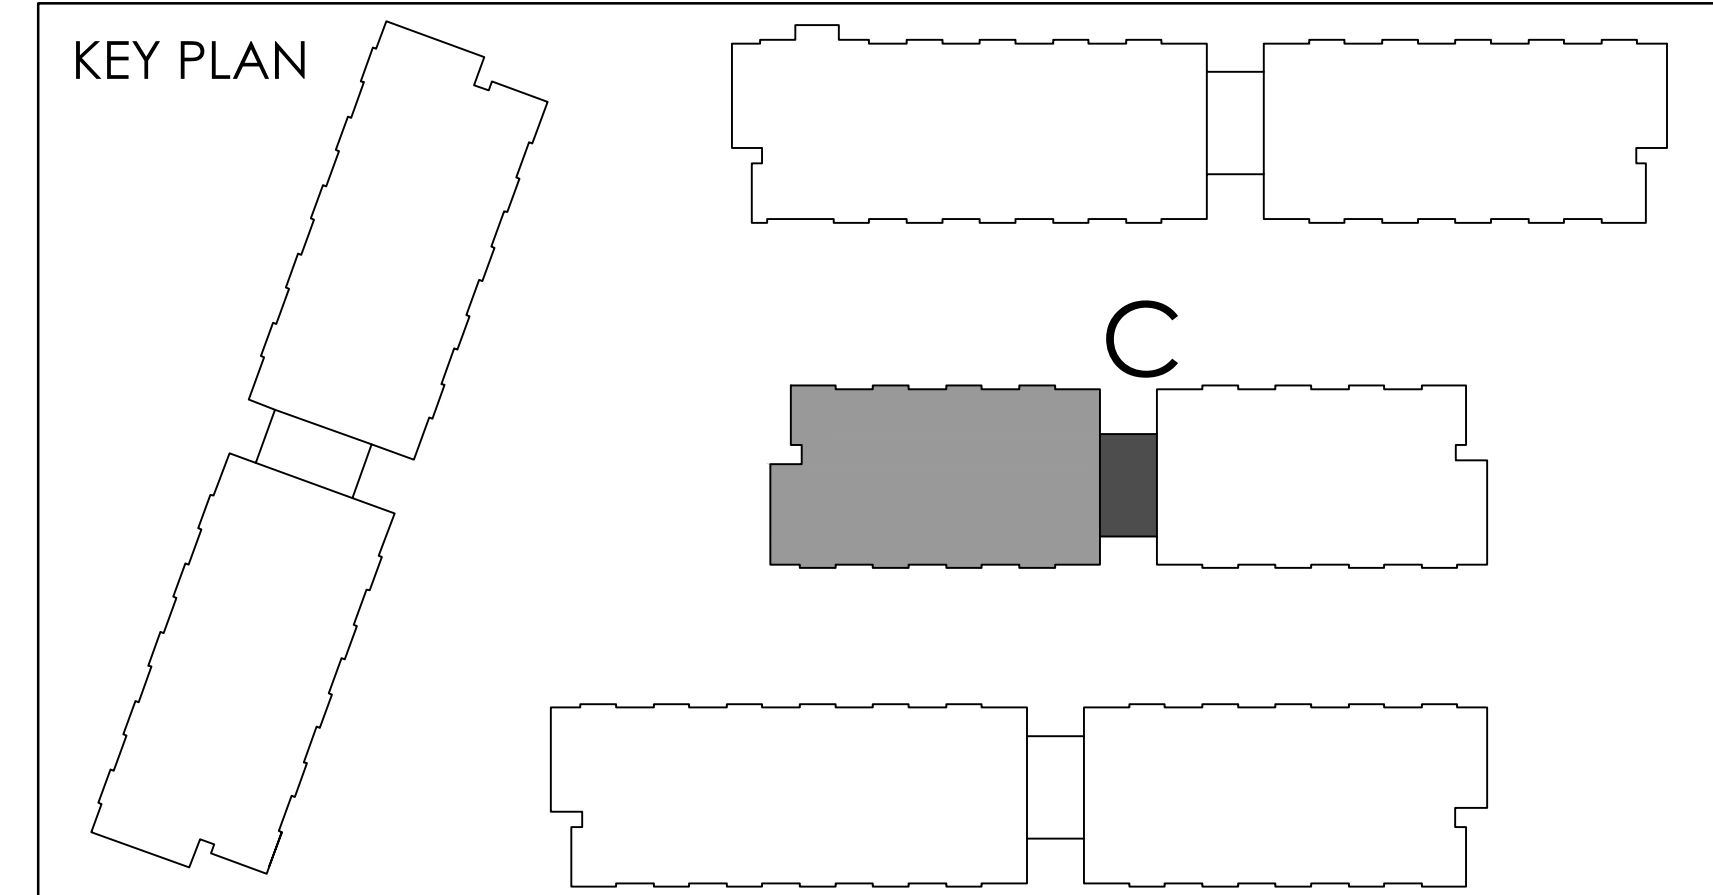

REF. A301c1 FOR CONTINUATION



KEY PLAN

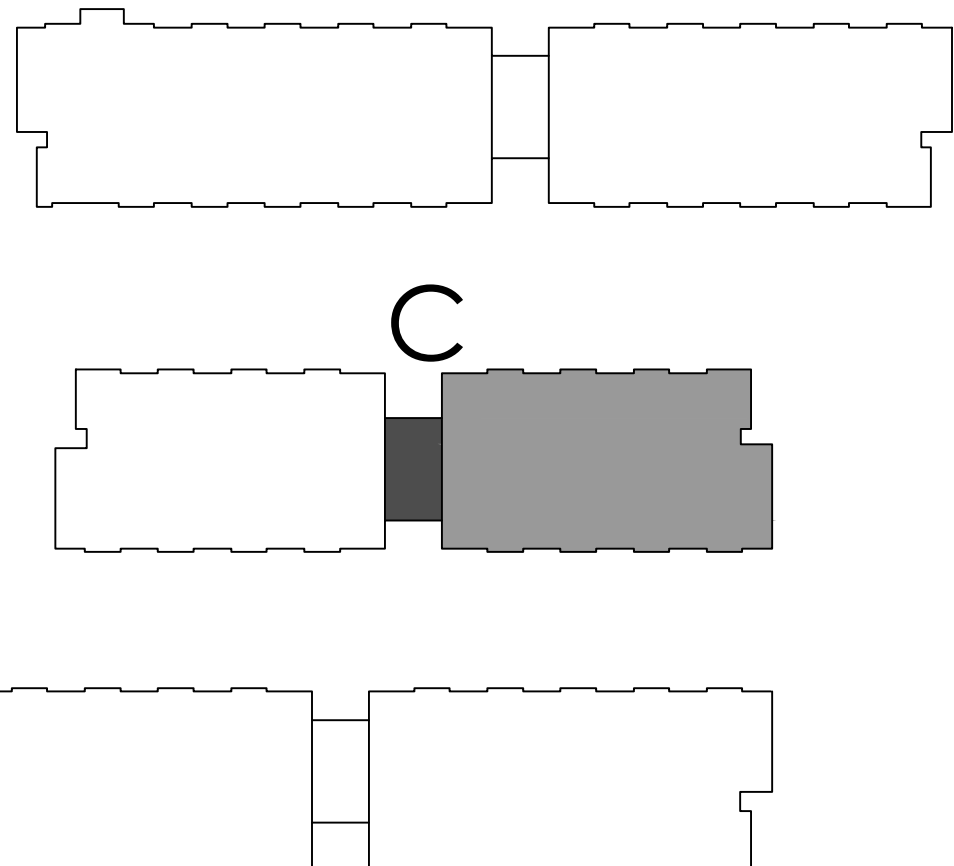

THIS DRAWING, AS AN INSTRUMENT OF SERVICE, IS PROVIDED BY AND IS THE PROPERTY OF GRAZIANI-CORAZZA ARCHITECTS INC. THE CONTRACTOR MUST VERIFY AND ACCEPT RESPONSIBILITY FOR ALL DIMENSIONS AND CONDITIONS ON SITE AND MUST KEEP GRAZIANI-CORAZZA ARCHITECTS INC. OF ANY VARIATIONS FROM THE SUPPLIED INFORMATION. GRAZIANI-CORAZZA ARCHITECTS INC. IS NOT RESPONSIBLE FOR THE ACCURACY OF SURVEY, STRUCTURAL, MECHANICAL, ELECTRICAL, AND OTHER ENGINEERING INFORMATION SHOWN ON THIS DRAWING. REFER TO THE APPROPRIATE ENGINEERING DRAWINGS BEFORE PROCEEDING WITH THE WORK. CONSTRUCTION MUST CONFORM TO ALL APPLICABLE CODES AND REQUIREMENTS OF THE AUTHORITIES HAVING JURISDICTION. ALWAYS CONSIDER THE LATEST REVISIONS. NO INVESTIGATION HAS BEEN UNDERTAKEN OR REPORTED ON BY THE OFFICE IN RELATION TO THE ENVIRONMENTAL CONDITION OF THIS SITE. THIS DRAWING IS NOT TO BE SCALED. ALL ARCHITECTURAL SYMBOLS INDICATED ON THIS DRAWING ARE GRAPHIC REPRESENTATIONS ONLY. CONDITIONS FOR ELECTRONIC INFORMATION TRANSFER: ELECTRONIC INFORMATION IS SUPPLIED TO THE OTHER ASSOCIATED FRAMES TO ASSIST THEM IN THE EXECUTION OF THEIR WORK. REVIEW THE RECEIPT FRAMES MUST DETERMINE THE COMPLETENESS, APPROPRIATENESS, RELEVANCE OF THE INFORMATION IN RESPECT TO THEIR PARTICULAR RESPONSIBILITY. GRAZIANI-CORAZZA ARCHITECTS INC. SHALL NOT BE RESPONSIBLE FOR: 1. ERRORS, OMISSIONS, INADEQUACIES DUE TO LOSS OF INFORMATION IN WHOLE OR PART WHEN INFORMATION IS TRANSFERRED. 2. TRANSMISSION OF ANY INFO OR CHANGE TO THE RECEIVING ELECTRONIC SYSTEM WHEN INFORMATION IS TRANSFERRED.

01. Aug.02.2019 Issued for tender

01. SEP.18.2019 Issued for Addendum 1



Issued for revisions



PROJECT ARCHITECT: B. GRAZIANI
ASSISTANT DESIGNER: R. LINCOLN
DRAWN BY: F.C./M.B.
CHECKED BY: D. BIASI (G. COLANGELO)
PLOT DATE: SEP.18.2019
JOB #: 1331.15

GROUND FLOOR PLAN
BUILDING C (PARTIAL PLAN)

1:50 A-301c2
TITLEDRAW SIZE: 915 x 1200

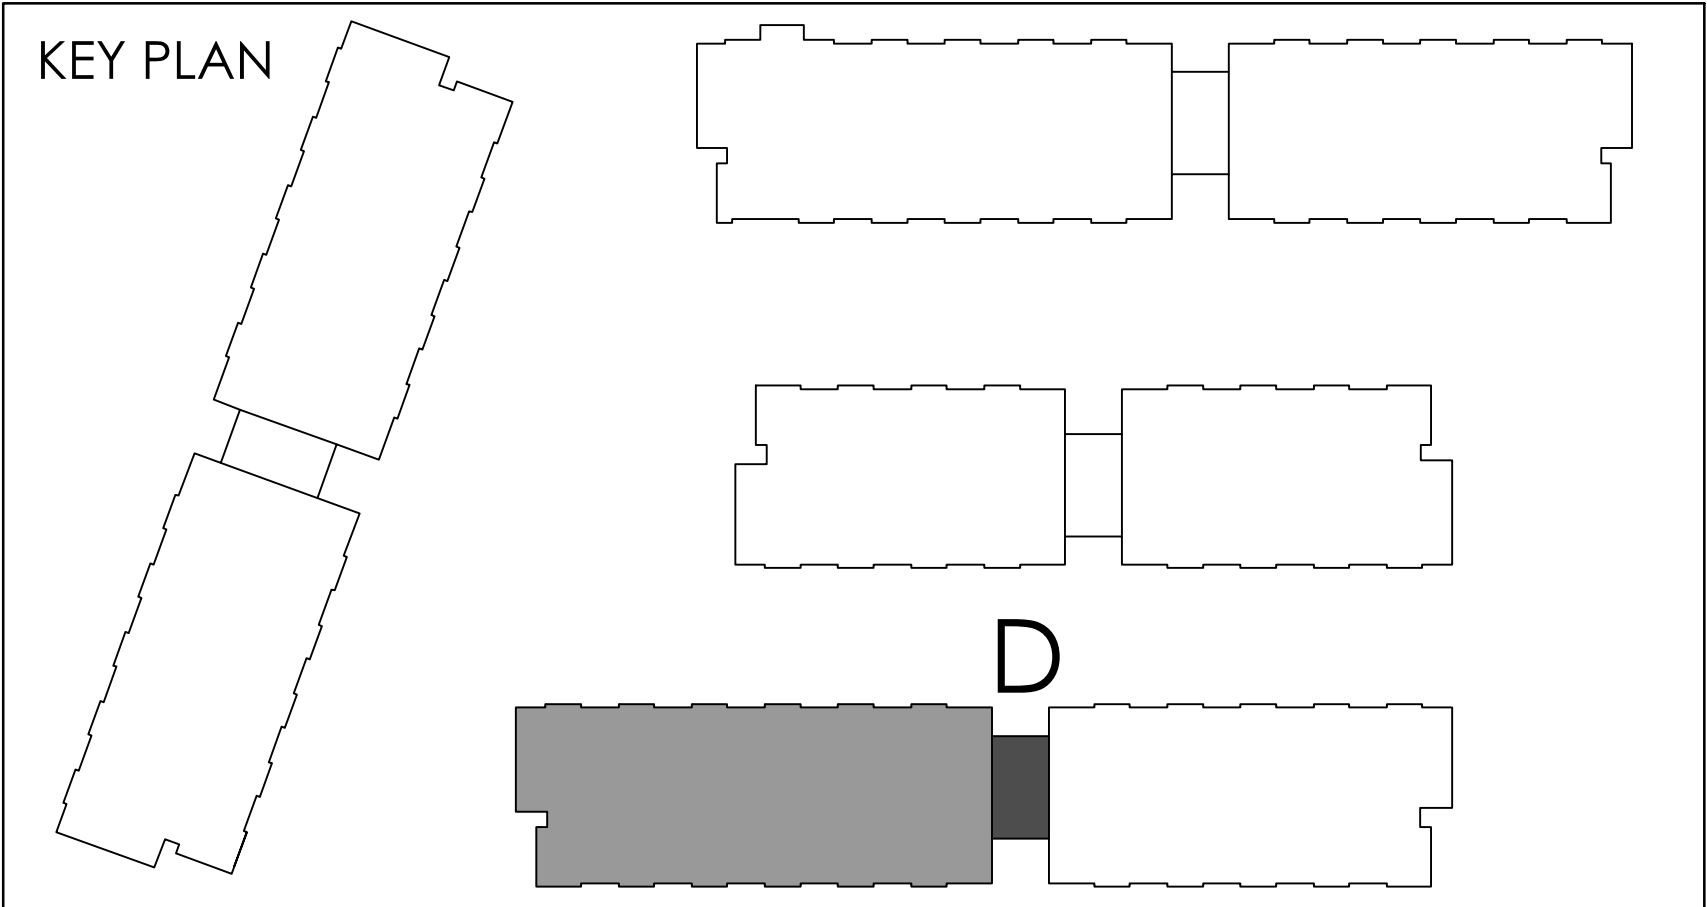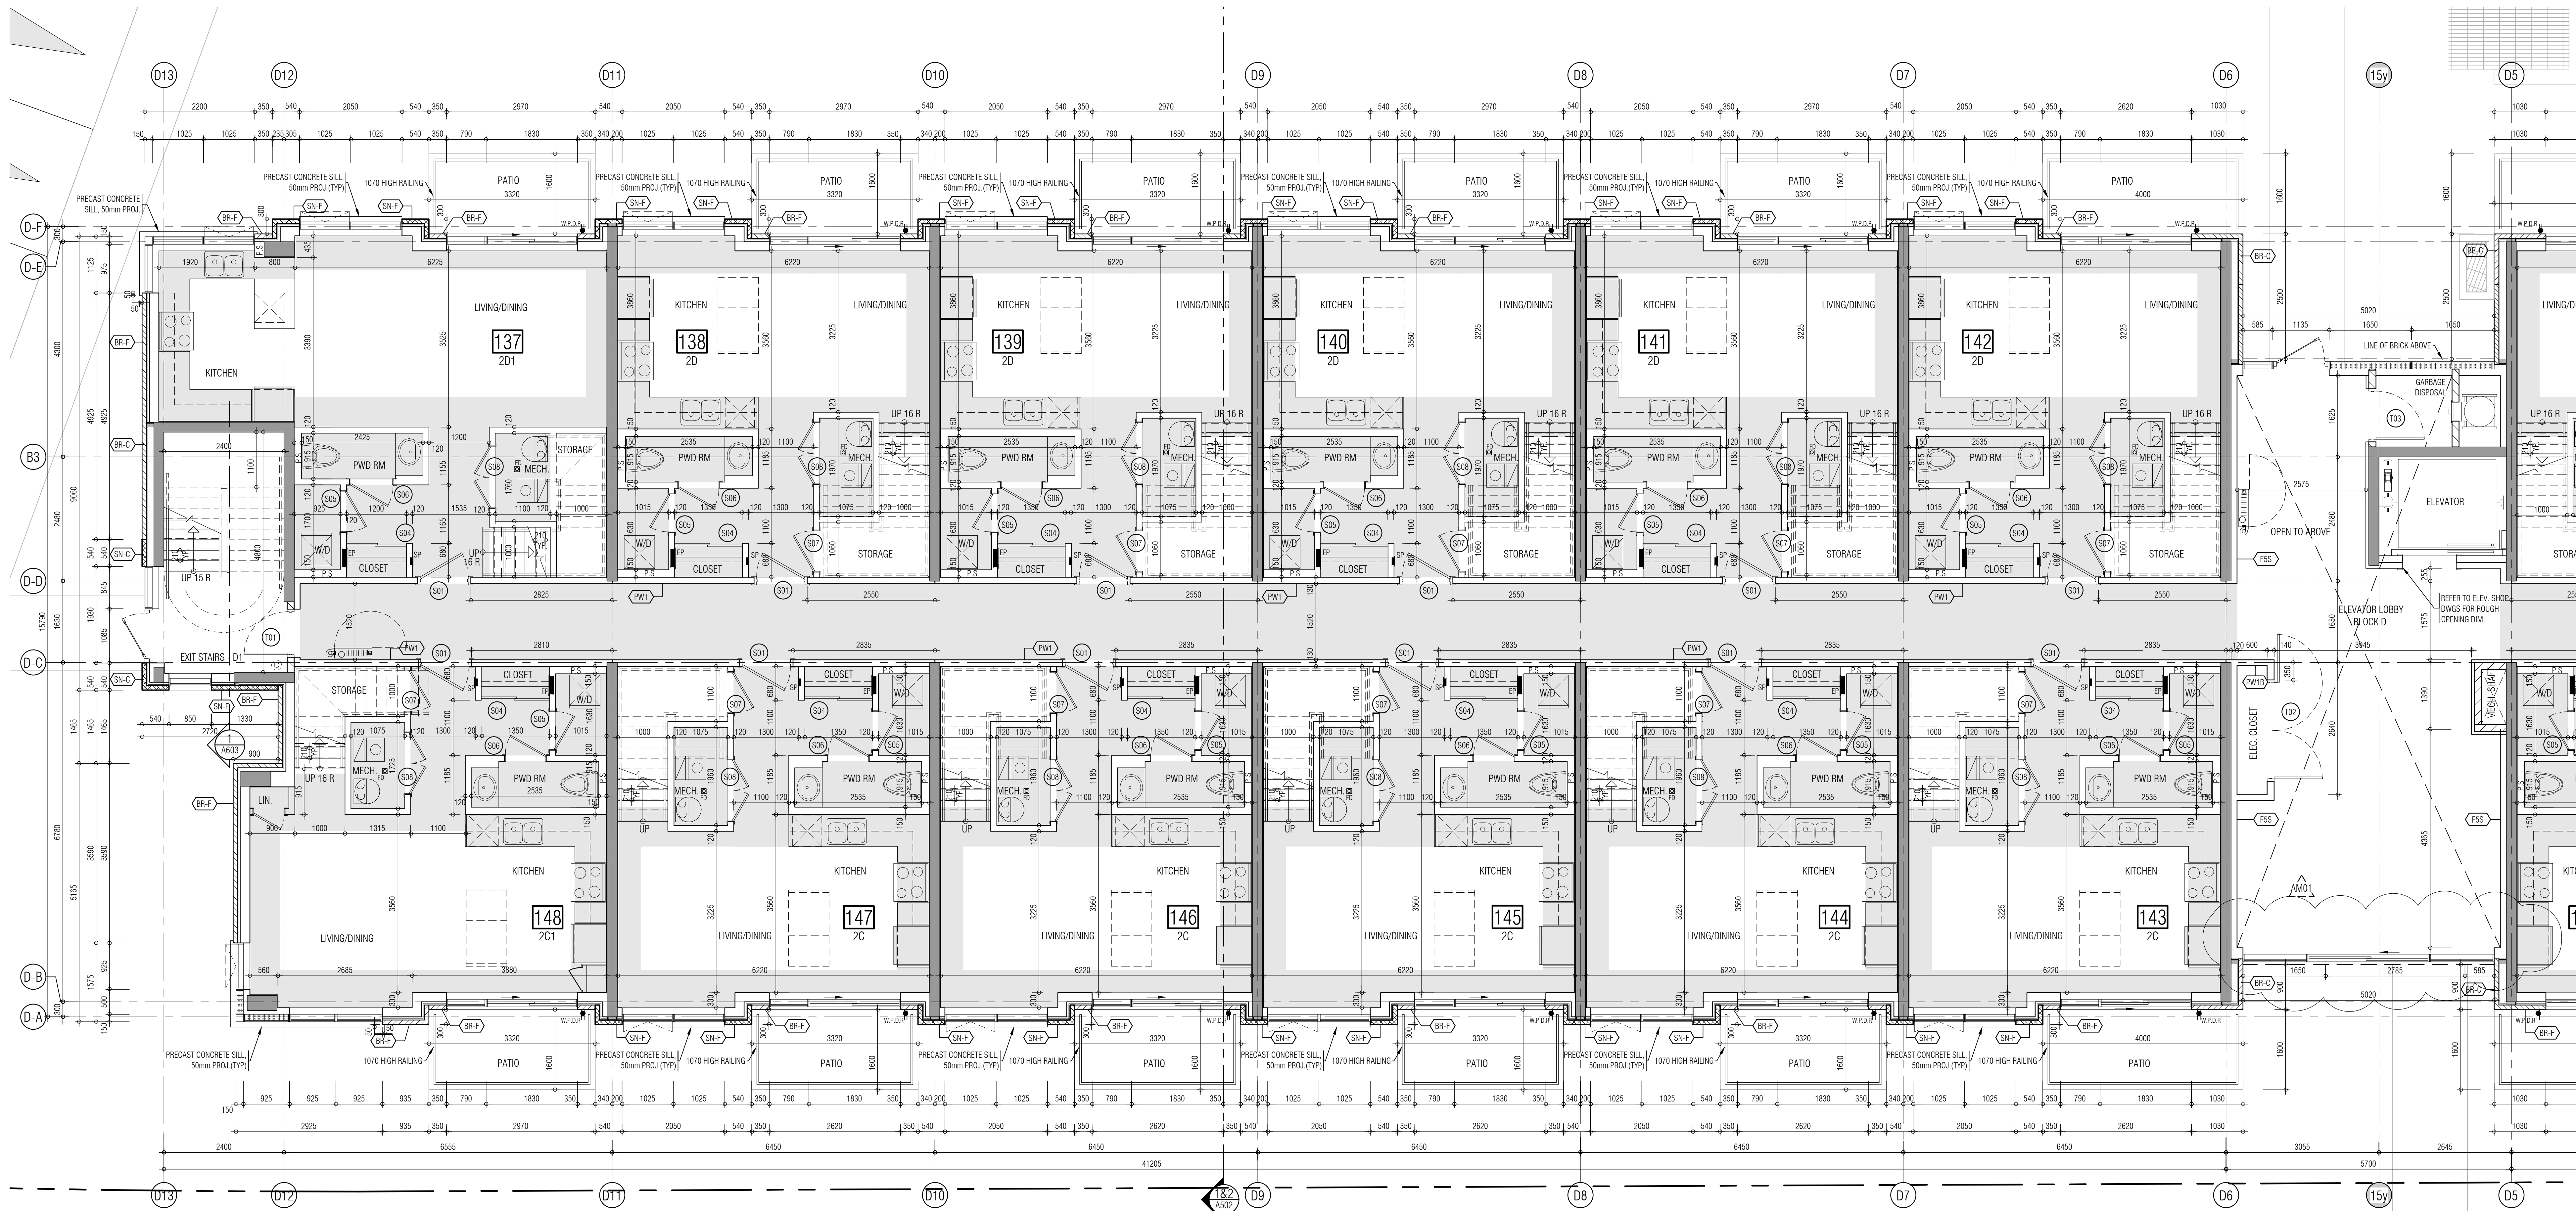

THIS DRAWING, AS AN INSTRUMENT OF SERVICE, IS PROVIDED BY AND IS THE PROPERTY OF GRAZIANI-CORAZZA ARCHITECTS INC. THE CONTRACTOR MUST VERIFY AND ACCEPT RESPONSIBILITY FOR ALL DIMENSIONS AND CONDITIONS ON SITE AND MUST KEEP GRAZIANI-CORAZZA ARCHITECTS INC. OF ANY WARRANTIES FROM THE SUPPLIED INFORMATION. GRAZIANI-CORAZZA ARCHITECTS INC. IS NOT RESPONSIBLE FOR THE ACCURACY OF SURVEY, STRUCTURAL, MECHANICAL, ELECTRICAL, AND OTHER ENGINEERING INFORMATION SHOWN ON THIS DRAWING. REFER TO THE APPROPRIATE ENGINEERING DRAWINGS BEFORE PROCEEDING WITH THE WORK. CONSTRUCTION MUST CONFORM TO ALL APPLICABLE CODES AND REQUIREMENTS OF THE AUTHORITIES HAVING JURISDICTION. ALWAYS CONSULT WITH THE ENGINEER OF RECORD FOR ANY CHANGES TO THE DRAWING. NO INVESTIGATION HAS BEEN UNDERTAKEN OR REPORTED ON BY THE OFFICE IN RELATION TO THE ENVIRONMENTAL CONDITION OF THIS SITE.

THIS DRAWING IS NOT TO BE SCALED. ALL ARCHITECTURAL SYMBOLS INDICATED ON THIS DRAWING ARE GRAPHIC REPRESENTATIONS ONLY.

CONDITIONS FOR ELECTRONIC INFORMATION TRANSFER:

ELECTRONIC INFORMATION IS SUPPLIED TO THE OTHER ASSOCIATED PARTS TO ASSIST THEM IN THE EXECUTION OF THEIR WORK. REVIEW THE RECEIPT FORMS MUST DETERMINE THE COMPLETENESS APPROPRIATENESS RELEVANCE OF THE INFORMATION IN RESPECT TO THEIR PARTICULAR RESPONSIBILITY.

1. ERRORS, OMISSIONS, INADEQUACIES DUE TO LOSS OF INFORMATION IN WHOLE OR PART WHEN INFORMATION IS TRANSFERRED.

2. TRANSMISSION OF ANY INFO OR CHANGE TO THE RECEIVING ELECTRONIC SYSTEM WHEN INFORMATION IS TRANSFERRED.

01. Aug.02.2019 Issued for tender

01. SEP.18.2019 Issued for Addendum 1

Issued for revisions:




RESIDENTIAL

ATTIMAR + PALLESCHE DRIVE ONTARIO


PROJECT ARCHITECT: B. GRAZIANI
ASSISTANT DESIGNER: R. LINCOLN
DRAWN BY: F.C./M.B.
CHECKED BY: D. BIASI (G. COLANGELO)
PLOT DATE: SEP.18.2019
JOB #: 1331.15

GROUND FLOOR PLAN
BUILDING D (PARTIAL PLAN)

1:50 A-301d1

TITLE BLOCK SIZE: 915 x 1200

REF-A301d1 FOR CONTINUATION

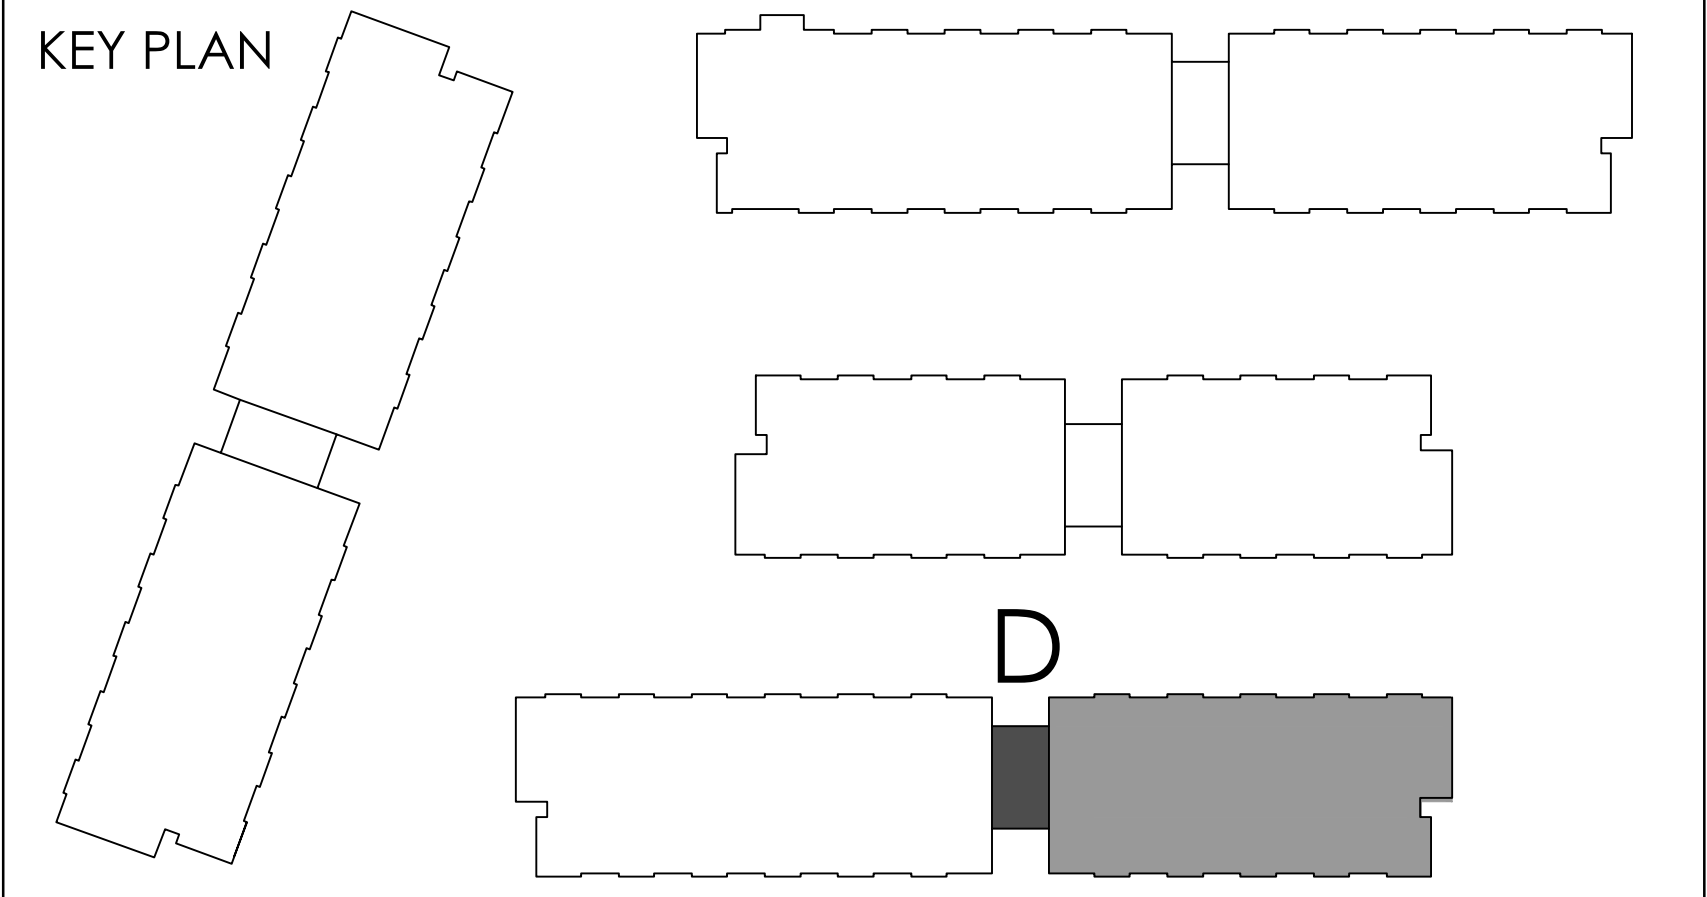

THIS DRAWING, AS AN INSTRUMENT OF SERVICE, IS PROVIDED BY AND IS THE PROPERTY OF GRAZIANI-CORAZZANI ARCHITECTS INC. THE CONTRACTOR MUST VERIFY AND ACCEPT RESPONSIBILITY FOR ALL DIMENSIONS AND CONDITIONS ON SITE AND MUST KEEP GRAZIANI-CORAZZANI ARCHITECTS INC. OF ANY VARIATIONS FROM THE SUPPLIED INFORMATION. GRAZIANI-CORAZZANI ARCHITECTS INC. IS NOT RESPONSIBLE FOR THE ACCURACY OF SURVEY, STRUCTURAL, MECHANICAL, ELECTRICAL, AND OTHER ENGINEERING INFORMATION SHOWN ON THIS DRAWING. 

THIS DRAWING IS NOT TO BE SCALED. ALL ARCHITECTURAL SYMBOLS INDICATED ON THIS DRAWING ARE GRAPHIC REPRESENTATIONS ONLY.

CONDITIONS FOR ELECTRONIC INFORMATION TRANSFER:

ELECTRONIC INFORMATION IS SUPPLIED TO THE OTHER ASSOCIATED FRAMES TO ASSIST THEM IN THE EXECUTION OF THEIR WORK. REVIEW THE RECEIPT FRAMES MUST DETERMINE THE COMPLETENESS APPROPRIATENESS RELEVANCE OF THE INFORMATION IN RESPECT TO THEIR PARTICULAR RESPONSIBILITY.

GRAZIANI-CORAZZANI ARCHITECTS INC. SHALL NOT BE RESPONSIBLE FOR:

1. ERRORS, OMISSIONS, INADEQUACIES DUE TO USE OF INFORMATION IN WHOLE OR PART WHEN INFORMATION IS TRANSFERRED.
2. TRANSMISSION OF ANY INFO OR CHANGE TO THE RECEIVING ELECTRONIC SYSTEM WHEN INFORMATION IS TRANSFERRED.

01. Aug 02, 2019 Issued for tender

01. SEP 18, 2019 Issued for Adendum 1

Issued for revisions:



BRAND: ATTIMAR + PALLESCHI DRIVE ONTARIO

PROJECT ARCHITECT: B. GRAZIANI

ASSISTANT DESIGNER: R. LINCOLN

DRAWN BY: F.C./M.B.

CHECKED BY: D. BIASE (G. COLANGELO)

JOB DATE: SEP 18, 2019

JOB # 1331.15

GROUND FLOOR PLAN
BUILDING D (PARTIAL PLAN)

1:50 A-301d2

TITLE BLOCK SIZE: 915 x 1200

THIS DRAWING, AS AN INSTRUMENT OF SERVICE, IS PROVIDED BY AND IS THE PROPERTY OF GRAZIANI-CORAZZA ARCHITECTS INC. THE CONTRACTOR MUST VERIFY AND ACCEPT RESPONSIBILITY FOR ALL DIMENSIONS AND CONDITIONS ON SITE AND MUST KEEP GRAZIANI-CORAZZA ARCHITECTS INC. OF ANY VARIATIONS FROM THE SUPPLIED INFORMATION. GRAZIANI-CORAZZA ARCHITECTS INC. IS NOT RESPONSIBLE FOR THE ACCURACY OF SURVEY, STRUCTURAL, MECHANICAL, ELECTRICAL, AND OTHER ENGINEERING INFORMATION SHOWN ON THIS DRAWING. REFER TO THE APPROPRIATE ENGINEERING DRAWINGS BEFORE PROCEEDING WITH THE WORK. CONSTRUCTION MUST CONFORM TO ALL APPLICABLE CODES AND REQUIREMENTS OF THE AUTHORITIES HAVING JURISDICTION. DULIS CONFORMANCE NOTING NO INVESTIGATION HAS BEEN UNDERTAKEN OR REPORTED ON BY THE OFFICE IN RELATION TO THE ENVIRONMENTAL CONDITION OF THIS SITE.

THIS DRAWING IS NOT TO BE SCALED. ALL ARCHITECTURAL SYMBOLS INDICATED ON THIS DRAWING ARE GRAPHIC REPRESENTATIONS ONLY.

CONDITIONS FOR ELECTRONIC INFORMATION TRANSFER:


ELECTRONIC INFORMATION IS SUPPLIED TO THE OTHER ASSOCIATED FRAMES TO ASSIST THEM IN THE EXECUTION OF THEIR WORK/REVIEW. THE RECIPIENT FRAMES MUST DETERMINE THE COMPLETENESS/APPROPRIATENESS/RELEVANCE OF THE INFORMATION IN RESPECT TO THEIR PARTICULAR RESPONSIBILITY.

GRAZIANI-CORAZZA ARCHITECTS INC. SHALL NOT BE RESPONSIBLE FOR:

1. ERRORS, OMISSIONS, INADEQUACIES DUE TO USE OF INFORMATION IN WHOLE OR PART WHEN INFORMATION IS TRANSFERRED;
2. TRANSMISSION OF ANY LOSS OR DAMAGE TO THE RECEIVING ELECTRONIC SYSTEM WHEN INFORMATION IS TRANSFERRED.

01. Aug/02/2019 Issued for tender

REF A302a2 FOR CONTINUATION

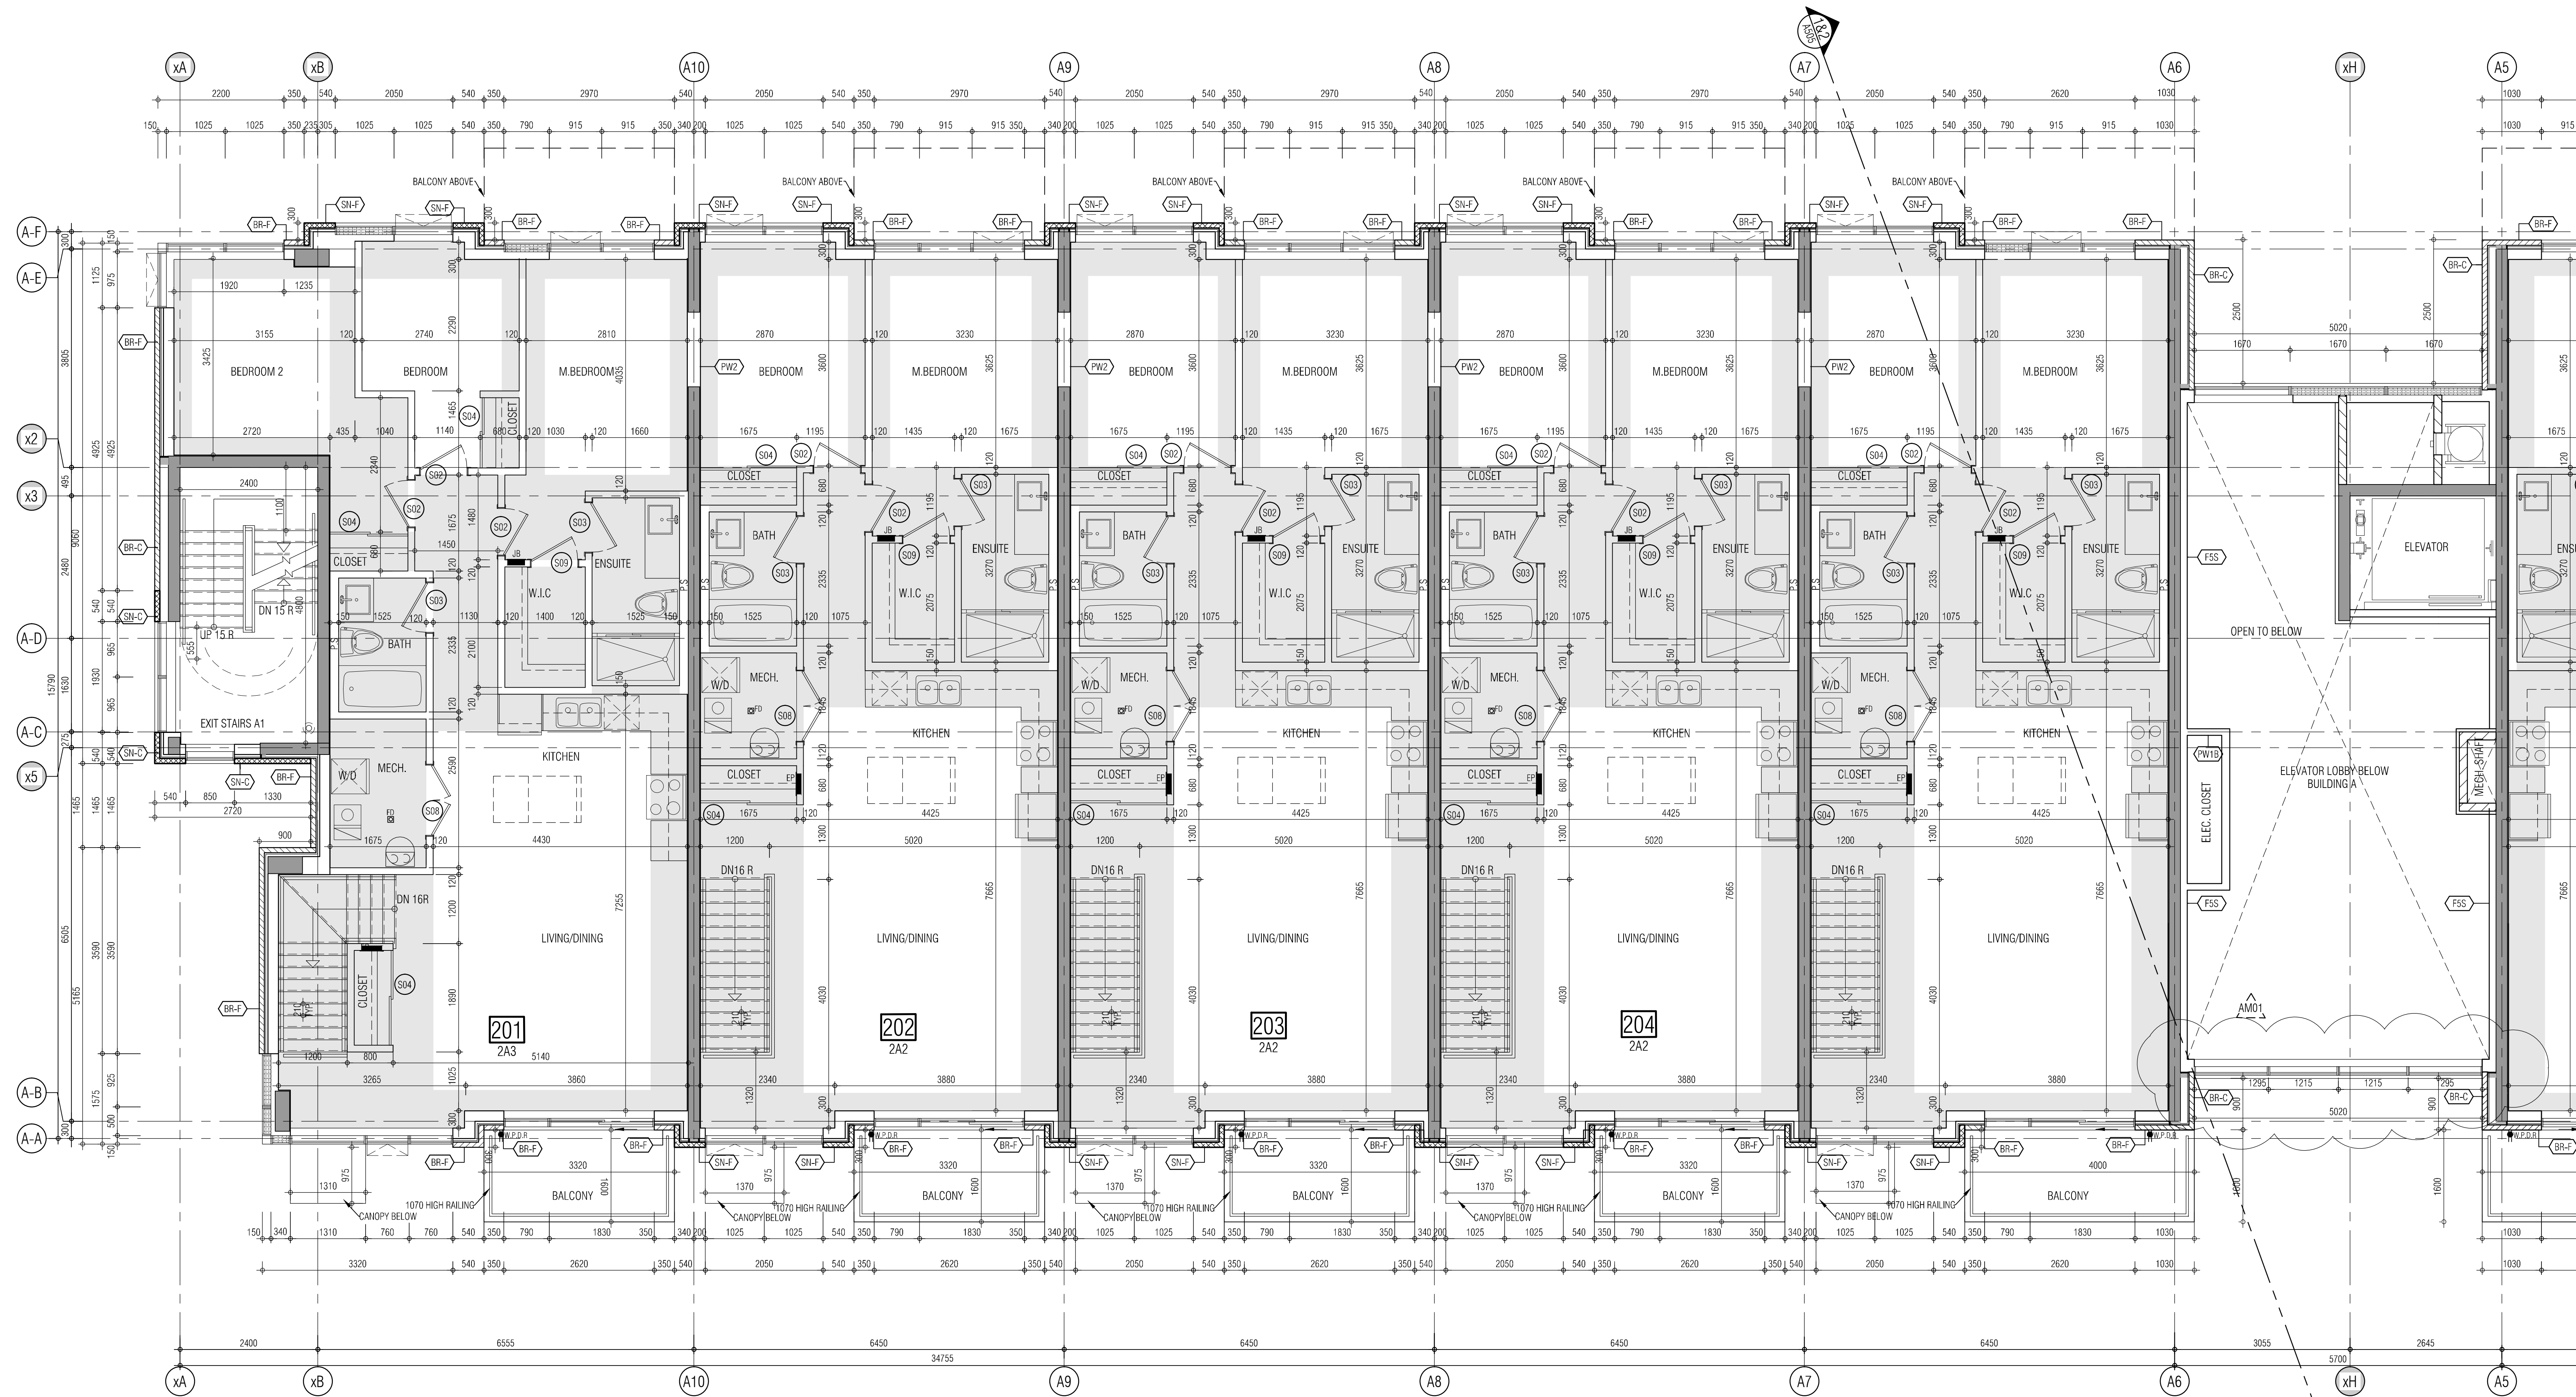

01. SEP 18, 2019 Issued for Addendum 1

Issued for revisions:

+

**GRAZIANI
CORAZZA
ARCHITECTS**

1100 DUNDAS STREET WEST, SUITE 100, MISSISSAUGA, ONTARIO L4W 1C1
TEL: 905.276.2600 FAX: 905.276.2644 WWW.GC-ARCHITECTS.COM

RESIDENTIAL


ATTMAR + PALLESCHI DRIVE ONTARIO

PROJECT ARCHITECT: B. GRAZIANI
ASSISTANT DESIGNER: R. LINCOLN
DRAWN BY: F.C./M.B.
CHECKED BY: D. BIAISE/G. COLANGELO
PLOT DATE: SEP 18, 2019
JOB # 1331.15

**SECOND FLOOR PLAN
BUILDING A (PARTIAL PLAN)**


1:50 A-302a1

TITLEBLOCK SIZE: 915 x 1200

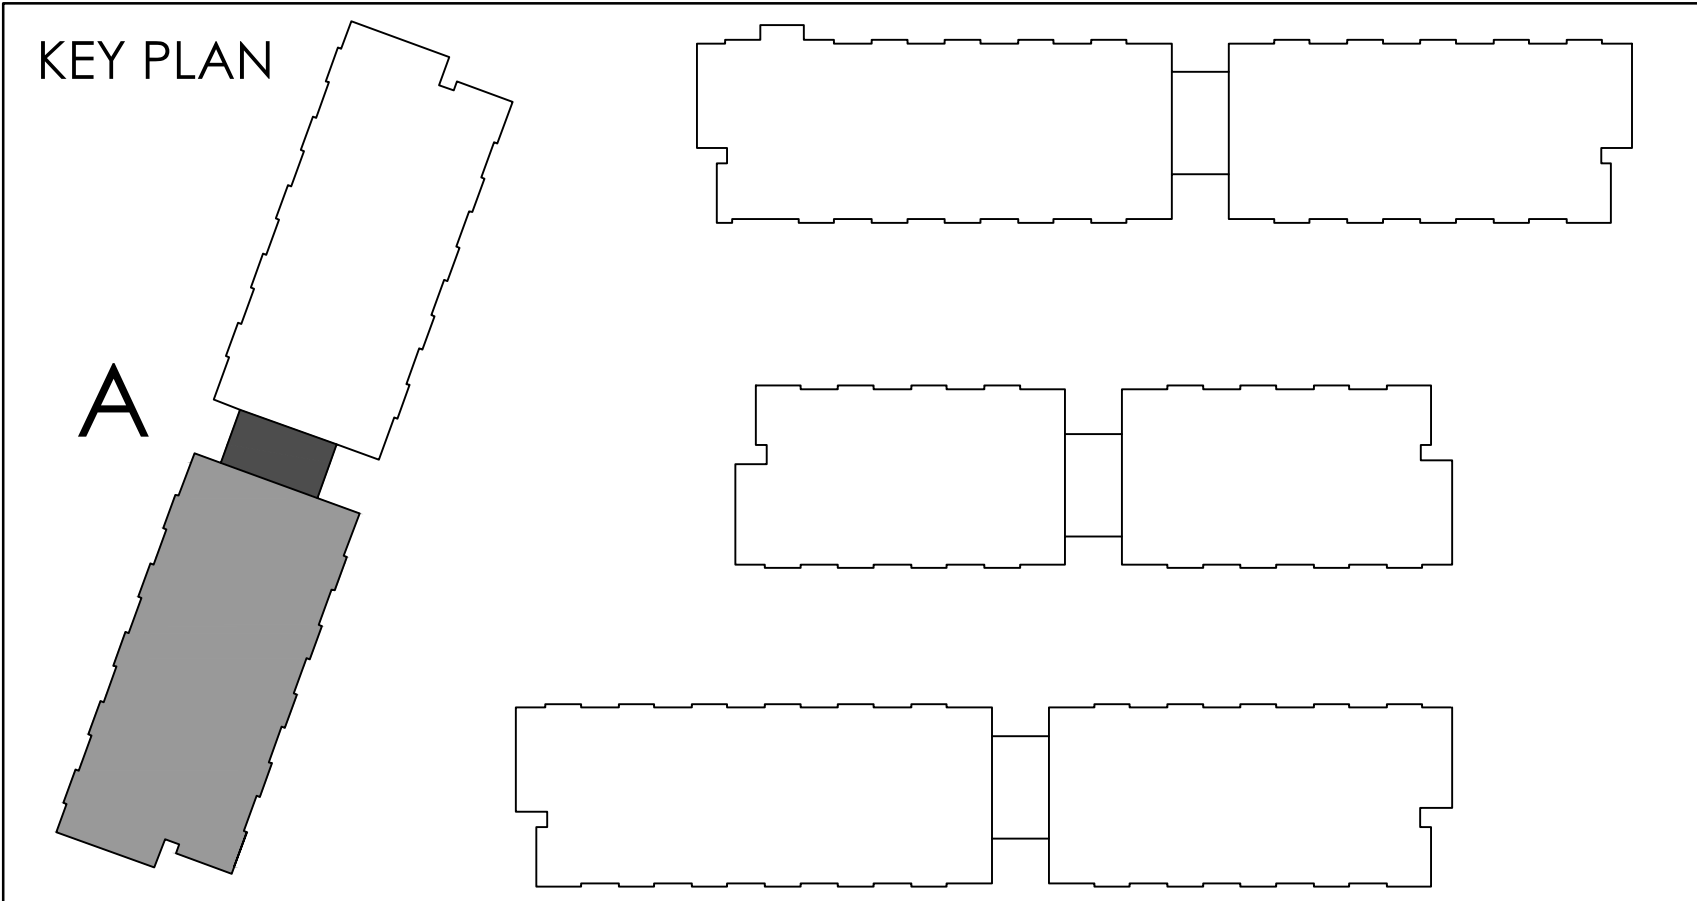

[illegible]

01. Aug.02.2019 issued for tender

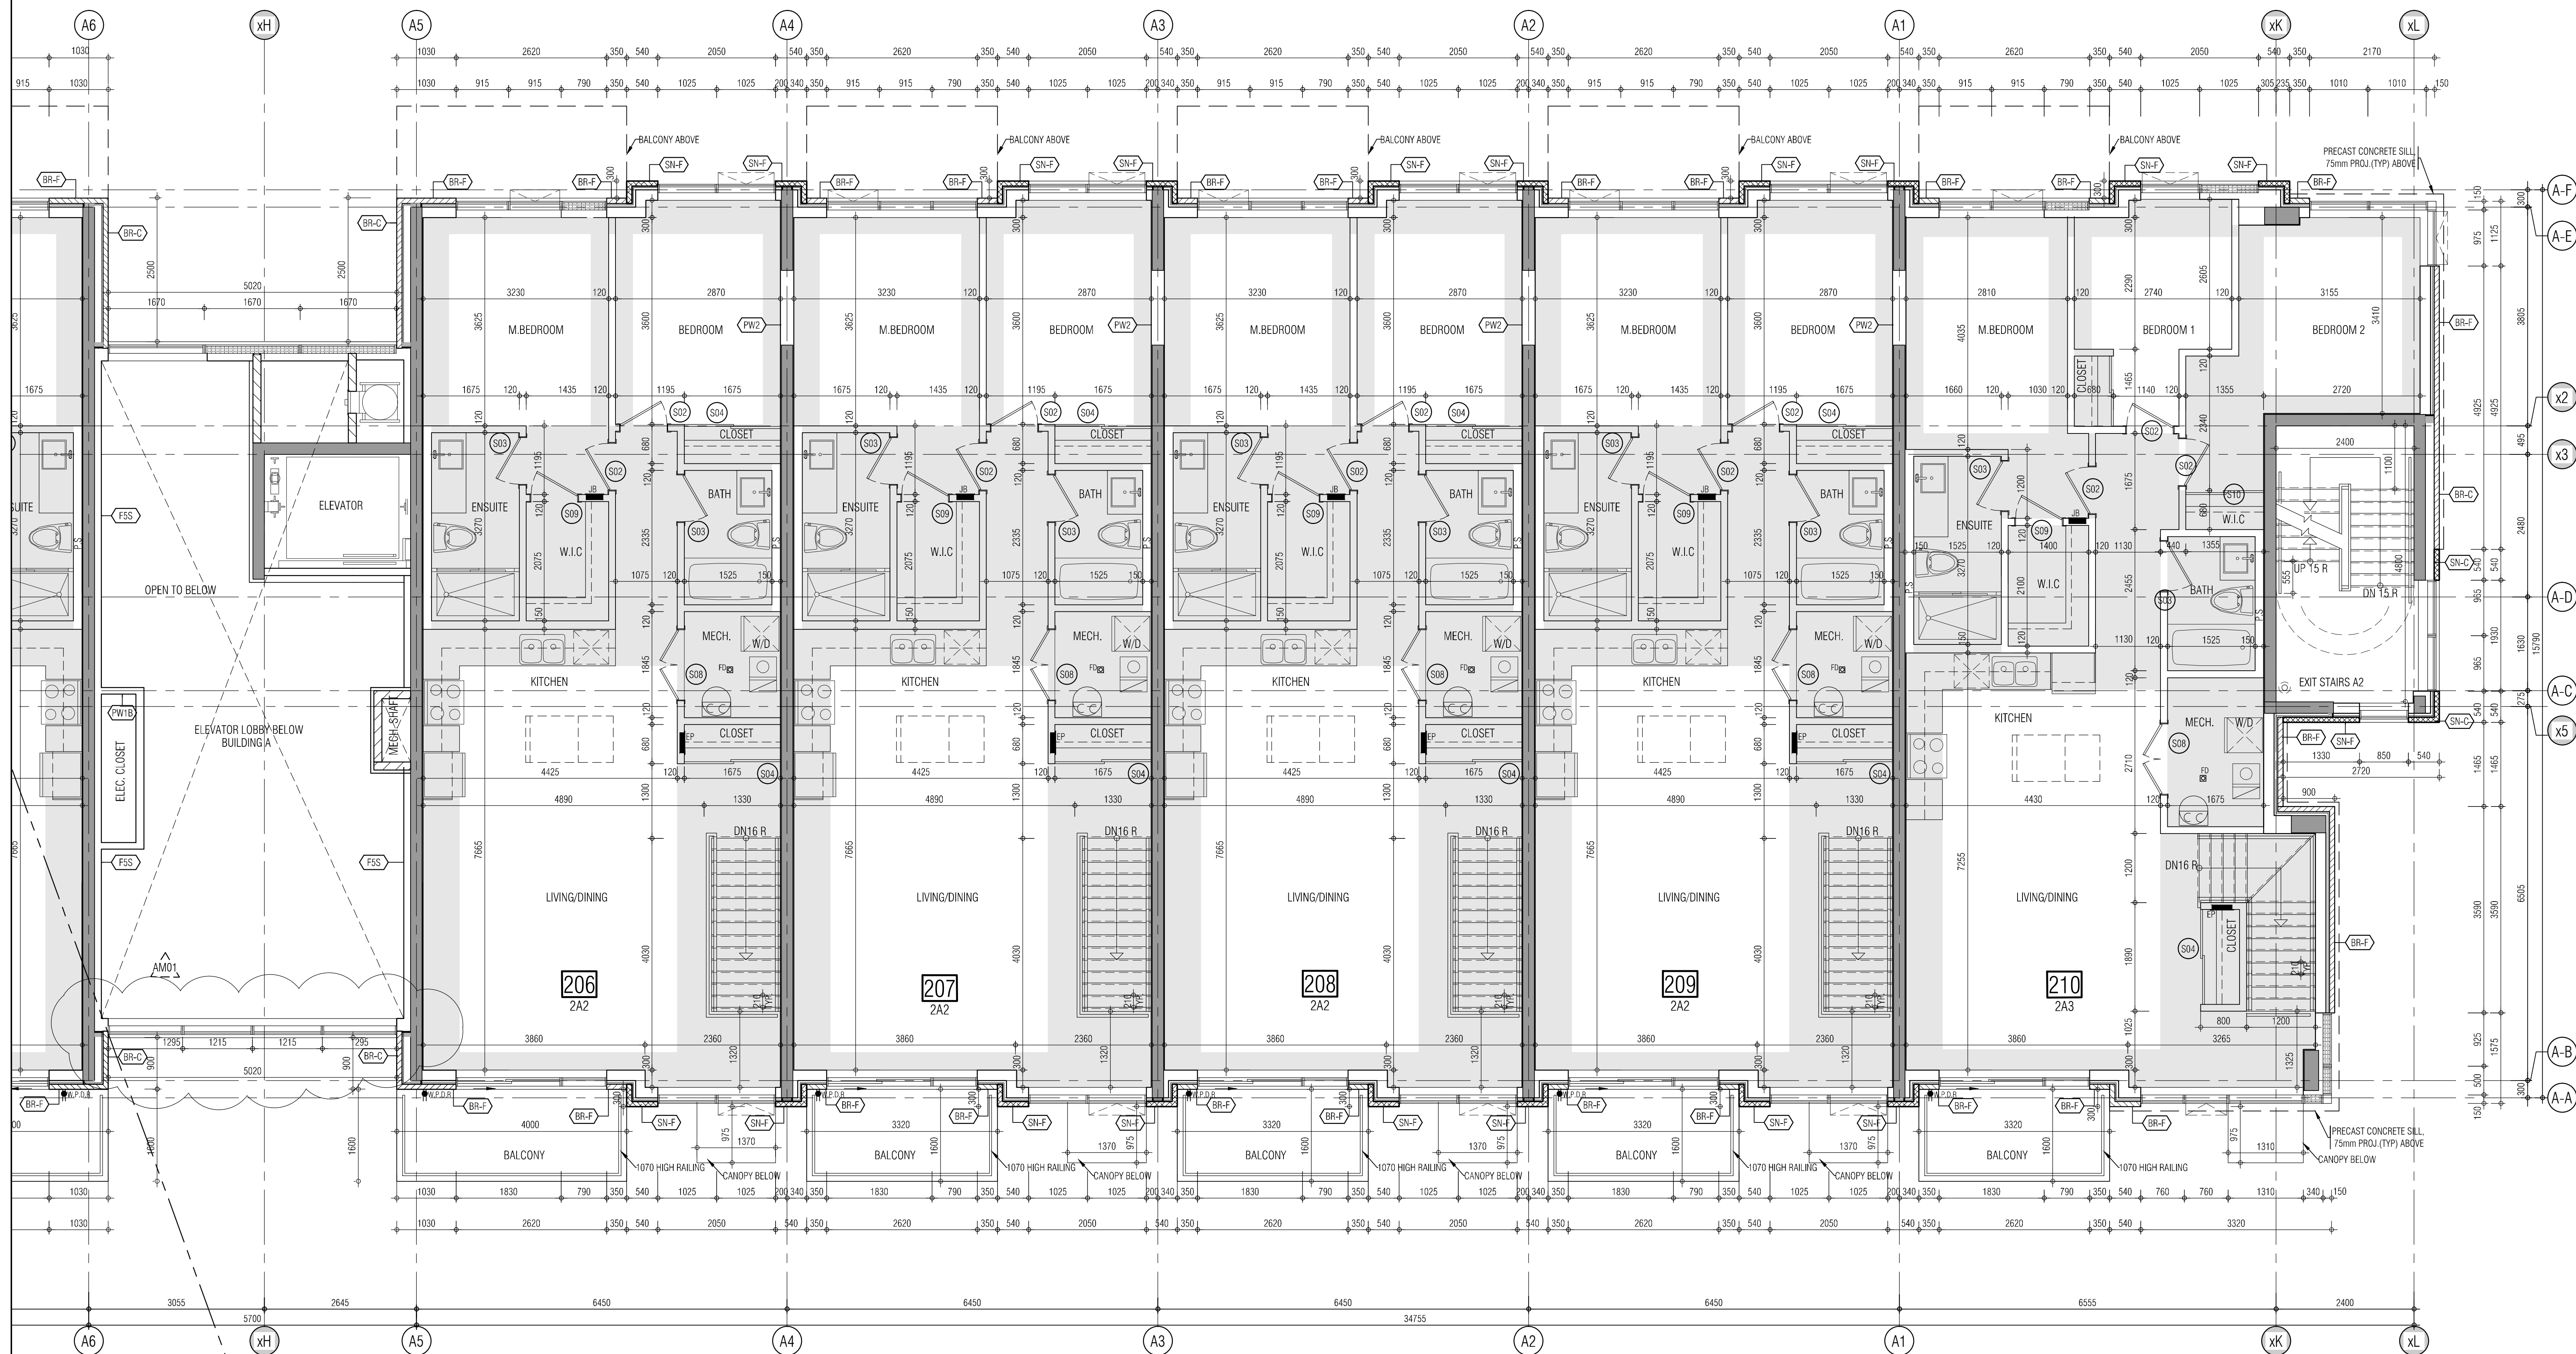

01. SEP 18, 2019 Issued for Addendum 1

issued for revisions



RESIDENTIAL


BRAMPTON ONTARIO

PROJECT ARCHITECT: B. GRAZIANI

ASSISTANT DESIGNER: R. LINCOLN
 ELECTRICAL: E. C. M. D.

CHECKED BY: D.BIASE/G.COLANGELO

PLOT DATE: SEP.18.2019


Job # 1331.13

SECOND FLOOR PLAN

BUILDING A (PARTIAL PLAN)

1.50 A 302.50

TITLE BOX SIZE: 915 x 1200

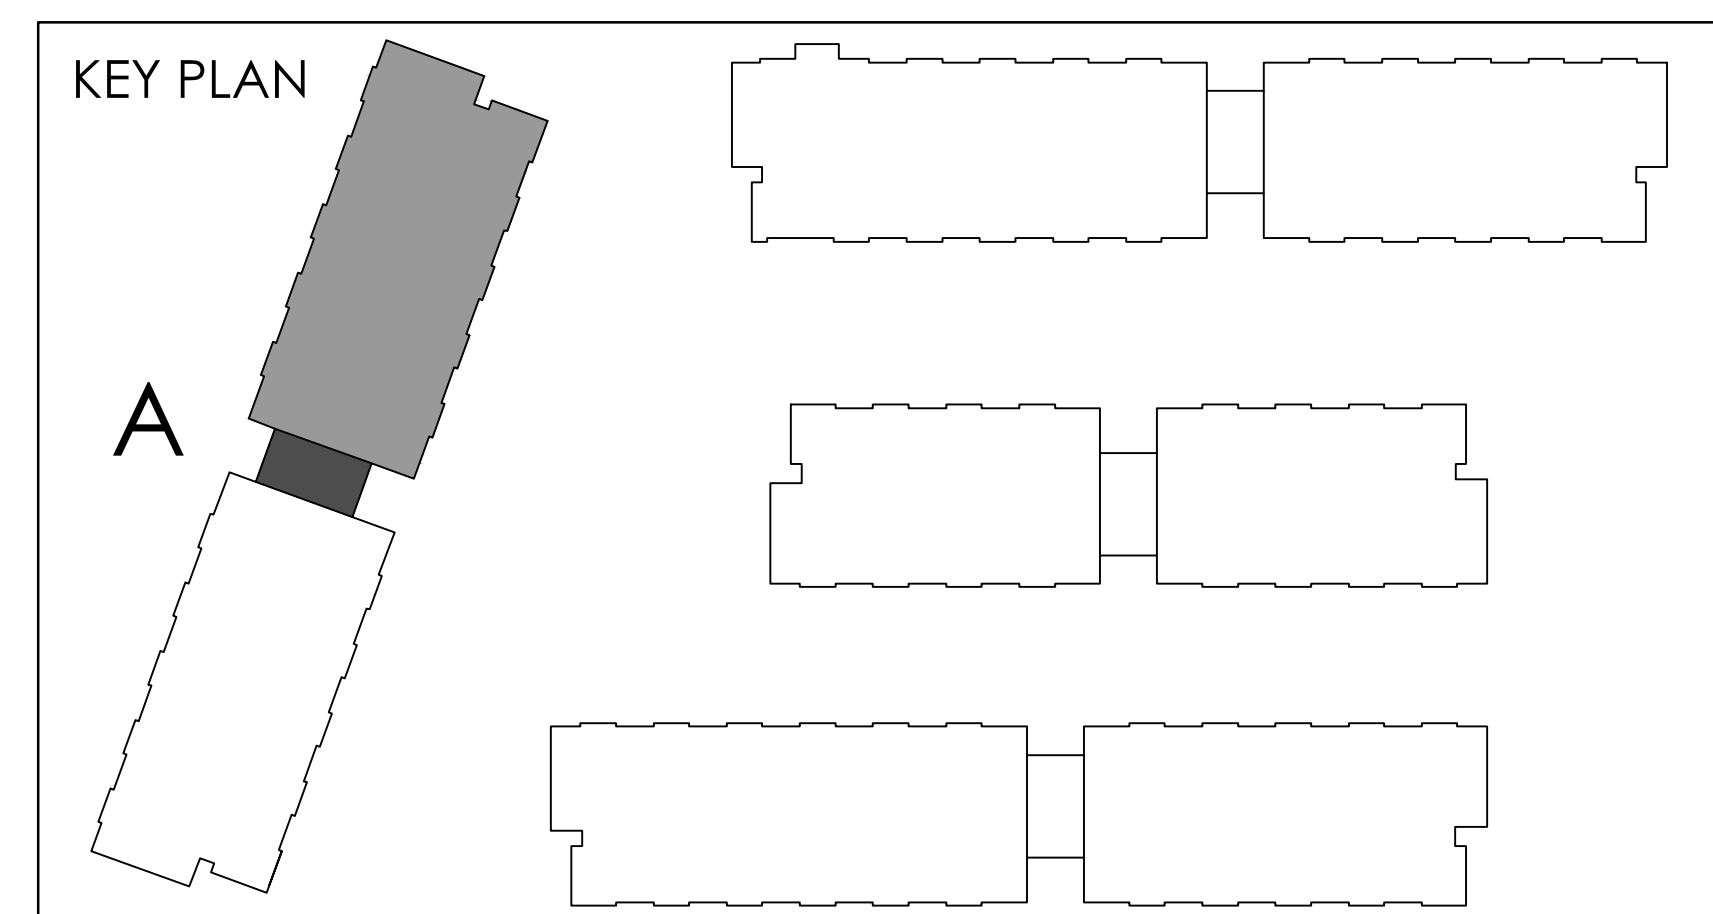 1:50 A-302a2

TITLE BOX SIZE: 915 x 1200

THIS DRAWING, AS AN INSTRUMENT OF SERVICE, IS PROVIDED BY AND IS THE PROPERTY OF GRAZIANI-CORAZZA ARCHITECTS INC. THE CONTRACTOR MUST VERIFY AND ACCEPT RESPONSIBILITY FOR ALL DIMENSIONS AND CONDITIONS ON SITE AND MUST KEEP GRAZIANI-CORAZZA ARCHITECTS INC. OF ANY WARRANTIES FROM THE SUPPLIED INFORMATION. GRAZIANI-CORAZZA ARCHITECTS INC. IS NOT RESPONSIBLE FOR THE ACCURACY OF SURVEY, STRUCTURAL, MECHANICAL, ELECTRICAL, AND OTHER ENGINEERING INFORMATION SHOWN ON THIS DRAWING. REFER TO THE APPROPRIATE ENGINEERING DRAWINGS BEFORE PROCEEDING WITH THE WORK. CONSTRUCTION MUST CONFORM TO ALL APPLICABLE CODES AND REQUIREMENTS OF THE AUTHORITIES HAVING JURISDICTION. DULIS CONFORMANCE NOTING NO INVESTIGATION HAS BEEN UNDERTAKEN OR REPORTED ON BY THE OFFICE IN RELATION TO THE ENVIRONMENTAL CONDITION OF THIS SITE.

THIS DRAWING IS NOT TO BE SCALED. ALL ARCHITECTURAL SYMBOLS INDICATED ON THIS DRAWING ARE GRAPHIC REPRESENTATIONS ONLY.

CONDITIONS FOR ELECTRONIC INFORMATION TRANSFER:


ELECTRONIC INFORMATION IS SUPPLIED TO THE OTHER ASSOCIATED FRAMES TO ASSIST THEM IN THE EXECUTION OF THEIR WORK. REVIEW THE RECEIPT FRAMES MUST DETERMINE THE COMPLETENESS APPROPRIATENESS RELEVANCE OF THE INFORMATION IN RESPECT TO THEIR PARTICULAR RESPONSIBILITY.

1. OTHER ENGINEERING INFORMATION DUE TO USE OF INFORMATION IN WHOLE OR PART WHEN INFORMATION IS TRANSFERRED.

2. TRANSMISSION OF ANY INFO OR CHANGE TO THE RECEIVING ELECTRONIC SYSTEM WHEN INFORMATION IS TRANSFERRED.

01. Aug.02.2019 Issued for tender

REF.A302b2 FOR CONTINUATION

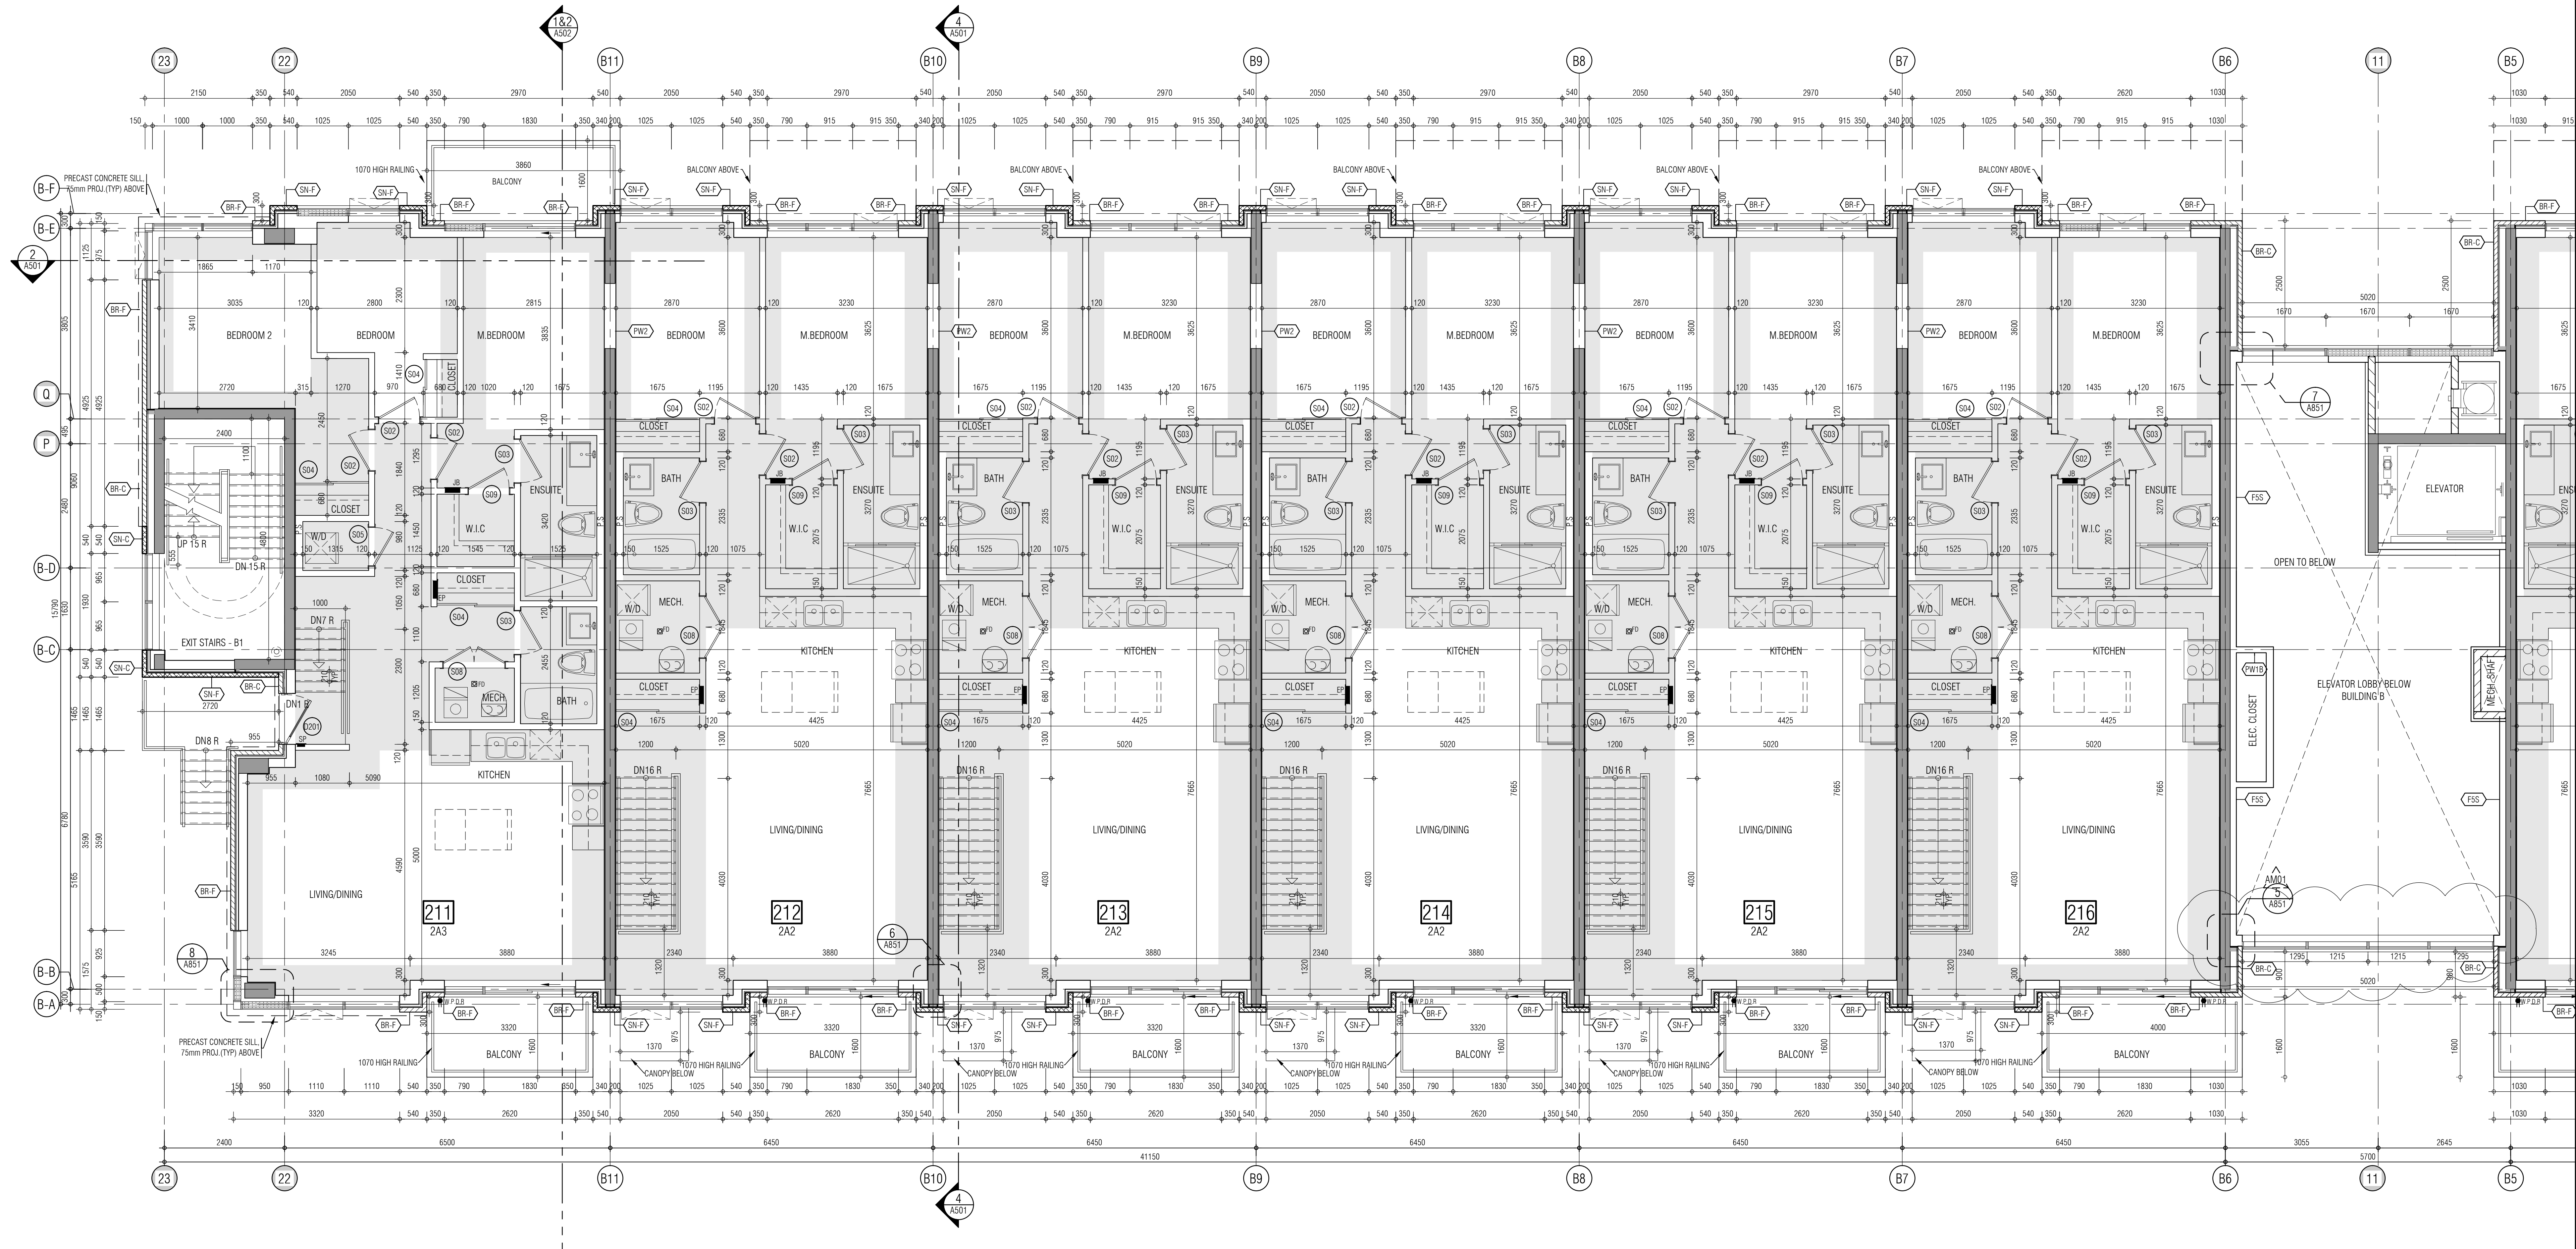

01. SEP.18.2019 Issued for Addendum 1

Issued for revisions:

+



RESIDENTIAL

ATTMART + PALLESCHE DRIVE ONTARIO


PROJECT ARCHITECT: B. GRAZIANI
ASSISTANT DESIGNER: R. LINCOLN
DRAWN BY: F.C./M.B.
CHECKED BY: D. BIASE (G. COLANGELO)
PLOT DATE: SEP.18.2019
JOB # 1331.15



SECOND FLOOR PLAN
BUILDING B (PARTIAL PLAN)

1:50 A-302b1

TITLE BLOCK SIZE: 915 x 1200

KEY PLAN

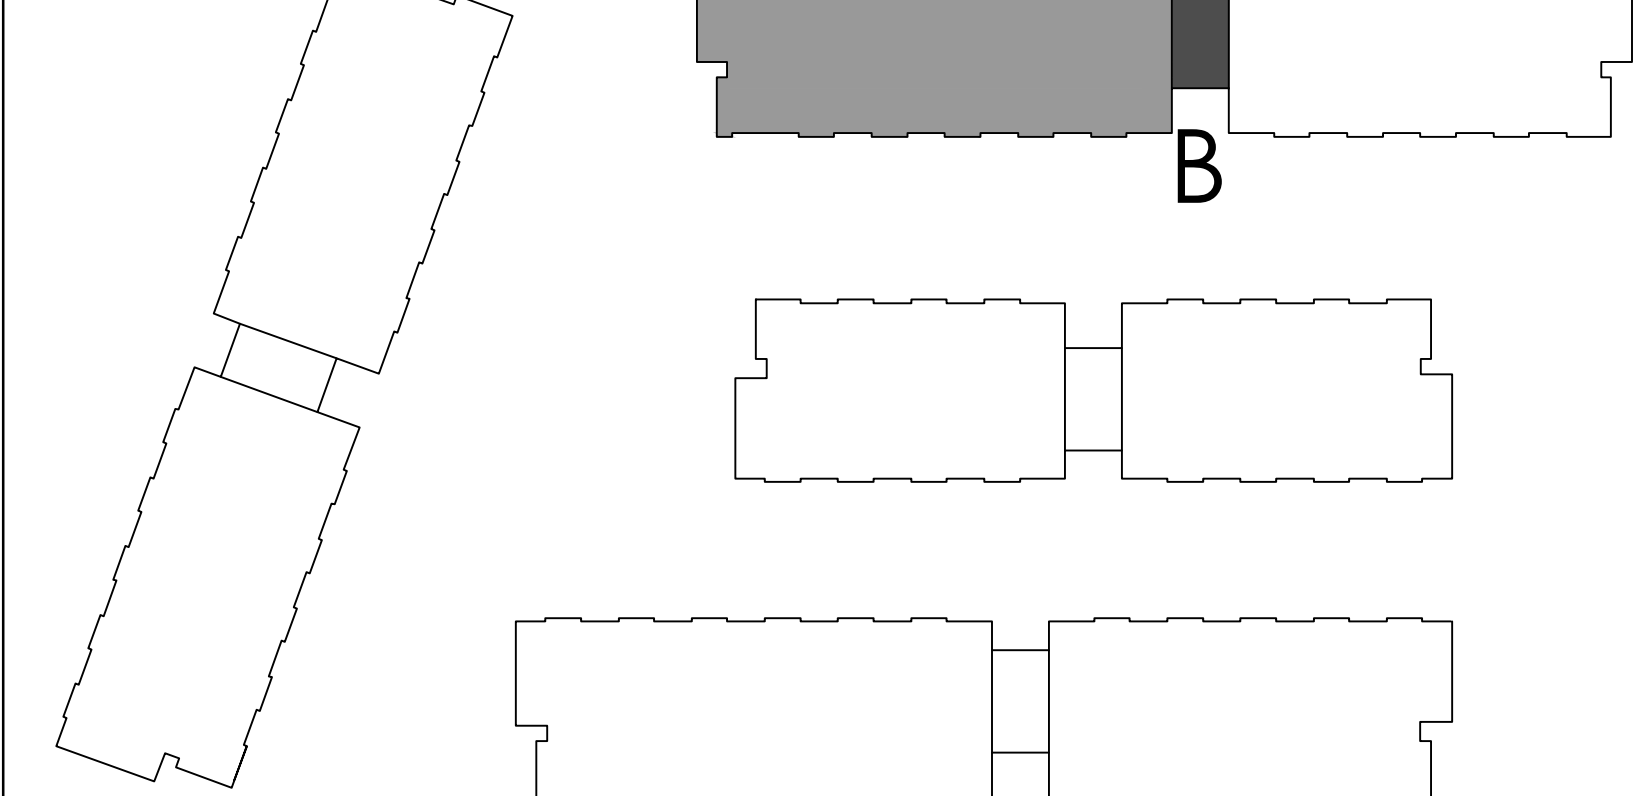

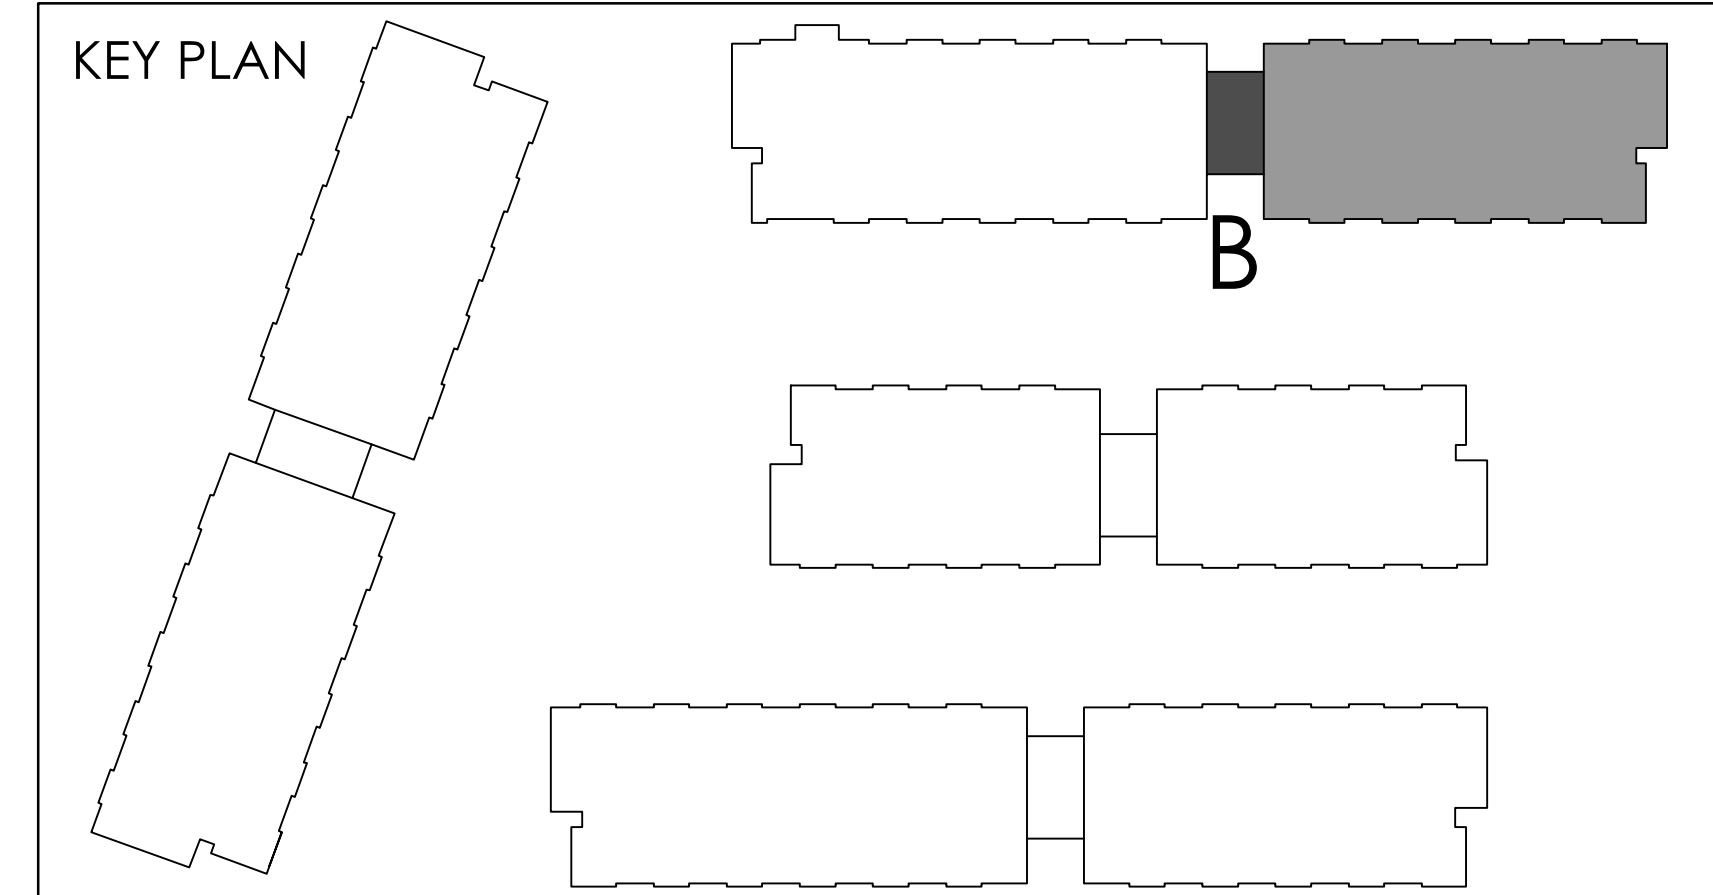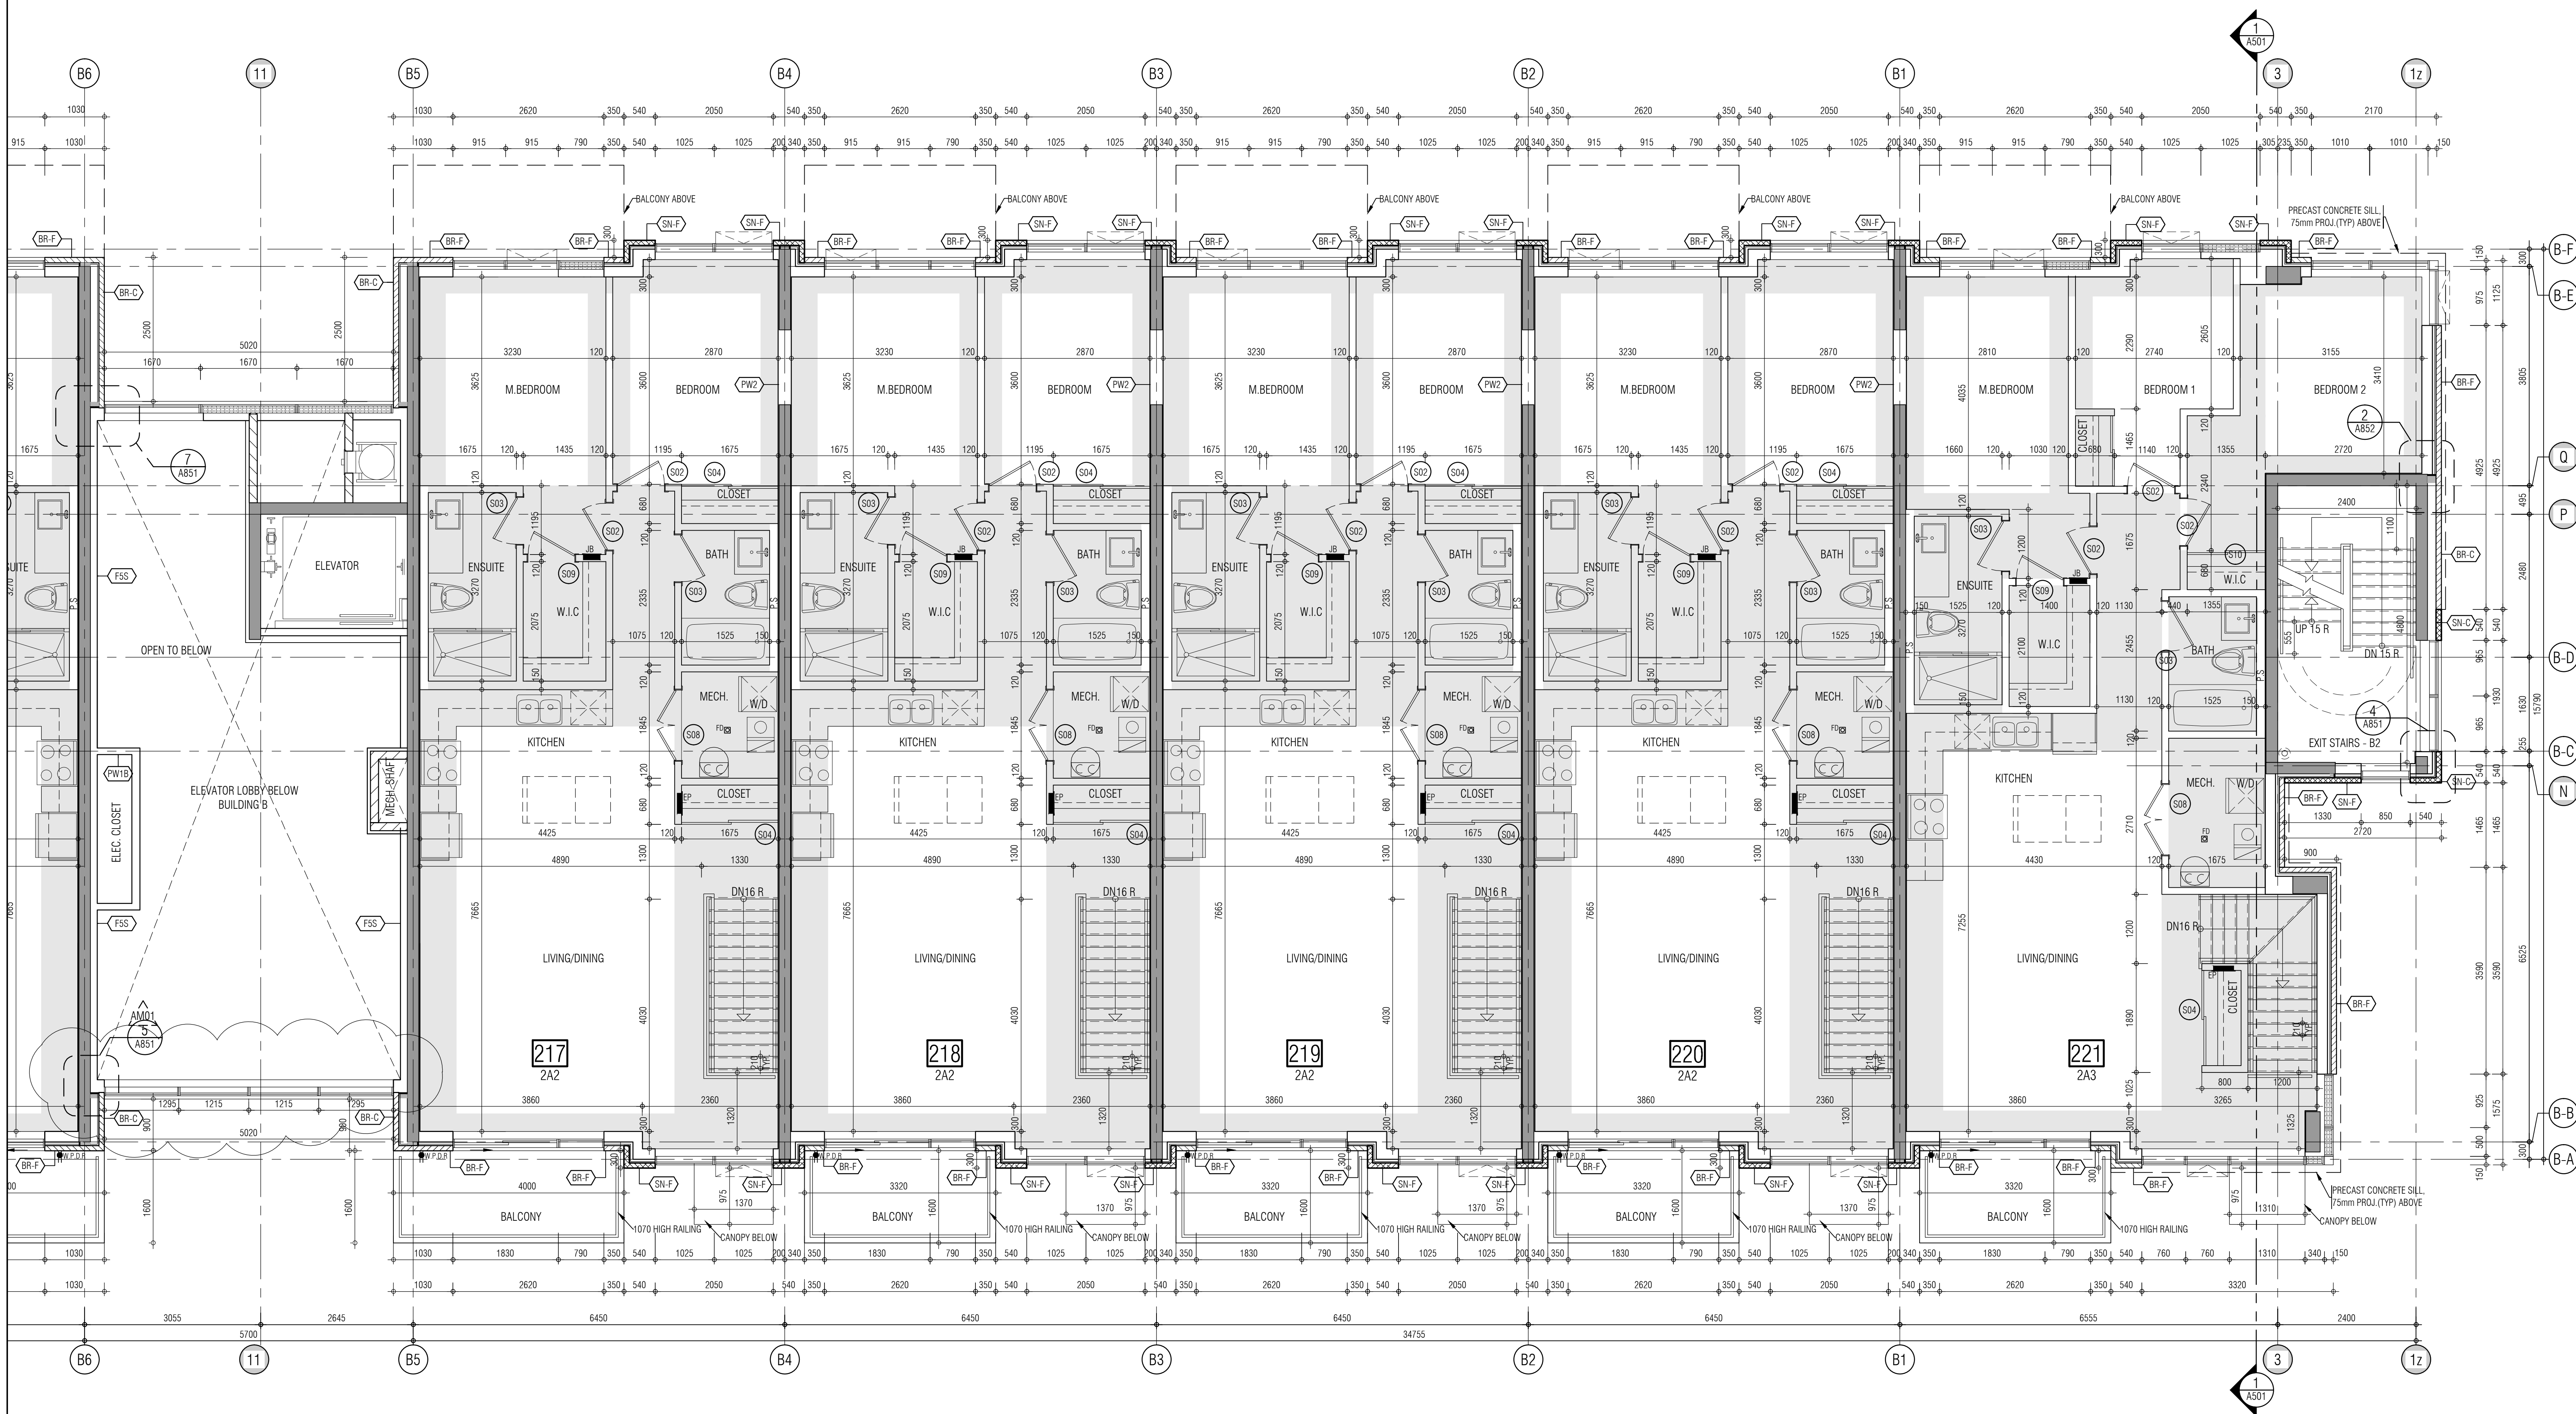

THIS DRAWING, AS AN INSTRUMENT OF SERVICE, IS PROVIDED BY AND IS THE PROPERTY OF GRAZIANI-CORAZZA ARCHITECTS INC. THE CONTRACTOR MUST VERIFY AND ACCEPT RESPONSIBILITY FOR ALL DIMENSIONS AND CONDITIONS ON SITE AND MUST KEEP GRAZIANI-CORAZZA ARCHITECTS INC. OF ANY WARRANTIES FROM THE SUPPLIED INFORMATION. GRAZIANI-CORAZZA ARCHITECTS INC. IS NOT RESPONSIBLE FOR THE ACCURACY OF SURVEY, STRUCTURAL, MECHANICAL, ELECTRICAL, AND OTHER ENGINEERING INFORMATION SHOWN ON THIS DRAWING. REFER TO THE APPROPRIATE ENGINEERING DRAWINGS BEFORE PROCEEDING WITH THE WORK. CONSTRUCTION MUST CONFORM TO ALL APPLICABLE CODES AND REQUIREMENTS OF THE AUTHORITIES HAVING JURISDICTION. ALWAYS CONSULT WITH THE INVESTIGATOR HAS BEEN UNDERTAKEN OR REPORTED ON BY THE OFFICE IN RELATION TO THE ENVIRONMENTAL CONDITION OF THIS SITE.

THIS DRAWING IS NOT TO BE SCALED. ALL ARCHITECTURAL SYMBOLS INDICATED ON THIS DRAWING ARE GRAPHIC REPRESENTATIONS ONLY.

CONDITIONS FOR ELECTRONIC INFORMATION TRANSFER:

ELECTRONIC INFORMATION IS SUPPLIED TO THE OTHER ASSOCIATED PARTS TO ASSIST THEM IN THE EXECUTION OF THEIR WORK/REVIEW. THE RECIPIENT PARTS MUST OBTAIN THE COMPLETED APPROPRIATE RELEVANCE OF THE INFORMATION IN RESPECT TO THEIR PARTICULAR RESPONSIBILITY.

GRAZIANI-CORAZZA ARCHITECTS INC. SHALL NOT BE RESPONSIBLE FOR:

1. ERRORS, OMISSIONS, INADEQUACIES DUE TO USE OF INFORMATION IN WHOLE OR PART WHEN INFORMATION IS TRANSFERRED.
2. TRANSMISSION OF ANY VALUE OR CHANGE TO THE RECEIVING ELECTRONIC SYSTEM WHEN INFORMATION IS TRANSFERRED.

01. Aug 02 2019 Issued for tender

01. SEP 18, 2019 Issued for Addendum 1

Issued for revisions:

+



GRAZIANI-CORAZZA ARCHITECTS
1100 SHEPPARD AVE. E. SUITE 100 MISSISSAUGA, ONTARIO L4X 1V3
TEL: 905.276.2000 FAX: 905.276.2444 WWW.GC-ARCHITECTS.COM



PROJECT ARCHITECT: B. GRAZIANI
ASSISTANT ARCHITECT: R. LINCOLN
DRAWN BY: F.C./M.B.
CHECKED BY: D. BIASE/G. COLANGELO
PLOT DATE: SEP 18, 2019
JOB # 1331.15

**SECOND FLOOR PLAN
BUILDING B (PARTIAL PLAN)**

1:50 A-302b2

TITLED LOCK SIZE: 915 x 1200

THIS DRAWING, AS AN INSTRUMENT OF SERVICE, IS PROVIDED BY AND IS THE PROPERTY OF GRAZIANI-CORAZZANI ARCHITECTS INC. THE CONTRACTOR MUST VERIFY AND ACCEPT RESPONSIBILITY FOR ALL DIMENSIONS AND CONDITIONS ON SITE AND MUST KEEP GRAZIANI-CORAZZANI ARCHITECTS INC. OF ANY VARIATIONS FROM THE SUPPLIED INFORMATION. GRAZIANI-CORAZZANI ARCHITECTS INC. IS NOT RESPONSIBLE FOR THE ACCURACY OF SURVEY, STRUCTURAL, MECHANICAL, ELECTRICAL, AND OTHER ENGINEERING INFORMATION SHOWN ON THIS DRAWING. REFER TO THE APPROPRIATE ENGINEERING DRAWINGS BEFORE PROCEEDING WITH THE WORK. CONSTRUCTION MUST CONFORM TO ALL APPLICABLE CODES AND REQUIREMENTS OF THE AUTHORITIES HAVING JURISDICTION. DULIS CONFORMANCE NOTING NO INVESTIGATION HAS BEEN UNDERTAKEN OR REPORTED ON BY THE OFFICE IN RELATION TO THE ENVIRONMENTAL CONDITION OF THIS SITE.

THIS DRAWING IS NOT TO BE SCALED. ALL ARCHITECTURAL SYMBOLS INDICATED ON THIS DRAWING ARE GRAPHIC REPRESENTATIONS ONLY.


CONDITIONS FOR ELECTRONIC INFORMATION TRANSFER:

ELECTRONIC INFORMATION IS SUPPLIED TO THE OTHER ASSOCIATED FIRMS TO ASSIST THEM IN THE EXECUTION OF THEIR WORK/REVIEW. THE RECEIVING FIRMS MUST OBTAIN THE COMPREHENSIVE APPROPRIATE RELEVANCE OF THE INFORMATION IN RESPECT TO THEIR PARTICULAR RESPONSIBILITY.

1. ERRORS, OMISSIONS, INADEQUACIES DUE TO LOSS OF INFORMATION IN WHOLE OR PART WHEN INFORMATION IS TRANSFERRED.


2. TRANSMISSION OF ANY VALUE OR CHANGE TO THE RECEIVING ELECTRONIC SYSTEM WHEN INFORMATION IS TRANSFERRED.

01. Aug.02.2019 Issued for tender

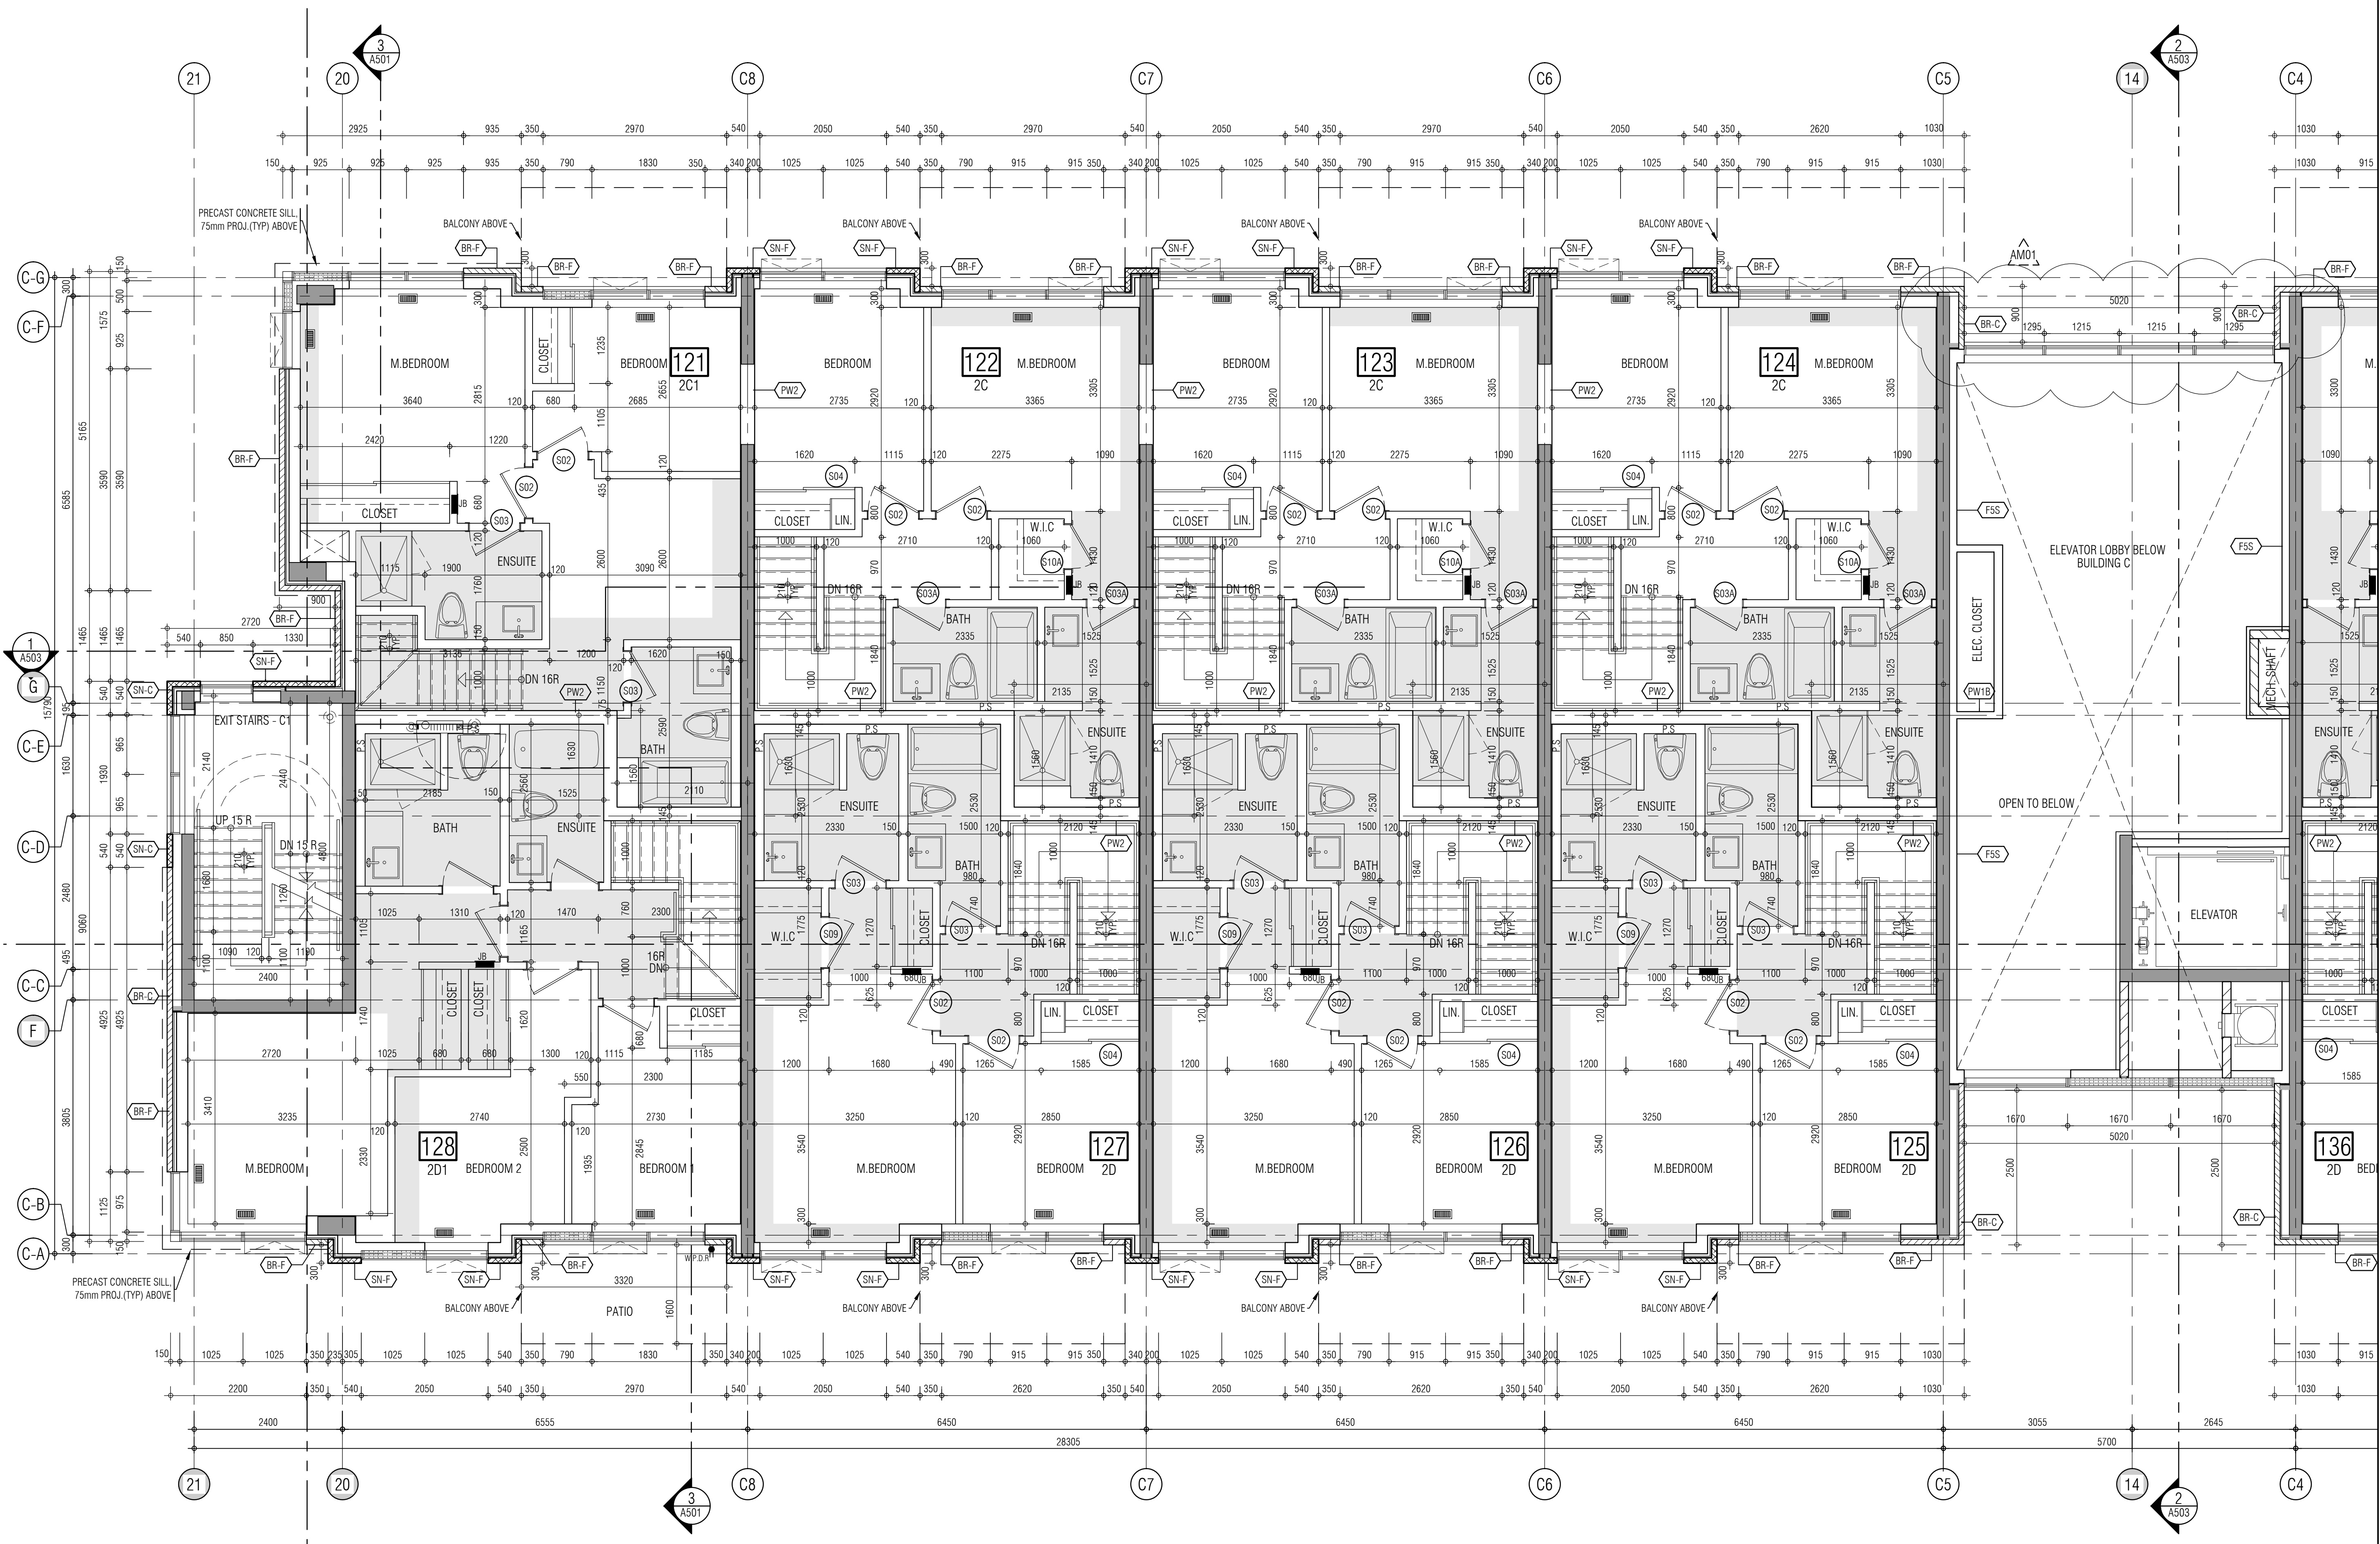

REF.A302c2 FOR CONTINUATION

KEY PLAN

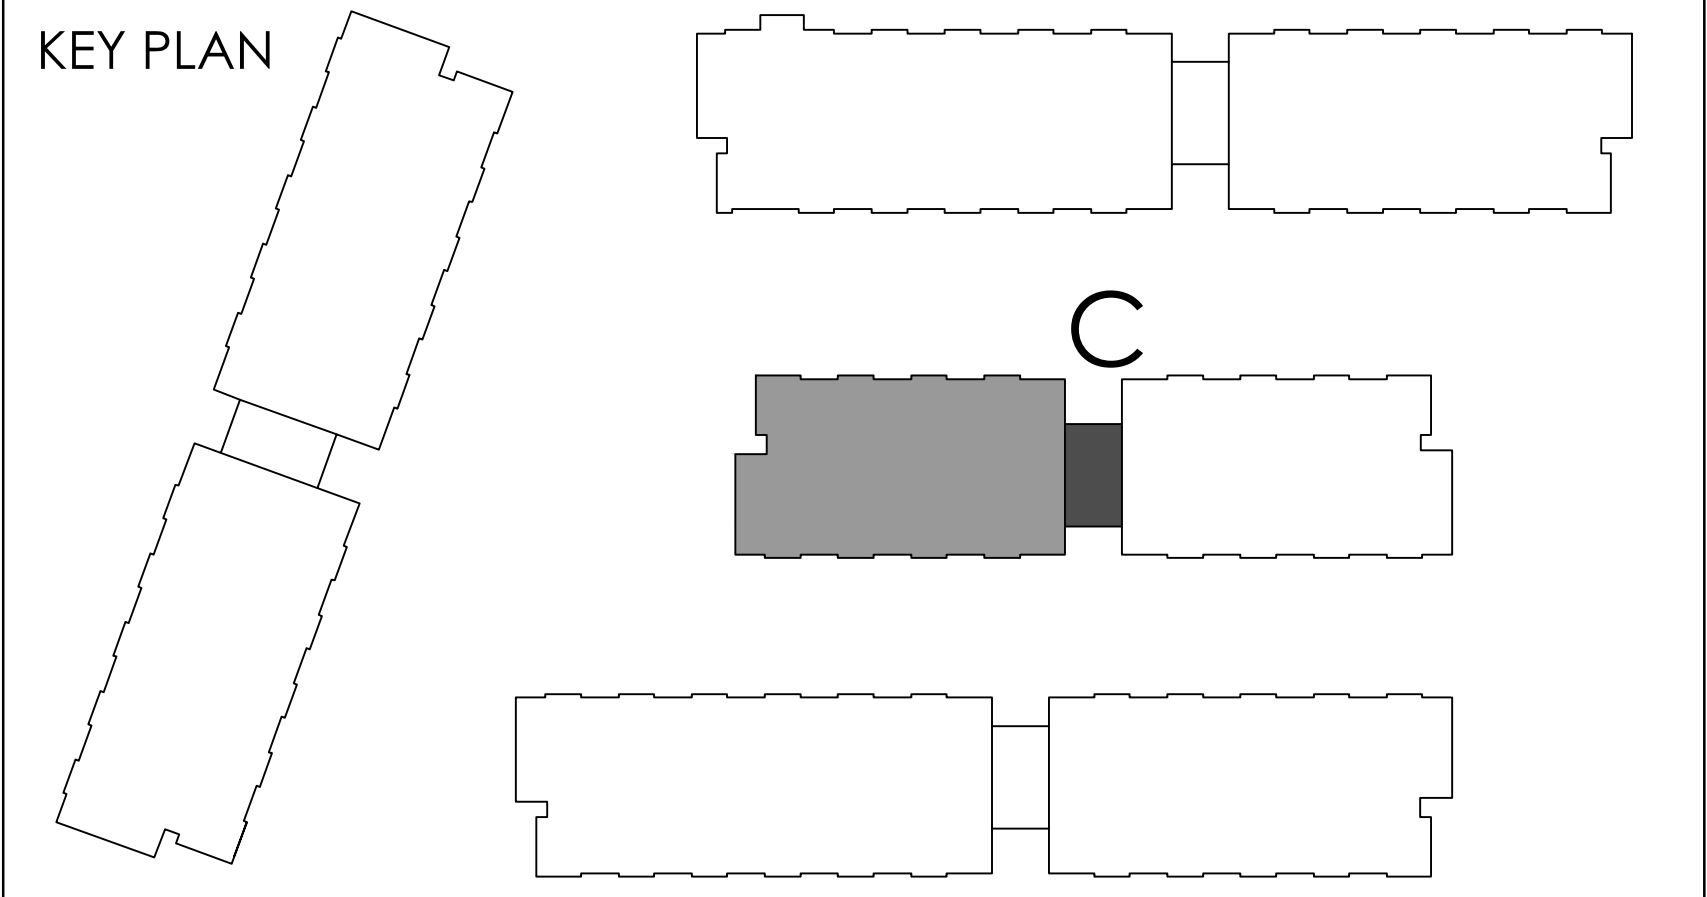

01. SEP.18.2019 Issued for Adendum 1
Issued for revisions

**GRAZIANI
CORAZZANI
ARCHITECTS**

1100 DUNDAS STREET WEST, SUITE 100, MISSISSAUGA, ONTARIO L4V 1G1
(905) 276-2600 F (905) 276-2844 WWW.GC-ARCHITECTS.COM


BRANFTON ATTIMAR + PALLESCHI DRIVE ONTARIO

PROJECT ARCHITECT: B. GRAZIANI
ASSISTANT DESIGNER: R. LINCOLN
DRAWN BY: F.C./M.B.
CHECKED BY: D. BIASI (G. COLANGELO)
PLOT DATE: SEP.18.2019
JOB # 1331.15


**SECOND FLOOR PLAN
BUILDING C (PARTIAL PLAN)**

1:50 A-302c1
TITLEBLOCK SIZE: 915 x 1200

REF. A302c1 FOR CONTINUATION

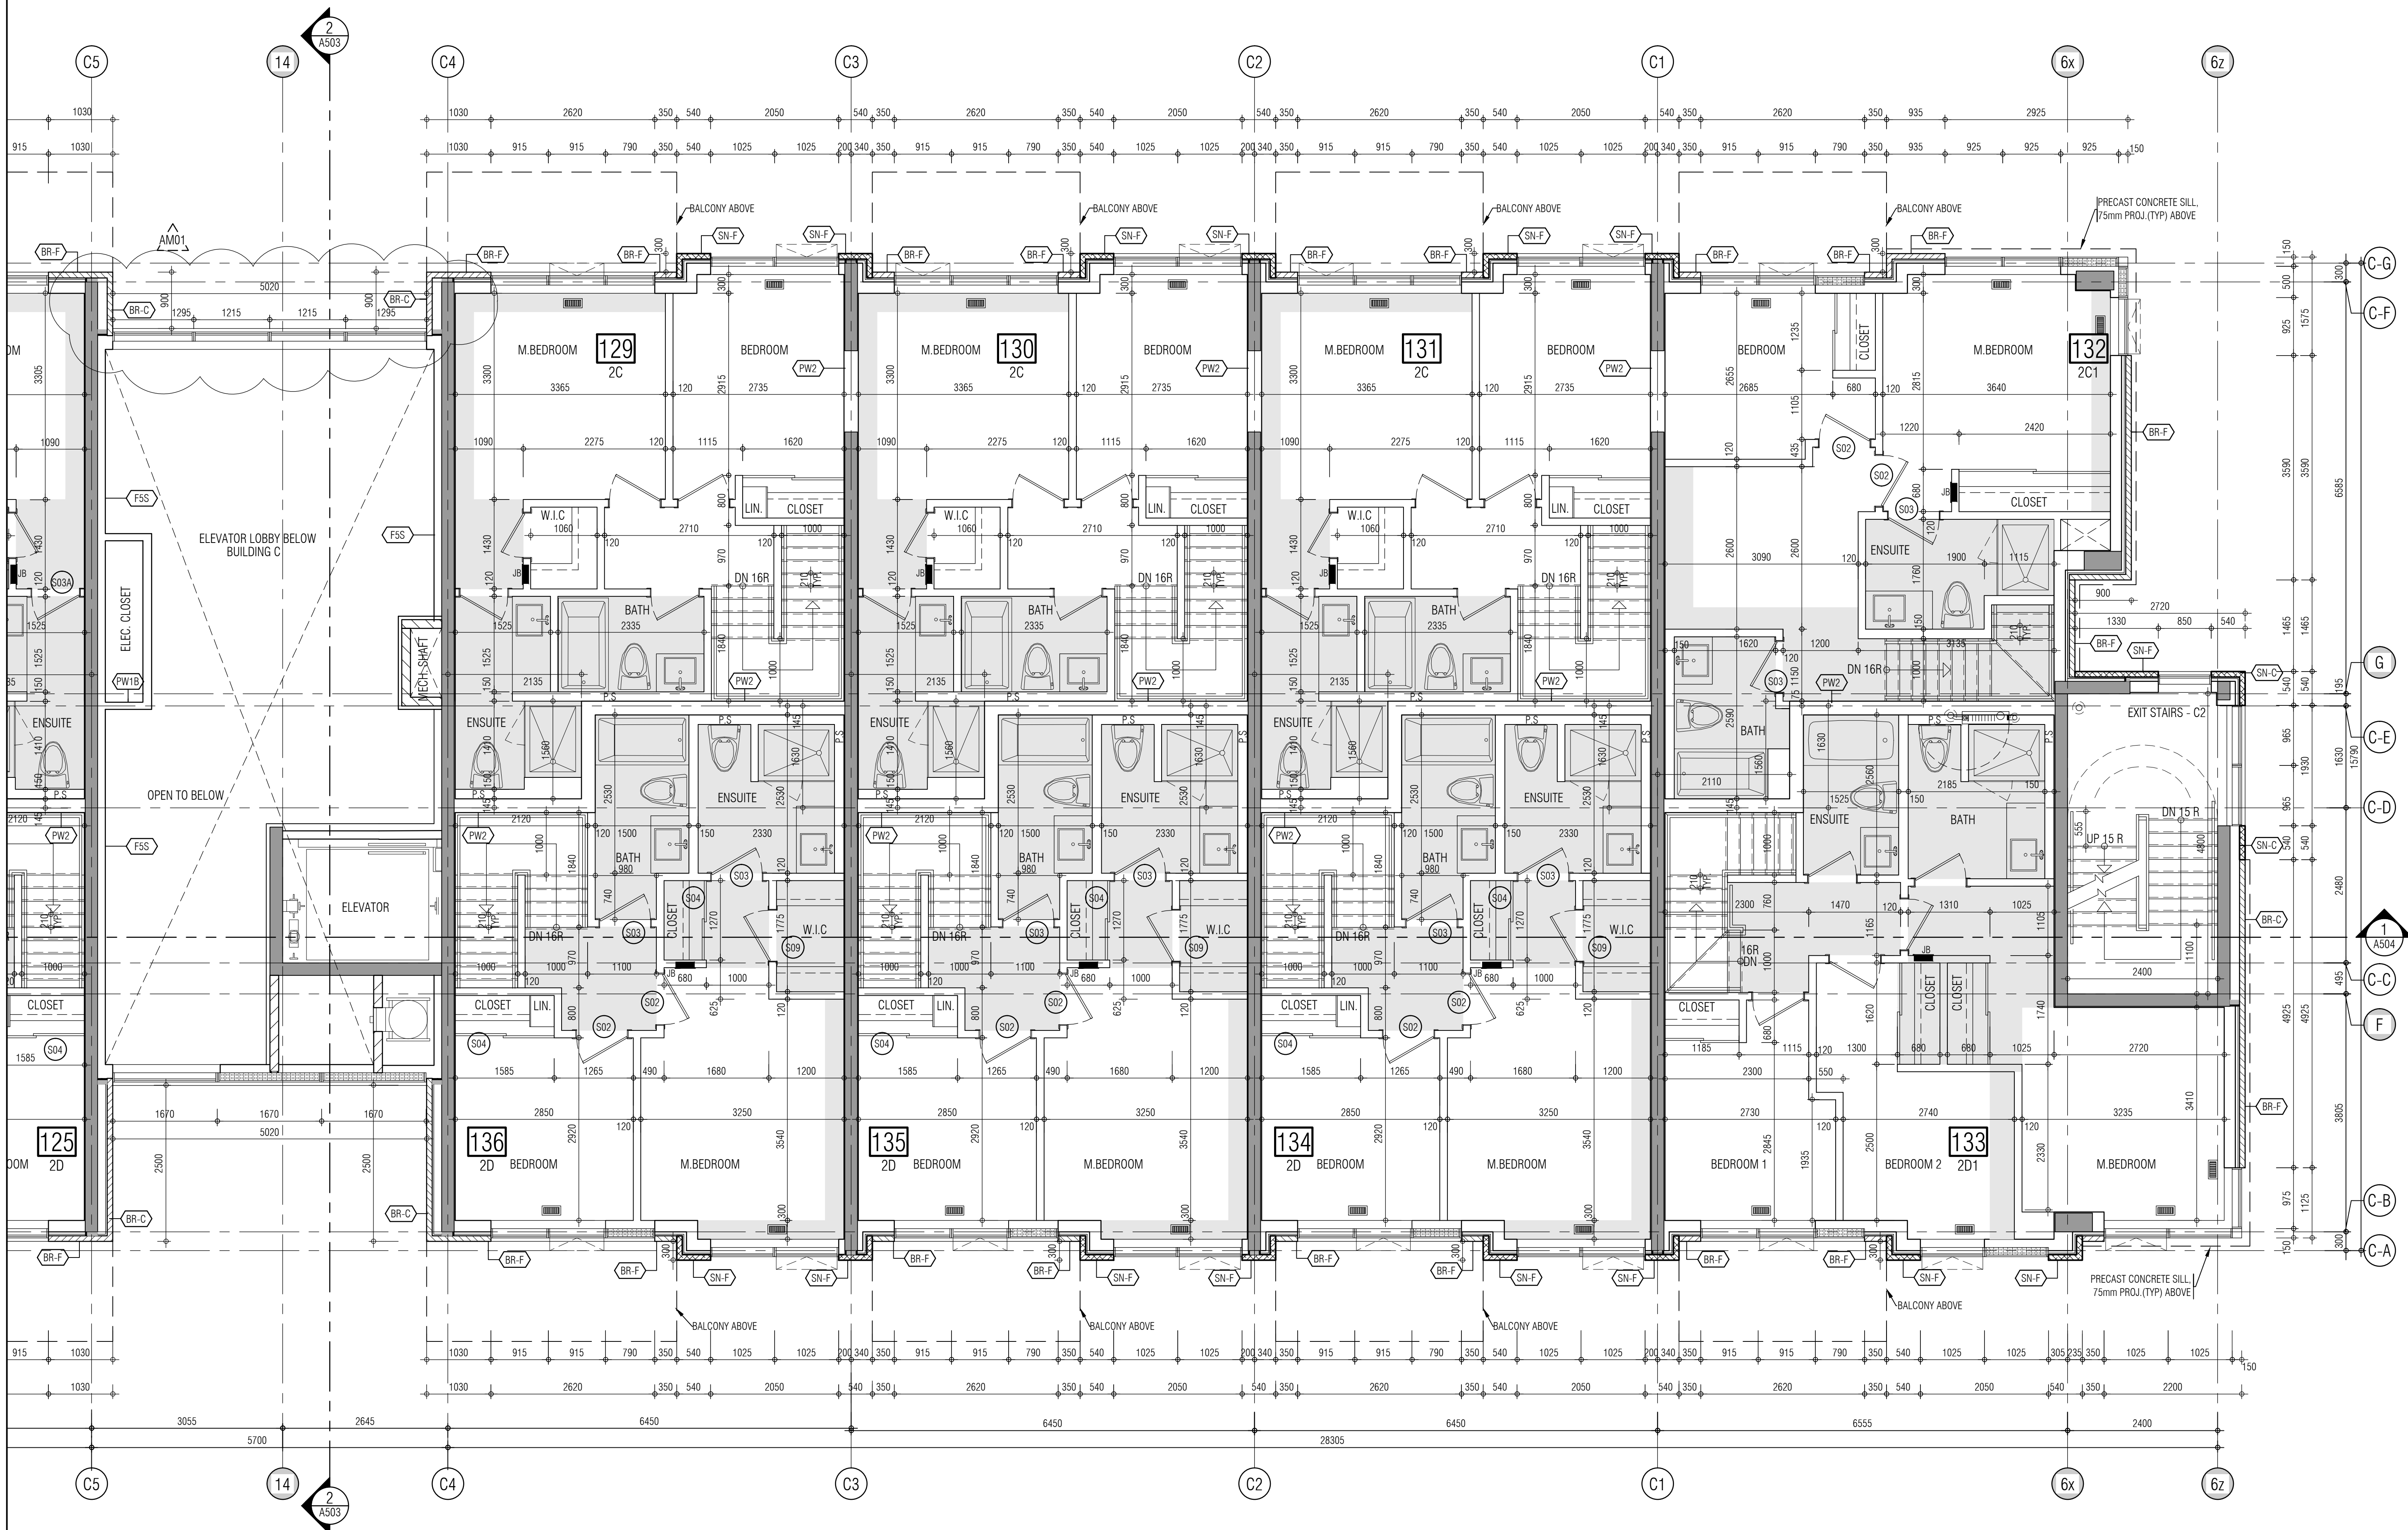

KEY PLAN

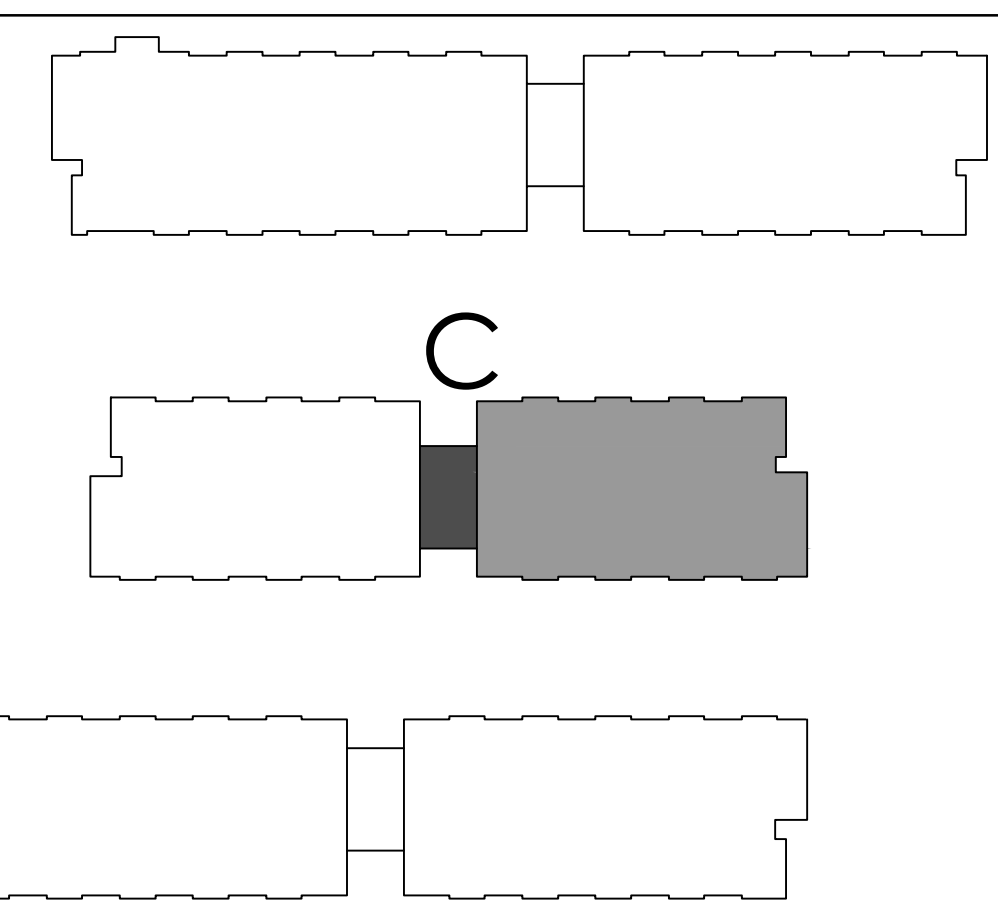

THIS DRAWING, AS AN INSTRUMENT OF SERVICE, IS PROVIDED BY AND IS THE PROPERTY OF GRAZIANI-CORAZIANI ARCHITECTS INC. THE CONTRACTOR MUST VERIFY AND ACCEPT RESPONSIBILITY FOR ALL DIMENSIONS AND CONDITIONS ON SITE AND MUST KEEP GRAZIANI-CORAZIANI ARCHITECTS INC. OF ANY WARRANTIES FROM THE SUPPLIED INFORMATION. GRAZIANI-CORAZIANI ARCHITECTS INC. IS NOT RESPONSIBLE FOR THE ACCURACY OF SURVEY, STRUCTURAL, MECHANICAL, ELECTRICAL, AND OTHER ENGINEERING INFORMATION SHOWN ON THIS DRAWING. REFER TO THE APPROPRIATE ENGINEERING DRAWINGS BEFORE PROCEEDING WITH THE WORK. CONSTRUCTION MUST CONFORM TO ALL APPLICABLE CODES AND REQUIREMENTS OF THE AUTHORITIES HAVING JURISDICTION. DULIS CONSTRUCTION HAS NO INVESTIGATION HAS BEEN UNDERTAKEN OR REPORTED ON BY THE OFFICE IN RELATION TO THE ENVIRONMENTAL CONDITION OF THIS SITE.

THIS DRAWING IS NOT TO BE SCALED. ALL ARCHITECTURAL SYMBOLS INDICATED ON THIS DRAWING ARE GRAPHIC REPRESENTATIONS ONLY.

CONDITIONS FOR ELECTRONIC INFORMATION TRANSFER:

ELECTRONIC INFORMATION IS SUPPLIED TO THE OTHER ASSOCIATED FIRMS TO ASSIST THEM IN THE EXECUTION OF THEIR WORK. REVIEW THE RECIPIENT FIRMS MUST DETERMINE THE COMPLETENESS APPROPRIATENESS RELEVANCE OF THE INFORMATION IN RESPECT TO THEIR PARTICULAR RESPONSIBILITY.

GRAZIANI-CORAZIANI ARCHITECTS INC. SHALL NOT BE RESPONSIBLE FOR:

1. ERRORS, OMISSIONS, INADEQUACIES DUE TO LOSS OF INFORMATION IN WHOLE OR PART WHEN INFORMATION IS TRANSFERRED.
2. TRANSMISSION OF ANY INFO OR CHANGE TO THE RECEIVING ELECTRONIC SYSTEM WHEN INFORMATION IS TRANSFERRED.

01. Aug.02.2019 Issued for tender

01. SEP.18.2019 Issued for Addendum 1

Issued for revisions:

GRAZIANI-CORAZIANI ARCHITECTS

1000 DUNDAS STREET WEST, SUITE 100, MISSISSAUGA, ONTARIO L4X 1G1
TEL: 905.276.2600 FAX: 905.276.2644 WWW.GC-ARCHITECTS.COM

ATTIMAR + PALLESCCHI DRIVE ONTARIO

BRANFORD

PROJECT ARCHITECT: B. GRAZIANI

ASSISTANT DESIGNER: R. LINCOLN

DRAWN BY: F.C./M.B.

CHECKED BY: D. BIASI (G. COLANGELO)

PLOT DATE: SEP.18.2019

JOB #: 1331.15

SECOND FLOOR PLAN
BUILDING C (PARTIAL PLAN)

1:50 A-302c2

TITLEBLOCK SIZE: 915 x 1200

THIS DRAWING, AS AN INSTRUMENT OF SERVICE, IS PROVIDED BY AND IS THE PROPERTY OF GRAZIANI-CORAZZI ARCHITECTS INC. THE CONTRACTOR MUST VERIFY AND ACCEPT RESPONSIBILITY FOR ALL DIMENSIONS AND CONDITIONS ON SITE AND MUST KEEP GRAZIANI-CORAZZI ARCHITECTS INC. OF ANY VARIATIONS FROM THE SUPPLIED INFORMATION. GRAZIANI-CORAZZI ARCHITECTS INC. IS NOT RESPONSIBLE FOR THE ACCURACY OF SURVEY, STRUCTURAL, MECHANICAL, ELECTRICAL, AND OTHER ENGINEERING INFORMATION SHOWN ON THIS DRAWING. REFER TO THE APPROPRIATE ENGINEERING DRAWINGS BEFORE PROCEEDING WITH THE WORK. CONSTRUCTION MUST CONFORM TO ALL APPLICABLE CODES AND REQUIREMENTS OF THE AUTHORITIES HAVING JURISDICTION. ALWAYS CONSULT WITH THE ENGINEER OF RECORD FOR ANY CHANGES TO THE DRAWING. NO INFORMATION BEING REPRODUCED OR TRANSMITTED IN ANY FORM OR BY ANY MEANS, WITHOUT PERMISSION IN WRITING FROM GRAZIANI-CORAZZI ARCHITECTS INC. THIS DRAWING IS NOT TO BE SCALED. ALL ARCHITECTURAL SYMBOLS INDICATED ON THIS DRAWING ARE GRAPHIC REPRESENTATIONS ONLY.


CONDITIONS FOR ELECTRONIC INFORMATION TRANSFER:

ELECTRONIC INFORMATION IS SUPPLIED TO THE OTHER ASSOCIATED PARTS TO ASSIST THEM IN THE EXECUTION OF THEIR WORK. REVIEW THE RECEIPT FORMS MUST DETERMINE THE COMPLETENESS, APPROPRIATENESS, RELEVANCE OF THE INFORMATION IN RESPECT TO THEIR PARTICULAR RESPONSIBILITY.

1. ENGINEERING INFORMATION IS NOT TO BE USED FOR INFORMATION IN WHOLE OR PART WHEN INFORMATION IS TRANSFERRED.


2. TRANSMISSION OF ANY INFO OR CHANGE TO THE RECEIVING ELECTRONIC SYSTEM WHEN INFORMATION IS TRANSFERRED.

01. Aug.02.2019 Issued for tender

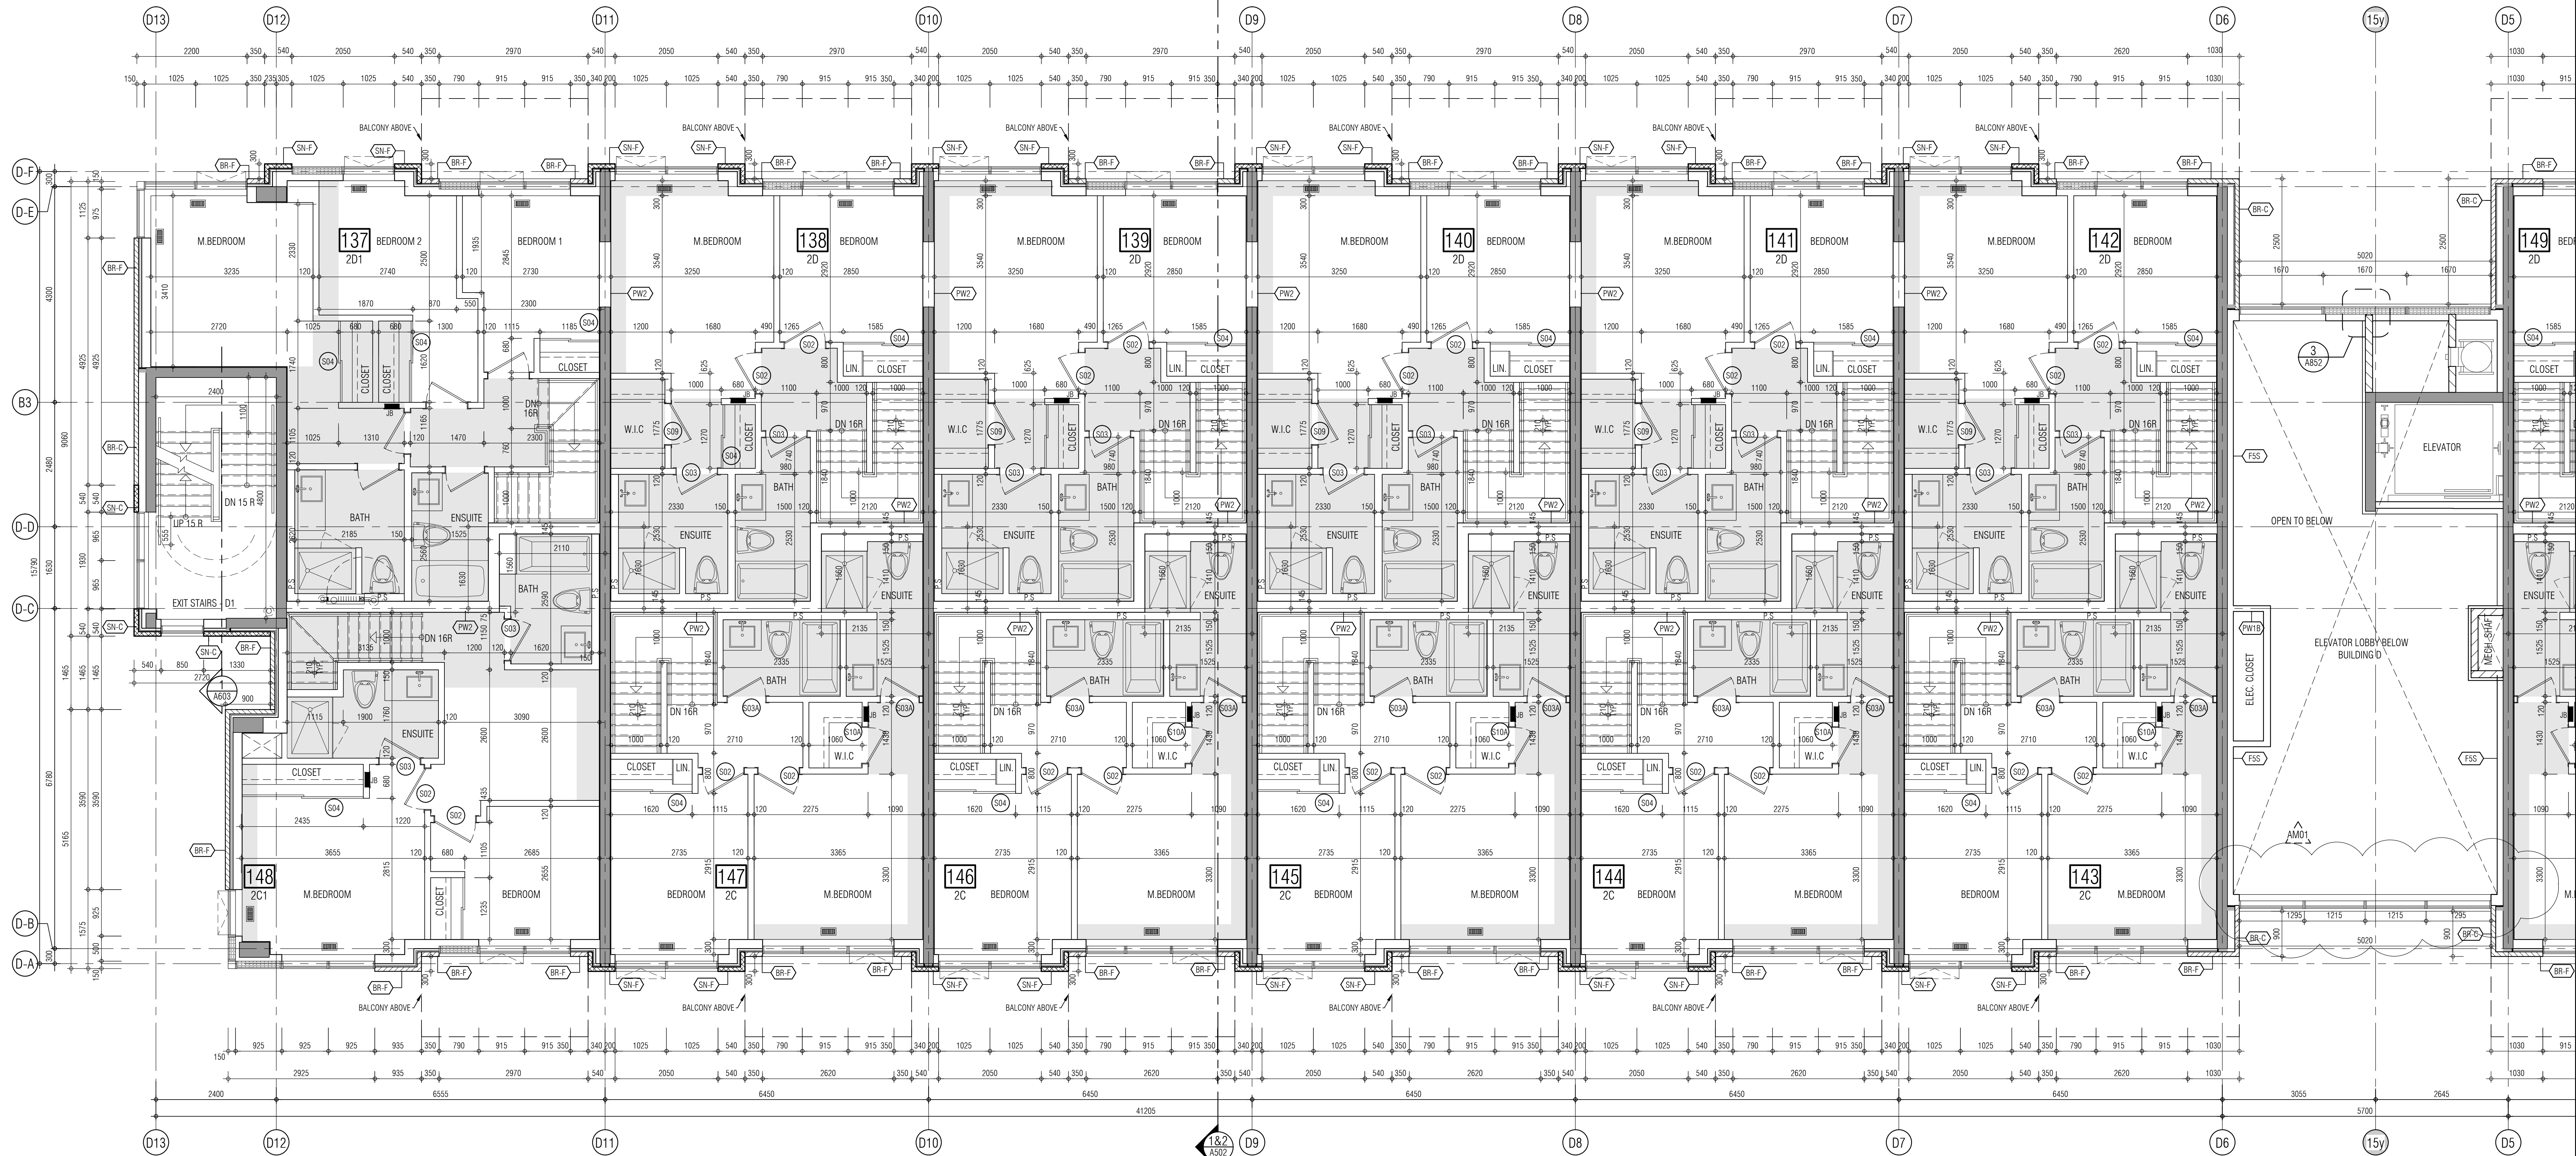

01. SEP.18.2019 Issued for Adendum 1

Issued for revisions:

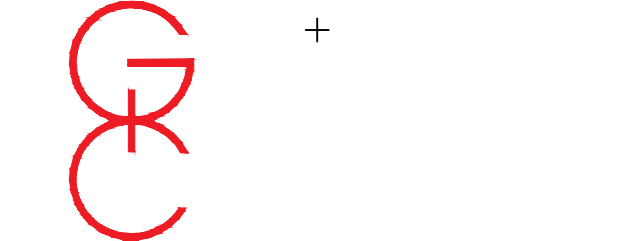

GRAZIANI-CORAZZI ARCHITECTS
1000 SHEPPARD AVENUE EAST, SUITE 100, MISSISSAUGA, ONTARIO L4X 1V3
TEL: 905.276.2600 FAX: 905.276.2644 WWW.GC-ARCHITECTS.COM

RESIDENTIAL

ATTMIR + PALLESCHI DRIVE ONTARIO


PROJECT ARCHITECT: B. GRAZIANI
ASSISTANT DESIGNER: R. LINCOLN
DRAWN BY: F.C./M.B.
CHECKED BY: D. BIASE (G. COLANGELO)
PLOT DATE: SEP.18.2019
JOB #: 1331.15

**SECOND FLOOR PLAN
BUILDING D (PARTIAL PLAN)**

1:50 A-302d1

TITLE BLOCK SIZE: 915 x 1200

REF-A302d1 FOR CONTINUATION

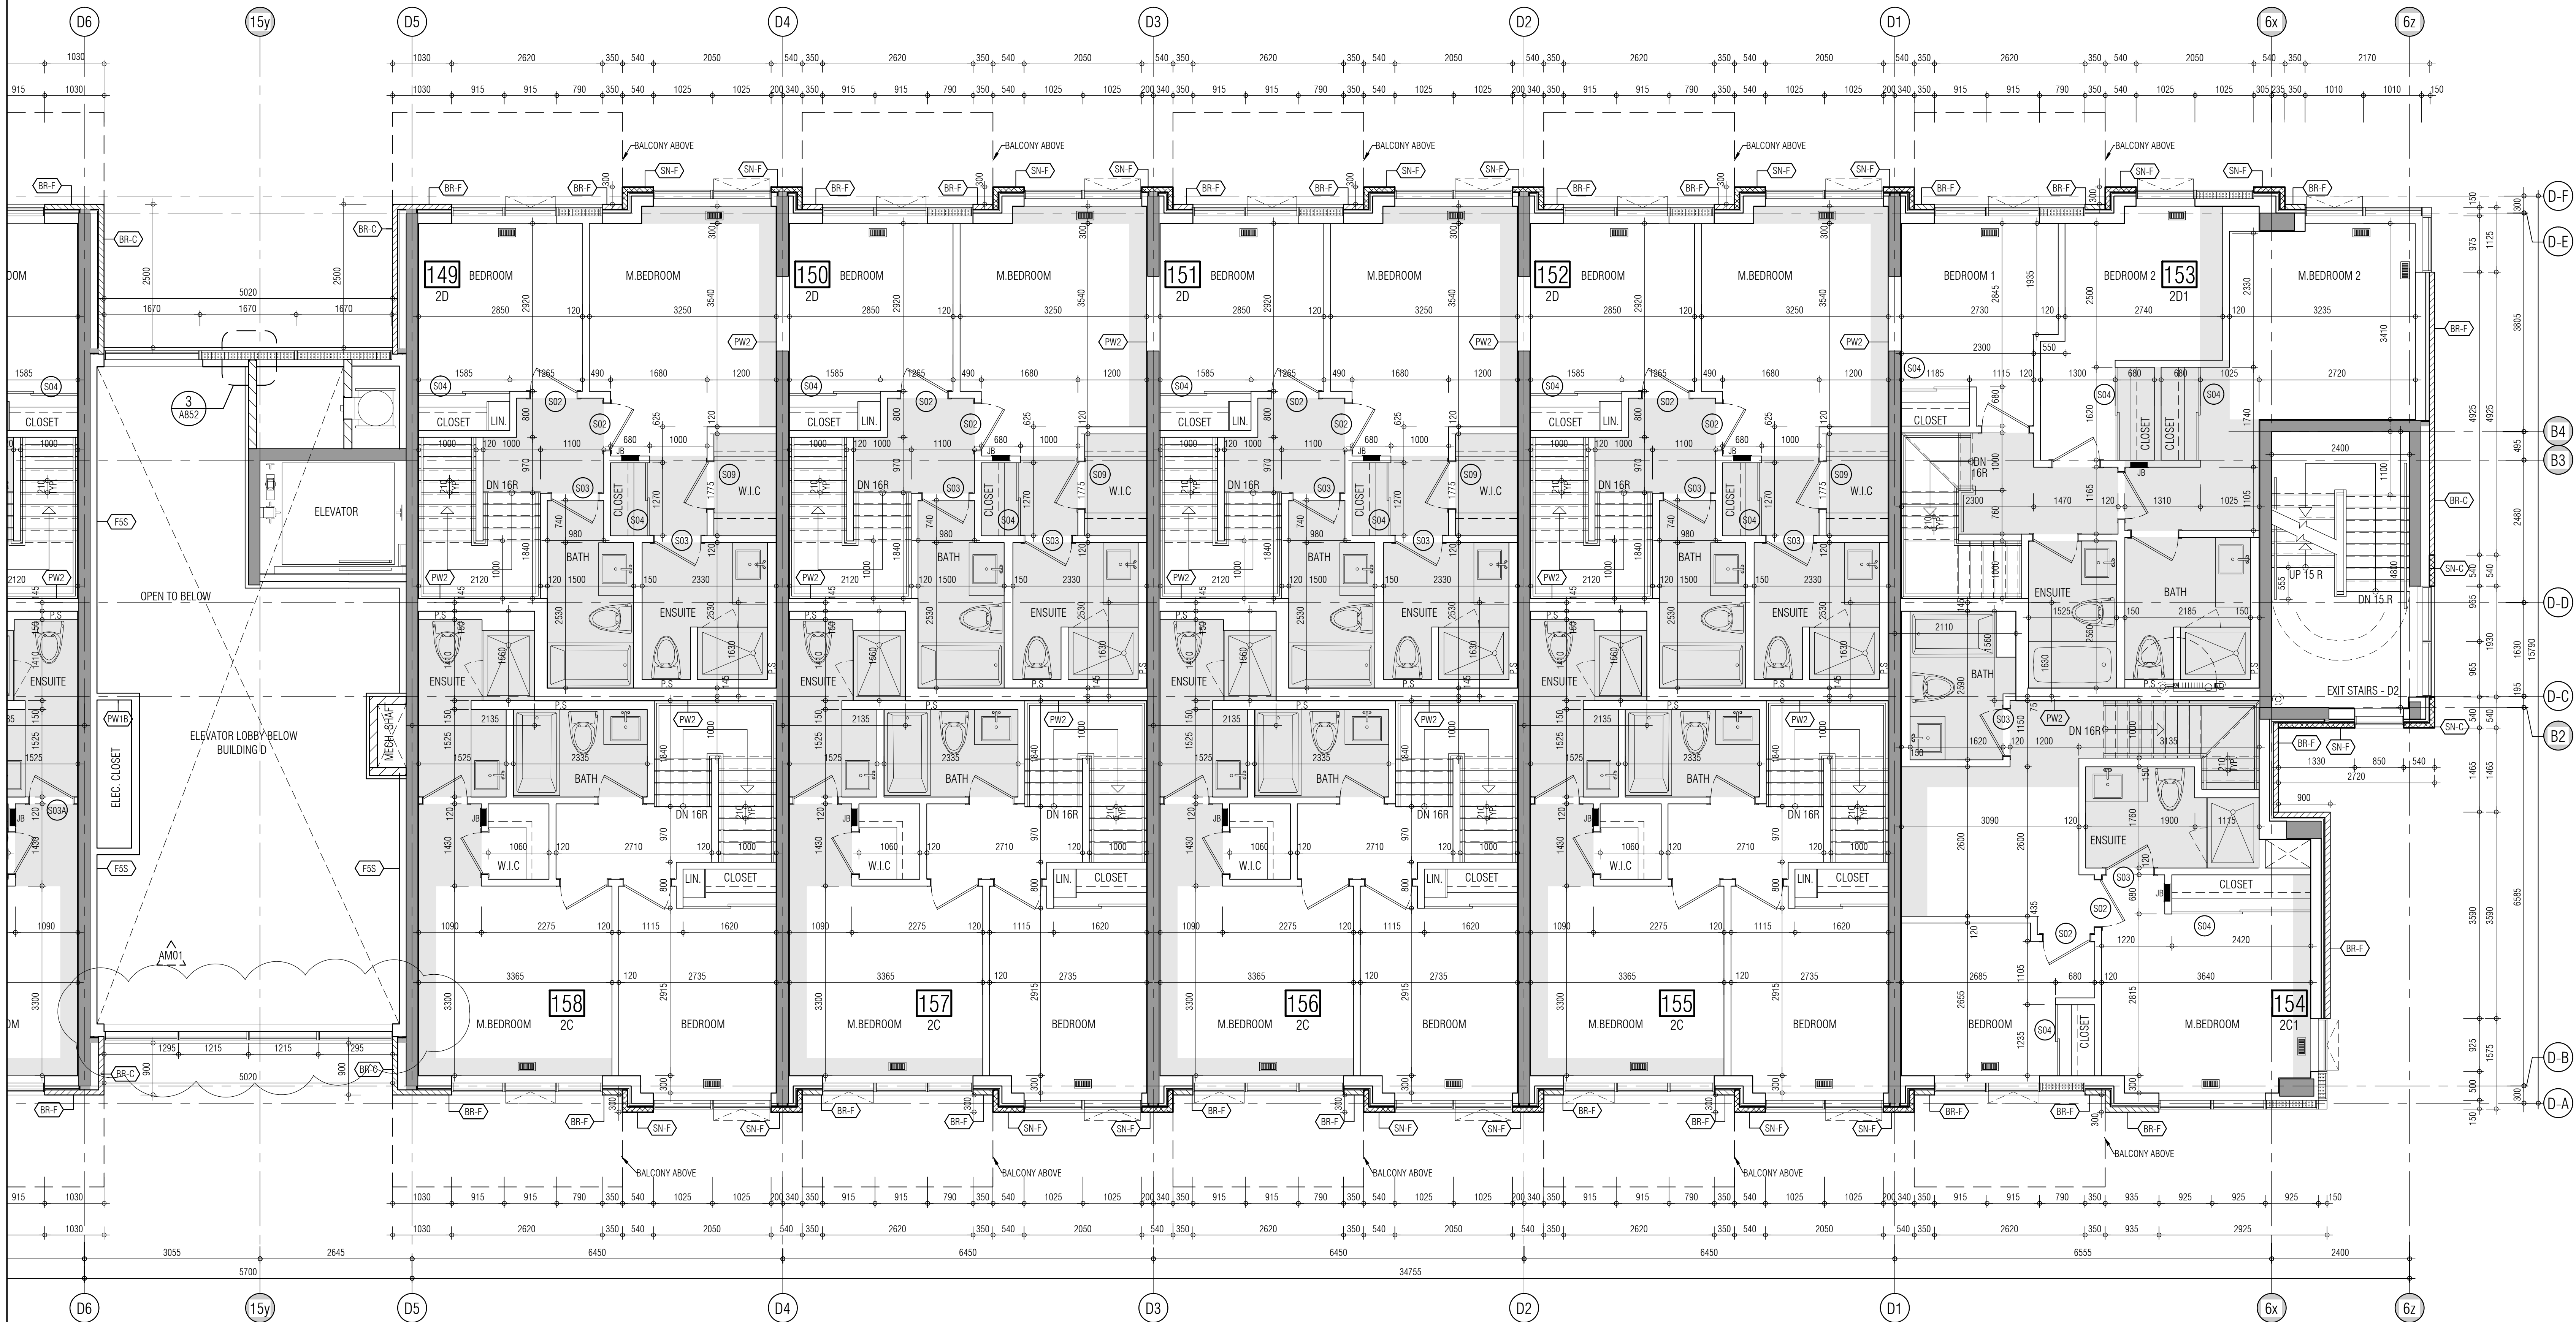

KEY PLAN

THIS DRAWING, AS AN INSTRUMENT OF SERVICE, IS PROVIDED BY AND IS THE PROPERTY OF GRAZIANI-CORAZZANI ARCHITECTS INC. THE CONTRACTOR MUST VERIFY AND ACCEPT RESPONSIBILITY FOR ALL DIMENSIONS AND CONDITIONS ON SITE AND MUST KEEP GRAZIANI-CORAZZANI ARCHITECTS INC. OF ANY VARIATIONS FROM THE SUPPLIED INFORMATION. GRAZIANI-CORAZZANI ARCHITECTS INC. IS NOT RESPONSIBLE FOR THE ACCURACY OF SURVEY, STRUCTURAL, MECHANICAL, ELECTRICAL, AND OTHER ENGINEERING INFORMATION SHOWN ON THIS DRAWING. REFER TO THE APPROPRIATE ENGINEERING DRAWINGS BEFORE PROCEEDING WITH THE WORK. CONSTRUCTION MUST CONFORM TO ALL APPLICABLE CODES AND REQUIREMENTS OF THE AUTHORITIES HAVING JURISDICTION. DULYS CONSTRUCTION HAS BEEN ADVISED THAT THIS DRAWING HAS BEEN APPROVED OR REPORTED ON BY THE OFFICE IN RESPECT TO THE ENVIRONMENTAL CONDITION OF THIS SITE.

THIS DRAWING IS NOT TO BE SCALED. ALL ARCHITECTURAL SYMBOLS INDICATED ON THIS DRAWING ARE GRAPHIC REPRESENTATIONS ONLY.

CONDITIONS FOR ELECTRONIC INFORMATION TRANSFER:

ELECTRONIC INFORMATION IS SUPPLIED TO THE OTHER ASSOCIATED FIRMS TO ASSIST THEM IN THE EXECUTION OF THEIR WORK/REVENUE. THE RECEIVING FIRMS MUST OBTAIN THE CORRESPONDING APPROPRIATE RELEVANCE OF THE INFORMATION IN RESPECT TO THEIR PARTICULAR RESPONSIBILITY.

GRAZIANI-CORAZZANI ARCHITECTS INC. SHALL NOT BE RESPONSIBLE FOR:

1. ERRORS, OMISSIONS, INADEQUACIES DUE TO USE OF INFORMATION IN WHOLE OR PART WHEN INFORMATION IS TRANSFERRED.
2. TRANSMISSION OF ANY INFO OR CHANGE TO THE RECEIVING ELECTRONIC SYSTEM WHEN INFORMATION IS TRANSFERRED.

01. Aug 02 2019 Issued for tender

01. SEP 18, 2019 Issued for Adendum 1

Issued for revisions:

GRAZIANI-CORAZZANI ARCHITECTS

1000 SHEPPARD AVENUE EAST, SUITE 100, MISSISSAUGA, ONTARIO L4X 1V3
TEL: 905-276-2000 FAX: 905-276-2844 WWW.GC-ARCHITECTS.COM

PROJECT ARCHITECT: B. GRAZIANI
ASSISTANT DESIGNER: R. LINCOLN
DRAWN BY: F.C./M.B.
CHECKED BY: D. BIASE/G. COLANGELO
PLOT DATE: SEP 18, 2019
JOB # 1331.15

SECOND FLOOR PLAN
BUILDING D (PARTIAL PLAN)

1:50 A-302d2
TITLE BLOCK SIZE: 915 x 1200

THIS DRAWING, AS AN INSTRUMENT OF SERVICE, IS PROVIDED BY AND IS THE PROPERTY OF GRAZIANI-CORAZZANI ARCHITECTS INC. THE CONTRACTOR MUST VERIFY AND ACCEPT RESPONSIBILITY FOR ALL DIMENSIONS AND CONDITIONS ON SITE AND MUST KEEP GRAZIANI-CORAZZANI ARCHITECTS INC. OF ANY VARIATIONS FROM THE SUPPLIED INFORMATION. GRAZIANI-CORAZZANI ARCHITECTS INC. IS NOT RESPONSIBLE FOR THE ACCURACY OF SURVEY, STRUCTURAL, MECHANICAL, ELECTRICAL, AND OTHER ENGINEERING INFORMATION SHOWN ON THIS DRAWING. REFER TO THE APPROPRIATE ENGINEERING DRAWINGS BEFORE PROCEEDING WITH THE WORK. CONSTRUCTION MUST CONFORM TO ALL APPLICABLE CODES AND REQUIREMENTS OF THE AUTHORITIES HAVING JURISDICTION. DURING CONSTRUCTION, NO INVESTIGATION HAS BEEN UNDERTAKEN OR REPORTED ON BY THE OFFICE IN RELATION TO THE ENVIRONMENTAL CONDITION OF THIS SITE.

THIS DRAWING IS NOT TO BE SCALED. ALL ARCHITECTURAL SYMBOLS INDICATED ON THIS DRAWING ARE GRAPHIC REPRESENTATIONS ONLY.

CONDITIONS FOR ELECTRONIC INFORMATION TRANSFER:


ELECTRONIC INFORMATION IS SUPPLIED TO THE OTHER ASSOCIATED FIRMS TO ASSIST THEM IN THE EXECUTION OF THEIR WORK. REVIEW THE RECIPIENT FIRMS MUST DETERMINE THE COMPLETENESS, APPROPRIATENESS, RELEVANCE OF THE INFORMATION IN RESPECT TO THEIR PARTICULAR RESPONSIBILITY.

1. OTHER ENGINEERING INFORMATION DUE TO USE OF INFORMATION IN WHOLE OR PART WHEN INFORMATION IS TRANSFERRED.

2. TRANSMISSION OF ANY INFO OR CHANGE TO THE RECEIVING ELECTRONIC SYSTEM WHEN INFORMATION IS TRANSFERRED.

01. Aug 02, 2019 Issued for tender

REF A303a2 FOR CONTINUATION

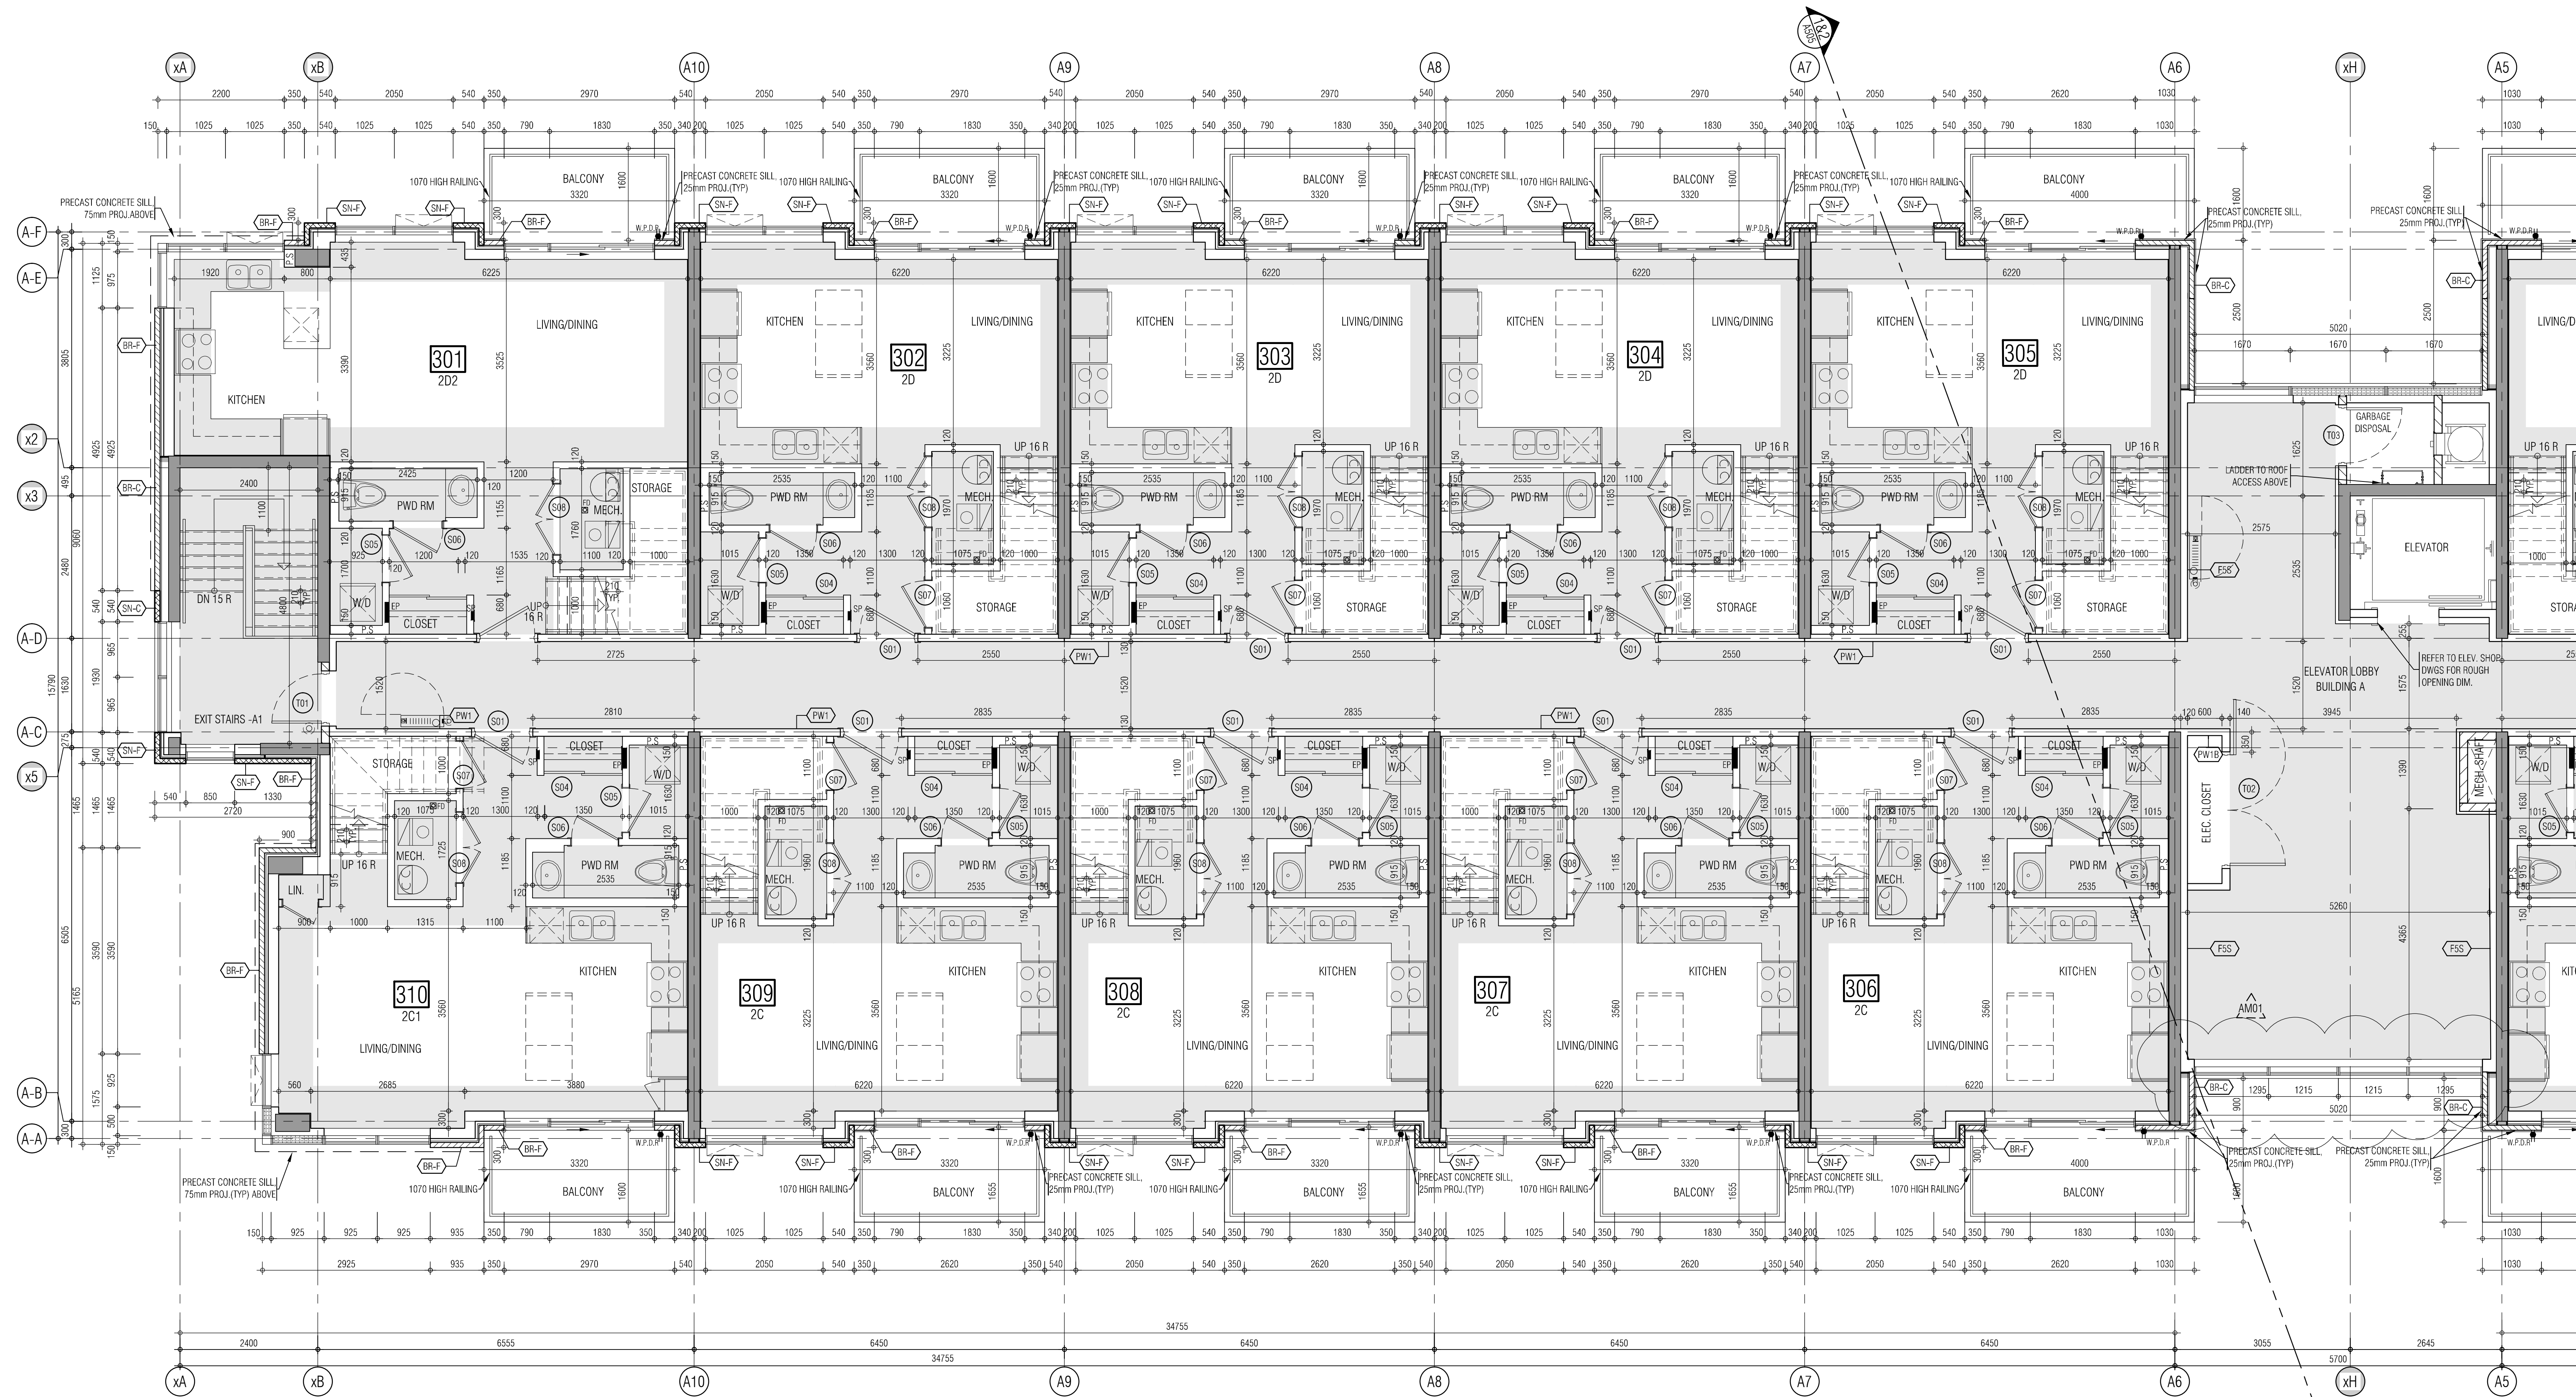

01. SEP 18, 2019 Issued for Addendum 1

Issued for revisions:

+

**GRAZIANI
CORAZZANI
ARCHITECTS**

1100 SHEPPARD AVENUE, SUITE 100 MISSISSAUGA, ONTARIO L4W 1G1
(905) 276-2600 F: (905) 276-2644 WWW.GC-ARCHITECTS.COM

RESIDENTIAL

ATTIMAR + PALLESCIO DRIVE


BRAMPTON ONTARIO

PROJECT ARCHITECT: B. GRAZIANI
ASSISTANT DESIGNER: R. LINCOLN
DRAWN BY: F.C./M.B.
CHECKED BY: D. BIASI (G. COLANGELO)
PLOT DATE: SEP 18, 2019
JOB #: 1331.15

**THIRD FLOOR PLAN
BUILDING A (PARTIAL PLAN)**

1:50 A-303a1

TITLE BLOCK SIZE: 915 x 1200

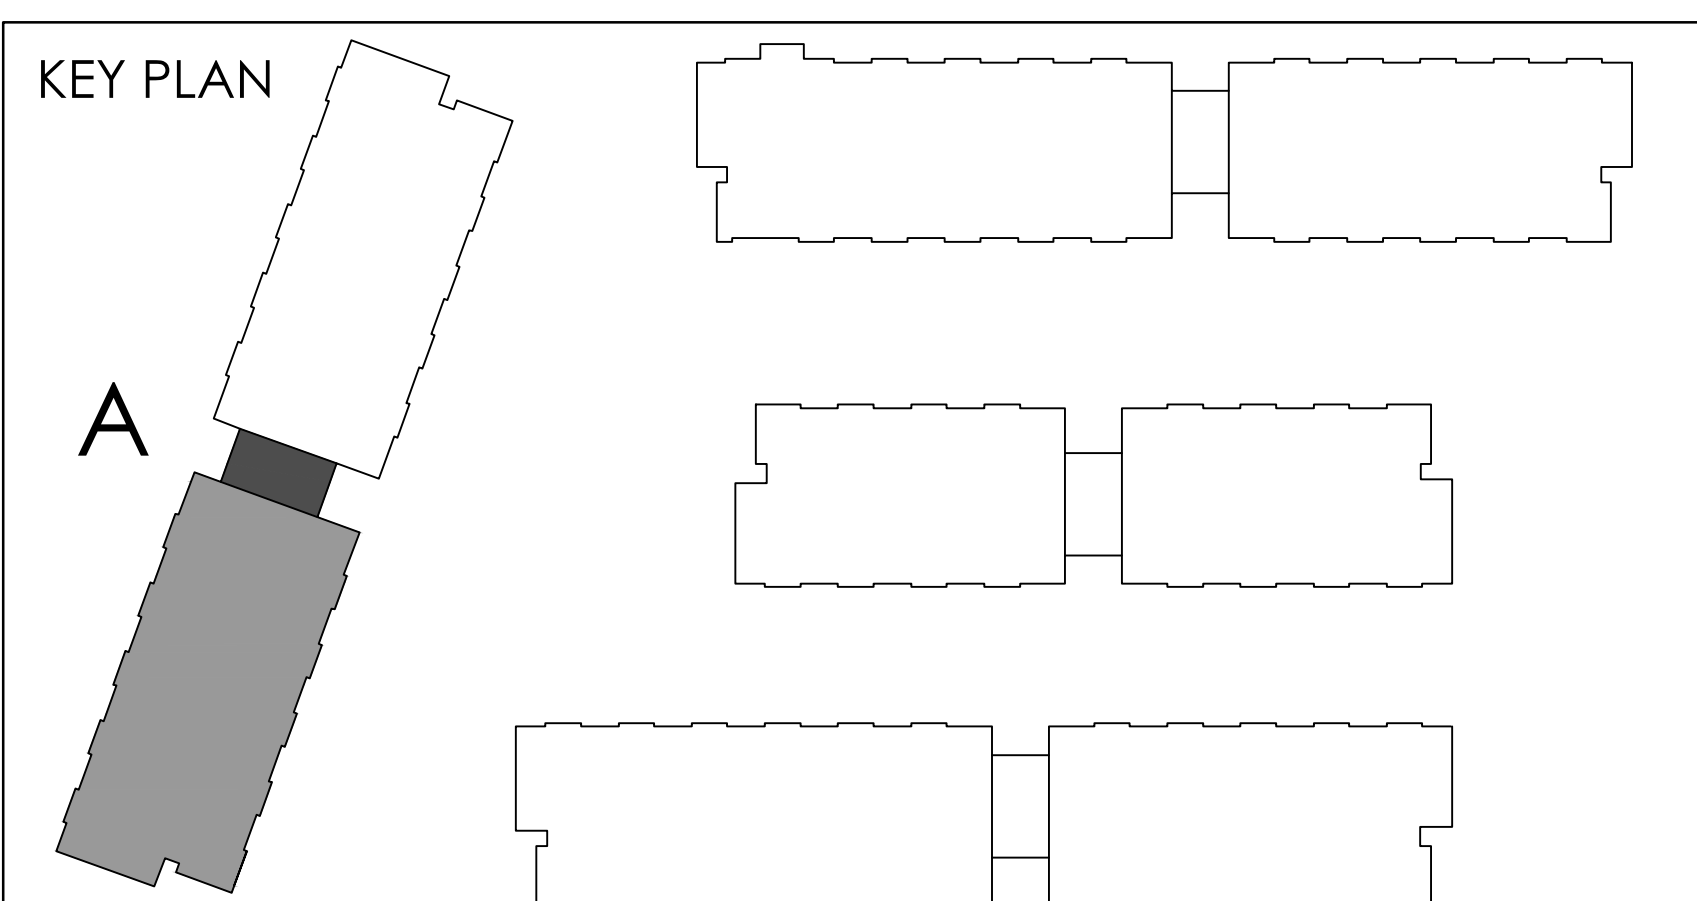


REF. A303a1 FOR CONTINUATION

THIS DRAWING, AS AN INSTRUMENT OF SERVICE, IS PROVIDED BY AND IS THE PROPERTY OF GRAZIANI-CORAZZA ARCHITECTS INC. THE CONTRACTOR MUST VERIFY AND ACCEPT RESPONSIBILITY FOR ALL DIMENSIONS AND CONDITIONS ON SITE AND MUST KEEP GRAZIANI-CORAZZA ARCHITECTS INC. OF ANY VARIATIONS FROM THE SUPPLIED INFORMATION. GRAZIANI-CORAZZA ARCHITECTS INC. IS NOT RESPONSIBLE FOR THE ACCURACY OF SURVEY, STRUCTURAL, MECHANICAL, ELECTRICAL, AND OTHER ENGINEERING INFORMATION SHOWN ON THIS DRAWING. REFER TO THE APPROPRIATE ENGINEERING DRAWINGS BEFORE PROCEEDING WITH THE WORK. CONSTRUCTION MUST CONFORM TO ALL APPLICABLE CODES AND REQUIREMENTS OF THE AUTHORITIES HAVING JURISDICTION. DURING CONSTRUCTION, NO INVESTIGATION HAS BEEN UNDERTAKEN OR REPORTED ON BY THE OFFICE IN RELATION TO THE ENVIRONMENTAL CONDITION OF THIS SITE. THIS DRAWING IS NOT TO BE SCALED. ALL ARCHITECTURAL SYMBOLS INDICATED ON THIS DRAWING ARE GRAPHIC REPRESENTATIONS ONLY. CONDITIONS FOR ELECTRONIC INFORMATION TRANSFER: ELECTRONIC INFORMATION IS SUPPLIED TO THE OTHER ASSOCIATED FIRMS TO ASSIST THEM IN THE EXECUTION OF THEIR WORK. REVERA, THE RECIPIENT FIRMS MUST OBTAIN THE COMPLETED APPROPRIATE RELEVANCE OF THE INFORMATION IN RESPECT TO THEIR PARTICULAR RESPONSIBILITY. GRAZIANI-CORAZZA ARCHITECTS INC. SHALL NOT BE RESPONSIBLE FOR: 1. ERRORS, OMISSIONS, INADEQUACIES DUE TO USE OF INFORMATION IN WHOLE OR PART WHEN INFORMATION IS TRANSFERRED. 2. TRANSMISSION OF ANY VALUE OF CHANGE TO THE RECEIVING ELECTRONIC SYSTEM WHEN INFORMATION IS TRANSFERRED.

01. Aug 02, 2019 Issued for tender

01. SEP 18, 2019 Issued for Addendum 1

Issued for revisions:

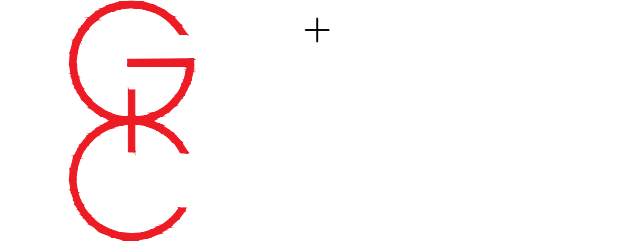

GRAZIANI-CORAZZA ARCHITECTS
1000 DUNDAS STREET WEST, SUITE 100, MISSISSAUGA, ONTARIO L4W 1C3
TEL: 905.276.2600 FAX: 905.276.2644 WWW.GC-ARCHITECTS.COM

RESIDENTIAL
ATTIMAR + PALLESCHE DRIVE
ONTARIO


PROJECT ARCHITECT: B. GRAZIANI
ASSISTANT DESIGNER: R. LINCOLN
DRAWN BY: F.C./M.B.
CHECKED BY: D. BIASI (G. COLANGELO)
PLOT DATE: SEP 18, 2019
JOB #: 1331.15

**THIRD FLOOR PLAN
BUILDING A (PARTIAL PLAN)**

1:50
A-303a2
TITLED BLOCK SIZE: 915 x 1200



KEY PLAN

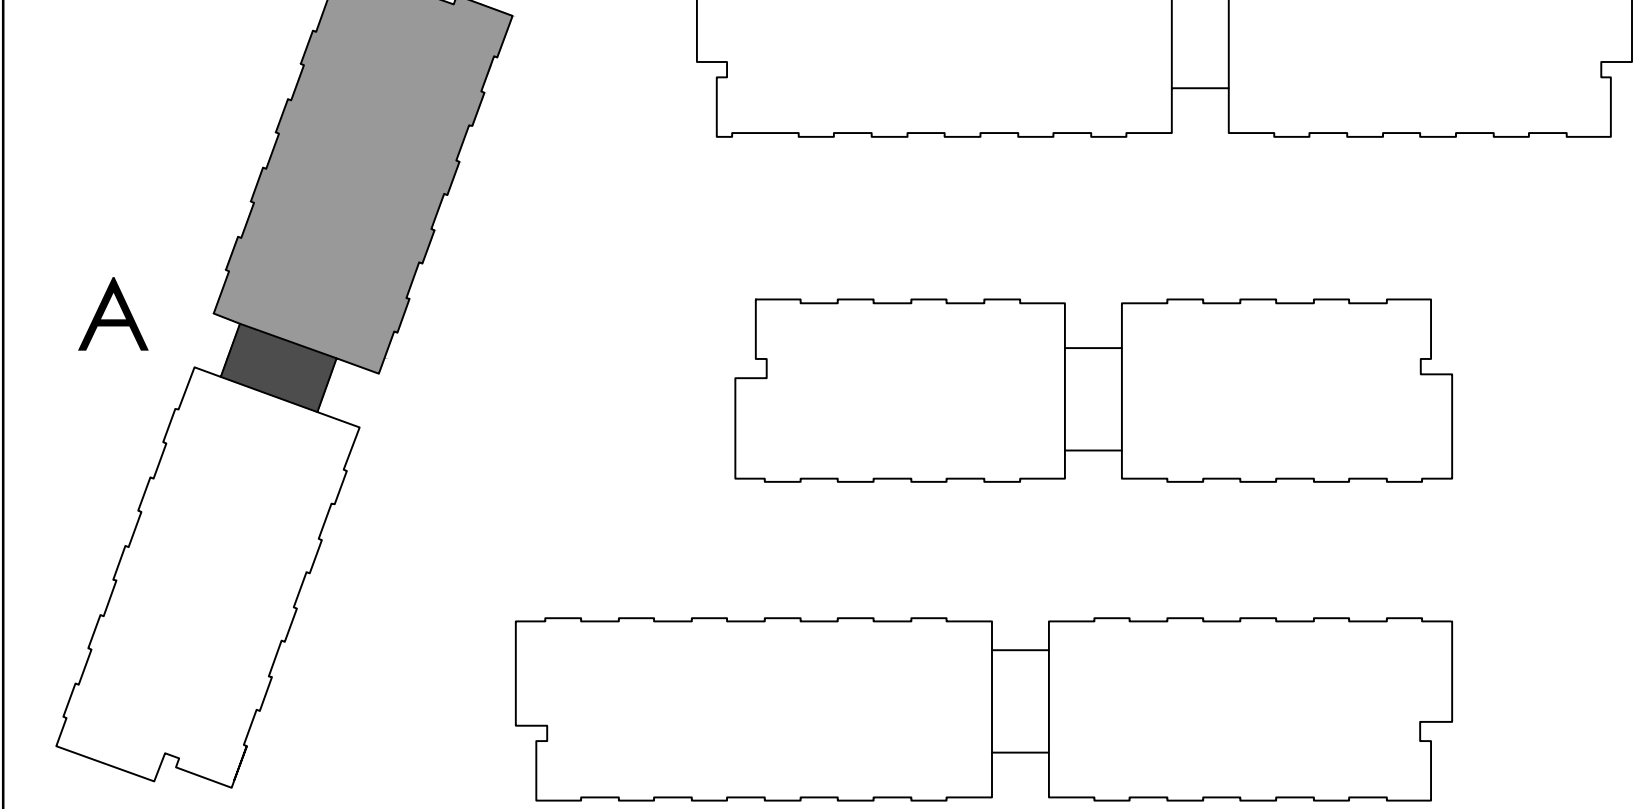

THIS DRAWING, AS AN INSTRUMENT OF SERVICE, IS PROVIDED BY AND IS THE PROPERTY OF GRAZIANI-CORAZZA ARCHITECTS INC. THE CONTRACTOR MUST VERIFY AND ACCEPT RESPONSIBILITY FOR ALL DIMENSIONS AND CONDITIONS ON SITE AND MUST KEEP GRAZIANI-CORAZZA ARCHITECTS INC. OF ANY VARIATIONS FROM THE SUPPLIED INFORMATION. GRAZIANI-CORAZZA ARCHITECTS INC. IS NOT RESPONSIBLE FOR THE ACCURACY OF SURVEY, STRUCTURAL, MECHANICAL, ELECTRICAL, AND OTHER ENGINEERING INFORMATION SHOWN ON THIS DRAWING. REFER TO THE APPROPRIATE ENGINEERING DRAWINGS BEFORE PROCEEDING WITH THE WORK. CONSTRUCTION MUST CONFORM TO ALL APPLICABLE CODES AND REQUIREMENTS OF THE AUTHORITIES HAVING JURISDICTION. ALWAYS CONSULT WITH THE APPROPRIATE ENGINEERING PROFESSIONAL BEFORE PROCEEDING WITH THE WORK. NO INTERPRETATION HAS BEEN UNDERTAKEN OR REPORTED ON BY THE OFFICE IN RELATION TO THE DIMENSIONS, CONDITIONS OF THIS SITE.

THIS DRAWING IS NOT TO BE SCALED. ALL ARCHITECTURAL SYMBOLS INDICATED ON THIS DRAWING ARE GRAPHIC REPRESENTATIONS ONLY.

CONDITIONS FOR ELECTRONIC INFORMATION TRANSFER:

ELECTRONIC INFORMATION IS SUPPLIED TO THE OTHER ASSOCIATED FIRMS TO ASSIST THEM IN THE EXECUTION OF THEIR WORK. REVIEW THE RECEIPT FIRMS MUST DETERMINE THE COMPLETENESS APPROPRIATENESS RELEVANCE OF THE INFORMATION IN RESPECT TO THEIR PARTICULAR RESPONSIBILITY.

1. ERRORS, OMISSIONS, INADEQUACIES DUE TO LOSS OF INFORMATION IN WHOLE OR PART WHEN INFORMATION IS TRANSFERRED.

2. TRANSMISSION OF ANY INFO OR CHANGE TO THE RECEIVING ELECTRONIC SYSTEM WHEN INFORMATION IS TRANSFERRED.


01. Aug.02.2019 Issued for tender

REF. A303d2 FOR CONTINUATION



01. SEP.18.2019 Issued for Addendum 1

Issued for revisions:

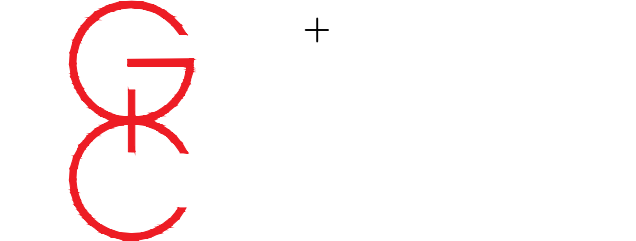

GRAZIANI-CORAZZA ARCHITECTS
1100 DAVENPORT DRIVE, SUITE 100, MISSISSAUGA, ONTARIO L4V 1G3
(905) 276-2600 F: (905) 276-2644 WWW.GC-ARCHITECTS.COM

RESIDENTIAL


BRAMPTON ATTAR + PALLESCHI DRIVE ONTARIO

PROJECT ARCHITECT: B. GRAZIANI
ASSISTANT DESIGNER: R. LINCOLN
DRAWN BY: F.C./M.B.
CHECKED BY: D. BIASI (G. COLANGELO)
PLOT DATE: SEP. 18. 2019
JOB #: 1331.15

**THIRD FLOOR PLAN
BUILDING D (PARTIAL PLAN)**

1:50 A-303d1


TITLE BLOCK SIZE: 915 x 1200

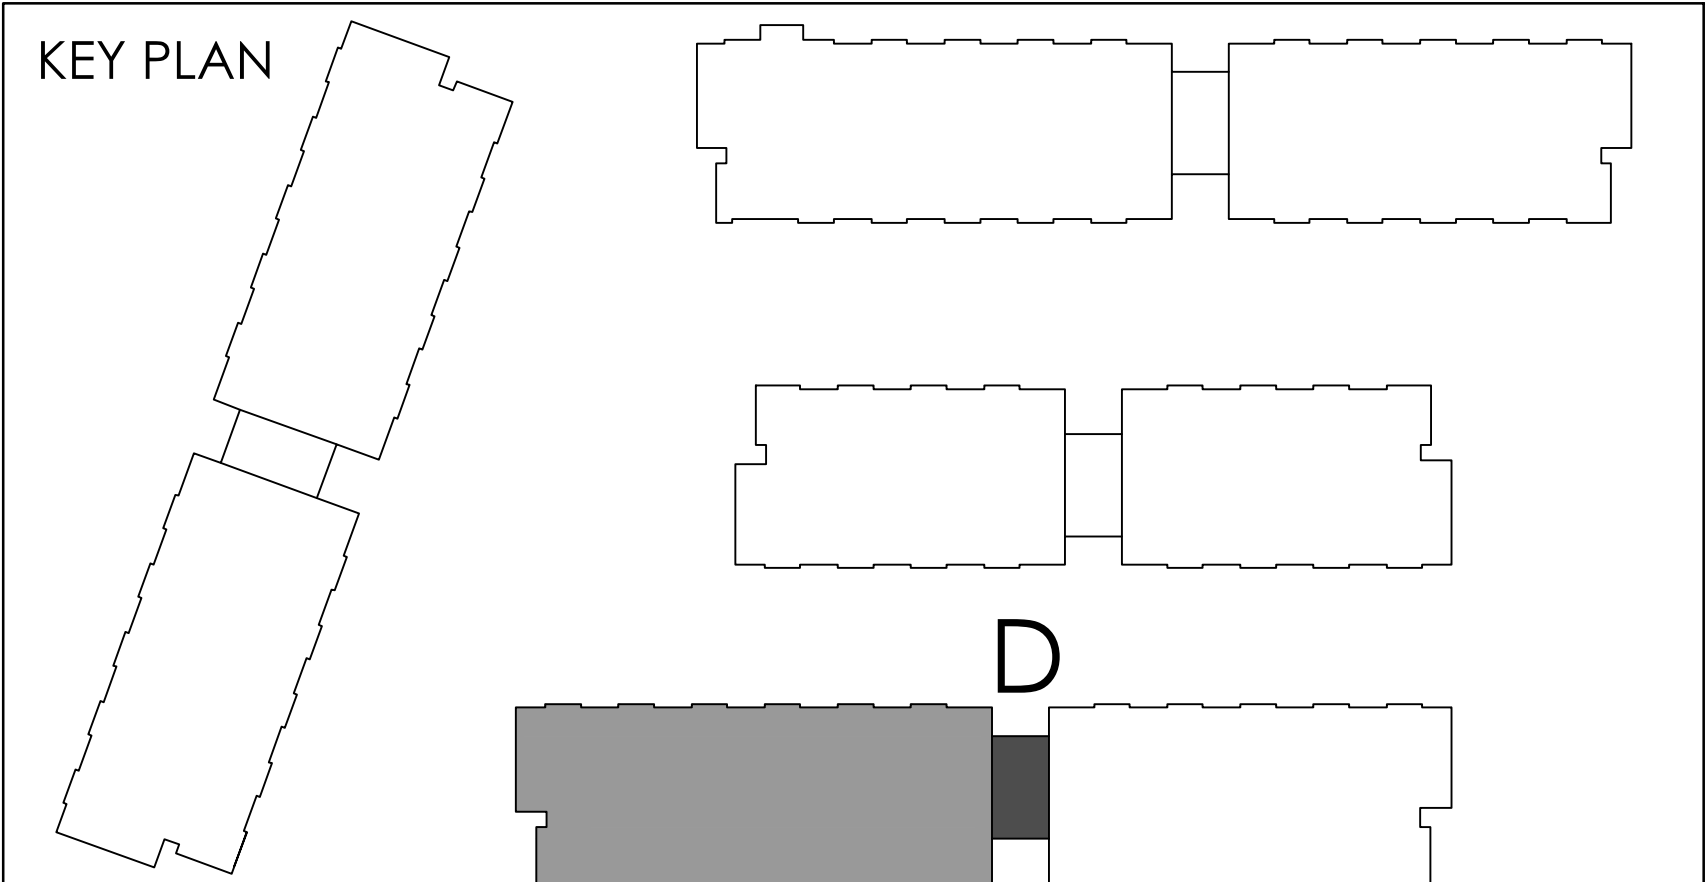

REF-A303d1 FOR CONTINUATION



KEY PLAN

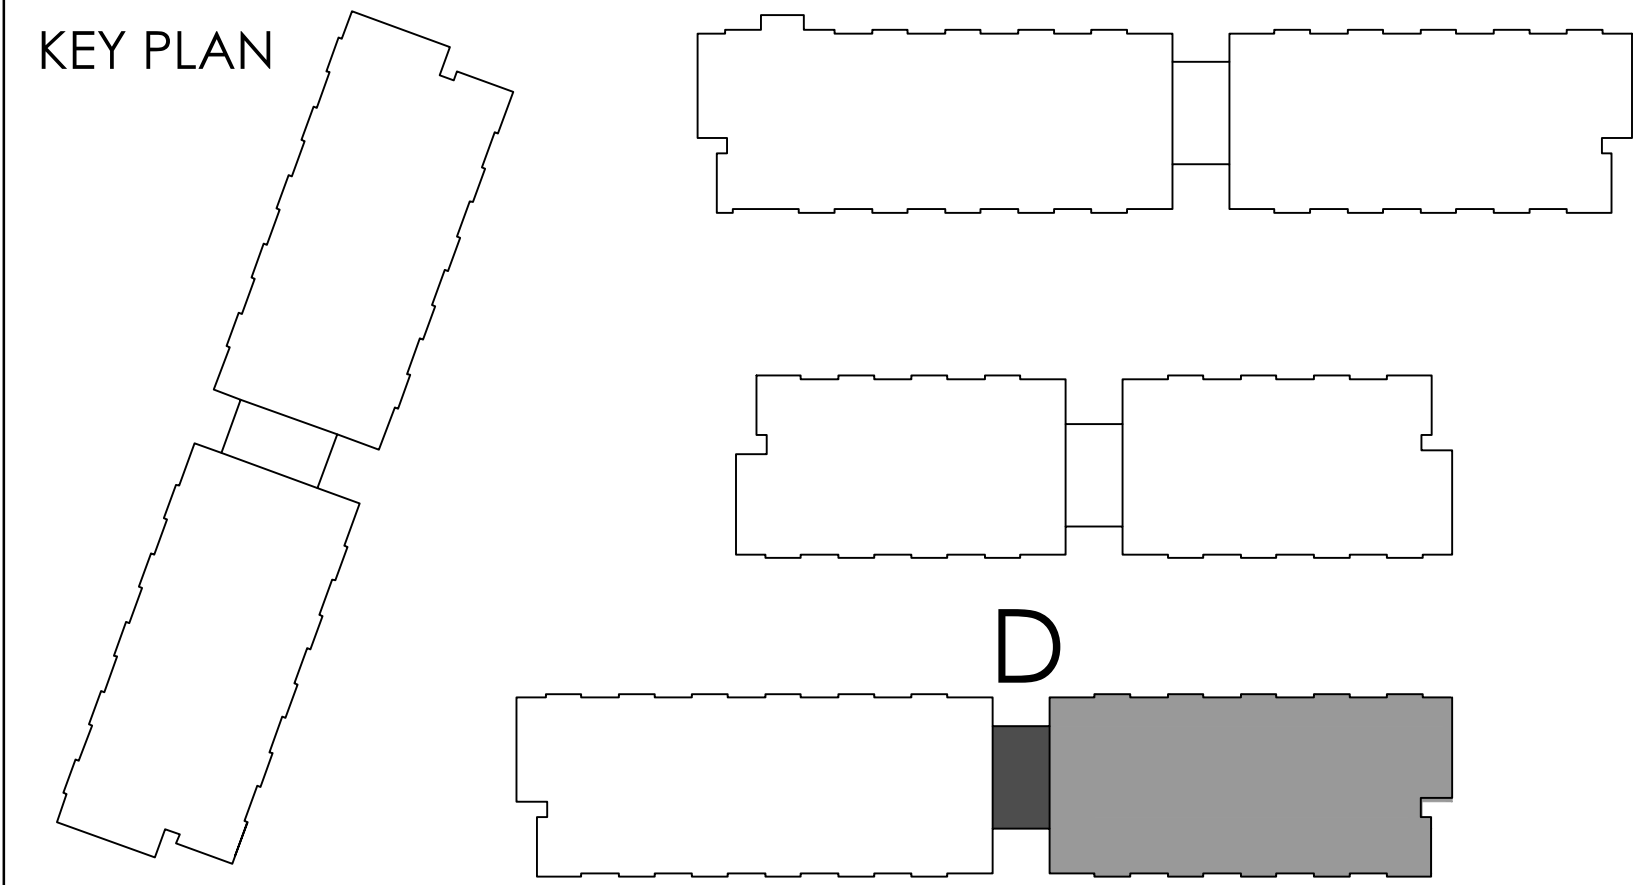

THIS DRAWING, AS AN INSTRUMENT OF SERVICE, IS PROVIDED BY AND IS THE PROPERTY OF GRAZIANI-CORAZZANI ARCHITECTS INC. THE CONTRACTOR MUST VERIFY AND ACCEPT RESPONSIBILITY FOR ALL DIMENSIONS AND CONDITIONS ON SITE AND MUST NOTIFY GRAZIANI-CORAZZANI ARCHITECTS INC. OF ANY VARIATIONS FROM THE SUPPLIED INFORMATION. GRAZIANI-CORAZZANI ARCHITECTS INC. IS NOT RESPONSIBLE FOR THE ACCURACY OF SURVEY, STRUCTURAL, MECHANICAL, ELECTRICAL, AND OTHER ENGINEERING INFORMATION SHOWN ON THIS DRAWING. REFER TO THE APPROPRIATE ENGINEERING DRAWINGS BEFORE PROCEEDING WITH THE WORK. CONSTRUCTION MUST CONFORM TO ALL APPLICABLE CODES AND REQUIREMENTS OF THE AUTHORITIES HAVING JURISDICTION. ANALYSIS CONFORMANCE NOTED IN INVESTIGATION HAS BEEN UNDERTAKEN OR REPORTED ON BY THE OFFICE IN RELATION TO THE ENVIRONMENTAL CONDITION OF THIS SITE.

THIS DRAWING IS NOT TO BE SCALED. ALL ARCHITECTURAL SYMBOLS INDICATED ON THIS DRAWING ARE GRAPHIC REPRESENTATIONS ONLY.

CONDITIONS FOR ELECTRONIC INFORMATION TRANSFER:

ELECTRONIC INFORMATION IS SUPPLIED TO THE OTHER ASSOCIATED FIRMS TO ASSIST THEM IN THE EXECUTION OF THEIR WORK. REVIEW THE RECEIPT FIRMS MUST DETERMINE THE COMPLETENESS APPROPRIATENESS AND RELEVANCE OF THE INFORMATION IN RESPECT TO THEIR PARTICULAR RESPONSIBILITY.

GRAZIANI-CORAZZANI ARCHITECTS INC. SHALL NOT BE RESPONSIBLE FOR:

1. ERRORS, OMISSIONS, INADEQUACIES DUE TO USE OF INFORMATION IN WHOLE OR PART WHEN INFORMATION IS TRANSFERRED;
2. TRANSMISSION OF ANY INFO OR CHANGE TO THE RECEIVING ELECTRONIC SYSTEM WHEN INFORMATION IS TRANSFERRED.

01. Aug 02 2019 Issued for tender

01. SEP 18, 2019 Issued for Addendum 1

Issued for revisions



BRAMPTON ATTAR + PALLESCHI DRIVE ONTARIO

PROJECT ARCHITECT: B. GRAZIANI

ASSISTANT DESIGNER: R. LINCOLN

DRAWN BY: F.C./M.B.

CHECKED BY: D. BIASE (G. COLANGELO)

PLOT DATE: SEP 18, 2019

JOB #: 1331.15

THIRD FLOOR PLAN
BUILDING D (PARTIAL PLAN)

1:50 A-303d2

TITLE BLOCK SIZE: 915 x 1200

THIS DRAWING, AS AN INSTRUMENT OF SERVICE, IS PROVIDED BY AND IS THE PROPERTY OF GRAZIANI-CORAZZANI ARCHITECTS INC. THE CONTRACTOR MUST VERIFY AND ACCEPT RESPONSIBILITY FOR ALL DIMENSIONS AND CONDITIONS ON SITE AND MUST NOTIFY GRAZIANI-CORAZZANI ARCHITECTS INC. OF ANY VARIATIONS FROM THE SUPPLIED INFORMATION. GRAZIANI-CORAZZANI ARCHITECTS INC. IS NOT RESPONSIBLE FOR THE ACCURACY OF SURVEY, STRUCTURAL, MECHANICAL, ELECTRICAL, AND OTHER ENGINEERING INFORMATION SHOWN ON THIS DRAWING. REFER TO THE APPROPRIATE ENGINEERING DRAWINGS BEFORE PROCEEDING WITH THE WORK. CONSTRUCTION MUST CONFORM TO ALL APPLICABLE CODES AND REQUIREMENTS OF THE AUTHORITY HAVING JURISDICTION. UNLESS OTHERWISE NOTED, NO INVESTIGATION HAS BEEN UNDERTAKEN OR REPORTED ON BY THE OFFICE IN RELATION TO THE ENVIRONMENTAL CONDITION OF THIS SITE.

THIS DRAWING IS NOT TO BE SCALED. ALL ARCHITECTURAL SYMBOLS INDICATED ON THIS DRAWING ARE GRAPHIC REPRESENTATIONS ONLY.


CONDITIONS FOR ELECTRONIC INFORMATION TRANSFER:

ELECTRONIC INFORMATION IS SUPPLIED TO THE OTHER ASSOCIATED FIRMS TO ASSIST THEM IN THE EXECUTION OF THEIR WORK. REVIEW THE RECEIPT FIRMS MUST EXTEND THE CORRESPONDING APPROPRIATE RESPONSIBILITY OF THE INFORMATION IN RESPECT TO THEIR PARTICULAR RESPONSIBILITY.


1. ENGINEERING INFORMATION: GRAZIANI-CORAZZANI ARCHITECTS INC. SHALL NOT BE RESPONSIBLE FOR THE ACCURACY OF INFORMATION IN WHOLE OR PART WHEN INFORMATION IS TRANSFERRED.

2. TRANSMISSION OF ANY INFO OR CHANGE TO THE RECEIVING ELECTRONIC SYSTEM WHEN INFORMATION IS TRANSFERRED.

01. Aug.02.2019 Issued for tender

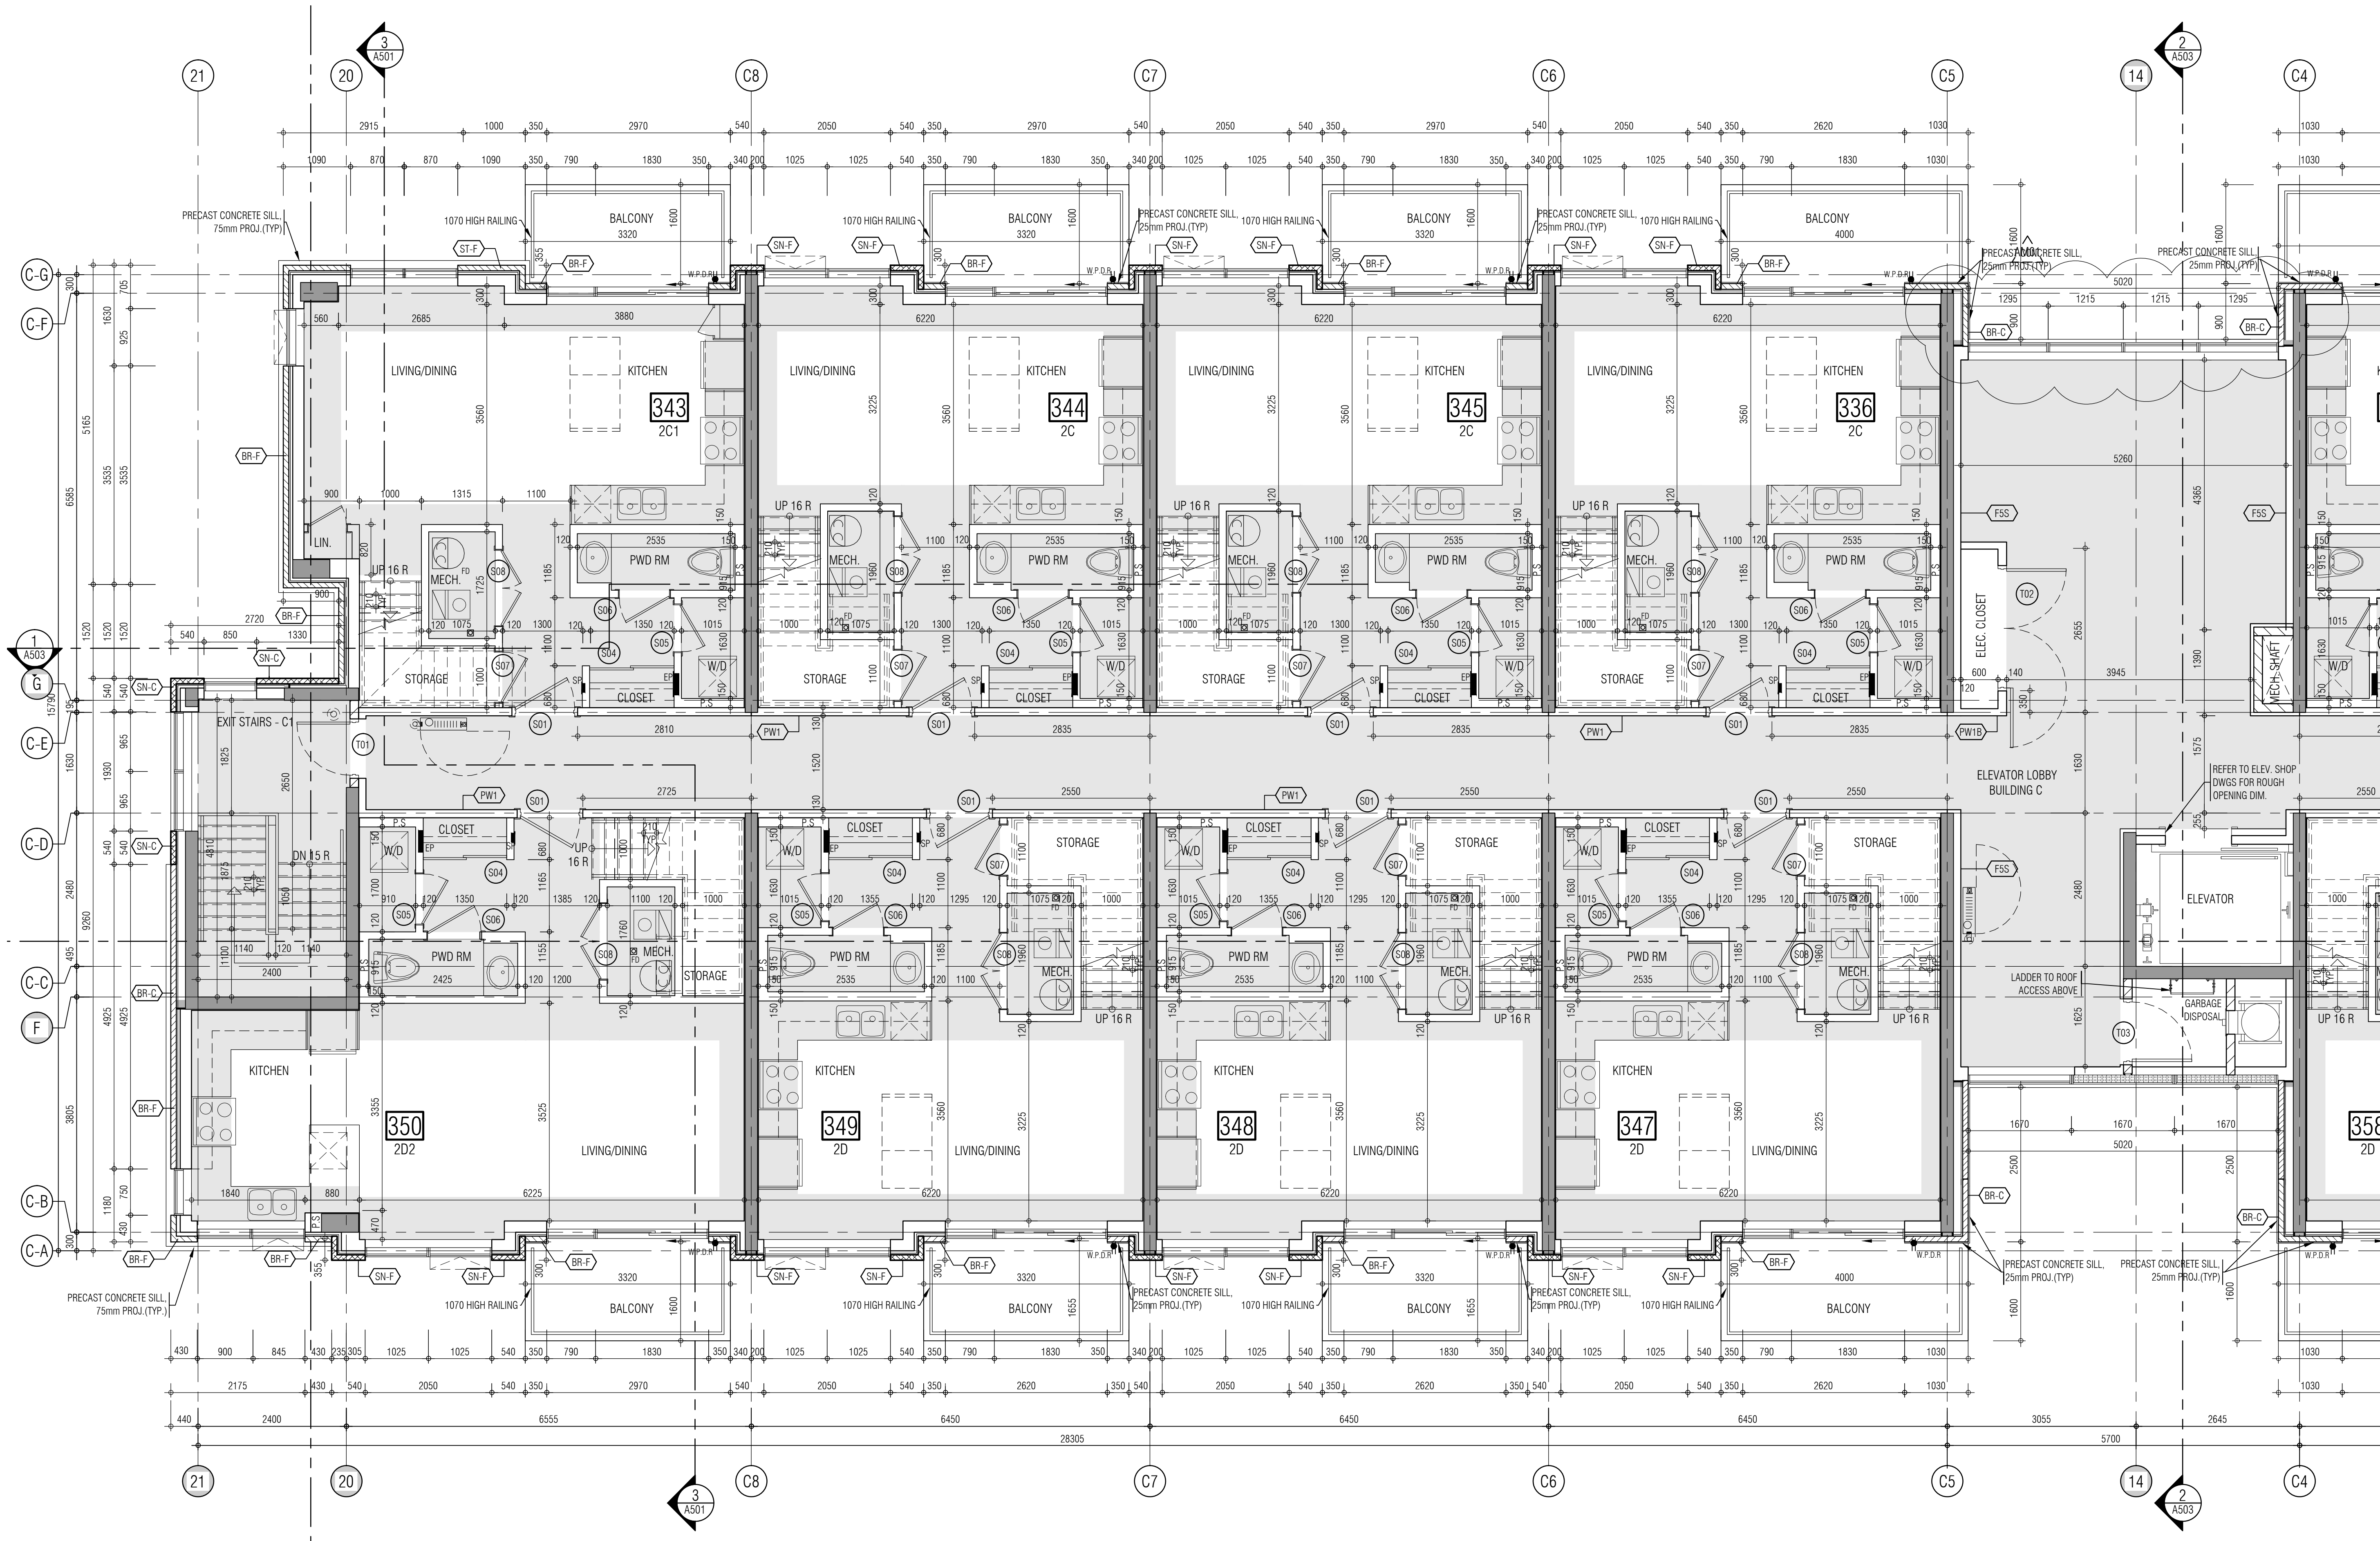

REF. A303c2 FOR CONTINUATION

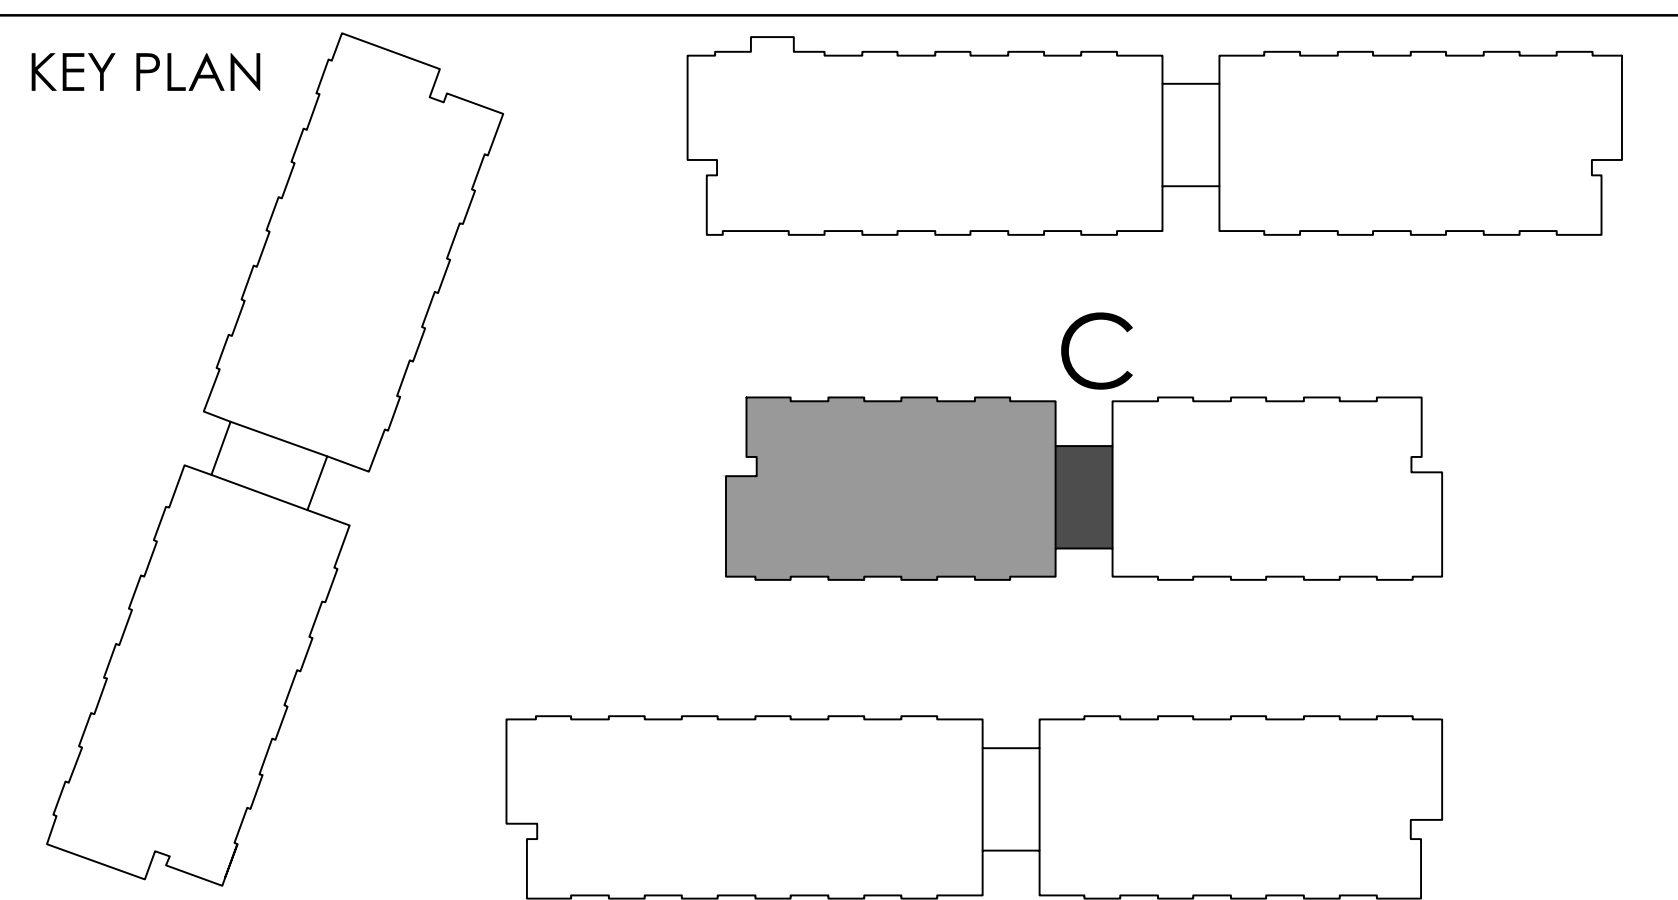

01. SEP.18.2019 Issued for Addendum 1

Issued for revisions

GRAZIANI CORAZZANI ARCHITECTS


1000 DAVENPORT DRIVE, SUITE 100, MISSISSAUGA, ONTARIO L4W 1G1
TEL: 905.276.2600 FAX: 905.276.2644 WWW.GC-ARCHITECTS.COM

BRANFON:	ATTMAR + PALLESCHI DRIVE	ONTARIO
PROJECT ARCHITECT:	B. GRAZIANI	
ASSISTANT DESIGNER:	R. LINCOLN	
DRAWN BY:	F.C./M.B.	
CHECKED BY:	D. BIAISE (G. COLANGELO)	
PLOT DATE:	SEP.18.2019	
JOB #:	1331.15	


**THIRD FLOOR PLAN
BUILDING C (PARTIAL PLAN)**

1:50 A-303c1
TITLE BLOCK SIZE: 915 x 1200

REF. A303c1 FOR CONTINUATION

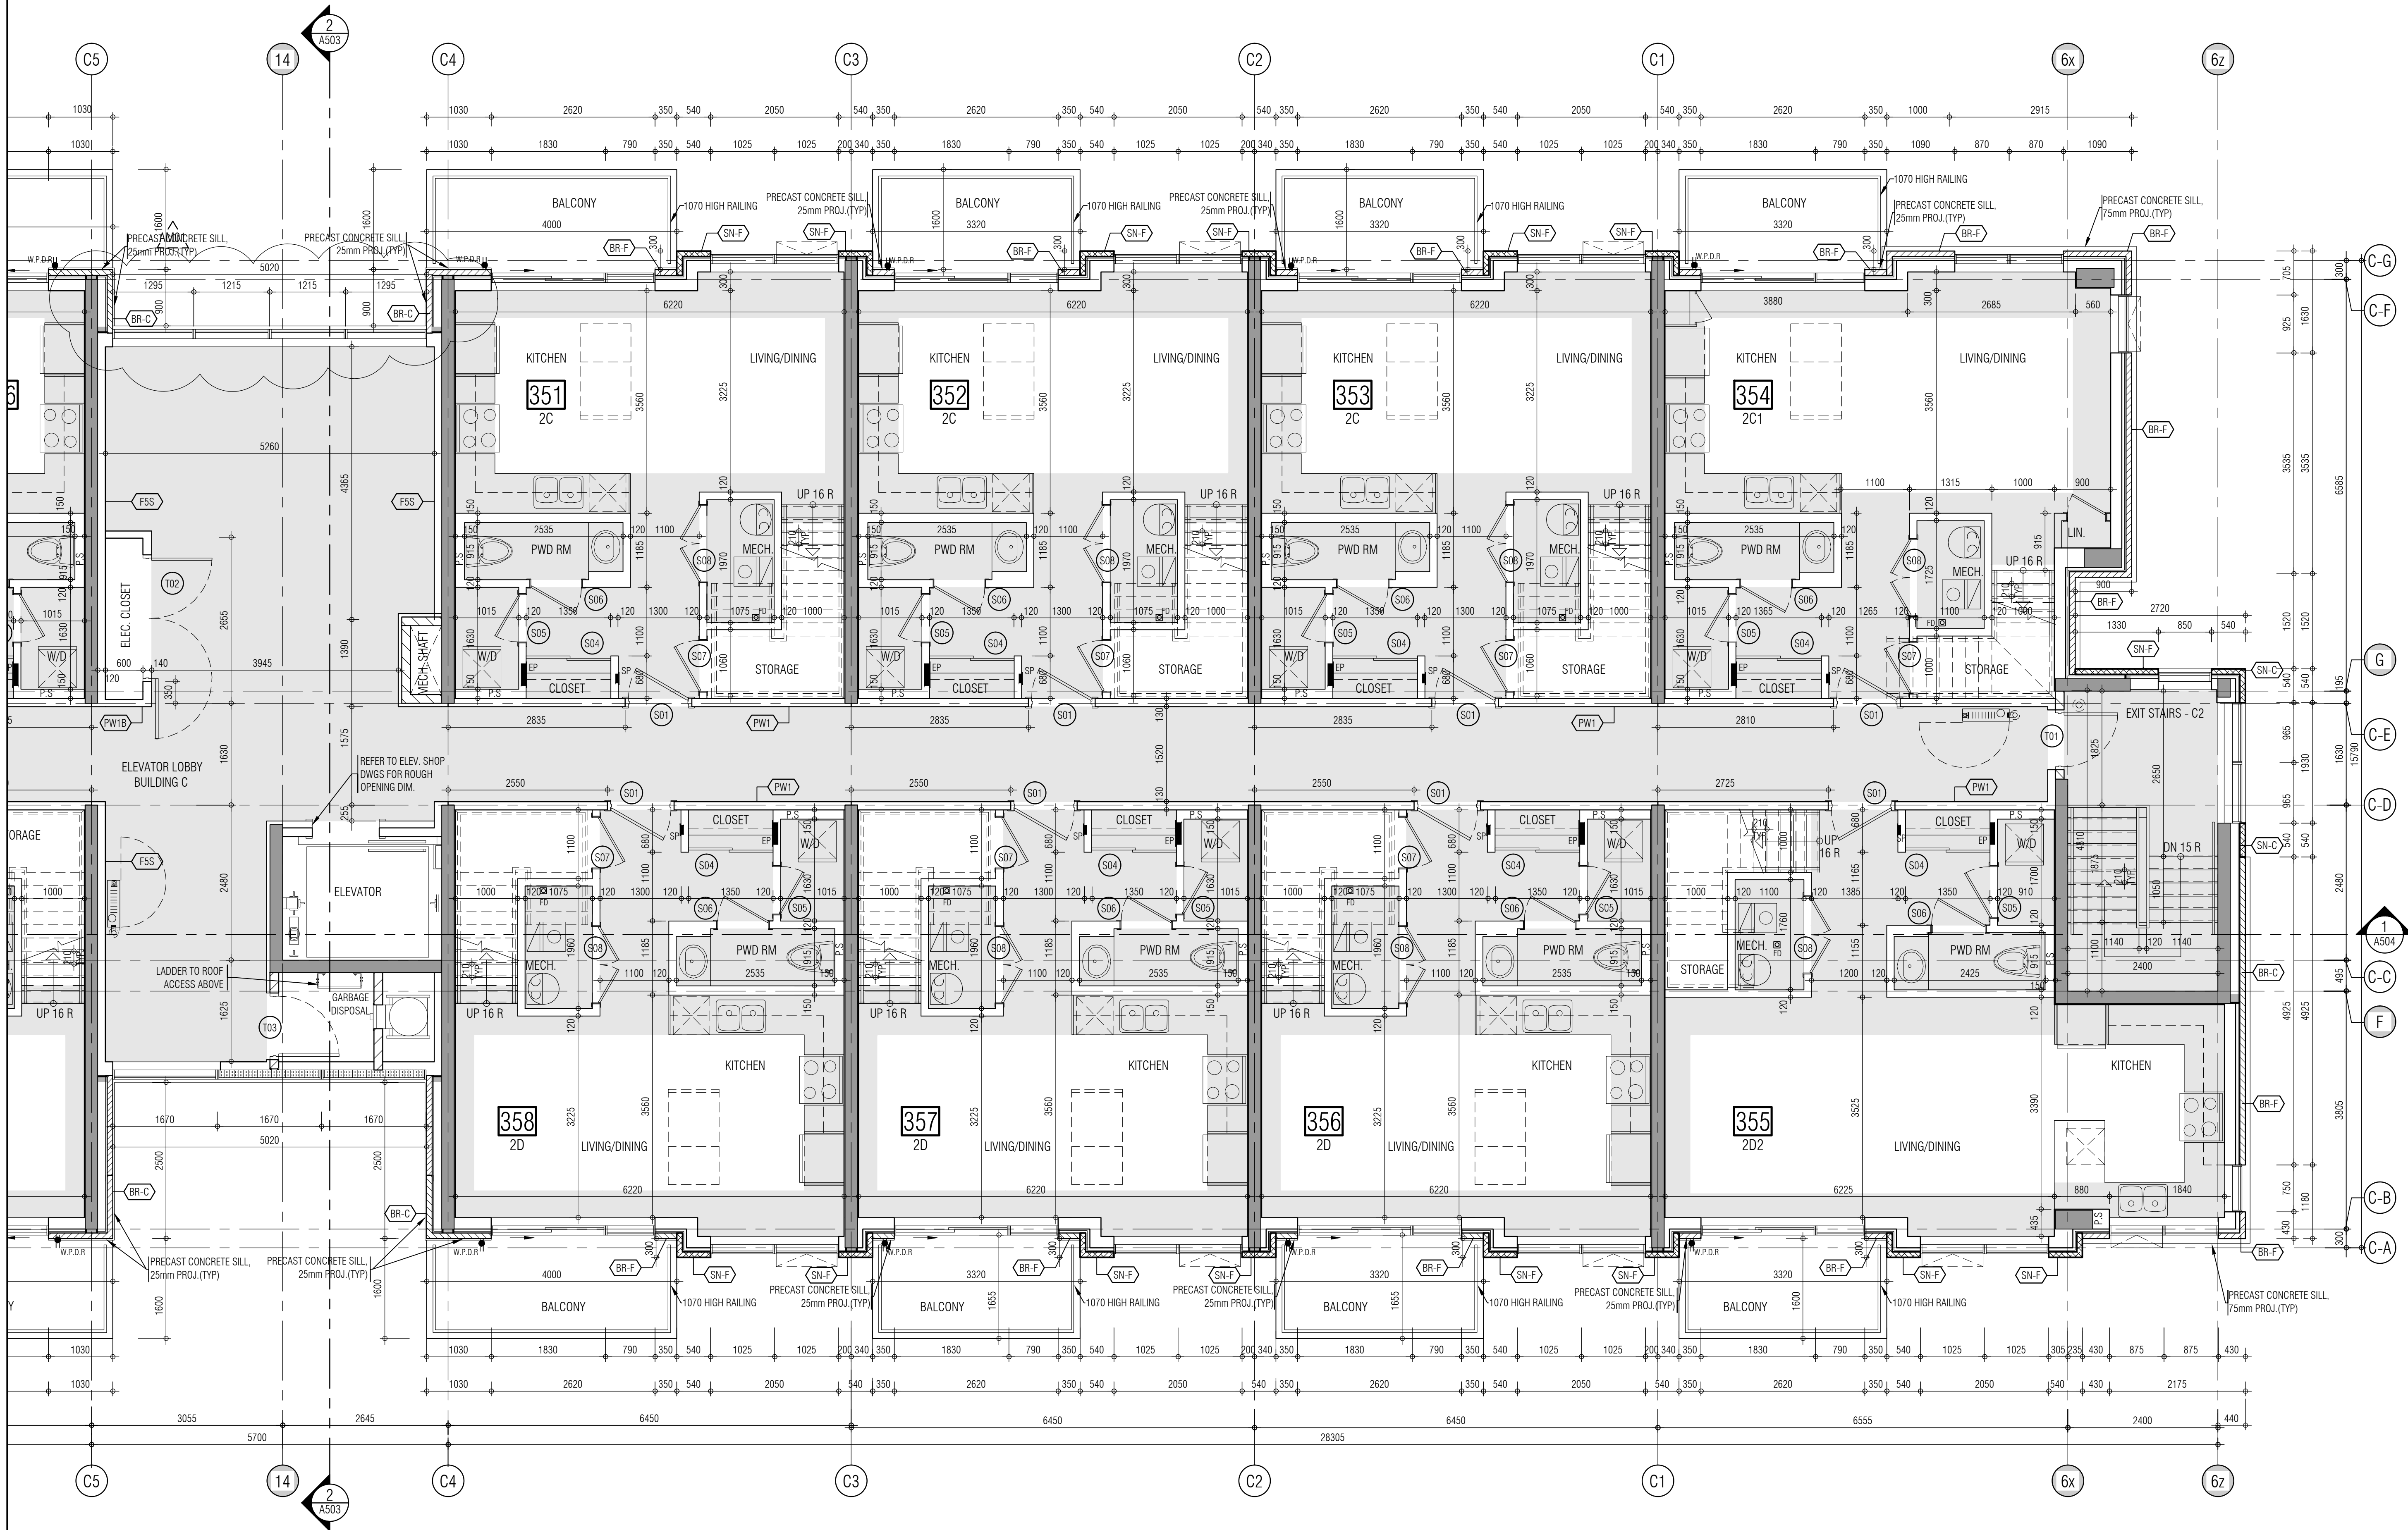

KEY PLAN

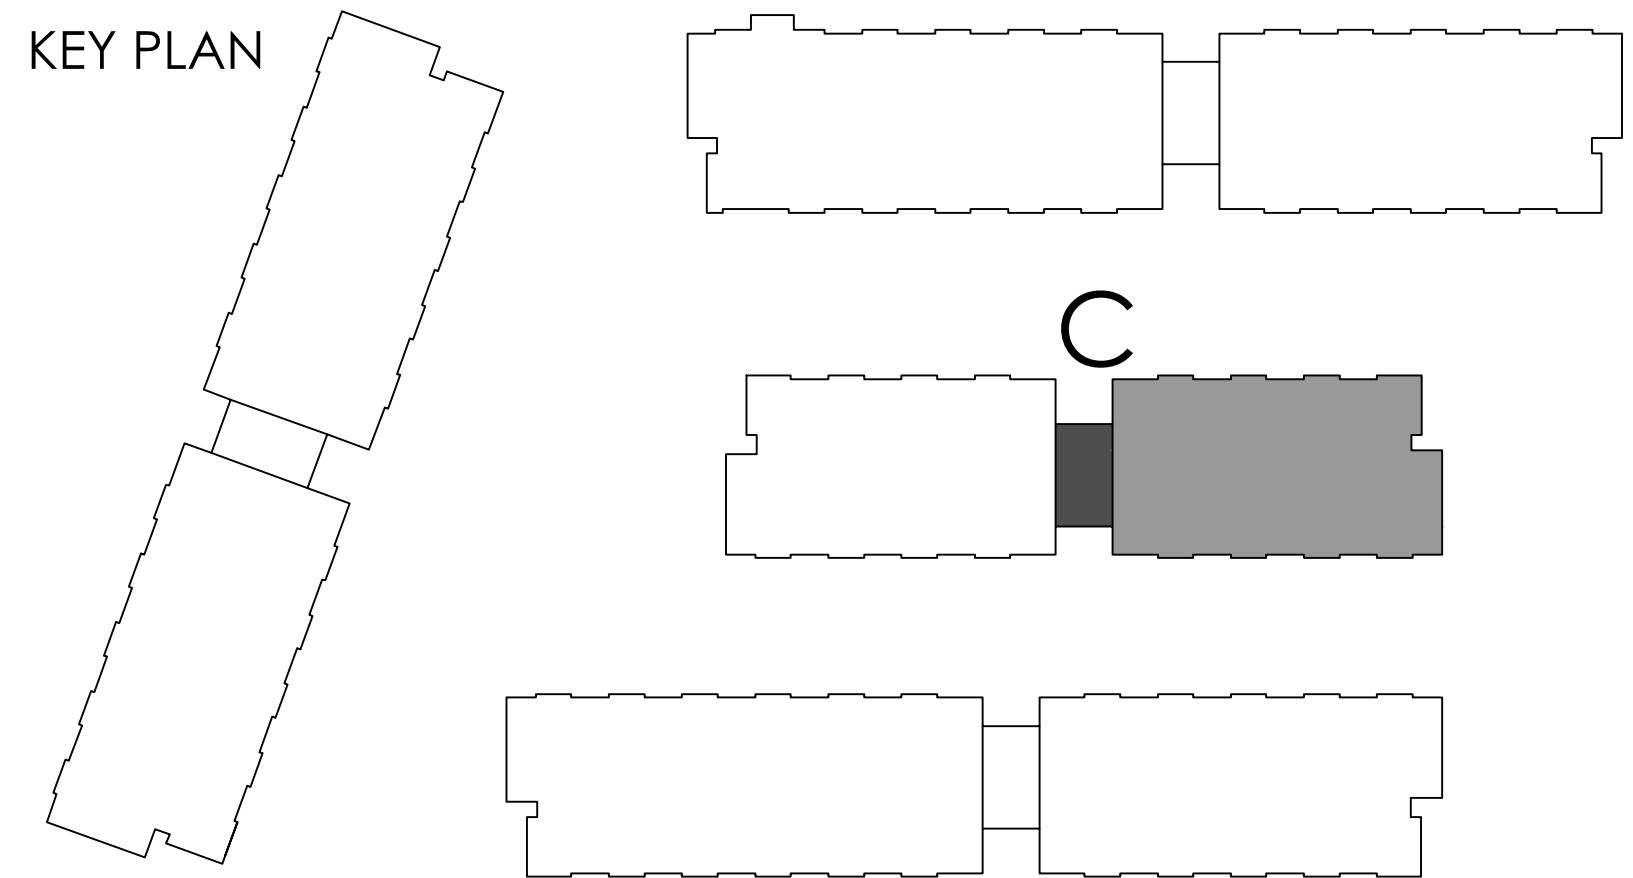

THIS DRAWING, AS AN INSTRUMENT OF SERVICE, IS PROVIDED BY AND IS THE PROPERTY OF GRAZIANI-CORAZZANI ARCHITECTS INC. THE CONTRACTOR MUST VERIFY AND ACCEPT RESPONSIBILITY FOR ALL DIMENSIONS AND CONDITIONS ON SITE AND MUST NOTIFY GRAZIANI-CORAZZANI ARCHITECTS INC. OF ANY VARIATIONS FROM THE SUPPLIED INFORMATION. GRAZIANI-CORAZZANI ARCHITECTS INC. IS NOT RESPONSIBLE FOR THE ACCURACY OF SURVEY, STRUCTURAL, MECHANICAL, ELECTRICAL, AND OTHER ENGINEERING INFORMATION SHOWN ON THIS DRAWING. REFER TO THE APPROPRIATE ENGINEERING DRAWINGS BEFORE PROCEEDING WITH THE WORK. CONSTRUCTION MUST CONFORM TO ALL APPLICABLE CODES AND REQUIREMENTS OF THE AUTHORITIES HAVING JURISDICTION. ANALYSIS CONFORMING WITH NO INVESTIGATION HAS BEEN UNDERTAKEN OR REPORTED ON BY THE OFFICE IN RELATION TO THE ENVIRONMENTAL CONDITION OF THIS SITE.

THIS DRAWING IS NOT TO BE SCALED. ALL ARCHITECTURAL SYMBOLS INDICATED ON THIS DRAWING ARE GRAPHIC REPRESENTATIONS ONLY.

CONDITIONS FOR ELECTRONIC INFORMATION TRANSFER:

ELECTRONIC INFORMATION IS SUPPLIED TO THE OTHER ASSOCIATED FIRMS TO ASSIST THEM IN THE EXECUTION OF THEIR WORK. REVIEW THE RECEIPT FIRMS MUST EXTEND THE CORRESPONDING APPROPRIATE RESPONSIBILITY OF THE INFORMATION IN RESPECT TO THEIR PARTICULAR RESPONSIBILITY.

GRAZIANI-CORAZZANI ARCHITECTS INC. SHALL NOT BE RESPONSIBLE FOR:

1. ERRORS, OMISSIONS, INADEQUACIES DUE TO LOSS OF INFORMATION IN WHOLE OR PART WHEN INFORMATION IS TRANSFERRED;
2. TRANSMISSION OF ANY KIND OF CHANGE TO THE RECEIVING ELECTRONIC SYSTEM WHEN INFORMATION IS TRANSFERRED.

01. Aug.02.2019 Issued for tender

01. SEP.18.2019 Issued for Addendum 1

Issued for revisions



ATTMAR + PALLESCHI DRIVE
ONTARIO

PROJECT ARCHITECT: B. GRAZIANI
ASSISTANT DESIGNER: R. LINCOLN
DRAWN BY: F.C./M.B.
CHECKED BY: D. BIASI (G. COLANGELO)
PLOT DATE: SEP.18.2019
JOB #: 1331.15

THIRD FLOOR PLAN
BUILDING C (PARTIAL PLAN)

1:50 A-303c2

TITLE BLOCK SIZE: 915 x 1200

THIS DRAWING, AS AN INSTRUMENT OF SERVICE, IS PROVIDED BY AND IS THE PROPERTY OF GRAZIANI-CORAZZA ARCHITECTS INC. THE CONTRACTOR MUST VERIFY AND ACCEPT RESPONSIBILITY FOR ALL DIMENSIONS AND CONDITIONS ON SITE AND MUST NOTIFY GRAZIANI-CORAZZA ARCHITECTS INC. OF ANY VARIATIONS FROM THE SUPPLIED INFORMATION. GRAZIANI-CORAZZA ARCHITECTS INC. IS NOT RESPONSIBLE FOR THE ACCURACY OF SURVEY, STRUCTURAL, MECHANICAL, ELECTRICAL, AND OTHER ENGINEERING INFORMATION SHOWN ON THIS DRAWING. REFERENCE TO THE APPROPRIATE ENGINEERING DRAWINGS BEFORE PROCEEDING WITH THE WORK. CONSTRUCTION MUST CONFORM TO ALL APPLICABLE CODES AND REQUIREMENTS OF THE JURISDICTION. JAWAB: ANALYSIS CONFORMANCE. NO INVESTIGATION HAS BEEN UNDERTAKEN OR REPORTED ON BY THE OFFICE IN RELATION TO THE ENVIRONMENTAL CONDITION OF THIS SITE.

THIS DRAWING IS NOT TO BE SCALED. ALL ARCHITECTURAL SYMBOLS INDICATED ON THIS DRAWING ARE GRAPHIC REPRESENTATIONS ONLY.


CONDITIONS FOR ELECTRONIC INFORMATION TRANSFER:

ELECTRONIC INFORMATION IS SUPPLIED TO THE OTHER ASSOCIATED FIRMS TO ASSIST THEM IN THE EXECUTION OF THEIR WORK. REVER: THE RECEIPT FIRMS MUST EXTEND THE CORRESPONDING APPROPRIATE RELEVANCE OF THE INFORMATION IN RESPECT TO THEIR PARTICULAR RESPONSIBILITY.


1. GRAZIANI-CORAZZA ARCHITECTS INC. SHALL NOT BE RESPONSIBLE FOR:
1.1. ERRORS, OMISSIONS, INADEQUACIES DUE TO USE OF INFORMATION IN WHOLE OR PART WHEN INFORMATION IS TRANSFERRED.
2. TRANSMISSION OF ANY INFO OR CHANGE TO THE RECEIVING ELECTRONIC SYSTEM WHEN INFORMATION IS TRANSFERRED.

01. Aug 02, 2019 Issued for tender

REF. A303b2 FOR CONTINUATION

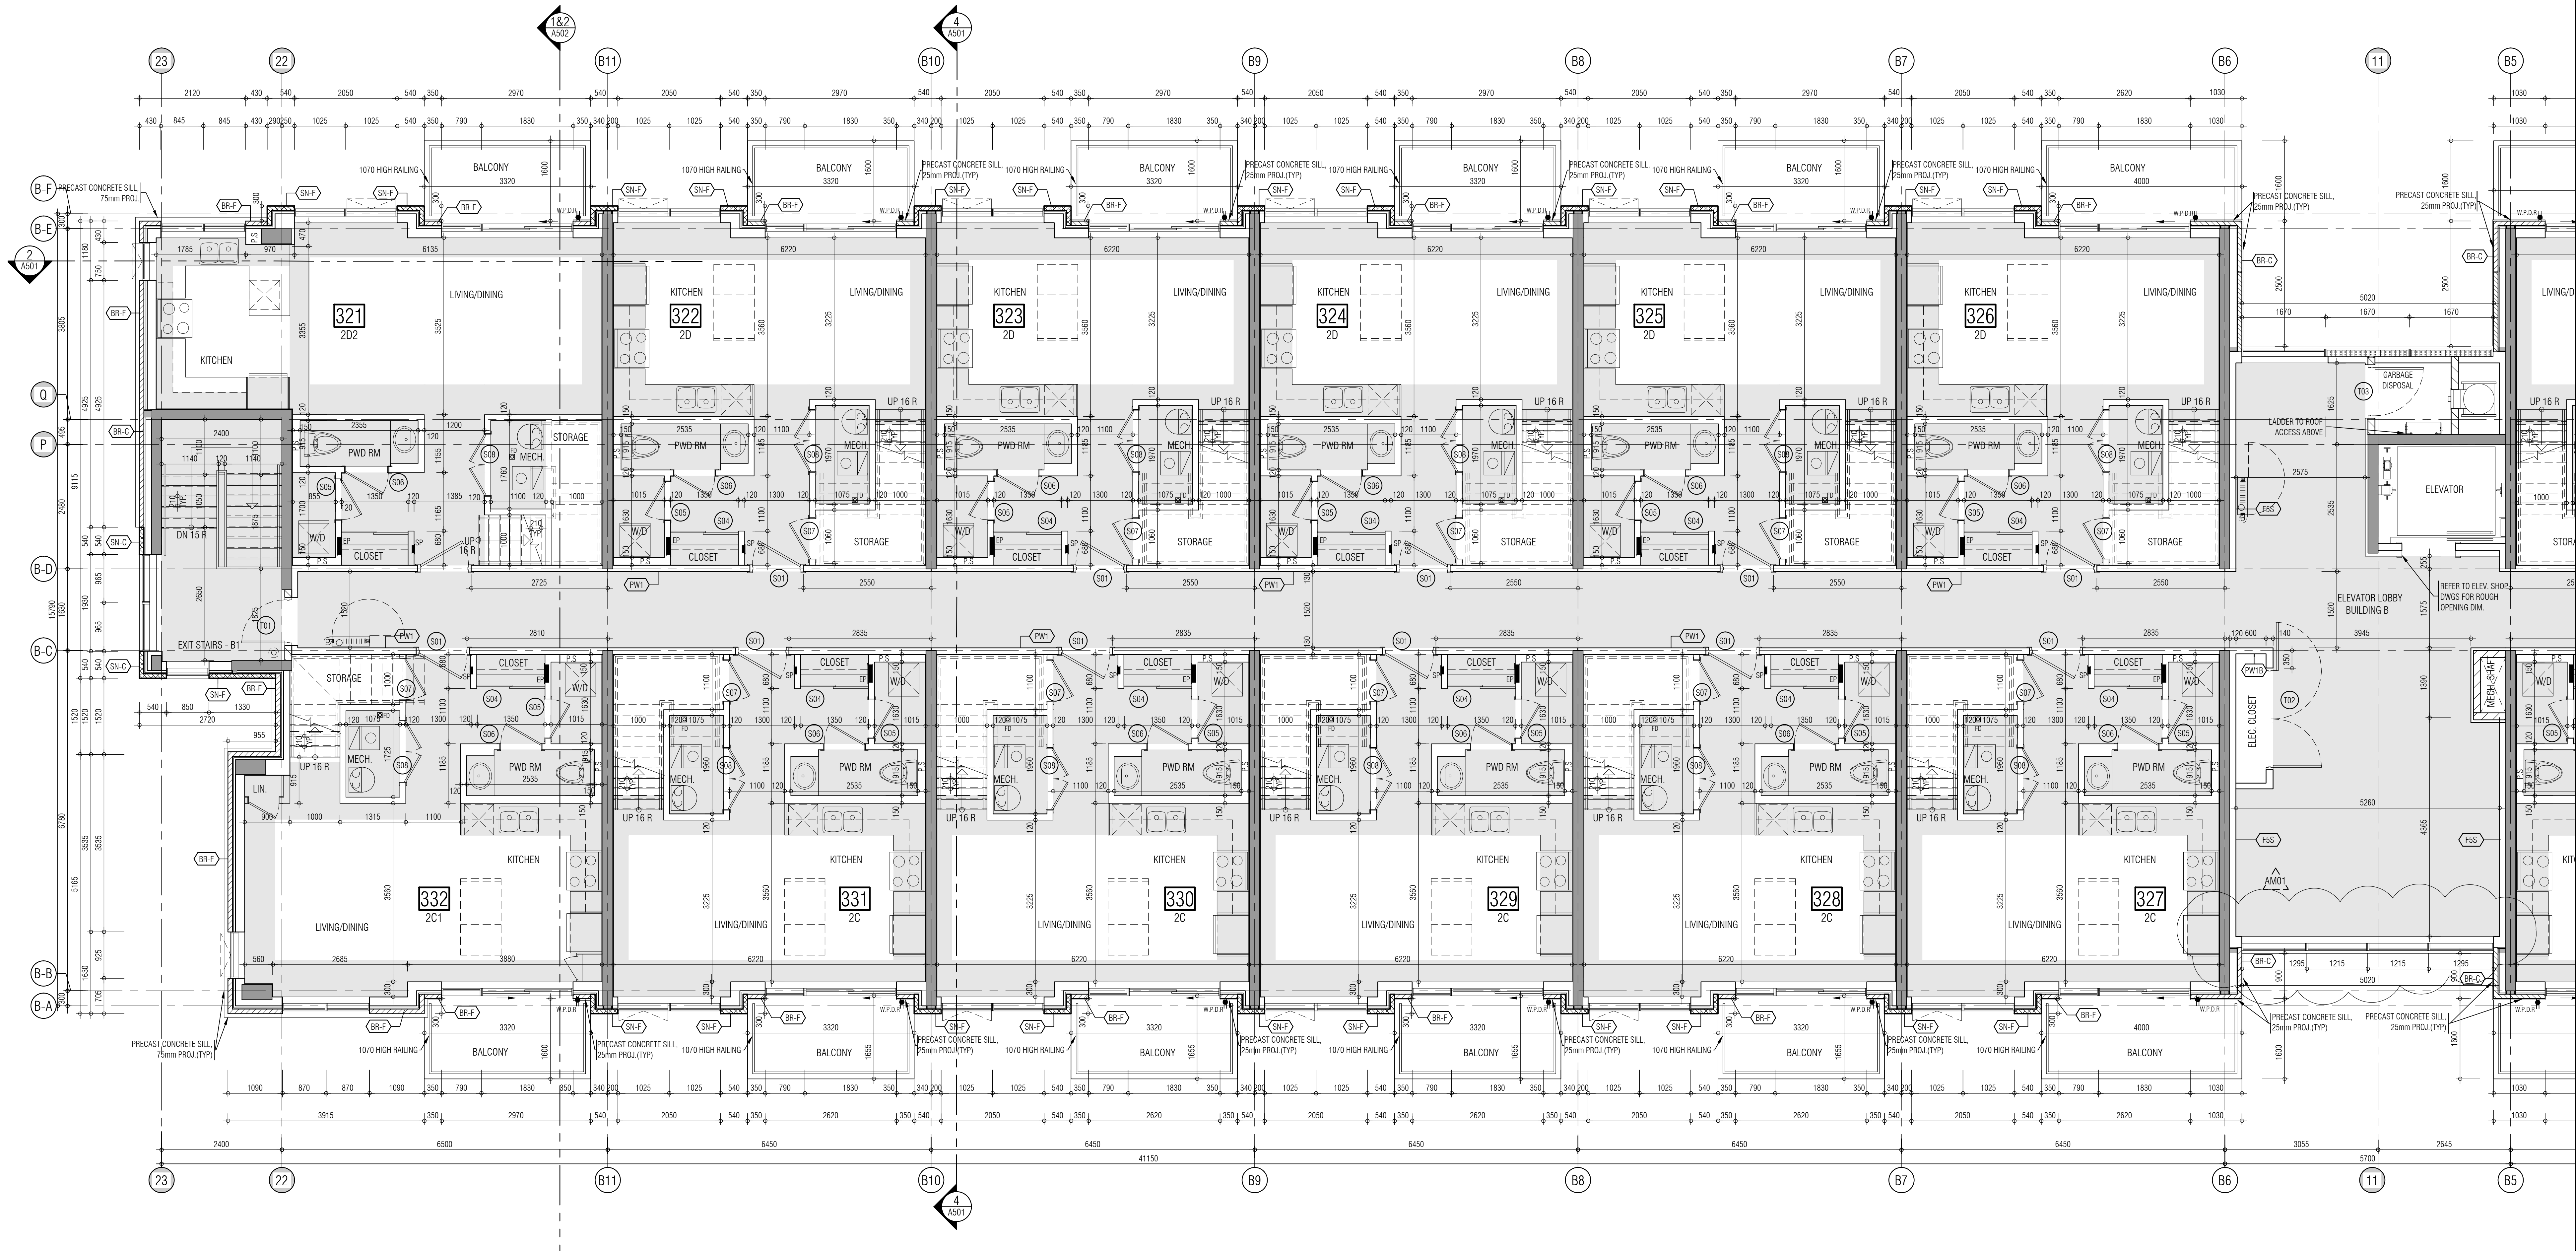

KEY PLAN

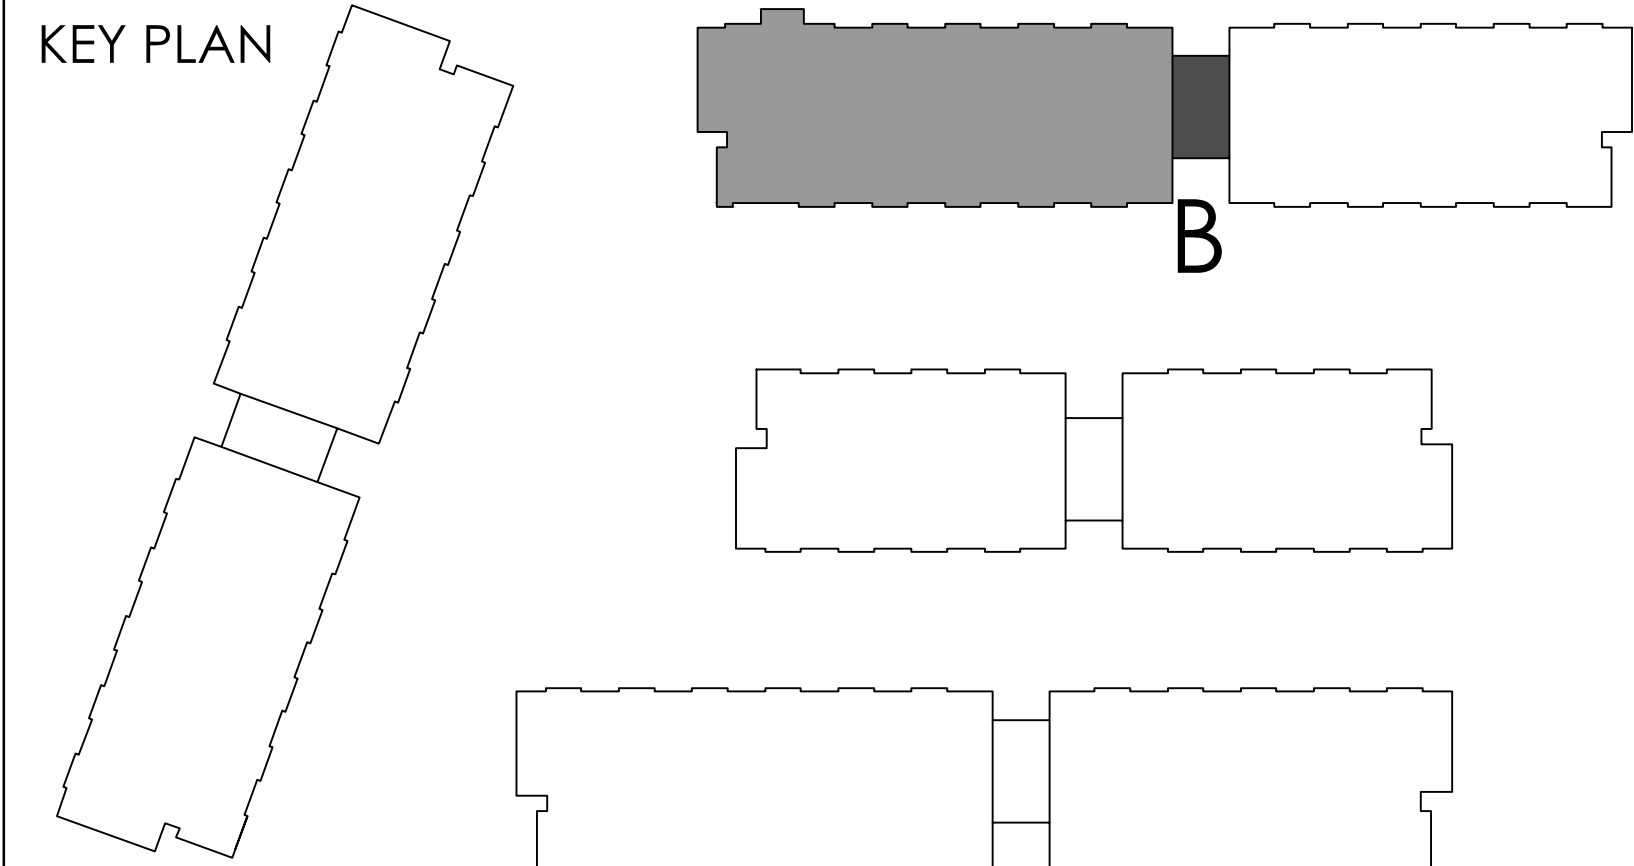

01. SEP 18, 2019 Issued for Adendum 1
Issued for revisions

**GRAZIANI
CORAZZA
ARCHITECTS**

1000 SHAWAN DR. SUITE 100 MISSISSAUGA, ONTARIO L4W 1G1
TEL: 905-276-2600 FAX: 905-276-2644 WWW.GC-ARCHITECTS.COM

BRAND: ATIMAR + PALLESCHE DRIVE ONTARIO

PROJECT ARCHITECT: B. GRAZIANI

ASSISTANT DESIGNER: R. LINCOLN

DRAWN BY: F.C./M.B.

CHECKED BY: D. BIASI (G. COLANGELO)

JOB DATE: SEP 18, 2019

JOB #: 1331.15

**THIRD FLOOR PLAN
BUILDING B (PARTIAL PLAN)**

1:50 A-303b1

TITLE BLOCK SIZE: 915 x 1200

01. Aug.02.2019 issued for tender



issued for revisions



TITLEBLOCK SIZE: 915 x 1200


THIS DRAWING, AS AN INSTRUMENT OF SERVICE, IS PROVIDED BY AND IS THE PROPERTY OF GRAZIANI-CORAZZA ARCHITECTS INC. THE CONTRACTOR MUST VERIFY AND ACCEPT RESPONSIBILITY FOR ALL DIMENSIONS AND CONDITIONS ON SITE AND MUST KEEP GRAZIANI-CORAZZA ARCHITECTS INC. OF ANY VARIATIONS FROM THE SUPPLIED INFORMATION. GRAZIANI-CORAZZA ARCHITECTS INC. IS NOT RESPONSIBLE FOR THE ACCURACY OF SURVEY, STRUCTURAL, MECHANICAL, ELECTRICAL, AND OTHER ENGINEERING INFORMATION SHOWN ON THIS DRAWING. REFER TO THE APPROPRIATE ENGINEERING DRAWINGS BEFORE PROCEEDING WITH THE WORK. CONSTRUCTION MUST CONFORM TO ALL APPLICABLE CODES AND REQUIREMENTS OF THE AUTHORITIES HAVING JURISDICTION. ALWAYS CONSULT THE SPECIFICATIONS AND NOTES TO THE DRAWINGS. CONSULT THE SITE SPECIFIC IN REGARD TO THE ENVIRONMENTAL, CLIMATE, AND OTHER FACTORS. THIS DRAWING IS NOT TO BE SCALED. ALL ARCHITECTURAL SYMBOLS INDICATED ON THIS DRAWING ARE GRAPHIC REPRESENTATIONS ONLY.

CONDITIONS FOR ELECTRONIC INFORMATION TRANSFER:

ELECTRONIC INFORMATION IS SUPPLIED TO THE OTHER ASSOCIATED PARTS TO ASSIST THEM IN THE EXECUTION OF THEIR WORK. REVIEW THE RECEIPT FORMS MUST DETERMINE THE COMPLETENESS, APPROPRIATENESS, RELEVANCE OF THE INFORMATION IN RESPECT TO THEIR PARTICULAR RESPONSIBILITY.

1. OTHER ENGINEERING INFORMATION DUE TO LOSS OF INFORMATION IN WHOLE OR PART WHEN INFORMATION IS TRANSFERRED.


2. TRANSFERRED OR ANY LOSS OF CHANGE TO THE RECEIVING ELECTRONIC SYSTEM WHEN INFORMATION IS TRANSFERRED.

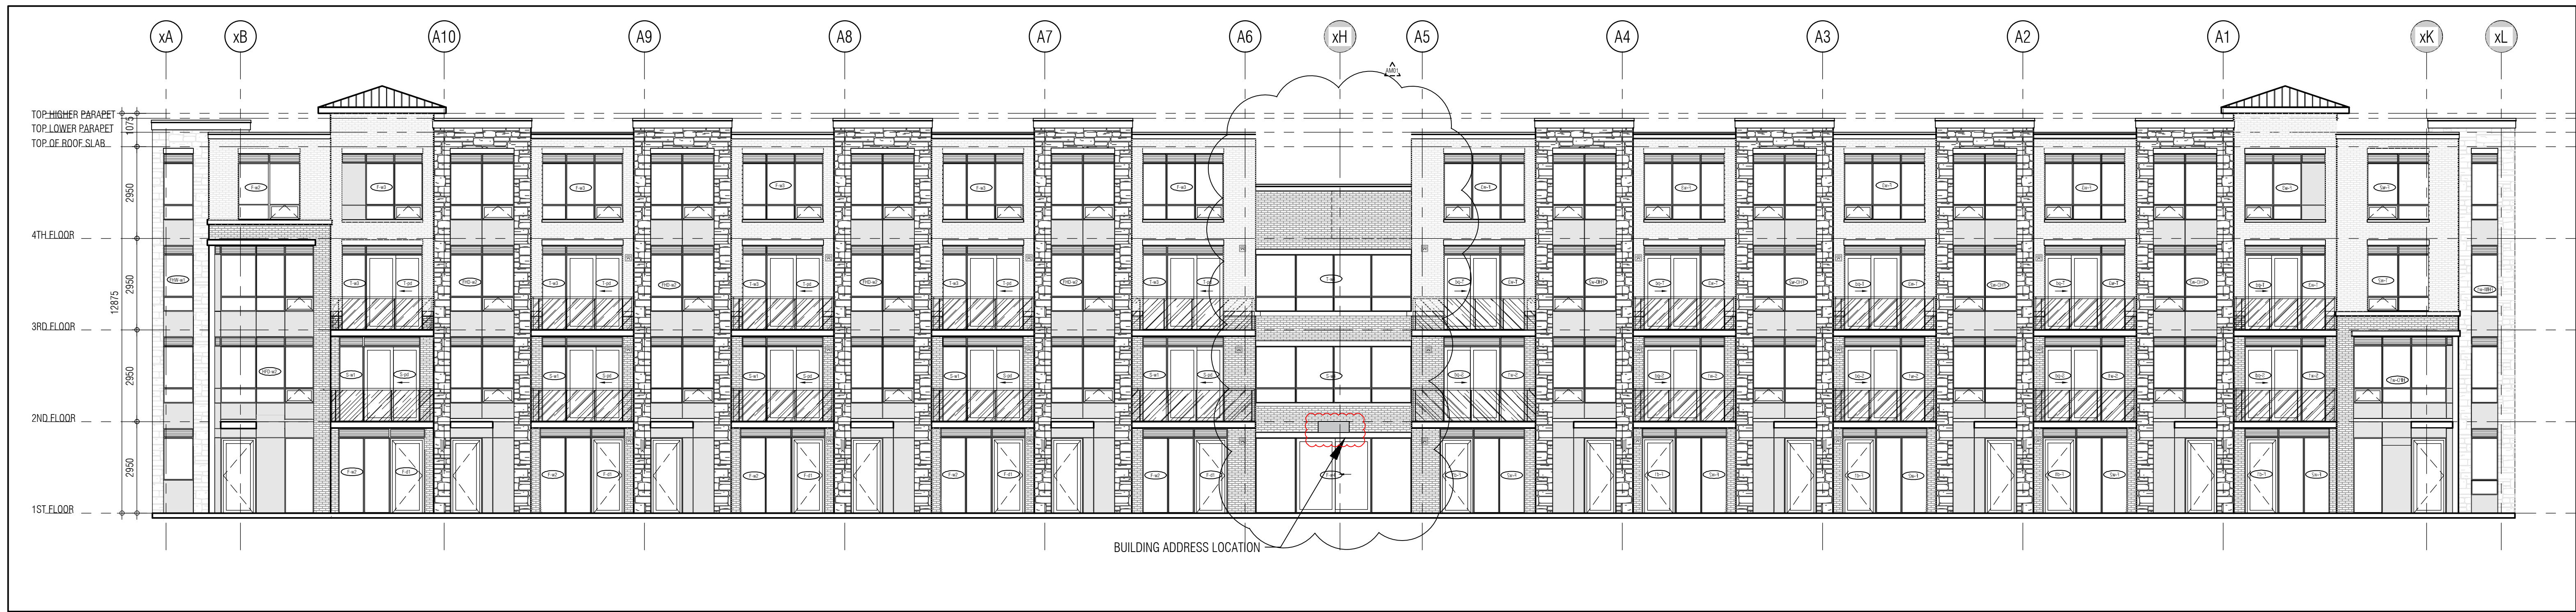


EAST ELEVATION 1
1:100 A401




WEST ELEVATION 2
1:100 A401

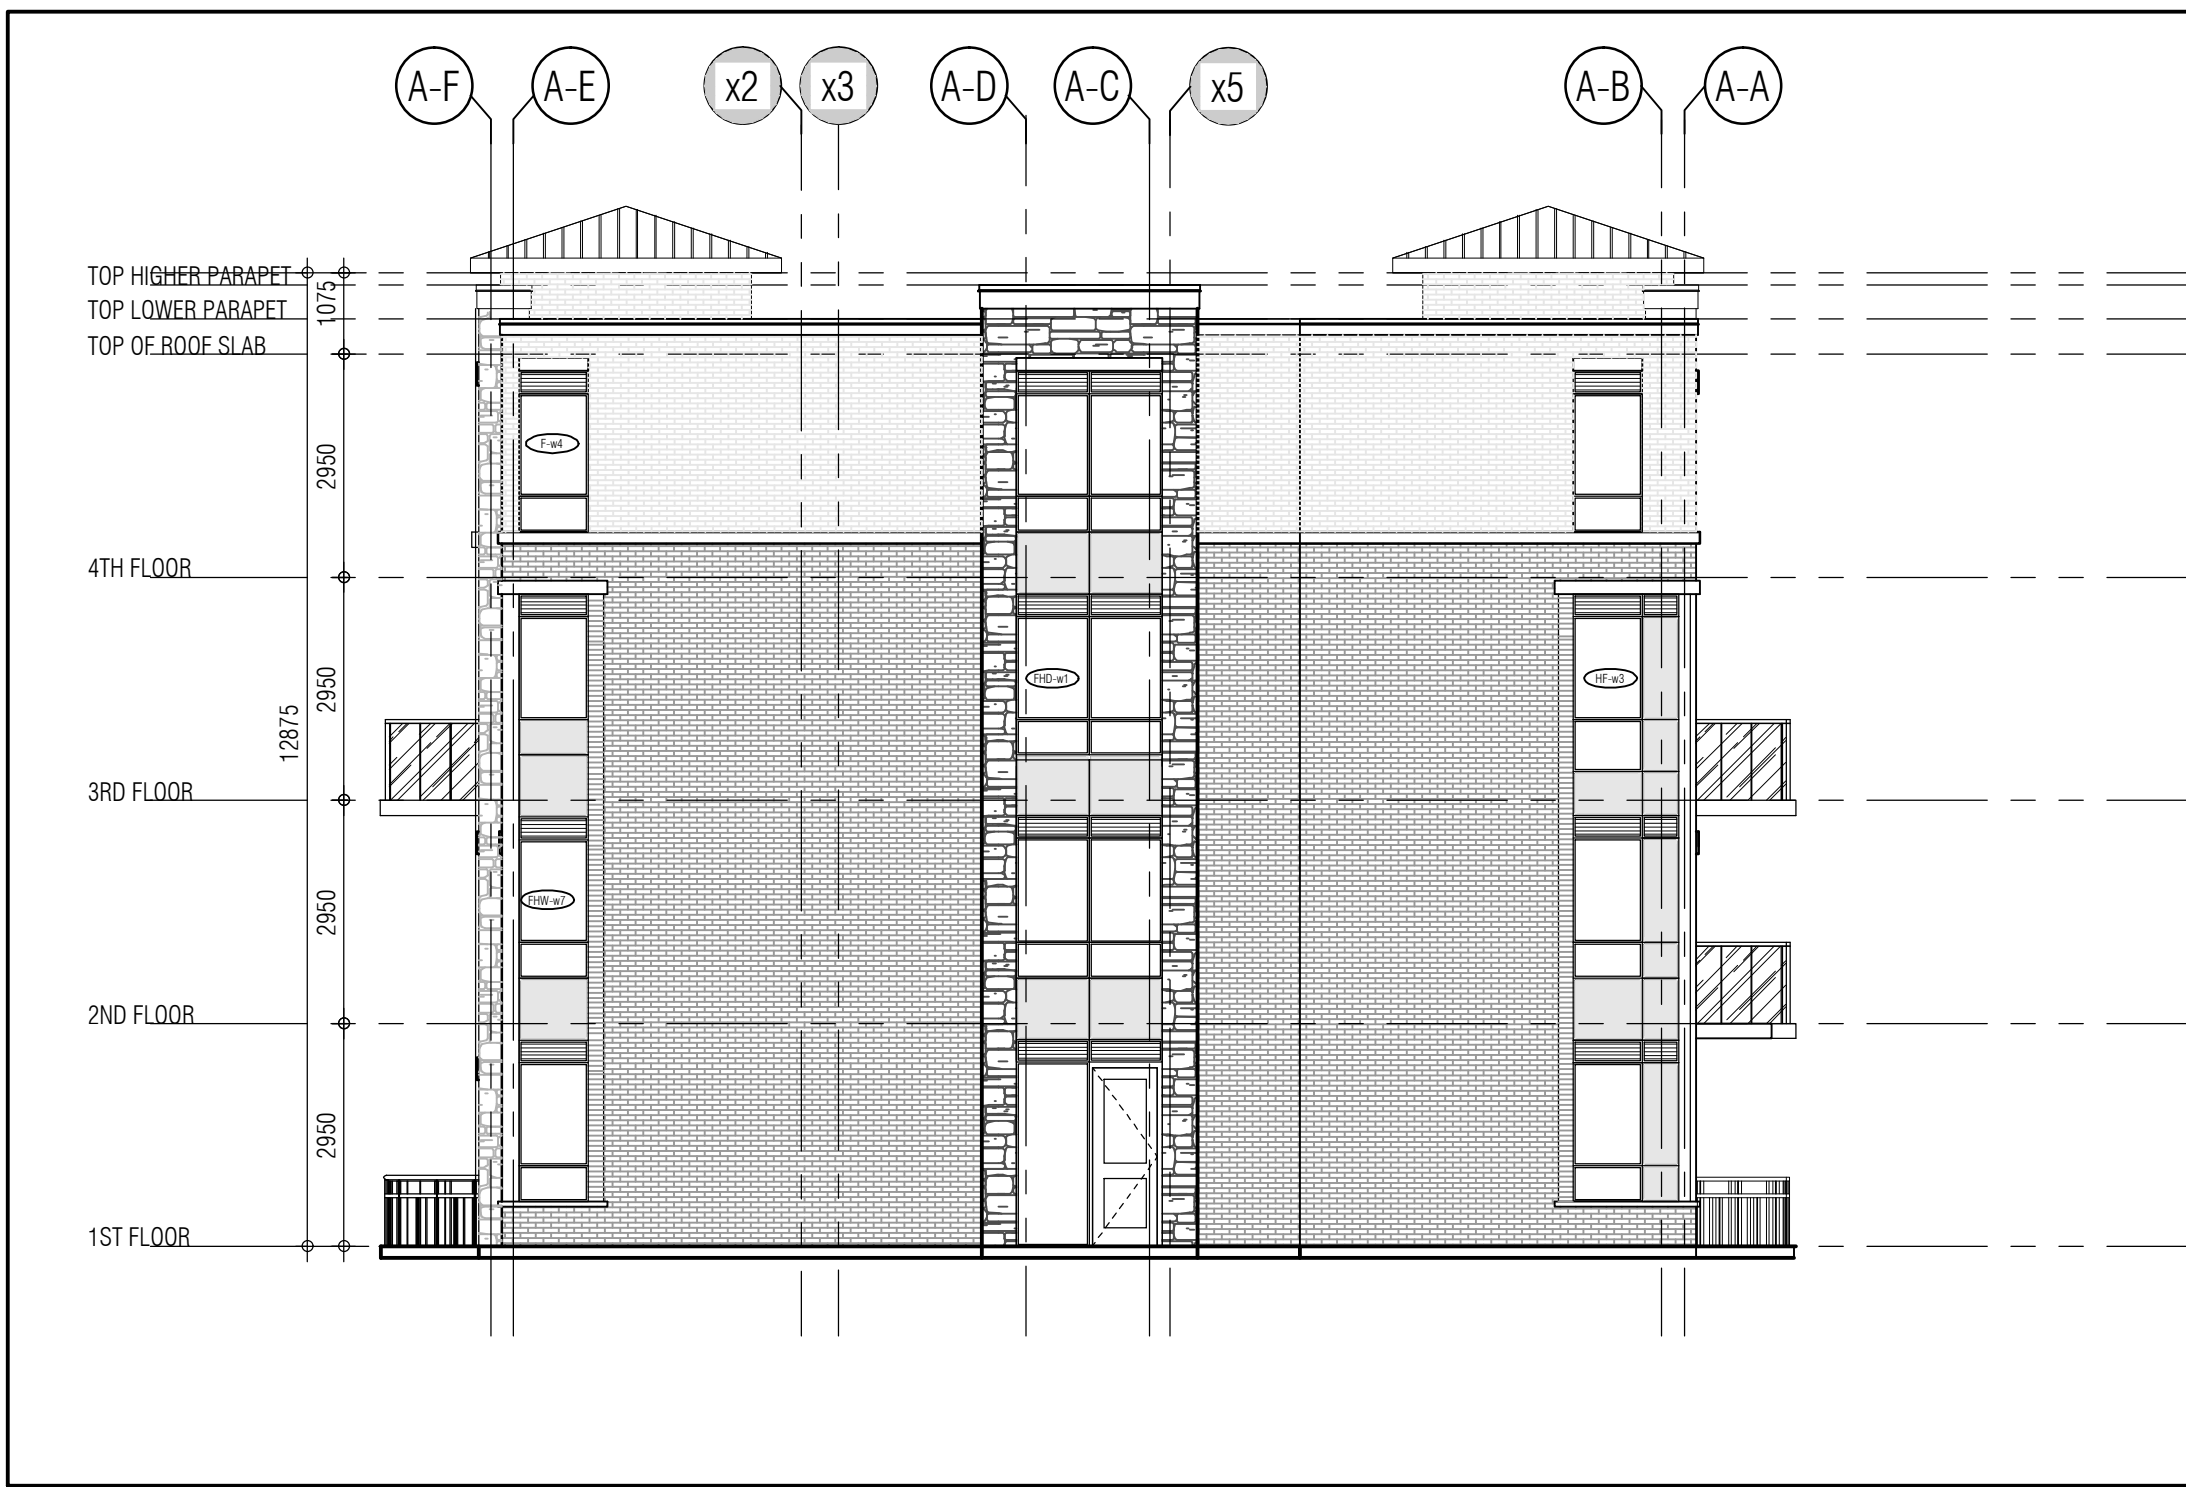

NORTH ELEVATION 3
1:100 A401

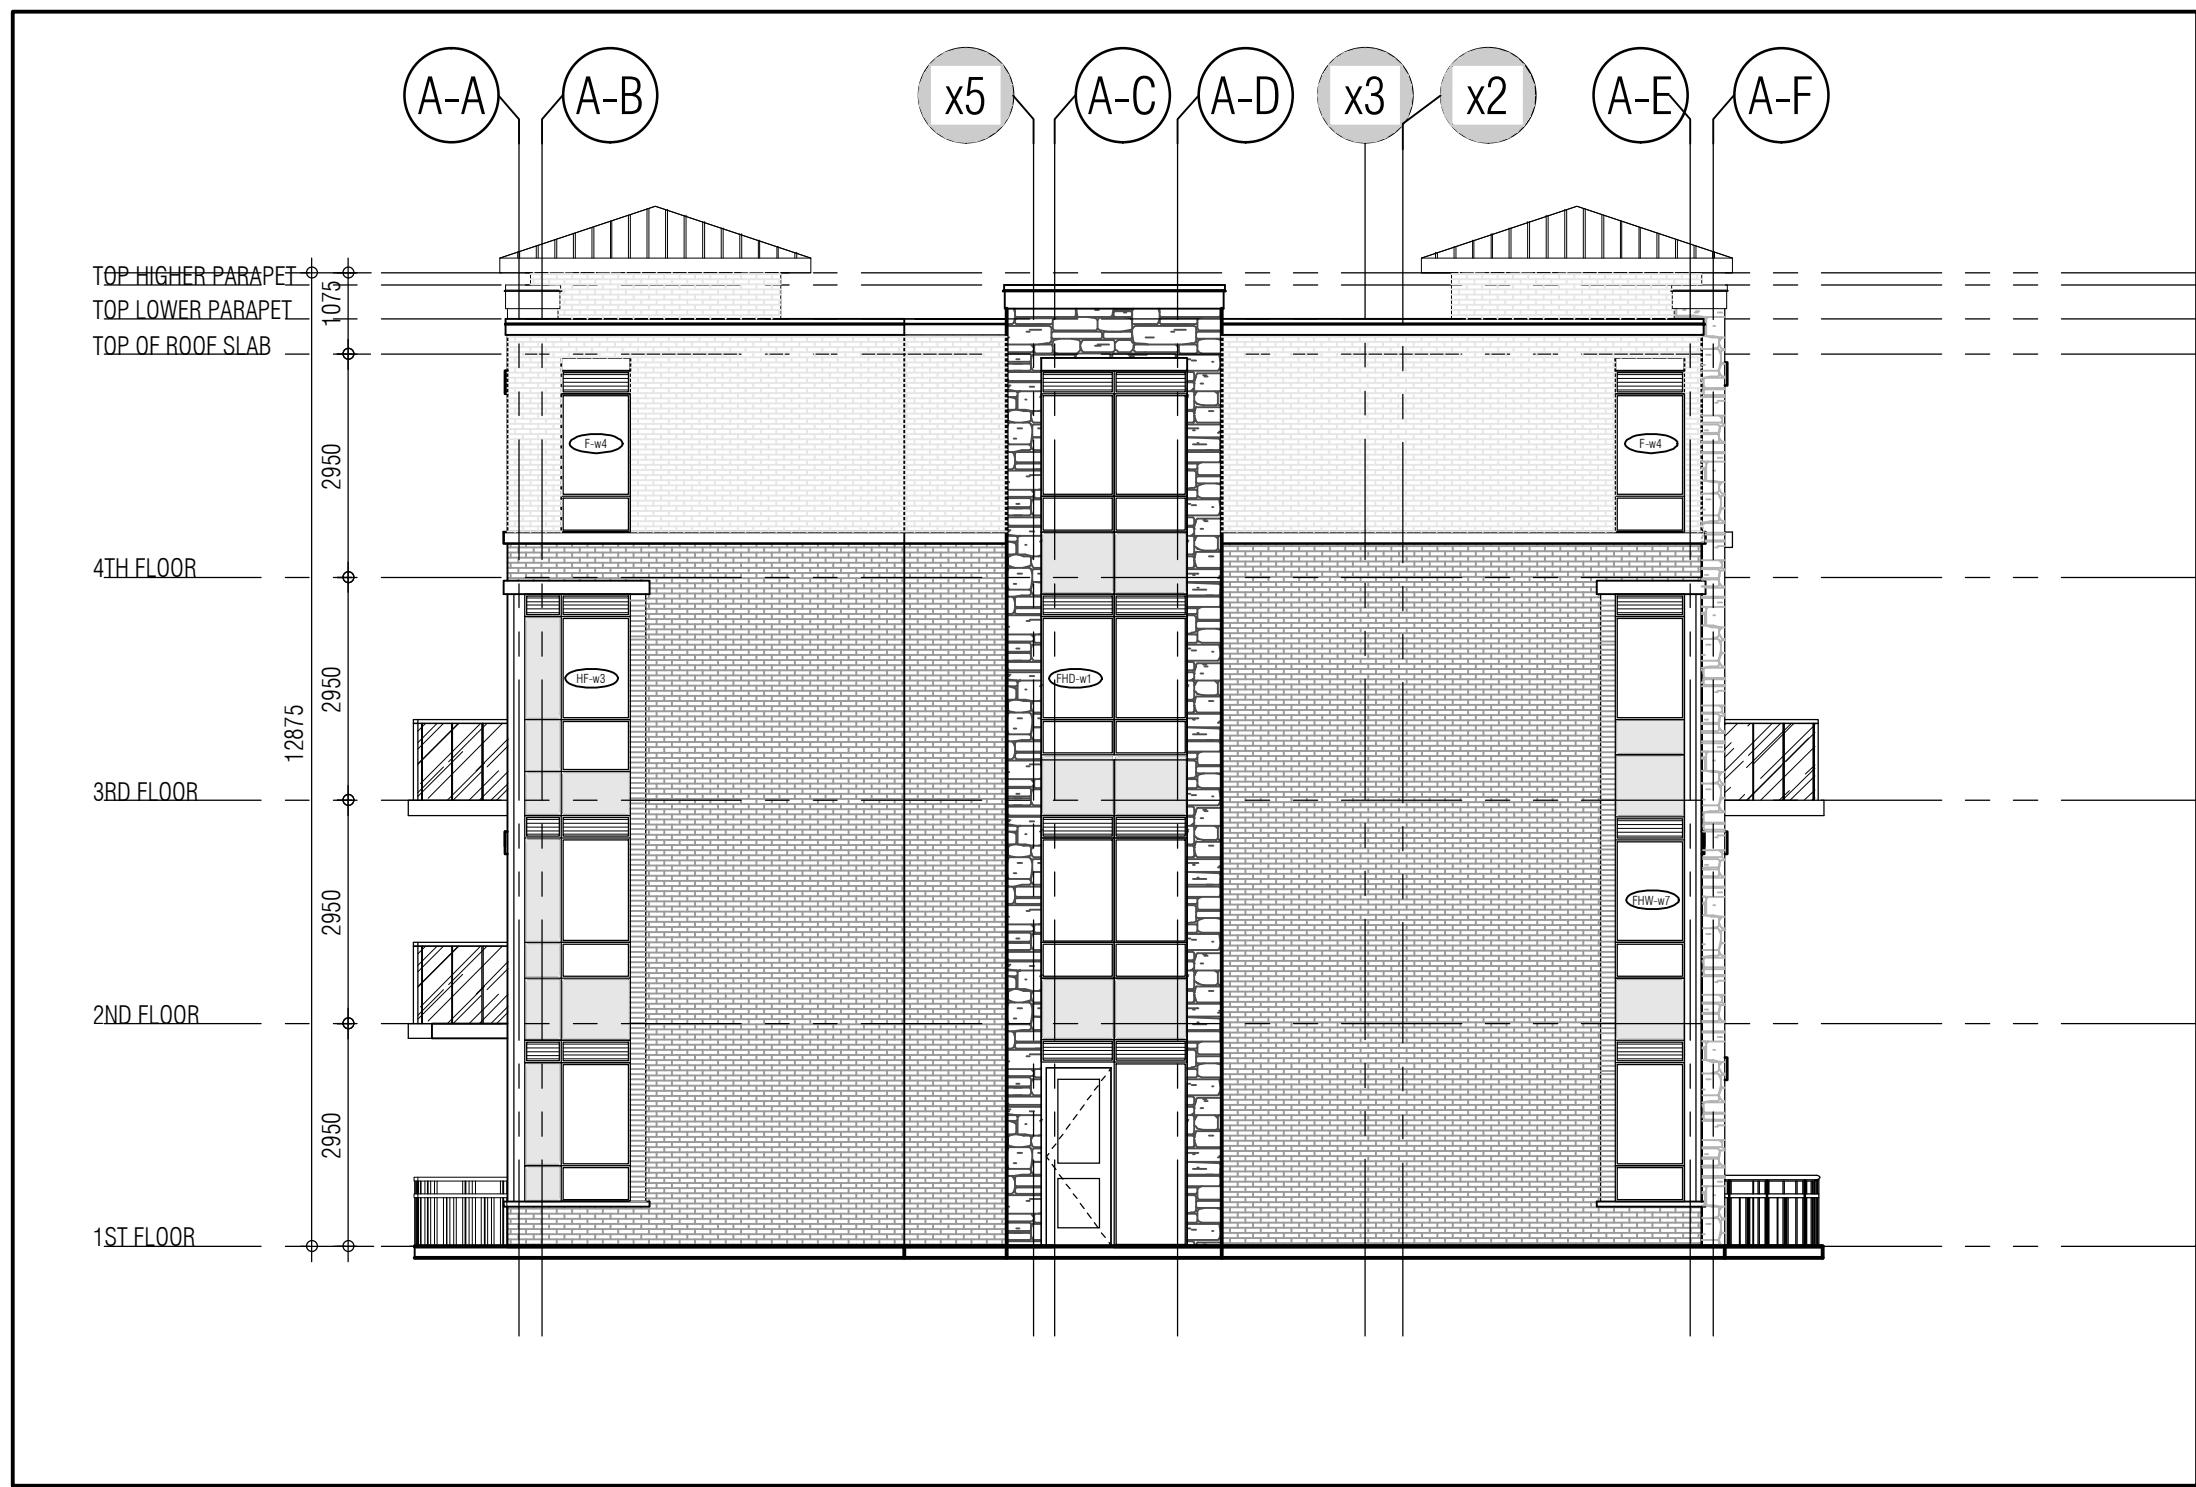

SOUTH ELEVATION 4
1:100 A401

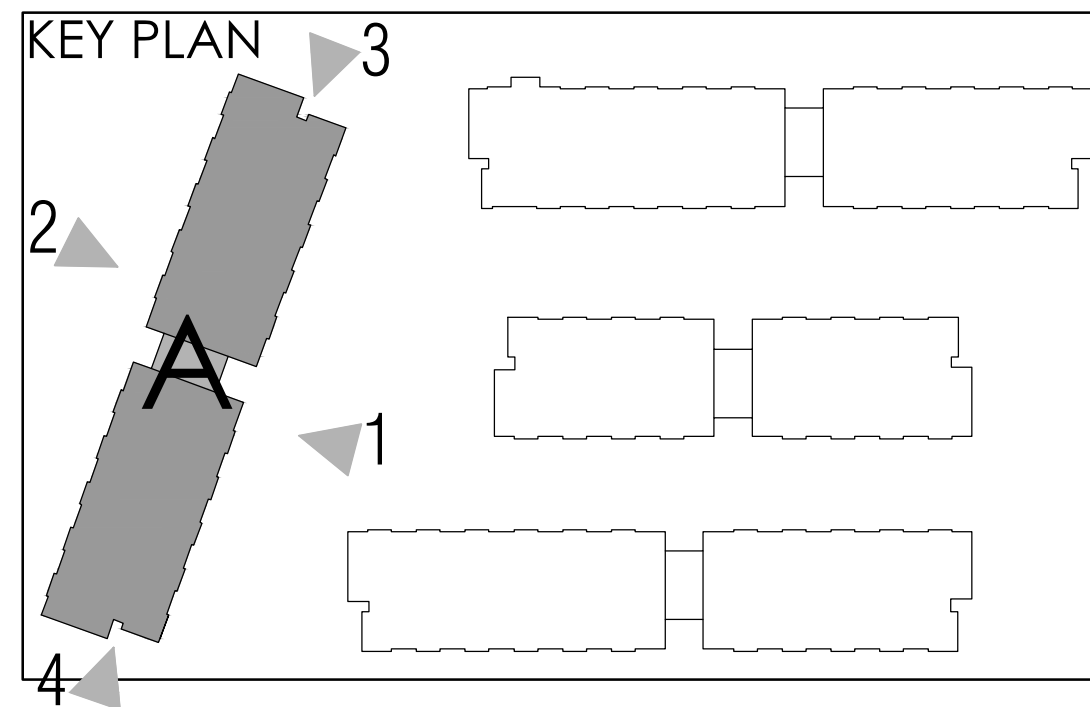

01. Aug 02 2019 Issued for tender

Issued for revisions



BRAMPTON
PROJECT ARCHITECT: B. GRAZIANI
ASSISTANT ARCHITECT: R. LINCOLN
DRAWN BY: F.C./M.B.
CHECKED BY: D. BIASE (G. COLANGELO)
PLOT DATE: SEP 18 2019
JOB # 1331.15

ATTMAR + PALLESCHI DRIVE ONTARIO

BUILDING A ELEVATIONS OVERALL ELEVATIONS

1:100 A401

TITLEBLOCK SIZE: 915 x 1200


[illegible]

01. Aug.02.2019 issued for tender

MATERIALS LEGEND	
	GL VISION GLASS GLS GLASS GLAZE
	GLZ GLAZED SPANDREL PANEL
	ML PREFINISHED METAL LOUVRE/GRILLE
	SV STONE VENEER
	DBV BRICK VENER (DARK) BRICK VENER BRICKGLAZED
	DBV BRICK VENER (LIGHT) BRICK VENER BRICKGLAZED
	PCG PRECAST CONCRETE HEADER/GRILL
	GLS GLASS RAILING
	ML PREFINISHED METAL (FLASHING)

NOTE: * EXACT SPOURED COLOUR NOT AVAILABLE, ATTEMPT CLOSE MATCH
NOTES AND TOLERANCE: ALLOW 1/4" FOR ADJUSTS; SPOURED

issued for revisions

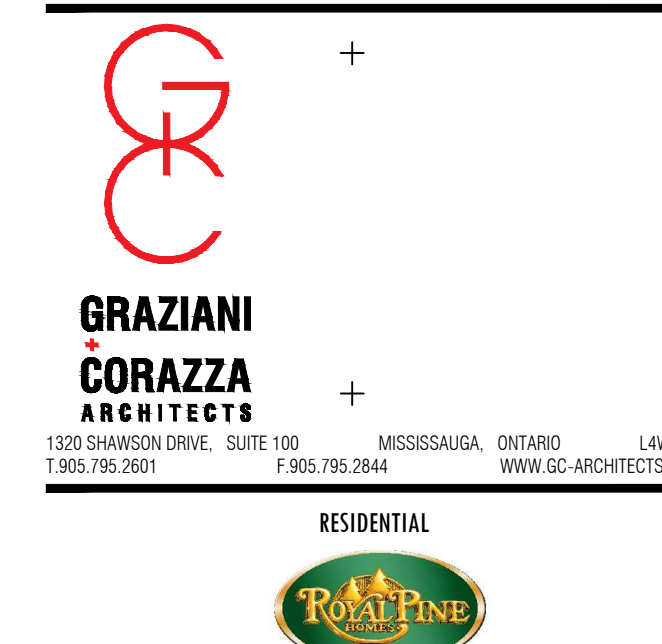

ATTMAR + PALLESCHI DRIVE		ONT.
BRAMPTON		
PROJECT ARCHITECT:	B. GRAZIANI	
ASSISTANT DESIGNER:	R. LINCOLN	
DRAWN BY:	F. C./M.B.	
CHECKED BY:	D. BIASE/G. COLANGELO	
PLOT DATE:	SEP. 18, 2019	
JOB #	1331.15	

EAST ELEVATION
BUILDING A

1:50 **A-401a**

TITLEBLOCK SIZE: 915 x 1200

THIS DRAWING, AS AN INSTRUMENT OF SERVICE, IS PROVIDED BY AND IS THE PROPERTY OF GRAZIANI-CORAZZANI ARCHITECTS INC. THE CONTRACTOR MUST VERIFY AND ACCEPT RESPONSIBILITY FOR ALL DIMENSIONS AND CONDITIONS ON SITE AND MUST KEEP GRAZIANI-CORAZZANI ARCHITECTS INC. OF ANY VARIATIONS FROM THE SUPPLIED INFORMATION. GRAZIANI-CORAZZANI ARCHITECTS INC. IS NOT RESPONSIBLE FOR THE ACCURACY OF SURVEY, STRUCTURAL, MECHANICAL, ELECTRICAL, AND OTHER ENGINEERING INFORMATION SHOWN ON THIS DRAWING. REFER TO THE APPROPRIATE ENGINEERING DRAWINGS BEFORE PROCEEDING WITH THE WORK. CONSTRUCTION MUST CONFORM TO ALL APPLICABLE CODES AND REQUIREMENTS OF THE AUTHORITIES HAVING JURISDICTION. ANALYSIS CHANGES NOTED: NO INVESTIGATION HAS BEEN UNDERTAKEN OR REPORTED ON BY THE OFFICE IN REGARD TO THE ENVIRONMENTAL CONDITION OF THIS SITE.

THIS DRAWING IS NOT TO BE SCALED. ALL ARCHITECTURAL SYMBOLS INDICATED ON THIS DRAWING ARE GRAPHIC REPRESENTATIONS ONLY.

CONDITIONS FOR ELECTRONIC INFORMATION TRANSFER:

ELECTRONIC INFORMATION IS SUPPLIED TO THE OTHER ASSOCIATED FRAMES TO ASSIST THEM IN THE EXECUTION OF THEIR WORK. REVIEW THE RECEIPT FRAMES MUST DETERMINE THE COMPLETENESS APPROPRIATENESS RELEVANCE OF THE INFORMATION IN RESPECT TO THEIR PARTICULAR RESPONSIBILITY.

1. GRAZIANI-CORAZZANI ARCHITECTS INC. SHALL NOT BE RESPONSIBLE FOR: 1.1. ERRORS, OMISSIONS, INADEQUACIES DUE TO LOSS OF INFORMATION IN WHOLE OR PART WHEN INFORMATION IS TRANSFERRED. 1.2. TRANSFORMATION OF ANY INFO OF CHANGE TO THE RECEIVING ELECTRONIC SYSTEM WHEN INFORMATION IS TRANSFERRED.

01: Aug.02.2019 issued for tender

REF. 2-A-401a2 FOR CONTINUATION



BUILDING A-WEST ELEVATION 1
1:50 A-401a2



BUILDING A-WEST ELEVATION 2
1:50 A-401a2

MATERIALS LEGEND	
	MASON GLASS
	GLAZED SPANDREL PANEL
	PREFINISHED METAL LOUVRE/GRILLE
	STONE VENEER
	BRICK VENEER (DARK)
	BRICK VENEER (LIGHT)
	PRECAST CONCRETE HEADER/GRILL
	GLASS RAILING
	PREFINISHED METAL (FLASHING)

NOTE: IF EXACT SPECIFIED COLOUR IS NOT AVAILABLE, ATTEMPT COLOUR MATCH AND SUBMIT ALTERNATIVE SAMPLES FOR ARCHITECT'S APPROVAL.

Issued for revisions

**GRAZIANI
CORAZZANI
ARCHITECTS**


RESIDENTIAL

ATTMAR + PALLESCHI DRIVE


BRAMPTON ONTARIO

PROJECT ARCHITECT: B. GRAZIANI
ASSISTANT DESIGNER: R. LINCOLN
DRAWN BY: F.C./M.B.
CHECKED BY: D. BIAISE/G. COLANGELO
PLOT DATE: SEP. 18. 2019
JOB # 1331.15


**WEST ELEVATION
BUILDING A**

THIS DRAWING, AS AN INSTRUMENT OF SERVICE, IS PROVIDED BY AND IS THE PROPERTY OF GRAZIANI-CORAZZA ARCHITECTS INC. THE CONTRACTOR MUST VERIFY AND ACCEPT RESPONSIBILITY FOR ALL DIMENSIONS AND CONDITIONS ON SITE AND MUST KEEP GRAZIANI-CORAZZA ARCHITECTS INC. OF ANY VARIATIONS FROM THE SUPPLIED INFORMATION. GRAZIANI-CORAZZA ARCHITECTS INC. IS NOT RESPONSIBLE FOR THE ACCURACY OF SURVEY, STRUCTURAL, MECHANICAL, ELECTRICAL, AND OTHER ENGINEERING INFORMATION SHOWN ON THIS DRAWING. REFER TO THE APPROPRIATE ENGINEERING DRAWINGS BEFORE PROCEEDING WITH THE WORK. CONSTRUCTION MUST CONFORM TO ALL APPLICABLE CODES AND REQUIREMENTS OF THE AUTHORITIES HAVING JURISDICTION. ALWAYS CONSULT THE SPECIFICATIONS AND NOTATIONS ON THIS DRAWING FOR ANY CHANGES. NOTES: NO INVESTIGATION HAS BEEN UNDERTAKEN OR REPORTED ON BY THIS OFFICE IN REGARD TO THE ENVIRONMENTAL CONDITION OF THIS SITE. THIS DRAWING IS NOT TO BE SCALED. ALL ARCHITECTURAL SYMBOLS INDICATED ON THIS DRAWING ARE GRAPHIC REPRESENTATIONS ONLY. CONDITIONS FOR ELECTRONIC INFORMATION TRANSFER: ELECTRONIC INFORMATION IS SUPPLIED TO THE OTHER ASSOCIATED FRAMS TO ASSIST THEM IN THE EXECUTION OF THEIR WORK. THE RECIPIENT FRAMS MUST EXTEND THE COMPREHENSIVE APPROPRIATE RELEVANCE OF THE INFORMATION IN RESPECT TO THEIR PARTICULAR RESPONSIBILITY. GRAZIANI-CORAZZA ARCHITECTS INC. SHALL NOT BE RESPONSIBLE FOR: 1. ERRORS, OMISSIONS, INADEQUACIES DUE TO LOSS OF INFORMATION IN WHOLE OR PART WHEN INFORMATION IS TRANSFERRED. 2. TRANSMISSION OF ANY LOSS OF CHANGE TO THE RECEIVING ELECTRONIC SYSTEM WHEN INFORMATION IS TRANSFERRED.

01. Aug.02.2019 issued for tender

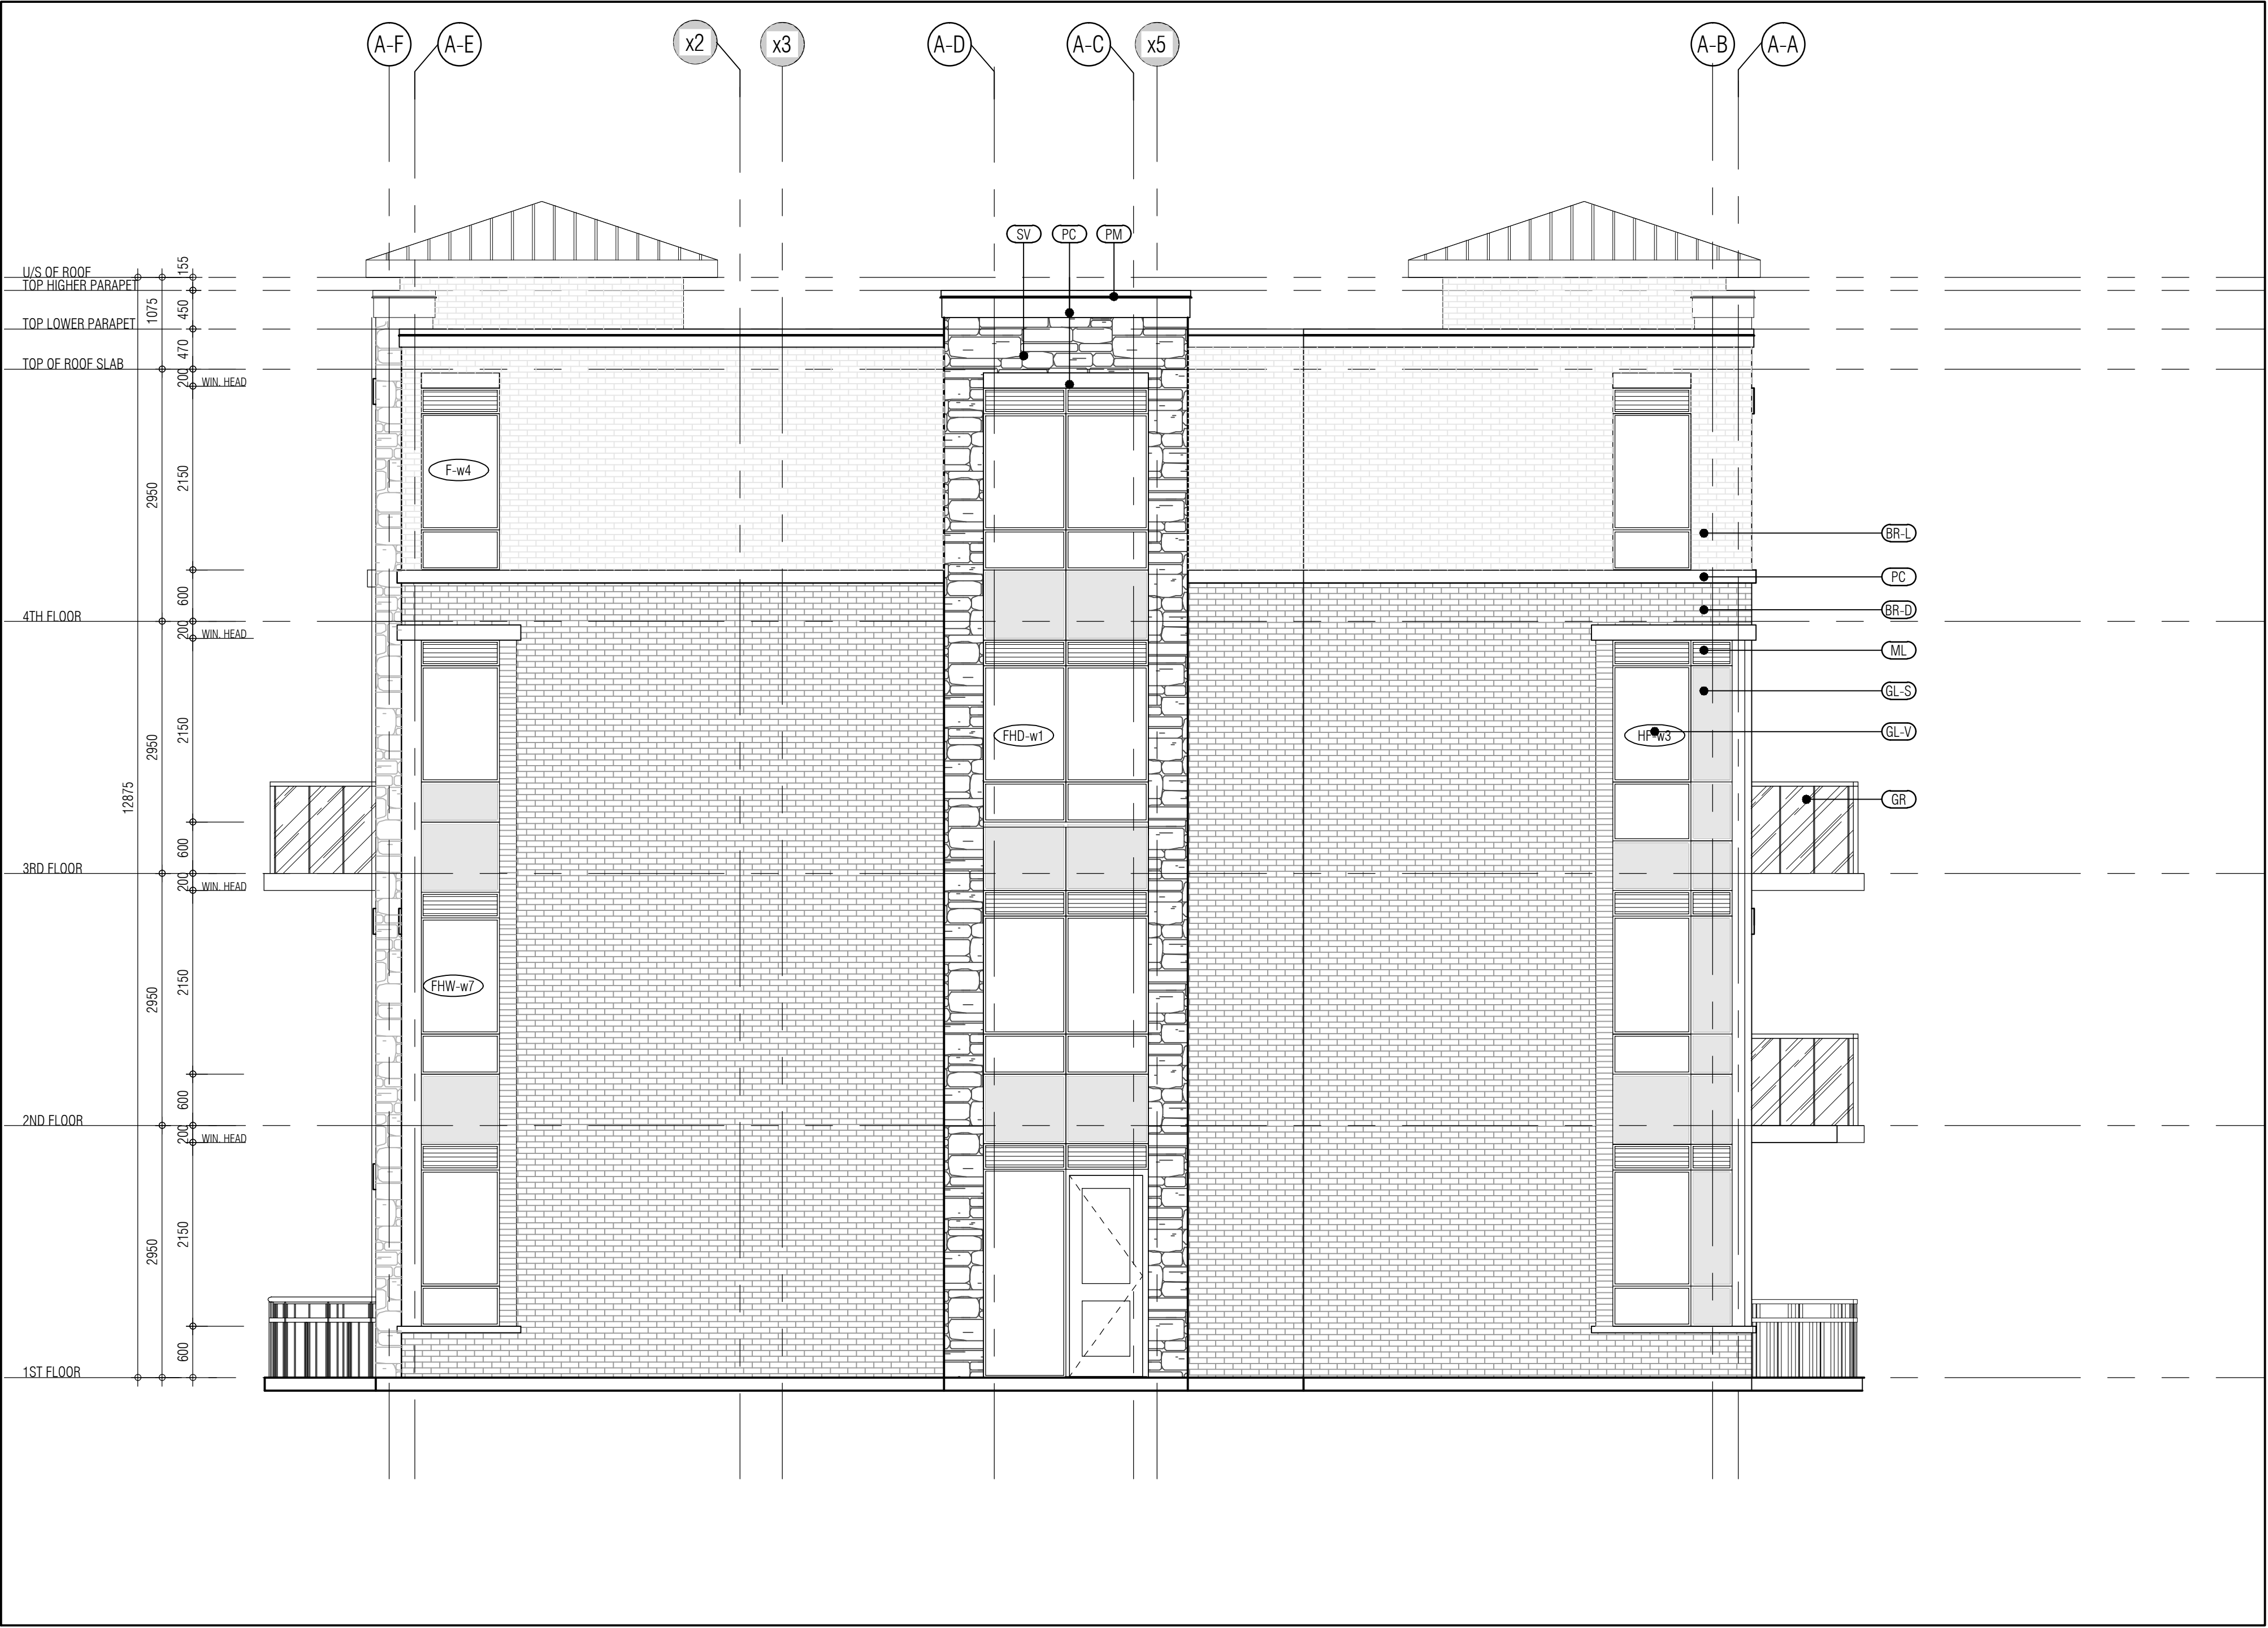

BUILDING A-NORTH ELEVATION 1
1:50 A-401a3

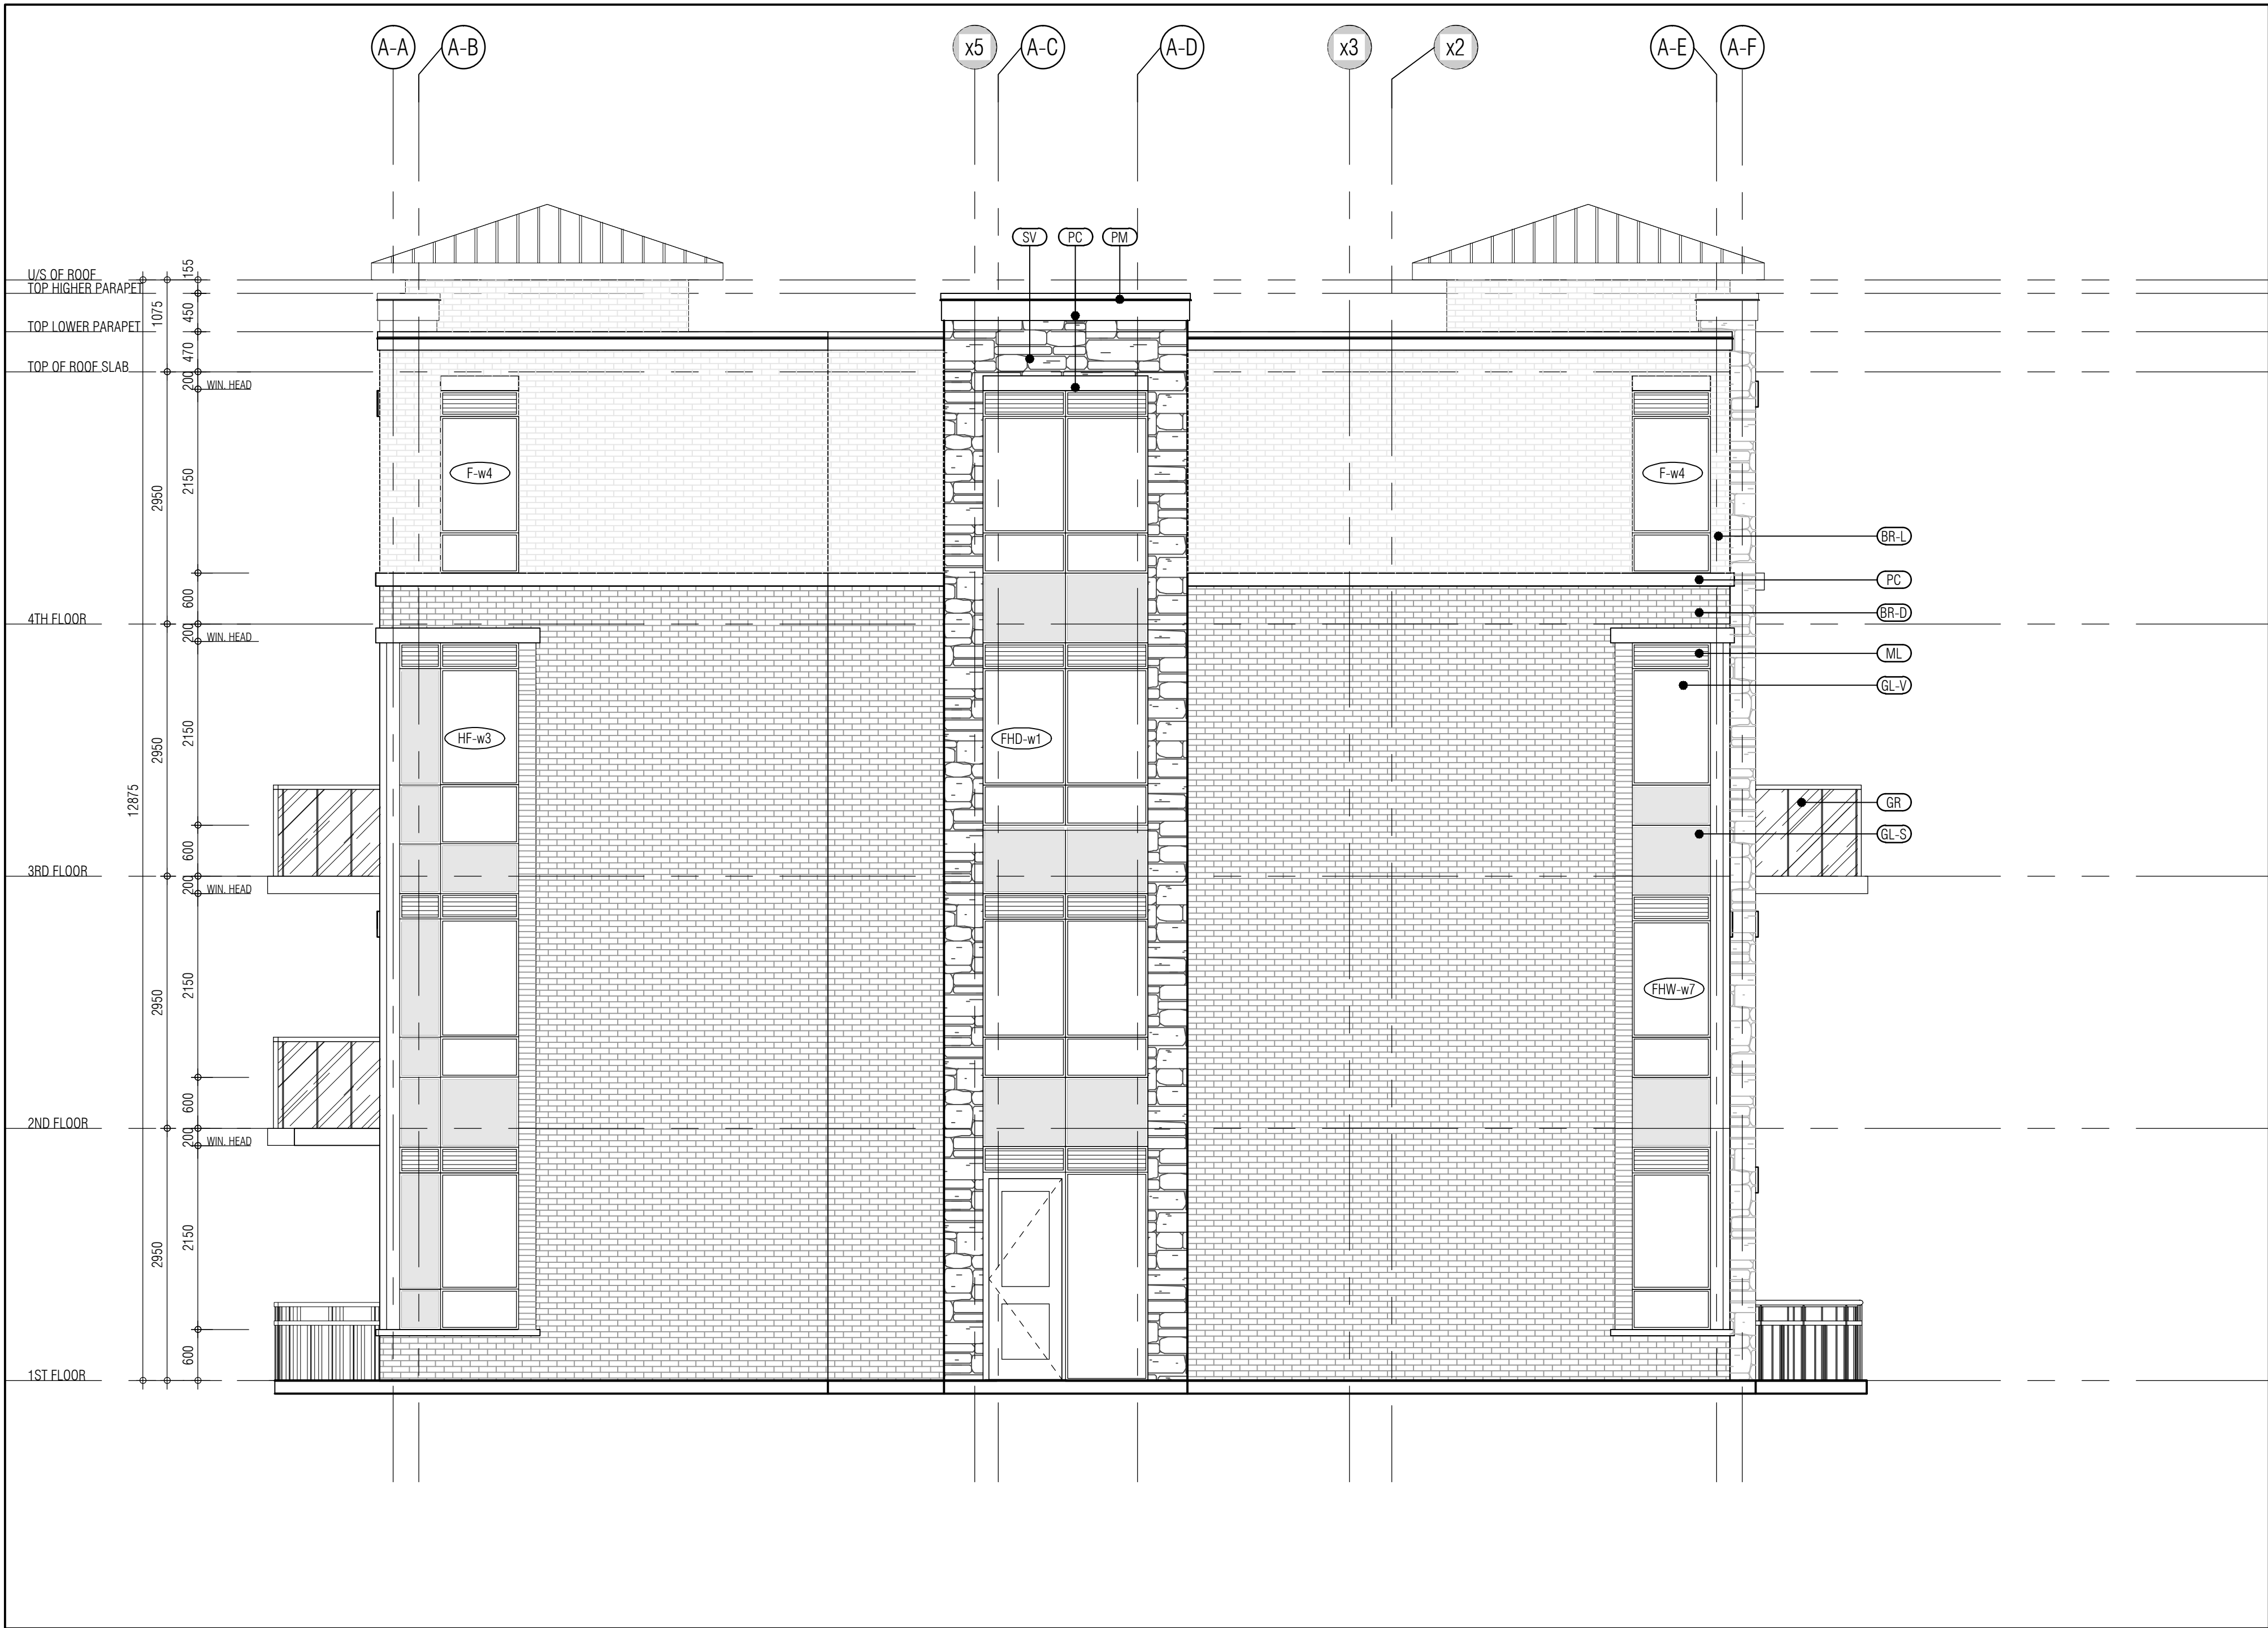

BUILDING A-SOUTH ELEVATION 2
1:50 A-401a3

MATERIALS LEGEND	
	MASON GLASS
	GLAZED SPANDREL PANEL
	PREFINISHED METAL LOUVER/GRILLE
	STONE VENEER
	BRICK VENEER (DARK)
	BRICK VENEER (LIGHT)
	PRECAST CONCRETE HEADER/GRILL
	GLASS RAILING
	PREFINISHED METAL (FLASHING)

NOTE: IF EXACT SPECIFIED COLOUR IS NOT AVAILABLE, ATTEMPT COLOUR MATCH AND SUBMIT ALTERNATIVE SAMPLES FOR ARCHITECT'S APPROVAL.

Issued for revisions

**GRAZIANI
CORAZZA
ARCHITECTS**


RESIDENTIAL

ATTMAR + PALLESCHI DRIVE

BRAMPTON ONTARIO

PROJECT ARCHITECT: B. GRAZIANI
ASSISTANT DESIGNER: R. LINCOLN
DRAWN BY: F.C./M.B.
CHECKED BY: D. BIASI (G. COLANGELO)
PLOT DATE: SEP. 18. 2019
JOB # 1331.15

**NORTH & SOUTH ELEVATION
BUILDING A**

THIS DRAWING, AS AN INSTRUMENT OF SERVICE, IS PROVIDED BY AND IS THE PROPERTY OF GRAZIANI-CORAZZA ARCHITECTS INC. THE CONTRACTOR MUST VERIFY AND ACCEPT RESPONSIBILITY FOR ALL DIMENSIONS AND CONDITIONS ON SITE AND MUST KEEP GRAZIANI-CORAZZA ARCHITECTS INC. OF ANY VARIATIONS FROM THE SUPPLIED INFORMATION. GRAZIANI-CORAZZA ARCHITECTS INC. IS NOT RESPONSIBLE FOR THE ACCURACY OF SURVEY, STRUCTURAL, MECHANICAL, ELECTRICAL, AND OTHER ENGINEERING INFORMATION SHOWN ON THIS DRAWING. REFER TO THE APPROPRIATE ENGINEERING DRAWINGS BEFORE PROCEEDING WITH THE WORK. CONSTRUCTION MUST CONFORM TO ALL APPLICABLE CODES AND REQUIREMENTS OF THE AUTHORITIES HAVING JURISDICTION. ANALYSIS CONFORMANCE NOTED: NO INVESTIGATION HAS BEEN UNDERTAKEN OR REPORTED ON BY THE OFFICE IN RELATION TO THE ENVIRONMENTAL CONDITION OF THIS SITE.





THIS DRAWING IS NOT TO BE SCALED. ALL ARCHITECTURAL SYMBOLS INDICATED ON THIS DRAWING ARE GRAPHIC REPRESENTATIONS ONLY.

CONDITIONS FOR ELECTRONIC INFORMATION TRANSFER:

ELECTRONIC INFORMATION IS SUPPLIED TO THE OTHER ASSOCIATED FRAMES TO ASSIST THEM IN THE EXECUTION OF THEIR WORK. REVIEW THE RECEIPT FRAMES MUST DETERMINE THE CORRESPONDING APPROPRIATE RELEVANCE OF THE INFORMATION IN RESPECT TO THEIR PARTICULAR RESPONSIBILITY.

GRAZIANI-CORAZZA ARCHITECTS INC. SHALL NOT BE RESPONSIBLE FOR:

1. OTHER, UNDESIGNED, UNDESIGNED DUE TO USE OF INFORMATION IN WHOLE OR PART WHEN INFORMATION IS TRANSFERRED.
2. TRANSMISSION OF ANY INFO OR CHANGE TO THE RECEIVING ELECTRONIC SYSTEM WHEN INFORMATION IS TRANSFERRED.

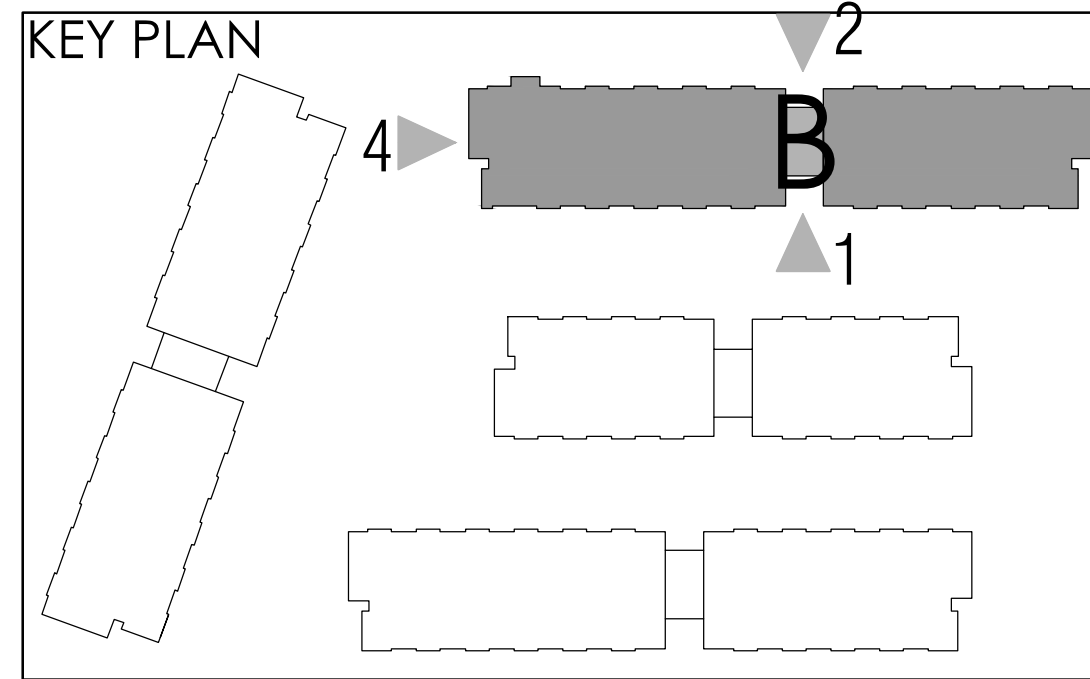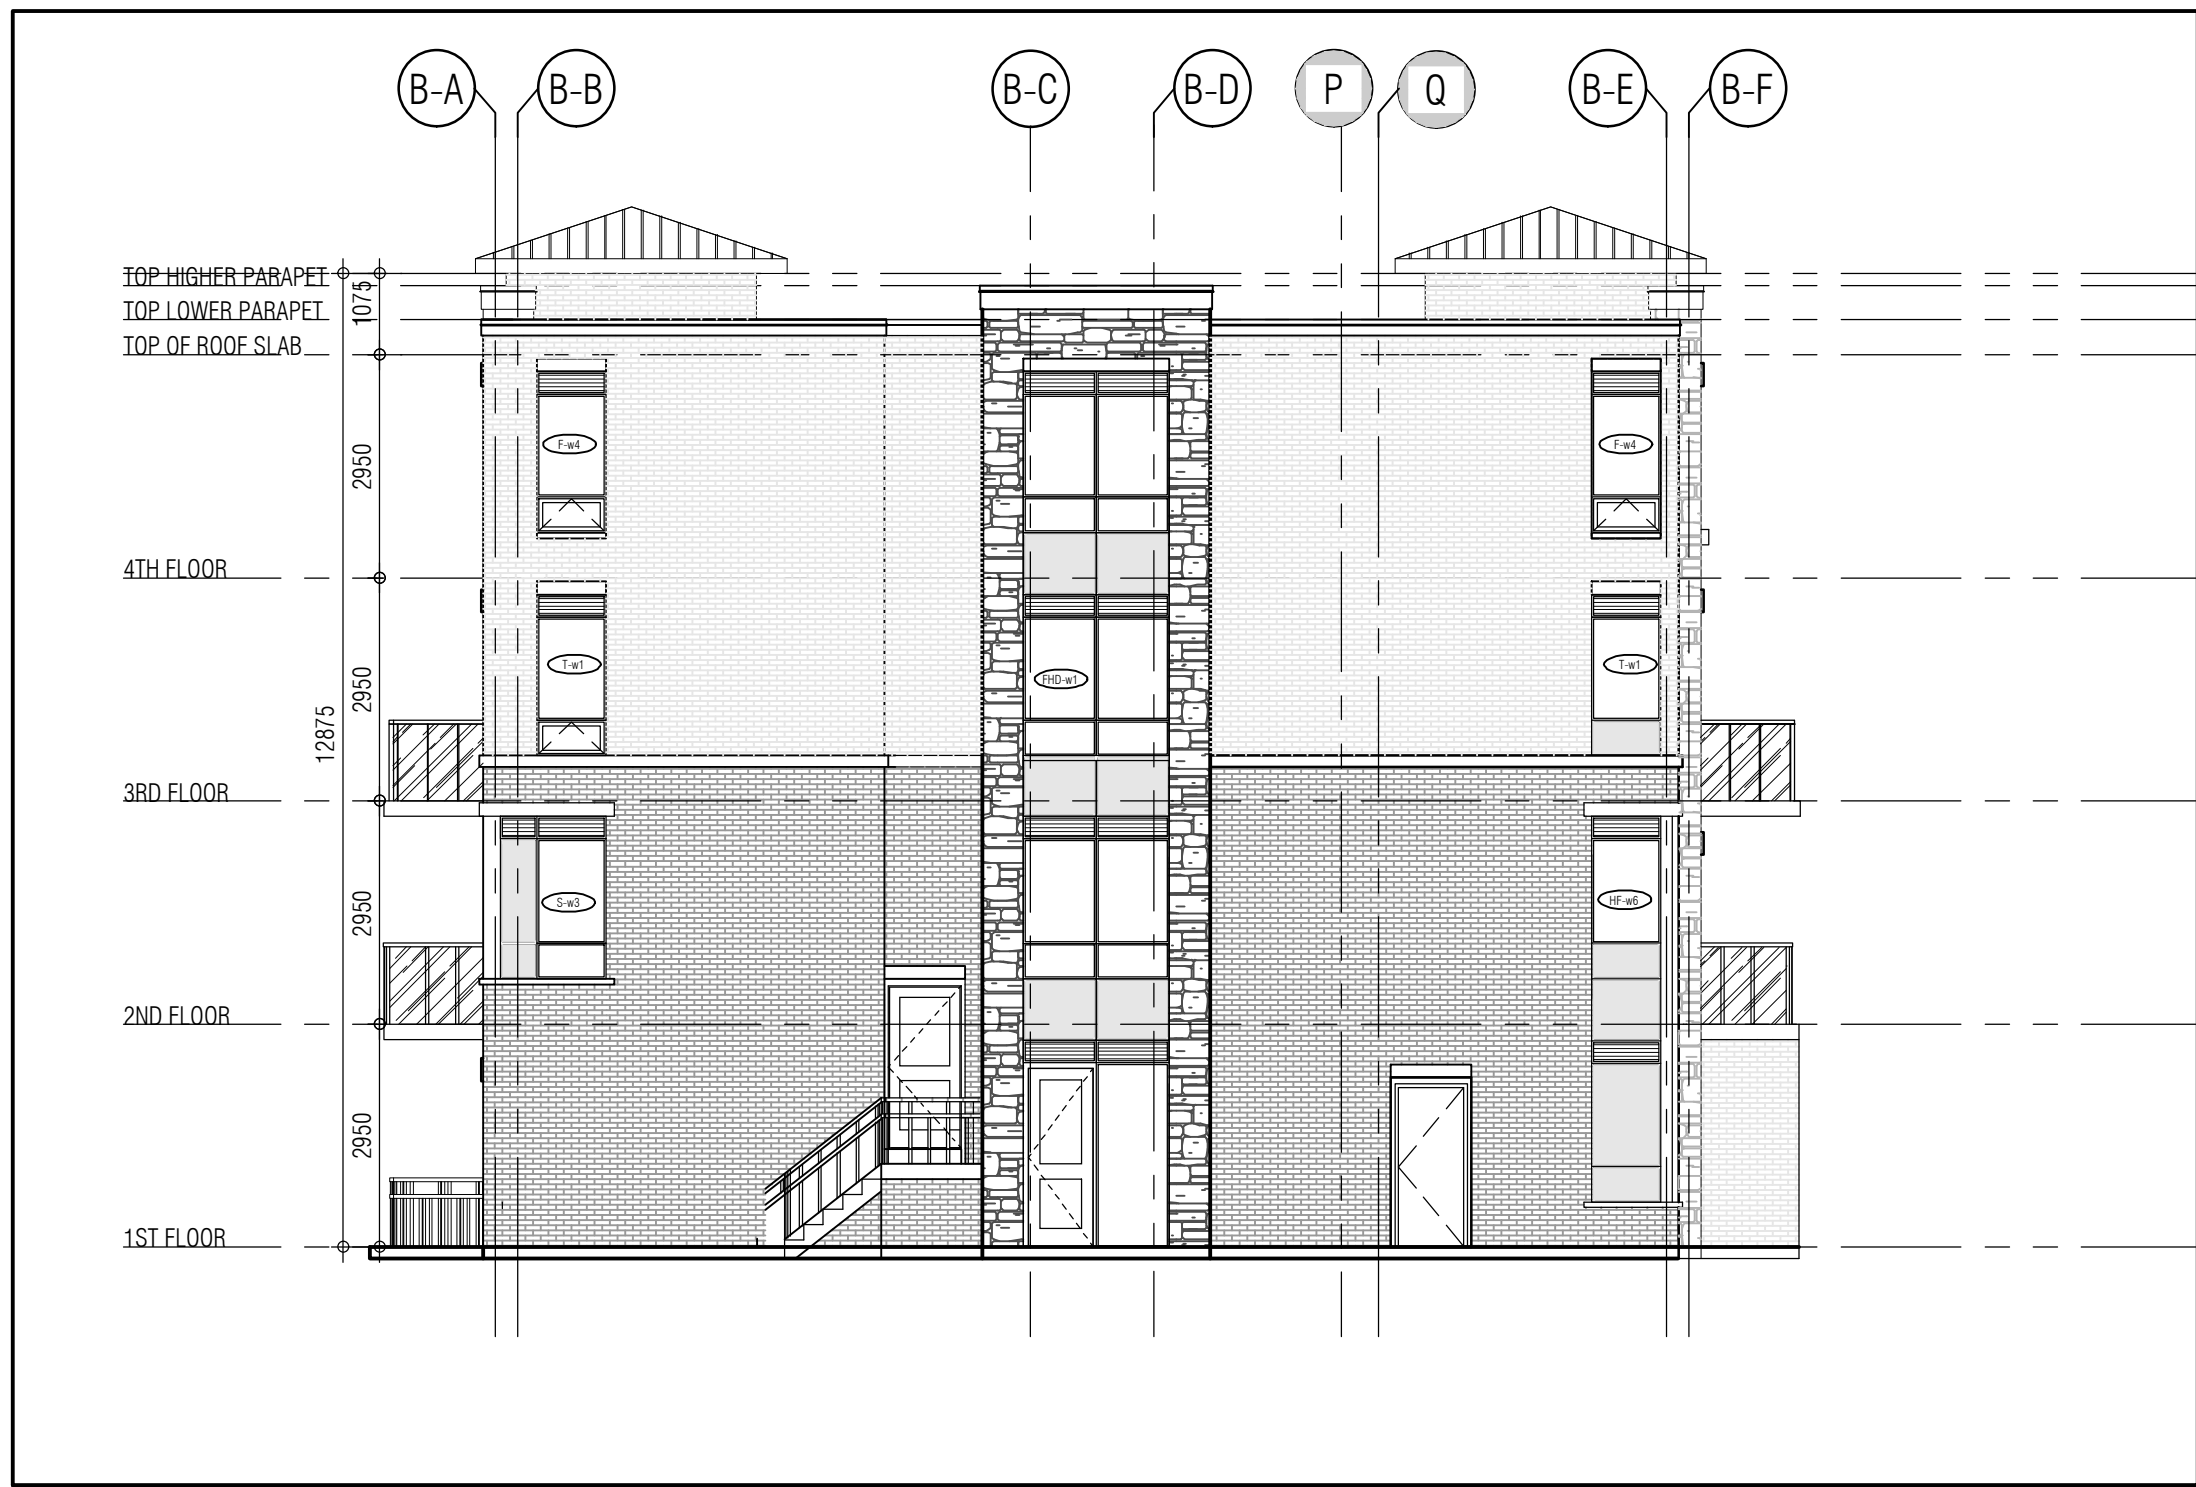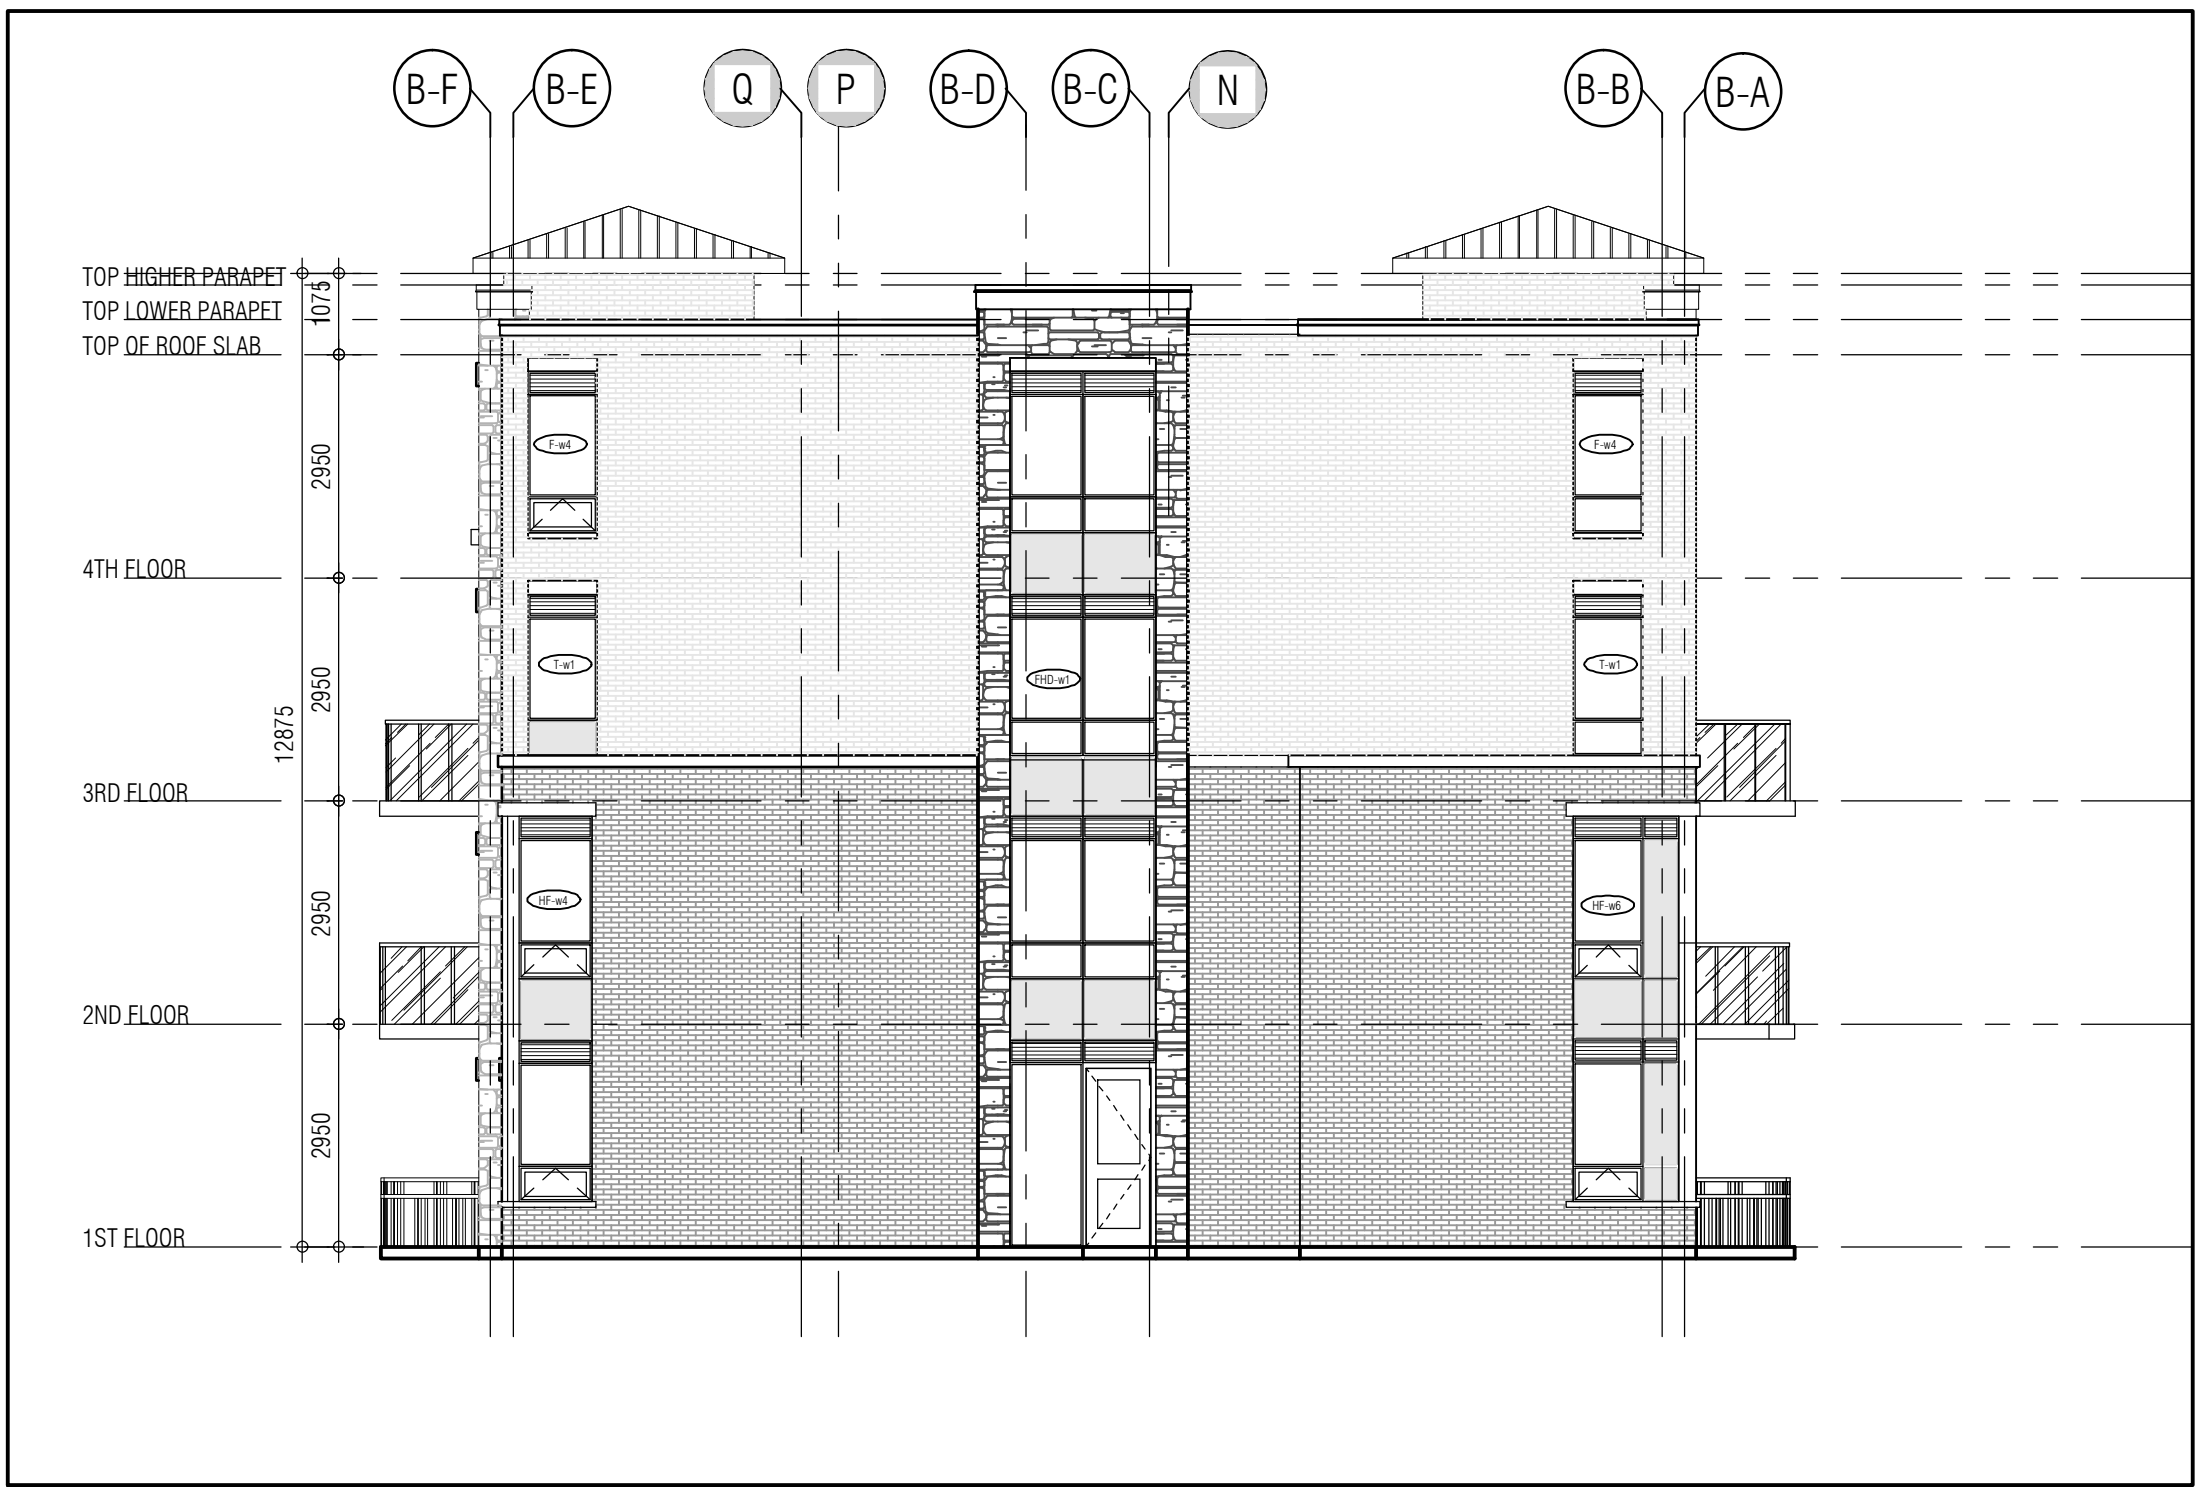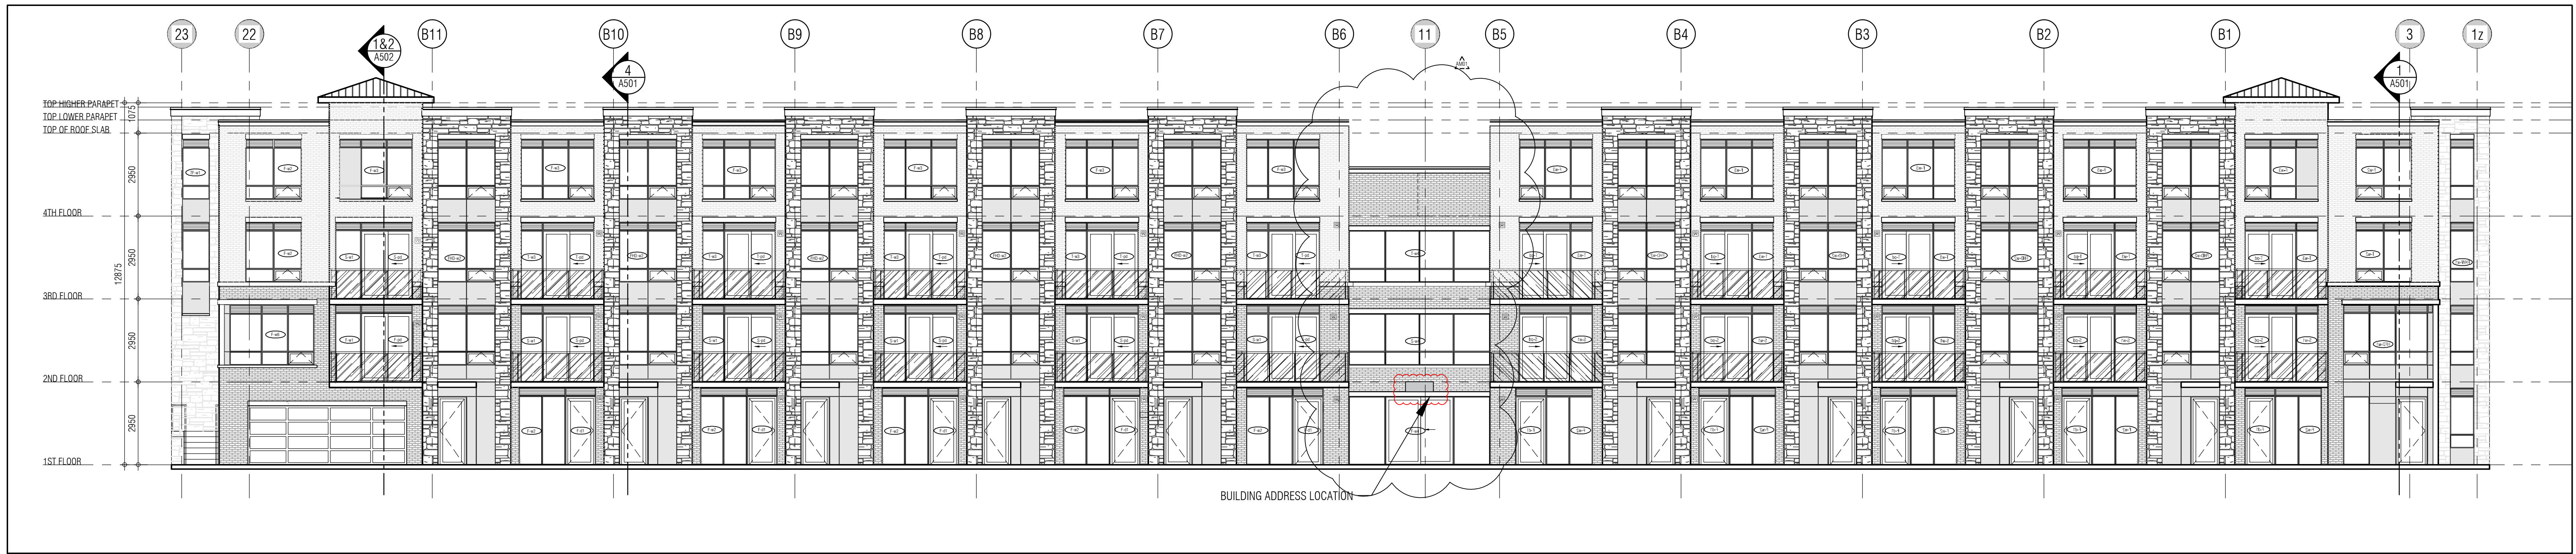

01. Aug 02 2019 Issued for tender

Issued for revisions



1000 SHEPPARD AVENUE EAST, SUITE 100, MISSISSAUGA, ONTARIO L4X 1C3
TEL: 905.276.2600 FAX: 905.276.2644 WWW.GC-ARCHITECTS.COM

BRAMPTON ATTAR + PALLESCHI DRIVE ONTARIO

PROJECT ARCHITECT: B. GRAZIANI
ASSISTANT DESIGNER: R. LINCOLN
DRAWN BY: F.C./M.B.
CHECKED BY: D. BIASI (G. COLANGELO)
PLOT DATE: SEP 18 2019
JOB #: 1331.15

BUILDING B ELEVATIONS
OVERALL ELEVATIONS

1:100 A402
TITLE BLOCK SIZE: 915 x 1200



BUILDING B-SOUTH ELEVATION 1
1:50 A-402b1

THIS DRAWING, AS AN INSTRUMENT OF SERVICE, IS PROVIDED BY AND IS THE PROPERTY OF GRAZIANI-CORAZZANI ARCHITECTS INC. THE CONTRACTOR MUST VERIFY AND ACCEPT RESPONSIBILITY FOR ALL DIMENSIONS AND CONDITIONS ON SITE AND MUST KEEP GRAZIANI-CORAZZANI ARCHITECTS INC. OF ANY VARIATIONS FROM THE SUPPLIED INFORMATION. GRAZIANI-CORAZZANI ARCHITECTS INC. IS NOT RESPONSIBLE FOR THE ACCURACY OF SURVEY, STRUCTURAL, MECHANICAL, ELECTRICAL, AND OTHER ENGINEERING INFORMATION SHOWN ON THIS DRAWING. REFER TO THE APPROPRIATE ENGINEERING DRAWINGS BEFORE PROCEEDING WITH THE WORK. CONSTRUCTION MUST CONFORM TO ALL APPLICABLE CODES AND REQUIREMENTS OF THE AUTHORITIES HAVING JURISDICTION. ANALYSIS CHANGES NOTED: NO INVESTIGATION HAS BEEN UNDERTAKEN OR REPORTED ON BY THE OFFICE IN REGARD TO THE ENVIRONMENTAL CONDITION OF THE SITE.

CONDITIONS FOR ELECTRONIC INFORMATION TRANSFER:

ELECTRONIC INFORMATION IS SUPPLIED TO THE OTHER ASSOCIATED FIRMS TO ASSIST THEM IN THE EXECUTION OF THEIR WORK. REVIEW THE RECEIPT FIRMS MUST DETERMINE THE COMPLETENESS APPROPRIATENESS RELEVANCE OF THE INFORMATION IN RESPECT TO THEIR PARTICULAR RESPONSIBILITY.

GRAZIANI-CORAZZANI ARCHITECTS INC. SHALL NOT BE RESPONSIBLE FOR:

1. OTHER ENGINEERING INFORMATION DUE TO LOSS OF INFORMATION IN WHOLE OR PART WHEN INFORMATION IS TRANSFERRED.

2. TRANSMISSION OF ANY LOSS OF DAMAGE TO THE RECEIVING ELECTRONIC SYSTEM WHEN INFORMATION IS TRANSFERRED.

01. Aug 02 2019 issued for tender

REF. 2-A-402b1 FOR CONTINUATION



BUILDING B-SOUTH ELEVATION 2
1:50 A-402b1

REF. 1-A-402b1 FOR CONTINUATION

MATERIALS LEGEND	
	GL-3 MASON GLASS
	GL-2 GLAZED SPANDREL PANEL
	GL-1 PREFINISHED METAL LOUVER/GRILLE
	ST-1 STONE VENEER
	BR-1 BRICK VENEER (DARK)
	BR-2 BRICK VENEER (LIGHT)
	PC-1 PRECAST CONCRETE HEADER/GRILLE
	GR-1 GLASS RAILING
	FM-1 PREFINISHED METAL (FLASHING)

NOTE: IF EXACT SPECIFIED COLOUR IS NOT AVAILABLE, ATTEMPT COLOUR MATCH AND SUBMIT ALTERNATIVE SAMPLES FOR ARCHITECT'S APPROVAL.

Issued for revisions:

**GRAZIANI
CORAZZANI
ARCHITECTS**

1100 DUNDAS STREET WEST, SUITE 100 MISSISSAUGA, ONTARIO L4W 1G3
TEL: 905-276-2800 FAX: 905-276-2844 WWW.GC-ARCHITECTS.COM

RESIDENTIAL

ATTMAR + PALLESCHI DRIVE

BRAMPTON ONTARIO

PROJECT ARCHITECT: B. GRAZIANI
ASSISTANT DESIGNER: R. LINCOLN
DRAWN BY: F.C./M.B.
CHECKED BY: D. BIASI (G. COLANGELO)
PLOT DATE: SEP. 18. 2019
JOB # 1331.15

**SOUTH ELEVATION
BUILDING B**



BUILDING B-NORTH ELEVATION 1
1:50 A-402b2

REF. 2-A-402b2 FOR CONTINUATION

THIS DRAWING, AS AN INSTRUMENT OF SERVICE, IS PROVIDED BY AND IS THE PROPERTY OF GRAZIANI-CORAZZANI ARCHITECTS INC. THE CONTRACTOR MUST VERIFY AND ACCEPT RESPONSIBILITY FOR ALL DIMENSIONS AND CONDITIONS ON SITE AND MUST KEEP GRAZIANI-CORAZZANI ARCHITECTS INC. OF ANY VARIATIONS FROM THE SUPPLIED INFORMATION. GRAZIANI-CORAZZANI ARCHITECTS INC. IS NOT RESPONSIBLE FOR THE ACCURACY OF SURVEY, STRUCTURAL, MECHANICAL, ELECTRICAL, AND OTHER ENGINEERING INFORMATION SHOWN ON THIS DRAWING. REFER TO THE APPROPRIATE ENGINEERING DRAWINGS BEFORE PROCEEDING WITH THE WORK. CONSTRUCTION MUST CONFORM TO ALL APPLICABLE CODES AND REQUIREMENTS OF THE AUTHORITIES HAVING JURISDICTION. ANALYSTS CHANGING NOTES OR INFORMATION HAS BEEN INDICATED OR REPORTED ON BY THE OFFICE IN REGARD TO THE DISCREPANCY, CORRECTION OF THIS SITE.

CONDITIONS FOR ELECTRONIC INFORMATION TRANSFER:

ELECTRONIC INFORMATION IS SUPPLIED TO THE OTHER ASSOCIATED FIRMS TO ASSIST THEM IN THE EXECUTION OF THEIR WORK. REVIEW THE RECENT FIRMS MUST DETERMINE THE COMPLETENESS APPROPRIATENESS RELEVANCE OF THE INFORMATION IN RESPECT TO THEIR PARTICULAR RESPONSIBILITY.

GRAZIANI-CORAZZANI ARCHITECTS INC. SHALL NOT BE RESPONSIBLE FOR:

1. ERRORS, OMISSIONS, INADEQUACIES DUE TO LOSS OF INFORMATION IN WHOLE OR PART WHEN INFORMATION IS TRANSFERRED.

2. TRANSFORMATION OF ANY INFO OR CHANGE TO THE RECEIVING ELECTRONIC SYSTEM WHEN INFORMATION IS TRANSFERRED.

01: Aug.02.2019 issued for tender

REF. 1-A-402b2 FOR CONTINUATION



BUILDING B-NORTH ELEVATION 2
1:50 A-402b2

MATERIALS LEGEND	
	GL-3 MASON GLASS
	GL-2 GLAZED SPANDREL PANEL
	ML-1 PREFINISHED METAL LOUVER/GRILLE
	SV-1 STONE VENEER
	BRV-1 BRICK VENEER (DARK)
	BRV-2 BRICK VENEER (LIGHT)
	PC-1 PRECAST CONCRETE HEADER/GRILL
	GR-1 GLASS RAILING
	FM-1 PREFINISHED METAL (FLASHING)

NOTE: IF EXACT SPECIFIED COLOUR IS NOT AVAILABLE, ATTEMPT COLOUR MATCH AND SUBMIT ALTERNATIVE SAMPLES FOR ARCHITECT'S APPROVAL.

Issued for revisions

**GRAZIANI
CORAZZANI
ARCHITECTS**

1100 DUNDAS STREET WEST, SUITE 100, MISSISSAUGA, ONTARIO L4W 1C1
TEL: 905.276.2600 FAX: 905.276.2644 WWW.GC-ARCHITECTS.COM

RESIDENTIAL

ATTMAR + PALLESCHE DRIVE

BRAMPTON ONTARIO

PROJECT ARCHITECT: B. GRAZIANI

ASSISTANT DESIGNER: R. LINCOLN

DRAWN BY: F.C./M.B.

CHECKED BY: D. BIASE (G. COLANGELO)

PLOT DATE: SEP. 18. 2019

JOB # 1331.15

NORTH ELEVATION
BUILDING B

1:50 A-402b2

TITLEBLOCK SIZE: 915 x 1200

THIS DRAWING, AS AN INSTRUMENT OF SERVICE, IS PROVIDED BY AND IS THE PROPERTY OF GRAZIANI-CORAZZA ARCHITECTS INC. THE CONTRACTOR MUST VERIFY AND ACCEPT RESPONSIBILITY FOR ALL DIMENSIONS AND CONDITIONS ON SITE AND MUST KEEP GRAZIANI-CORAZZA ARCHITECTS INC. OF ANY VARIATIONS FROM THE SUPPLIED INFORMATION. GRAZIANI-CORAZZA ARCHITECTS INC. IS NOT RESPONSIBLE FOR THE ACCURACY OF SURVEY, STRUCTURAL, MECHANICAL, ELECTRICAL, AND OTHER ENGINEERING INFORMATION SHOWN ON THIS DRAWING. REFER TO THE APPROPRIATE ENGINEERING DRAWINGS BEFORE PROCEEDING WITH THE WORK. CONSTRUCTION MUST CONFORM TO ALL APPLICABLE CODES AND REQUIREMENTS OF THE AUTHORITIES HAVING JURISDICTION. ANALYSTS/ENGINEERS MUST INVESTIGATE HAS BEEN UNDERTAKEN OR REPORTED ON BY THE OFFICE IN REGARD TO THE DISPERSED, CONDITION OF THIS SITE.

THIS DRAWING IS NOT TO BE SCALED. ALL ARCHITECTURAL SYMBOLS INDICATED ON THIS DRAWING ARE GRAPHIC REPRESENTATIONS ONLY.


CONDITIONS FOR ELECTRONIC INFORMATION TRANSFER:

ELECTRONIC INFORMATION IS SUPPLIED TO THE OTHER ASSOCIATED FRAMES TO ASSIST THEM IN THE EXECUTION OF THEIR WORK/REVIEW. THE RECIPIENT FRAMES MUST EXTEND THE COMPLETENESS APPROPRIATELY. RELEVANCE OF THE INFORMATION IN RESPECT TO THEIR PARTICULAR RESPONSIBILITY.


GRAZIANI-CORAZZA ARCHITECTS INC. SHALL NOT BE RESPONSIBLE FOR:

1. OTHERS' NEGLIGENCE/INCOMPETENCE DUE TO LOSS OF INFORMATION IN WHOLE OR PART WHEN INFORMATION IS TRANSFERRED.
2. TRANSMISSION OF ANY LOSS OF DAMAGE TO THE RECEIVING ELECTRONIC SYSTEM WHEN INFORMATION IS TRANSFERRED.

01 - Aug.02.2019 issued for tender

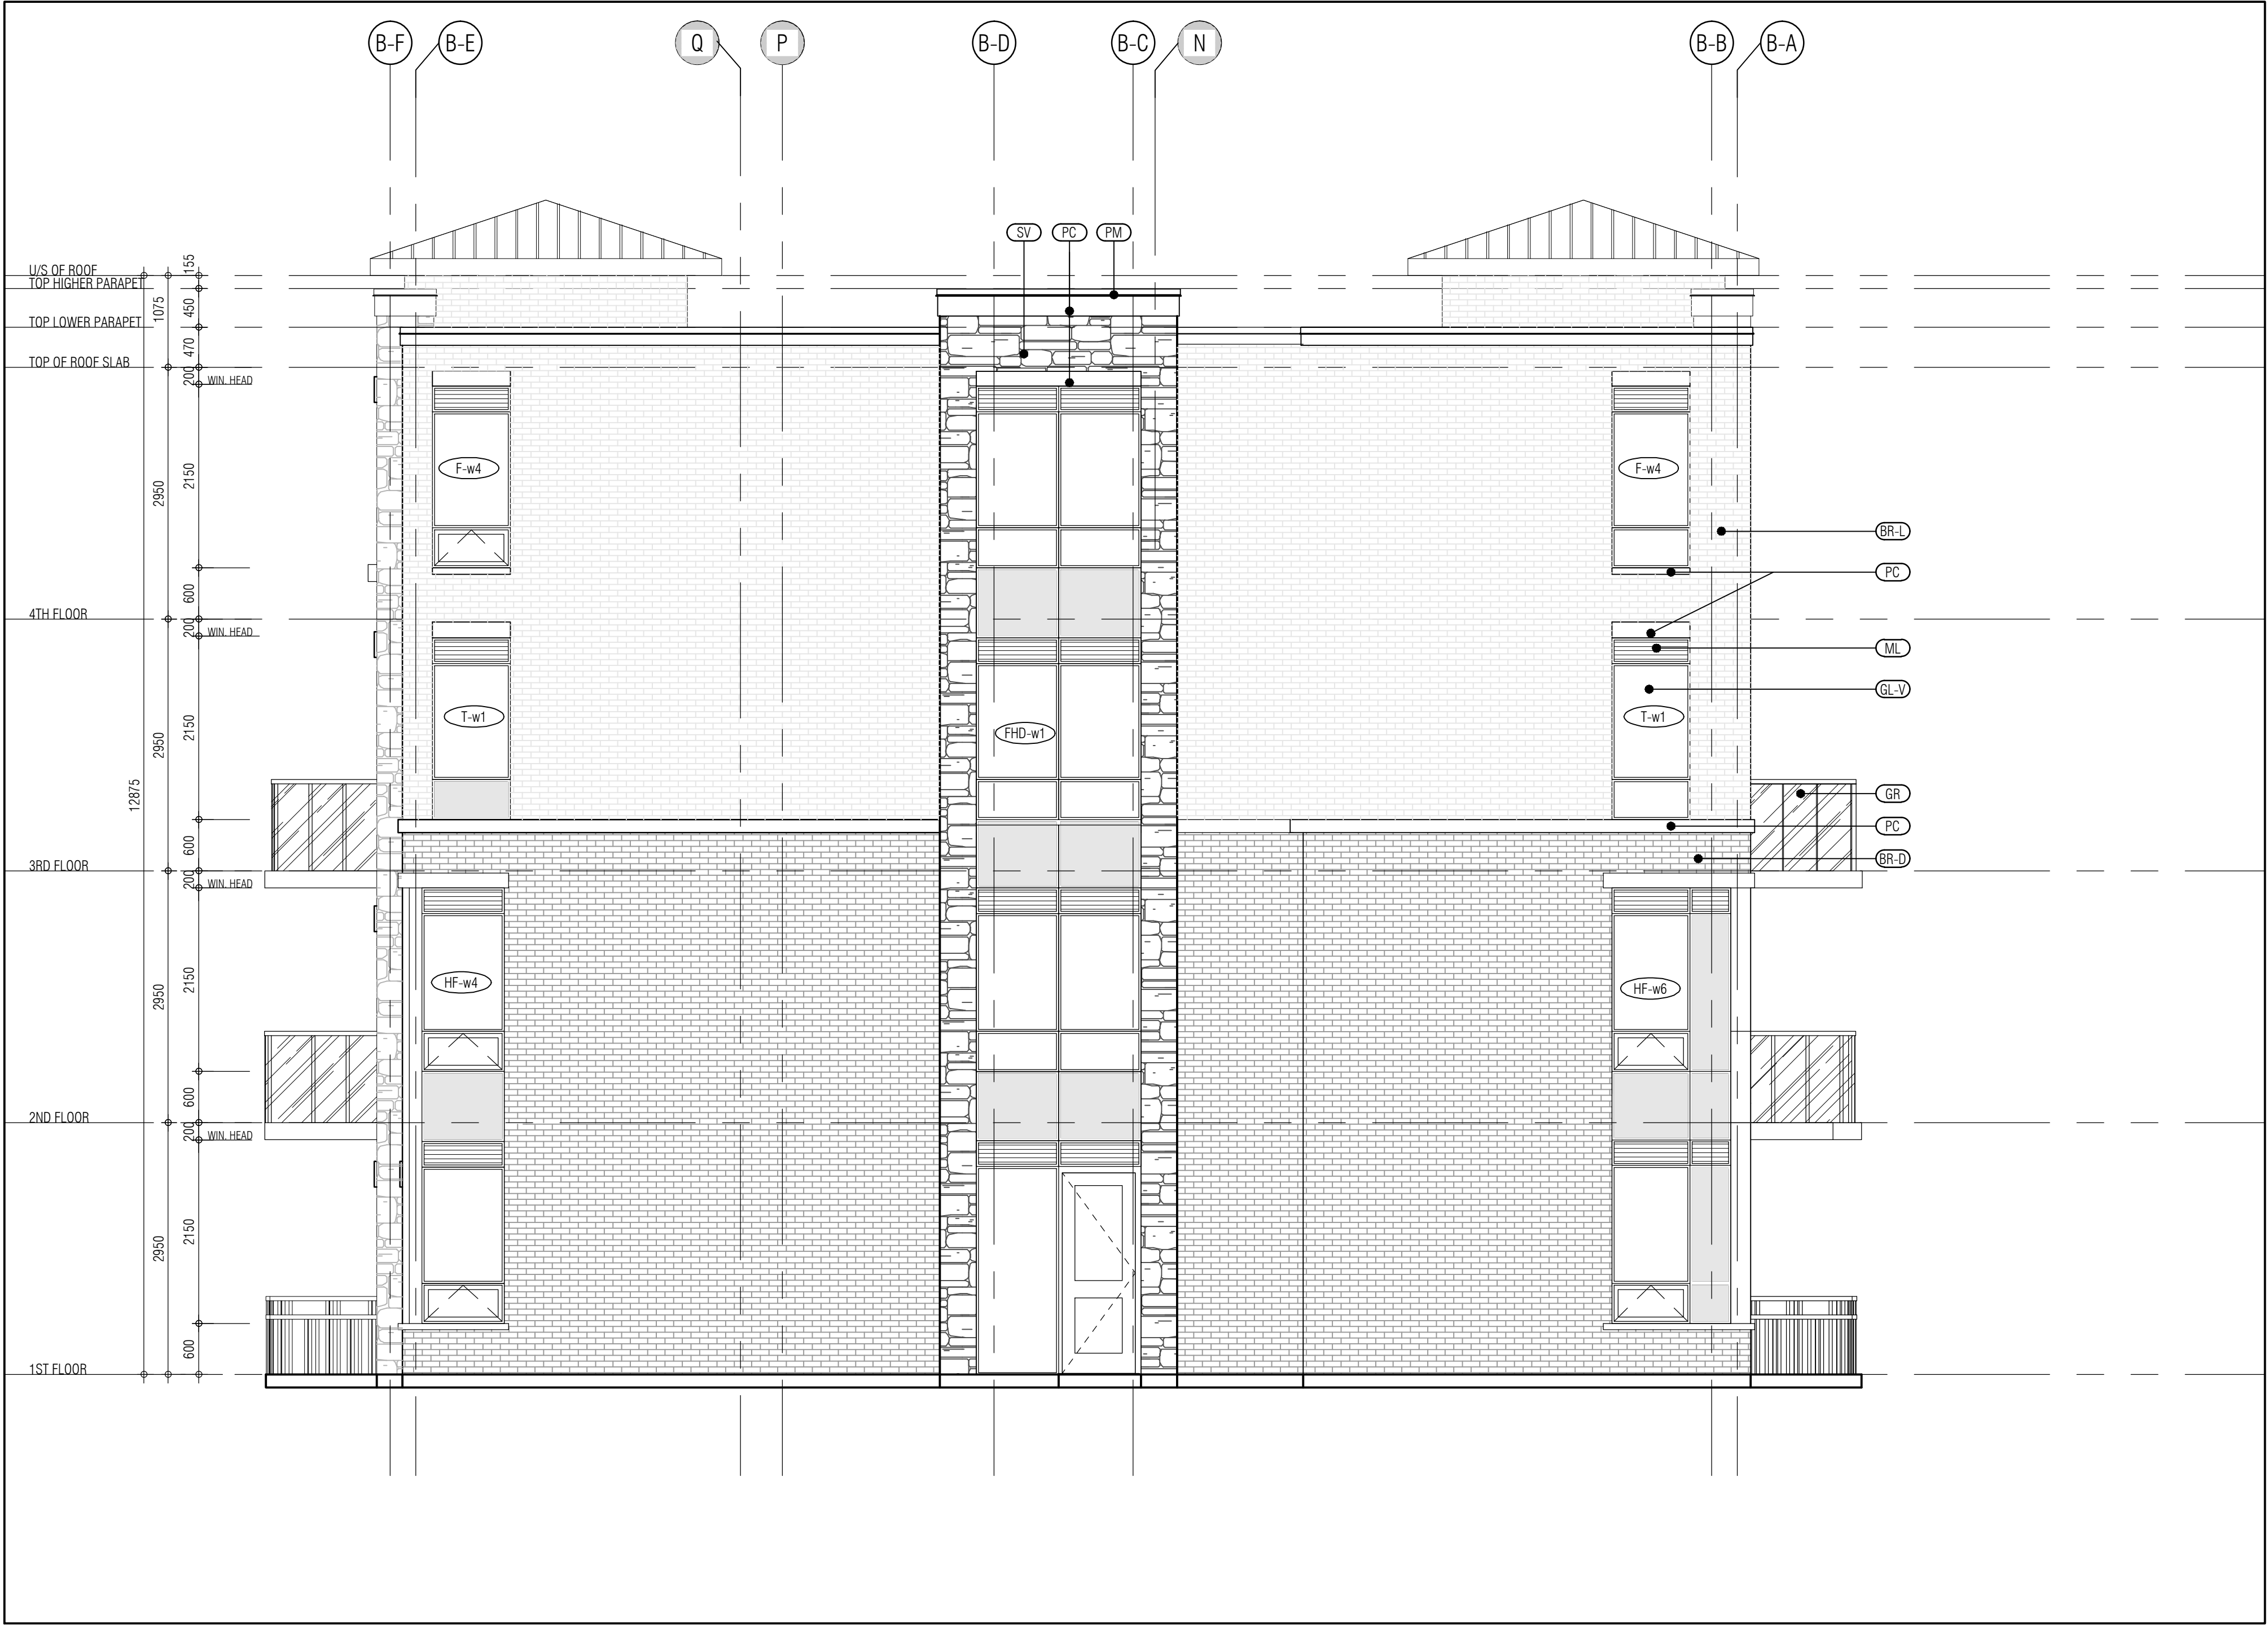

BUILDING B-WEST ELEVATION 1
1:50 A-402b3

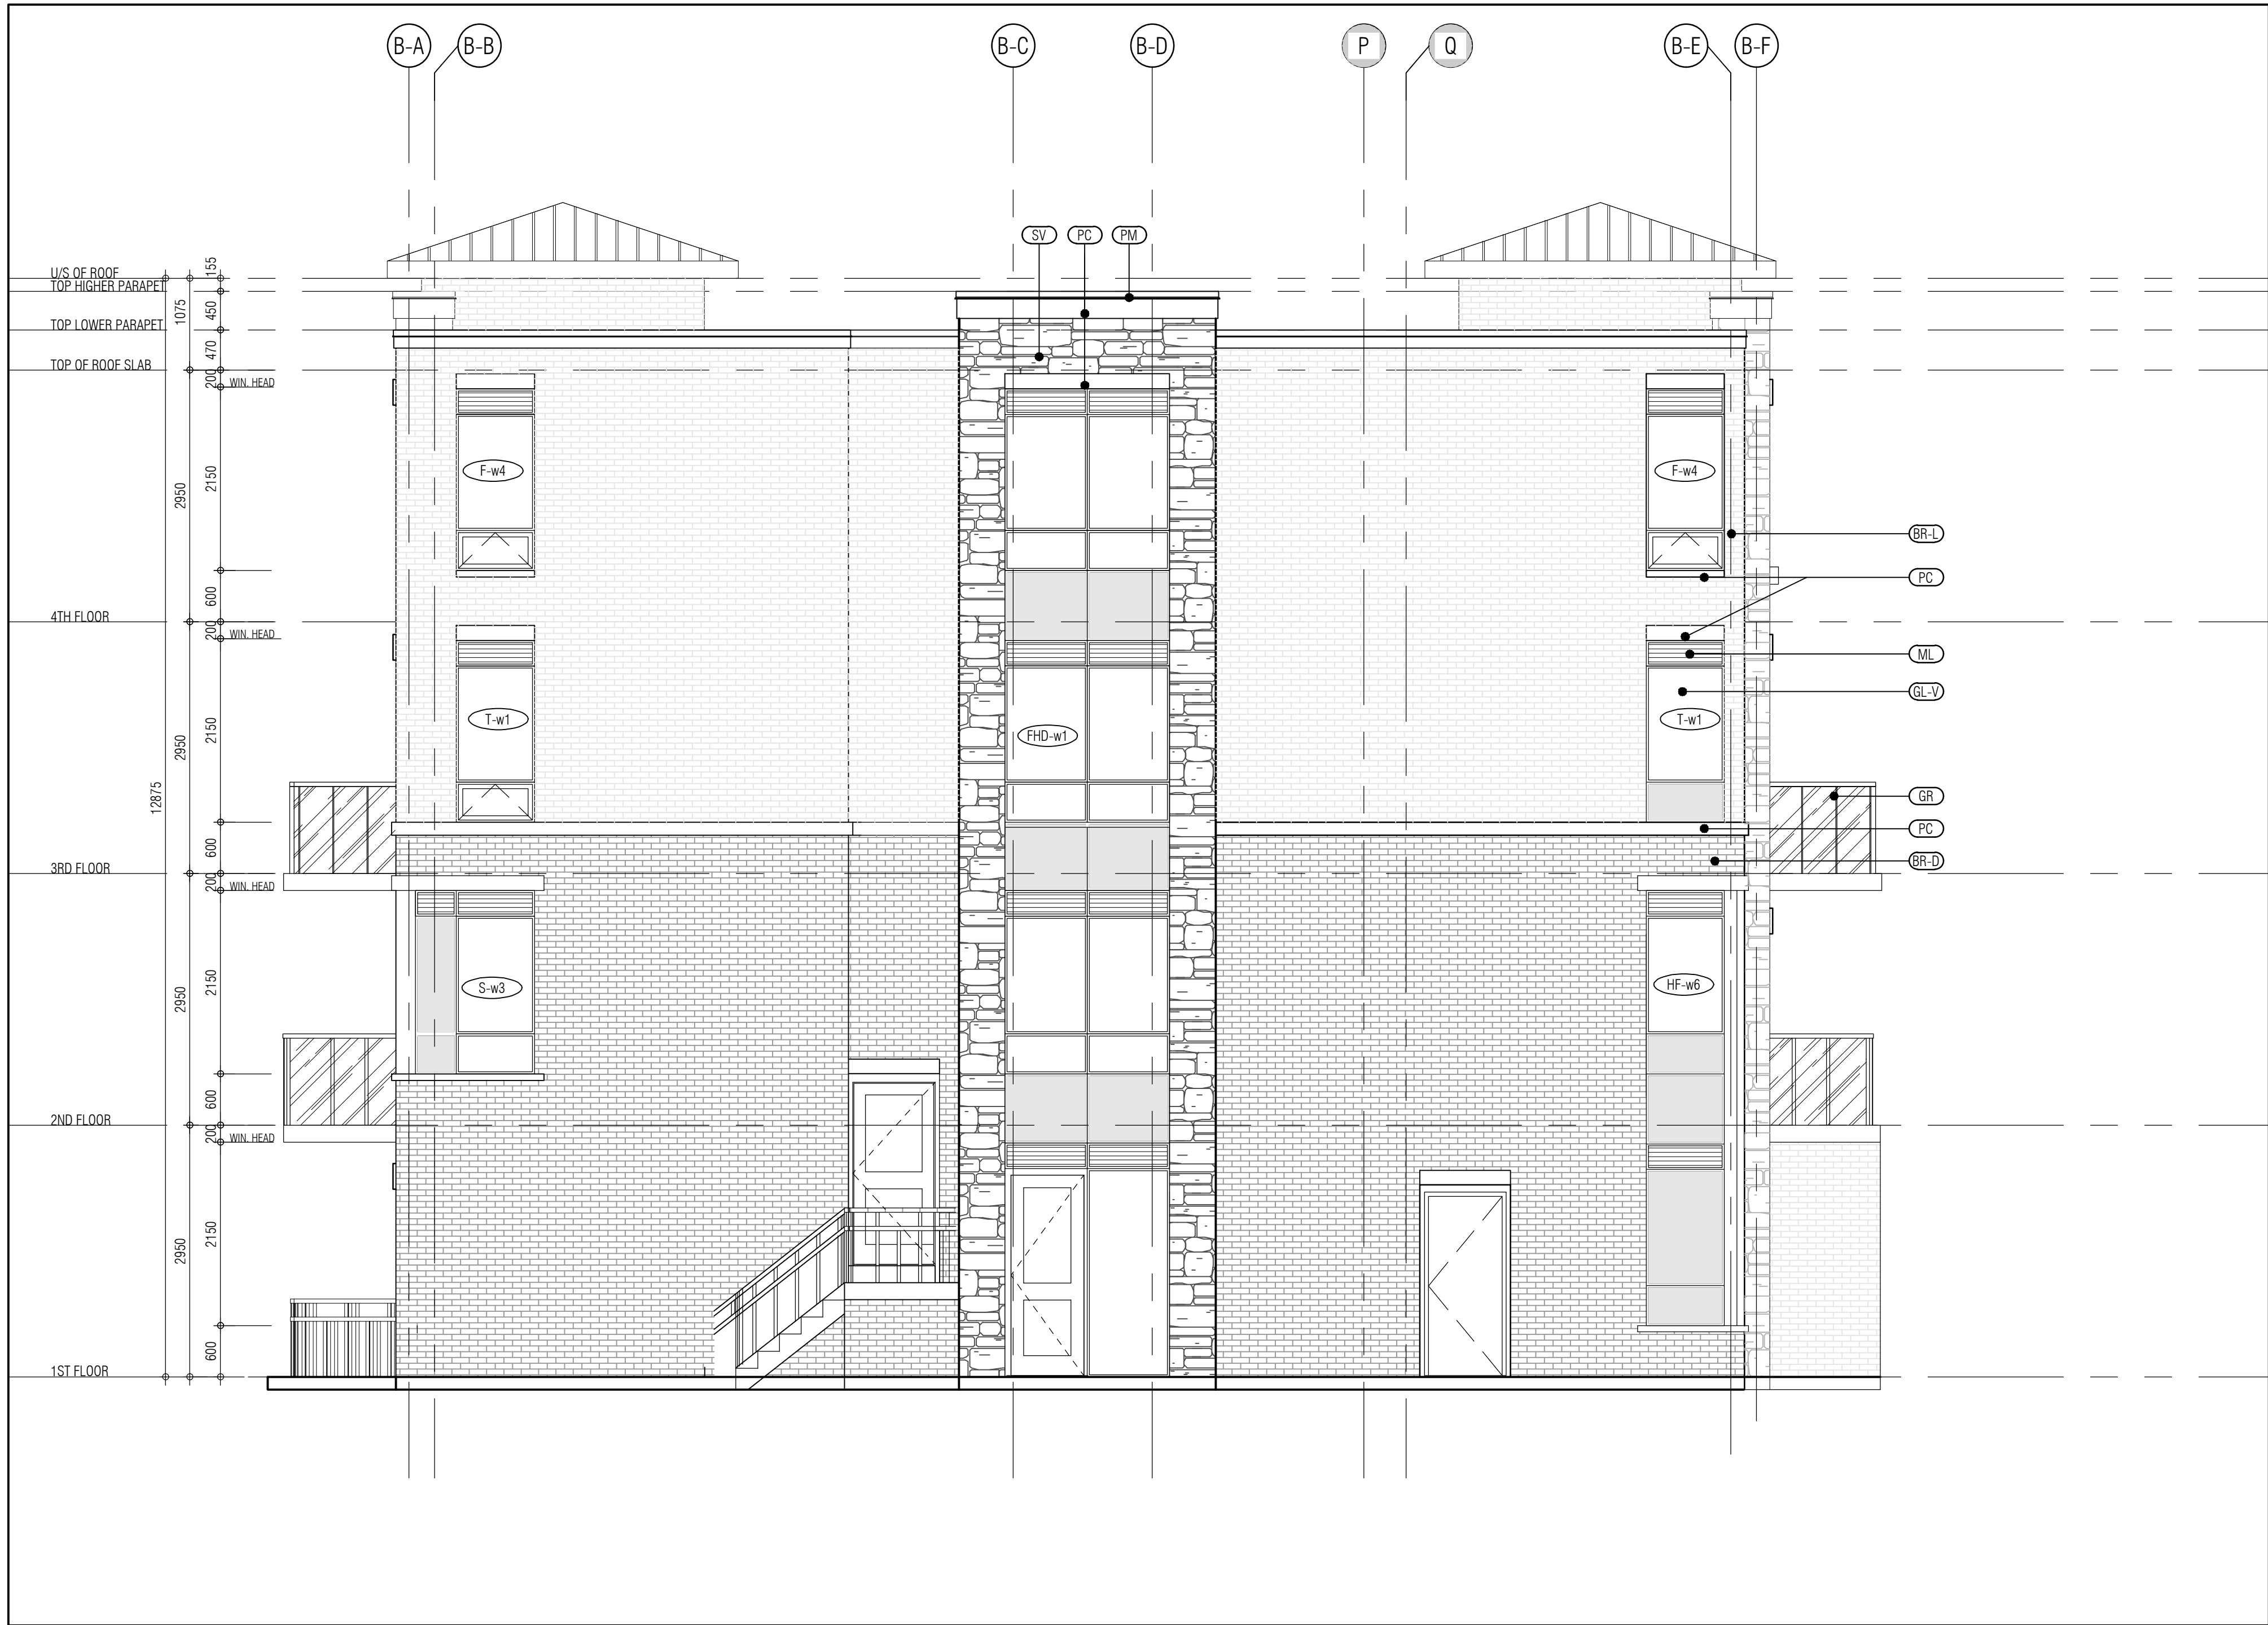

BUILDING B-EAST ELEVATION 2
1:50 A-402b3

MATERIALS LEGEND	
	MASON GLASS
	GLAZED SPANDREL PANEL
	PREFINISHED METAL LOUVRE/GRILLE
	STONE VENEER
	BRICK VENEER (DARK)
	BRICK VENEER (LIGHT)
	PRECAST CONCRETE HEADER/GRILL
	GLASS RAILING
	PREFINISHED METAL (FLASHING)

NOTE: IF EXACT SPECIFIED COLOUR IS NOT AVAILABLE, ATTEMPT COLOUR MATCH AND SUBMIT ALTERNATIVE SAMPLES FOR ARCHITECT'S APPROVAL.

issued for revisions

**GRAZIANI
CORAZZA
ARCHITECTS**

1100 SHAWAN CHINA, SUITE 100 MISSISSAUGA, ONTARIO L4W 1C1
T: 905.706.2600 F: 905.793.2844 WWW.GC-ARCHITECTS.COM

RESIDENTIAL

ATTMAR + PALLESCHI DRIVE

BRAMPTON ONTARIO

PROJECT ARCHITECT: B. GRAZIANI

ASSISTANT DESIGNER: R. LINCOLN

DRAWN BY: F.C./M.B.

CHECKED BY: D. BIASE/G. COLANGELO

PLOT DATE: SEP. 18. 2019

JOB # 1331.15

**EAST & WEST ELEVATION
BUILDING B**

THIS DRAWING, AS AN INSTRUMENT OF SERVICE, IS PROVIDED BY AND IS THE PROPERTY OF GRAZIANI-CORAZZA ARCHITECTS INC. THE CONTRACTOR MUST VERIFY AND ACCEPT RESPONSIBILITY FOR ALL DIMENSIONS AND CONDITIONS ON SITE AND MUST KEEP GRAZIANI-CORAZZA ARCHITECTS INC. OF ANY VARIATIONS FROM THE SUPPLIED INFORMATION. GRAZIANI-CORAZZA ARCHITECTS INC. IS NOT RESPONSIBLE FOR THE ACCURACY OF SURVEY, STRUCTURAL, MECHANICAL, ELECTRICAL, AND OTHER ENGINEERING INFORMATION SHOWN ON THIS DRAWING. REFER TO THE APPROPRIATE ENGINEERING DRAWINGS BEFORE PROCEEDING WITH THE WORK. CONSTRUCTION MUST CONFORM TO ALL APPLICABLE CODES AND REQUIREMENTS OF THE AUTHORITIES HAVING JURISDICTION. ALWAYS CONSULT THE SPECIFICATIONS AND NOTES TO THE DRAWINGS. CONSULT THE SITE SPECIFIC IN REGARDS TO THE ENVIRONMENTAL, CLIMATE, OF THIS SITE.

THIS DRAWING IS NOT TO BE SCALED. ALL ARCHITECTURAL SYMBOLS INDICATED ON THIS DRAWING ARE GRAPHIC REPRESENTATIONS ONLY.

CONDITIONS FOR ELECTRONIC INFORMATION TRANSFER:

ELECTRONIC INFORMATION IS SUPPLIED TO THE OTHER ASSOCIATED PARTS TO ASSIST THEM IN THE EXECUTION OF THEIR WORK. REVIEW THE RECEIPT FORMS MUST EXAMINE THE COMPLETENESS APPROPRIATENESS RELEVANCE OF THE INFORMATION IN RESPECT TO THEIR PARTICULAR RESPONSIBILITY.

GRAZIANI-CORAZZA ARCHITECTS INC. SHALL NOT BE RESPONSIBLE FOR:

1. ERRORS, OMISSIONS, INADEQUACIES DUE TO LOSS OF INFORMATION IN WHOLE OR PART WHEN INFORMATION IS TRANSFERRED.
2. TRANSMISSION OF ANY LOSS OF CHANGE TO THE RECEIVING ELECTRONIC SYSTEM WHEN INFORMATION IS TRANSFERRED.


01. Aug 02 2019 Issued for tender




SOUTH ELEVATION 1
1:100 A403




NORTH ELEVATION 2
1:100 A403

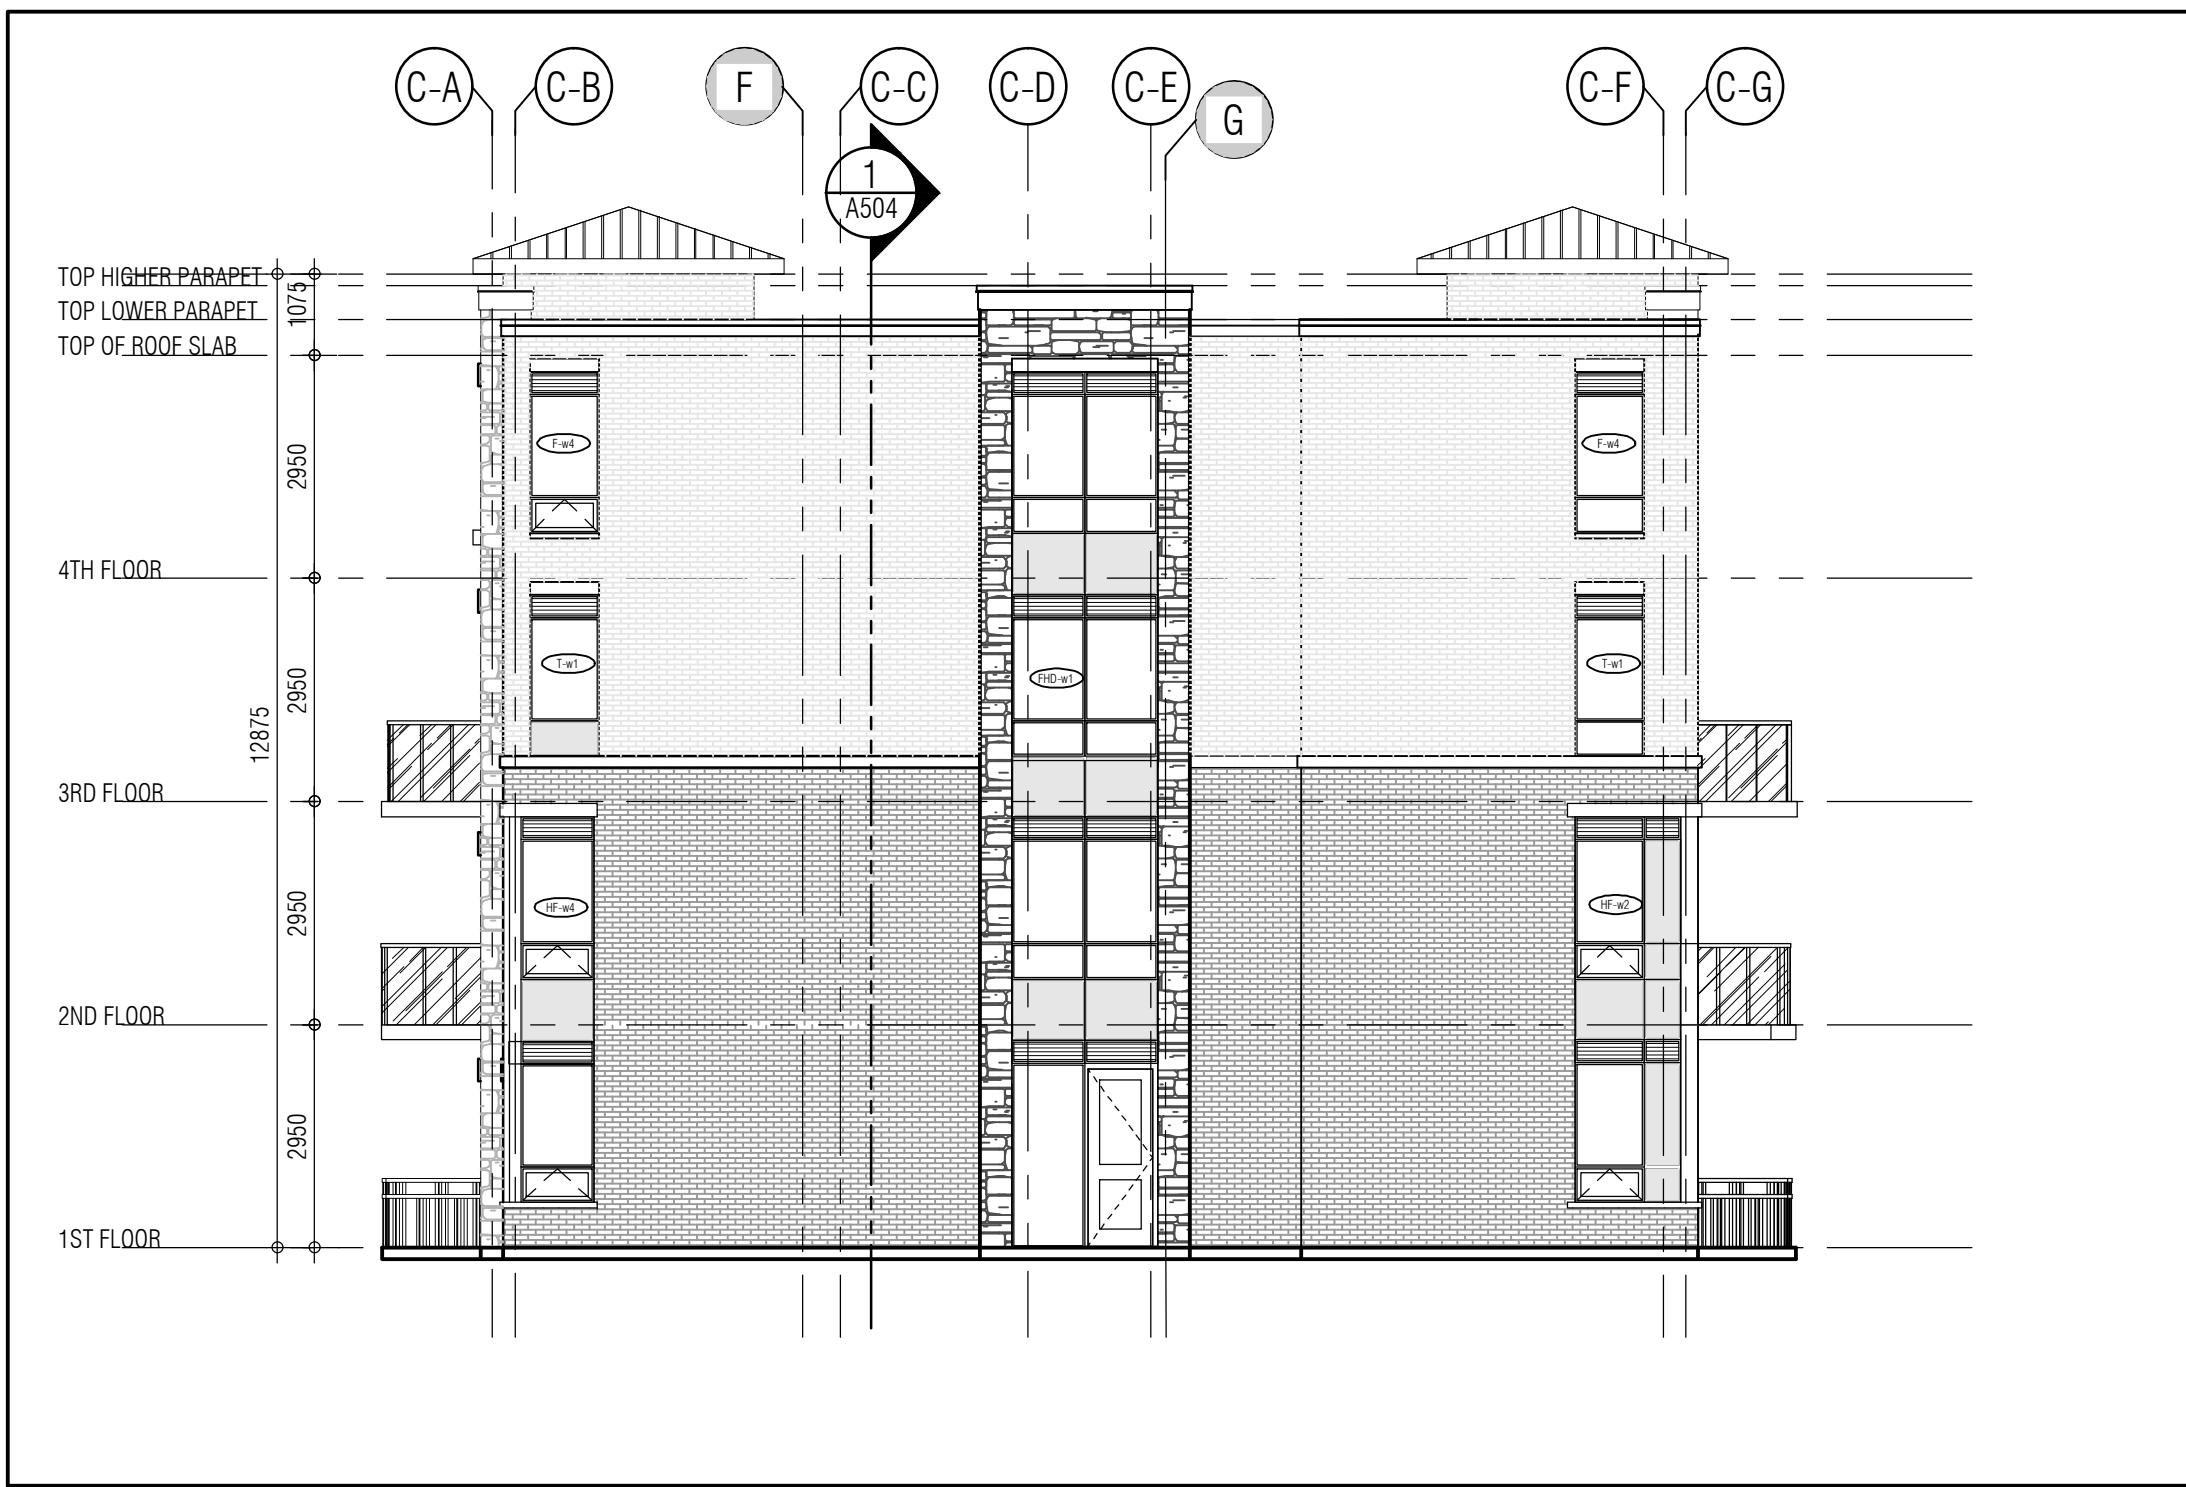

EAST ELEVATION 3
1:100 A403

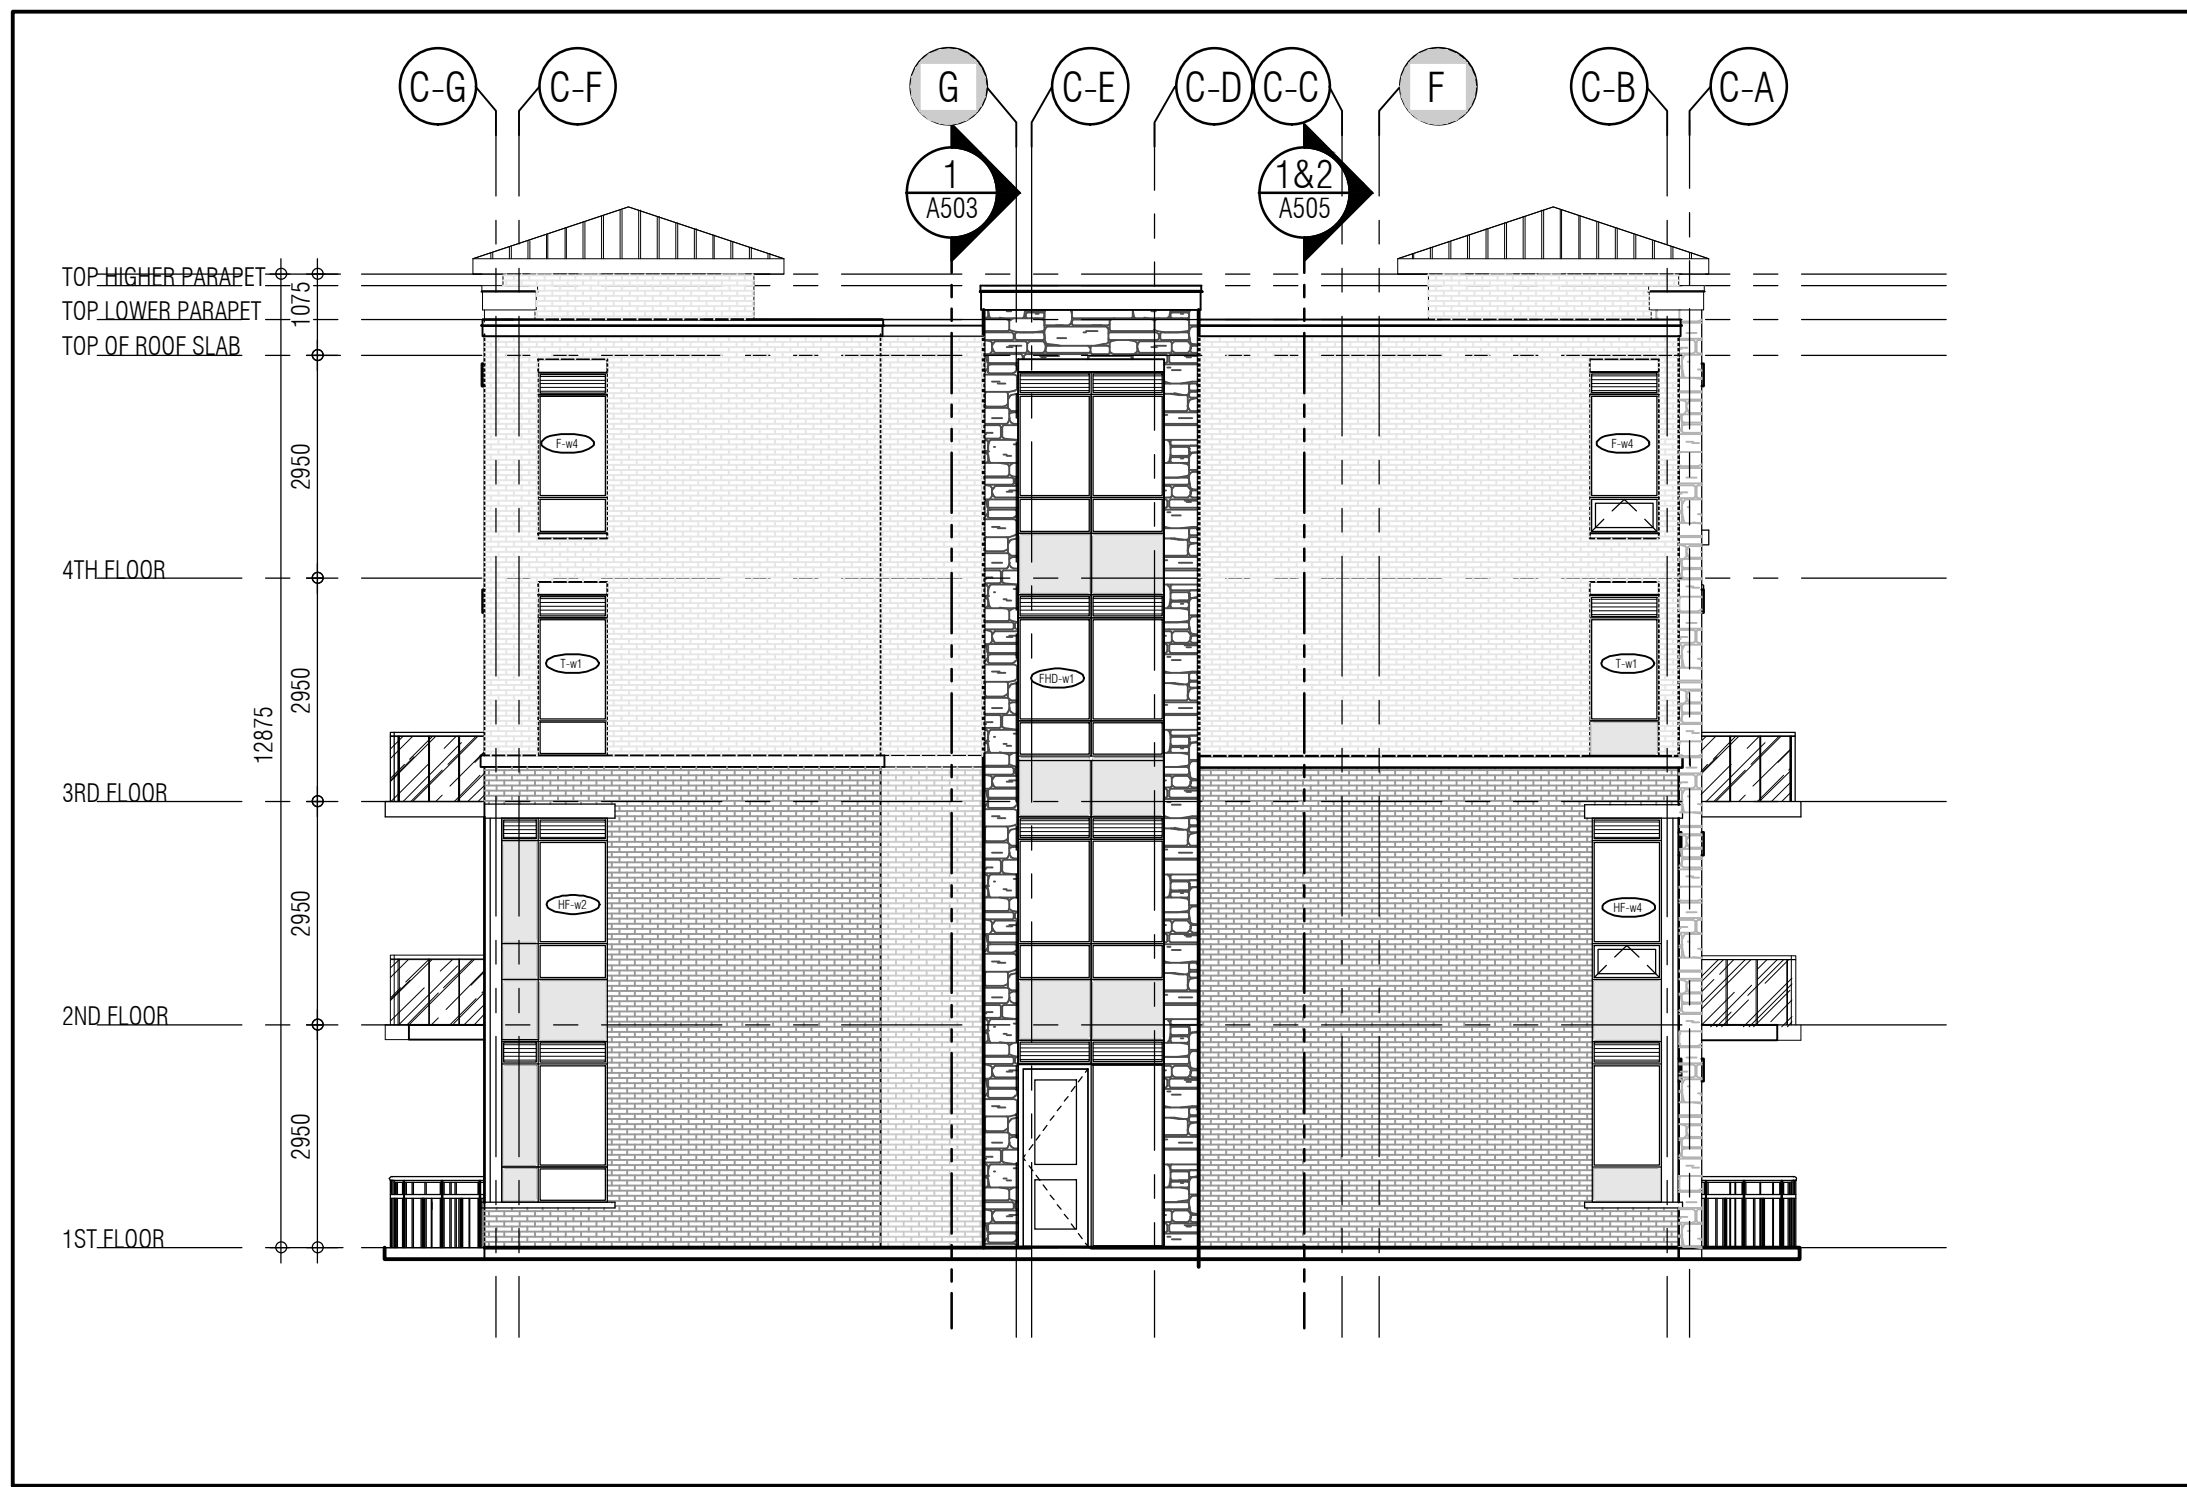

WEST ELEVATION 4
1:100 A403

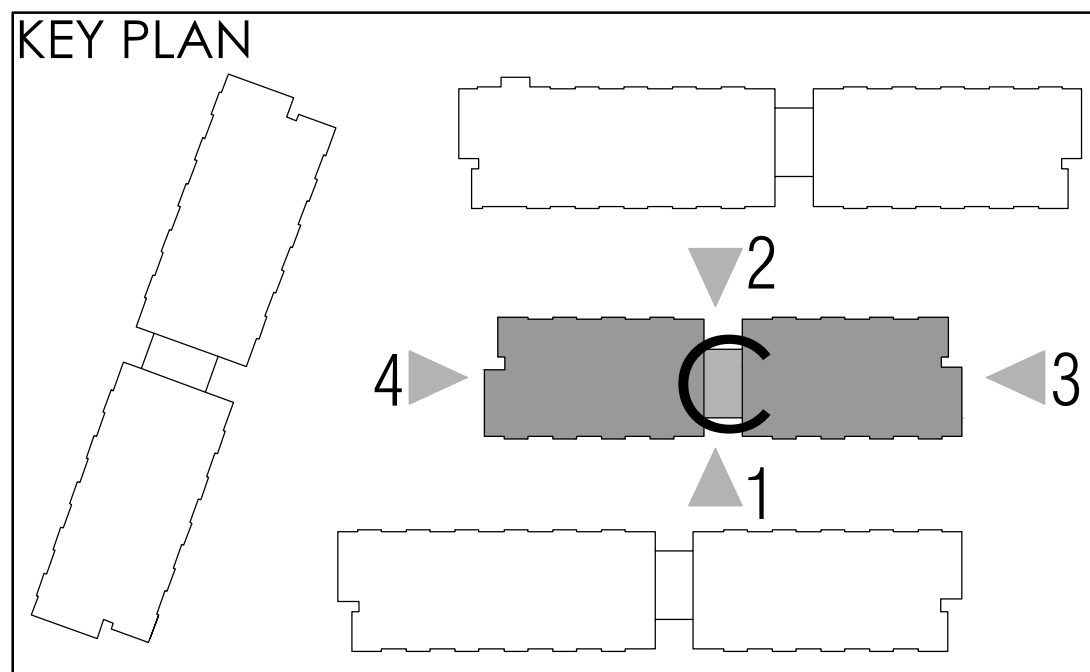

Issued for revisions

+

+

**GRAZIANI
CORAZZA
ARCHITECTS**

1000 SHAWANIGAN DRIVE, SUITE 100, MISSISSAUGA, ONTARIO L4W 1C1
TEL: 905-262-2000 FAX: 905-262-2001 WWW.GC-ARCHITECTS.COM

RESIDENTIAL

POINTE

ATTMAR + PALLESCHI DRIVE

BRAMPTON ONTARIO

PROJECT ARCHITECT: B. GRAZIANI

ASSISTANT DESIGNER: R. LINCOLN

DRAWN BY: F.C./M.B.

CHECKED BY: D. BIASE (G. COLANGELO)

PLOT DATE: SEP. 18. 2019


JOB # 1331.15

**BUILDING C ELEVATIONS
OVERALL ELEVATIONS**


1:100 A403

TITLEBLOCK SIZE: 915 x 1200

01. Aug.02.2019 issued for tender

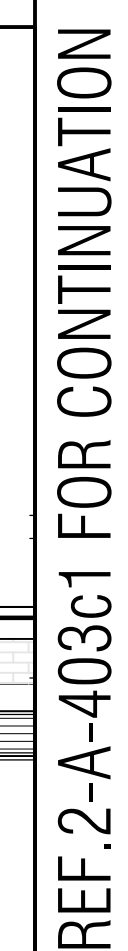

1:50 A-403c

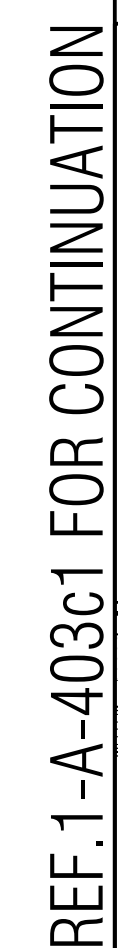


1:50 A-403c

1:50 A-403c1

TITLEBLOCK SIZE: 915 x 120

01. Aug.02.2019 issued for tender

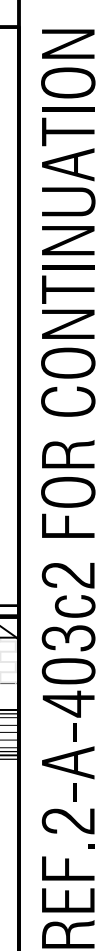

1:50 A-403c



1:50 A-403c

NOTE: IF EXACT SPECIFIED COLOUR IS NOT AVAILABLE, ATTEMPT COLOUR MATCH AND SUBMIT ALTERNATIVE SAMPLES FOR ARCHITECT'S APPROVAL.

$$\begin{array}{c} \text{G} \\ \text{C} \end{array} +$$

RESIDENTIAL

BRAMPTON ONT

ASSISTANT DESIGNER: R. LINCOLN

PLOT DATE: SEP.18.2019

NORTH ELEVATION

A-403CZ


01. Aug.02.2019 issued for tender



issued for revisions



EAST & WEST ELEVATION
BUILDING C

THIS DRAWING, AS AN INSTRUMENT OF SERVICE, IS PROVIDED BY AND IS THE PROPERTY OF GRAZIANI-CORAZZA ARCHITECTS INC. THE CONTRACTOR MUST VERIFY AND ACCEPT RESPONSIBILITY FOR ALL DIMENSIONS AND CONDITIONS ON SITE AND MUST KEEP GRAZIANI-CORAZZA ARCHITECTS INC. OF ANY VARIATIONS FROM THE SUPPLIED INFORMATION. GRAZIANI-CORAZZA ARCHITECTS INC. IS NOT RESPONSIBLE FOR THE ACCURACY OF SURVEY, STRUCTURAL, MECHANICAL, ELECTRICAL, AND OTHER ENGINEERING INFORMATION SHOWN ON THIS DRAWING. REFER TO THE APPROPRIATE ENGINEERING DRAWINGS BEFORE PROCEEDING WITH THE WORK. CONSTRUCTION MUST CONFORM TO ALL APPLICABLE CODES AND REQUIREMENTS OF THE AUTHORITIES HAVING JURISDICTION. ALWAYS CONSULTING NOTES NO VARIATION HAS BEEN UNDERTAKEN OR REPORTED ON BY THE OFFICE IN REGARD TO THE DIMENSIONAL CONDITION OF THE SITE.

THIS DRAWING IS NOT TO BE SCALED. ALL ARCHITECTURAL SYMBOLS INDICATED ON THIS DRAWING ARE GRAPHIC REPRESENTATIONS ONLY.





CONDITIONS FOR ELECTRONIC INFORMATION TRANSFER:

ELECTRONIC INFORMATION IS SUPPLIED TO THE OTHER ASSOCIATED PARTS TO ASSIST THEM IN THE EXECUTION OF THEIR WORK. REVIEW THE RECEIPT FORMS MUST EXAMINE THE COMPLETENESS APPROPRIATENESS RELEVANCE OF THE INFORMATION IN RESPECT TO THEIR PARTICULAR RESPONSIBILITY.

1. OTHER ENGINEERING INFORMATION DUE TO LOSS OF INFORMATION IN WHOLE OR PART WHEN INFORMATION IS TRANSFERRED.

2. TRANSFERRED OR ANY LOSS OF CHANGE TO THE RECEIVING ELECTRONIC SYSTEM WHEN INFORMATION IS TRANSFERRED.

01. Aug.02.2019 Issued for tender

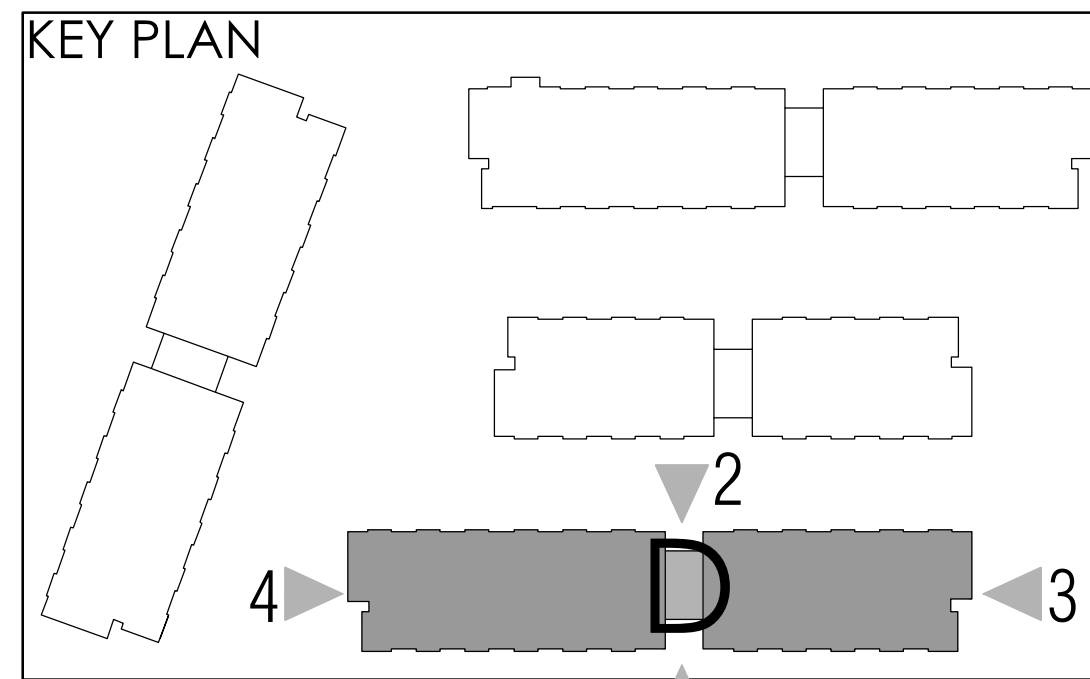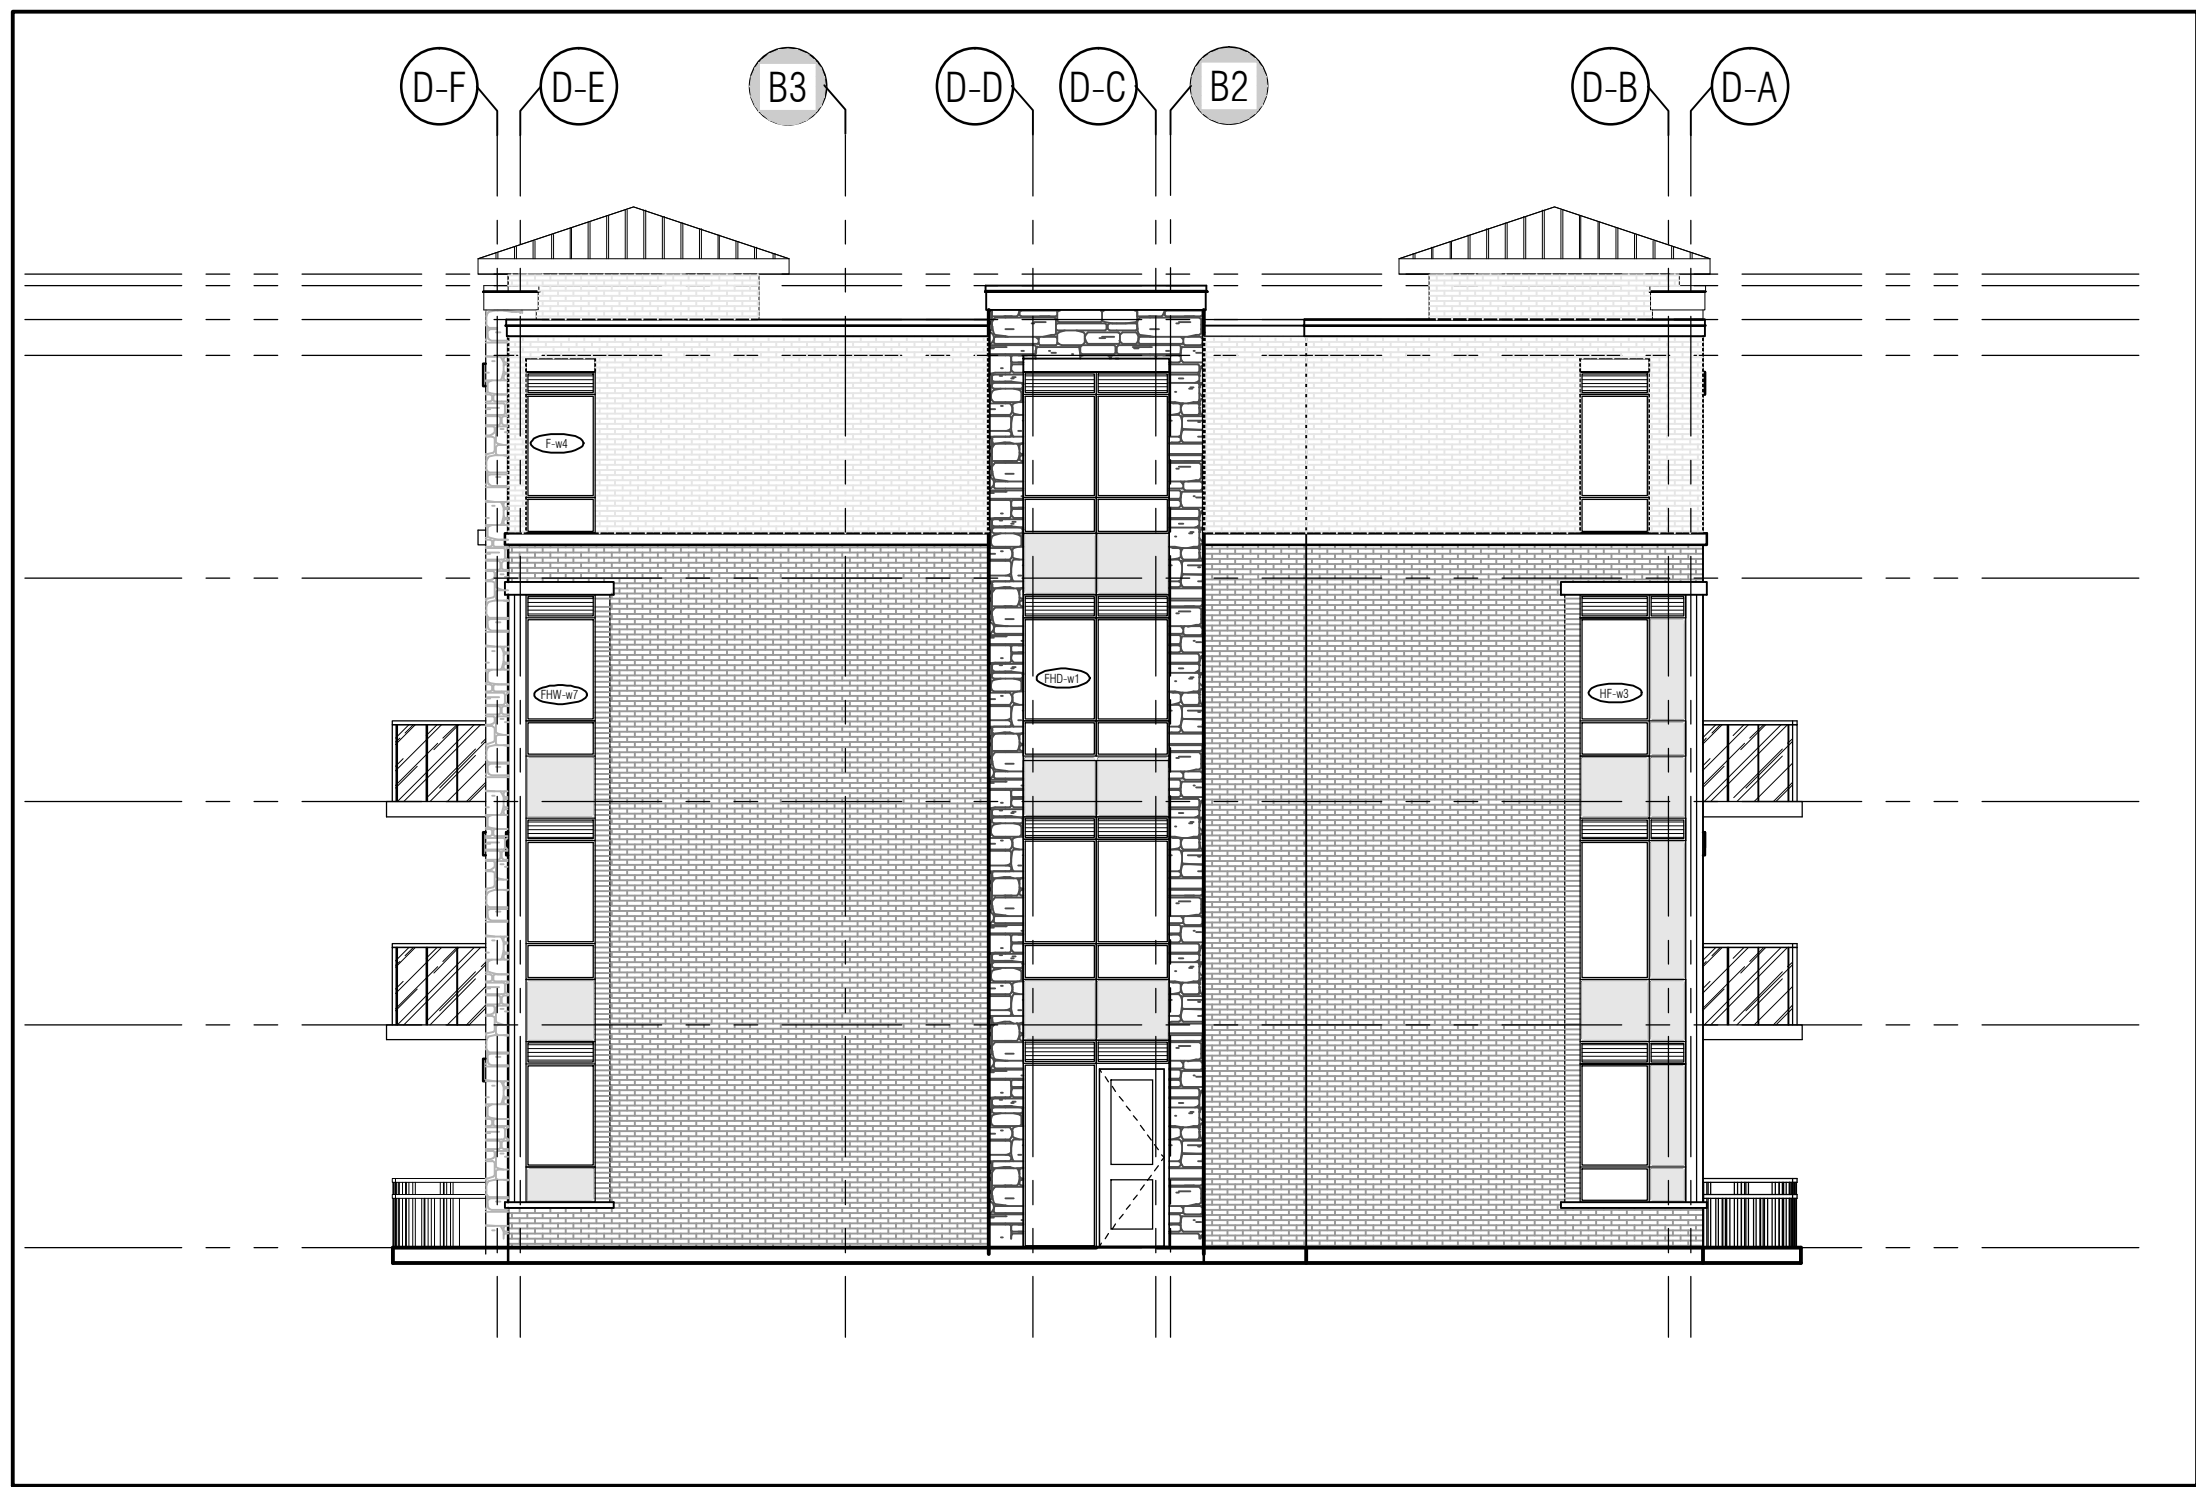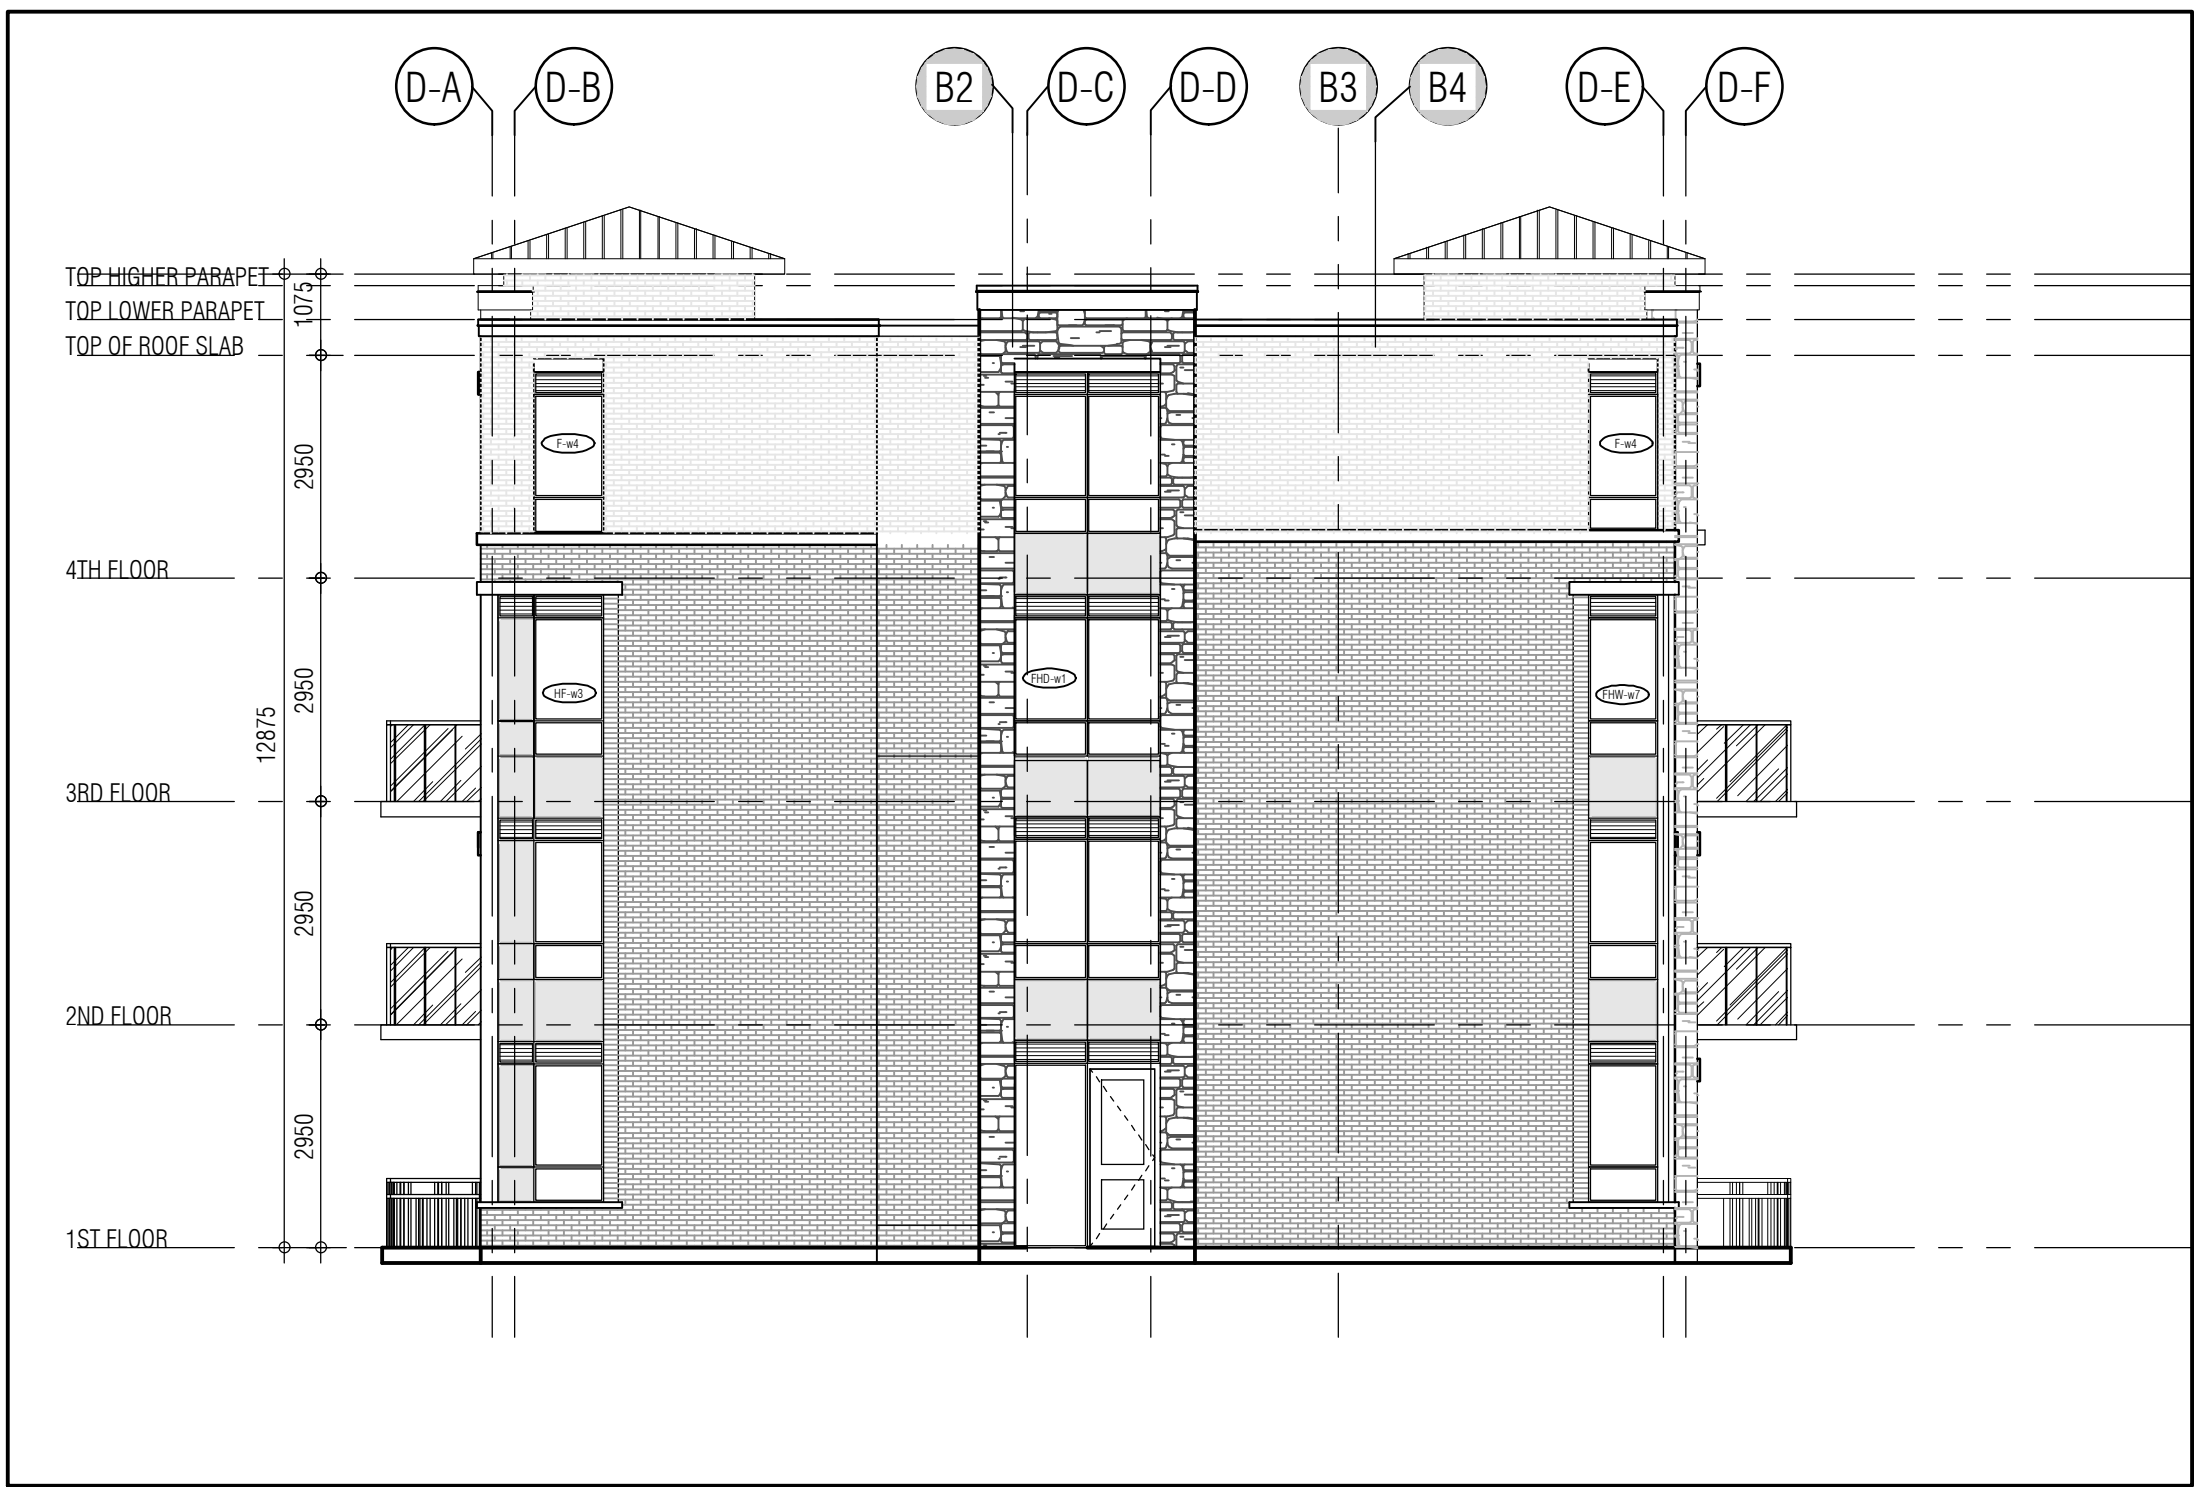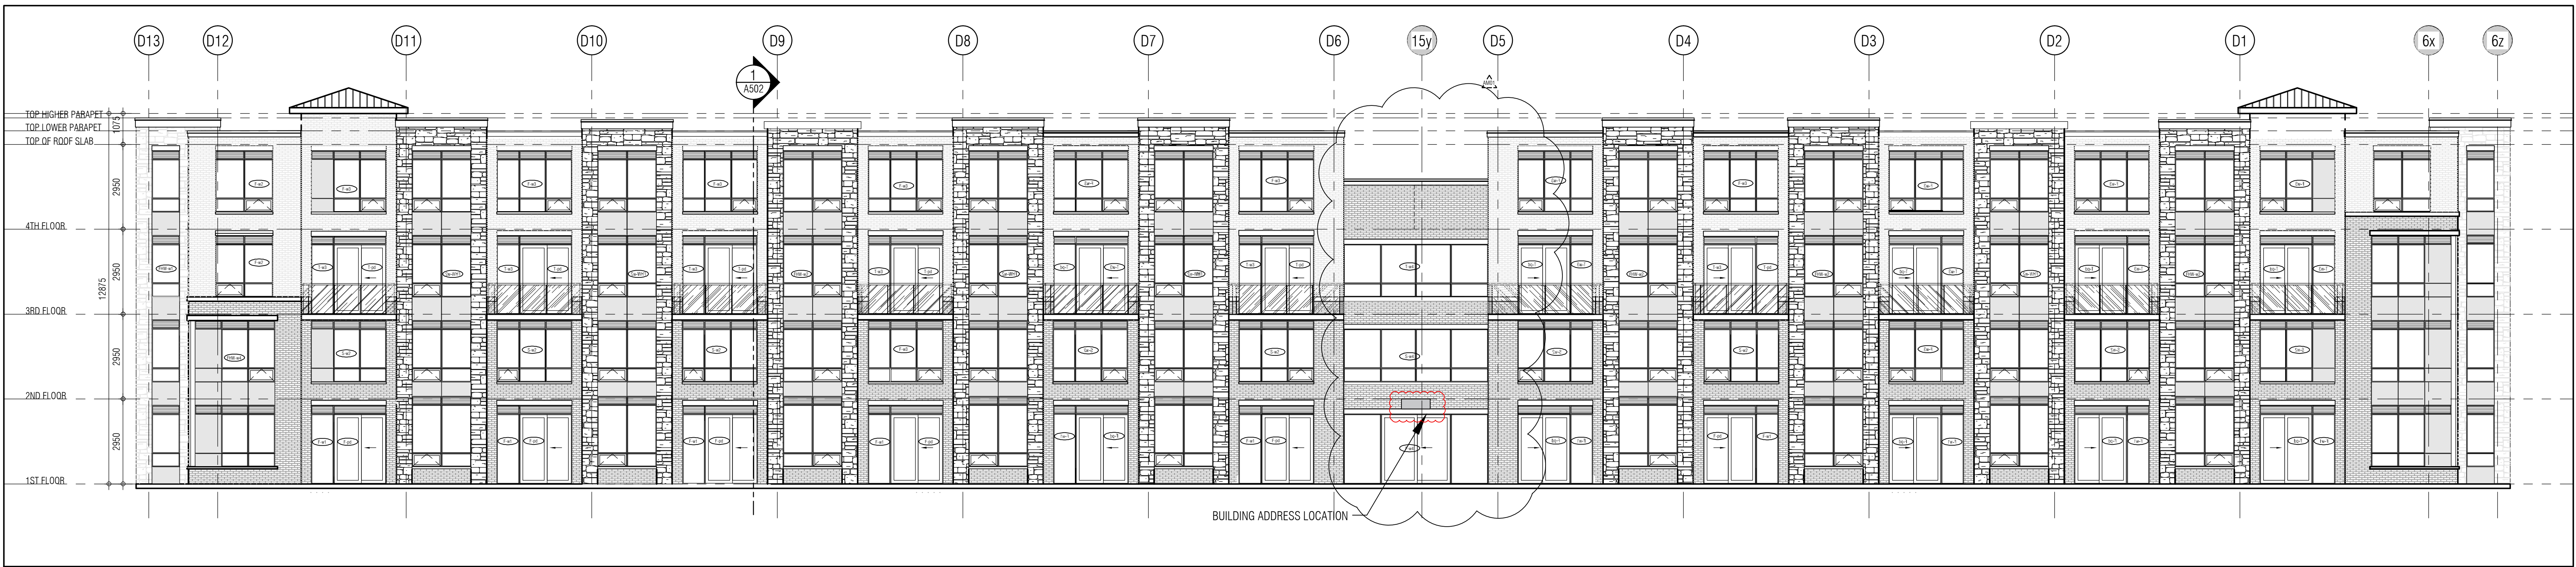

Issued for revisions

GRAZIANI-CORAZZA ARCHITECTS


RESIDENTIAL

ATTMAR + PALLESCHI DRIVE


BRAMPTON ONTARIO

PROJECT ARCHITECT: B. GRAZIANI
ASSISTANT ARCHITECT: R. LINCOLN
DRAWN BY: F.C./M.B.
CHECKED BY: D. BIASI (G. COLANGELO)
PLOT DATE: SEP. 18. 2019
JOB # 1331.15

**BUILDING D ELEVATIONS
OVERALL ELEVATIONS**

1:100 A404

TITLEBLOCK SIZE: 915 x 1200

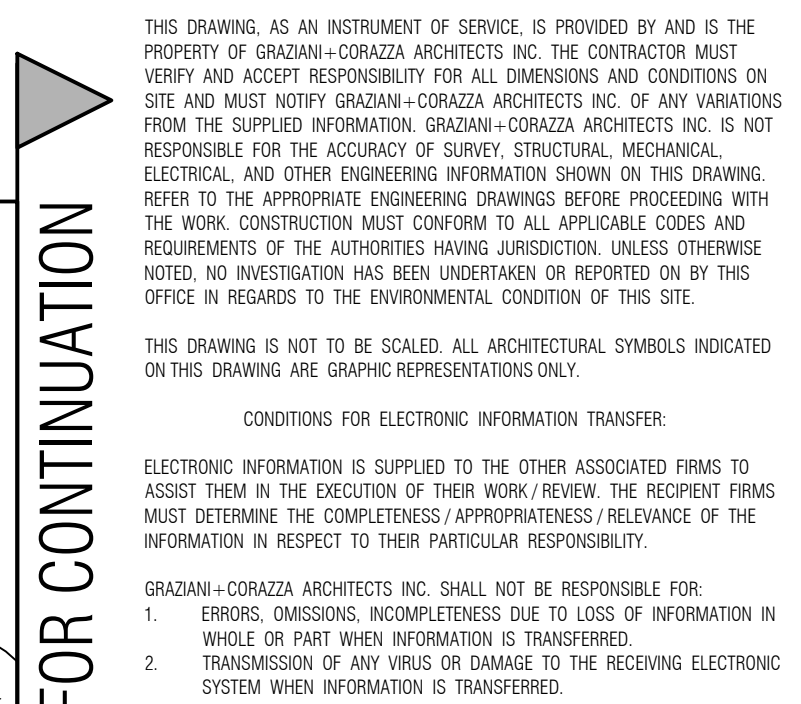

01. Aug.02.2019 issued for tender

REF.1-A-404d1 FOR CONTINUATION

BUILDING D-SOUTH ELEVATION 2
1:50 8-404

MATERIALS LEGEND	
	(G-3) VISION GLASS GLASS GLAZE
	(G-4) GLAZED SPANDREL PANEL
	(G-5) PREFINISHED METAL LOUVER/GRILL
	(G-6) STONE VENEER
	(G-7) BRICK VENEER (DARK) VISION BRICK BRICKSCREEN
	(G-8) BRICK VENEER (LIGHT) VISION BRICK
	(G-9) PRECAST CONCRETE HEADER/GILL
	(G-10) GLASS RAILING
	(G-11) PREFINISHED METAL (FLASHING)

NOTE: IF EXACT SPECIFIED COLOR IS NOT AVAILABLE, ATTEMPT COLOR MATCHING AND SUBMIT ALTERNATING SAMPLES FOR ARCHITECT'S APPROVAL.

issued for revisions



ATTMAR + PALLESCHI DRIVE

PROJECT ARCHITECT:	B. GRAZIANI
ASSISTANT DESIGNER:	R. LINCOLN
DRAWN BY:	F.C./M.B.
CHECKED BY:	D. BIASE/G. COLANGELO
PLOT DATE:	SEP. 18, 2019
JOB #	1331.15

**SOUTH ELEVATION
BUILDING D**

1:50 A-404d1

TITLEBLOCK SIZE: 915x1200









01 - Aug.02.2019 issued for tender

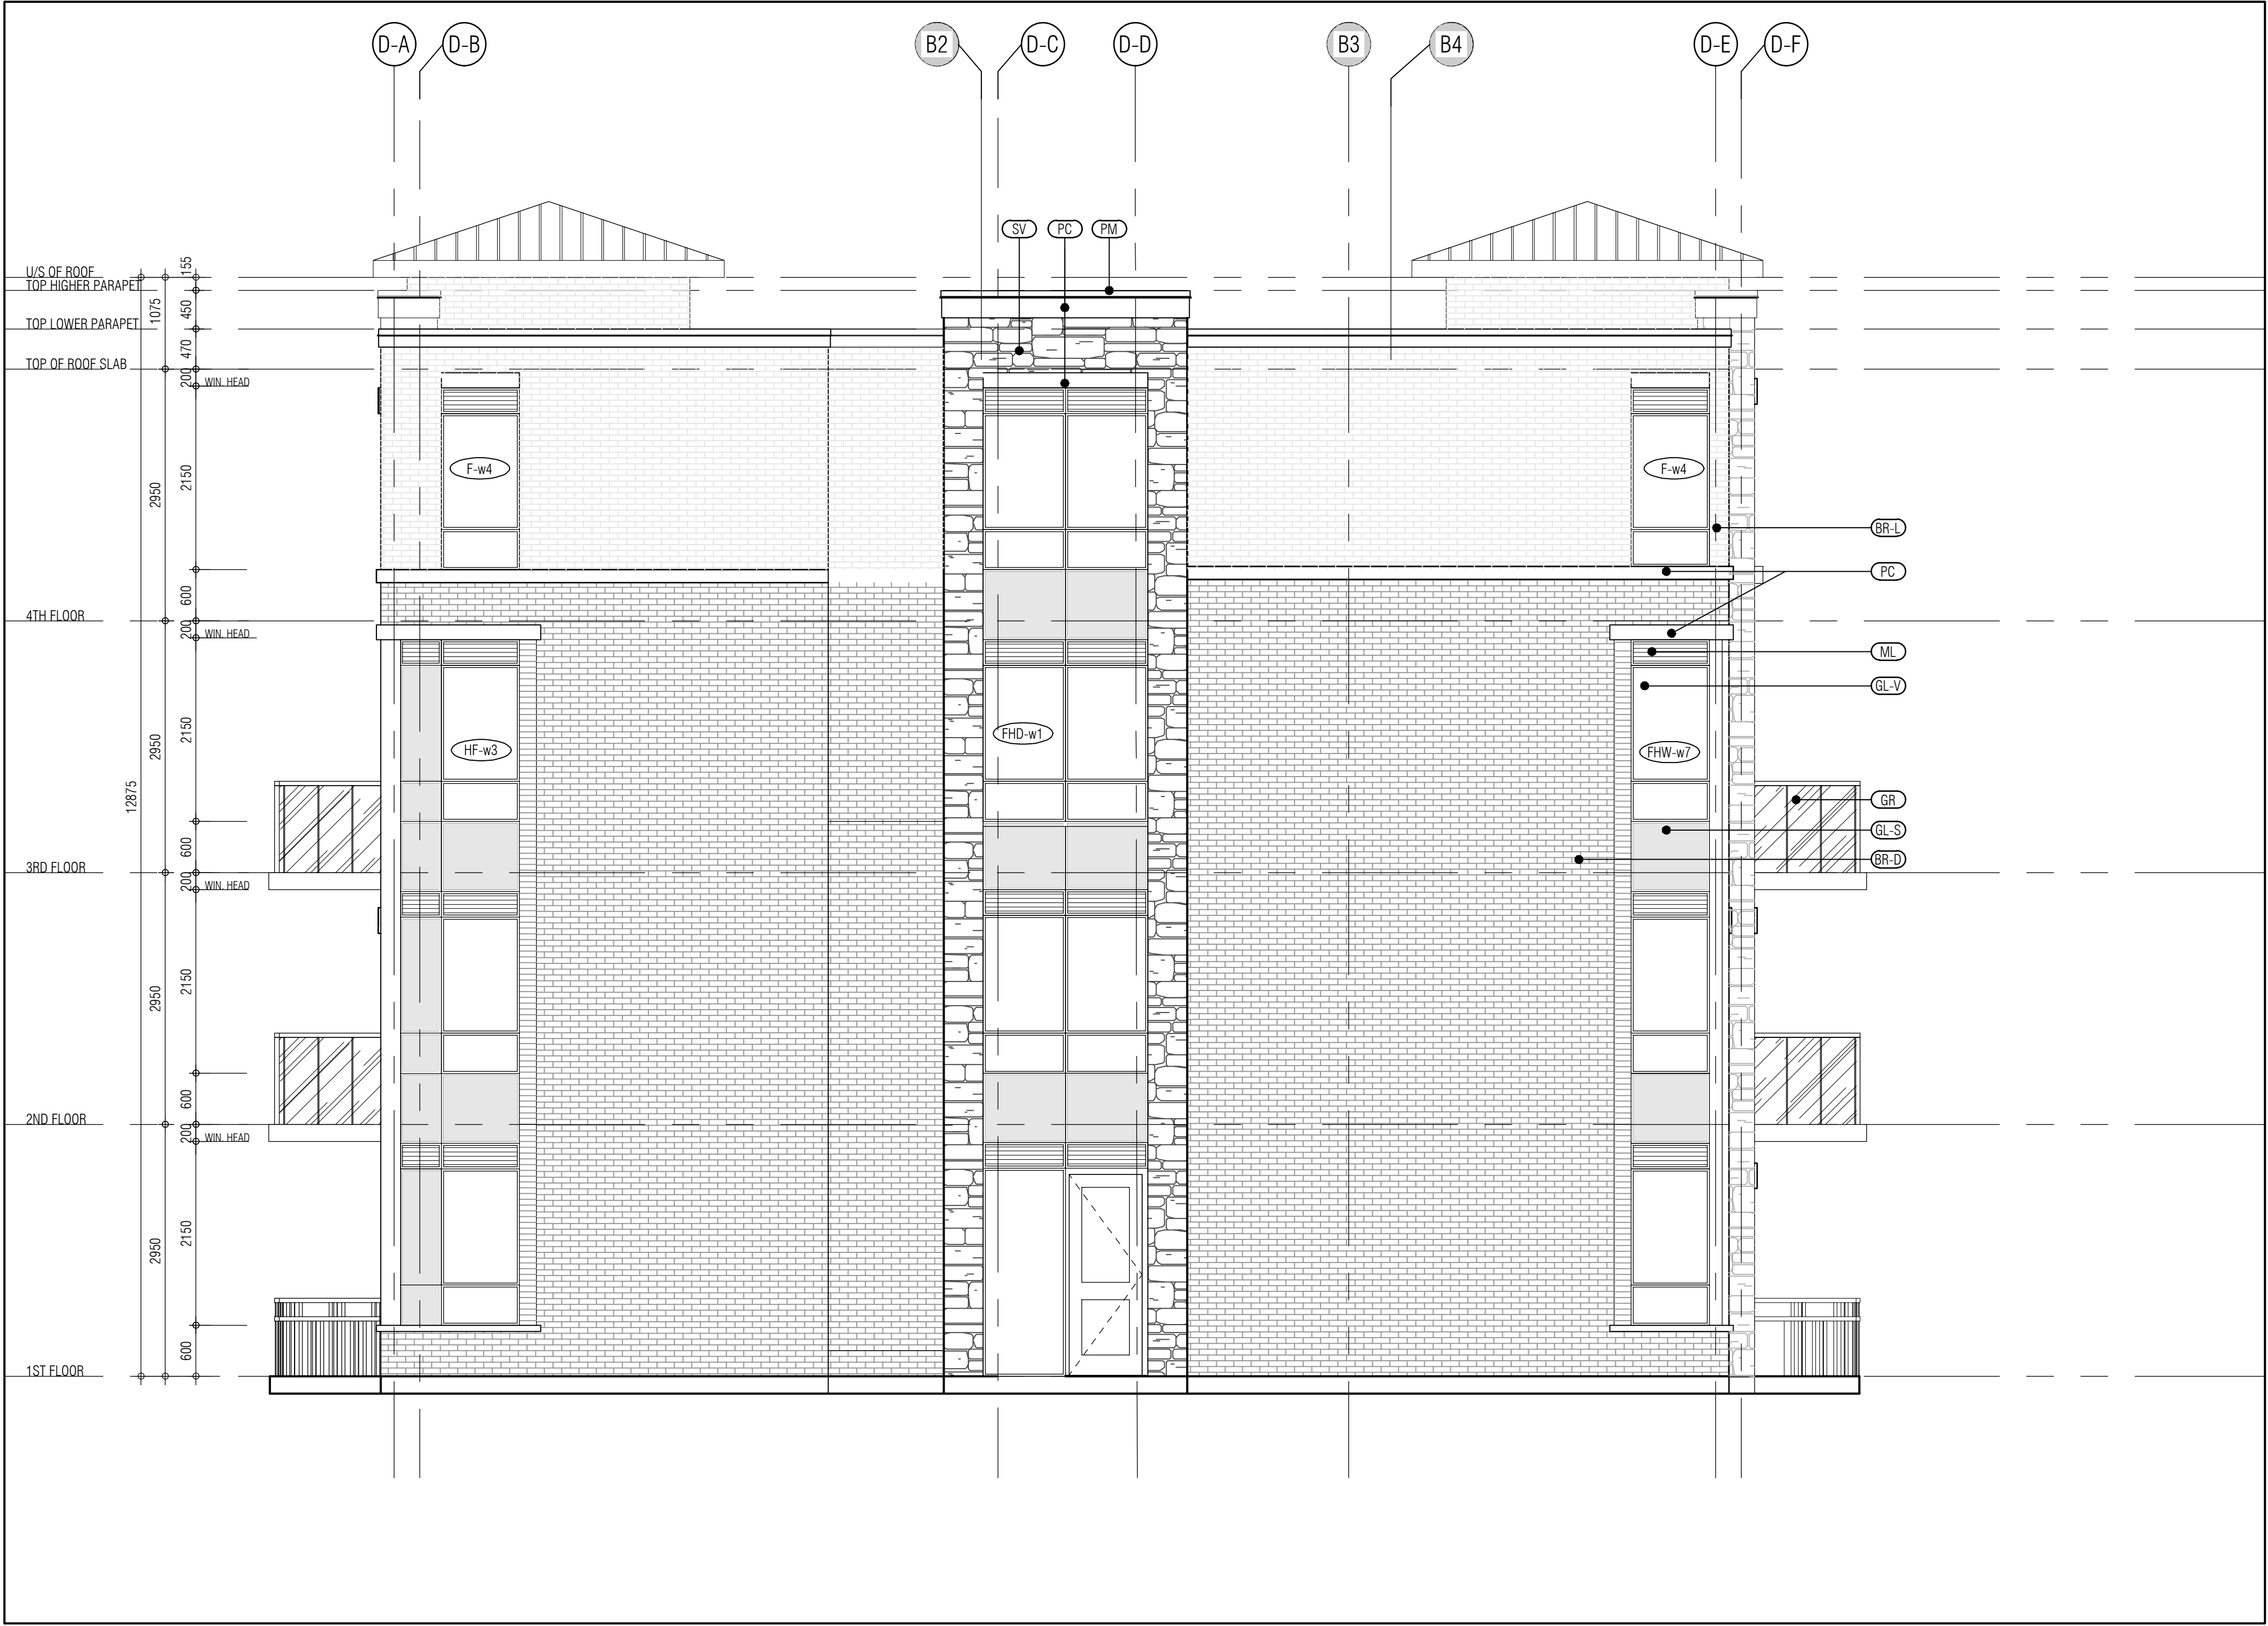

BUILDING D-EAST ELEVATION 1
1:50 A-404d3

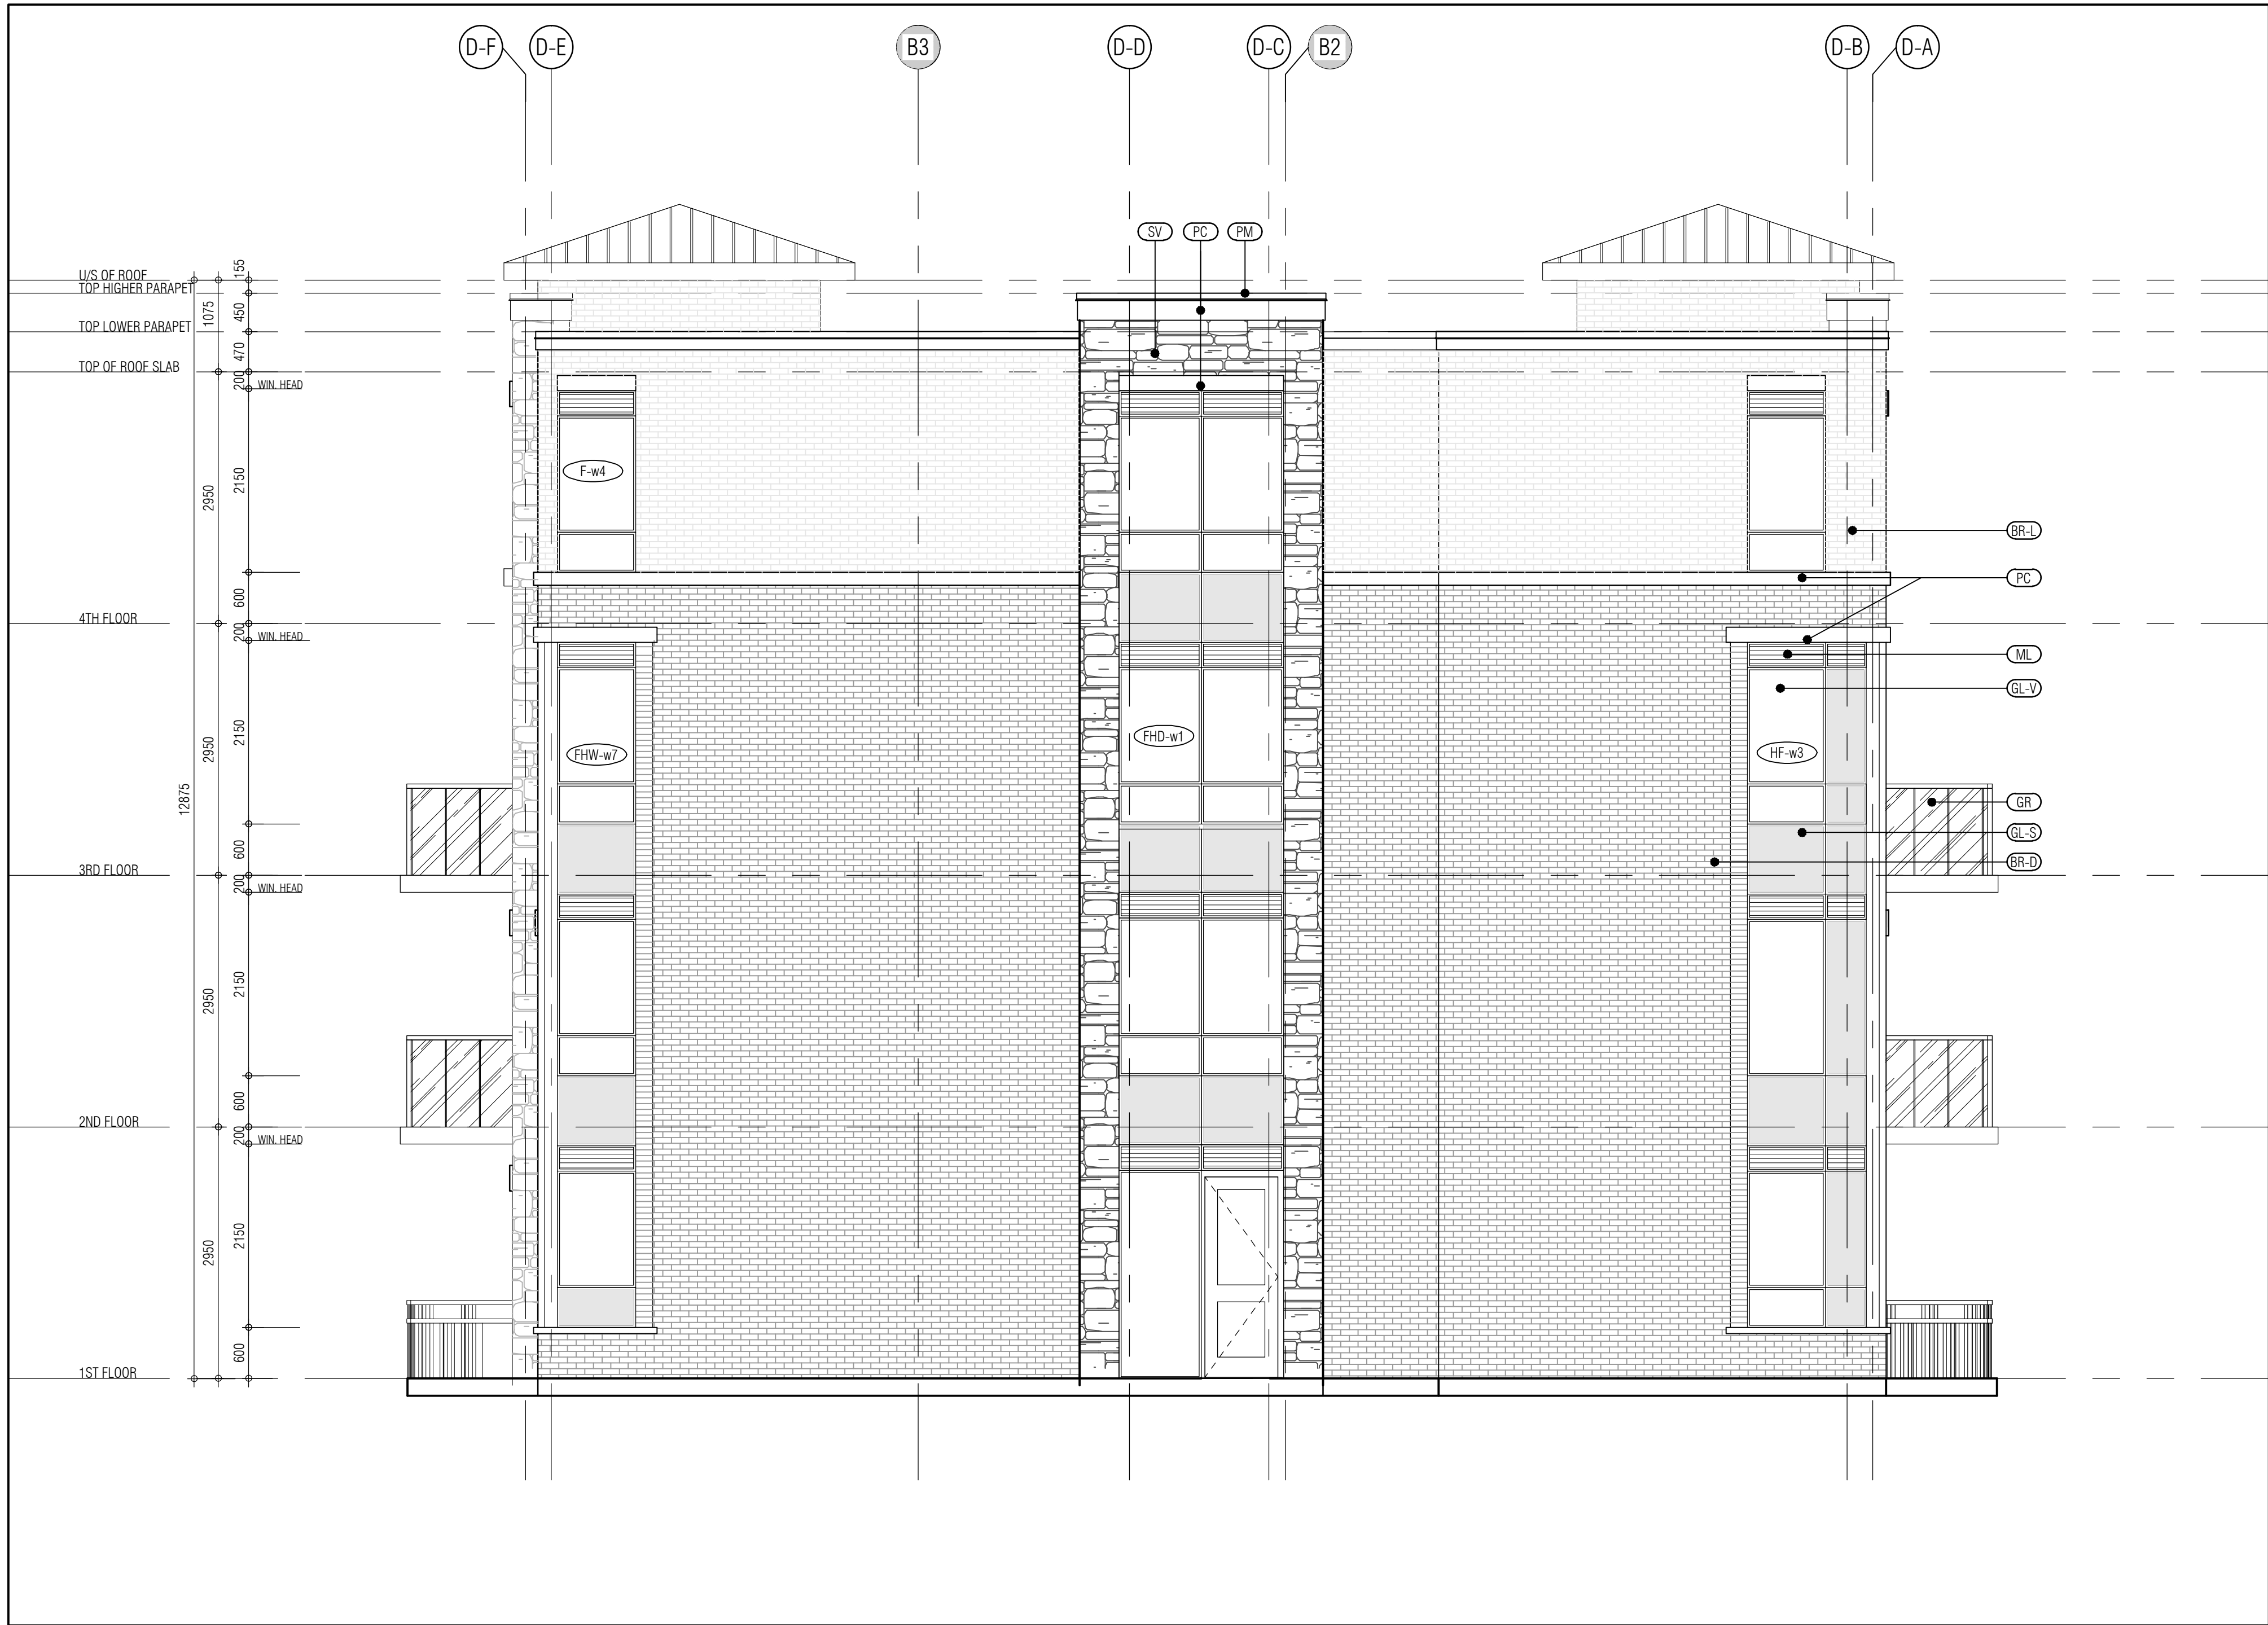

BUILDING D-WEST ELEVATION 2
1:50 A-404d3

MATERIALS LEGEND	
	VISION GLASS
	GLAZED SPANDREL PANEL
	PREFINISHED METAL LOUVRE/GRILLE
	STONE VENEER
	BRICK VENEER (DARK)
	BRICK VENEER (LIGHT)
	PRECAST CONCRETE HEADER/GRILL
	GLASS RAILING
	PREFINISHED METAL (FLASHING)

NOTE: IF EXACT SPECIFIED COLOUR IS NOT AVAILABLE, ATTEMPT COLOUR MATCH AND SUBMIT ALTERNATIVE SAMPLES FOR ARCHITECT'S APPROVAL.

issued for revisions

+

+

GRAZIANI
CORAZZA
ARCHITECTS

1000 SHAWANIGAN DRIVE, SUITE 100, MISSISSAUGA, ONTARIO L4W 1G1
TEL: 905.276.2000 FAX: 905.276.2044 WWW.GC-ARCHITECTS.COM

RESIDENTIAL

ATTMAR + PALLESCHI DRIVE

BRAMPTON ONTARIO

PROJECT ARCHITECT: B. GRAZIANI

ASSISTANT DESIGNER: R. LINCOLN

DRAWN BY: F.C./M.B.

CHECKED BY: D. BIASI (G. COLANGELO)

PLOT DATE: SEP. 18. 2019

JOB # 1331.15

EAST & WEST ELEVATION
BUILDING D

THIS DRAWING, AS AN INSTRUMENT OF SERVICE, IS PROVIDED BY AND IS THE PROPERTY OF GRAZIANI-CORAZZI ARCHITECTS INC. THE CONTRACTOR MUST VERIFY AND ACCEPT RESPONSIBILITY FOR ALL DIMENSIONS AND CONDITIONS ON SITE AND MUST KEEP GRAZIANI-CORAZZI ARCHITECTS INC. OF ANY VARIATIONS FROM THE SUPPLIED INFORMATION. GRAZIANI-CORAZZI ARCHITECTS INC. IS NOT RESPONSIBLE FOR THE ACCURACY OF SURVEY, STRUCTURAL, MECHANICAL, ELECTRICAL, AND OTHER ENGINEERING INFORMATION SHOWN ON THIS DRAWING. REFER TO THE APPROPRIATE ENGINEERING DRAWINGS BEFORE PROCEEDING WITH THE WORK. CONSTRUCTION MUST CONFORM TO ALL APPLICABLE CODES AND REQUIREMENTS OF THE AUTHORITIES HAVING JURISDICTION. ANALYSIS, CALCULATIONS, NO INVESTIGATION HAS BEEN UNDERTAKEN OR REPORTED ON BY THIS OFFICE IN RELATION TO THE DIMENSIONAL CONDITION OF THIS SITE.



THIS DRAWING IS NOT TO BE SCALED. ALL ARCHITECTURAL SYMBOLS INDICATED ON THIS DRAWING ARE GRAPHIC REPRESENTATIONS ONLY.

CONDITIONS FOR ELECTRONIC INFORMATION TRANSFER:

ELECTRONIC INFORMATION IS SUPPLIED TO THE OTHER ASSOCIATED FIRMS TO ASSIST THEM IN THE EXECUTION OF THEIR WORK/REVIEW. THE RECEIPT FIRMS MUST DETERMINE THE COMPLETENESS/APPROPRIATENESS/RELEVANCE OF THE INFORMATION IN RESPECT TO THEIR PARTICULAR RESPONSIBILITY.

GRAZIANI-CORAZZI ARCHITECTS INC. SHALL NOT BE RESPONSIBLE FOR:

1. OTHERS' NEGLIGENCE, INADEQUACIES DUE TO USE OF INFORMATION IN WHOLE OR PART WHEN INFORMATION IS TRANSFERRED.
2. TRANSMISSION OF ANY LOSS OR DAMAGE TO THE RECEIVING ELECTRONIC SYSTEM WHEN INFORMATION IS TRANSFERRED.

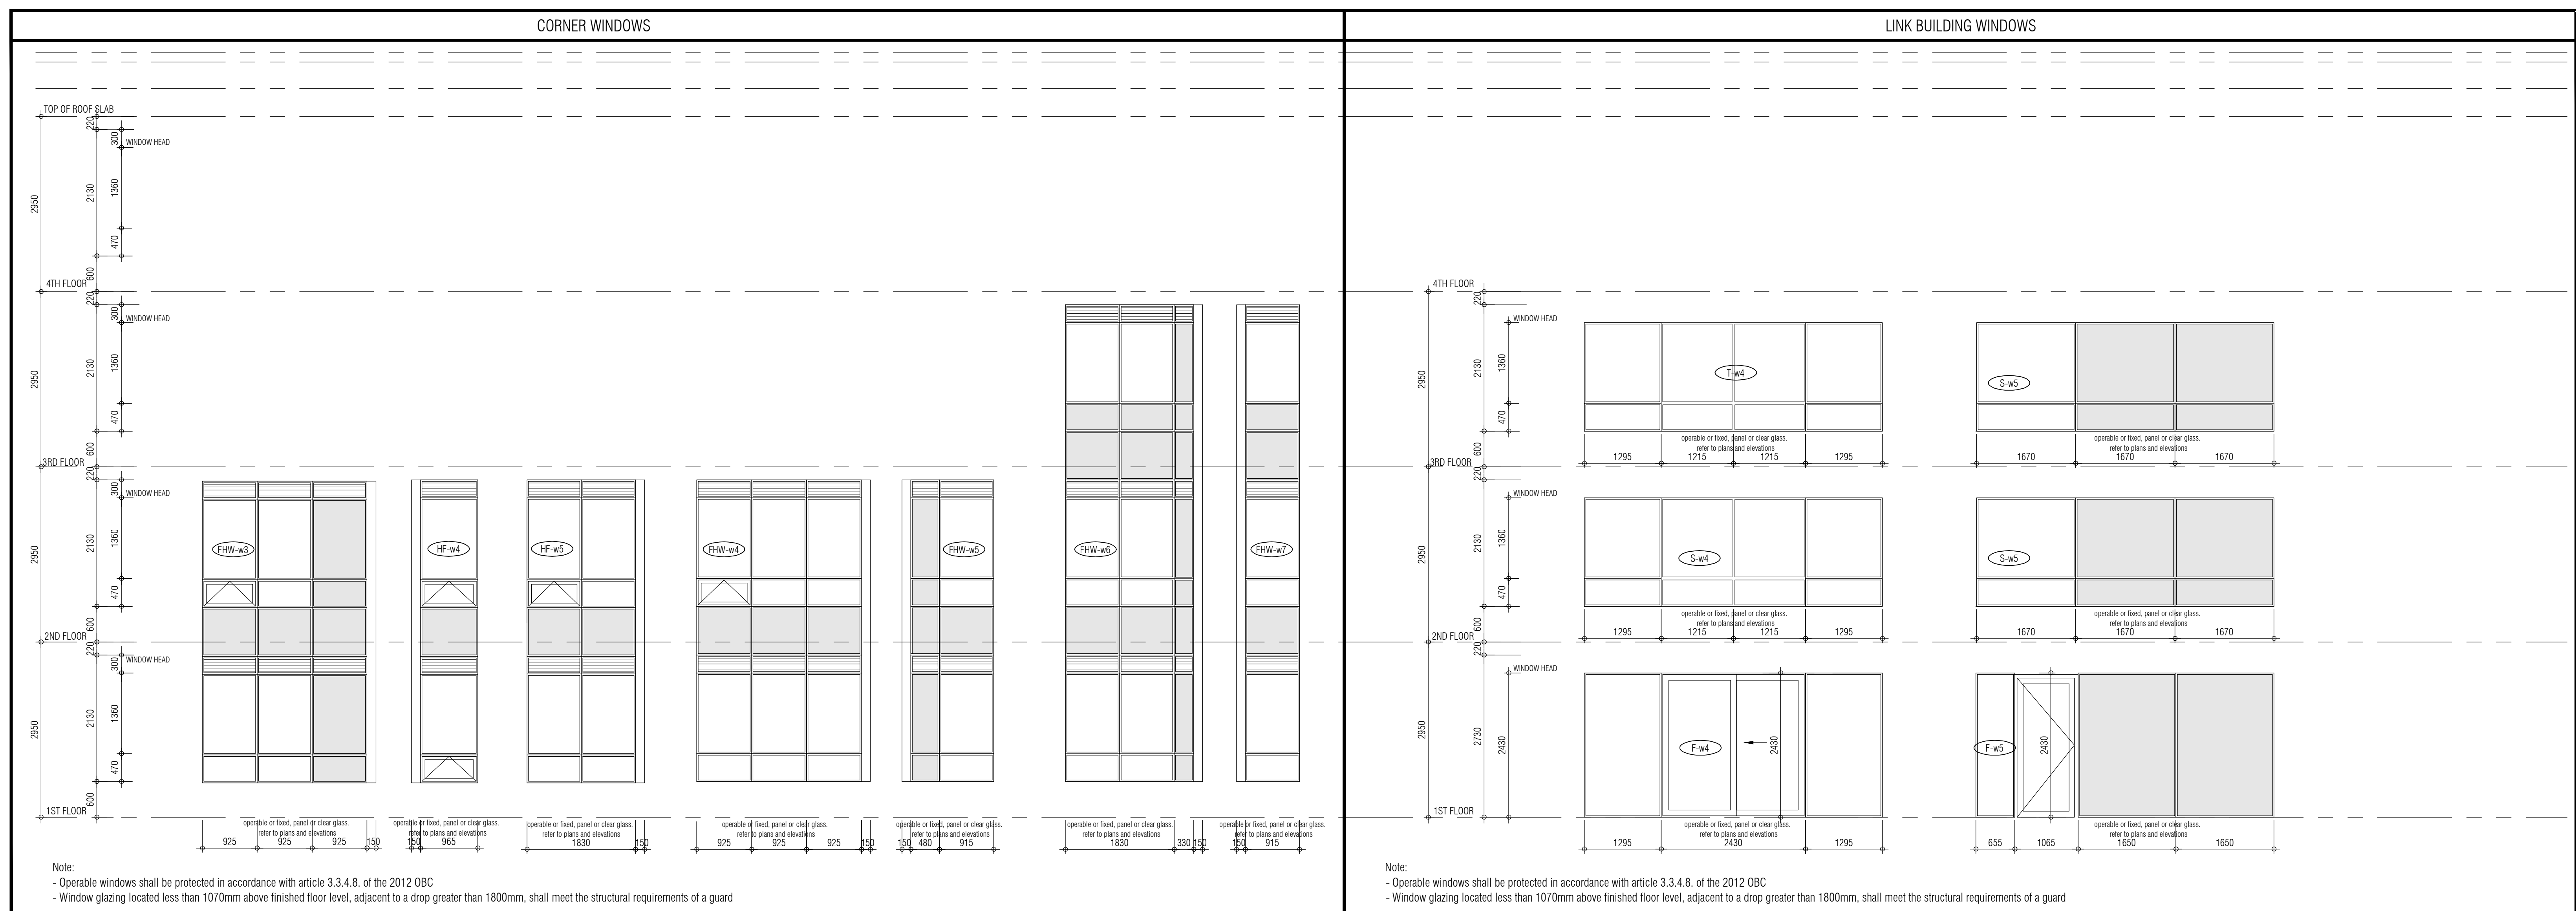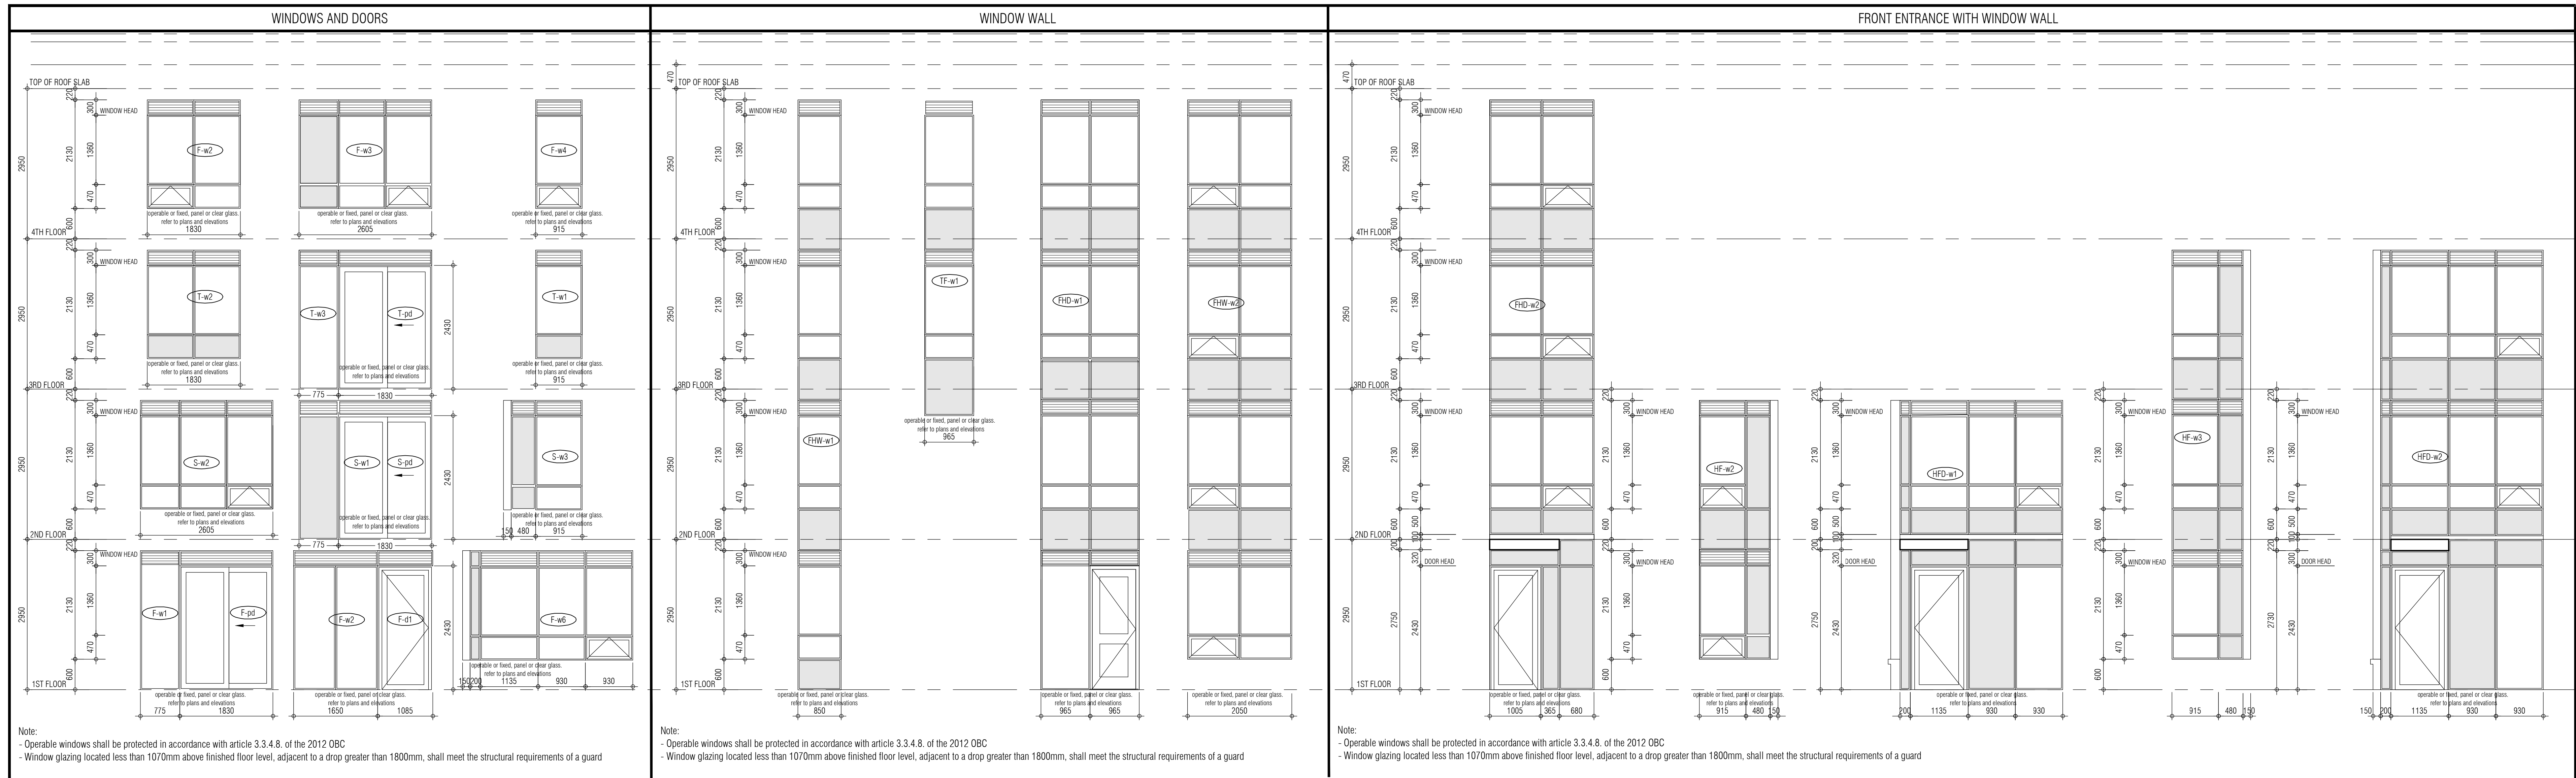

01. Aug.02.2019 issued for tender

issued for revisions




1100 DAVENPORT DRIVE, SUITE 100, MISSISSAUGA, ONTARIO L4V 1G3
TEL: 905.265.2650 FAX: 905.265.2644 WWW.GC-ARCHITECTS.COM



BRAMPTON ONTARIO

PROJECT ARCHITECT: B. GRAZIANI
ASSISTANT DESIGNER: R. LINCOLN
DRAWN BY: F.C./M.B.
CHECKED BY: D. BIASI (G. COLANGELO)
PLOT DATE: SEP. 18.2019
JOB #: 1331.15

Window Schedule

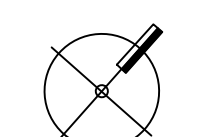

1:100

A900

TITLEBLOCK SIZE: 915 x 1200