



ADDENDUM

Forestside Estates
 Attmar & Palleschi Drive
 Brampton, Ontario
 Attn: **Vince Staffieri**

AM 07

PROJECT : Forestside
PROJECT # : 1331.15
DATE : Dec 14, 2020

Site instructions/memos and Addendums are issued only for the purpose of recording any clarification or interpretation of the contract documents or giving direction on problems resulting from field conditions. These memos are subject to the provisions of the contract documents and unless reviewed with and authorized by the Client, will not affect the contract. Should the Contractor require a change in the contract price or project schedule, he shall submit to the Client, prior to commencement of work outlined in this memo, an itemized proposal for approval.

Title: Updated drawings

Reference:		Changes:
P1	Underground Plan	• Add concrete block with chain link fence above and note at underground garage door.
A301 A302 A303	Floor Plans	• Remove Garbage room door in link areas and extend closet depth to firehose cabinets.
A403 A404	Elevations Elevations	• Revise East West Elevation Orientation. • Revise North South Elevation Orientation.

Reason: **Revise doors, fence and update elevations as directed by client.**

GRAZIANI + CORAZZA
 ARCHITECTS INC

D. Biase C.E.T.
 Principal

**Distribution:**

Royal Pine Homes	Vince Staffieri Cinzia Caruzo	vince@royalpinehomes.com Cinzia@royalpinehomes.com
Jablonski Engineering	Kevin Deonaraine	kdeonaraine@astint.on.ca
United Engineering	Rene Cuales Leonard Matthews Susan Pan Mark Giorgi	rene@u-eng.ca Lenard@u-eng.ca susan@u-eng.ca mark@u-eng.ca
Candevcon Limited	Diarmund Hogan Dudister Damnaraigh	dhorgan@candevcon.com dude@candevcon.com
Starfire Sprinkler Systems	Elite Novosselova Peter Adrian	elitecanada@hotmail.com Peter@starfiresystems.biz
Strybos Barron King Ltd.	Bryn Barron Kaleigh Gills Sydney Martel	bbarron@strybos.com kgillis@strybos.com smartel@strybos.com
Graziani + Corazza Architects	Domenic Biase Gino Colangelo Fernando Croatto	dbiase@gc-architects.com gcolangelo@gc-architects.com FCroatto@gc-architects.com


THIS DRAWING IS NOT TO BE SCALED. ALL ARCHITECTURAL SYMBOLS INDICATED ON THIS DRAWING ARE GRAPHIC REPRESENTATIONS ONLY.

CONDITIONS FOR ELECTRONIC INFORMATION TRANSFER:

ELECTRONIC INFORMATION IS SUPPLIED TO THE OTHER ASSOCIATED FIRMS TO ASSIST THEM IN THE EXECUTION OF THEIR WORK. HOWEVER, THE RECIPIENT FIRMS MUST DETERMINE THE COMPLETENESS/APPROPRIATENESS/RELEVANCE OF THE INFORMATION IN RESPECT TO THEIR PARTICULAR RESPONSIBILITY.


1. ERRORS, OMISSIONS, INCOMPLETENESS DUE TO LOSS OF INFORMATION IN WHOLE OR PART WHEN INFORMATION IS TRANSFERRED.
2. TRANSMISSION OF ANY DATA OR QUALITY OF RECEIVING ELECTRONIC SYSTEM WHEN INFORMATION IS TRANSFERRED.

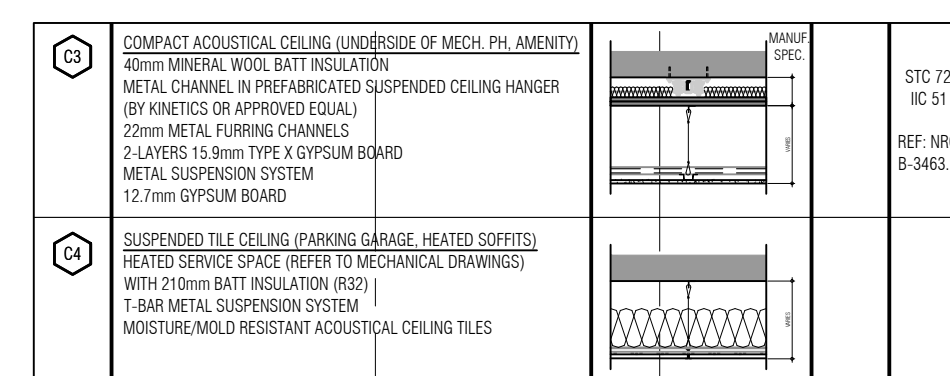

01. SEP 18, 2019 Issued for Addendum 1			
Issued for revisions			
RESIDENTIAL			
 ATTMAR + PALLESCHI DRIVE			
PROJECT ARCHITECT:	B. GRAZIANI		
ASSISTANT DESIGNER:	R. LINCOLN		
DRAWN BY:	G. C./F./M.B.		
CHECKED BY:	D. BIASE/G. COLANGELO		
PLOT DATE:	DEC. 14, 2020		
JOB ID:	1321.15		
PI UNDERGROUND PLAN (OVERALL PLAN)			
		1:200 A211	

THIS DRAWING, AS AN INSTRUMENT OF SERVICE, IS PROVIDED BY AND IS THE PROPERTY OF GRAZIANI-CORAZZA ARCHITECTS INC. THE CONTRACTOR MUST VERIFY AND ACCEPT RESPONSIBILITY FOR ALL DIMENSIONS AND CONDITIONS ON SITE AND MUST NOTIFY GRAZIANI-CORAZZA ARCHITECTS INC. OF ANY VARIATIONS FROM THE SUPPLIED INFORMATION. GRAZIANI-CORAZZA ARCHITECTS INC. IS NOT RESPONSIBLE FOR THE ACCURACY OF SURVEY, STRUCTURAL, MECHANICAL, ELECTRICAL, AND OTHER ENGINEERING INFORMATION SHOWN ON THIS DRAWING. REFER TO THE APPROPRIATE ENGINEERING DRAWINGS BEFORE PROCEEDING WITH THE WORK. CONSTRUCTION MUST CONFORM TO ALL APPLICABLE CODES AND REQUIREMENTS OF THE APPLICABLE HAVING JURISDICTION. UNLESS OTHERWISE NOTED, NO INVESTIGATION HAS BEEN UNDERTAKEN OR REPORTED ON BY THIS OFFICE IN REGARD TO THE ENVIRONMENTAL CONDITION OF THIS SITE.

THIS DRAWING IS NOT TO BE SCALED. ALL ARCHITECTURAL SYMBOLS INDICATED ON THIS DRAWING ARE GRAPHIC REPRESENTATIONS ONLY.

CONDITIONS FOR ELECTRONIC INFORMATION TRANSFER:

ELECTRONIC INFORMATION IS SUPPLIED TO THE OTHER ASSOCIATED FIRMS TO ASSIST THEM IN THE EXECUTION OF THEIR WORK. REVIEW THE RECEIVED FIRMS MUST DETERMINE THE COMPLETENESS, APPROPRIATENESS, RELEVANCE OF THE INFORMATION IN RESPECT TO THEIR PARTICULAR RESPONSIBILITY.


GRAZIANI-CORAZZA ARCHITECTS INC. SHALL NOT BE RESPONSIBLE FOR ERRORS, OMISSIONS, INCOMPLETENESS DUE TO LOSS OF INFORMATION IN WHOLE OR PART WHEN INFORMATION IS TRANSMITTED.

TRANSMISSION OF ANY FILES OR DAMAGE TO THE RECEIVING ELECTRONIC SYSTEM WHEN INFORMATION IS TRANSMITTED.

01. Oct.07.2019 issued for tender
02. Mar.13.2020 issued for design coordination #2
03. Mar.16.2020 issued for addendum #2
04. Mar.16.2020 issued for addendum #3
05. Aug.24.2020 issued for addendum #4
06. Sept. 28.2020 issued for permit
07. Oct.20.2020 issued for addendum #5
08. Nov.23.2020 issued for addendum #6
09. Dec.14.2020 issued for addendum #7

01. SEP 18, 2019 Issued for Addendum 1

issued for revisions

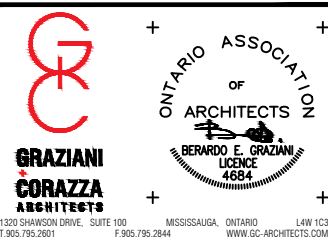

ATTMAR + PALLESCHI DRIVE

BRAMPTON ONTARIO

PROJECT ARCHITECT: B. GRAZIANI

ASSISTANT DESIGNER: R. LINCOLN

DRAWN BY: G.C./F.C./M.B.

CHECKED BY: D. BIASI/G. COLANGELO

PILOT DATE: DEC. 14.2020

JOB # 1331.15

P1 UNDERGROUND PLAN
(ENLARGE PLAN)

1:100 A211a

TITLEBLOCK SIZE: 915 x 1200

GENERAL NOTES & LEGEND

CONSTRUCTION NOTES: ALL NOTES ARE TO BE READ IN CONJUNCTION WITH THE DRAWING. DIMENSIONS ARE GIVEN IN METERS UNLESS OTHERWISE NOTED. 





THIS DRAWING, AS AN INSTRUMENT OF SERVICE, IS PROVIDED BY AND IS THE PROPERTY OF GRAZIANI-CORAZZA ARCHITECTS INC. THE CONTRACTOR MUST VERIFY AND ACCEPT RESPONSIBILITY FOR ALL DIMENSIONS AND COORDINATIONS WITH ALL EXISTING AND PROPOSED WORK. GRAZIANI-CORAZZA ARCHITECTS INC. IS NOT RESPONSIBLE FOR THE ACCURACY OF SURVEY, STRUCTURAL, MECHANICAL, ELECTRICAL, AND OTHER INFORMATION SHOWN ON THIS DRAWING. REFER TO THE APPROPRIATE ENGINEERING DRAWINGS BEFORE PROCEEDING WITH THE WORK. CONSTRUCTION MUST COMPLY WITH ALL APPLICABLE CODES AND REQUIREMENTS OF THE AUTHORITIES HAVING JURISDICTION. UNLESS OTHERWISE NOTED, NO MODIFICATION HAS BEEN MADE TO ANY INFORMATION OR BY THIS OFFICE IN REGARD TO THE ENVIRONMENTAL CONDITION OF THIS SITE.

THIS DRAWING IS NOT TO BE SCALED. ALL ARCHITECTURAL SYMBOLS INDICATED ON THIS DRAWING ARE GRAPHIC REPRESENTATIONS ONLY.

CONDITIONS FOR ELECTRONIC INFORMATION TRANSFER:

ELECTRONIC INFORMATION IS SUPPLIED TO THE OTHER ASSOCIATED FIRMS TO ASSIST THEM IN THE EXECUTION OF THEIR WORK. REVIEW THE RECEIVED FIRMS MUST DETERMINE THE COMPLETENESS, APPROPRIATENESS, RELIANCE OF THE INFORMATION IN RESPECT TO THEIR PARTICULAR RESPONSIBILITY.

GRAZIANI-CORAZZA ARCHITECTS INC. SHALL NOT BE RESPONSIBLE FOR ERRORS, OMISSIONS, INCOMPLETENESS DUE TO LOSS OF INFORMATION IN WHOLE OR PART, WHEN INFORMATION IS TRANSMITTED.

TRANSMISSION OF ANY FILES OR DAMAGE TO THE RECEIVING ELECTRONIC SYSTEM WHEN INFORMATION IS TRANSMITTED.

01. Oct.07.2019 Issued for tender
02. Mar.13.2020 Issued for design coordination #2
03. Mar.16.2020 Issued for addendum #2
04. Mar.16.2020 Issued for addendum #3
05. Aug.24.2020 Issued for addendum #4
06. Sept.28.2020 Issued for permit
07. Oct.20.2020 Issued for addendum #5
08. Nov.23.2020 Issued for addendum #6
09. Dec.14.2020 Issued for addendum #7












01. SEP 18, 2019 Issued for Addendum 1

Issued for revisions

ONTARIO ASSOCIATION OF ARCHITECTS

GRAZIANI CORAZZA ARCHITECTS


ATTMAR + PALLECHHI DRIVE

BRAMPTON **ONTARIO**

PROJECT ARCHITECT: R. GRAZIANI
ASSISTANT DESIGNER: R. LINCOLN
DRAWN BY: G. F. C. M. B.
CHECKED BY: D. BIASE / G. COLANGELO
PILOT DATE: DEC. 14, 2020
JOB # 1331.15

P1 UNDERGROUND PLAN (ENLARGE PLAN)

1:100 A211b

TITLEBLOCK SIZE: 915 x 1200

THIS DRAWING IS AN INSTRUMENT OF SERVICE, IT IS PROVIDED BY AND IS THE PROPERTY OF GRAZIANI-CORAZZA ARCHITECTS INC. THE CONTRACTOR MUST VERIFY AND ACCEPT RESPONSIBILITY FOR ALL DIMENSIONS AND COORDINATE ON SITE AND MUST NOTIFY GRAZIANI-CORAZZA ARCHITECTS INC. OF ANY VARIATIONS FROM THE SUPPLIED INFORMATION. GRAZIANI-CORAZZA ARCHITECTS INC. IS NOT RESPONSIBLE FOR THE ACCURACY OF SURVEY, STRUCTURAL, MECHANICAL, ELECTRICAL, AND OTHER ENGINEERING INFORMATION SHOWN ON THIS DRAWING. REFER TO THE APPROPRIATE ENGINEERING DRAWINGS BEFORE PROCEEDING WITH THE WORK. CONSTRUCTION MUST CONFORM TO ALL APPLICABLE CODES AND REQUIREMENTS OF THE AUTHORITIES HAVING JURISDICTION. UNLESS OTHERWISE NOTED, NO INVESTIGATION HAS BEEN UNDERTAKEN OR REPORTED ON BY THIS OFFICE IN REGARDS TO THE ENVIRONMENTAL CONDITION OF THIS SITE.

THIS DRAWING IS NOT TO BE SCALED. ALL ARCHITECTURAL SYMBOLS INDICATED ON THIS DRAWING ARE GRAPHIC REPRESENTATIONS ONLY.

CONDITIONS FOR ELECTRONIC INFORMATION TRANSFER:

ELECTRONIC INFORMATION IS SUPPLIED TO THE OTHER ASSOCIATED FIRMS TO ASSIST THEM IN THE EXECUTION OF THEIR WORK. REVIEW THE RECEIVED FIRMS MUST DETERMINE THE COMPLETENESS, APPROPRIATENESS, RELIANCE OF THE INFORMATION IN RESPECT TO THEIR PARTICULAR RESPONSIBILITY.

GRAZIANI-CORAZZA ARCHITECTS INC. SHALL NOT BE RESPONSIBLE FOR ERROR, OMISSION, INCOMPLETENESS DUE TO USE OF INFORMATION IN WHOLE OR PART WHEN INFORMATION IS TRANSMITTED.

1. TRANSMISSION OF ANY FILES OR DAMAGE TO THE RECEIVING ELECTRONIC SYSTEM WHEN INFORMATION IS TRANSMITTED.

01. Oct.07.2019 Issued for tender
02. Mar.13.2020 Issued for design coordination #2
03. Mar.16.2020 Issued for addendum #2
04. Mar.16.2020 Issued for addendum #3
05. Aug.24.2020 Issued for addendum #4
06. Sept.28.2020 Issued for permit
07. Oct.20.2020 Issued for addendum #5
08. Nov.23.2020 Issued for addendum #6
09. Dec.14.2020 Issued for addendum #7

01. SEP 18, 2019 Issued for Addendum 1

Issued for revisions




RESIDENTIAL

ATTMAR + PALLESCHI DRIVE

BRAMPTON ONTARIO

PROJECT ARCHITECT: B.GRAZIANI

ASSISTANT DESIGNER: R.LINCOLN


DRAWN BY: G.C./F.C./M.B.

CHECKED BY: D.BIASI/G.COLANGELO

PLLOT DATE: DEC.13.2020

JOB # 1331.15

GROUND FLOOR OVERALL PLAN

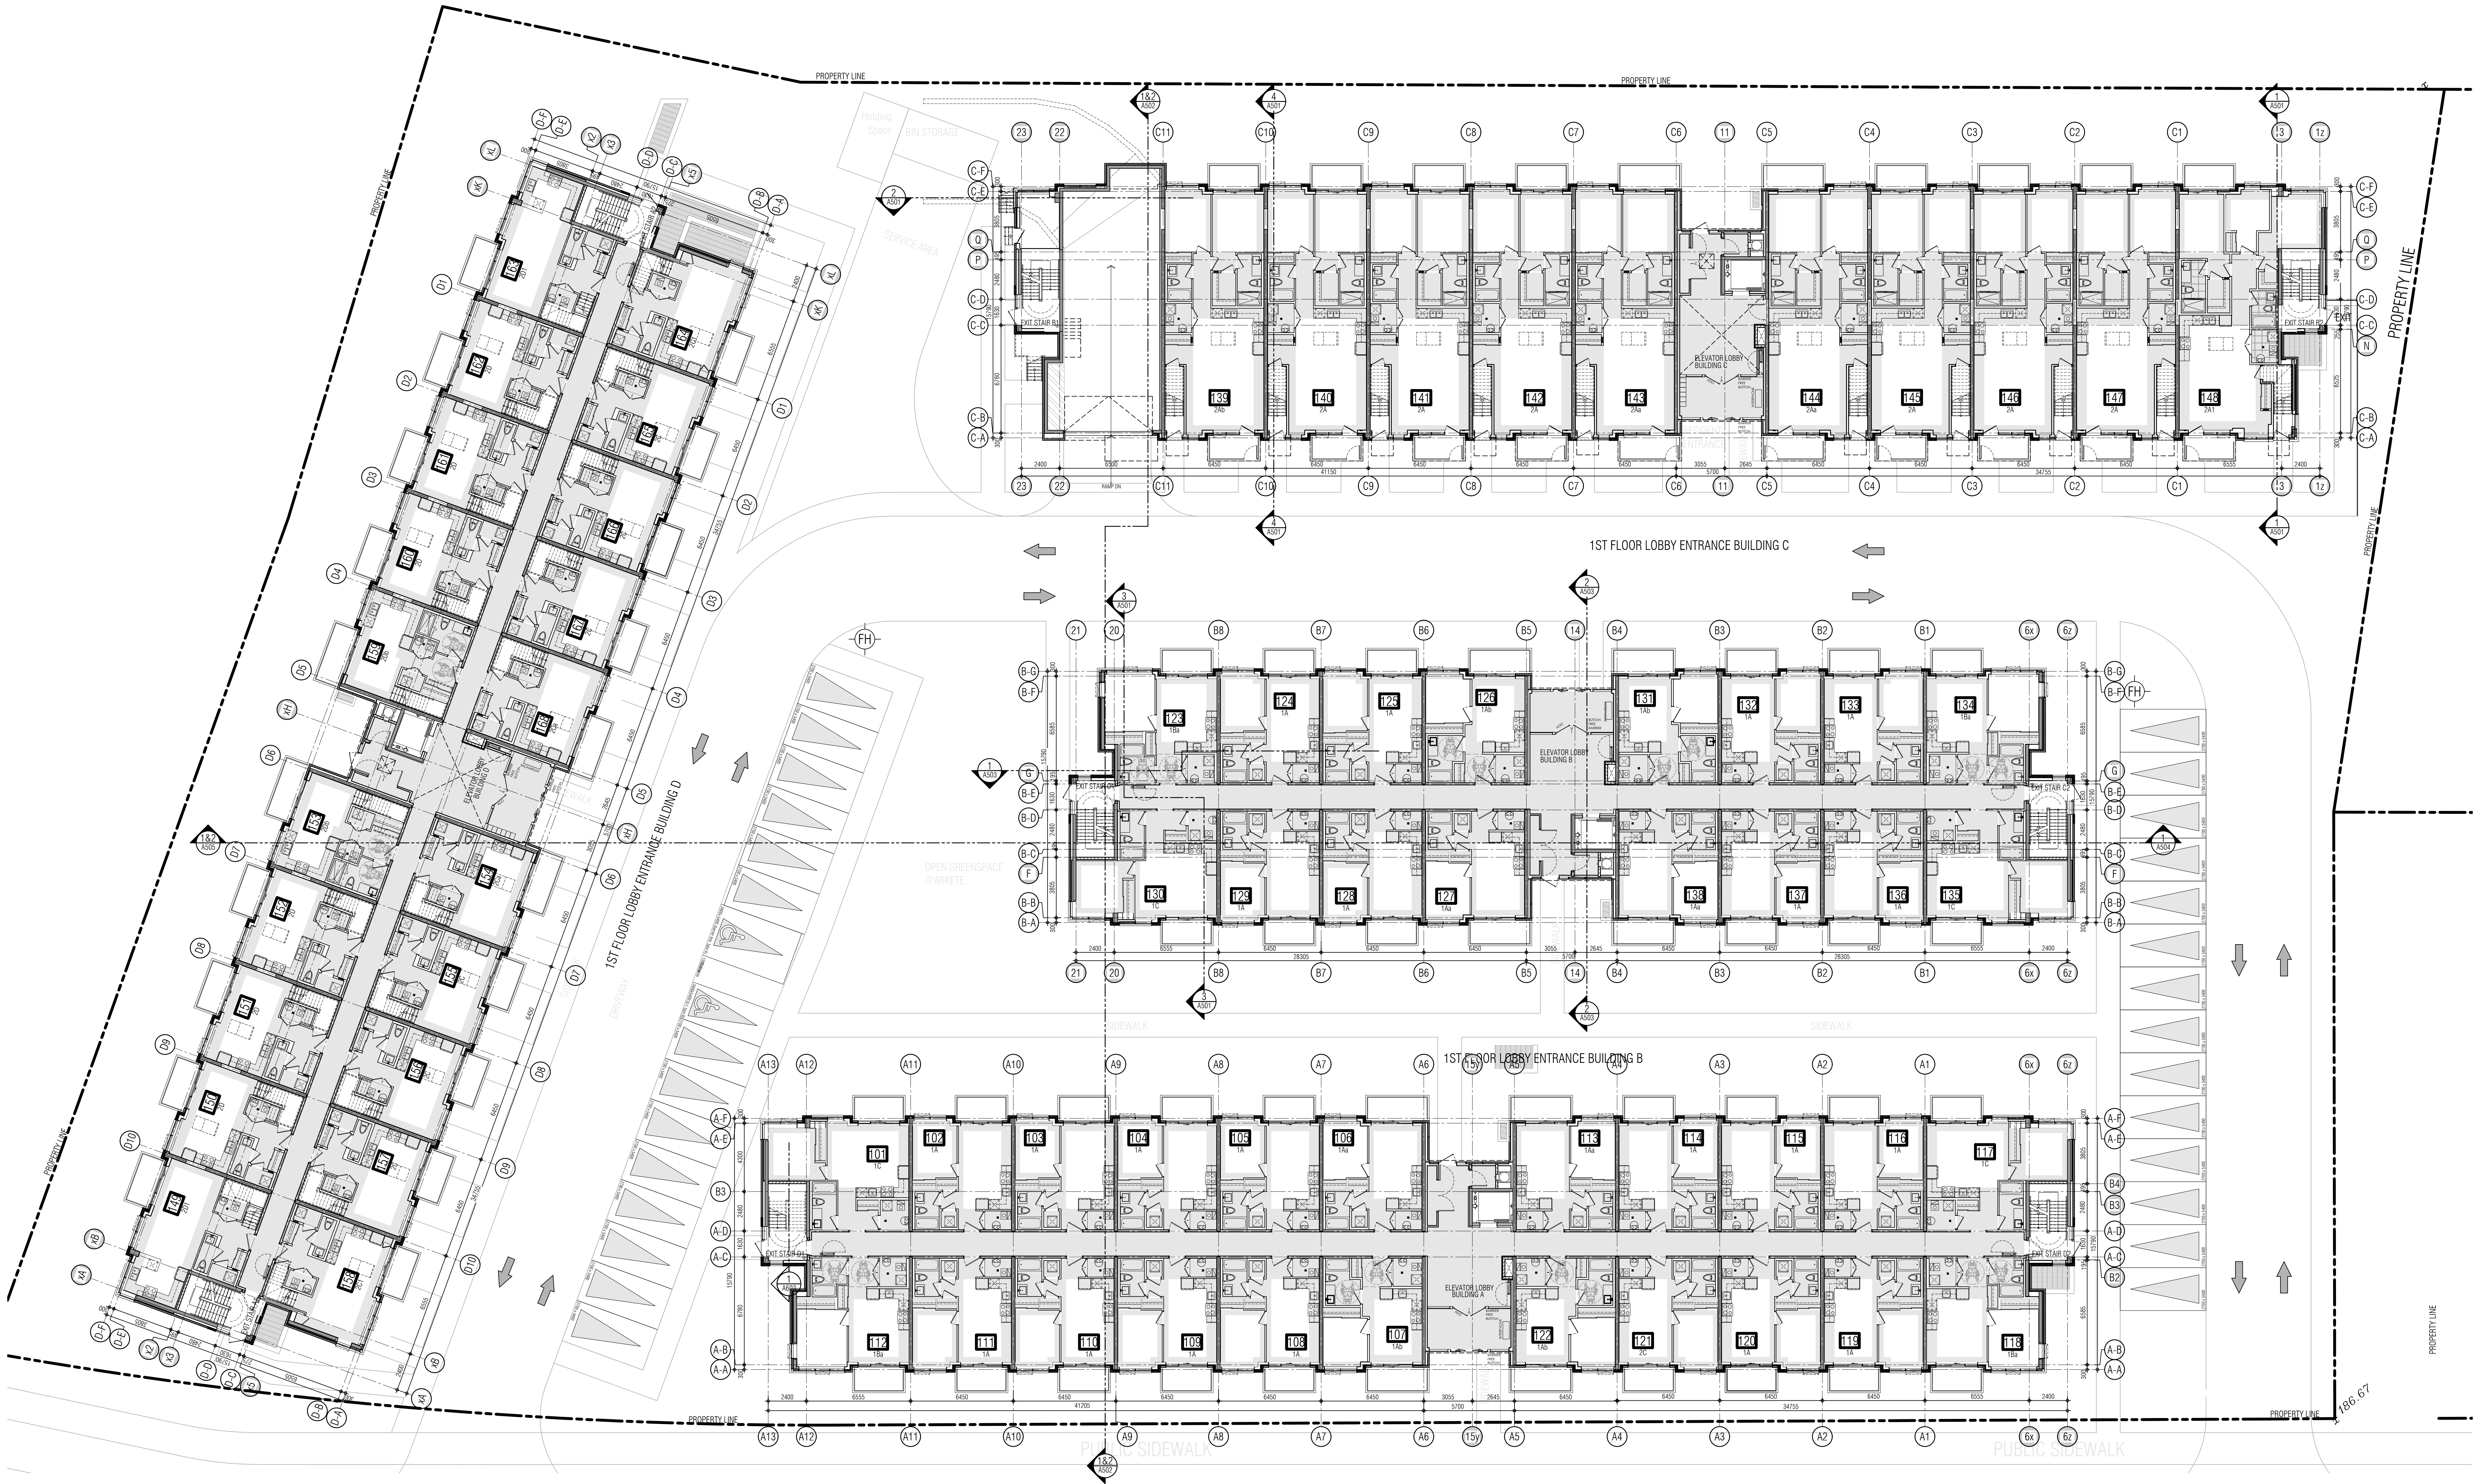

THIS DRAWING, AS AN INSTRUMENT OF SERVICE, IS PROVIDED BY AND IS THE PROPERTY OF GRAZIANI-CORAZZA ARCHITECTS INC. THE CONTRACTOR MUST VERIFY AND ACCEPT RESPONSIBILITY FOR ALL DIMENSIONS AND COORDINATIONS AND MUST NOTIFY GRAZIANI-CORAZZA ARCHITECTS INC. OF ANY DISCREPANCIES FROM THE SUPPLIED INFORMATION. GRAZIANI-CORAZZA ARCHITECTS INC. IS NOT RESPONSIBLE FOR THE ACCURACY OF SURVEY, STRUCTURAL, MECHANICAL, ELECTRICAL, AND OTHER ENGINEERING INFORMATION SHOWN ON THIS DRAWING. REFER TO THE APPROPRIATE ENGINEERING DRAWINGS BEFORE PROCEEDING WITH THE WORK. CONSTRUCTION MUST COMPLY TO ALL APPLICABLE CODES AND REQUIREMENTS OF THE AUTHORITIES HAVING JURISDICTION. UNLESS OTHERWISE NOTED, NO MODIFICATION HAS BEEN MADE TO ANY REPORTED OR BY THIS OFFICE IN RELATION TO THE ENVIRONMENTAL CONDITION OF THIS SITE.

THIS DRAWING IS NOT TO BE SCALED. ALL ARCHITECTURAL SYMBOLS INDICATED ON THIS DRAWING ARE GRAPHIC REPRESENTATIONS ONLY.


CONDITIONS FOR ELECTRONIC INFORMATION TRANSFER

ELECTRONIC INFORMATION IS SUPPLIED TO THE OTHER ASSOCIATED FIRMS TO ASSIST THEM IN THE EXECUTION OF THEIR WORK. REVIEW THE RECEIVED FIRMS MUST DETERMINE THE COMPLETENESS, APPROPRIATENESS, RELIANCE OF THE INFORMATION IN RESPECT TO THEIR PARTICULAR RESPONSIBILITY.

1. GRAZIANI-CORAZZA ARCHITECTS INC. SHALL NOT BE RESPONSIBLE FOR ERRORS, OMISSIONS, INCOMPLETENESS DUE TO USE OF INFORMATION IN WHOLE OR PART, WHEN INFORMATION IS TRANSFERRED.
2. TRANSMISSION OF ANY FILES OR DAMAGE TO THE RECEIVING ELECTRONIC SYSTEM WHEN INFORMATION IS TRANSFERRED.

REF A301d2 FOR CONTINUATION

- | | | | |
|-----|--------------|-----------------------------------|---|
| 01. | Oct.07.2019 | Issued for tender | — |
| 02. | Mar.13.2020 | Issued for design coordination #2 | — |
| 03. | Mar.16.2020 | Issued for addendum #2 | — |
| 04. | Mar.16.2020 | Issued for addendum #3 | — |
| 05. | Aug.24.2020 | Issued for addendum #4 | — |
| 06. | Sept.28.2020 | Issued for permit | — |
| 07. | Oct.20.2020 | Issued for addendum #5 | — |
| 08. | Nov.23.2020 | Issued for addendum #6 | — |
| 09. | Dec.14.2020 | Issued for addendum #7 | — |

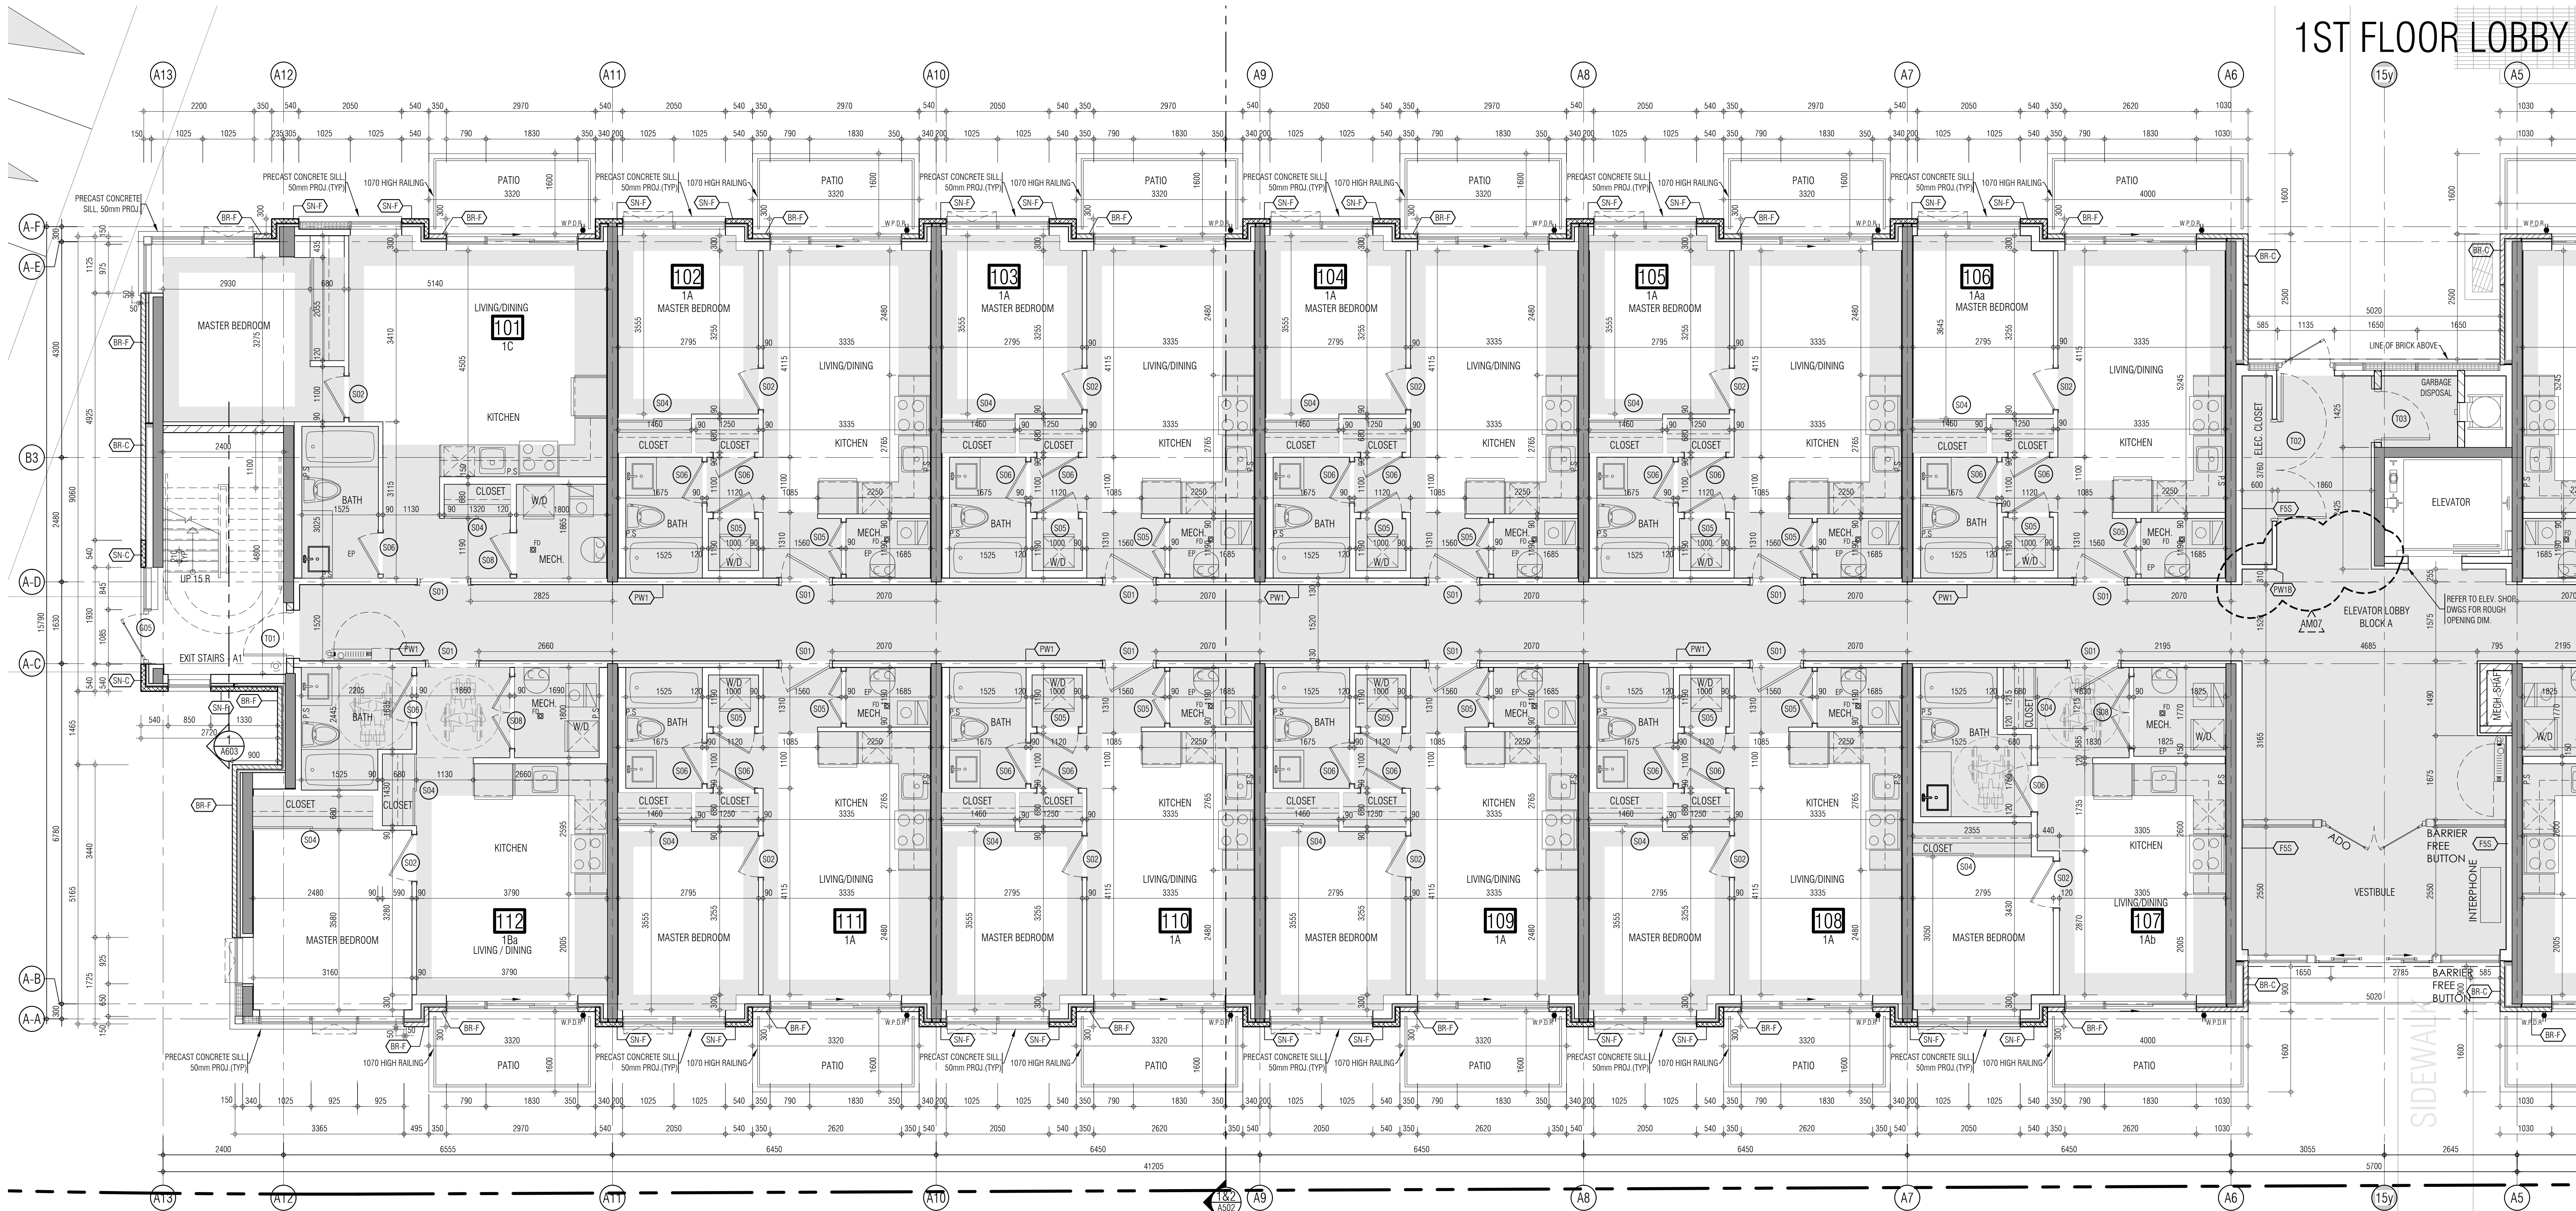

01. SEP 18, 2019 Issued for Addendum 1

Issued for revisions



1331 SHANAHAN DRIVE, SUITE 100 MISSISSAUGA, ONTARIO L4W 1C3
905.760.2801 F:905.760.2804 WWW.GC-ARCHITECTS.COM




BRAMPTON ONTARIO
PROJECT ARCHITECT: B. GRAZIANI
ASSISTANT DESIGNER: R. LINCOLN
DRAWN BY: G. C./F. C./M. B.
CHECKED BY: D. BIASE/G. COLANGELO
PLOT DATE: DEC.13.2020
JOB #: 1331.15

GROUND FLOOR PLAN
BUILDING A (PARTIAL PLAN)


1:50 A-301a1

TITLEBLOCK SIZE: 915 x 1200

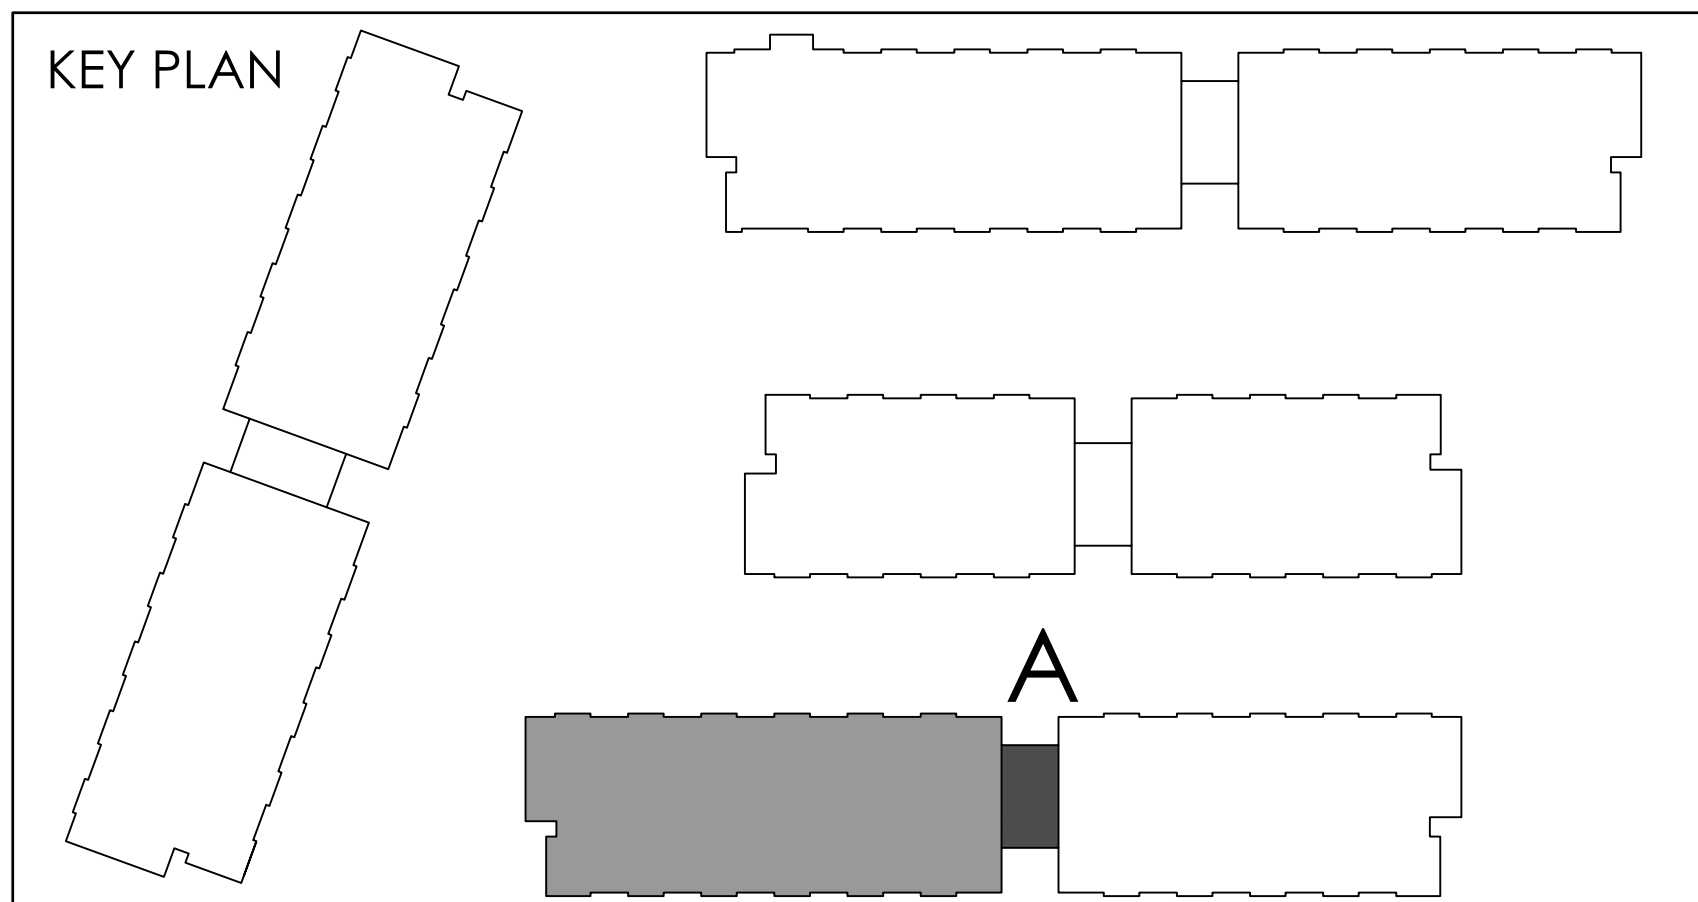


REF.A301d1 FOR CONTINUATION

1ST FLOOR LOBBY ENTRANCE BUILDING B

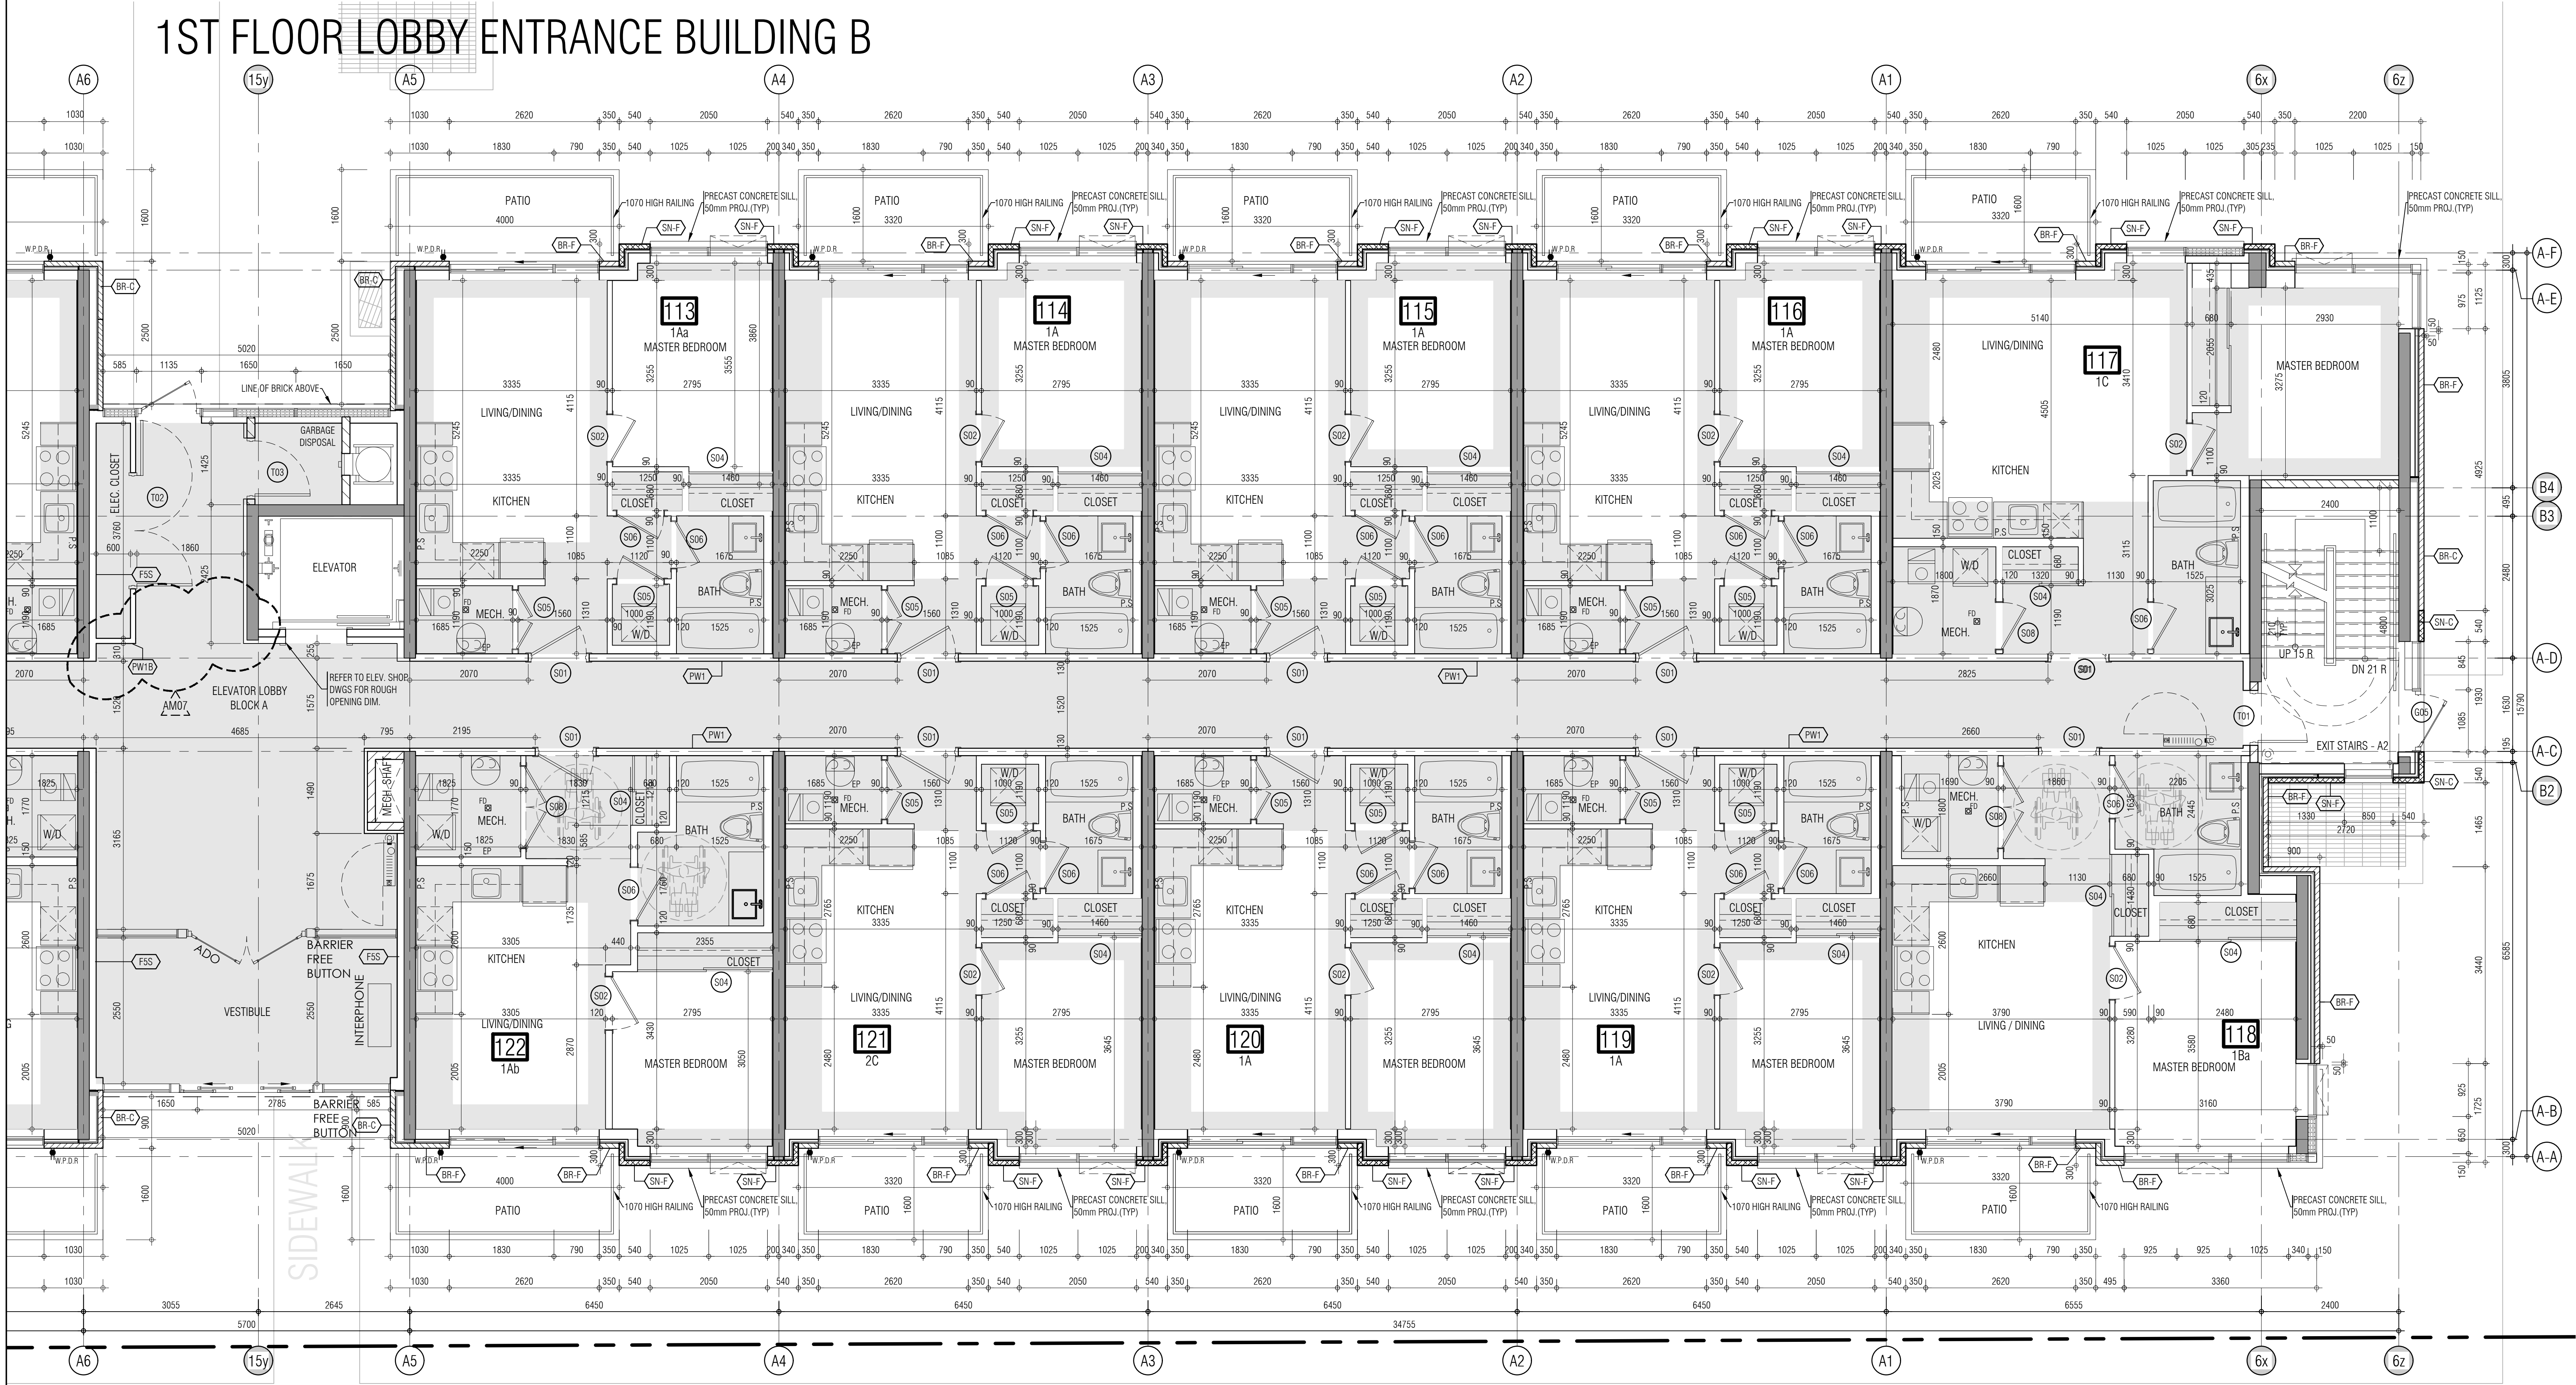

KEY PLAN

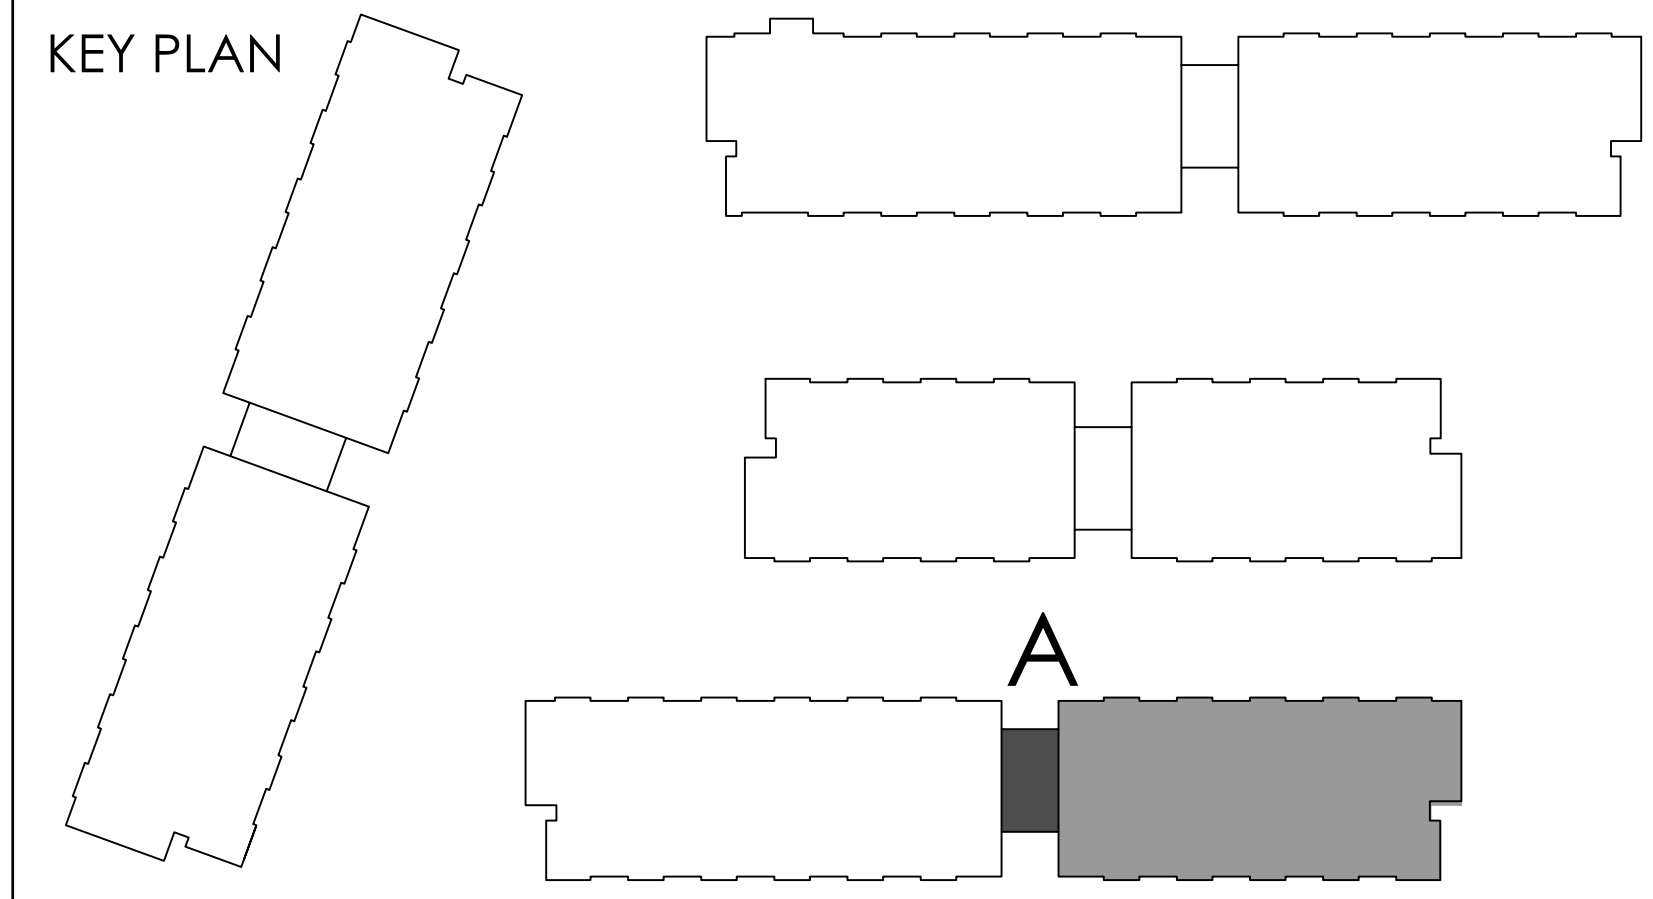

- 01. Oct.07.2019 issued for tender
- 02. Mar.13.2020 issued for design coordination #2
- 03. Mar.16.2020 issued for addendum #2
- 04. Mar.16.2020 issued for addendum #3
- 05. Aug.24.2020 issued for addendum #4
- 06. Sept.28.2020 issued for permit
- 07. Oct.20.2020 issued for addendum #5
- 08. Nov.23.2020 issued for addendum #6
- 09. Dec.14.2020 issued for addendum #7

- 01. SEP.18.2019 issued for Addendum 1
- issued for revisions



ATTMAR + PALLESCI DRIVE
PROJECT ARCHITECT: B. GRAZIANNI
ASSISTANT DESIGNER: R. LINCOLN
DRAWN BY: G.C./F.C./M.B.
CHECKED BY: D. BIASE/G. COLANGELO
PLOT DATE: DEC.13.2020
JOB #: 1331.15

GROUND FLOOR PLAN BUILDING A (PARTIAL PLAN)

1:50 A-301a2
TITLE BLOCK SIZE: 915 x 1200


THIS DRAWING IS NOT TO BE SCALED. ALL ARCHITECTURAL SYMBOLS INDICATED ON THIS DRAWING ARE GRAPHIC REPRESENTATIONS ONLY.

CONDITIONS FOR ELECTRONIC INFORMATION TRANSFER:

ELECTRONIC INFORMATION IS SUPPLIED TO THE OTHER ASSOCIATED FIRMS TO ASSIST THEM IN THE EXECUTION OF THEIR WORK. REVIEW, THE RECENT FIRMS MUST DETERMINE THE COMPLETENESS/APPROPRIATENESS/RELEVANCE OF THE INFORMATION IN RESPECT TO THEIR PARTICULAR RESPONSIBILITY.



- 1. ERRORS/OMISSIONS/INCOMPLETENESS DUE TO LOSS OF INFORMATION IN WHOLE OR PART WHEN INFORMATION IS TRANSFERRED.
- 2. TRANSMISSION OF ANY PUBLIC OR PRIVATE DAMAGE TO THE RECEIVING ELECTRONIC SYSTEM WHEN INFORMATION IS TRANSFERRED.

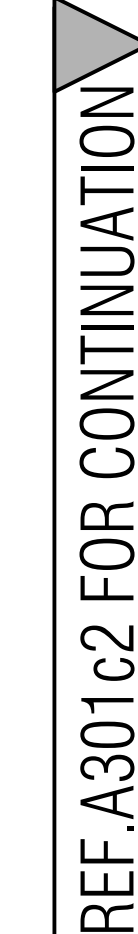

[illegible]

01.	Oct.07.2019	issued for tender	
02.	Mar.13.2020	issued for design coordination #2	
03.	Mar.16.2020	issued for addendum #2	
04.	Mar.16.2020	issued for addendum #3	
05.	Aug.24.2020	issued for addendum #4	
06.	Sept. 28.2020	issued for permit	bq
07.	Oct.20.2020	issued for addendum #5	bq
08.	Nov.23.2020	issued for addendum #6	bq
09.	Dec.14.2020	issued for addendum #7	bq

KEY PLAN

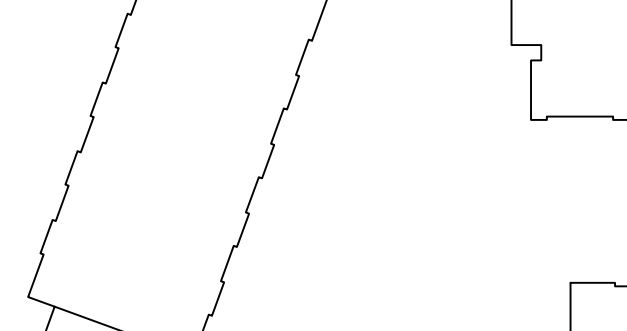


THIS DRAWING IS AN INSTRUMENT OF SERVICE, IT IS PROVIDED BY AND IS THE PROPERTY OF GRAZIANI-CORAZZA ARCHITECTS INC. THE CONTRACTOR MUST VERIFY AND ACCEPT RESPONSIBILITY FOR ALL DIMENSIONS AND COORDINATIONS AND MUST NOTIFY GRAZIANI-CORAZZA ARCHITECTS INC. OF ANY DISCREPANCIES FROM THE SUPPLIED INFORMATION. GRAZIANI-CORAZZA ARCHITECTS INC. IS NOT RESPONSIBLE FOR THE ACCURACY OF SURVEY, STRUCTURAL, MECHANICAL, ELECTRICAL, AND OTHER ENGINEERING INFORMATION SHOWN ON THIS DRAWING. REFER TO THE APPROPRIATE ENGINEERING DRAWINGS BEFORE PROCEEDING WITH THE WORK. CONSTRUCTION MUST COMPLY TO ALL APPLICABLE CODES AND REQUIREMENTS OF THE AUTHORITIES HAVING JURISDICTION. UNLESS OTHERWISE NOTED, NO MODIFICATION HAS BEEN MADE TO ANY REPORTED OR BY THIS OFFICE IN RELATION TO THE ENVIRONMENTAL CONDITION OF THIS SITE.

THIS DRAWING IS NOT TO BE SCALED. ALL ARCHITECTURAL SYMBOLS INDICATED ON THIS DRAWING ARE GRAPHIC REPRESENTATIONS ONLY.


CONDITIONS FOR ELECTRONIC INFORMATION TRANSFER:

ELECTRONIC INFORMATION IS SUPPLIED TO THE OTHER ASSOCIATED FIRMS TO ASSIST THEM IN THE EXECUTION OF THEIR WORK. REVIEW THE RECEIVED FIRMS MUST DETERMINE THE COMPLETENESS, APPROPRIATENESS, RELIANCE OF THE INFORMATION IN RESPECT TO THEIR PARTICULAR RESPONSIBILITY.

1. GRAZIANI-CORAZZA ARCHITECTS INC. SHALL NOT BE RESPONSIBLE FOR ERROR, OMISSION, INCOMPLETENESS DUE TO USE OF INFORMATION IN WHOLE OR PART, WHEN INFORMATION IS TRANSFERRED.
2. TRANSMISSION OF ANY FILES OR DAMAGE TO THE RECEIVING ELECTRONIC SYSTEM WHEN INFORMATION IS TRANSFERRED.


REF A30102 FOR CONTINUATION

- | | | | |
|-----|--------------|-----------------------------------|----|
| 01. | Oct.07.2019 | Issued for tender | — |
| 02. | Mar.13.2020 | Issued for design coordination #2 | — |
| 03. | Mar.16.2020 | Issued for addendum #2 | — |
| 04. | Mar.16.2020 | Issued for addendum #3 | — |
| 05. | Aug.24.2020 | Issued for addendum #4 | — |
| 06. | Sept.28.2020 | Issued for permit | lg |
| 07. | Oct.20.2020 | Issued for addendum #5 | lg |
| 08. | Nov.23.2020 | Issued for addendum #6 | lg |
| 09. | Dec.14.2020 | Issued for addendum #7 | lg |

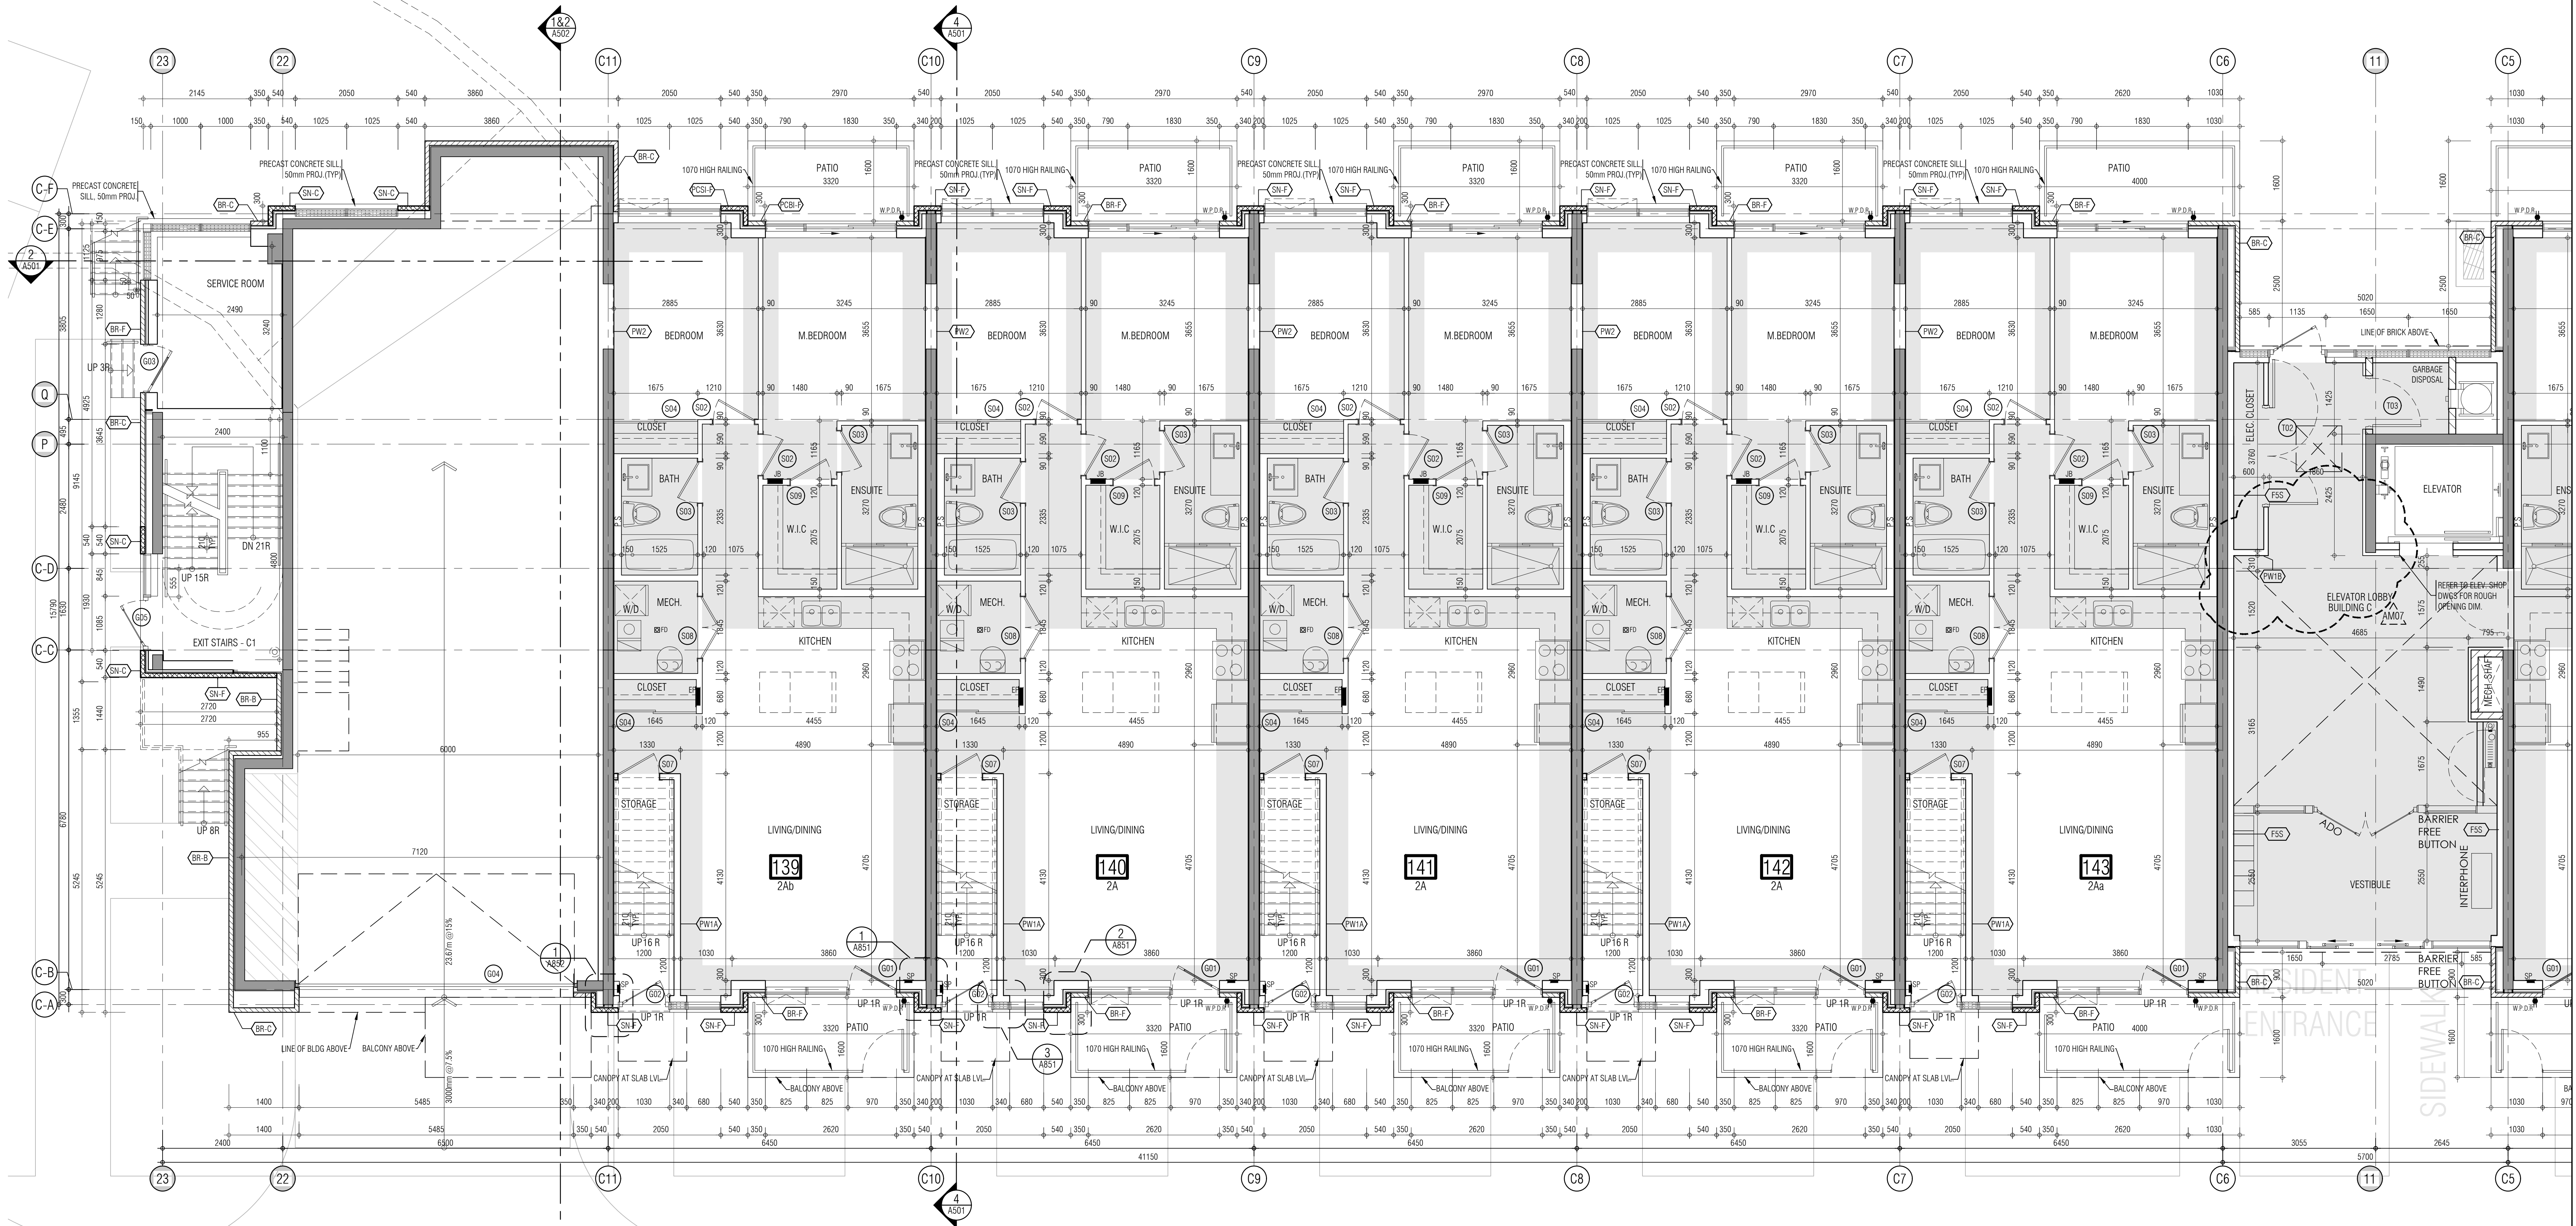

01. SEP 18, 2019 Issued for Addendum 1

Issued for revisions

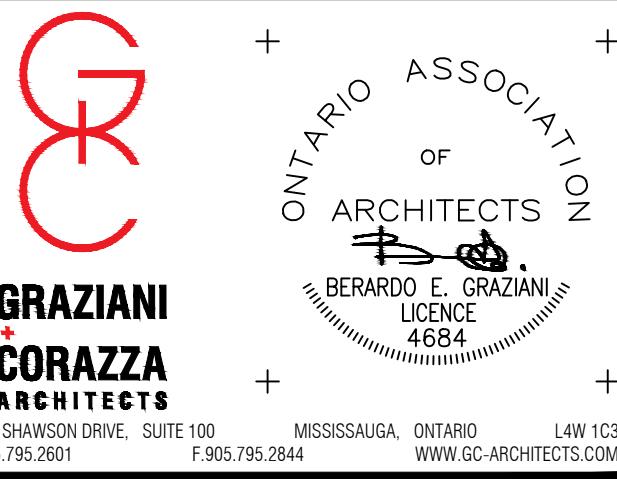




ATTMAY + PALLESCI DRIVE

PROJECT ARCHITECT:	B. GRAZIANI
ASSISTANT DESIGNER:	R. LINCOLN
DRAWN BY:	G. C.F. / M.B.
CHECKED BY:	D. BIASI / G. COLANGELO
PLANT DATE:	DEC.13.2020
JOB #:	1331.15

GROUND FLOOR PLAN
BUILDING C (PARTIAL PLAN)




1:50

A-301.c1

TITLE BLOCK SIZE: 915 x 1200

KEY PLAN

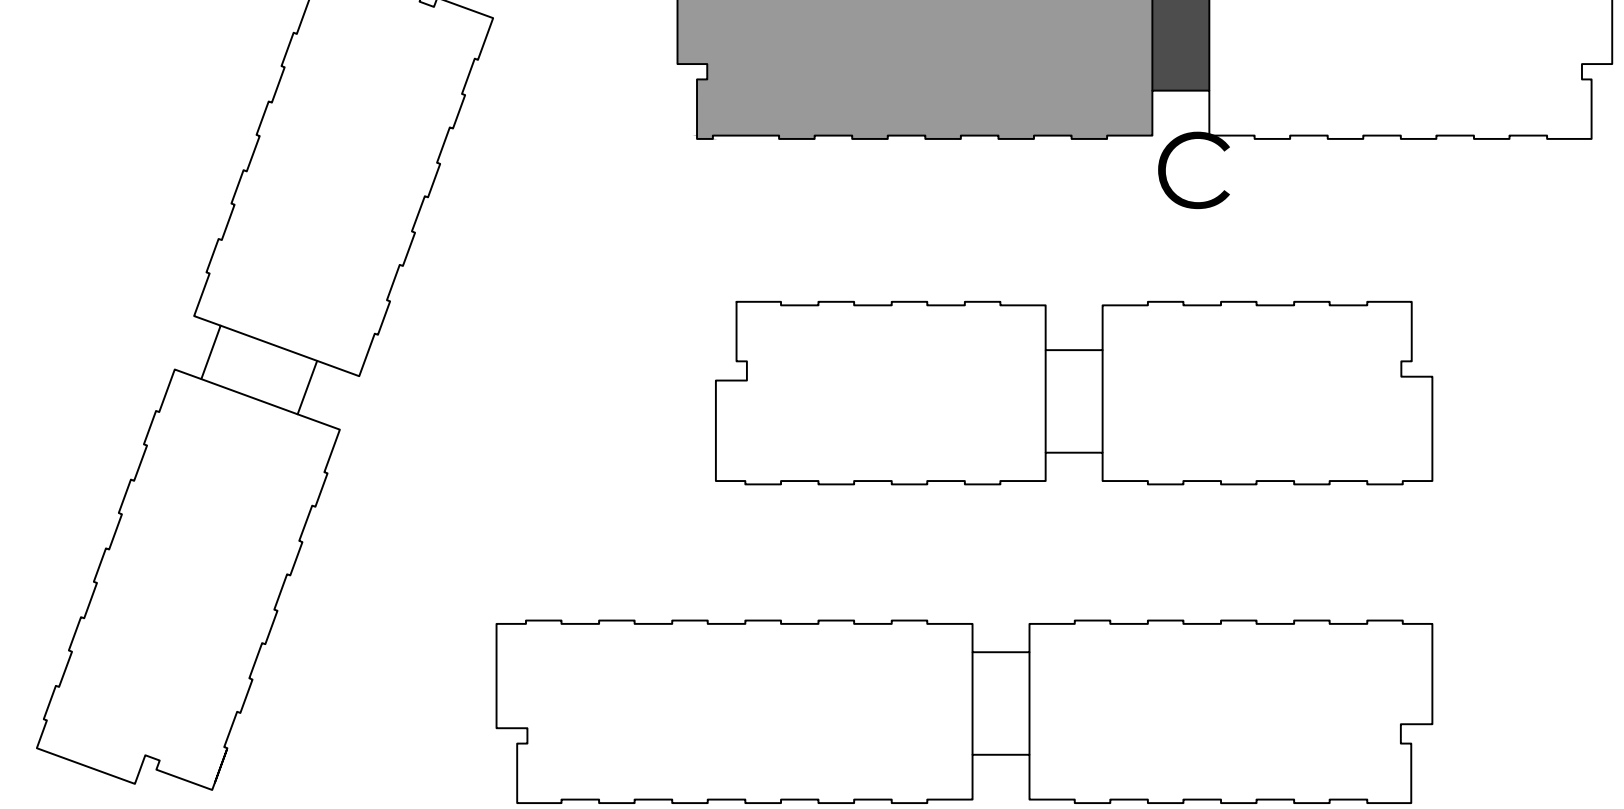

THIS DRAWING IS NOT TO BE SCALED. ALL ARCHITECTURAL SYMBOLS INDICATED ON THIS DRAWING ARE GRAPHIC REPRESENTATIONS ONLY.

CONDITIONS FOR ELECTRONIC INFORMATION TRANSFER:

ELECTRONIC INFORMATION IS SUPPLIED TO THE OTHER ASSOCIATED FIRMS TO ASSIST THEM IN THE EXECUTION OF THEIR WORK/REVIEW. THE RECIPIENT FIRMS MUST EXTEND THE SAME LEVEL OF CAREFULNESS/RELIANCE OF THE INFORMATION IN RESPECT TO THEIR PARTICULAR RESPONSIBILITY.

GRADWOLD-CORAZZA ARCHITECTS INC. SHALL NOT BE RESPONSIBLE FOR:

1. ELECTRONIC CHANGES/INCOMPLETENESS DUE TO LOSS OF INFORMATION IN WHOLE OR PART WHEN INFORMATION IS TRANSFERRED.
2. TRANSMISSION OF ANY VIRUS OR DAMAGE TO THE RECEIVING ELECTRONIC SYSTEM WHEN INFORMATION IS TRANSFERRED.

RESIDENTIAL 			
BRAMPTON ATTMAY & PALLESCH DRIVE		ONTARIO	
PROJECT ARCHITECT:	B. GRAZIANI		
ASSISTANT DESIGNER:	R. LINCOLN		
DRAWN BY:	G. C.F. / M.B.		
CHECKED BY:	D. BIASI; G. COLANGELO		
PLUT DATE:	DEC. 13/2020		
1038.15	1331.15		
GROUND FLOOR PLAN BUILDING C (PARTIAL PLAN)			
		1:50 A-301c2	
FILE BLOCK SIZE: 915 x 1200			










KEY PLAN


GROUND FLOOR PLAN
BUILDING C (PARTIAL PLAN)

 1:50 A-301c2

TITLEBLOCK SIZE: 915 x 1200

THIS DRAWING IS NOT TO BE SCALED. ALL ARCHITECTURAL SYMBOLS INDICATED ON THIS DRAWING ARE GRAPHIC REPRESENTATIONS ONLY.

CONDITIONS FOR ELECTRONIC INFORMATION TRANSFER:

ELECTRONIC INFORMATION IS SUPPLIED TO THE OTHER ASSOCIATED FIRMS TO ASSIST THEM IN THE EXECUTION OF THEIR WORK. HOWEVER, THE RECIPIENT FIRMS MUST DETERMINE THE COMPLETENESS/APPROPRIATENESS/RELEVANCE OF THE INFORMATION IN RESPECT TO THEIR PARTICULAR RESPONSIBILITY.

GRADNIN+KOROZA ARCHITECTS INC. SHALL NOT BE RESPONSIBLE FOR:

1. ERRORS, OMISSIONS, INCOMPLETENESS DUE TO LOSS OF INFORMATION IN WHOLE OR PART WHEN INFORMATION IS TRANSFERRED.
2. TRANSMISSION OF ANY DATA OR QUALITY OF RECEIVING ELECTRONIC SYSTEM WHEN INFORMATION IS TRANSFERRED.


01. SEP 18, 2019 Issued for Adendum 1
issued for revisions



ATTMAR + PALLESCHI DRIVE

**GROUND FLOOR PLAN
BUILDING D (PARTIAL PLAN)**

ATTMAR + PALLESCHI DRIVE

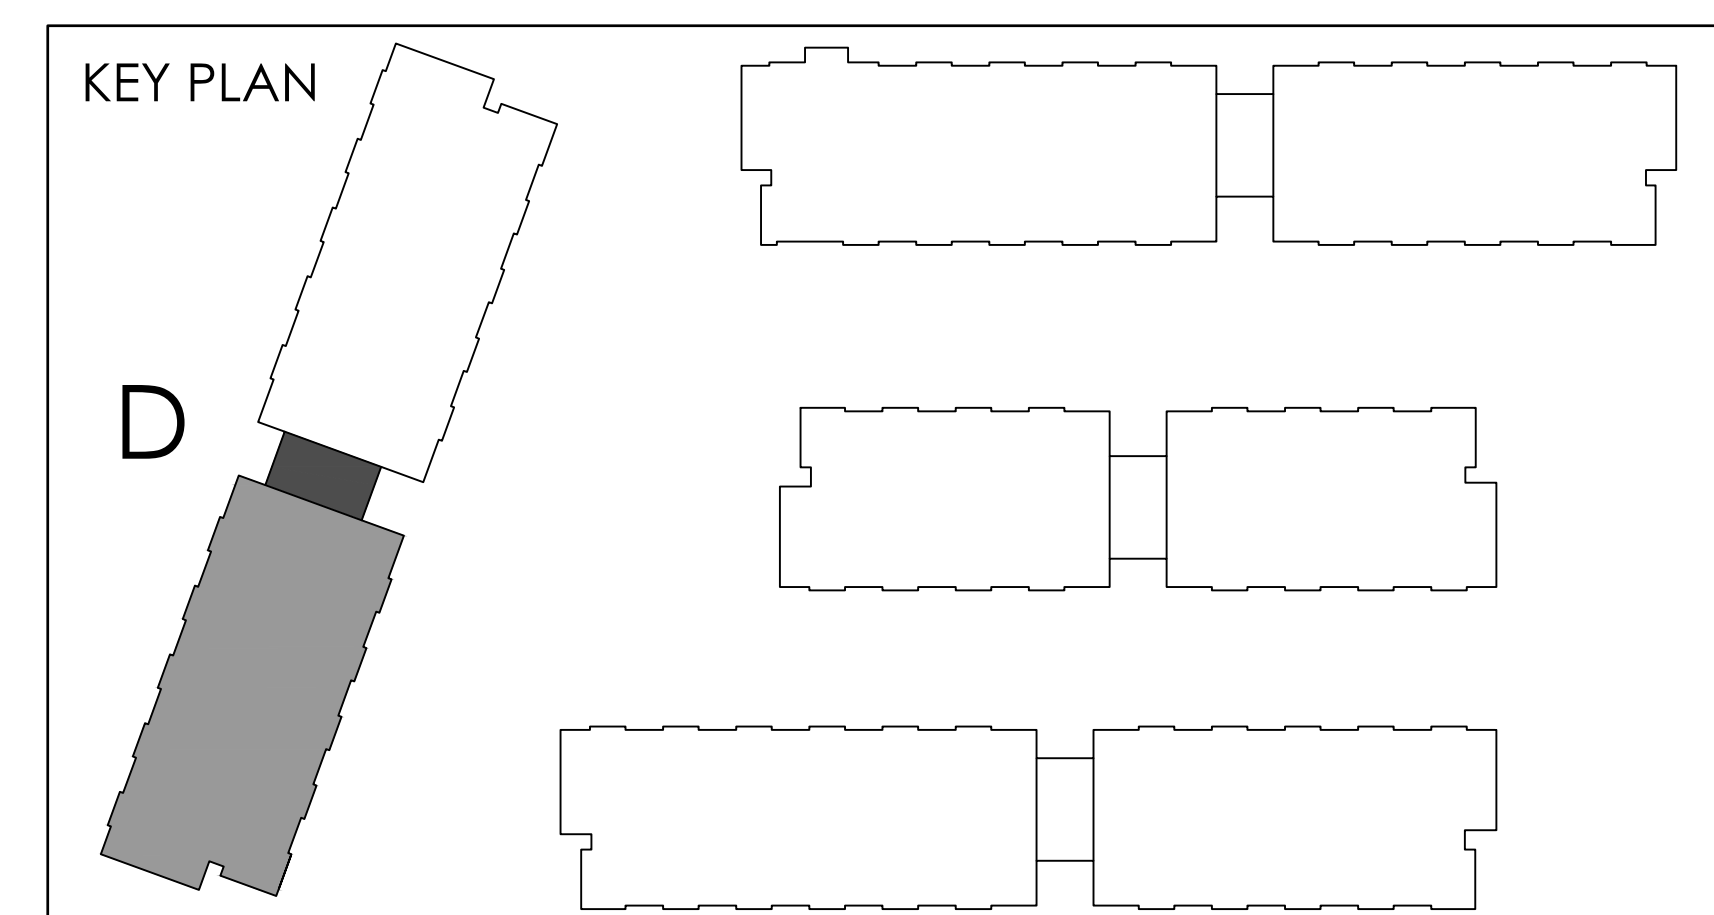

THIS DRAWING, AS AN INSTRUMENT OF SERVICE, IS PROVIDED BY AND IS THE PROPERTY OF GRAZIANI-CORAZZI ARCHITECTS INC. THE CONTRACTOR MUST VERIFY AND ACCEPT RESPONSIBILITY FOR ALL DIMENSIONS AND COORDINATING WITH ALL OTHER WORK. GRAZIANI-CORAZZI ARCHITECTS INC. IS NOT RESPONSIBLE FOR THE ACCURACY OF SURVEY, STRUCTURAL, MECHANICAL, ELECTRICAL, AND OTHER ENGINEERING INFORMATION SHOWN ON THIS DRAWING. REFER TO THE APPROPRIATE ENGINEERING DRAWINGS BEFORE PROCEEDING WITH THE WORK. CONSTRUCTION MUST COMPLY IN ALL APPLICABLE CODES AND REQUIREMENTS OF THE AUTHORITIES HAVING JURISDICTION. UNLESS OTHERWISE NOTED, NO MODIFICATION HAS BEEN MADE TO ANY INFORMATION IN THIS OFFICE IN RELATION TO THE ENVIRONMENTAL CONDITION OF THIS SITE.

THIS DRAWING IS NOT TO BE SCALED. ALL ARCHITECTURAL SYMBOLS INDICATED ON THIS DRAWING ARE GRAPHIC REPRESENTATIONS ONLY.

CONDITIONS FOR ELECTRONIC INFORMATION TRANSFER:

ELECTRONIC INFORMATION IS SUPPLIED TO THE OTHER ASSOCIATED FIRMS TO ASSIST THEM IN THE EXECUTION OF THEIR WORK. REVIEW THE RECEIVED FIRMS MUST DETERMINE THE COMPLETENESS, APPROPRIATENESS, RELIANCE OF THE INFORMATION IN RESPECT TO THEIR PARTICULAR RESPONSIBILITY.

GRAZIANI-CORAZZI ARCHITECTS INC. SHALL NOT BE RESPONSIBLE FOR:


1. ERRORS, OMISSIONS, INCOMPLETENESS DUE TO USE OF INFORMATION IN WHOLE OR PART, WHEN INFORMATION IS TRANSFERRED.

2. TRANSMISSION OF ANY VIRUS OR DAMAGE TO THE RECEIVING ELECTRONIC SYSTEM WHEN INFORMATION IS TRANSFERRED.

01. Oct.07.2019 issued for tender
02. Mar.13.2020 issued for design coordination #2
03. Mar.16.2020 issued for addendum #2
04. Mar.16.2020 issued for addendum #3
05. Aug.24.2020 issued for addendum #4
06. Sept.28.2020 issued for permit
07. Oct.20.2020 issued for addendum #5
08. Nov.23.2020 issued for addendum #6
09. Dec.14.2020 issued for addendum #7

01. SEP 18, 2019 Issued for Addendum 1

Issued for revisions

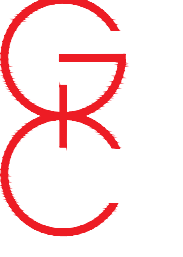**GRAZIANI
CORAZZI**
ARCHITECTS


ONTARIO ASSOCIATION
OF
ARCHITECTS


RESIDENTIAL

BRAMPTON ATTAR + PALLESCHI DRIVE ONTARIO

PROJECT ARCHITECT: B. GRAZIANI

ASSISTANT DESIGNER: R. LINCOLN


DRAWN BY: G. C./F./M.B.

CHECKED BY: D. BIASI/G. COLANGELO

PLANT DATE: DEC.13.2020

JOB #: 1331.15

**GROUND FLOOR PLAN
BUILDING D (PARTIAL PLAN)**

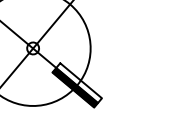 1:50 **A-301d2**

TITLE BLOCK SIZE: 915 x 1200

REF.A301a1 FOR CONTINUATION



THIS DRAWING IS AN INSTRUMENT OF SERVICE, IS PROVIDED BY AND IS THE PROPERTY OF GRAZIANI-CORAZZA ARCHITECTS INC. THE CONTRACTOR MUST VERIFY AND ACCEPT RESPONSIBILITY FOR ALL DIMENSIONS AND COORDINATING ON SITE AND MUST NOTIFY GRAZIANI-CORAZZA ARCHITECTS INC. OF ANY VARIATIONS FROM THE SUPPLIED INFORMATION. GRAZIANI-CORAZZA ARCHITECTS INC. IS NOT RESPONSIBLE FOR THE ACCURACY OF SURVEY, STRUCTURAL, MECHANICAL, ELECTRICAL, AND OTHER ENGINEERING INFORMATION SHOWN ON THIS DRAWING. REFER TO THE APPROPRIATE ENGINEERING DRAWINGS BEFORE PROCEEDING WITH THE WORK. CONSTRUCTION MUST CONFORM TO ALL APPLICABLE CODES AND REQUIREMENTS OF THE AUTHORITIES HAVING JURISDICTION. UNLESS OTHERWISE NOTED, NO MODIFICATION HAS BEEN IDENTIFIED OR REPORTED BY THIS OFFICE IN RELATION TO THE ENVIRONMENTAL CONDITION OF THIS SITE.

THIS DRAWING IS NOT TO BE SCALED. ALL ARCHITECTURAL SYMBOLS INDICATED ON THIS DRAWING ARE GRAPHIC REPRESENTATIONS ONLY.

CONDITIONS FOR ELECTRONIC INFORMATION TRANSFER:

ELECTRONIC INFORMATION IS SUPPLIED TO THE OTHER ASSOCIATED FIRMS TO ASSIST THEM IN THE EXECUTION OF THEIR WORK. REVIEW THE RECEIVED FIRMS MUST DETERMINE THE COMPLETENESS, APPROPRIATENESS, RELIANCE OF THE INFORMATION IN RESPECT TO THEIR PARTICULAR RESPONSIBILITY.

GRAZIANI-CORAZZA ARCHITECTS INC. SHALL NOT BE RESPONSIBLE FOR ERROR, OMISSIONS, INCOMPLETENESS DUE TO USE OF INFORMATION IN WHOLE OR PART, WHEN INFORMATION IS TRANSMITTED.

1. TRANSMISSION OF ANY VIEWS OR DAMAGE TO THE RECEIVING ELECTRONIC SYSTEM WHEN INFORMATION IS TRANSMITTED.

01. Oct.07.2019 issued for tender
02. Mar.13.2020 issued for design coordination #2
03. Mar.16.2020 issued for addendum #2
04. Mar.16.2020 issued for addendum #3
05. Aug.24.2020 issued for addendum #4
06. Sept.28.2020 issued for permit
07. Oct.20.2020 issued for addendum #5
08. Nov.23.2020 issued for addendum #6
09. Dec.14.2020 issued for addendum #7

01. SEP.18.2019 issued for Addendum 1

issued for revisions



1333 SHARONVILLE DRIVE, SUITE 100 MISSISSAUGA, ONTARIO L4W 1C3
905.760.2901 P:905.760.2900 WWW.GC-ARCHITECTS.COM



ATTMAR + PALLESCHI DRIVE

BRAMPTON ONTARIO

PROJECT ARCHITECT: B. GRAZIANI

ASSISTANT DESIGNER: R. LINCOLN


DRAWN BY: G. C./F. C./M. B.

CHECKED BY: D. BIASI/G. COLANGELO

PLANT DATE: DEC.13.2020

JOB # 1331.15

SECOND FLOOR OVERALL PLAN

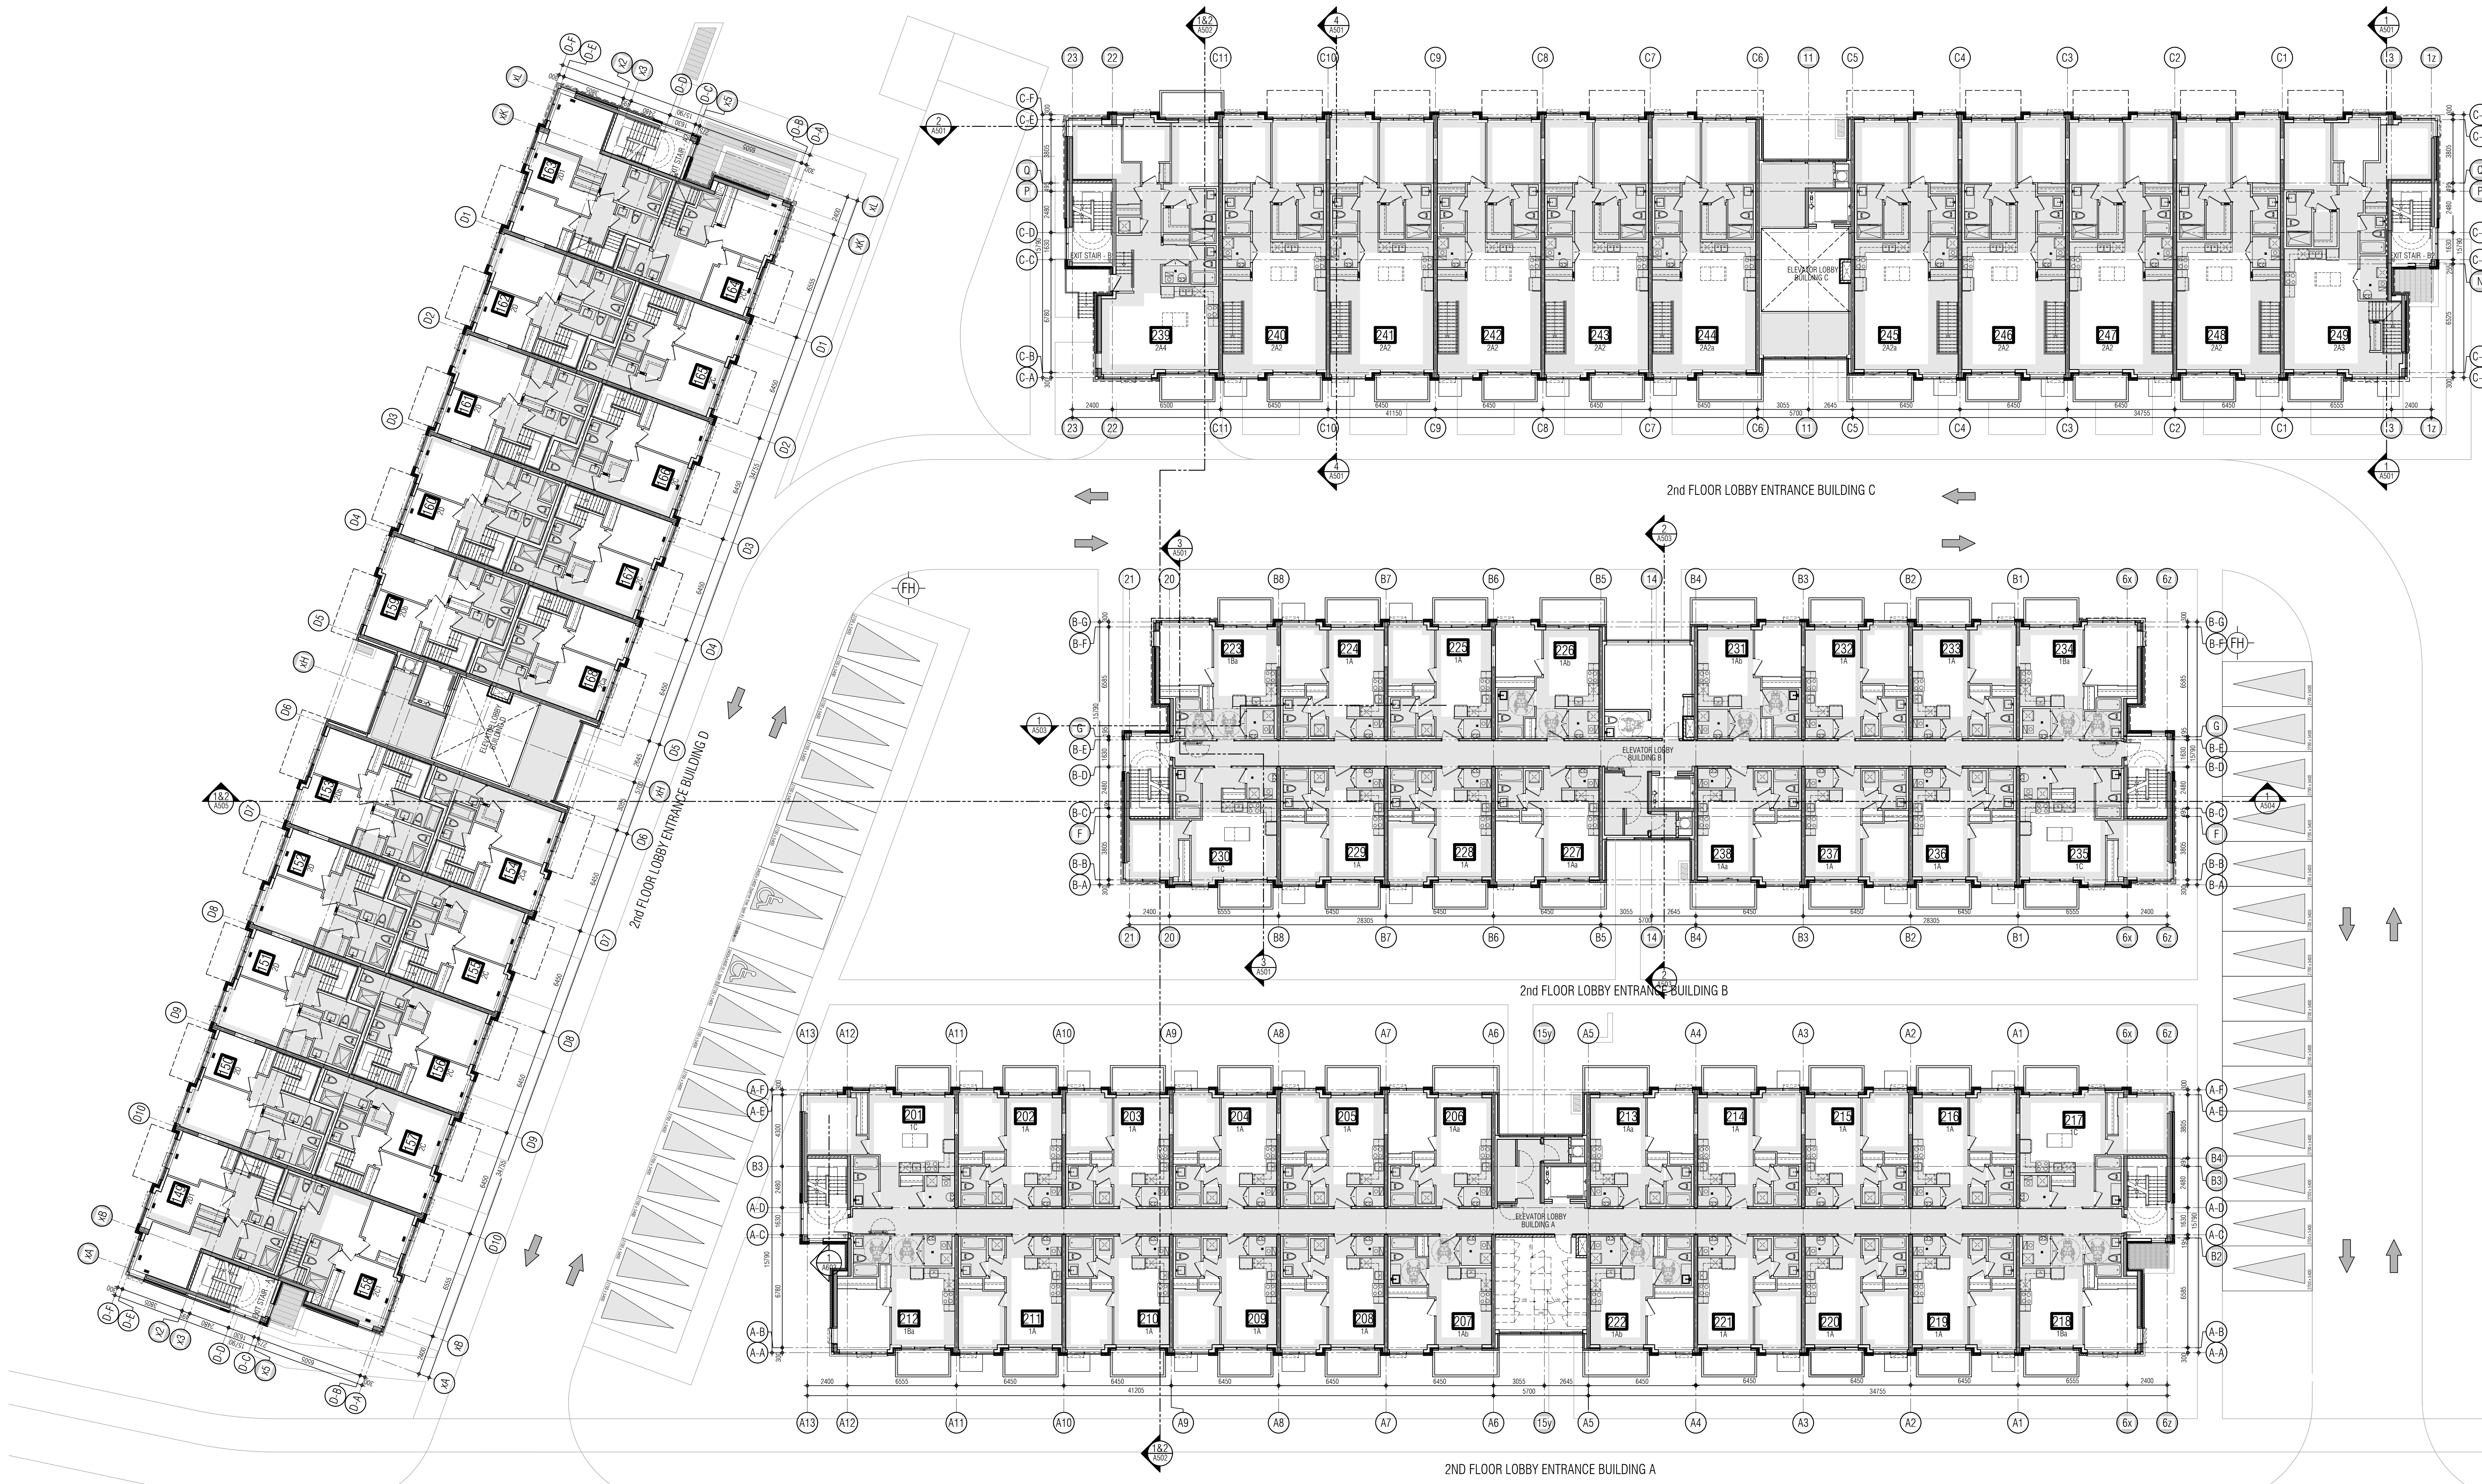

THIS DRAWING, AS AN INSTRUMENT OF SERVICE, IS PROVIDED BY AND IS THE PROPERTY OF GRAZIANI-CORAZZA ARCHITECTS INC. THE CONTRACTOR MUST VERIFY AND ACCEPT RESPONSIBILITY FOR ALL DIMENSIONS AND COORDINATIONS AND MUST NOTIFY GRAZIANI-CORAZZA ARCHITECTS INC. OF ANY DISCREPANCIES FROM THE SUPPLIED INFORMATION. GRAZIANI-CORAZZA ARCHITECTS INC. IS NOT RESPONSIBLE FOR THE ACCURACY OF SURVEY, STRUCTURAL, MECHANICAL, ELECTRICAL, AND OTHER ENGINEERING INFORMATION SHOWN ON THIS DRAWING. REFER TO THE APPROPRIATE ENGINEERING DRAWINGS BEFORE PROCEEDING WITH THE WORK. CONSTRUCTION MUST COMPLY TO ALL APPLICABLE CODES AND REQUIREMENTS OF THE AUTHORITIES HAVING JURISDICTION. UNLESS OTHERWISE NOTED, NO MODIFICATION HAS BEEN MADE TO ANY REPORTED OR BY THIS OFFICE IN RELATION TO THE ENVIRONMENTAL CONDITION OF THIS SITE.

THIS DRAWING IS NOT TO BE SCALED. ALL ARCHITECTURAL SYMBOLS INDICATED ON THIS DRAWING ARE GRAPHIC REPRESENTATIONS ONLY.

CONDITIONS FOR ELECTRONIC INFORMATION TRANSFER

ELECTRONIC INFORMATION IS SUPPLIED TO THE OTHER ASSOCIATED FIRMS TO ASSIST THEM IN THE EXECUTION OF THEIR WORK. REVIEW THE RECEIVED FIRMS MUST DETERMINE THE COMPLETENESS, APPROPRIATENESS, RELIANCE OF THE INFORMATION IN RESPECT TO THEIR PARTICULAR RESPONSIBILITY.

GRAZIANI-CORAZZA ARCHITECTS INC. SHALL NOT BE RESPONSIBLE FOR ERRORS, OMISSIONS, INCOMPLETENESS DUE TO LOSS OF INFORMATION IN WHOLE OR PART, WHEN INFORMATION IS TRANSFERRED.

TRANSMISSION OF ANY FILES OR DAMAGE TO THE RECEIVING ELECTRONIC SYSTEM WHEN INFORMATION IS TRANSFERRED.

REF A302a2 FOR CONTINUATION

01. Oct.07.2019 Issued for tender
02. Mar.13.2020 Issued for design coordination #2
03. Mar.16.2020 Issued for addendum #2
04. Mar.16.2020 Issued for addendum #3
05. Aug.24.2020 Issued for addendum #4
06. Sept.28.2020 Issued for permit
07. Oct.20.2020 Issued for addendum #5
08. Nov.23.2020 Issued for addendum #6
09. Dec.14.2020 Issued for addendum #7



01. SEP 18, 2019 Issued for Addendum 1

Issued for revisions



ATTMIR + PALLESCHI DRIVE

BRAMPTON ONTARIO

PROJECT ARCHITECT: B. GRAZIANI

ASSISTANT DESIGNER: R. LINCOLN

DRAWN BY: G. C. F. / M. B.

CHECKED BY: D. BIASE / G. COLANGELO

PLANT DATE: DEC. 13. 2020

JOB # 1331.15

SECOND FLOOR PLAN
BUILDING A (PARTIAL PLAN)

1:50 A-302a1

TITLE BLOCK SIZE: 915 x 1200

THIS DRAWING IS NOT TO BE SCALED. ALL ARCHITECTURAL SYMBOLS INDICATED ON THIS DRAWING ARE GRAPHIC REPRESENTATIONS ONLY.

CONDITIONS FOR ELECTRONIC INFORMATION TRANSFER:

ELECTRONIC INFORMATION IS SUPPLIED TO THE OTHER ASSOCIATED FIRMS TO ASSIST THEM IN THE EXECUTION OF THEIR WORK. REVIEW THE RECIPIENT FIRMS MUST DETERMINE THE ADEQUACY OF THE CAPACITY/RELIANCE OF THE INFORMATION IN RESPECT TO THEIR PARTICULAR RESPONSIBILITY.

GRADWIN+CORAZZA ARCHITECTS INC. SHALL NOT BE RESPONSIBLE FOR:

1. ELECTRONIC CHANGES, INADEQUACIES, LOSS OF LOSS OF INFORMATION IN WHOLE OR PART WHEN INFORMATION IS TRANSFERRED;
2. TRANSMISSION OF ANY VIRUS OR DAMAGE TO THE RECEIVING ELECTRONIC SYSTEM WHEN INFORMATION IS TRANSFERRED.

+ +

**GRAZIANNI
CORAZZA
ARCHITECTS**

+ +

+ +

F. 905.795.3844 M. MISSISSAUGA, ONTARIO L4W 1K3
WWW.GC-ARCHITECTS.COM

RESIDENTIAL

ATTAMAR & PALLESCH DRIVE

ORRAMPION	ONTARIO
------------------	----------------

PROJECT ARCHITECT:	B. GRAZIANI
ASSISTANT DESIGNER:	R. LINCOLN
DRAWN BY:	G. C.F./M.B.
CHECKED BY:	B. BRASE/G. COLANGELO
PLUT DATE:	DEC.13.2020
100% Fee:	1331.15



SECOND FLOOR PLAN

BUILDING A (PARTIAL PLAN)

1:50

A-302a2

FILE/DLOCK SIZE: 915 x 1200

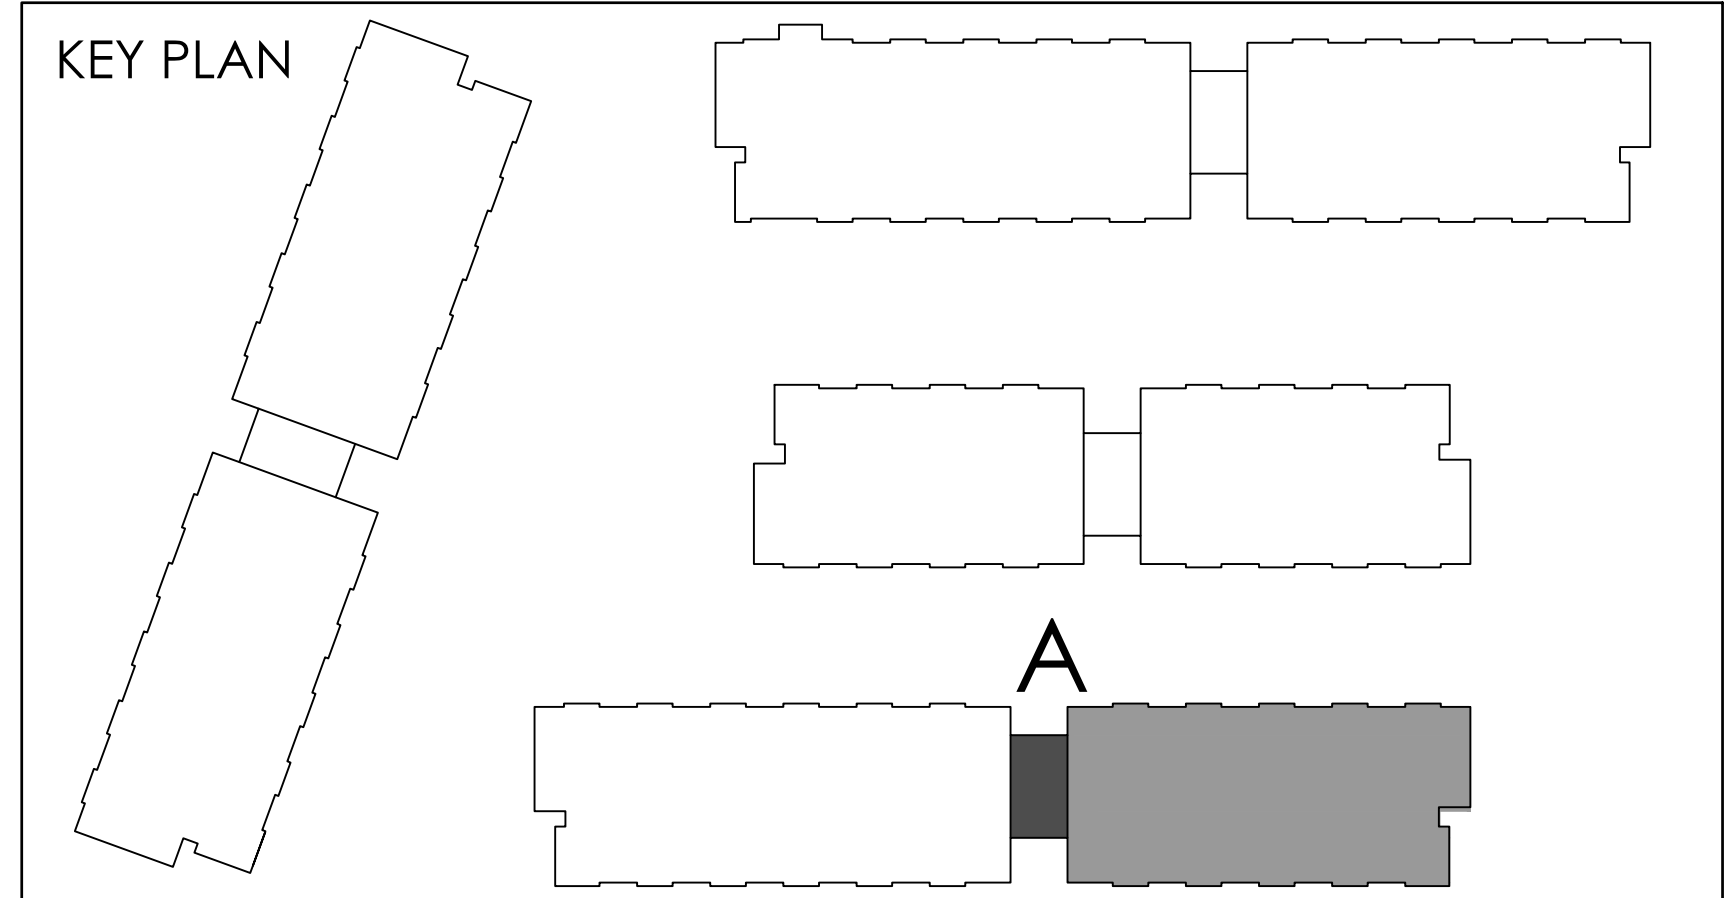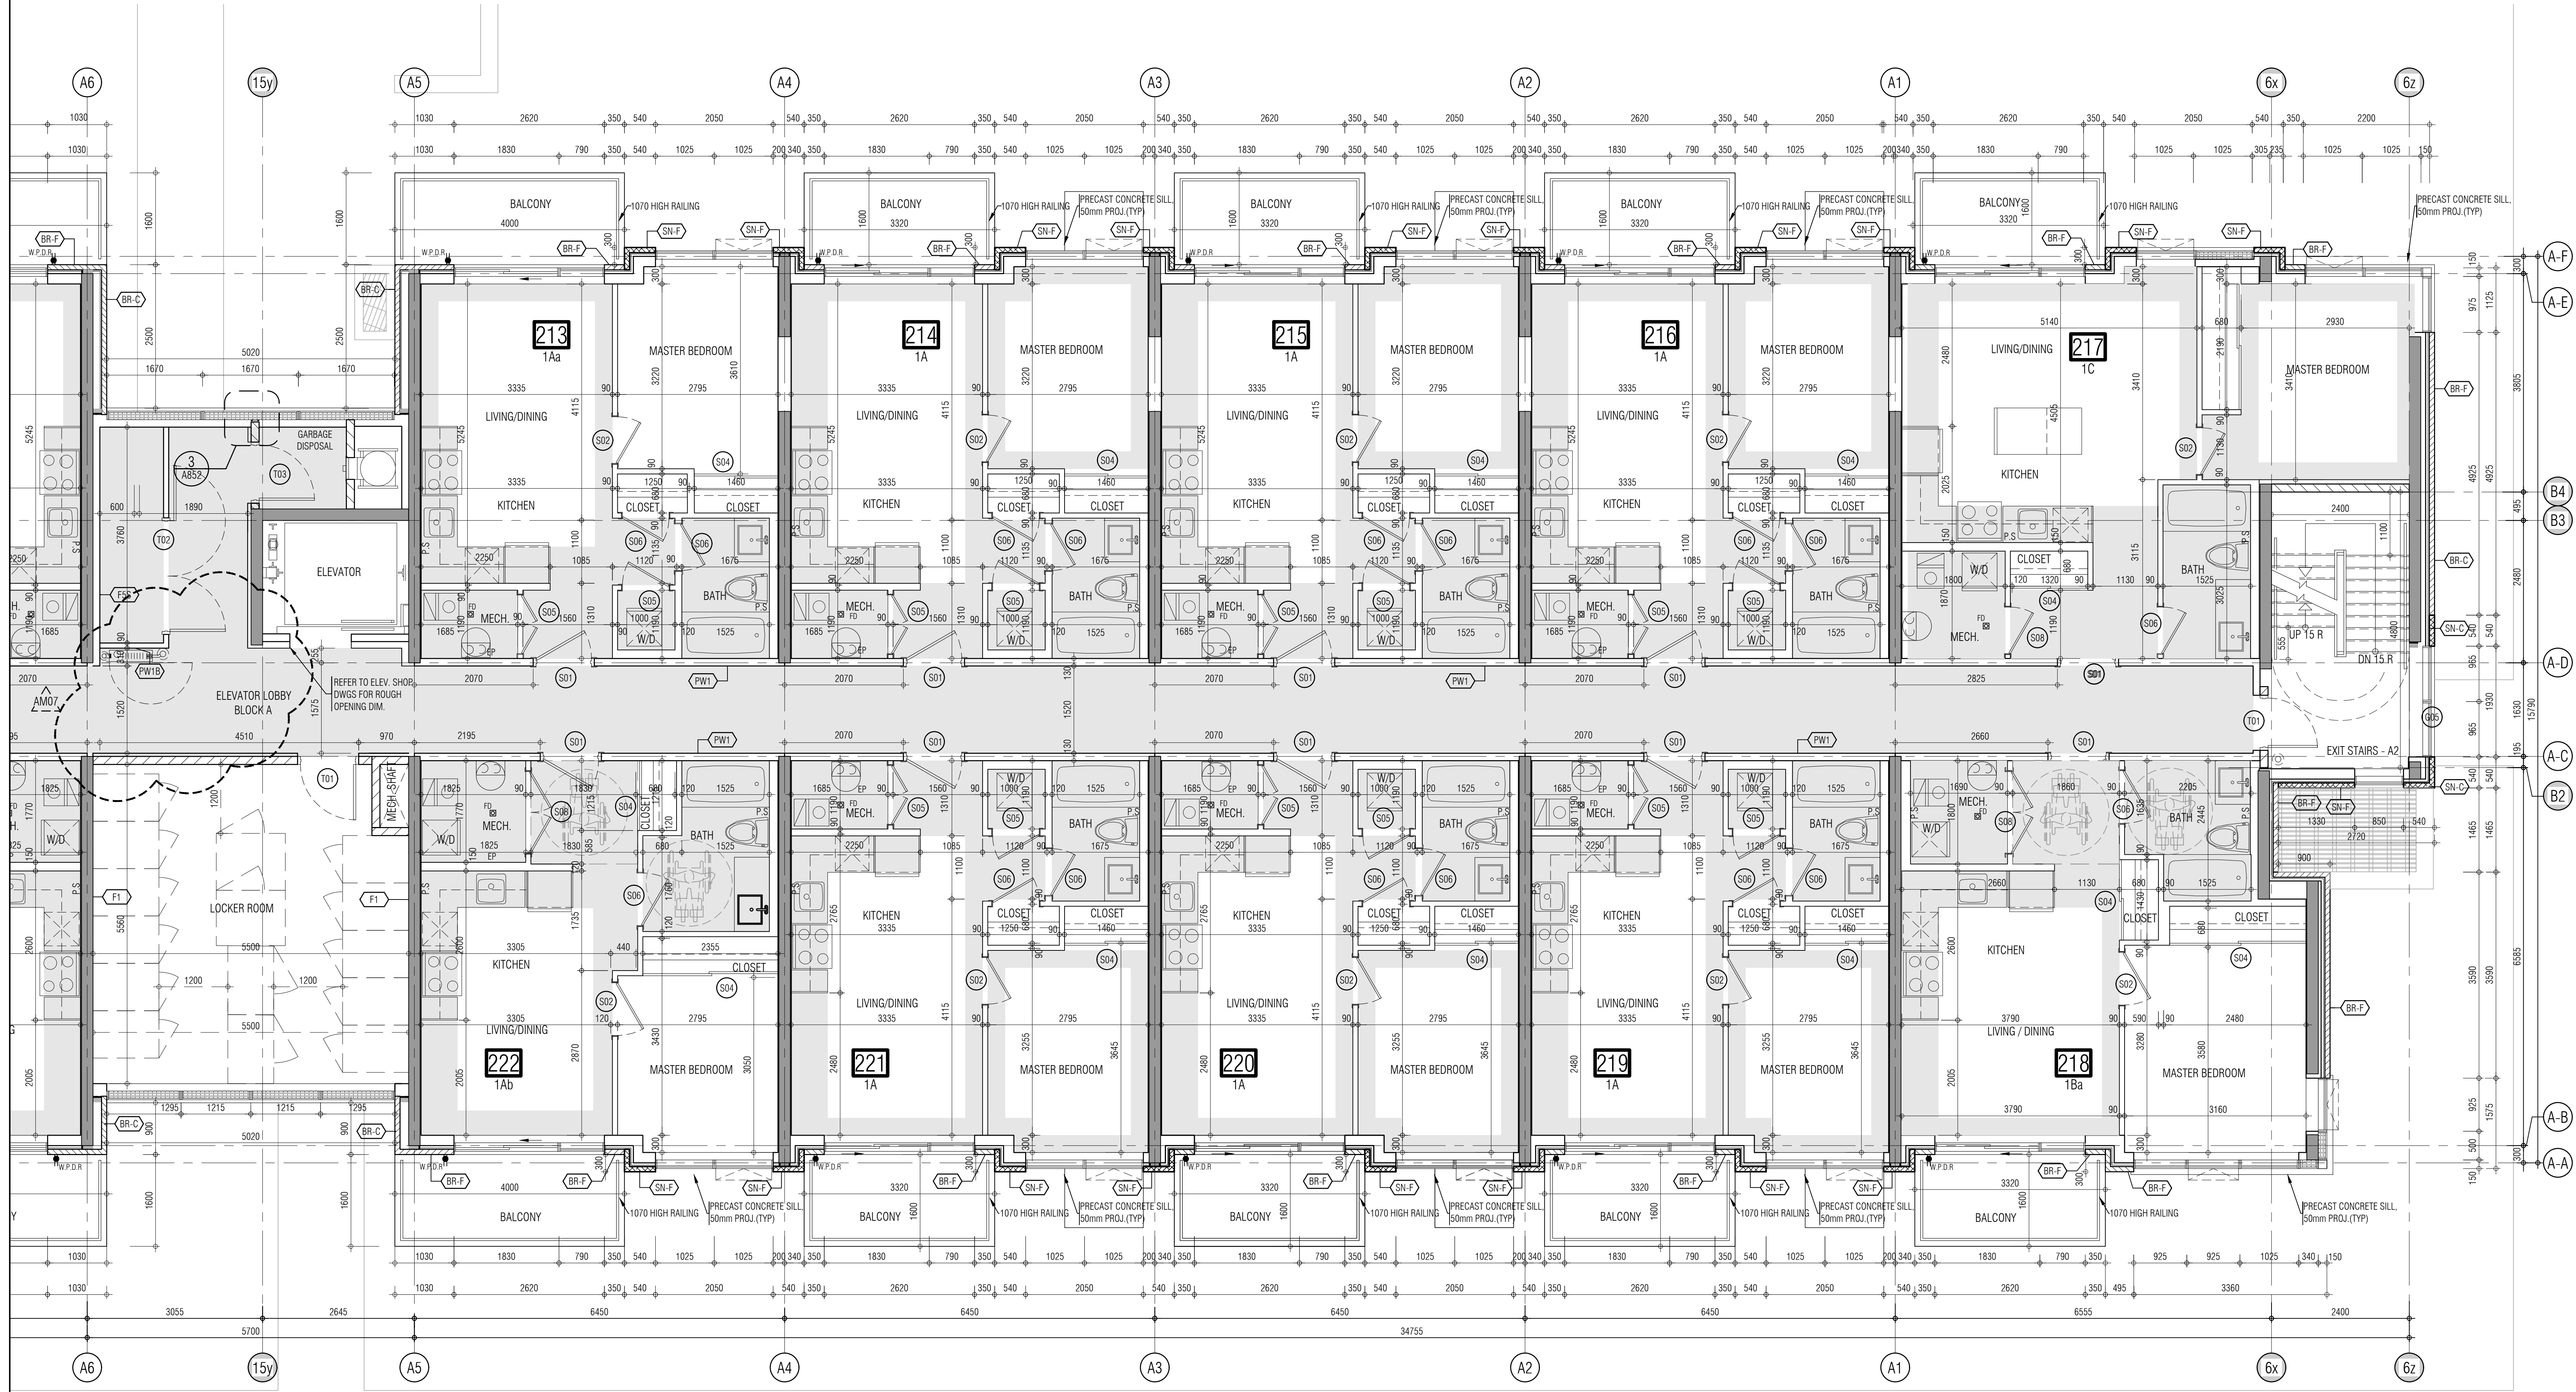

THIS DRAWING, AS AN INSTRUMENT OF SERVICE, IS PROVIDED BY AND IS THE PROPERTY OF GRAZIANI-CORAZZA ARCHITECTS INC. THE CONTRACTOR MUST VERIFY AND ACCEPT RESPONSIBILITY FOR ALL DIMENSIONS AND COORDINATIONS AND MUST NOTIFY GRAZIANI-CORAZZA ARCHITECTS INC. OF ANY DISCREPANCIES FROM THE SUPPLIED INFORMATION. GRAZIANI-CORAZZA ARCHITECTS INC. IS NOT RESPONSIBLE FOR THE ACCURACY OF SURVEY, STRUCTURAL, MECHANICAL, ELECTRICAL, AND OTHER ENGINEERING INFORMATION SHOWN ON THIS DRAWING. REFER TO THE APPROPRIATE ENGINEERING DRAWINGS BEFORE PROCEEDING WITH THE WORK. CONSTRUCTION MUST COMPLY TO ALL APPLICABLE CODES AND REQUIREMENTS OF THE AUTHORITIES HAVING JURISDICTION. UNLESS OTHERWISE NOTED, NO INVESTIGATION HAS BEEN UNDERTAKEN OR REPORTED ON BY THIS OFFICE IN RELATION TO THE ENVIRONMENTAL CONDITION OF THIS SITE.

THIS DRAWING IS NOT TO BE SCALED. ALL ARCHITECTURAL SYMBOLS INDICATED ON THIS DRAWING ARE GRAPHIC REPRESENTATIONS ONLY.

CONDITIONS FOR ELECTRONIC INFORMATION TRANSFER:

ELECTRONIC INFORMATION IS SUPPLIED TO THE OTHER ASSOCIATED FIRMS TO ASSIST THEM IN THE EXECUTION OF THEIR WORK. REVIEW THE RECEIVED FIRMS MUST DETERMINE THE COMPLETENESS, APPROPRIATENESS, RELIANCE OF THE INFORMATION IN RESPECT TO THEIR PARTICULAR RESPONSIBILITY.


GRAZIANI-CORAZZA ARCHITECTS INC. SHALL NOT BE RESPONSIBLE FOR ERRORS, OMISSIONS, INCOMPLETENESS DUE TO USE OF INFORMATION IN WHOLE OR PART, WHEN INFORMATION IS TRANSFERRED.

1. TRANSMISSION OF ANY WRITING OR CHANGE TO THE RECEIVING ELECTRONIC SYSTEM WHEN INFORMATION IS TRANSFERRED.

01. Oct.07.2019 issued for tender
02. Mar.13.2020 issued for design coordination #2
03. Mar.16.2020 issued for addendum #2
04. Mar.16.2020 issued for addendum #3
05. Aug.24.2020 issued for addendum #4
06. Sept.28.2020 issued for permit
07. Oct.20.2020 issued for addendum #5
08. Nov.23.2020 issued for addendum #6
09. Dec.14.2020 issued for addendum #7



REF.A302c2 FOR CONTINUATION

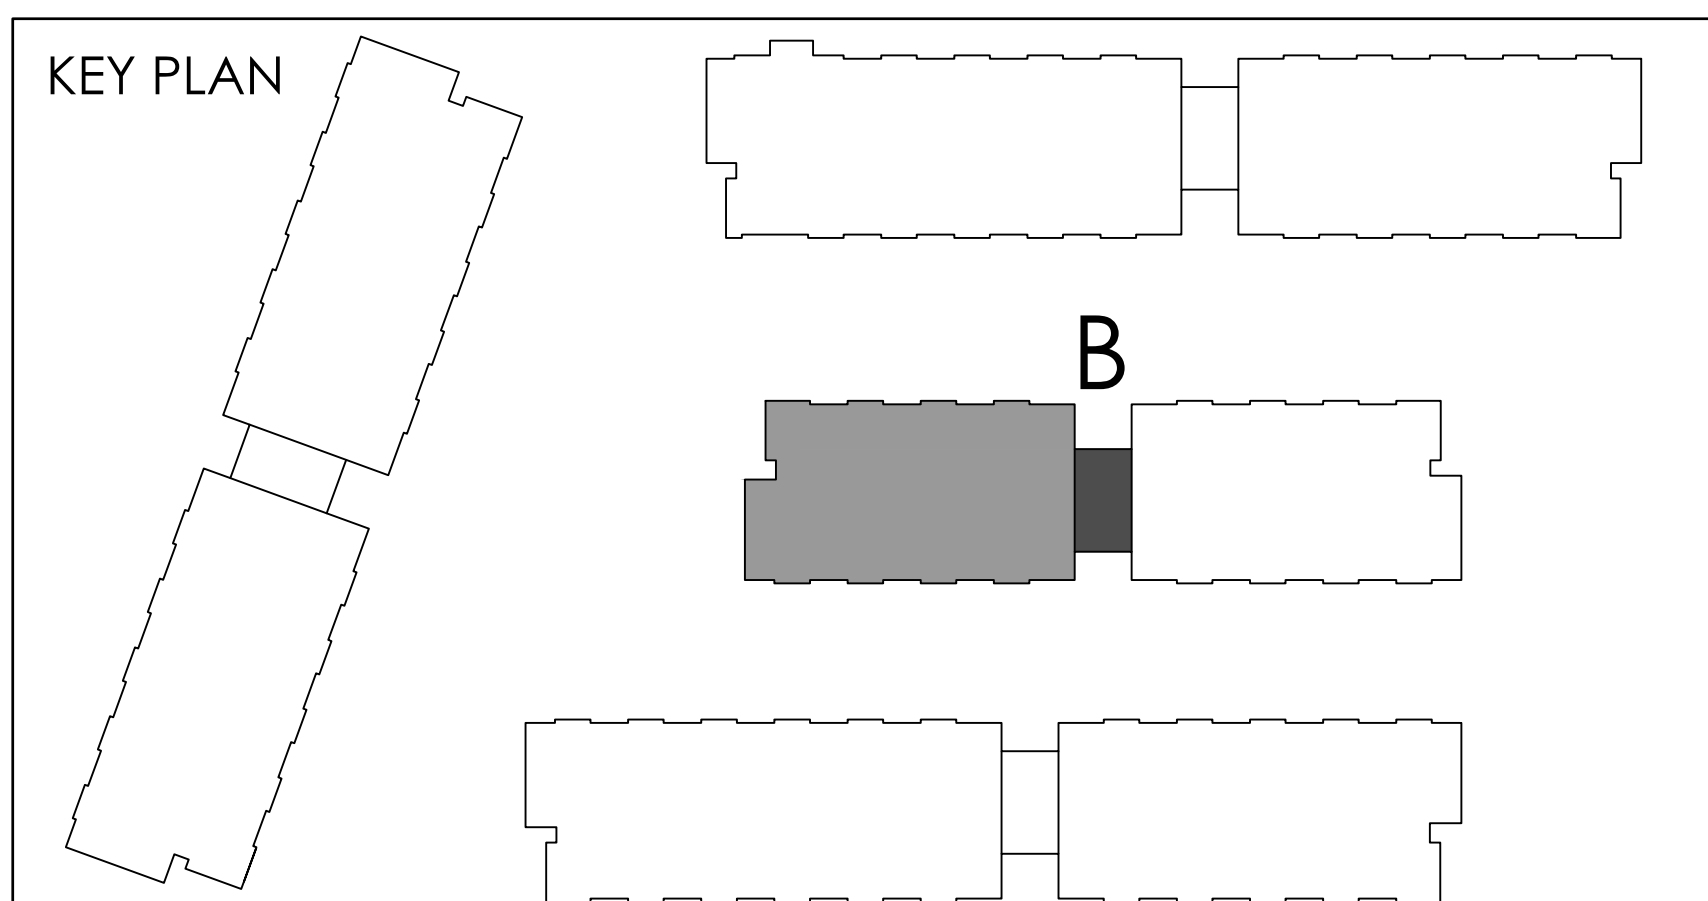

01. SEP 18, 2019 Issued for Addendum 1

Issued for revisions

GRAZIANI CORAZZA ARCHITECTS

1335 SHANNON DRIVE, SUITE 100 MISSISSAUGA, ONTARIO L4W 1C3
905.760.2901 P.905.760.2904 WWW.GC-ARCHITECTS.COM

ONTARIO ASSOCIATION OF ARCHITECTS

BERNARD L. CORAZZA
LICENCE 46584

RESIDENTIAL

ATTMAR + PALLESCI DRIVE

BRAMPTON ONTARIO

PROJECT ARCHITECT: B.GRAZIANI

ASSISTANT DESIGNER: R.LINCOLN

DRAWN BY: G.C./F.C./M.B.

CHECKED BY: D.BIASI/G.COLANGELO

PLLOT DATE: DEC.13.2020

JOB # 1331.15

**SECOND FLOOR PLAN
BUILDING B (PARTIAL PLAN)**

1:50 A-302b1

TITLEBLOCK SIZE: 915 x 1200



01.	Oct.07.2019	issued for tender
02.	Mar.13.2020	issued for design coordination #2
03.	Mar.16.2020	issued for addendum #2
04.	Mar.16.2020	issued for addendum #3
05.	Aug.24.2020	issued for addendum #4
06.	Sept. 28.2020	issued for permit
07.	Oct.20.2020	issued for addendum #5
08.	Nov.23.2020	issued for addendum #6
09.	Dec.14.2020	issued for addendum #7

KEY PLAN



THIS DRAWING IS AN INSTRUMENT OF SERVICE, IT IS PROVIDED BY AND IS THE PROPERTY OF GRAZIANI-CORAZZA ARCHITECTS INC. THE CONTRACTOR MUST VERIFY AND ACCEPT RESPONSIBILITY FOR ALL DIMENSIONS AND COORDINATIONS. GRAZIANI-CORAZZA ARCHITECTS INC. IS NOT RESPONSIBLE FOR THE ACCURACY OF SURVEY, STRUCTURAL, MECHANICAL, ELECTRICAL, AND OTHER ENGINEERING INFORMATION SHOWN ON THIS DRAWING. REFER TO THE APPROPRIATE ENGINEERING DRAWINGS BEFORE PROCEEDING WITH THE WORK. CONSTRUCTION MUST COMPLY TO ALL APPLICABLE CODES AND REQUIREMENTS OF THE AUTHORITIES HAVING JURISDICTION. UNLESS OTHERWISE NOTED, NO INVESTIGATION HAS BEEN MADE/REQUIRED AS REPORTED ON BY THIS OFFICE IN RELATION TO THE ENVIRONMENTAL CONDITION OF THIS SITE.

THIS DRAWING IS NOT TO BE SCALED. ALL ARCHITECTURAL SYMBOLS INDICATED ON THIS DRAWING ARE GRAPHIC REPRESENTATIONS ONLY.


CONDITIONS FOR ELECTRONIC INFORMATION TRANSFER:

ELECTRONIC INFORMATION IS SUPPLIED TO THE OTHER ASSOCIATED FIRMS TO ASSIST THEM IN THE EXECUTION OF THEIR WORK. REVIEW THE RELEVANT FIRMS MUST DETERMINE THE COMPLETENESS, APPROPRIATENESS, RELIANCE OF THE INFORMATION IN RESPECT TO THEIR PARTICULAR RESPONSIBILITY.

1. GRAZIANI-CORAZZA ARCHITECTS INC. SHALL NOT BE RESPONSIBLE FOR ERROR, OMISSION, INCOMPLETENESS DUE TO USE OF INFORMATION IN WHOLE OR PART WHEN INFORMATION IS TRANSFERRED.
2. TRANSMISSION OF ANY FILES OR DAMAGE TO THE RECEIVING ELECTRONIC SYSTEM WHEN INFORMATION IS TRANSFERRED.

REF A302a2 FOR CONTINUATION

- | | | | |
|-----|--------------|-----------------------------------|---|
| 01. | Oct.07.2019 | Issued for tender | — |
| 02. | Mar.13.2020 | Issued for design coordination #2 | — |
| 03. | Mar.16.2020 | Issued for addendum #2 | — |
| 04. | Mar.16.2020 | Issued for addendum #3 | — |
| 05. | Aug.24.2020 | Issued for addendum #4 | — |
| 06. | Sept.28.2020 | Issued for permit | h |
| 07. | Oct.20.2020 | Issued for addendum #5 | h |
| 08. | Nov.23.2020 | Issued for addendum #6 | h |
| 09. | Dec.14.2020 | Issued for addendum #7 | h |

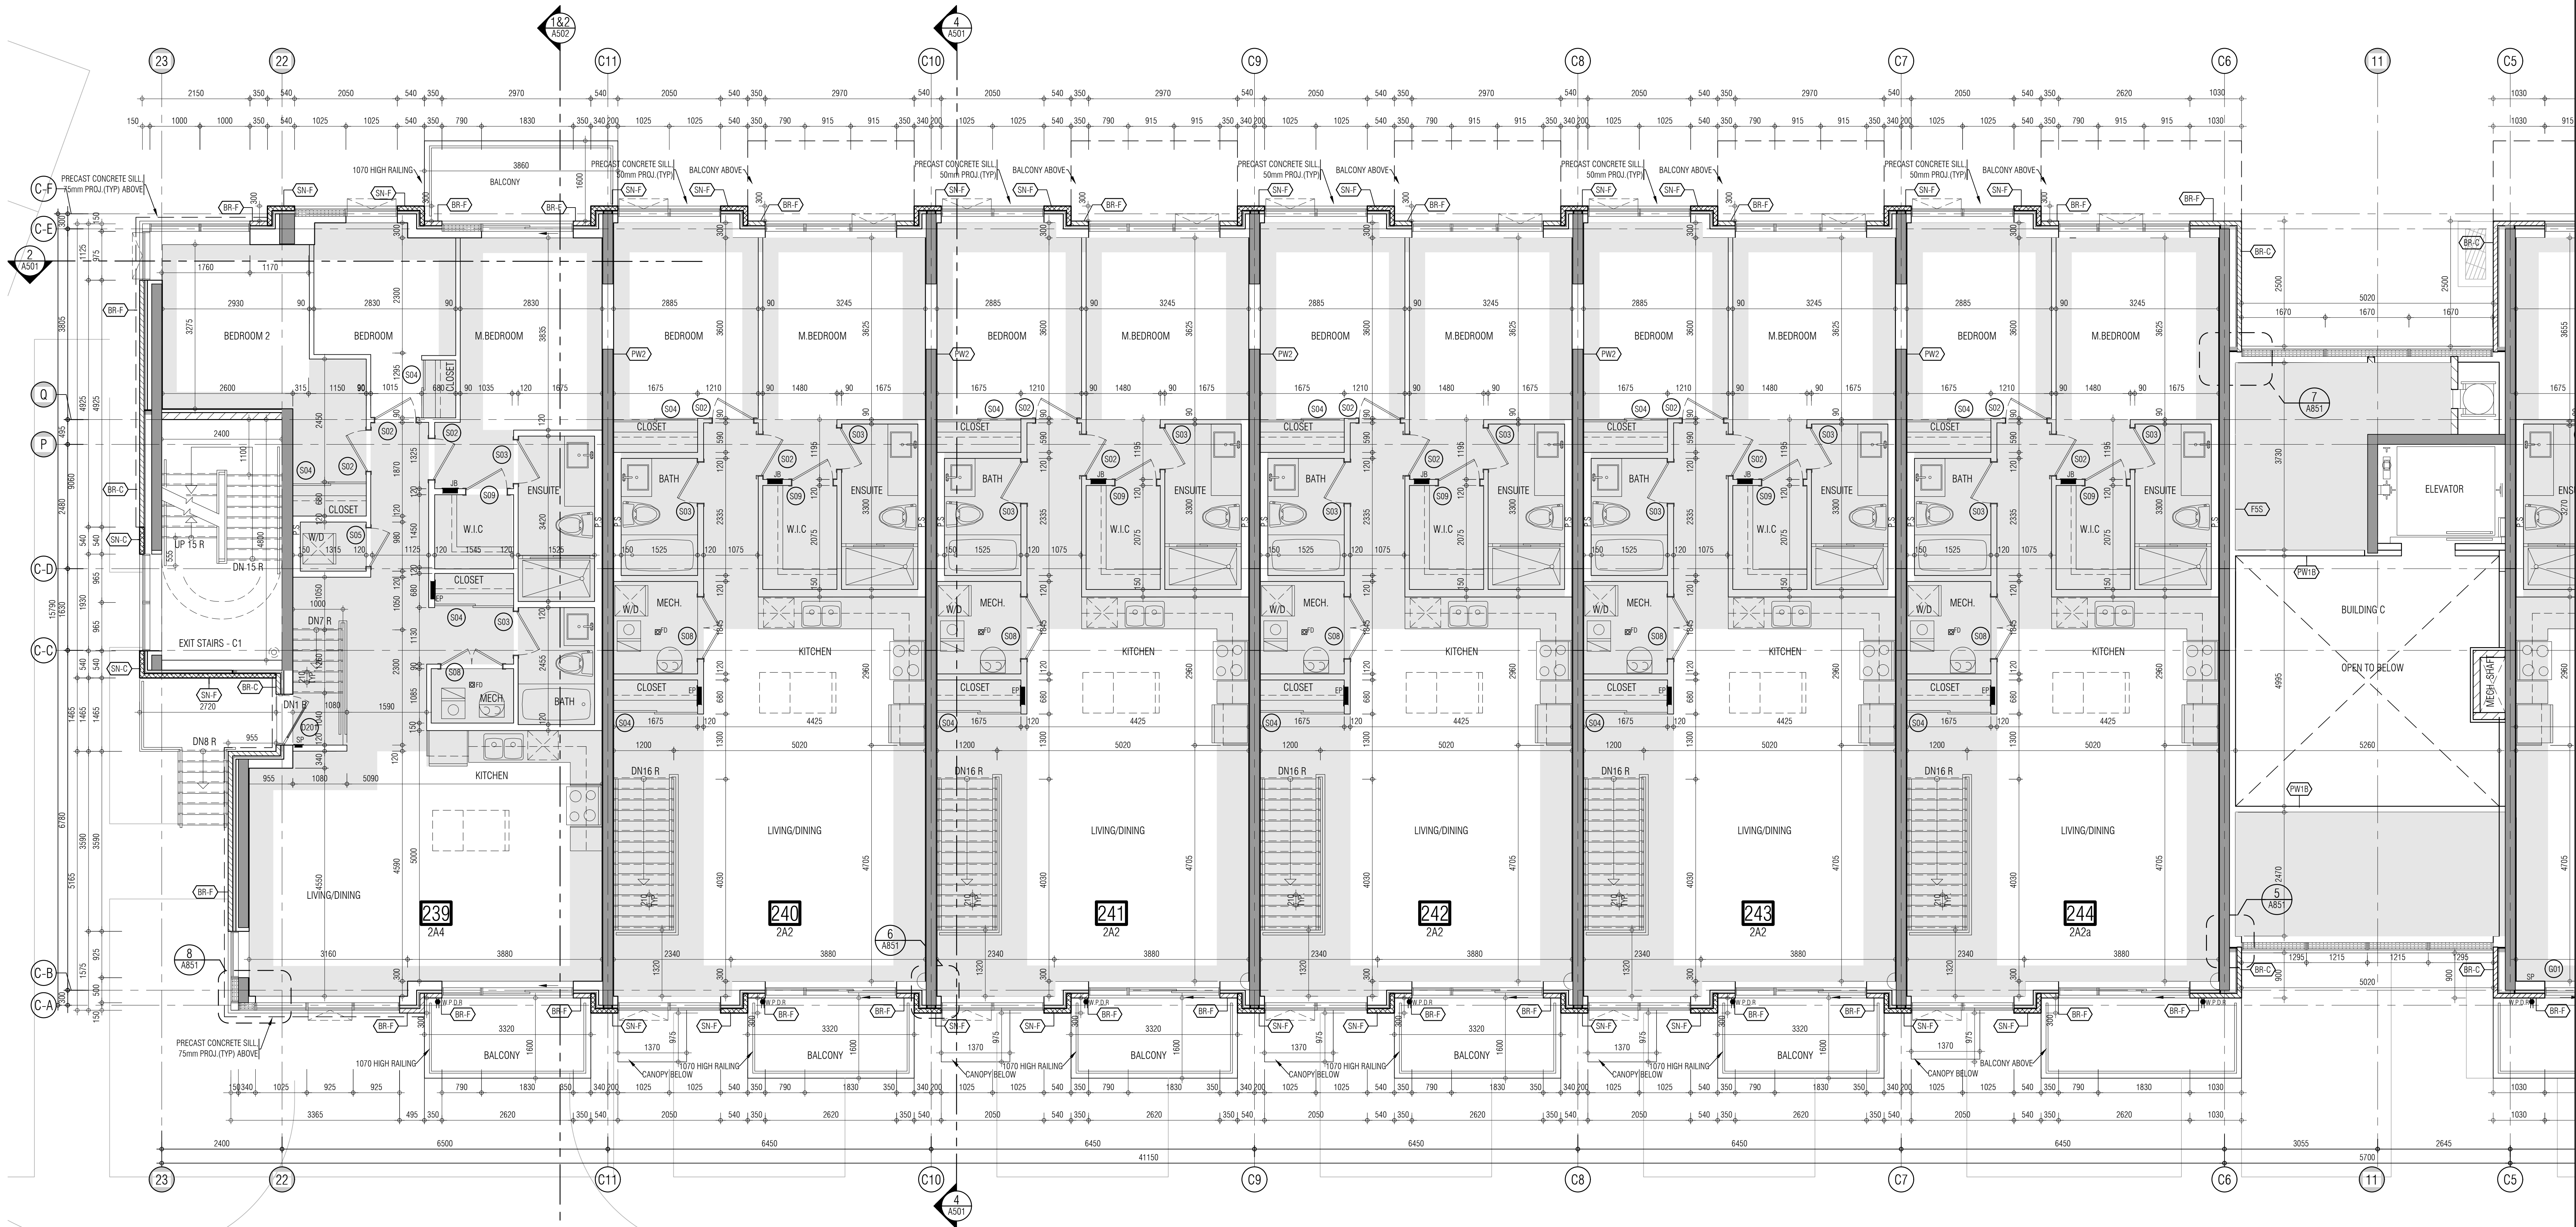

01. SEP.18.2019 Issued for Addendum 1

Issued for revisions



BRAMPTON
PROJECT ARCHITECT: B. GRAZIANI
ASSISTANT DESIGNER: R. LINCOLN
DRAWN BY: G. C./F. C./M.B.
CHECKED BY: D. BIASE/G. COLANGELO
PLOT DATE: DEC.13.2020
JOB #: 1331.15

SECOND FLOOR PLAN
BUILDING C (PARTIAL PLAN)




1:50

A-302c1

TITLEBLOCK SIZE: 915 x 1200

KEY PLAN

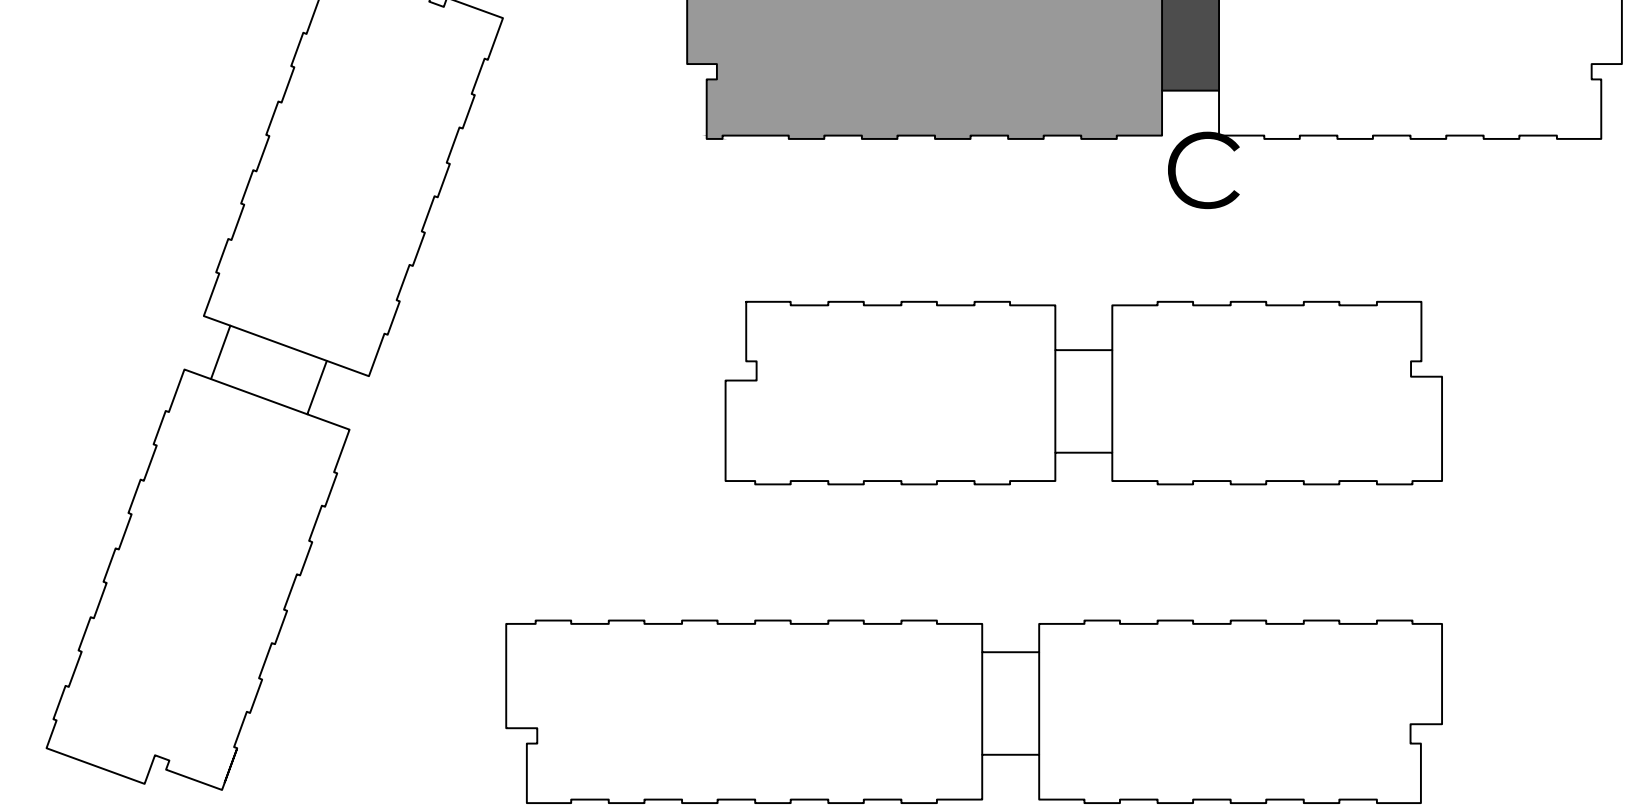


THIS DRAWING IS NOT TO BE SCALED. ALL ARCHITECTURAL SYMBOLS INDICATED ON THIS DRAWING ARE GRAPHIC REPRESENTATIONS ONLY.

CONDITIONS FOR ELECTRONIC INFORMATION TRANSFER:

ELECTRONIC INFORMATION IS SUPPLIED TO THE OTHER ASSOCIATED FIRMS TO ASSIST THEM IN THE EXECUTION OF THEIR WORK. REVIEW THE RECIPIENT FIRMS MUST DETERMINE THE ADEQUACY OF THE CAPACITY/RELIANCE OF THE INFORMATION IN RESPECT TO THEIR PARTICULAR RESPONSIBILITY.

GRADWIN+CORAZZA ARCHITECTS INC. SHALL NOT BE RESPONSIBLE FOR:

1. ELECTRONIC CHANGES, INADEQUACIES, LOSS OF LOSS OF INFORMATION IN WHOLE OR PART WHEN INFORMATION IS TRANSFERRED;
2. TRANSMISSION OF ANY VIRUS OR DAMAGE TO THE RECEIVING ELECTRONIC SYSTEM WHEN INFORMATION IS TRANSFERRED.

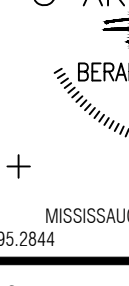SEP 18/2019 Issued for Addendum 1 Issued for revisions					
					
GRAZIANI CORAZZA ARCHITECTS 1125 DUNDAS ST. W. SUITE 100 F 905.795.3001		MISSISSAUGA, ONTARIO L4W 1K3 F 905.795.3844 WWW.GG-ARCHITECTS.COM			
RESIDENTIAL					
					
BRAMPTON		ATTARMA & PALLINCO DRIVE		ONTARIO	
PROJECT ARCHITECT:		B. GRAZIANI			
ASSISTANT DESIGNER:		R. LINCOLN			
DRAWN BY:		G. C.F./M.B.			
CHECKED BY:		D. BRASE/G. COLANGELO			
PLOT DATE:		DEC.13/2020			
1331.15					
100%					
SECOND FLOOR PLAN BUILDING C (PARTIAL PLAN)					
		1:50		A-302c2	
TITLE BLOCK SIZE: 915 x 1200					

THIS DRAWING IS AN INSTRUMENT OF SERVICE, IT IS PROVIDED BY AND IS THE PROPERTY OF GRAZIANI CORAZZI ARCHITECTS INC. THE CONTRACTOR MUST VERIFY AND ACCEPT RESPONSIBILITY FOR ALL DIMENSIONS AND COORDINATIONS. ANY AND ALL MODIFICATIONS TO THIS DRAWING MUST BE APPROVED BY GRAZIANI CORAZZI ARCHITECTS INC. BEFORE ANY CONSTRUCTION BEGINS. GRAZIANI CORAZZI ARCHITECTS INC. IS NOT RESPONSIBLE FOR THE ACCURACY OF SURVEY, STRUCTURAL, MECHANICAL, ELECTRICAL, AND OTHER ENGINEERING INFORMATION SHOWN ON THIS DRAWING. REFER TO THE APPROPRIATE ENGINEERING DRAWINGS BEFORE PROCEEDING WITH THE WORK. CONSTRUCTION MUST COMPLY WITH ALL APPLICABLE CODES AND REQUIREMENTS OF THE AUTHORITIES HAVING JURISDICTION, UNLESS OTHERWISE NOTED. NO MODIFICATION HAS BEEN MADE HEREIN AS REPORTED BY OR THIS OFFICE IN RELATION TO THE ENVIRONMENTAL CONDITION OF THIS SITE.

THIS DRAWING IS NOT TO BE SCALED. ALL ARCHITECTURAL SYMBOLS INDICATED ON THIS DRAWING ARE GRAPHIC REPRESENTATIONS ONLY.

CONDITIONS FOR ELECTRONIC INFORMATION TRANSFER:


ELECTRONIC INFORMATION IS SUPPLIED TO THE OTHER ASSOCIATED FIRMS TO ASSIST THEM IN THE EXECUTION OF THEIR WORK. REVIEW THE RECEIVED FIRMS MUST DETERMINE THE COMPLETENESS, APPROPRIATENESS, RELIANCE OF THE INFORMATION IN RESPECT TO THEIR PARTICULAR RESPONSIBILITY.

GRAZIANI CORAZZI ARCHITECTS INC. SHALL NOT BE RESPONSIBLE FOR ERROR, OMISSION, INCOMPLETENESS DUE TO USE OF INFORMATION IN WHOLE OR PART, WHEN INFORMATION IS TRANSFERRED.

TRANSMISSION OF ANY FILES OR CHANGE TO THE RECEIVING ELECTRONIC SYSTEM AFTER INFORMATION IS TRANSFERRED.

01. Oct.07.2019 Issued for tender —
02. Mar.13.2020 Issued for design coordination #2 —
03. Mar.16.2020 Issued for addendum #2 —
04. Mar.16.2020 Issued for addendum #3 —
05. Aug.24.2020 Issued for addendum #4 —
06. Sept.28.2020 Issued for permit lq
07. Oct.20.2020 Issued for addendum #5 lq
08. Nov.23.2020 Issued for addendum #6 lq
09. Dec.14.2020 Issued for addendum #7 lq

REF.A302a2 FOR CONTINUATION

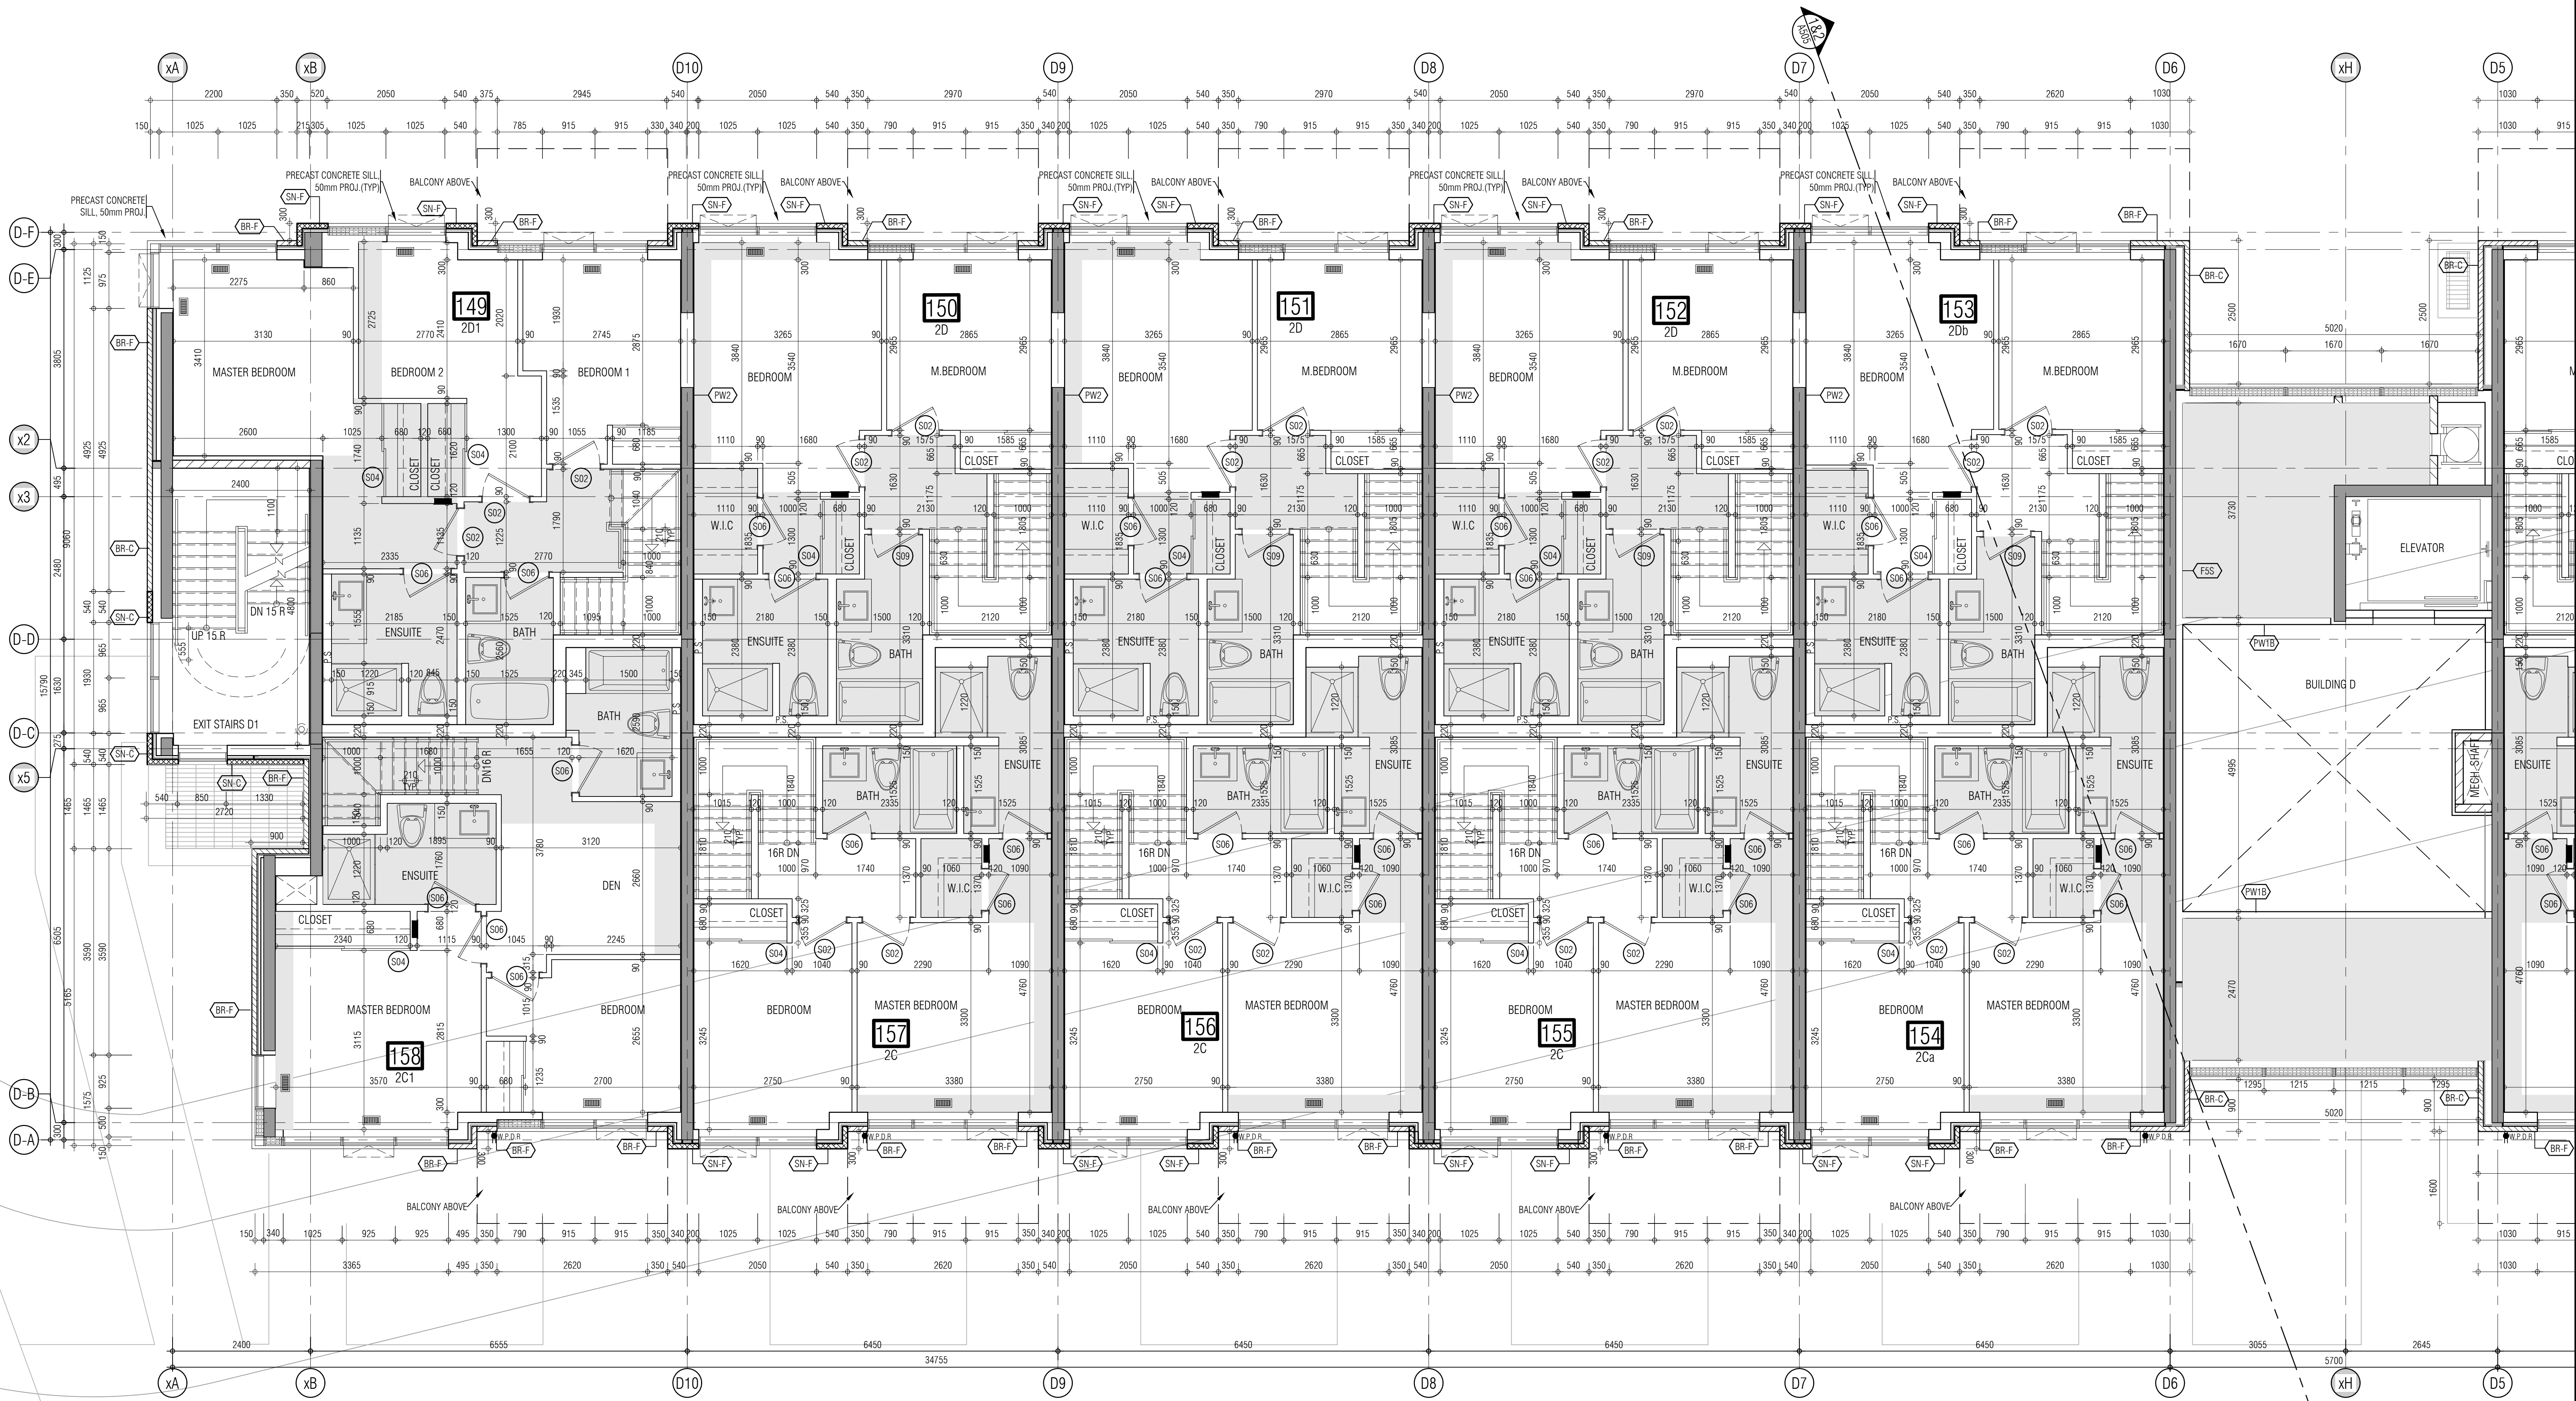

01. SEP.18.2019 Issued for Addendum 1 —
Issued for revisions





RESIDENTIAL
ATTMAR + PALLESCHI DRIVE
BRAMPTON ONTARIO

PROJECT ARCHITECT: B.GRAZIANI
ASSISTANT DESIGNER: R.LINCOLN
DRAWN BY: G.C./F.C./M.B.
CHECKED BY: D.BIASI/G.COLANGELO
PLOT DATE: DEC.13.2020
JOB #: 1331.15

SECOND FLOOR PLAN
BUILDING D (PARTIAL PLAN)

1:50 A-302d1

TITLEBLOCK SIZE: 915 x 1200

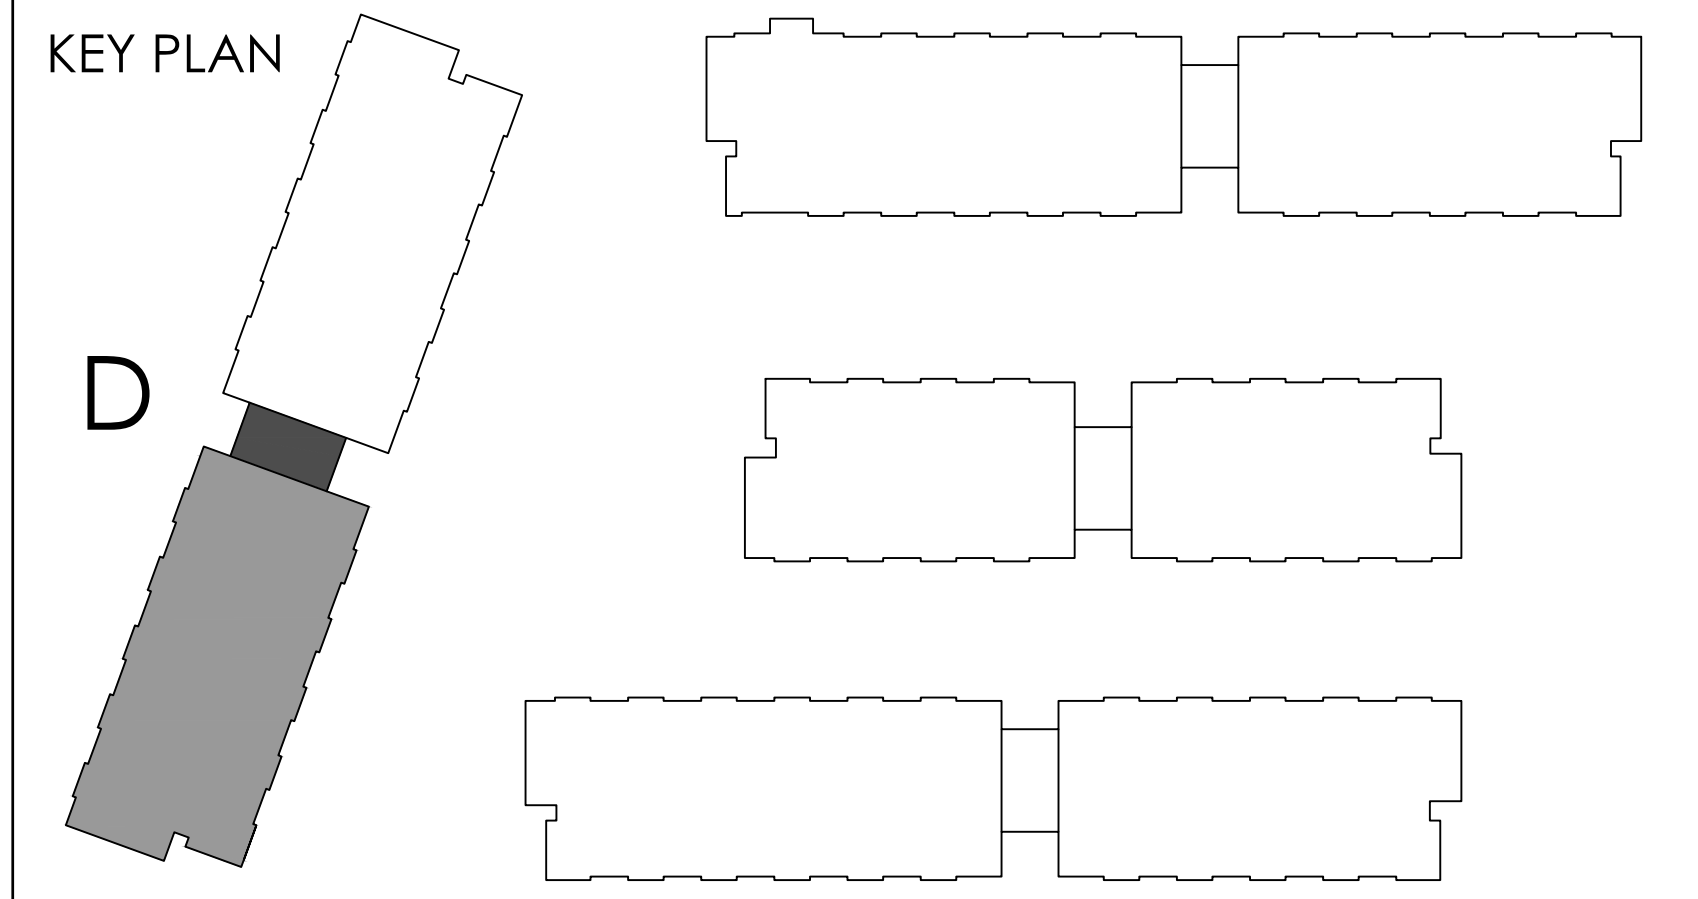

THIS DRAWING IS AN INSTRUMENT OF SERVICE, IT IS PROVIDED BY AND IS THE PROPERTY OF GRAZIANI-CORAZZA ARCHITECTS INC. THE CONTRACTOR MUST VERIFY AND ACCEPT RESPONSIBILITY FOR ALL DIMENSIONS AND COORDINATING ON SITE AND MUST NOTIFY GRAZIANI-CORAZZA ARCHITECTS INC. OF ANY VARIATIONS FROM THE SUPPLIED INFORMATION. GRAZIANI-CORAZZA ARCHITECTS INC. IS NOT RESPONSIBLE FOR THE ACCURACY OF SURVEY, STRUCTURAL, MECHANICAL, ELECTRICAL, AND OTHER ENGINEERING INFORMATION SHOWN ON THIS DRAWING. REFER TO THE APPROPRIATE ENGINEERING DRAWINGS BEFORE PROCEEDING WITH THE WORK. CONSTRUCTION MUST COMPLY TO ALL APPLICABLE CODES AND REQUIREMENTS OF THE AUTHORITIES HAVING JURISDICTION. UNLESS OTHERWISE NOTED, NO INVESTIGATION HAS BEEN UNDERTAKEN OR REPORTED ON BY THIS OFFICE IN RELATION TO THE ENVIRONMENTAL CONDITION OF THIS SITE.

THIS DRAWING IS NOT TO BE SCALED. ALL ARCHITECTURAL SYMBOLS INDICATED ON THIS DRAWING ARE GRAPHIC REPRESENTATIONS ONLY.


CONDITIONS FOR ELECTRONIC INFORMATION TRANSFER:

ELECTRONIC INFORMATION IS SUPPLIED TO THE OTHER ASSOCIATED FIRMS TO ASSIST THEM IN THE EXECUTION OF THEIR WORK. REVIEW THE RECEIVED FIRMS MUST DETERMINE THE COMPLETENESS, APPROPRIATENESS, RELIANCE OF THE INFORMATION IN RESPECT TO THEIR PARTICULAR RESPONSIBILITY.

GRAZIANI-CORAZZA ARCHITECTS INC. SHALL NOT BE RESPONSIBLE FOR:


1. ERROR, OMISSION, INCOMPLETENESS DUE TO USE OF INFORMATION IN WHOLE OR PART, WHEN INFORMATION IS TRANSFERRED.

2. TRANSMISSION OF ANY VIRUS OR DAMAGE TO THE RECEIVING ELECTRONIC SYSTEM WHEN INFORMATION IS TRANSFERRED.

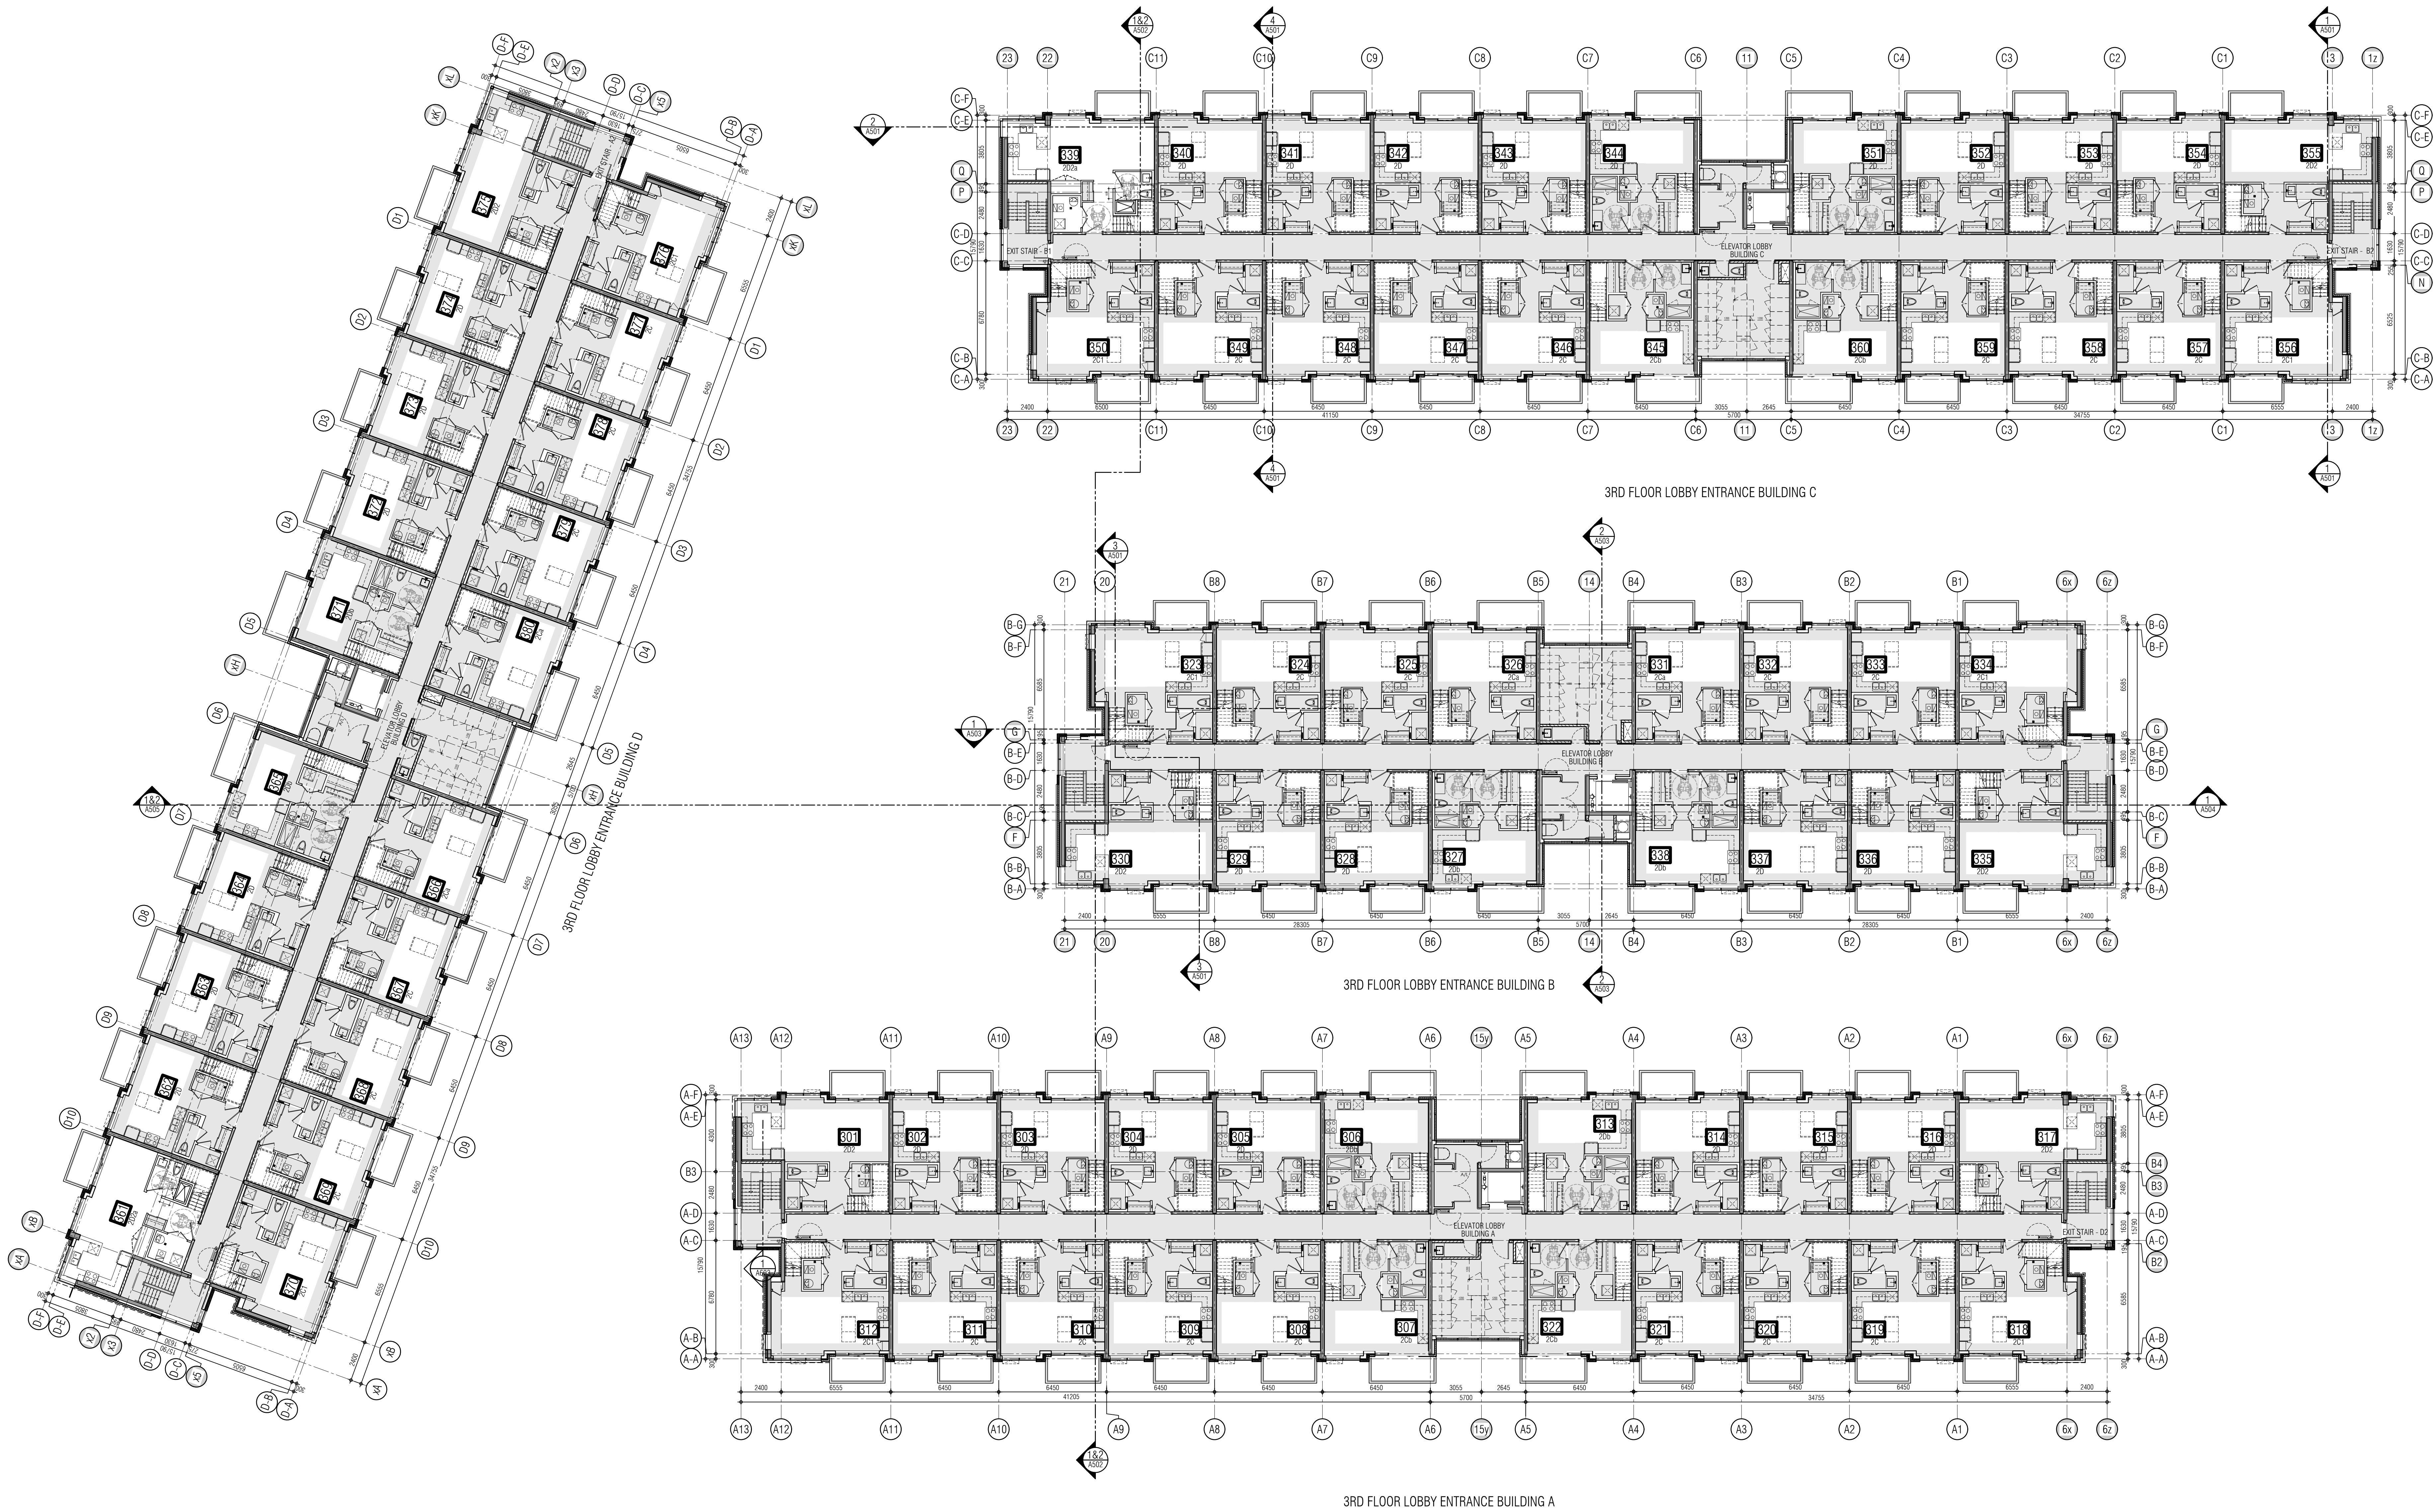

- 01. Oct.07.2019 issued for tender
- 02. Mar.13.2020 issued for design coordination #2
- 03. Mar.16.2020 issued for addendum #2
- 04. Mar.16.2020 issued for addendum #3
- 05. Aug.24.2020 issued for addendum #4
- 06. Sept.28.2020 issued for permit
- 07. Oct.20.2020 issued for addendum #5
- 08. Nov.23.2020 issued for addendum #6
- 09. Dec.14.2020 issued for addendum #7

01. SEP 18, 2019 Issued for Addendum 1
Issued for revisions

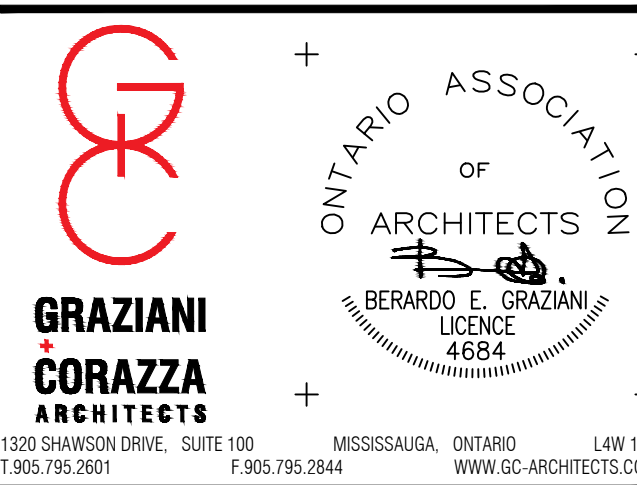




BRAMPTON ONTARIO
PROJECT ARCHITECT: B.GRAZIANI
ASSISTANT DESIGNER: R.LINCOLN
DRAWN BY: G.C./F.C./M.B.
CHECKED BY: D.BIASE/G.COLANGELO
PLOT DATE: DEC.13.2020
JOB #: 1331.15

THIRD FLOOR OVERALL PLAN

THIS DRAWING IS AN INSTRUMENT OF SERVICE, IS PROVIDED BY AND IS THE PROPERTY OF GRAZIANI CORAZZA ARCHITECTS INC. THE CONTRACTOR MUST VERIFY AND ACCEPT RESPONSIBILITY FOR ALL DIMENSIONS AND COORDINATIONS. THE CONTRACTOR MUST NOTIFY GRAZIANI CORAZZA ARCHITECTS INC. OF ANY DISCREPANCIES FROM THE SUPPLIED INFORMATION. GRAZIANI CORAZZA ARCHITECTS INC. IS NOT RESPONSIBLE FOR THE ACCURACY OF SURVEY, STRUCTURAL, MECHANICAL, ELECTRICAL, AND OTHER ENGINEERING INFORMATION SHOWN ON THIS DRAWING. REFER TO THE APPROPRIATE ENGINEERING DRAWINGS BEFORE PROCEEDING WITH THE WORK. CONSTRUCTION MUST CONFORM TO ALL APPLICABLE CODES AND REQUIREMENTS OF THE AUTHORITIES HAVING JURISDICTION. UNLESS OTHERWISE NOTED, NO MODIFICATION HAS BEEN MADE/MADE AS REPORTED IN BY THIS OFFICE IN RELATION TO THE ENVIRONMENTAL CONDITION OF THIS SITE.

THIS DRAWING IS NOT TO BE SCALED. ALL ARCHITECTURAL SYMBOLS INDICATED ON THIS DRAWING ARE GRAPHIC REPRESENTATIONS ONLY.

CONDITIONS FOR ELECTRONIC INFORMATION TRANSFER:



ELECTRONIC INFORMATION IS SUPPLIED TO THE OTHER ASSOCIATED FIRMS TO ASSIST THEM IN THE EXECUTION OF THEIR WORK. REVIEW THE RECEIVED FIRMS MUST DETERMINE THE COMPLETENESS, APPROPRIATENESS, RELIANCE OF THE INFORMATION IN RESPECT TO THEIR PARTICULAR RESPONSIBILITY.

GRAZIANI CORAZZA ARCHITECTS INC. SHALL NOT BE RESPONSIBLE FOR ERRORS, OMISSIONS, INCOMPLETENESS DUE TO USE OF INFORMATION IN WHOLE OR PART, WHEN INFORMATION IS TRANSFERRED.

TRANSMISSION OF ANY FILES OR DAMAGE TO THE RECEIVING ELECTRONIC SYSTEM WHEN INFORMATION IS TRANSFERRED.

REF A303d2 FOR CONTINUATION

01. Oct.07.2019 Issued for tender
02. Mar.13.2020 Issued for design coordination #2
03. Mar.16.2020 Issued for addendum #2
04. Mar.16.2020 Issued for addendum #3
05. Aug.24.2020 Issued for addendum #4
06. Sept.28.2020 Issued for permit
07. Oct.20.2020 Issued for addendum #5
08. Nov.23.2020 Issued for addendum #6
09. Dec.14.2020 Issued for addendum #7

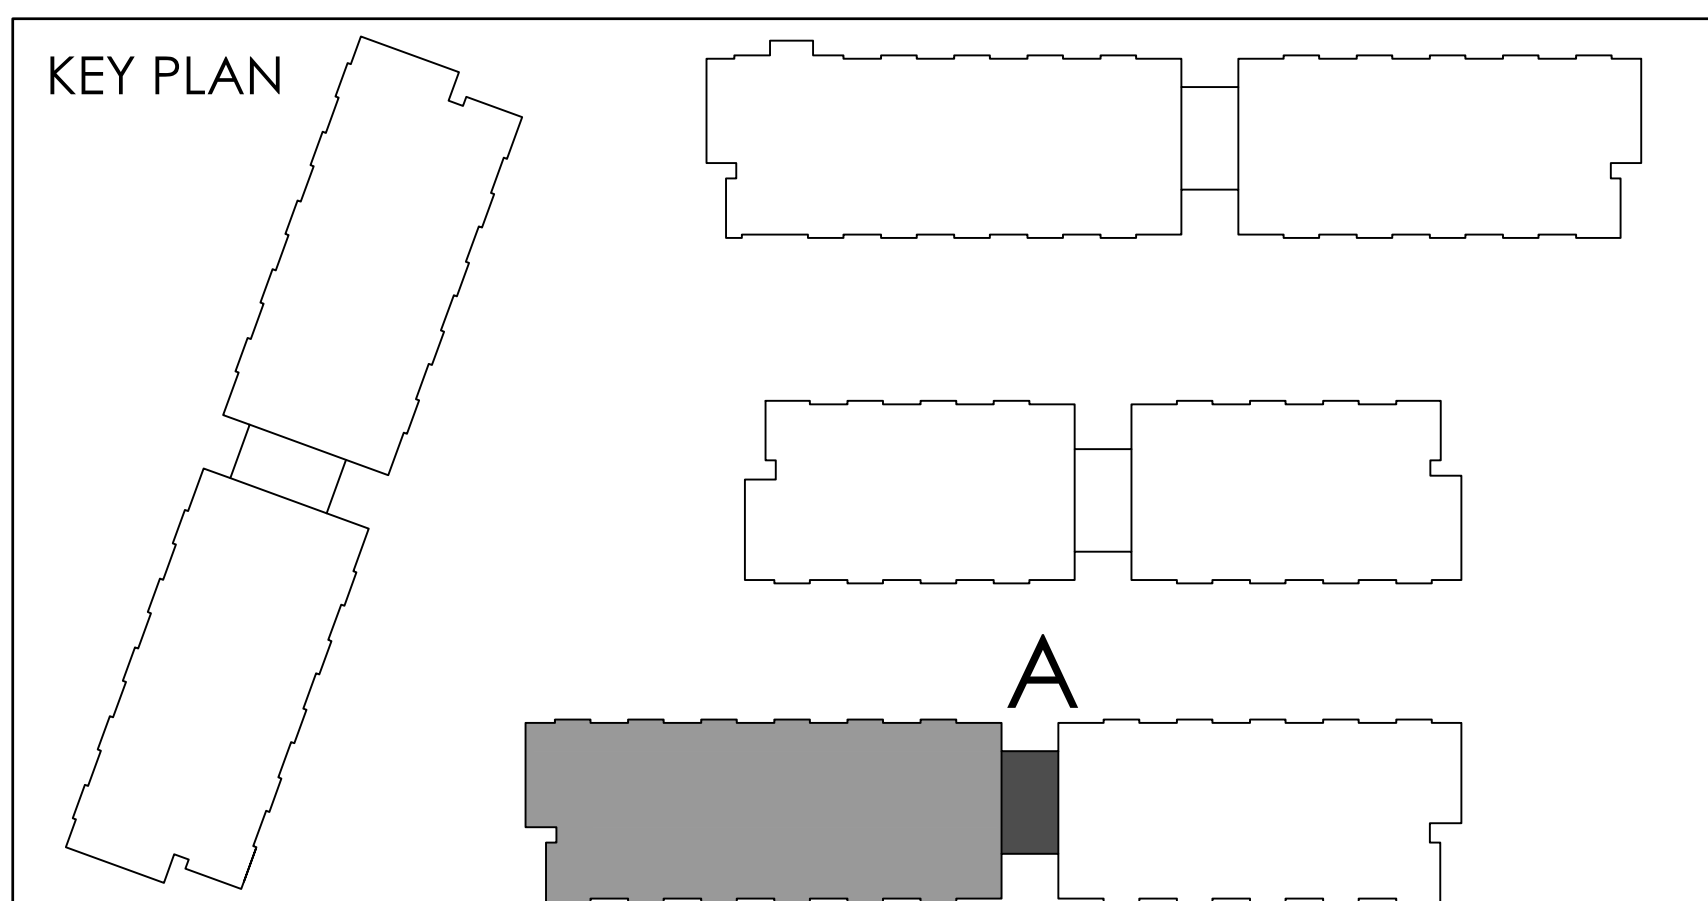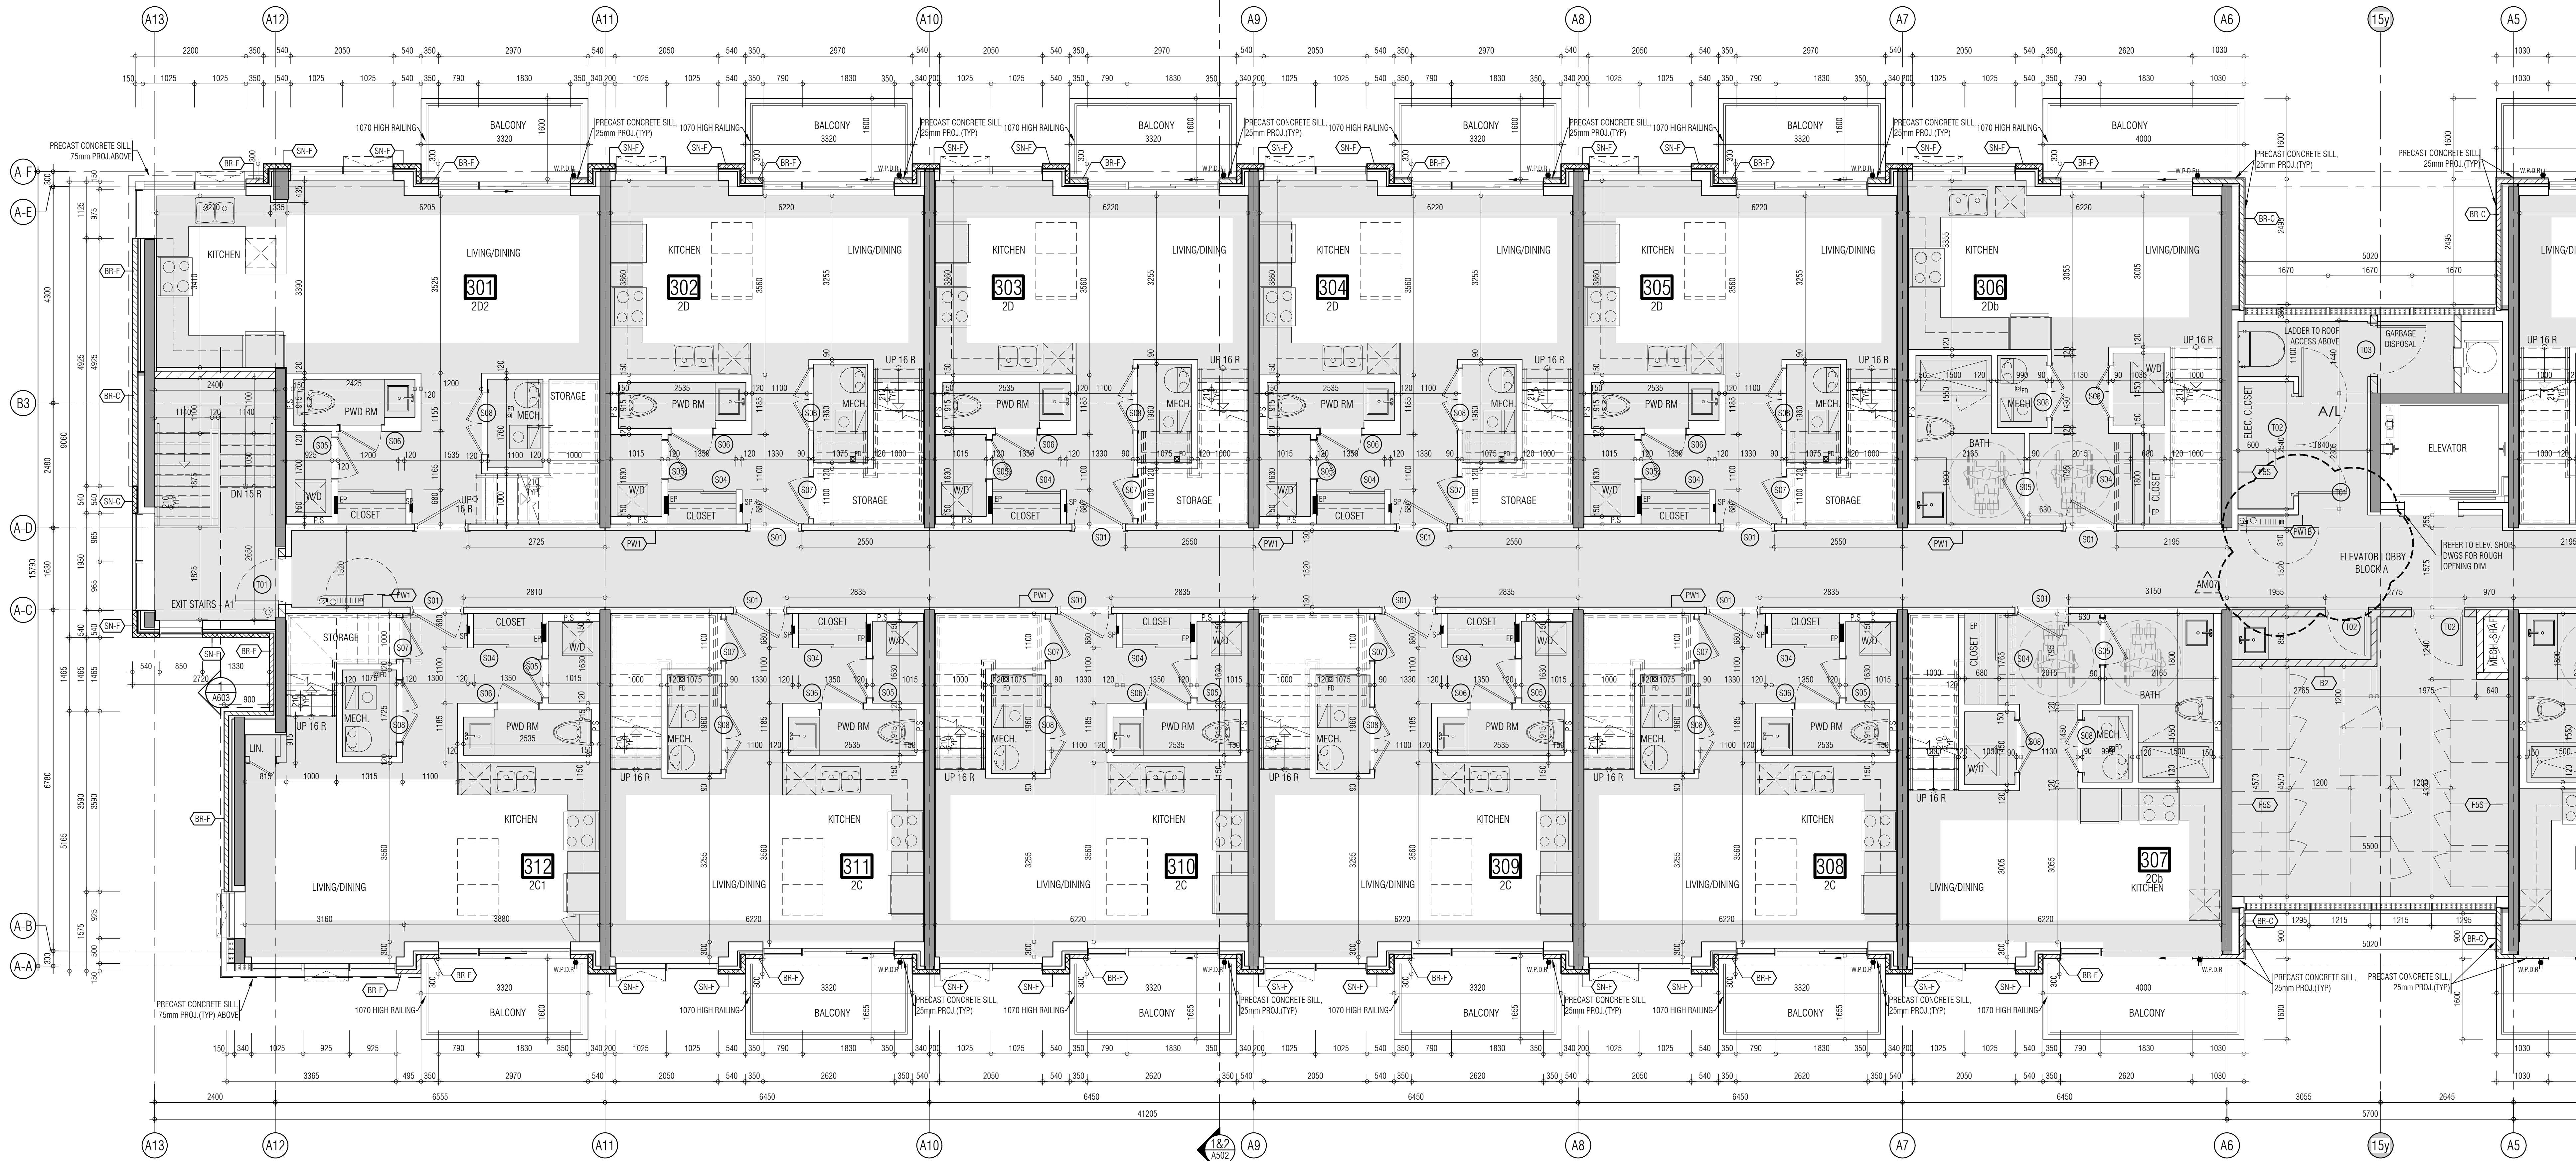

01. SEP 18, 2019 Issued for Addendum 1
- Issued for revisions

GRAZIANI CORAZZA ARCHITECTS


ONTARIO ASSOCIATION OF ARCHITECTS


RESIDENTIAL

BRAMPTON ATTAR + PALLESCI DRIVE ONTARIO

PROJECT ARCHITECT: B. GRAZIANI

ASSISTANT DESIGNER: R. LINCOLN

DRAWN BY: G. C./F. C./M. B.

CHECKED BY: D. BIASI/G. COLANGELO

PLLOT DATE: DEC. 13, 2020

JOB #: 1331.15

THIRD FLOOR PLAN
BUILDING A (PARTIAL PLAN)

1:50 A-303a1

TITLEBLOCK SIZE: 915 x 1200

THIS DRAWING IS NOT TO BE SCALED. ALL ARCHITECTURAL SYMBOLS INDICATED ON THIS DRAWING ARE GRAPHIC REPRESENTATIONS ONLY.

CONDITIONS FOR ELECTRONIC INFORMATION TRANSFER:

ELECTRONIC INFORMATION IS SUPPLIED TO THE OTHER ASSOCIATED FIRMS TO ASSIST THEM IN THE EXECUTION OF THEIR WORK/REVIEW. THE RECIPIENT FIRMS MUST DETERMINE THE APPROPRIATE LEVEL OF INFORMATION RELIANCE OF THE INFORMATION IN RESPECT TO THEIR PARTICULAR RESPONSIBILITY.

GRADWAL & ORAZA ARCHITECTS INC. SHALL NOT BE RESPONSIBLE FOR:

1. ERRORS, OMISSIONS, INCOMPLETENESS DUE TO LOSS OF INFORMATION IN WHOLE OR PART WHEN INFORMATION IS TRANSFERRED.
2. TRANSMISSION OF ANY VIRUS OR DAMAGE TO THE RECEIVING ELECTRONIC SYSTEM WHEN INFORMATION IS TRANSFERRED.

01 SEP 18 2019 Issued for Addendum 1		+ + + +	
RESIDENTIAL			
			
ATTMAY & PALLESCHI DRIVE		ONTARIO	
BRANFORD			
PROJECT ARCHITECT:	B. GRAZIANI		
ASSISTANT DESIGNER:	R. LINCOLN		
C.D.F. BY:	G. C/VE. C.M.B		
CHECKED BY:	D. BIASE / G. COLANGELO		
PILOT DATE:	DEC. 13, 2020		
JOHNS	1331.15		
THIRD FLOOR PLAN BUILDING A (PARTIAL PLAN)			
			
1/8" = 1'-0"		A-303a2	
PRINTED DATE: 09/15/2020			

THIS DRAWING, AS AN INSTRUMENT OF SERVICE, IS PROVIDED BY AND IS THE PROPERTY OF GRAZIANI-CORAZZA ARCHITECTS INC. THE CONTRACTOR MUST VERIFY AND ACCEPT RESPONSIBILITY FOR ALL DIMENSIONS AND COORDINATE ON SITE AND MUST NOTIFY GRAZIANI-CORAZZA ARCHITECTS INC. OF ANY VARIATIONS FROM THE SUPPLIED INFORMATION. GRAZIANI-CORAZZA ARCHITECTS INC. IS NOT RESPONSIBLE FOR THE ACCURACY OF SURVEY, STRUCTURAL, MECHANICAL, ELECTRICAL, AND OTHER ENGINEERING INFORMATION SHOWN ON THIS DRAWING. REFER TO THE APPROPRIATE ENGINEERING DRAWINGS BEFORE PROCEEDING WITH THE WORK. CONSTRUCTION MUST COMPLY TO ALL APPLICABLE CODES AND REQUIREMENTS OF THE AUTHORITIES HAVING JURISDICTION. UNLESS OTHERWISE NOTED, NO MODIFICATION HAS BEEN IDENTIFIED OR REPORTED OR BY THIS OFFICE IN RELATION TO THE ENVIRONMENTAL CONDITION OF THIS SITE.

THIS DRAWING IS NOT TO BE SCALED. ALL ARCHITECTURAL SYMBOLS INDICATED ON THIS DRAWING ARE GRAPHIC REPRESENTATIONS ONLY.


CONDITIONS FOR ELECTRONIC INFORMATION TRANSFER:

ELECTRONIC INFORMATION IS SUPPLIED TO THE OTHER ASSOCIATED FIRMS TO ASSIST THEM IN THE EXECUTION OF THEIR WORK. REVIEW THE RELEVANT FIRMS MUST DETERMINE THE COMPLETENESS, APPROPRIATENESS, RELIANCE OF THE INFORMATION IN RESPECT TO THEIR PARTICULAR RESPONSIBILITY.


GRAZIANI-CORAZZA ARCHITECTS INC. SHALL NOT BE RESPONSIBLE FOR ERROR, OMISSION, INCOMPLETENESS DUE TO USE OF INFORMATION IN WHOLE OR PART WHEN INFORMATION IS TRANSFERRED.

1. TRANSMISSION OF ANY WRIT OF DAMAGE TO THE RECEIVING ELECTRONIC SYSTEM WHEN INFORMATION IS TRANSFERRED.

01. Oct.07.2019 issued for tender —
02. Mar.13.2020 issued for design coordination #2 —
03. Mar.16.2020 issued for addendum #2 —
04. Mar.16.2020 issued for addendum #3 —
05. Aug.24.2020 issued for addendum #4 —
06. Sept.28.2020 issued for permit lq
07. Oct.20.2020 issued for addendum #5 lq
08. Nov.23.2020 issued for addendum #6 lq
09. Dec.14.2020 issued for addendum #7 lq

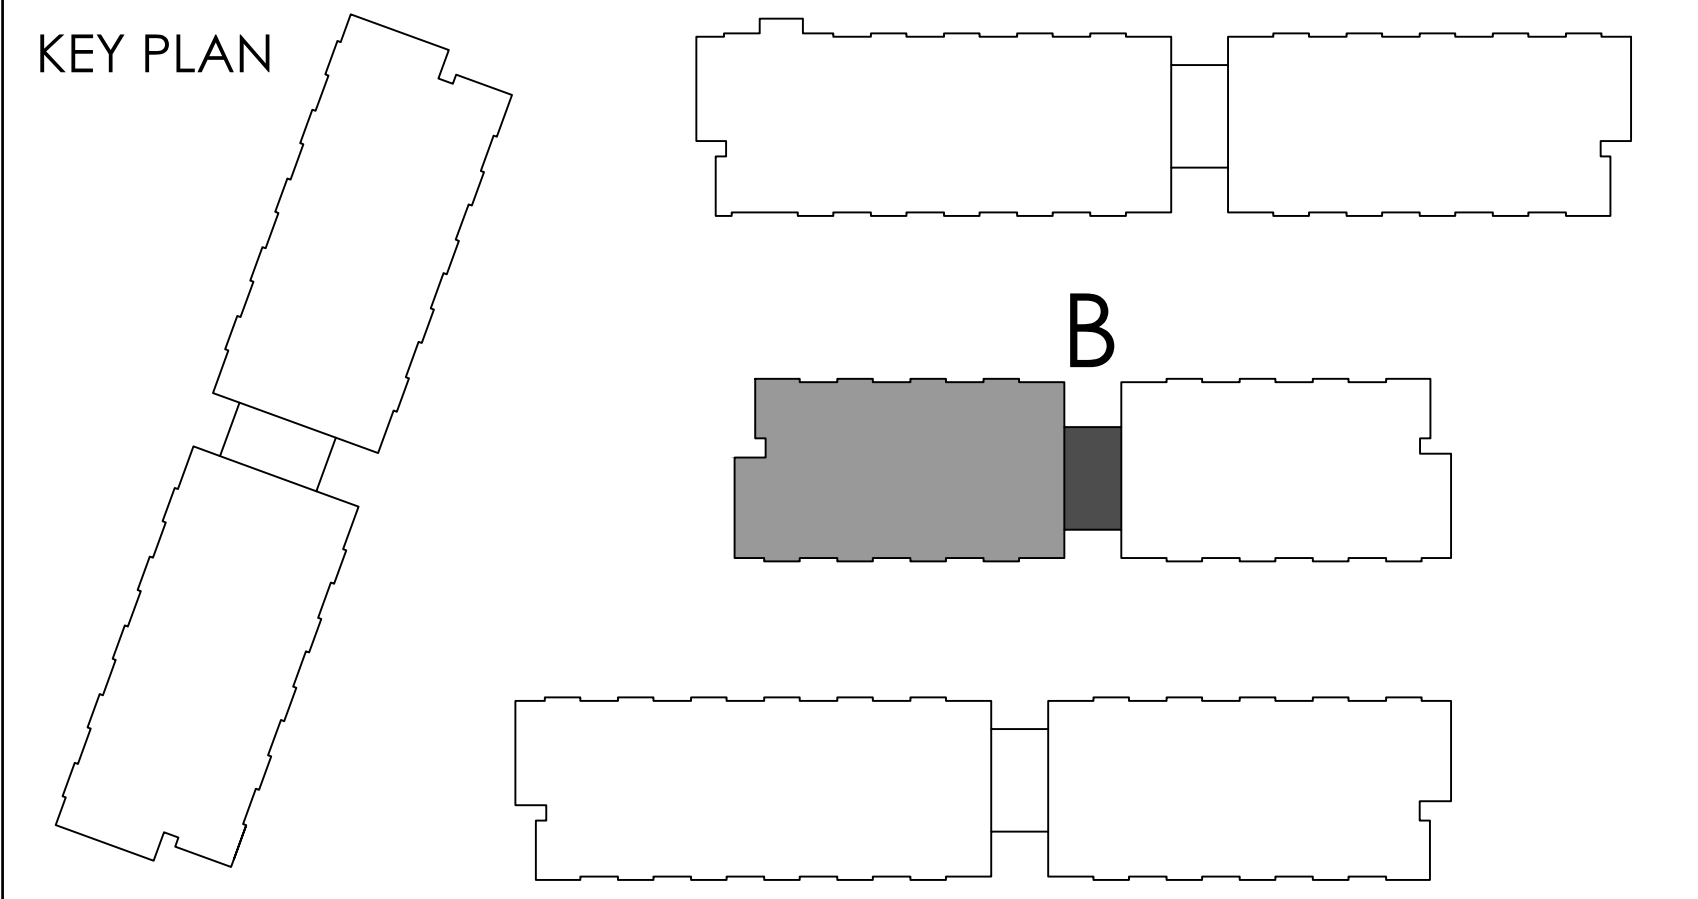

01. SEP 18, 2019 Issued for Addendum 1
Issued for revisions

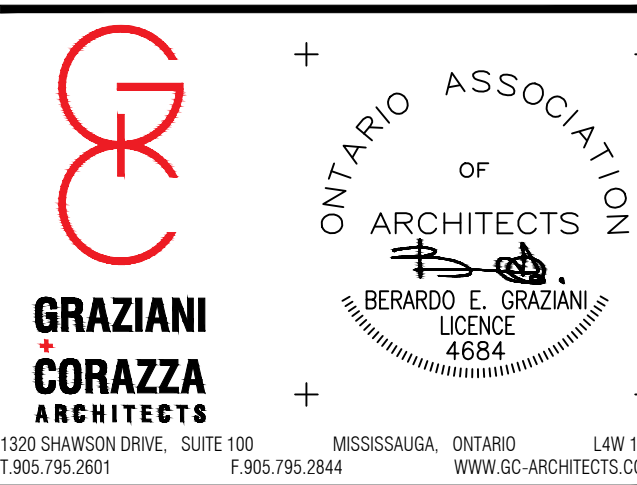


RESIDENTIAL

ATTMAR + PALLESCHI DRIVE

BRAMPTON ONTARIO

PROJECT ARCHITECT: B. GRAZIANI

ASSISTANT DESIGNER: R. LINCOLN

DRAWN BY: G. C. F. C. M. B.

CHECKED BY: D. BIASI / G. COLANGELO

PLANT DATE: DEC. 13, 2020

JOB # 1331.15


THIRD FLOOR PLAN

BUILDING B (PARTIAL PLAN)

1:50 A-303b1

TITLEBLOCK SIZE: 915 x 1200

REF.A303c1 FOR CONTINUATION

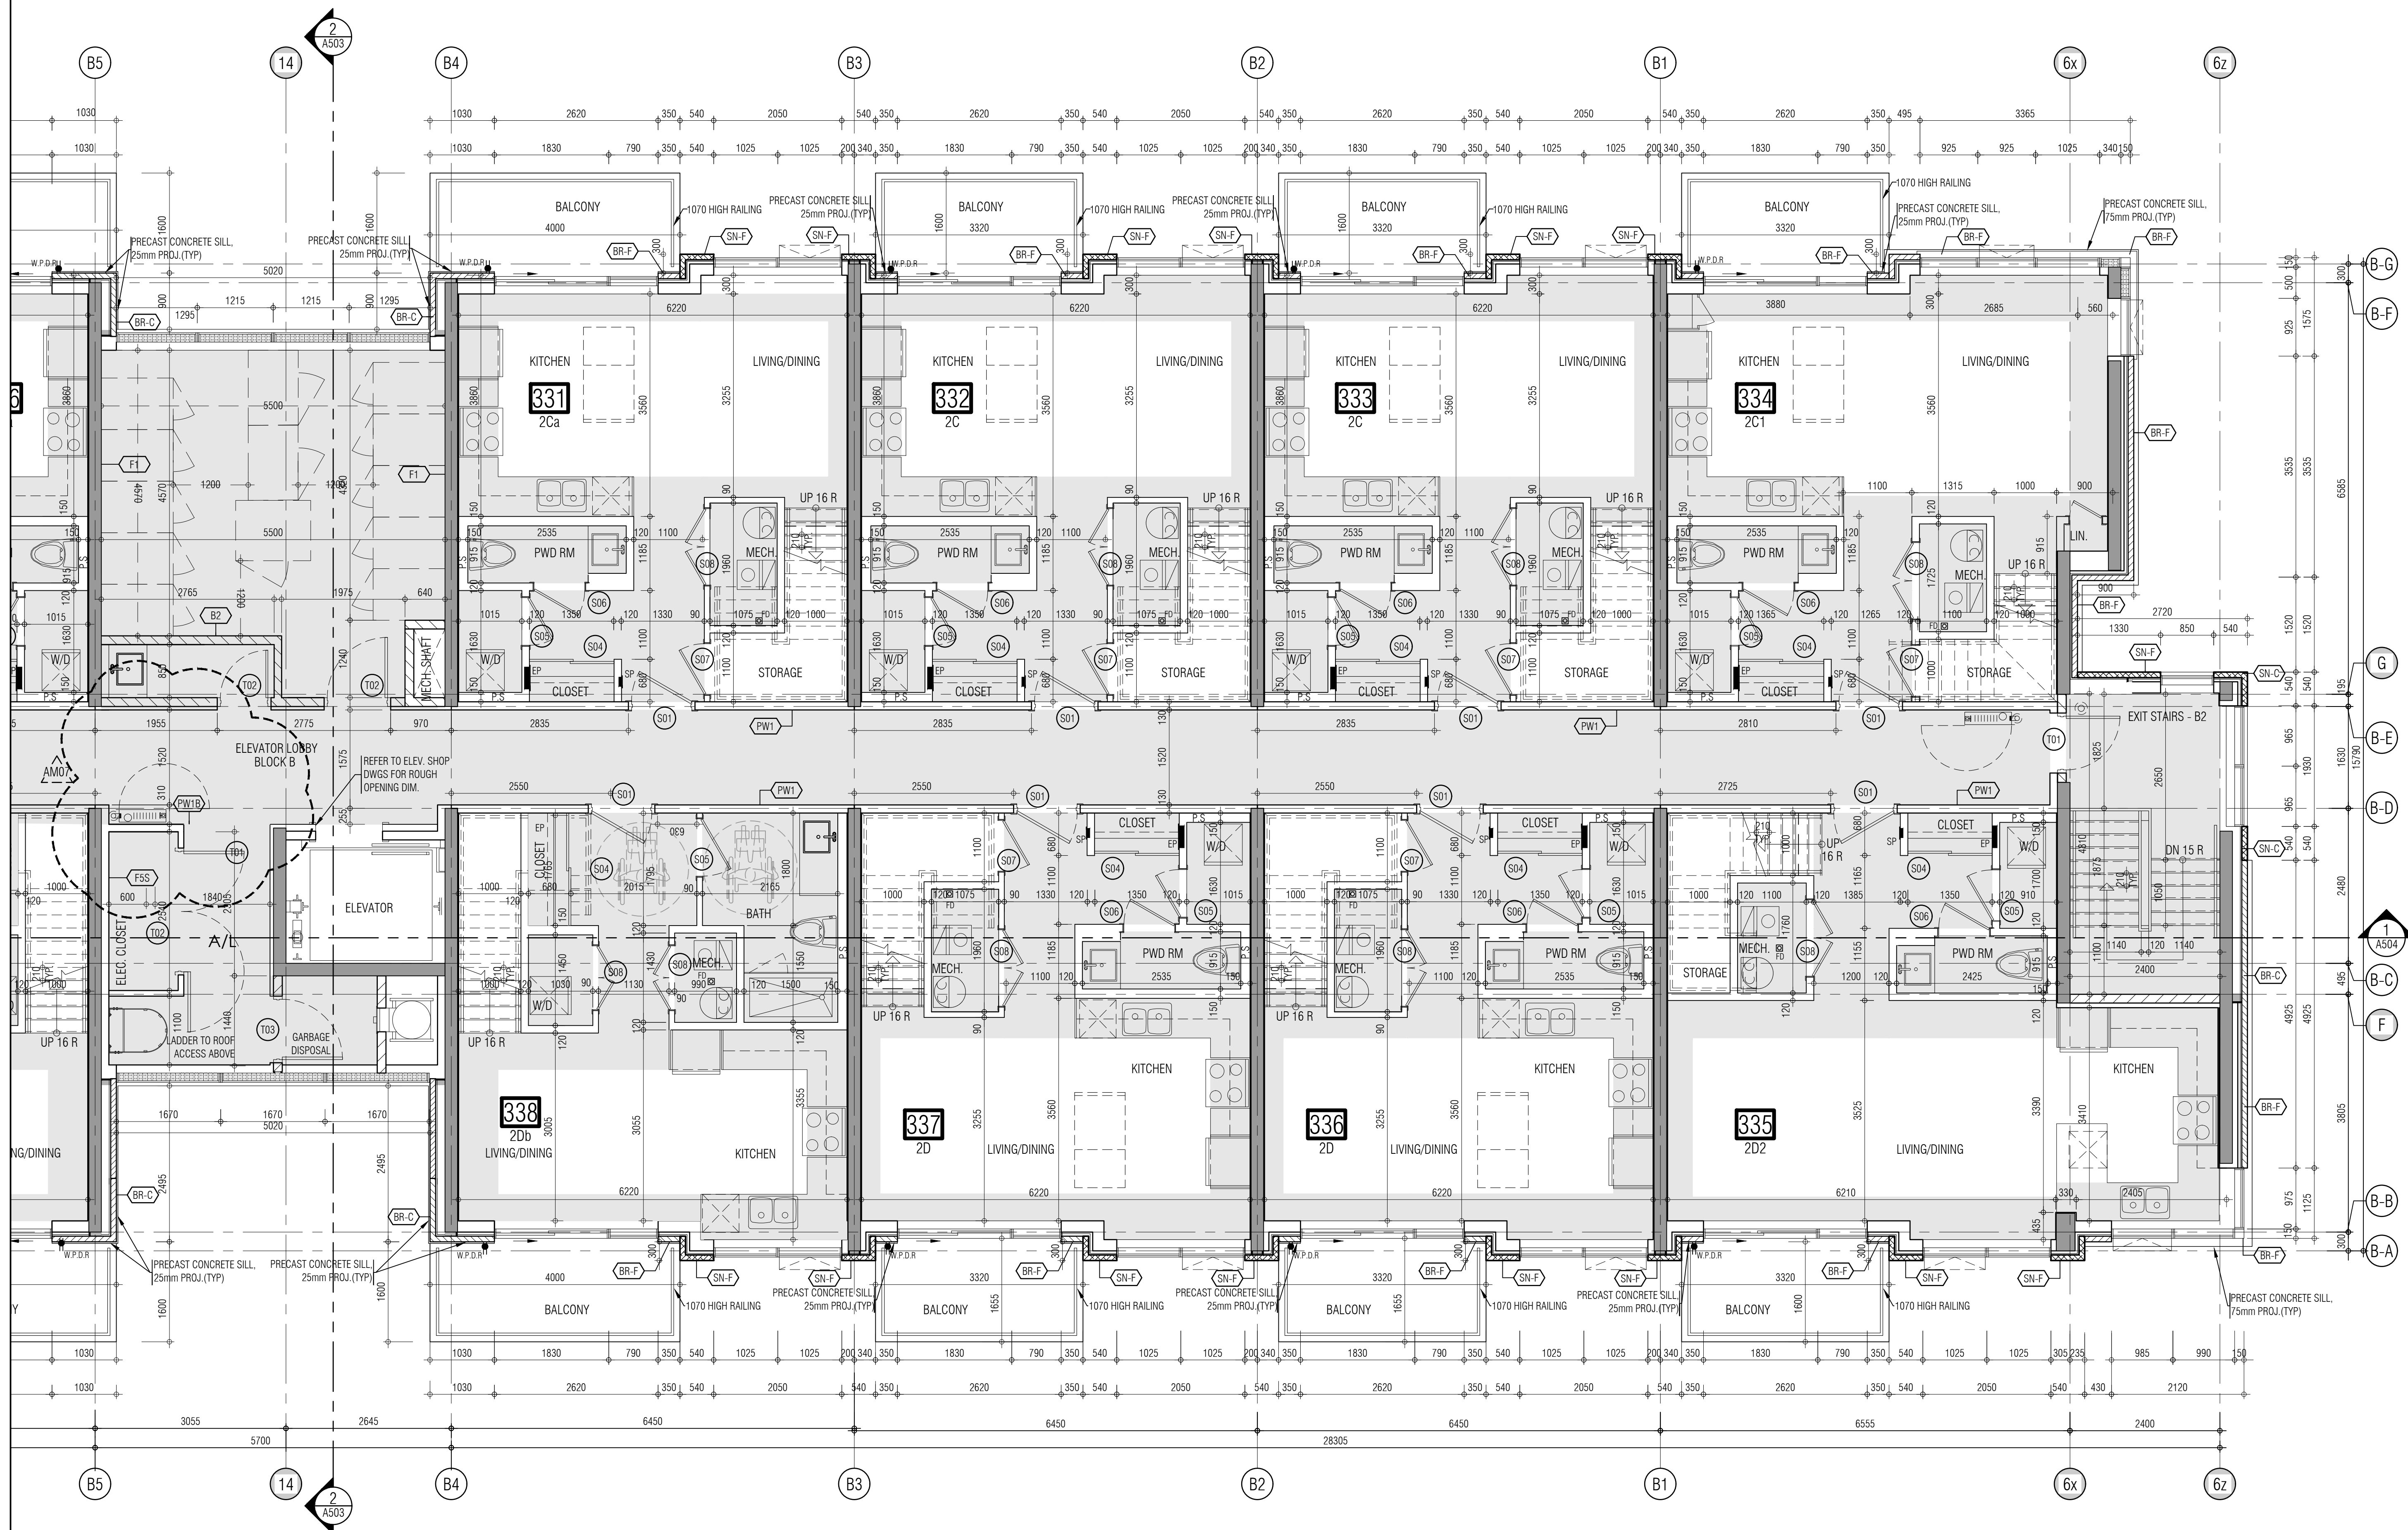

THIS DRAWING IS NOT TO BE SCALED. ALL ARCHITECTURAL DIMENSIONS INDICATED ON THIS DRAWING ARE GRAPHIC REPRESENTATIONS ONLY.

CONDITIONS FOR ELECTRONIC INFORMATION TRANSFER:

ELECTRONIC INFORMATION IS SUPPLIED TO THE OTHER ASSOCIATED FIRMS TO ASSIST THEM IN THE EXECUTION OF THEIR WORK. REVIEW THE RECIPIENT FIRMS MUST DETERMINE THE ADEQUACY OF THE CAPABILITY/RELIANCE OF THE INFORMATION IN RESPECT TO THEIR PARTICULAR RESPONSIBILITY.

GRADWIN+CORAZZA ARCHITECTS INC. SHALL NOT BE RESPONSIBLE FOR:

1. ERRORS, OMISSIONS, INADEQUACIES, LOSS OF LOSS OF INFORMATION IN WHOLE OR PART WHEN INFORMATION IS TRANSFERRED;
2. TRANSMISSION OF ANY VIRUS OR DAMAGE TO THE RECEIVING ELECTRONIC SYSTEM WHEN INFORMATION IS TRANSFERRED.


01. SEP 18, 2019 Issued for Adendum 1



THIRD FLOOR PLAN
BUILDING C (PARTIAL PLAN)



KEY PLAN

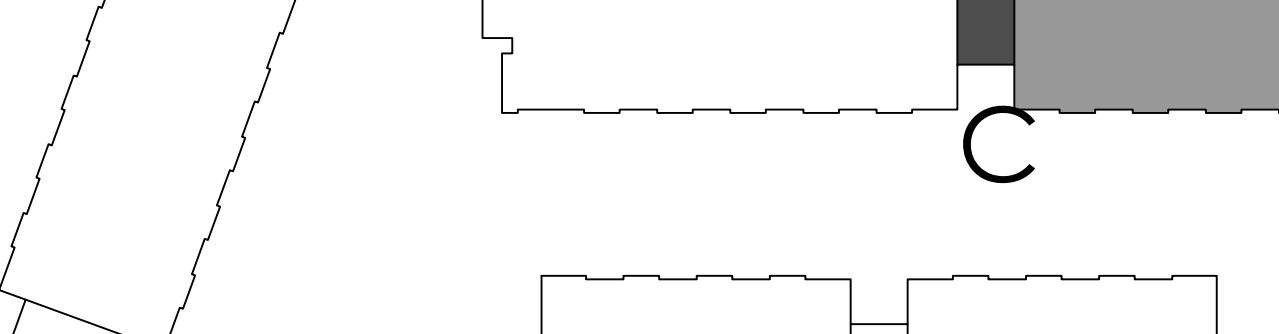

The key plan shows the layout of the site. It includes a large rectangular area on the left, a smaller rectangular area in the middle, and a larger rectangular area on the right. The proposed development is indicated by a shaded area within the middle section, labeled 'C'.

50 A-303c2

THIS DRAWING IS NOT TO BE SCALED. ALL ARCHITECTURAL SYMBOLS INDICATED ON THIS DRAWING ARE GRAPHIC REPRESENTATIONS ONLY.


CONDITIONS FOR ELECTRONIC INFORMATION TRANSFER:

ELECTRONIC INFORMATION IS SUPPLIED TO THE OTHER ASSOCIATED FIRMS TO ASSIST THEM IN THE EXECUTION OF THEIR WORK. HOWEVER, THE RECIPIENT FIRMS MUST DETERMINE THE EXTENT OF ANY UNLAWFUL OR UNWARRANTED REVELANCE OF THE INFORMATION IN THEIR PARTICULAR RESPONSIBILITY.

GRADWAL & ORAZA ARCHITECTS INC. SHALL NOT BE RESPONSIBLE FOR:

1. ERRORS, OMISSIONS, INADEQUACIES DUE TO LOSS OF INFORMATION IN WHOLE OR PART WHEN INFORMATION IS TRANSFERRED;
2. TRANSMISSION OF ANY VIRUS OR DAMAGE TO THE RECEIVING ELECTRONIC SYSTEM WHEN INFORMATION IS TRANSFERRED.

01.	Oct.07.2019	issued for tender	—
02.	Mar.13.2020	issued for design coordination #2	—
03.	Mar.16.2020	issued for addendum #2	—
04.	Mar.16.2020	issued for addendum #3	—
05.	Aug.24.2020	issued for addendum #4	—
06.	Sept. 28.2020	issued for permit	bg
07.	Oct.20.2020	issued for addendum #5	bg
08.	Nov.23.2020	issued for addendum #6	bg
09.	Dec.14.2020	issued for addendum #7	bg

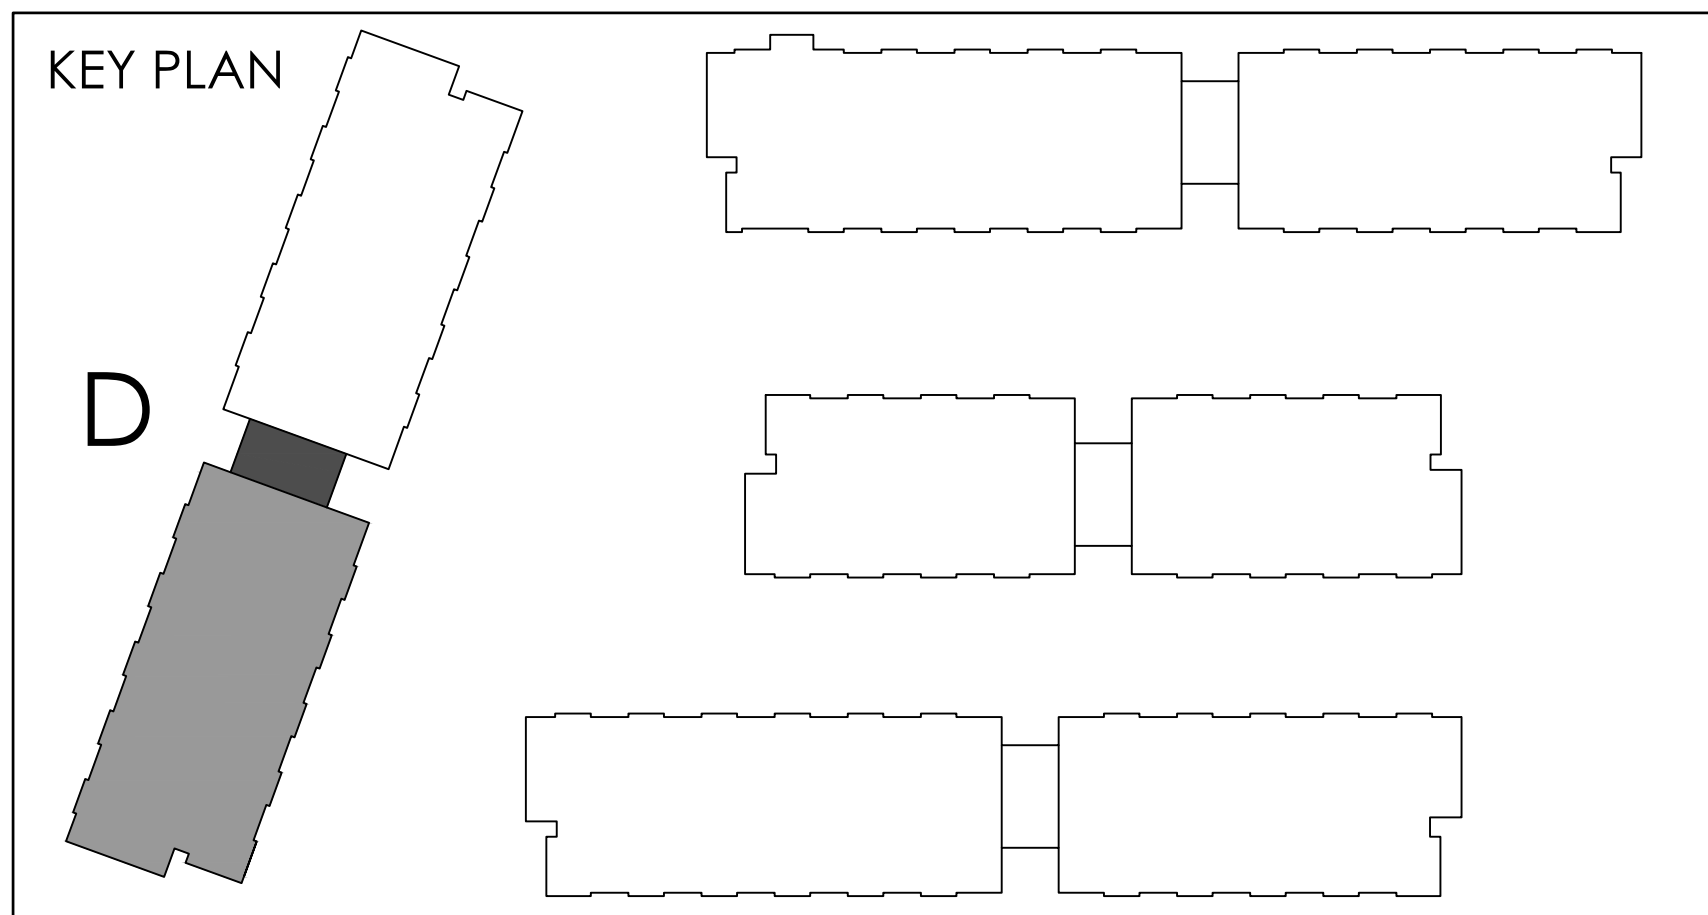

SEP 18, 2019 Issued for Addendum 1 issued for revisions			
			
THIRD FLOOR PLAN BUILDING D (PARTIAL PLAN)			
		1:50	
TITLEBLOCK SIZE: 915 x 1200		A-303d1	

THIS DRAWING IS AN INSTRUMENT OF SERVICE, IT IS PROVIDED BY AND IS THE PROPERTY OF GRAZIANI CORAZZA ARCHITECTS INC. THE CONTRACTOR MUST VERIFY AND ACCEPT RESPONSIBILITY FOR ALL DIMENSIONS AND COORDINATIONS AND MUST NOTIFY GRAZIANI CORAZZA ARCHITECTS INC. OF ANY DISCREPANCIES FROM THE SUPPLIED INFORMATION. GRAZIANI CORAZZA ARCHITECTS INC. IS NOT RESPONSIBLE FOR THE ACCURACY OF SURVEY, STRUCTURAL, MECHANICAL, ELECTRICAL, AND OTHER ENGINEERING INFORMATION SHOWN ON THIS DRAWING. REFER TO THE APPROPRIATE ENGINEERING DRAWINGS BEFORE PROCEEDING WITH THE WORK. CONSTRUCTION MUST COMPLY IN ALL APPLICABLE CODES AND REQUIREMENTS OF THE AUTHORITIES HAVING JURISDICTION, UNLESS OTHERWISE NOTED. NO MODIFICATION HAS BEEN MADE HEREIN OR REPORTED ON BY THIS OFFICE IN RELATION TO THE ENVIRONMENTAL CONDITION OF THIS SITE.

THIS DRAWING IS NOT TO BE SCALED. ALL ARCHITECTURAL SYMBOLS INDICATED ON THIS DRAWING ARE GRAPHIC REPRESENTATIONS ONLY.

CONDITIONS FOR ELECTRONIC INFORMATION TRANSFER:

ELECTRONIC INFORMATION IS SUPPLIED TO THE OTHER ASSOCIATED FIRMS TO ASSIST THEM IN THE EXECUTION OF THEIR WORK. REVIEW THE RECEIVED FIRMS MUST DETERMINE THE COMPLETENESS, APPROPRIATENESS, RELIANCE OF THE INFORMATION IN RESPECT TO THEIR PARTICULAR RESPONSIBILITY.


GRAZIANI CORAZZA ARCHITECTS INC. SHALL NOT BE RESPONSIBLE FOR ERRORS, OMISSIONS, INCOMPLETENESS DUE TO LOSS OF INFORMATION IN WHOLE OR PART, WHEN INFORMATION IS TRANSFERRED.

1. TRANSMISSION OF ANY FILES OF DAMAGE TO THE RECEIVING ELECTRONIC SYSTEM WHEN INFORMATION IS TRANSFERRED.

01. Oct.07.2019 issued for tender
02. Mar.13.2020 issued for design coordination #2
03. Mar.16.2020 issued for addendum #2
04. Mar.16.2020 issued for addendum #3
05. Aug.24.2020 issued for addendum #4
06. Sept.28.2020 issued for permit
07. Oct.20.2020 issued for addendum #5
08. Nov.23.2020 issued for addendum #6
09. Dec.14.2020 issued for addendum #7

01. SEP 18, 2019 Issued for Addendum 1

Issued for revisions

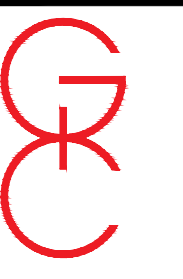

**GRAZIANI
CORAZZA**
ARCHITECTS

1335 SHAWINIGAN DRIVE, SUITE 100 MISSISSAUGA, ONTARIO L4W 1C3
905.760.2801 P.905.760.2804 WWW.GC-ARCHITECTS.COM

ONTARIO ASSOCIATION
OF
ARCHITECTS

BERNARD L. CORAZZA
LICENCE
46584

RESIDENTIAL

ATTMAR + PALLESCCHI DRIVE

BRAMPTON ONTARIO

PROJECT ARCHITECT: B. GRAZIANI

ASSISTANT DESIGNER: R. LINCOLN

DRAWN BY: G. C./F. C./M.B.

CHECKED BY: D. BIASE/G. COLANGELO

PLANT DATE: DEC.13.2020


JOB # 1331.15

**THIRD FLOOR PLAN
BUILDING D (PARTIAL PLAN)**

1:50 A-303d2

TITLEBLOCK SIZE: 915 x 1200

REF.A303a1 FOR CONTINUATION

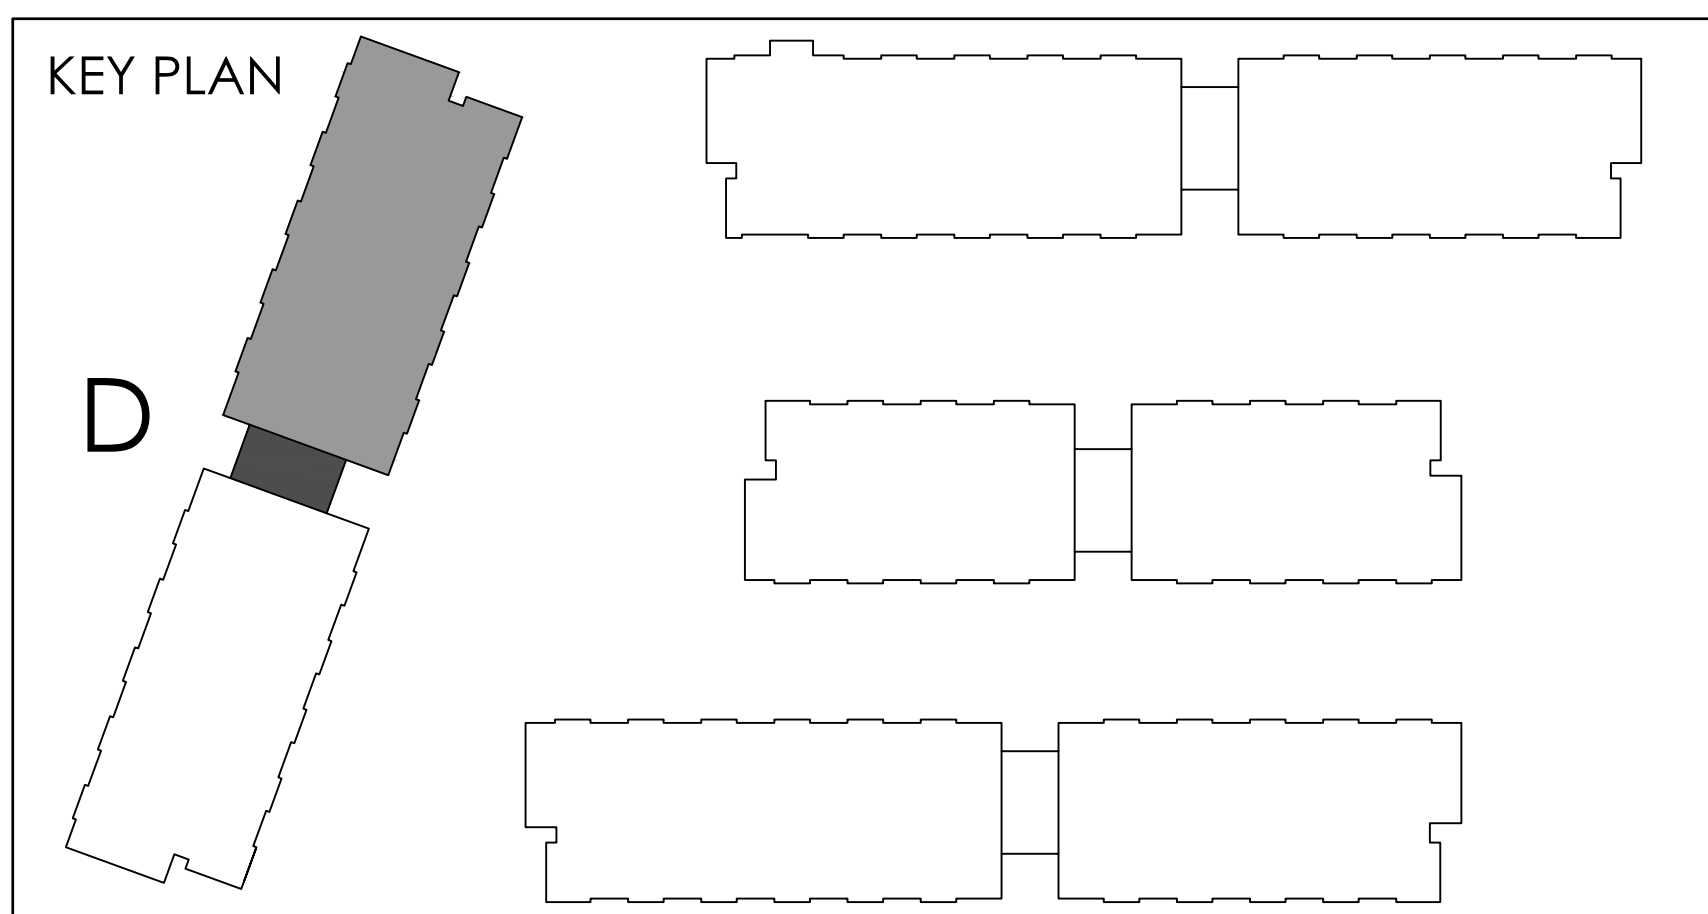

THIS DRAWING, AS AN INSTRUMENT OF SERVICE, IS PROVIDED BY AND IS THE PROPERTY OF GRAZIANI-CORAZZA ARCHITECTS INC. THE CONTRACTOR MUST VERIFY AND ACCEPT RESPONSIBILITY FOR ALL DIMENSIONS AND COORDINATING ON SITE AND MUST NOTIFY GRAZIANI-CORAZZA ARCHITECTS INC. OF ANY VARIATIONS FROM THE SUPPLIED INFORMATION. GRAZIANI-CORAZZA ARCHITECTS INC. IS NOT RESPONSIBLE FOR THE ACCURACY OF SURVEY, STRUCTURAL, MECHANICAL, ELECTRICAL, AND OTHER ENGINEERING INFORMATION SHOWN ON THIS DRAWING. REFER TO THE APPROPRIATE ENGINEERING DRAWINGS BEFORE PROCEEDING WITH THE WORK. CONSTRUCTION MUST COMPLY TO ALL APPLICABLE CODES AND REQUIREMENTS OF THE AUTHORITIES HAVING JURISDICTION. UNLESS OTHERWISE NOTED, NO INVESTIGATION HAS BEEN UNDERTAKEN OR REPORTED ON BY THIS OFFICE IN REGARDS TO THE ENVIRONMENTAL CONDITION OF THIS SITE.

THIS DRAWING IS NOT TO BE SCALED. ALL ARCHITECTURAL SYMBOLS INDICATED ON THIS DRAWING ARE GRAPHIC REPRESENTATIONS ONLY.

CONDITIONS FOR ELECTRONIC INFORMATION TRANSFER:

ELECTRONIC INFORMATION IS SUPPLIED TO THE OTHER ASSOCIATED FIRMS TO ASSIST THEM IN THE EXECUTION OF THEIR WORK. REVIEW THE RECEIVED FIRMS MUST DETERMINE THE COMPLETENESS, APPROPRIATENESS, RELIANCE OF THE INFORMATION IN RESPECT TO THEIR PARTICULAR RESPONSIBILITY.

GRAZIANI-CORAZZA ARCHITECTS INC. SHALL NOT BE RESPONSIBLE FOR ERRORS, OMISSIONS, INCOMPLETENESS DUE TO USE OF INFORMATION IN WHOLE OR PART, WHEN INFORMATION IS TRANSFERRED.

1. TRANSMISSION OF ANY VIEWS OR DAMAGE TO THE RECEIVING ELECTRONIC SYSTEM WHEN INFORMATION IS TRANSFERRED.


01. Oct.07.2019 issued for tender
02. Mar.13.2020 issued for design coordination #2
03. Mar.16.2020 issued for addendum #2
04. Mar.16.2020 issued for addendum #3
05. Aug.24.2020 issued for addendum #4
06. Sept.28.2020 issued for permit
07. Oct.20.2020 issued for addendum #5
08. Nov.23.2020 issued for addendum #6
09. Dec.14.2020 issued for addendum #7



SOUTH ELEVATION 1
1:100 A403




NORTH ELEVATION 2
1:100 A403

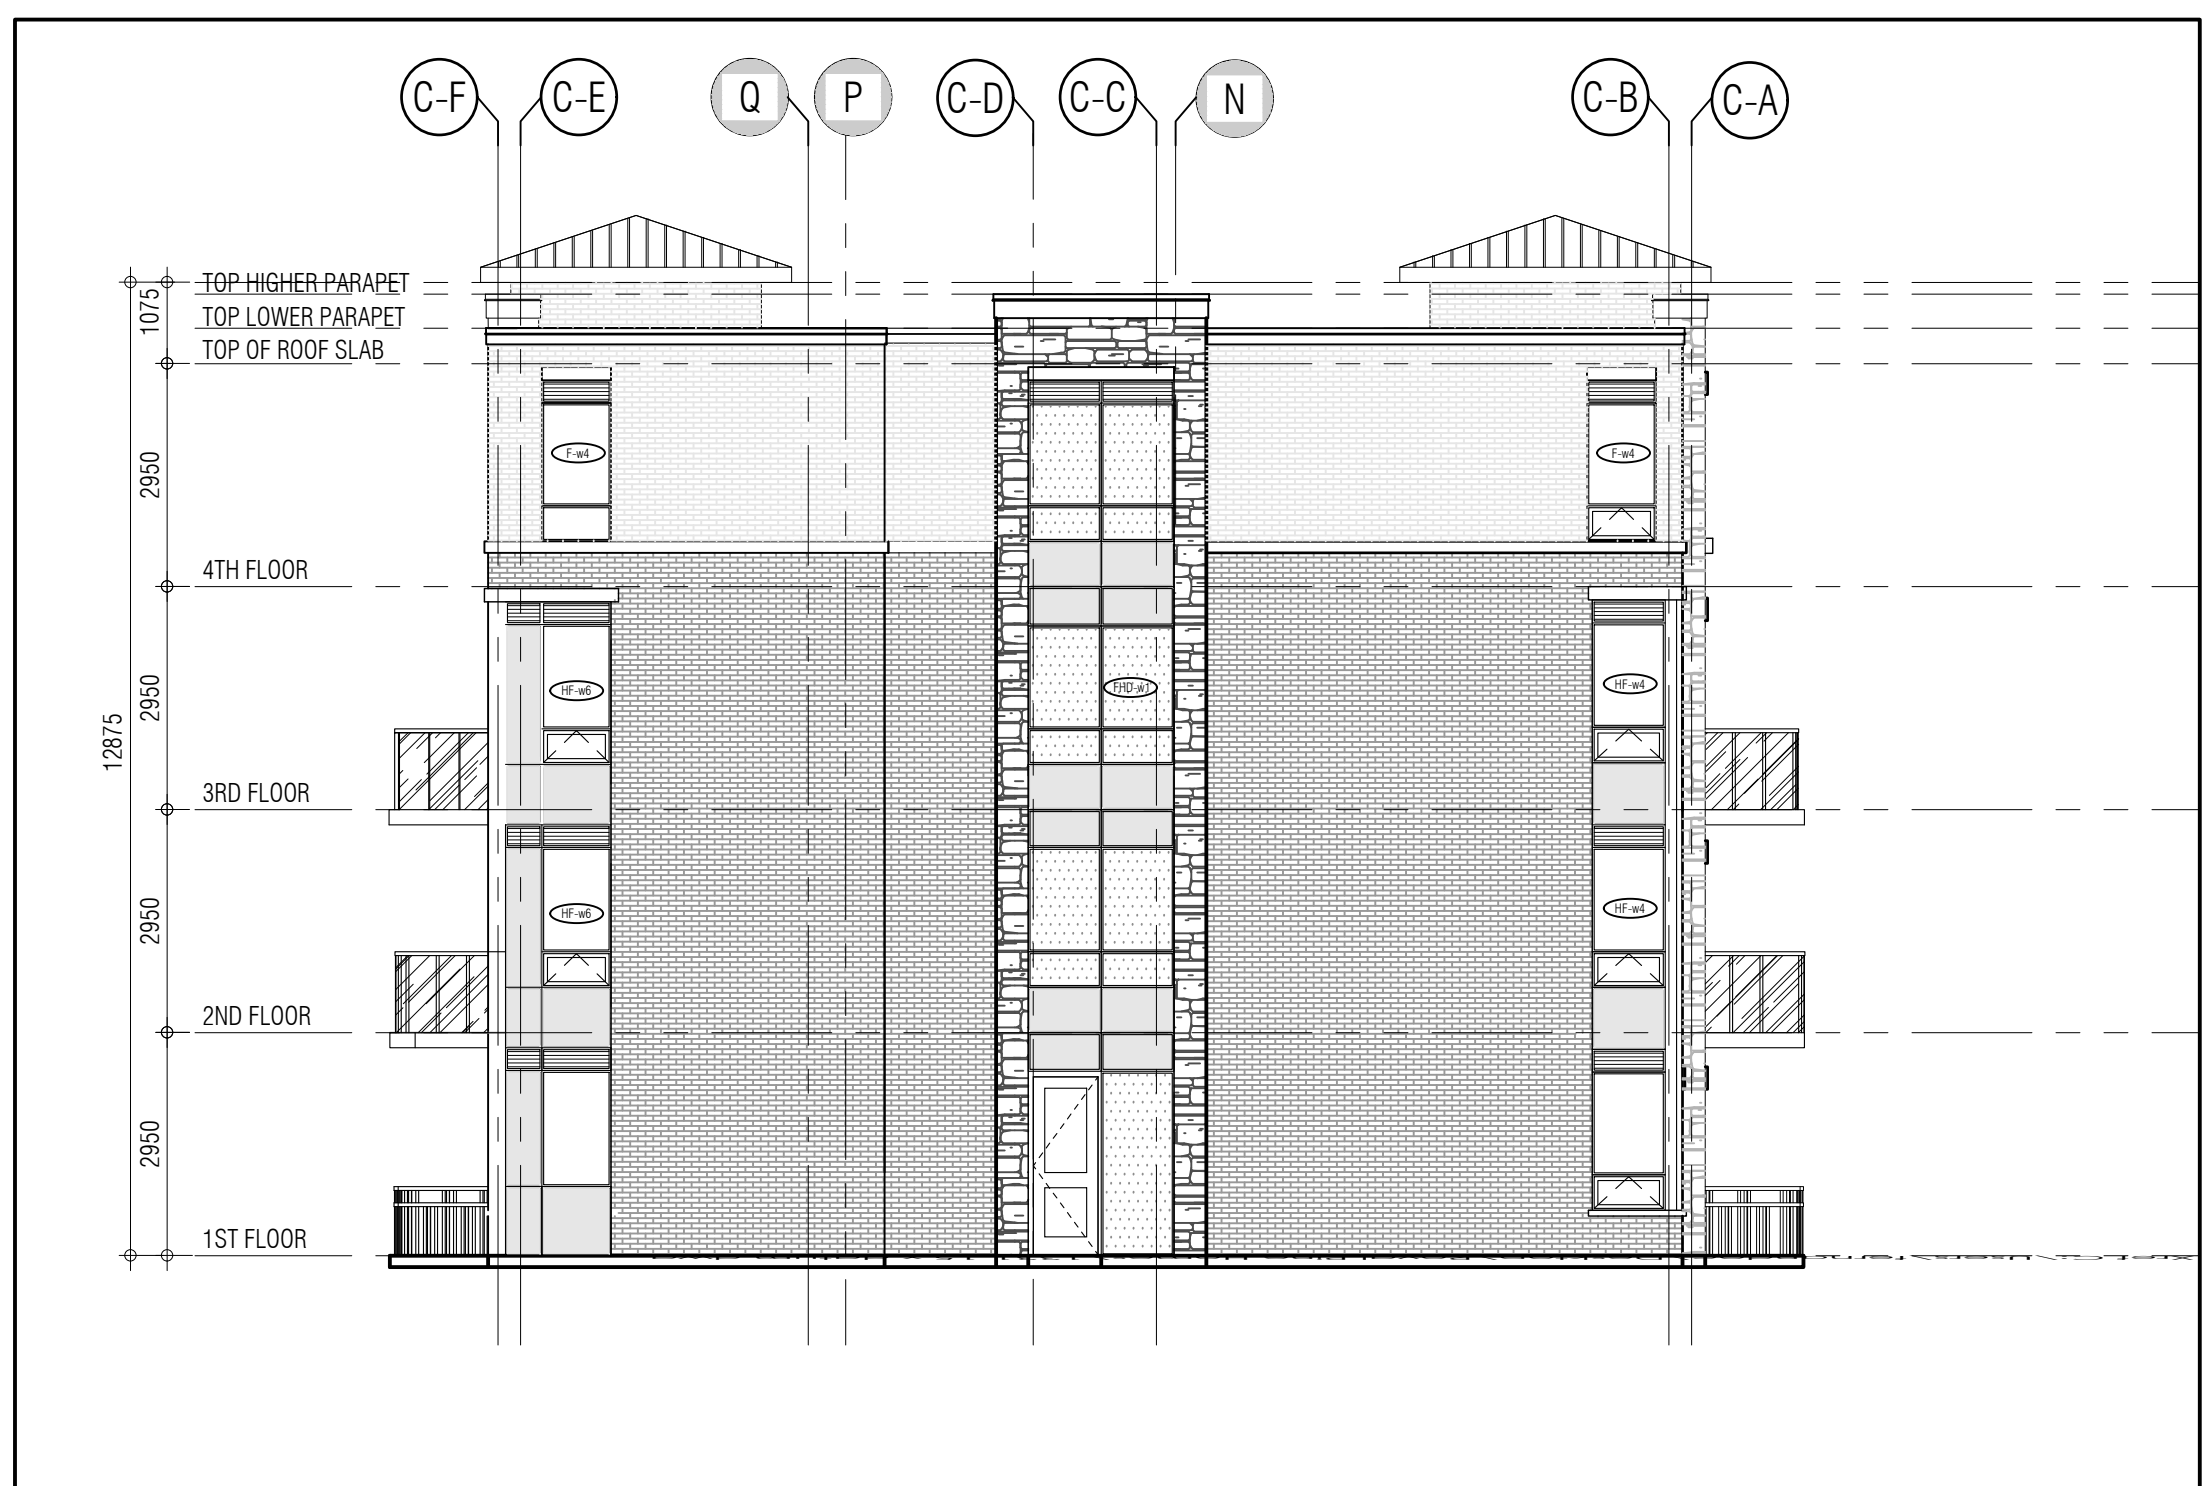

EAST ELEVATION 3
1:100 A403



WEST ELEVATION 4
1:100 A403

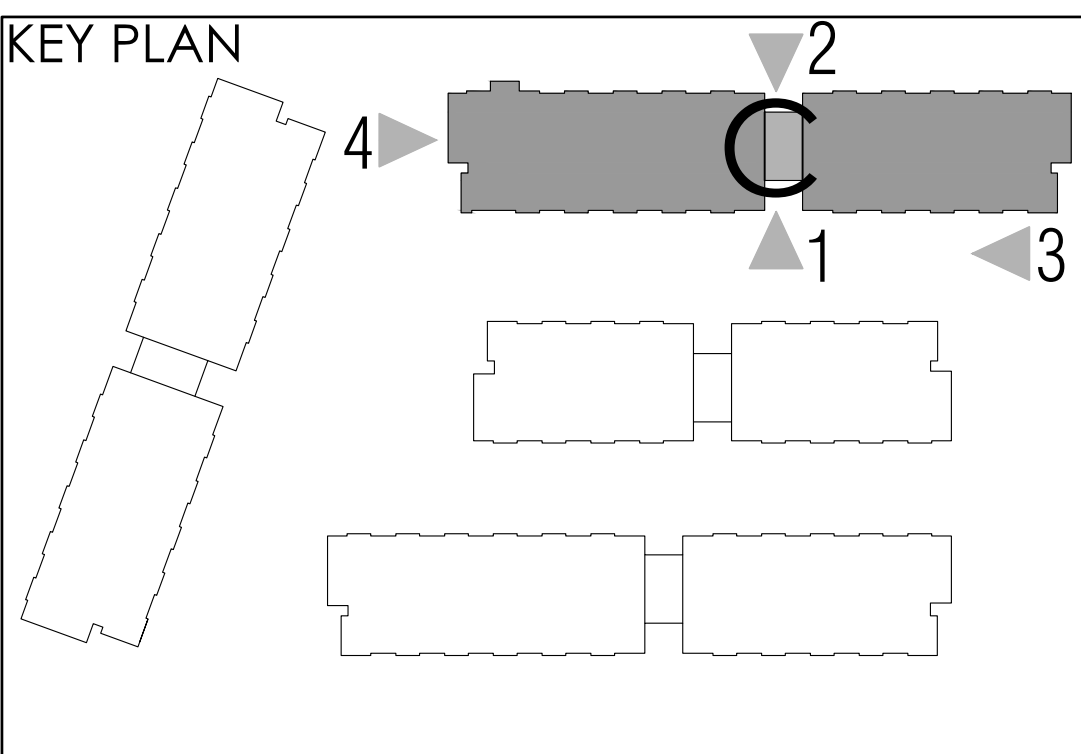

Issued for revisions

GRAZIANI CORAZZA ARCHITECTS

BERNARD L. CORAZZA
ARCHITECT
LICENCE
46584

1333 SHAWANIGA DRIVE, SUITE 109 MISSISSAUGA, ONTARIO L4W 1C3
905.760.2801 P.905.760.2804 WWW.GC-ARCHITECTS.COM

RESIDENTIAL

ATTMAR + PALLESCI DRIVE



BRAMPTON ONTARIO

PROJECT ARCHITECT: B. GRAZIANI
ASSISTANT DESIGNER: R. LINCOLN
DRAWN BY: G. C. F. C. M. B.
CHECKED BY: D. BIASE / G. COLANGELO
PLOT DATE: DEC. 13. 2020
JOB # 1331.15

BUILDING C ELEVATIONS
OVERALL ELEVATIONS

1:100 A403

TITLE BLOCK SIZE: 915 x 1200

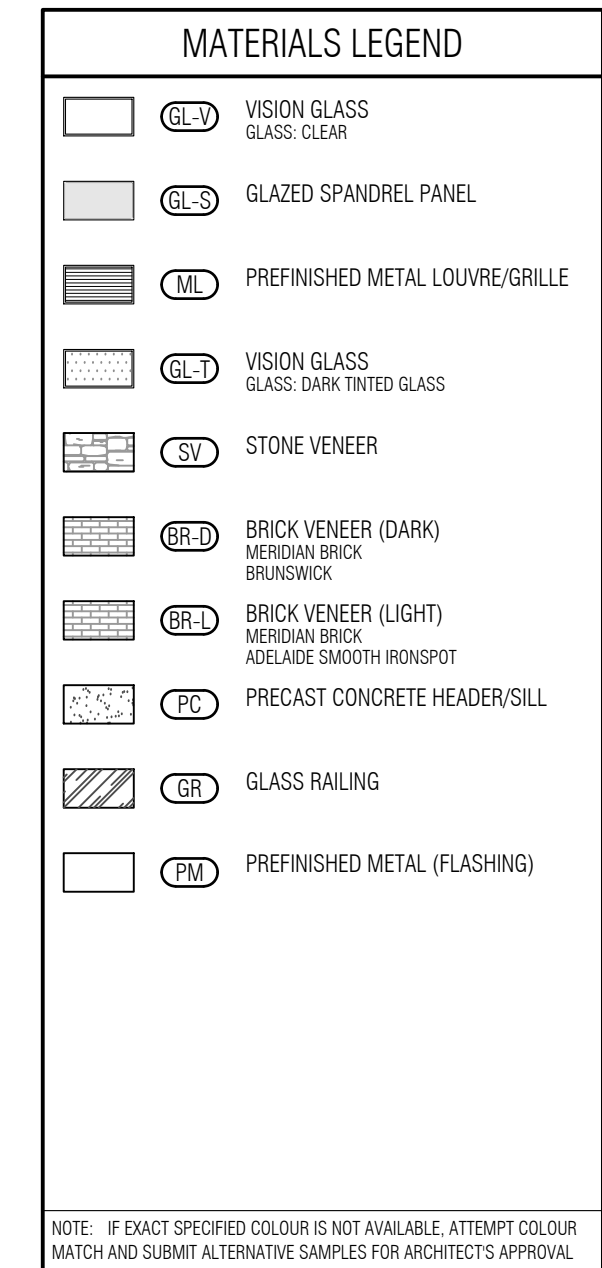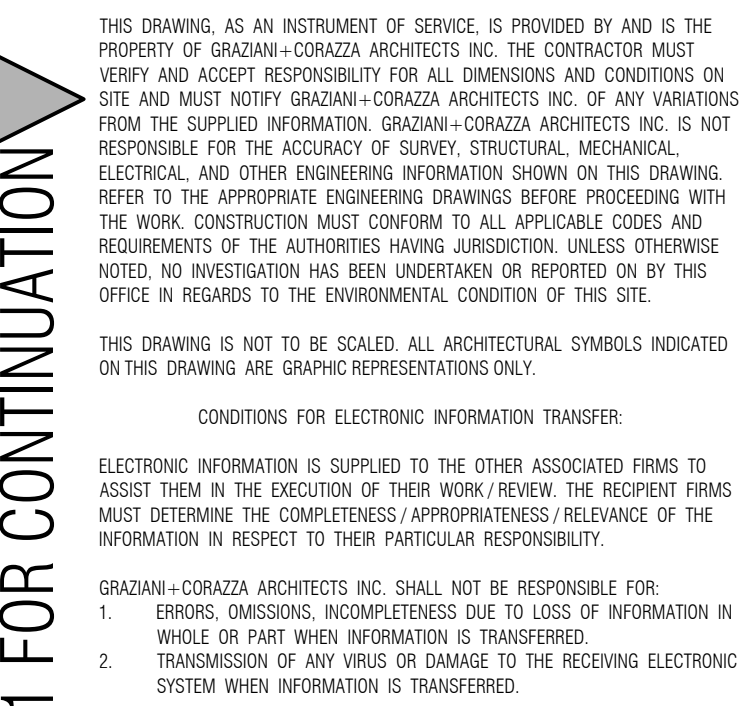

SSUED for revisions



**GRAZIANI
CORAZZA
ARCHITECTS**





ONTARIO

RESIDENTIAL

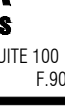

ATTARW + PALLESCHOW DRIVE

ORIGINATOR

PROJECT ARCHITECT:

ASSISTANT DESIGNER:

DRAWN BY:

CHECKED BY:

DATE:

PROJECT DATE:

**B. GRAZIANI
R. LINCOLN
G.C.F.C./M.B
D. BIASE/ G. COLOANGELO**

DEC. 12.2020

1331.15

ONTARIO

01.	Oct.07.2019	issued for tender	—
02.	Mar.13.2020	issued for design coordination #2	—
03.	Mar.16.2020	issued for addendum #2	—
04.	Mar.16.2020	issued for addendum #3	—
05.	Aug.24.2020	issued for addendum #4	—
06.	Sept. 28.2020	issued for permit	bg
07.	Oct.20.2020	issued for addendum #5	bg
08.	Nov.23.2020	issued for addendum #6	bg
09.	Dec.14.2020	issued for addendum #7	bg



issued for revisions 		+	
RESIDENTIAL			
			
ATTMAR & PALLADES DRIVE		ONTARIO	
BRAMPTON			
PROJECT ARCHITECT:		G. GRAZZANI	
ASSISTANT DESIGNER:		R. LINCOLN	
DRAWN BY:		G. F. C. / M. B.	
CHECKED BY:		D. BRASE / G. COLANGELO	
DATE:		DEC. 13, 2020	
PLLOT DATE:		12/31/15	

50 A-403c2

TITLEBLOCK SIZE: 915 x 1200

THIS DRAWING IS NOT TO BE SCALED. ALL ARCHITECTURAL SYMBOLS INDICATED ON THIS DRAWING ARE GRAPHIC REPRESENTATIONS ONLY.

CONDITIONS FOR ELECTRONIC INFORMATION TRANSFER:

ELECTRONIC INFORMATION IS SUPPLIED TO THE OTHER ASSOCIATED FIRMS TO ASSIST THEM IN THE EXECUTION OF THEIR WORK. REVIEW, THE RECENT FIRMS MUST DETERMINE THE COMPLETENESS/APPROPRIATENESS/RELEVANCE OF THE INFORMATION IN RESPECT TO THEIR PARTICULAR RESPONSIBILITY.


- 1. ERRORS/OMISSIONS/INCOMPLETENESS DUE TO LOSS OF INFORMATION IN WHOLE OR PART WHEN INFORMATION IS TRANSFERRED.



THIS DRAWING, AS AN INSTRUMENT OF SERVICE, IS PROVIDED BY AND IS THE PROPERTY OF GRAZIANI-CORAZZA ARCHITECTS INC. THE CONTRACTOR MUST VERIFY AND ACCEPT RESPONSIBILITY FOR ALL DIMENSIONS AND COORDINATING ON SITE AND MUST NOTIFY GRAZIANI-CORAZZA ARCHITECTS INC. OF ANY VARIATIONS FROM THE SUPPLIED INFORMATION. GRAZIANI-CORAZZA ARCHITECTS INC. IS NOT RESPONSIBLE FOR THE ACCURACY OF SURVEY, STRUCTURAL, MECHANICAL, ELECTRICAL, AND OTHER ENGINEERING INFORMATION SHOWN ON THIS DRAWING. REFER TO THE APPROPRIATE ENGINEERING DRAWINGS BEFORE PROCEEDING WITH THE WORK. CONSTRUCTION MUST COMPLY TO ALL APPLICABLE CODES AND REQUIREMENTS OF THE AUTHORITIES HAVING JURISDICTION. UNLESS OTHERWISE NOTED, NO MODIFICATION HAS BEEN UNDERTAKEN OR REPORTED BY OR THIS OFFICE IN REGARDS TO THE ENVIRONMENTAL CONDITION OF THIS SITE.




THIS DRAWING IS NOT TO BE SCALED. ALL ARCHITECTURAL SYMBOLS INDICATED ON THIS DRAWING ARE GRAPHIC REPRESENTATIONS ONLY.

CONDITIONS FOR ELECTRONIC INFORMATION TRANSFER:

ELECTRONIC INFORMATION IS SUPPLIED TO THE OTHER ASSOCIATED FIRMS TO ASSIST THEM IN THE EXECUTION OF THEIR WORK. REVIEW THE RECEIVED FIRMS MUST DETERMINE THE COMPLETENESS, APPROPRIATENESS, RELIANCE OF THE INFORMATION IN RESPECT TO THEIR PARTICULAR RESPONSIBILITY.

GRAZIANI-CORAZZA ARCHITECTS INC. SHALL NOT BE RESPONSIBLE FOR ERRORS, OMISSIONS, INCOMPLETENESS DUE TO USE OF INFORMATION IN WHOLE OR PART, WHEN INFORMATION IS TRANSMITTED.

TRANSMISSION OF ANY VIEWS OR DAMAGE TO THE RECEIVING ELECTRONIC SYSTEM WHEN INFORMATION IS TRANSMITTED.

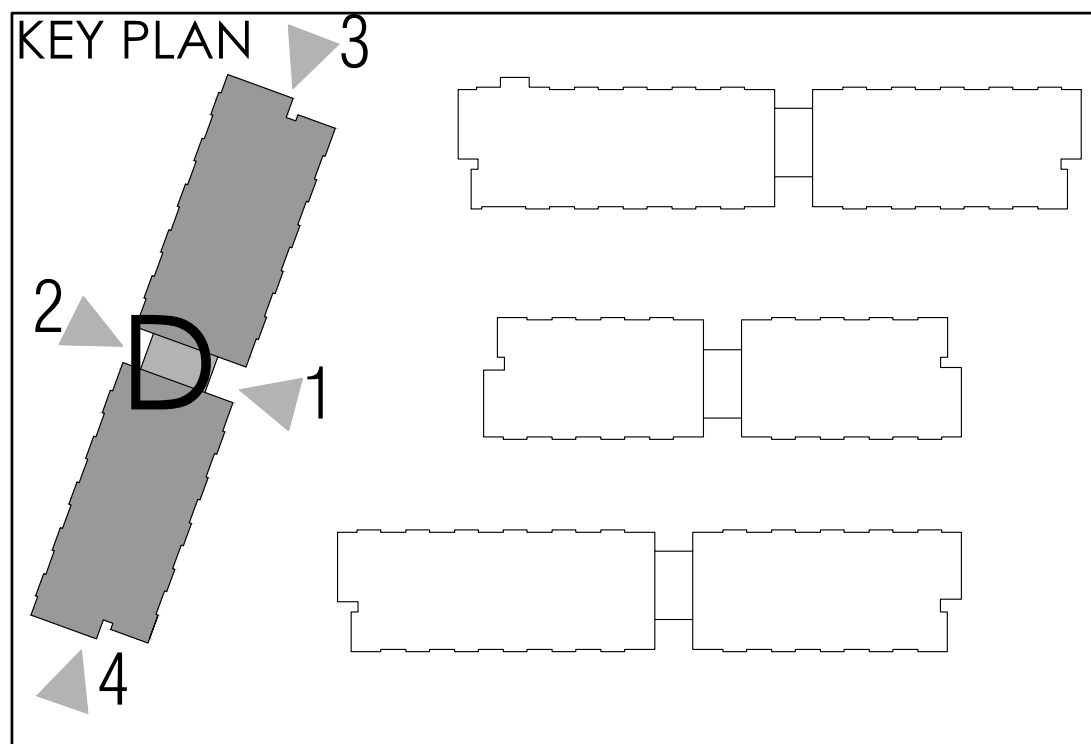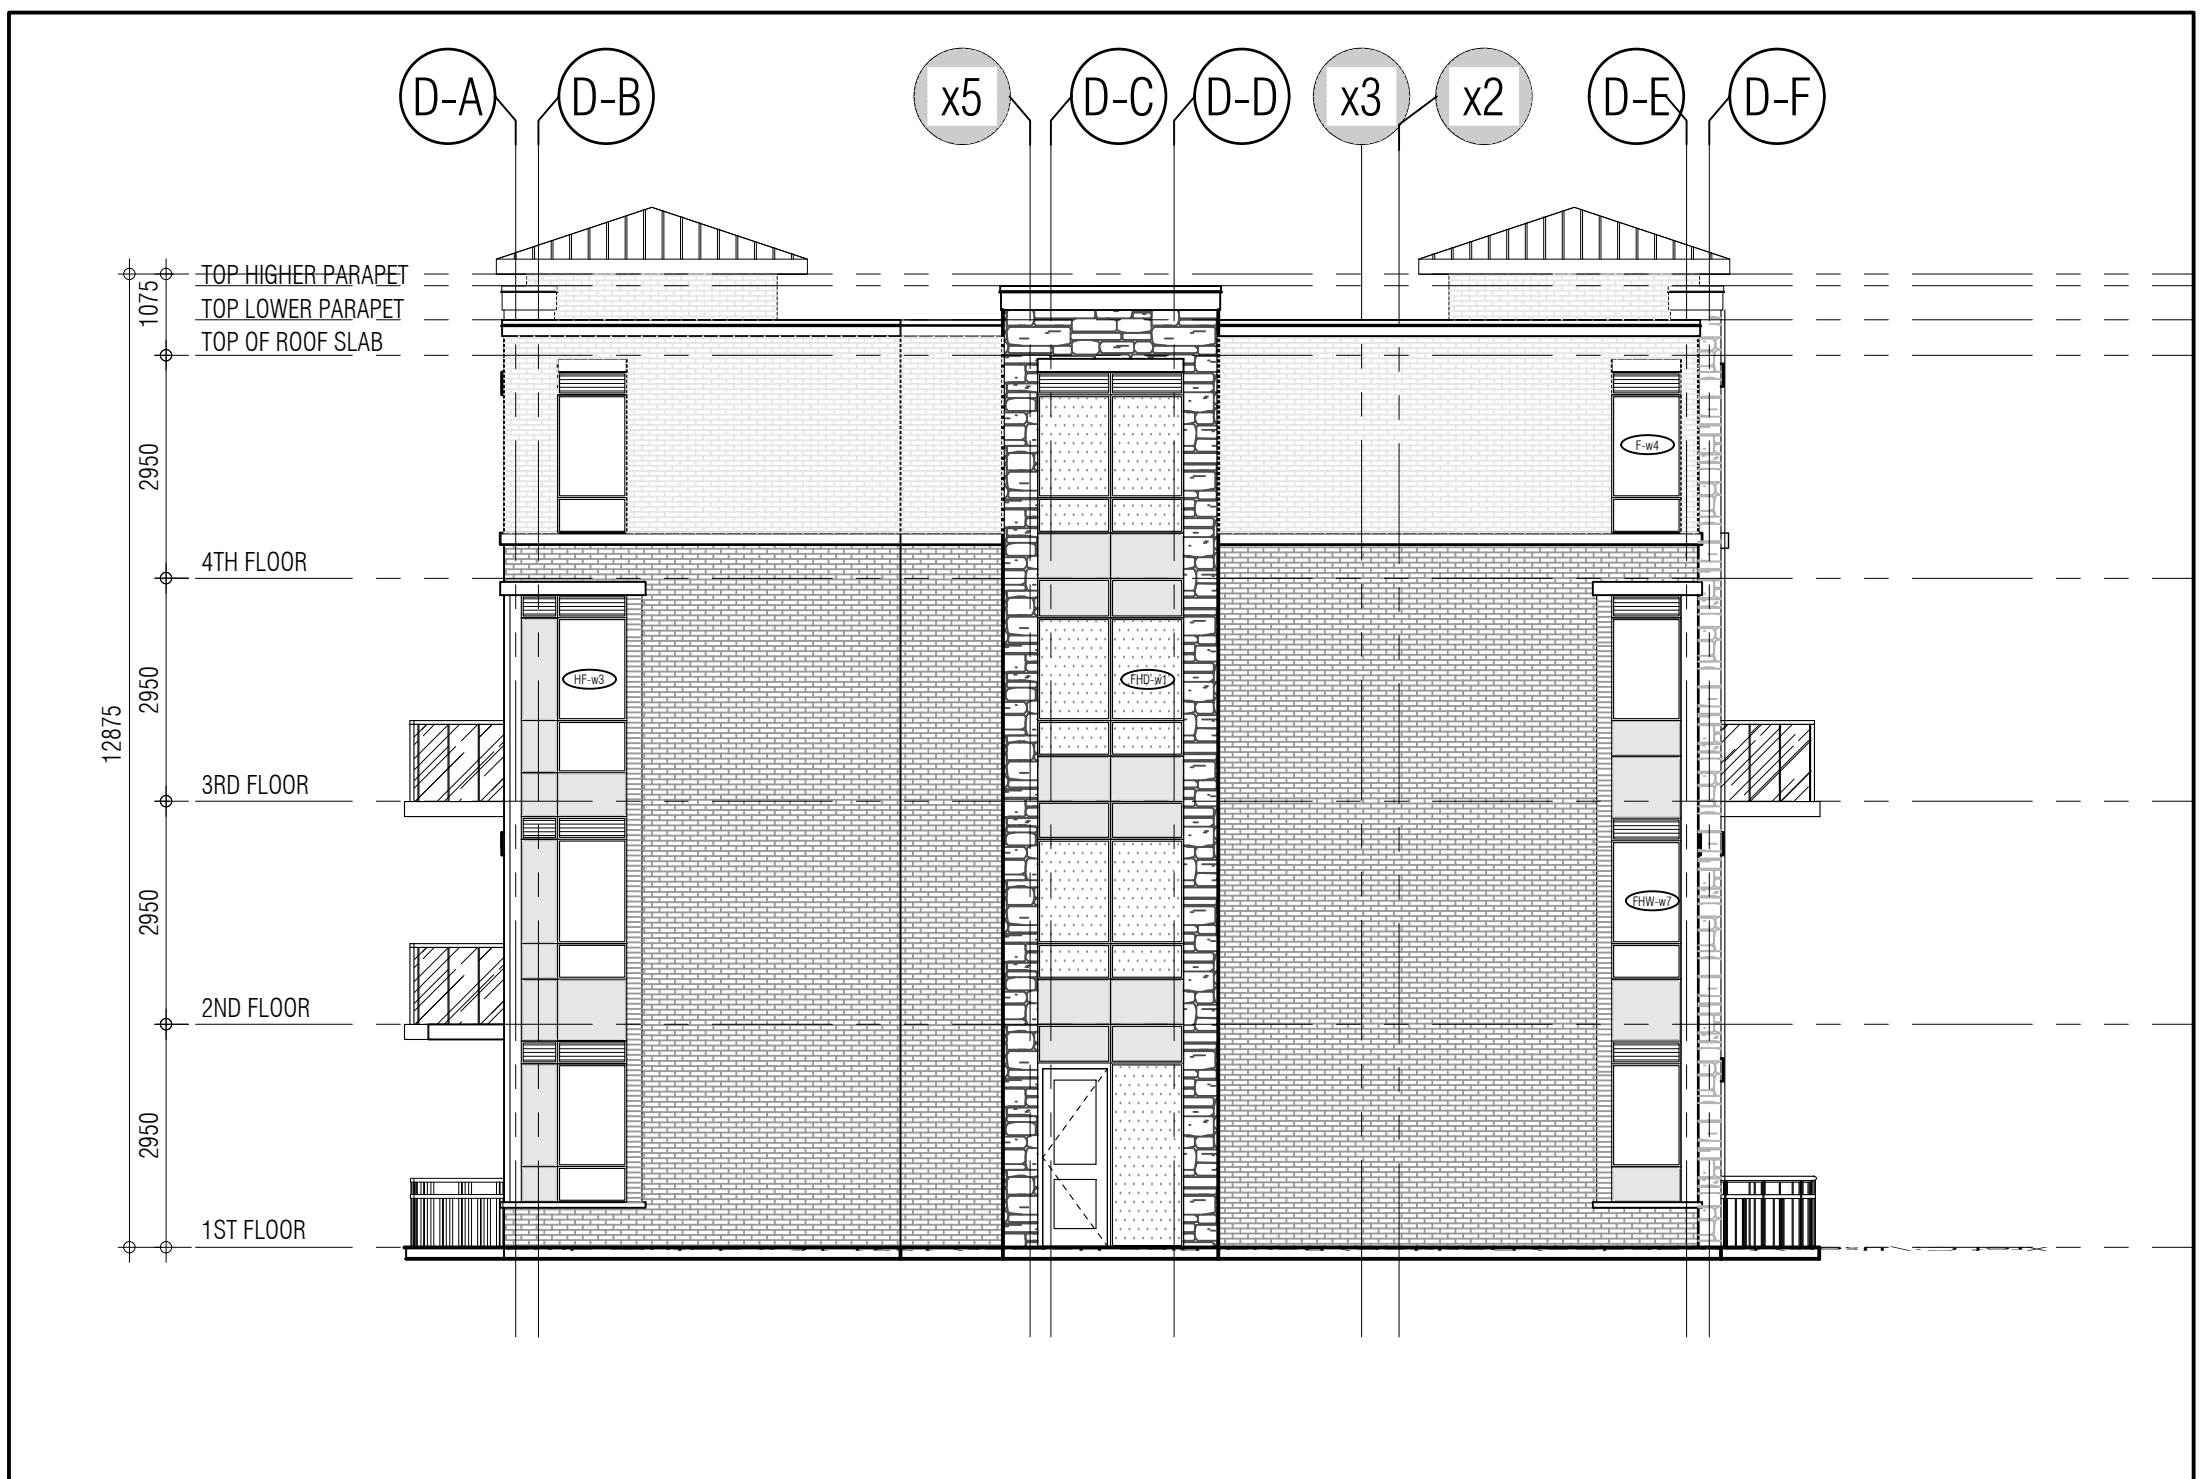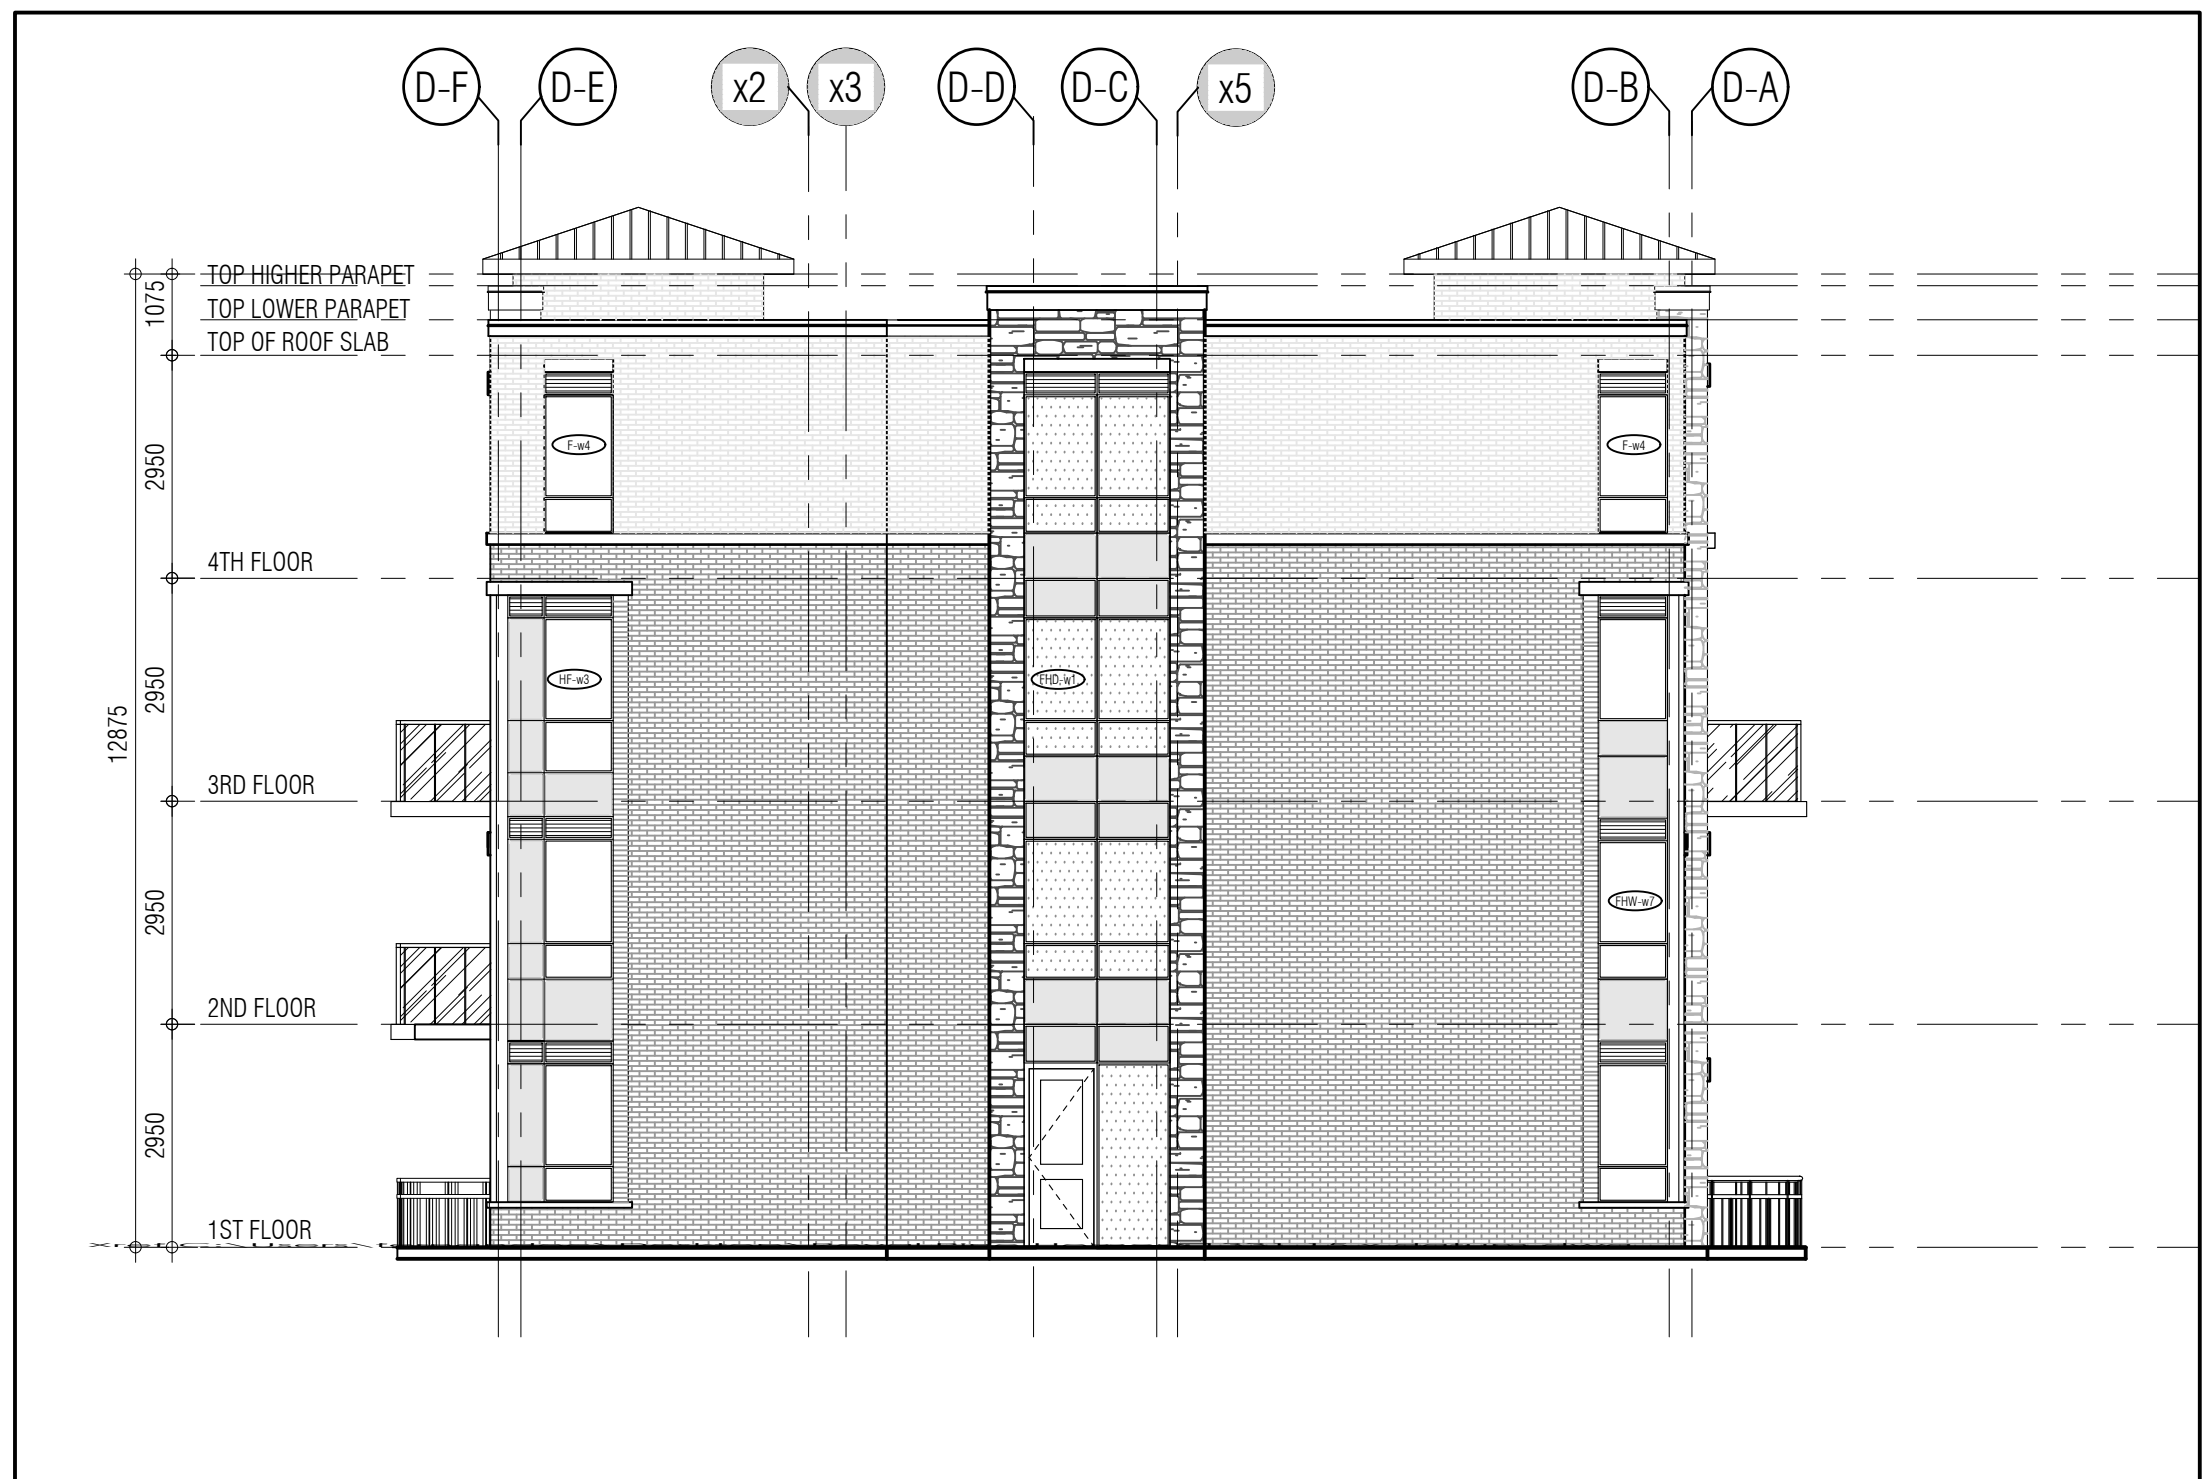

- 01. Oct.07.2019 issued for tender
- 02. Mar.13.2020 issued for design coordination #2
- 03. Mar.16.2020 issued for addendum #2
- 04. Mar.16.2020 issued for addendum #3
- 05. Aug.24.2020 issued for addendum #4
- 06. Sept.28.2020 issued for permit
- 07. Oct.20.2020 issued for addendum #5
- 08. Nov.23.2020 issued for addendum #6
- 09. Dec.14.2020 issued for addendum #7

ISSUED FOR REVISIONS

GRAZIANI CORAZZA ARCHITECTS

1331 SHAWANAGA DRIVE, SUITE 100 MISSISSAUGA, ONTARIO L4W 1C3
905.760.2901 P.905.760.2904 WWW.GC-ARCHITECTS.COM

RESIDENTIAL

ATTMAR + PALLESCCHI DRIVE

BRAMPTON ONTARIO

PROJECT ARCHITECT: B. GRAZIANI
ASSISTANT DESIGNER: R. LINCOLN
DRAWN BY: G. C. F. / M. B.
CHECKED BY: D. BIASE / G. COLANGELO
PLOT DATE: DEC. 13. 2020
JOB # 1331.15

**BUILDING D ELEVATIONS
OVERALL ELEVATIONS**

1:100 A404

TITLE BLOCK SIZE: 915 x 1200

THIS DRAWING, AS AN INSTRUMENT OF SERVICE, IS PROVIDED BY AND IS THE PROPERTY OF GRAZIANI-CORAZZA ARCHITECTS INC. THE CONTRACTOR MUST VERIFY AND ACCEPT RESPONSIBILITY FOR ALL DIMENSIONS AND COORDINATING ON SITE AND MUST NOTIFY GRAZIANI-CORAZZA ARCHITECTS INC. OF ANY DISCREPANCIES FROM THE SUPPLIED INFORMATION. GRAZIANI-CORAZZA ARCHITECTS INC. IS NOT RESPONSIBLE FOR THE ACCURACY OF SURVEY, STRUCTURAL, MECHANICAL, ELECTRICAL, AND OTHER ENGINEERING INFORMATION SHOWN ON THIS DRAWING. REFER TO THE APPROPRIATE ENGINEERING DRAWINGS BEFORE PROCEEDING WITH THE WORK. CONSTRUCTION MUST COMPLY TO ALL APPLICABLE CODES AND REQUIREMENTS OF THE AUTHORITIES HAVING JURISDICTION, UNLESS OTHERWISE NOTED. NO MODIFICATION HAS BEEN MADE TO THIS DRAWING OR ANY OF THE OFFICE IN REGARD TO THE ENVIRONMENTAL CONDITION OF THIS SITE.

THIS DRAWING IS NOT TO BE SCALED. ALL ARCHITECTURAL SYMBOLS INDICATED ON THIS DRAWING ARE GRAPHIC REPRESENTATIONS ONLY.

CONDITIONS FOR ELECTRONIC INFORMATION TRANSFER:

ELECTRONIC INFORMATION IS SUPPLIED TO THE OTHER ASSOCIATED FIRMS TO ASSIST THEM IN THE EXECUTION OF THEIR WORK. REVIEW THE RECEIVED FIRMS MUST DETERMINE THE COMPLETENESS, APPROPRIATENESS, RELIANCE OF THE INFORMATION IN RESPECT TO THEIR PARTICULAR RESPONSIBILITY.

GRAZIANI-CORAZZA ARCHITECTS INC. SHALL NOT BE RESPONSIBLE FOR ERRORS, OMISSIONS, INCOMPLETENESS DUE TO USE OF INFORMATION IN WHOLE OR PART, WHEN INFORMATION IS TRANSFERRED.

TRANSMISSION OF ANY FILES OR DAMAGE TO THE RECEIVING ELECTRONIC SYSTEM WHEN INFORMATION IS TRANSFERRED.

01. Oct.07.2019 issued for tender
02. Mar.13.2020 issued for design coordination #2
03. Mar.16.2020 issued for addendum #2
04. Mar.16.2020 issued for addendum #3
05. Aug.24.2020 issued for addendum #4
06. Sept.28.2020 issued for permit
07. Oct.20.2020 issued for addendum #5
08. Nov.23.2020 issued for addendum #6
09. Dec.14.2020 issued for addendum #7

MATERIALS LEGEND	
	VISION GLASS (ALUM. CLEAR)
	GLAZED SPANDREL PANEL
	PREFINISHED METAL LOUVER/GRILLE
	VISION GLASS (ALUM. LOW IRON)
	STONE VENEER
	BRICK VENEER (DARK)
	BRICK VENEER (LIGHT)
	PRECAST CONCRETE HEADER/CILL
	GLASS RAILING
	PREFINISHED METAL (FLASHING)

NOTE: IF EXACT SPECIFIED COLOUR IS NOT AVAILABLE, ATTEMPT COLOUR MATCH AND SUBMIT EXISTING SAMPLES FOR ARCHITECT'S APPROVAL.

Issued for revisions

ONTARIO ASSOCIATION OF ARCHITECTS

GRAZIANI CORAZZA ARCHITECTS

1333 SHAWANAGA DRIVE, SUITE 109 MISSISSAUGA, ONTARIO L4W 1C3
M5S 1W6 (905) 276-2901 FAX: (905) 276-2964 WWW.GC-ARCHITECTS.COM

RAFAEL CORAZZA
REGISTERED PROFESSIONAL ARCHITECT

ATTMAY + PALLESCHI DRIVE

BRAMPTON ONTARIO

PROJECT ARCHITECT: B. GRAZIANI

ASSISTANT DESIGNER: R. LINCOLN

DRAWN BY: G. C./F. C./M. B.

CHECKED BY: D. BIASI/G. COLANGELO

PLLOT DATE: DEC.13.2020

JOB #7 1331.15

EAST ELEVATION
BUILDING D

1:50 A-404d1

TITLEBLOCK SIZE: 915 x 1200

REF. 2-A-401a1 FOR CONTINUATION



BUILDING D-EAST ELEVATION 1
1:50 A-404d1

REF. 1-A-401a1 FOR CONTINUATION



BUILDING D-EAST ELEVATION 2
1:50 A-404d1

01.	Oct.07.2019	issued for tender	---
02.	Mar.13.2020	issued for design coordination #2	---
03.	Mar.16.2020	issued for addendum #2	---
04.	Mar.16.2020	issued for addendum #3	---
05.	Aug.24.2020	issued for addendum #4	---
06.	Sept. 28.2020	issued for permit	bg
07.	Oct.20.2020	issued for addendum #5	bg
08.	Nov.23.2020	issued for addendum #6	bg
09.	Dec.14.2020	issued for addendum #7	bg



TION/



ssued for revisions



**GRAZIANI
&
CORAZZA**
ARCHITECTS

1300 DAVENPORT DRIVE, SUITE 100
MISSISSAUGA, ONTARIO L4W 1C3
TEL: 905.709.7001 • F: 905.709.7844
WWW.GC-ARCHITECTS.COM

+


ONTARIO
OR
ARCHITECTS



BERARDINO E. GRAZIANI
LOREN
4884

MISSISSAUGA, ONTARIO L4W 1C3
WWW.GC-ARCHITECTS.COM

RESIDENTIAL

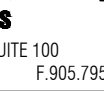

ATTIMAR & PALLESCH DRIVE

ONTARIO

BRAMPTON

PROJECT ARCHITECT:

ASSISTANT DESIGNER:

DRAWN BY:

CHECKED BY:

PLLOT DATE:

JOB #:

8. GRAZIANI

R. LINCOLN

G. F. C./M.B



D. BIASI, G. COLANGELO

DEC. 13, 2020

1331.15

1:50 A-404d2

TITLEBLOCK SIZE: 915 x 1200

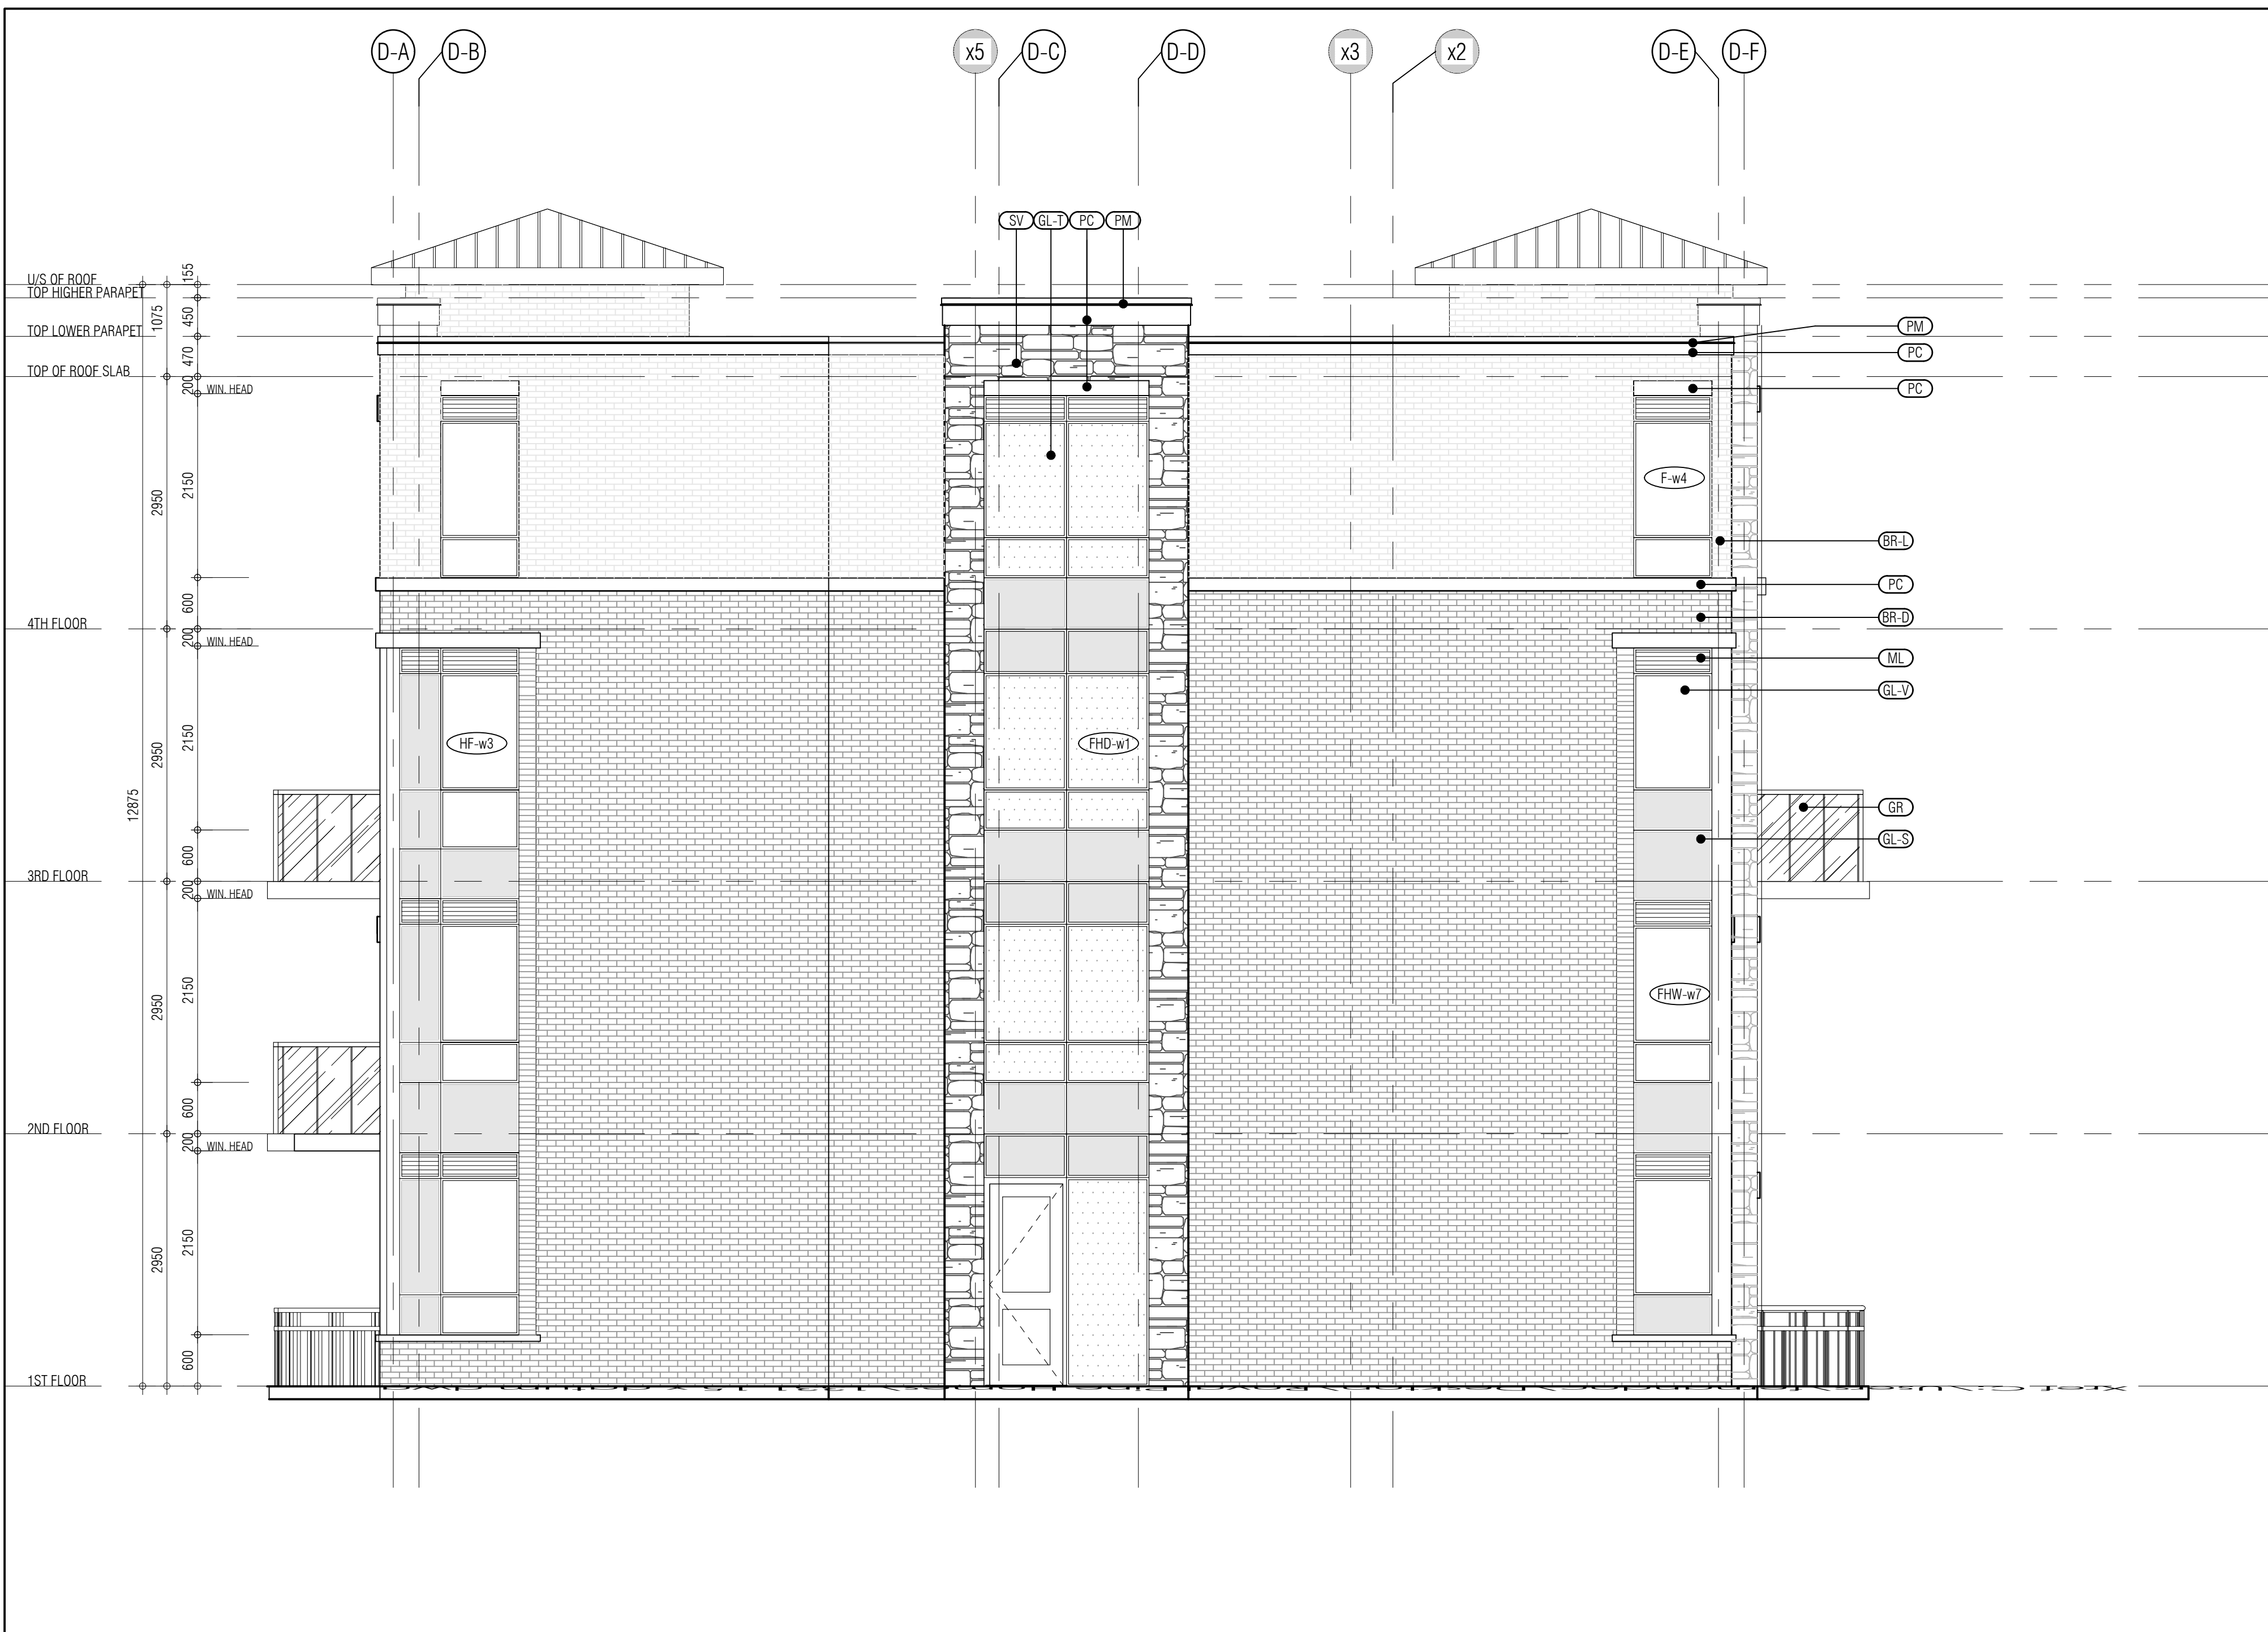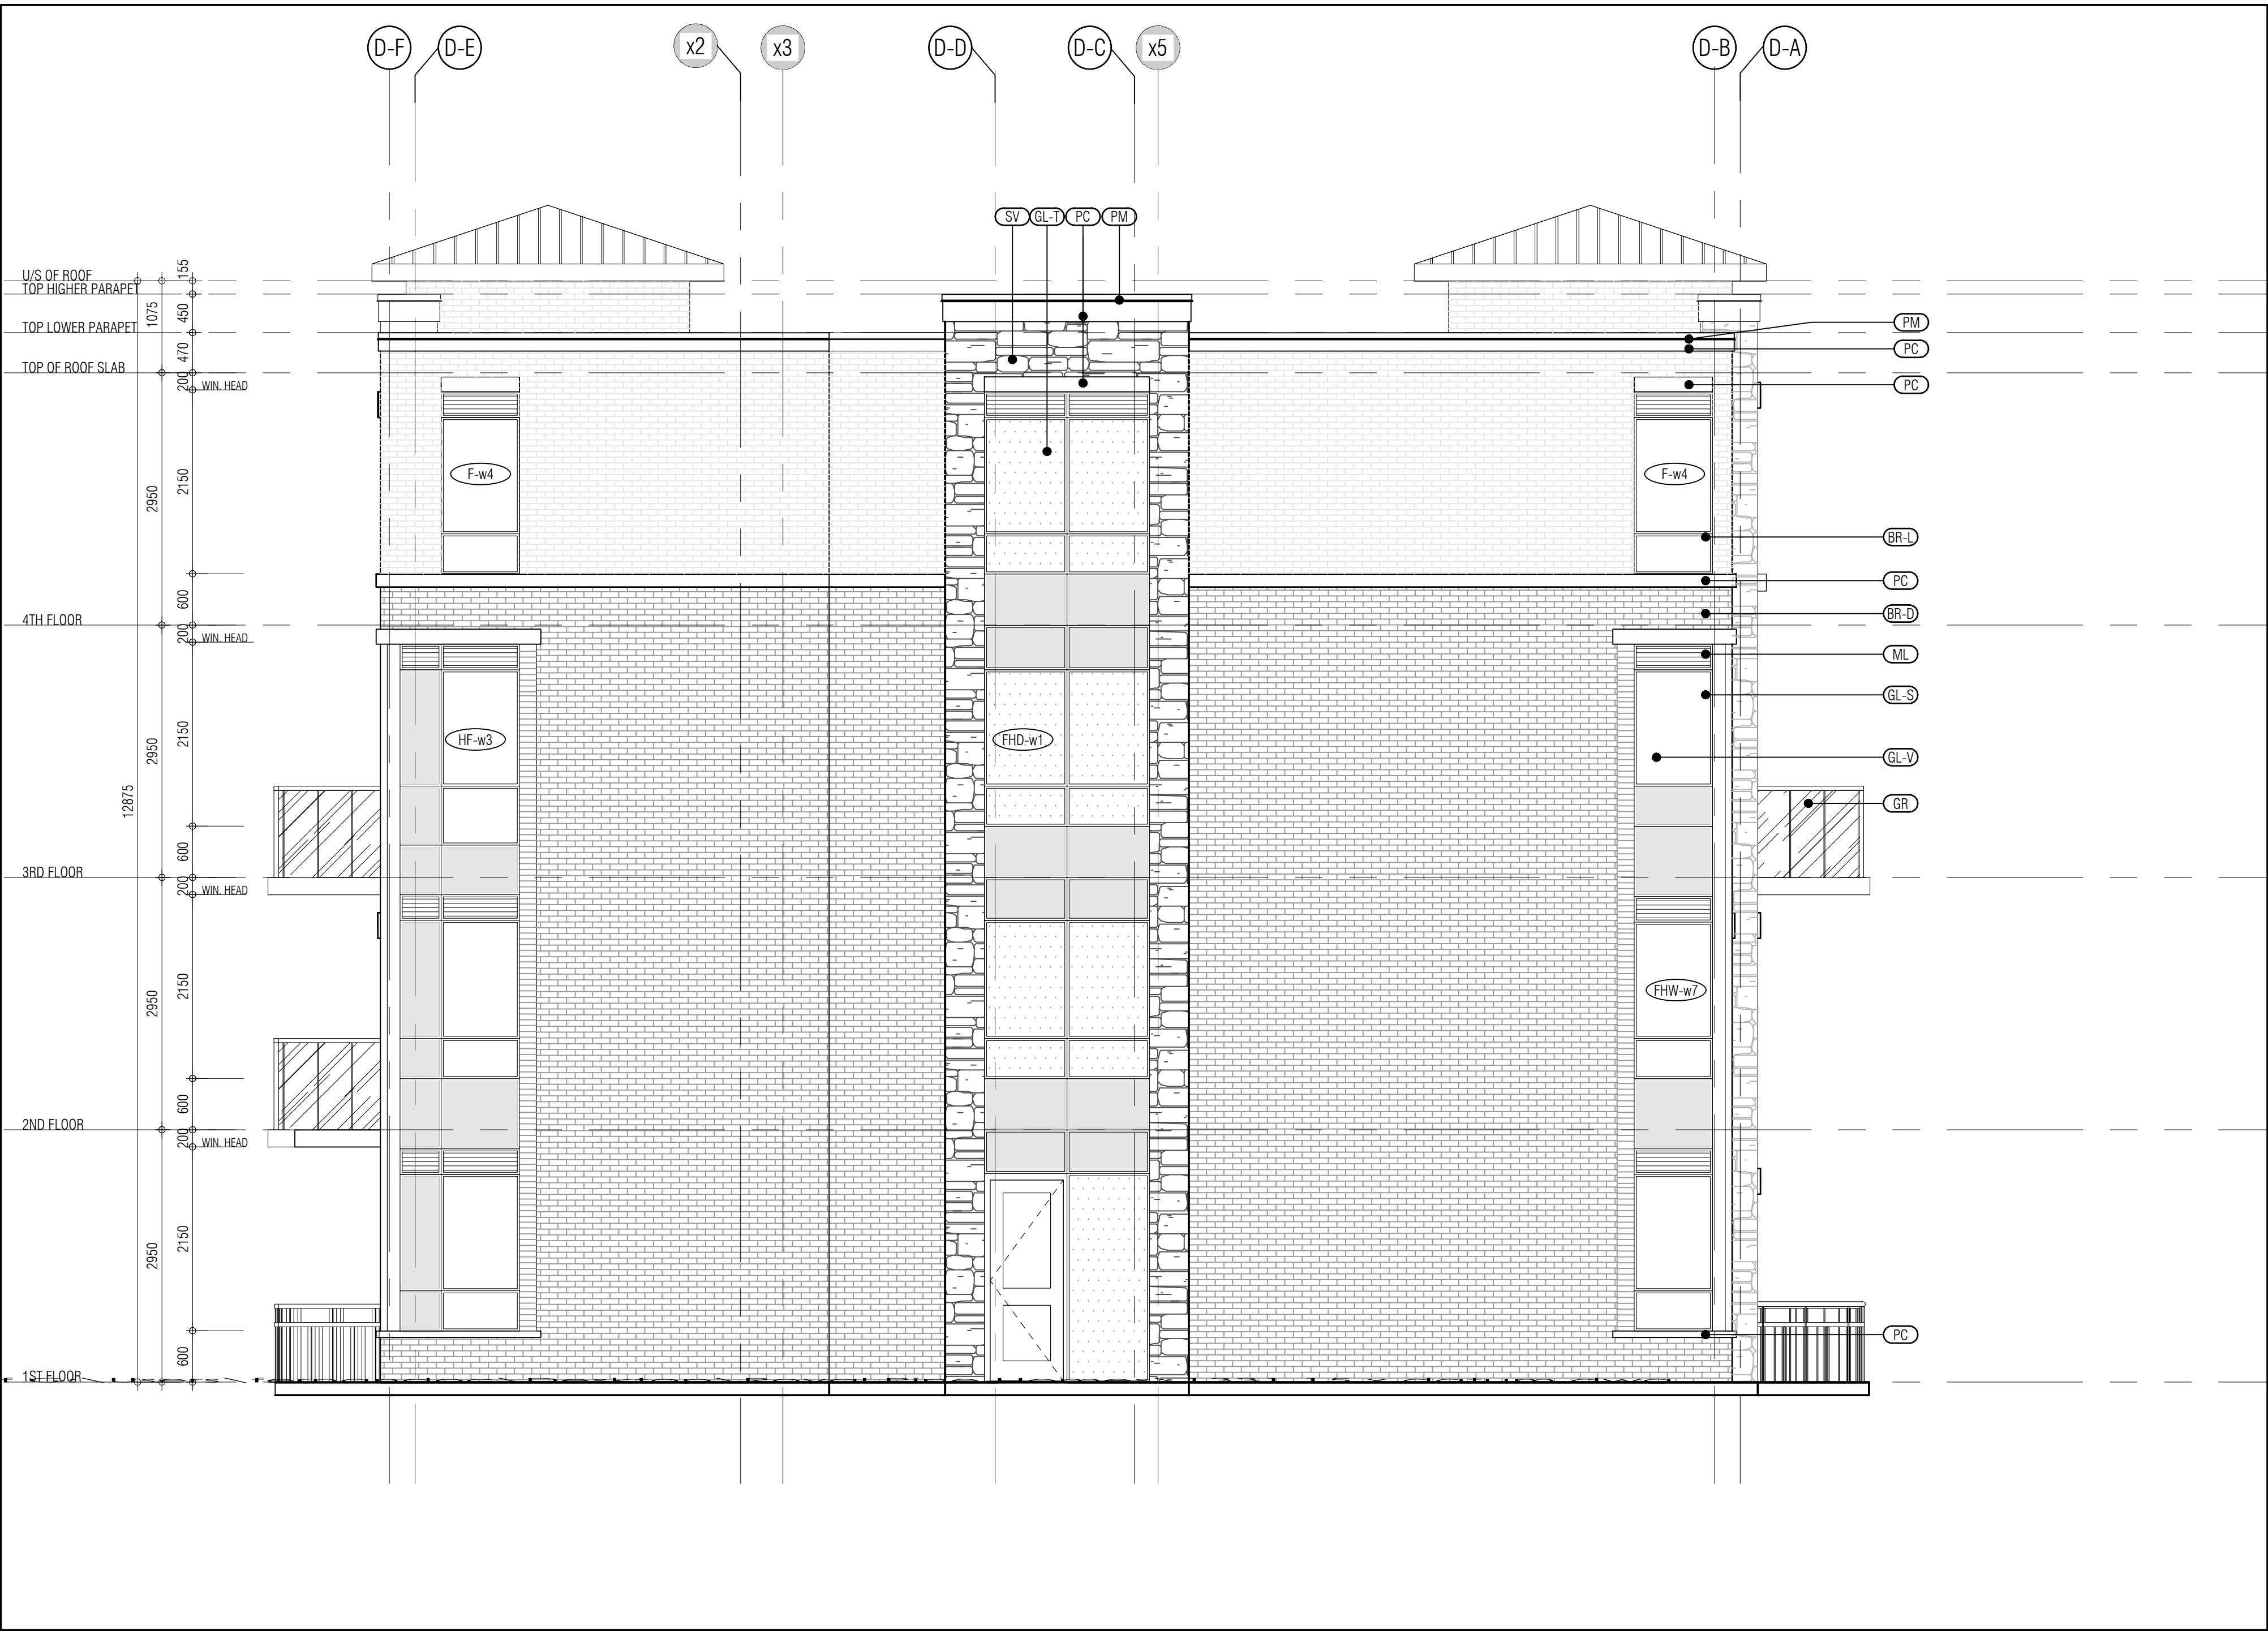

THIS DRAWING, AS AN INSTRUMENT OF SERVICE, IS PROVIDED BY AND IS THE PROPERTY OF GRAZIANI-CORAZZA ARCHITECTS INC. THE CONTRACTOR MUST VERIFY AND ACCEPT RESPONSIBILITY FOR ALL DIMENSIONS AND COORDINATING ON SITE AND MUST NOTIFY GRAZIANI-CORAZZA ARCHITECTS INC. OF ANY DISCREPANCIES FROM THE SUPPLIED INFORMATION. GRAZIANI-CORAZZA ARCHITECTS INC. IS NOT RESPONSIBLE FOR THE ACCURACY OF SURVEY, STRUCTURAL, MECHANICAL, ELECTRICAL, AND OTHER ENGINEERING INFORMATION SHOWN ON THIS DRAWING. REFER TO THE APPROPRIATE ENGINEERING DRAWINGS BEFORE PROCEEDING WITH THE WORK. CONSTRUCTION MUST COMPLY TO ALL APPLICABLE CODES AND REQUIREMENTS OF THE AUTHORITIES HAVING JURISDICTION, UNLESS OTHERWISE NOTED. NO MODIFICATION HAS BEEN INDICATED OR REPORTED BY OR BY THIS OFFICE IN REGARDS TO THE ENVIRONMENTAL CONDITION OF THIS SITE.

THIS DRAWING IS NOT TO BE SCALED. ALL ARCHITECTURAL SYMBOLS INDICATED ON THIS DRAWING ARE GRAPHIC REPRESENTATIONS ONLY.

CONDITIONS FOR ELECTRONIC INFORMATION TRANSFER:

ELECTRONIC INFORMATION IS SUPPLIED TO THE OTHER ASSOCIATED FIRMS TO ASSIST THEM IN THE EXECUTION OF THEIR WORK. REVIEW THE RECEIVED FIRMS MUST DETERMINE THE COMPLETENESS, APPROPRIATENESS, RELIANCE OF THE INFORMATION IN RESPECT TO THEIR PARTICULAR RESPONSIBILITY.

GRAZIANI-CORAZZA ARCHITECTS INC. SHALL NOT BE RESPONSIBLE FOR ERRORS, OMISSIONS, INCOMPLETENESS DUE TO USE OF INFORMATION IN WHOLE OR PART, WHEN INFORMATION IS TRANSFERRED.

1. TRANSMISSION OF ANY FILES OR CHANGE TO THE RECEIVING ELECTRONIC SYSTEM WHEN INFORMATION IS TRANSFERRED.

- | | | | |
|-----|--------------|-----------------------------------|-----|
| 01. | Oct.07.2019 | Issued for tender | --- |
| 02. | Mar.13.2020 | Issued for design coordination #2 | --- |
| 03. | Mar.16.2020 | Issued for addendum #2 | --- |
| 04. | Mar.16.2020 | Issued for addendum #3 | --- |
| 05. | Aug.24.2020 | Issued for addendum #4 | --- |
| 06. | Sept.28.2020 | Issued for permit | bq |
| 07. | Oct.20.2020 | Issued for addendum #5 | bq |
| 08. | Nov.23.2020 | Issued for addendum #6 | bq |
| 09. | Dec.14.2020 | Issued for addendum #7 | bq |

MATERIALS LEGEND	
	VISION GLASS (ALUM. SLUR)
	GLAZED SPANDREL PANEL
	PREFINISHED METAL LOUVER GRILLE
	VISION GLASS (ALUM. LOW-TINTED GLASS)
	STONE VENEER
	BRICK VENEER (DARK) MEDIUM BRICK BRICKWORK
	BRICK VENEER (LIGHT) MEDIUM BRICK BRICKWORK
	ALUMINUM BRICK BRICKWORK
	PREFRCAST CONCRETE HEADERS/ILL
	GLASS RAILING
	PREFINISHED METAL (FLASHING)

NOTE: IF EXACT SPECIFIED COLOUR IS NOT AVAILABLE, ATTEMPT COLOUR MATCH AND SUBMIT EXISTING SAMPLES FOR ARCHITECT'S APPROVAL.

Issued for revisions

**GRAZIANI
CORAZZA
ARCHITECTS**

1331 SHANNON DRIVE, SUITE 109 MISSISSAUGA, ONTARIO L4W 1C3
M5S 1W6 (2ND FLOOR) P: 905.299.2966 WWW.GC-ARCHITECTS.COM

ONTARIO ASSOCIATION
OF
ARCHITECTS

BERNARD L. CORAZZA
LICENSE
46584

RESIDENTIAL

ATTMOR + PALLESCHI DRIVE

BRAMPTON ONTARIO

PROJECT ARCHITECT: B. GRAZIANI
ASSISTANT DESIGNER: R. LINCOLN
DRAWN BY: G. C./F. C./M. B.
CHECKED BY: D. BIASI/G. COLANGELO
PLOT DATE: DEC.13.2020
JOB # 1331.15

**NORTH & SOUTH ELEVATION
BUILDING D**