



UNITED ENGINEERING INC
Mechanical and Electrical Consulting Engineers

3645 Keele St. #105
Toronto, ON, M3J 1M6
Email: info@u-eng.ca
T: (416) 398-1999
F: (416) 398-1933

SITE SUPPLEMENTAL INSTRUCTION

PROJECT: Forestside Estates
Attmar & Palleschi Drive
Brampton, Ontario

PROJECT NO.: 18-017

CONTRACT: Electrical

DATE: Apr. 19, 2021

SITE SI NO. E-2

THIS SITE SUPPLEMENTAL INSTRUCTION IS NOT TO BE CONSTRUED AS A CHANGE IN THE CONTRACT PRICE, BUT IS ISSUED FOR CLARIFICATION ONLY. IF A CHANGE IN CONTRACT PRICE IS PERCEIVED, PROVIDE AN ITEMIZED BREAKDOWN OF ANY EXTRAS OR CREDITS WITHIN SEVEN (7) WORKING DAYS.




PURPOSE: Revise per client request.

1.0 Reference Drawings E-9A (Details A - Electrical) Issued




1.1 Add: Note for CO monitor system detail as shown.

PREPARED BY: *Susan Pan*
Susan Pan
Electrical Department

ISSUED TO ROYAL PINE HOMES,
Cinzia Caruso, Cinzia@royalpinehomes.com;
Vince Staffieri, vince@royalpinehomes.com;
Frank Carogioiello, frank@royalpinehomes.com;
Steve Carogioiello, steve@royalpinehomes.com;
Peter Szlichta, Peter@royalpinehomes.com
FOR DISTRIBUTION TO ALL AFFECTED PARTIES.

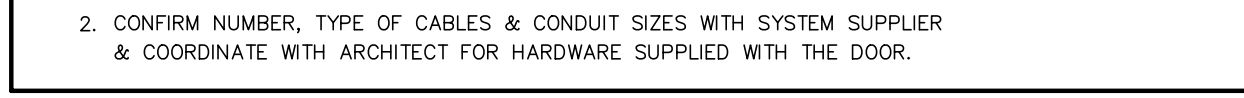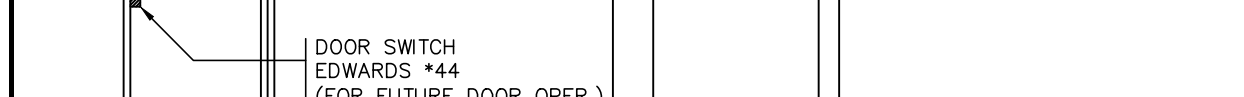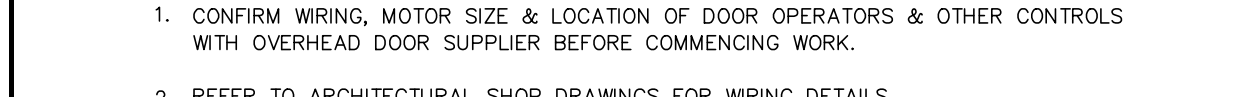

ELECTRIC HEATER SCHEDULE	SCALE: N.T.S.
---------------------------------	------------------

   [illegible]

This drawing, is an instrument of service, is provided by and is the property of United Engineering Inc. The contractor must verify and accept responsibility for all dimensions and conditions on site and must notify United Engineering Inc. of any discrepancy before proceeding.

United Engineering Inc. is not responsible for the accuracy of Architectural, structural, interior design, etc. on this drawing.

Refer to the appropriate trade drawings before proceeding with any work. Installation must conform to all applicable codes and requirements of the authorities having jurisdiction.

This drawing is not to be scaled, all symbols are graphic representations only.



TITLE	DETAILS A ELECTRICAL
-------	-------------------------

BRAMPTON STACKED
FORESTSIDE ESTATES

ATTMAR + PALLESCHI DRIVE
BRAMPTON, ONTARIO

DRAWN SP	CHECKED MG	SCALE N.T.S.
DATE MAY, 2019	PROJECT 18-017	DRAWING E-9A OF 16