DSANTOS | WED JUN 30/21 05:23 PM | K:\PROJECTS\2016\216102.ROY\SITE\216102-SP01.DWG

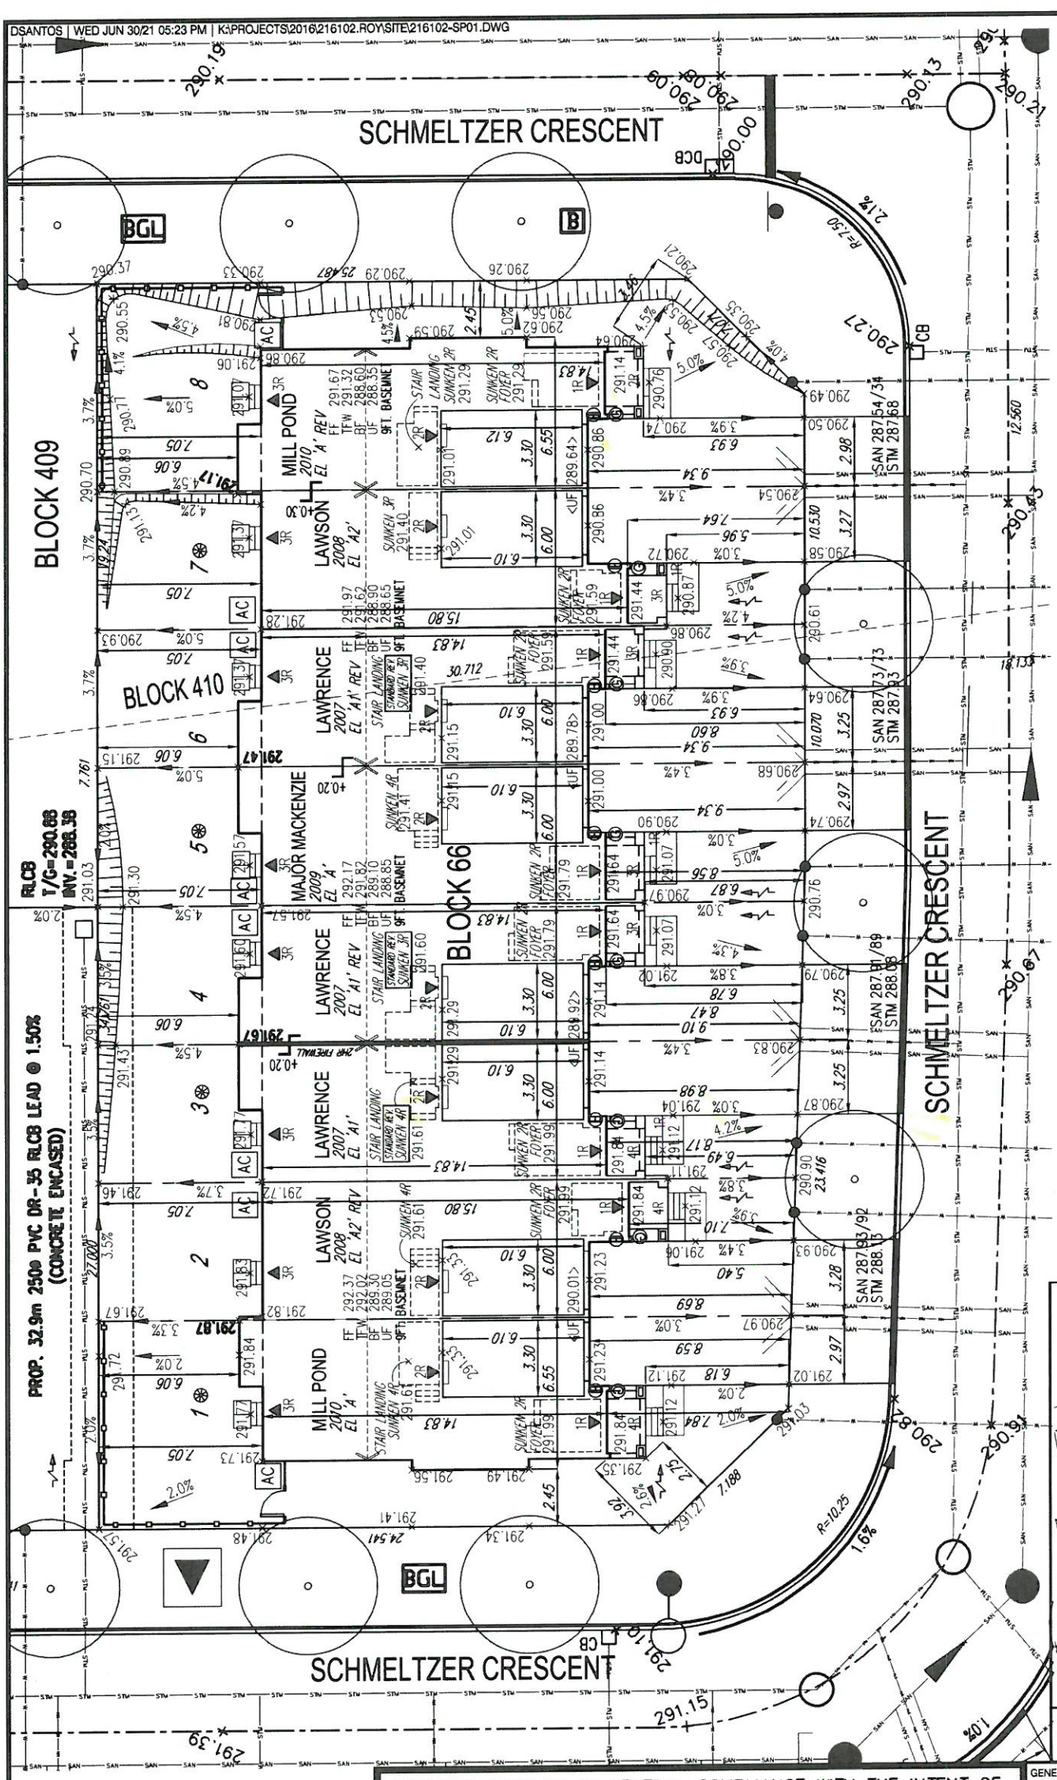

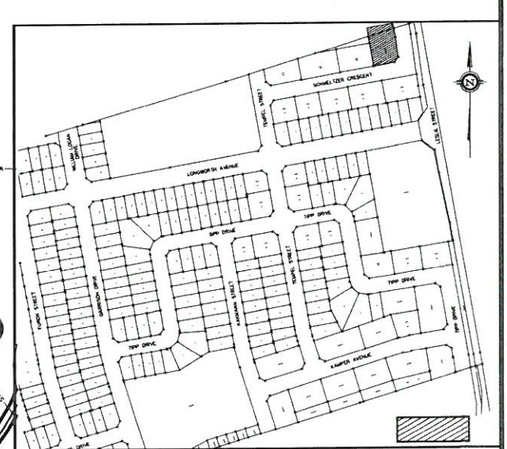

N.T.S. **KEY MAP** Subject LOT

REVIEWED ONLY AS TO GENERAL COMPLIANCE WITH THE INTENT OF THE GRADING AND SERVICING DRAWINGS. THE ENGINEER DOES NOT WARRANT THAT THE INFORMATION CONTAINED ON THIS PLAN IS EITHER ACCURATE OR CORRECT. SOLE RESPONSIBILITY FOR CORRECT DESIGN, DETAILS AND DIMENSIONS WILL REMAIN WITH THE PARTY SUBMITTING THE DRAWING.

- ☐ REVIEWED
- ☐ REVIEWED AS NOTED
- ☐ REVISE AND RESUBMIT

The MUNICIPAL INFRASTRUCTURE Group Ltd.

Date: July 8 2021 By: Kevin

GENERAL NOTES:
1. BUILDER TO VERIFY LOCATION OF UTILITIES AND OTHER SERVICES. IF MIN. DIMENSIONS ARE NOT MAINTAINED, BUILDER IS TO RELOCATE AT BUILDER'S EXPENSE.
2. BUILDER TO VERIFY ELEV. OF STM. AND SAN. LATERALS IN RELATION TO BASEMENT U/S OF FOOTING ELEVATIONS FOR COMPLIANCE WITH MUNICIPAL STANDARDS PRIOR TO EXCAVATION.
3. APPROVED PERMIT DRAWINGS & CONSTRUCTION NOTES MUST BE REVIEWED AND FOLLOWED IN CONJUNCTION WITH THE SITING AND GRADING PLAN. BUILDER TO VERIFY BUILDING ENVELOPE ON SITE PLAN MATCHES APPROVED PERMIT DRAWINGS & CONSTRUCTION NOTES PRIOR TO POURING CONCRETE. IF THERE ARE ANY DISCREPANCIES, THEY ARE TO BE BROUGHT TO THE ATTENTION OF HUNT DESIGN ASSOCIATES INC.
4. UNLESS NOTED ON BUILDING ENVELOPE OR APPROVED PERMIT DRAWINGS & CONSTRUCTION NOTES, ALL TOP OF FOUNDATION WALLS INCLUDING GARAGE WALLS TO BE CONSISTENT WITH THE ELEVATION PROVIDED FOR TFW ON SITING AND GRADING PLAN. THE EXTERIOR OF THE FOUNDATION WALL TO BE PROVIDED WITH A REDUCTION OF THICKNESS FOR MASONRY VENEER AS REQUIRED.

-	-	-
-	-	-
-	-	-
-	-	-
-	-	-
ISSUED FOR FINAL APPROVAL	DS	2021.06.30
ISSUED FOR PRELIMINARY APPROVAL	DS	2021.06.16

N

ENGINEERED FILL LOTS · STREET TREE · RETAINING WALL · CATCH BASIN · DOUBLE / SINGLE STM & SAN CONNECTION · SANITARY MANHOLE · STORM MANHOLE · VALVE & CHAMBER · VALVE & BOX · HYDRANT · WATER SERVICE · HYDRO SERVICE · SHEET DRAINAGE · STREET LIGHT PEDESTAL · STREET LIGHT · TRAFFIC SIGNAL POWER PEDESTAL · BELL PEDESTAL · CABLE PEDESTAL · HYDRO POLE · HYDRO POLE GUY · STREET SIGN · COMMUNITY MAILBOX · HYDRO TRANSFORMER · PADMOUNTED MOTOR · 189.65 EXISTING GRADES · 190.10 PROPOSED GRADES · 2.0% SWALE DIRECTION · EMBANKMENT / BERM MAX 3:1 SLOPE · SAN SANITARY LINE · STM STORM WATER LINE · W WATERLINE · H HYDRO LINE · G GAS LINE · C CABLE LINE · B BELL · HGBC HYDRO, GAS, BELL, CABLE LINE · DOWNSPOUTS · WINDOWS PERMITTED · 45 MINUTE FIRE RATED WALL SIDEYARD DISTANCE IS LESS THAN 1.2m TO LOT LINE. (NO WINDOWS PERMITTED) · EXTERIOR DOOR LOCATION · EXTERIOR DOOR LOCATION IF GRADE PERMITS · SUMP PUMP AND SURFACE DISCHARGE LOCATION · UPGRADE ELEVATION · CHAIN LINK FENCE · FENCE AND GATE · PRIVACY FENCE · ACOUSTIC FENCE · FF FINISHED FLOOR · TFW TOP OF FOUNDATION WALL · BF BASEMENT FLOOR · UF UNDERSIDE OF FOOTING · WOD WALKOUT DECK · WOB WALKOUT BASEMENT · MOD MODIFIED · REV REVERSED · ND NO DOOR · HIGHLIGHTED GRADE

Title: SITING AND GRADING PLAN

Plan No.: - Lot: BLOCK 66 Street Name: SCHMELTZER CRESCENT

THE UNDERSIGNED HAS REVIEWED AND TAKES RESPONSIBILITY FOR THIS DESIGN AND HAS THE QUALIFICATIONS AND MEETS THE REQUIREMENTS SET OUT IN THE ONTARIO BUILDING CODE TO BE A DESIGNER.

QUALIFICATION INFORMATION
DEREK R. SANTOS — SIGNATURE — 37308 BCIN
NAME
REGISTRATION INFORMATION
HUNT DESIGN ASSOCIATES INC. 19695

HUNT DESIGN ASSOCIATES INC.
www.huntdesign.ca

Royal Pine Homes / Centerfield Properties Inc - 216102
"OAKRIDGE MEADOWS", RICHMOND HILL, ON

Drawn By	Checked By	Scale	File Number	Lot / Page Number
DS	DS	1:250	216102-SP01.DWG	BLOCK 66

8966 Woodbine Ave, Markham, ON L3R 0J7 T 905.737.5133 F 905.737.7326

All drawings specifications related documents and design are the copyright property of Hunt Design Associates (H.D.A). Reproduction of this property in whole or in part is strictly prohibited without H.D.A.'s written permission (H.D.A. assumes no responsibility or liability for this property unless it bears the appropriate BCIN number and original signature.)