



SITE INSTRUCTION

Forestside Estates
 Attmar & Palleschi Drive
 Brampton, Ontario
 Attn: **Vince Staffieri**

SI A04

PROJECT : Forestside
PROJECT # : 1331.15
DATE : July 27, 2021

Site instructions/memos and Addendums are issued only for the purpose of recording any clarification or interpretation of the contract documents or giving direction on problems resulting from field conditions. These memos are subject to the provisions of the contract documents and unless reviewed with and authorized by the Client, will not affect the contract. Should the Contractor require a change in the contract price or project schedule, he shall submit to the Client, prior to commencement of work outlined in this memo, an itemized proposal for approval.

Title: Revisions to plans as itemized.

Reference:		Changes:
CS231	P1 Underground Slab Edge	Revise Grid Line location on Building D to match above floors above.
CS3010S-G	P1 Underground and 1 st Floor CS Plan Grids	Create new sheet to show added dimensions and tie in the Grids from underground to the shear walls of the floors above.

Reason: Tie in Dimension grids from the underground to the shear walls of the floors above as per client request.

GRAZIANI + CORAZZA
 ARCHITECTS INC

D. Biase C.E.T.
 Principal

**Distribution:**

Royal Pine Homes	Vince Staffieri Cinzia Caruzo	vince@royalpinehomes.com Cinzia@royalpinehomes.com
Jablonski Engineering	Kevin Deonaraine	kdeonaraine@astint.on.ca
United Engineering	Rene Cuales Leonard Matthews Susan Pan Mark Giorgi	rene@u-eng.ca Lenard@u-eng.ca susan@u-eng.ca mark@u-eng.ca
Candevcon Limited	Diarmund Hogan Dudister Damnaraigh	dhorgan@candevcon.com dude@candevcon.com
Starfire Sprinkler Systems	Elite Novosselova Peter Adrian	elitecanada@hotmail.com Peter@starfiresystems.biz
Strybos Barron King Ltd.	Bryn Barron Kaleigh Gills Sydney Martel	bbarron@strybos.com kgillis@strybos.com smartel@strybos.com
Graziani + Corazza Architects	Domenic Biase Gino Colangelo Fernando Croatto	dbiase@gc-architects.com gcolangelo@gc-architects.com FCroatto@gc-architects.com

THIS DRAWING IS NOT TO BE SCALED. ALL ARCHITECTURAL SYMBOLS INDICATED ON THIS DRAWING ARE GRAPHIC REPRESENTATIONS ONLY.


CONDITIONS FOR ELECTRONIC INFORMATION TRANSFER

ELECTRONIC INFORMATION IS SUPPLIED TO THE OTHER ASSOCIATED FIRMS TO ASSIST THEM IN THE EXECUTION OF THEIR WORK. REVIEW THE RECIPIENT FIRMS MUST EXTEND THE SAME COURTESY AND CONSIDER THE RELEVANCE OF THE INFORMATION IN RESPECT TO THEIR PARTICULAR RESPONSIBILITY.

KNOWLEDGE—CANADA ARCHITECTS INC. SHALL NOT BE RESPONSIBLE FOR:

1. ERRORS OR OMISSIONS INCOMPLETENESS DUE TO LOSS OF INFORMATION IN WHOLE OR PART WHEN INFORMATION IS TRANSFERRED;
2. TRANSMISSION OF ANY VIRUS OR DAMAGE TO THE RECEIVING ELECTRONIC SYSTEM WHEN INFORMATION IS TRANSFERRED.

01. SEP18/2019 Issued for circulation 1 [bg](#)

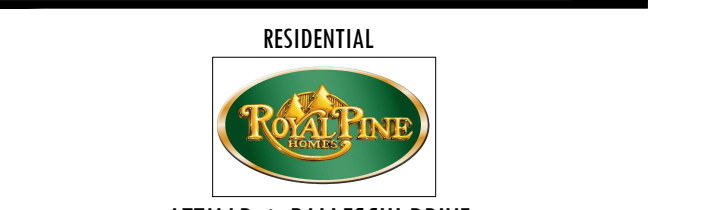

P1 UNDERGROUND AND 1ST FLOOR GRIDS (OVERALL PLAN)

