

FORESTSIDE TOWNHOUSES

(Royal Pine Homes)



SITE INSTRUCTION # 7

Instruction Issued By: Kevin Deonarraine

Instruction Issued To: Vince Staffieri

Date: November 17th, 2021

JAP Project No: 19066

Text of Instruction:

The following revisions have been made to the drawing set:

1.1 **Refer to Drawing S-102B "GROUND FLOOR FRAMING PLAN"**

- a) Updated to match slab edge in bubbled area

END OF SITE INSTRUCTION # 7

FORESTSIDE TOWNHOUSES

TORONTO, ONTARIO

Project
Number : #19066

Issued for : ISSUED FOR SITE INSTRUCTION # 7

Issued date : NOVEMBER 18, 2021




**JABLONSKY, AST
AND PARTNERS**
CONSULTING ENGINEERS

1129 LESLIE STREET
DON MILLS, ON., M3C 2K5
TEL. 416-447 7405
FAX 416-447 2771
e-mail: jap@astint.on.ca

LIST OF STRUCTURAL DRAWINGS

Drawing Index

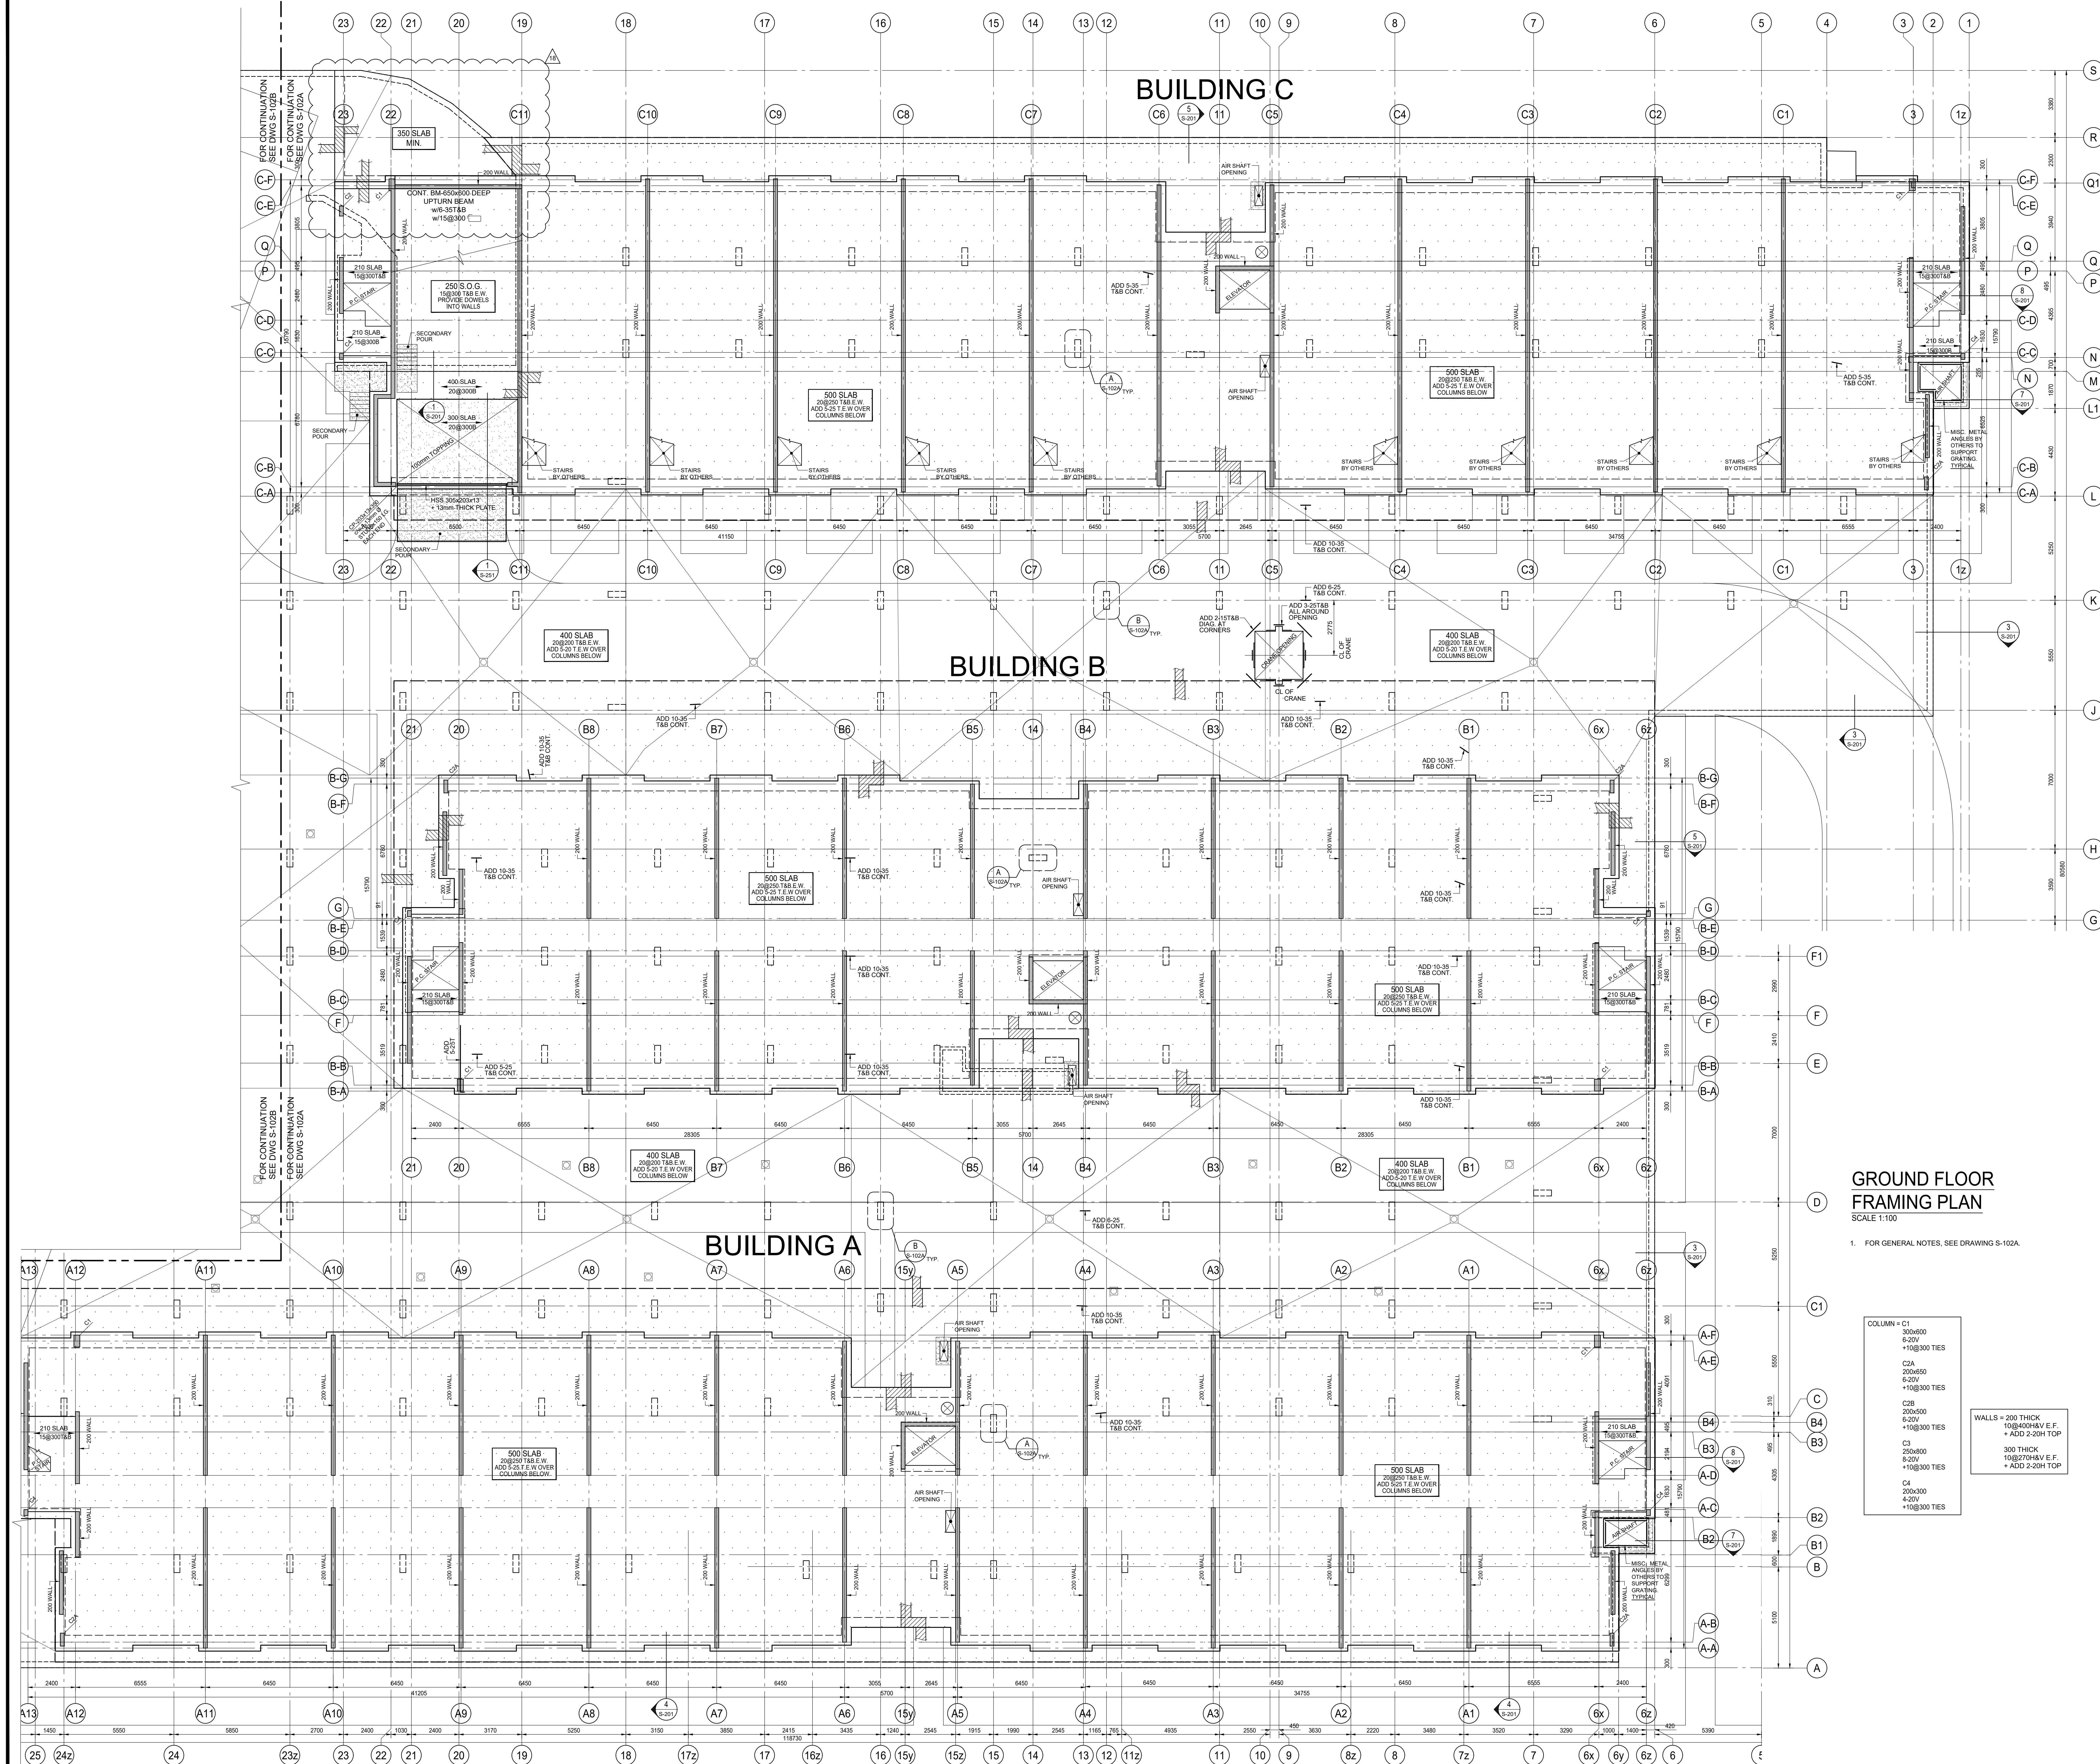

ISSUES		
No.	DATE	DESCRIPTION
1.	2019-08-02	ISSUED FOR TENDER
2.	2019-08-28	ISSUED FOR TENDER ADDENDUM #1
3.	2019-09-12	ISSUED FOR TENDER ADDENDUM #2
4.	2020-01-31	ISSUED FOR TENDER ADDENDUM #3
5.	2020-05-07	ISSUED FOR TENDER ADDENDUM #4
6.	2020-09-28	ISSUED FOR PERMIT
7.	2021-01-08	ISSUED FOR TENDER ADDENDUM #5
8.	2021-02-22	ISSUED FOR TENDER ADDENDUM #6
9.	2021-03-03	ISSUED FOR PERMIT BUILDINGS A, B, C, D
10.	2021-03-25	ISSUED FOR PROGRESSIVE CONSTRUCTION
11.	2021-03-25	ISSUED FOR PERMIT BUILDINGS A, B, C, D
12.	2021-04-21	ISSUED FOR SITE INSTRUCTION #2
13.	2021-05-07	ISSUED FOR SITE INSTRUCTION #3
14.	2021-05-18	ISSUED FOR SITE INSTRUCTION #4
15.	2021-05-28	ISSUED FOR SITE INSTRUCTION #5
16.	2021-06-15	ISSUED FOR PROGRESSIVE CONSTRUCTION #2
17.	2021-09-27	ISSUED FOR PERMIT REVISION TO BUILDING D
18.	2021-11-18	ISSUED FOR SITE INSTRUCTION #6

REVISIONS		
No.	DATE	DESCRIPTION
CONTRACTOR MUST VERIFY ALL DIMENSIONS AND BE RESPONSIBLE FOR SAME REPORTING ANY DISCREPANCIES TO THE ARCHITECT BEFORE COMMENCING THE WORK.		
PRINTS ARE NOT TO BE SCALED.		

**GROUND FLOOR
FRAMING PLAN**
SCALE 1:100

1. FOR GENERAL NOTES, SEE DRAWING S-102A.

COLUMN - C1	
300x600	6-20V
200x650	+10@300 TIES
C2A	
200x650	6-20V
200x500	+10@300 TIES
C2B	
200x500	6-20V
200x400	+10@300 TIES
C3	
250x800	8-20V
200x400	+10@300 TIES
C4	
200x300	4-20V
200x300	+10@300 TIES

WALLS = 200 THICK
10@400H&V E.F.
+ ADD 2-20H TOP

**Jablonsky, Ast
and Partners
CONSULTING
ENGINEERS**
1120 LESLIE STREET
DON MILLS, ON, M3C 2K5
TEL: 416-447-1465
FAX: 416-447-2771

Job Title:
FORETSIDE TOWNHOUSES
TORONTO, ONTARIO

Sheet Title:
**1ST FLOOR
BUILDINGS A, B, & C**

North

Date Plotted: Nov 17 2021
Drawn By: ND
Checked By: JW
Job No: 19066

Date: Nov 17 2021
Scale: 1 : 100
Revision Number:
Sheet No: S-102B