



SITE INSTRUCTION

Forestside Estates
 Attmar & Palleschi Drive
 Brampton, Ontario
 Attn: **Vince Staffieri**

SI A15

PROJECT : Forestside
PROJECT # : 1331.15
DATE : Dec. 7, 2021

Site instructions/memos and Addendums are issued only for the purpose of recording any clarification or interpretation of the contract documents or giving direction on problems resulting from field conditions. These memos are subject to the provisions of the contract documents and unless reviewed with and authorized by the Client, will not affect the contract. Should the Contractor require a change in the contract price or project schedule, he shall submit to the Client, prior to commencement of work outlined in this memo, an itemized proposal for approval.

Title: Revisions to plans as itemized.

Reference:		Changes:
CS301-OS CS301a1, CS301b1 CS302, CS302a1, CS302a2, CS302b1, CS302b2, CS302d1, CS302d2	1st Floor Slab Edge	Fill in openings for construction access on concrete shear walls.
A301, A301c1, A301c2, A301d1, A301d2 A302, A302a1, A302a2, A302b1, A302b2, A302d1, A302d2	1 st Floor Plan Bldg. C & D 2 nd Floor Plan Bldg. A, B, & D	Fill in openings for construction access on concrete shear walls.

Reason: Revisions to plans of shear wall openings as per structural coordination.

GRAZIANI + CORAZZA
 ARCHITECTS INC

D. Biase C.E.T.
 Principal

**Distribution:**

Royal Pine Homes	Vince Staffieri Cinzia Caruzo	vince@royalpinehomes.com Cinzia@royalpinehomes.com
Jablonski Engineering	Kevin Deonaraine	kdeonaraine@astint.on.ca
United Engineering	Rene Cuales Leonard Matthews Susan Pan Mark Giorgi	rene@u-eng.ca Lenard@u-eng.ca susan@u-eng.ca mark@u-eng.ca
Candevcon Limited	Diarmund Hogan Dudister Damnaraigh	dhorgan@candevcon.com dude@candevcon.com
Starfire Sprinkler Systems	Elite Novosselova Peter Adrian	elitecanada@hotmail.com Peter@starfiresystems.biz
Strybos Barron King Ltd.	Bryn Barron Kaleigh Gills Sydney Martel	bbarron@strybos.com kgillis@strybos.com smartel@strybos.com
Graziani + Corazza Architects	Domenic Biase Gino Colangelo Fernando Croatto	dbiase@gc-architects.com gcolangelo@gc-architects.com FCroatto@gc-architects.com

THIS DRAWING IS AN INSTRUMENT OF SERVICE, IT IS PROVIDED BY AND IS THE PROPERTY OF GRAZIANI-CORAZZA ARCHITECTS INC. THE CONTRACTOR MUST VERIFY AND ACCEPT RESPONSIBILITY FOR ALL DIMENSIONS AND COORDINATIONS AND MUST NOT REPRODUCE OR TRANSMIT THIS DRAWING OR ANY PART THEREOF WITHOUT THE WRITTEN PERMISSION OF GRAZIANI-CORAZZA ARCHITECTS INC. IT IS NOT RESPONSIBLE FOR THE ACCURACY OF SURVEY, STRUCTURAL, MECHANICAL, ELECTRICAL AND OTHER INFORMATION SHOWN ON THIS DRAWING. REFER TO THE APPROPRIATE ENGINEERING DRAWINGS BEFORE PROCEEDING WITH THE WORK. CONSTRUCTION MUST CONFORM TO ALL APPLICABLE CODES AND REQUIREMENTS OF THE AUTHORITY HAVING JURISDICTION. UNLESS OTHERWISE NOTED, NO INVESTIGATION HAS BEEN UNDERTAKEN OR REPORTED ON BY THIS OFFICE IN REGARD TO THE ENVIRONMENTAL CONDITION OF THIS SITE.


THIS DRAWING IS NOT TO BE SCALED. ALL ARCHITECTURAL SYMBOLS INDICATED ON THIS DRAWING ARE GRAPHIC REPRESENTATIONS ONLY.

CONDITIONS FOR ELECTRONIC INFORMATION TRANSFER:

ELECTRONIC INFORMATION IS SUPPLIED TO THE OTHER ASSOCIATED FIRMS TO ASSIST THEM IN THE EXECUTION OF THEIR WORK. REVIEW THE RECEIVED FIRMS MUST DETERMINE THE COMPLETENESS, APPROPRIATENESS, RELIANCE OF THE INFORMATION IN RESPECT TO THEIR PARTICULAR RESPONSIBILITY.

GRAZIANI-CORAZZA ARCHITECTS INC. SHALL NOT BE RESPONSIBLE FOR ERRORS, OMISSIONS, INCOMPLETENESS DUE TO LOSS OF INFORMATION IN WHOLE OR PART WHEN INFORMATION IS TRANSMITTED.

1. TRANSMISSION OF ANY FILES OR DAMAGE TO THE RECEIVING ELECTRONIC SYSTEM WHEN INFORMATION IS TRANSMITTED.

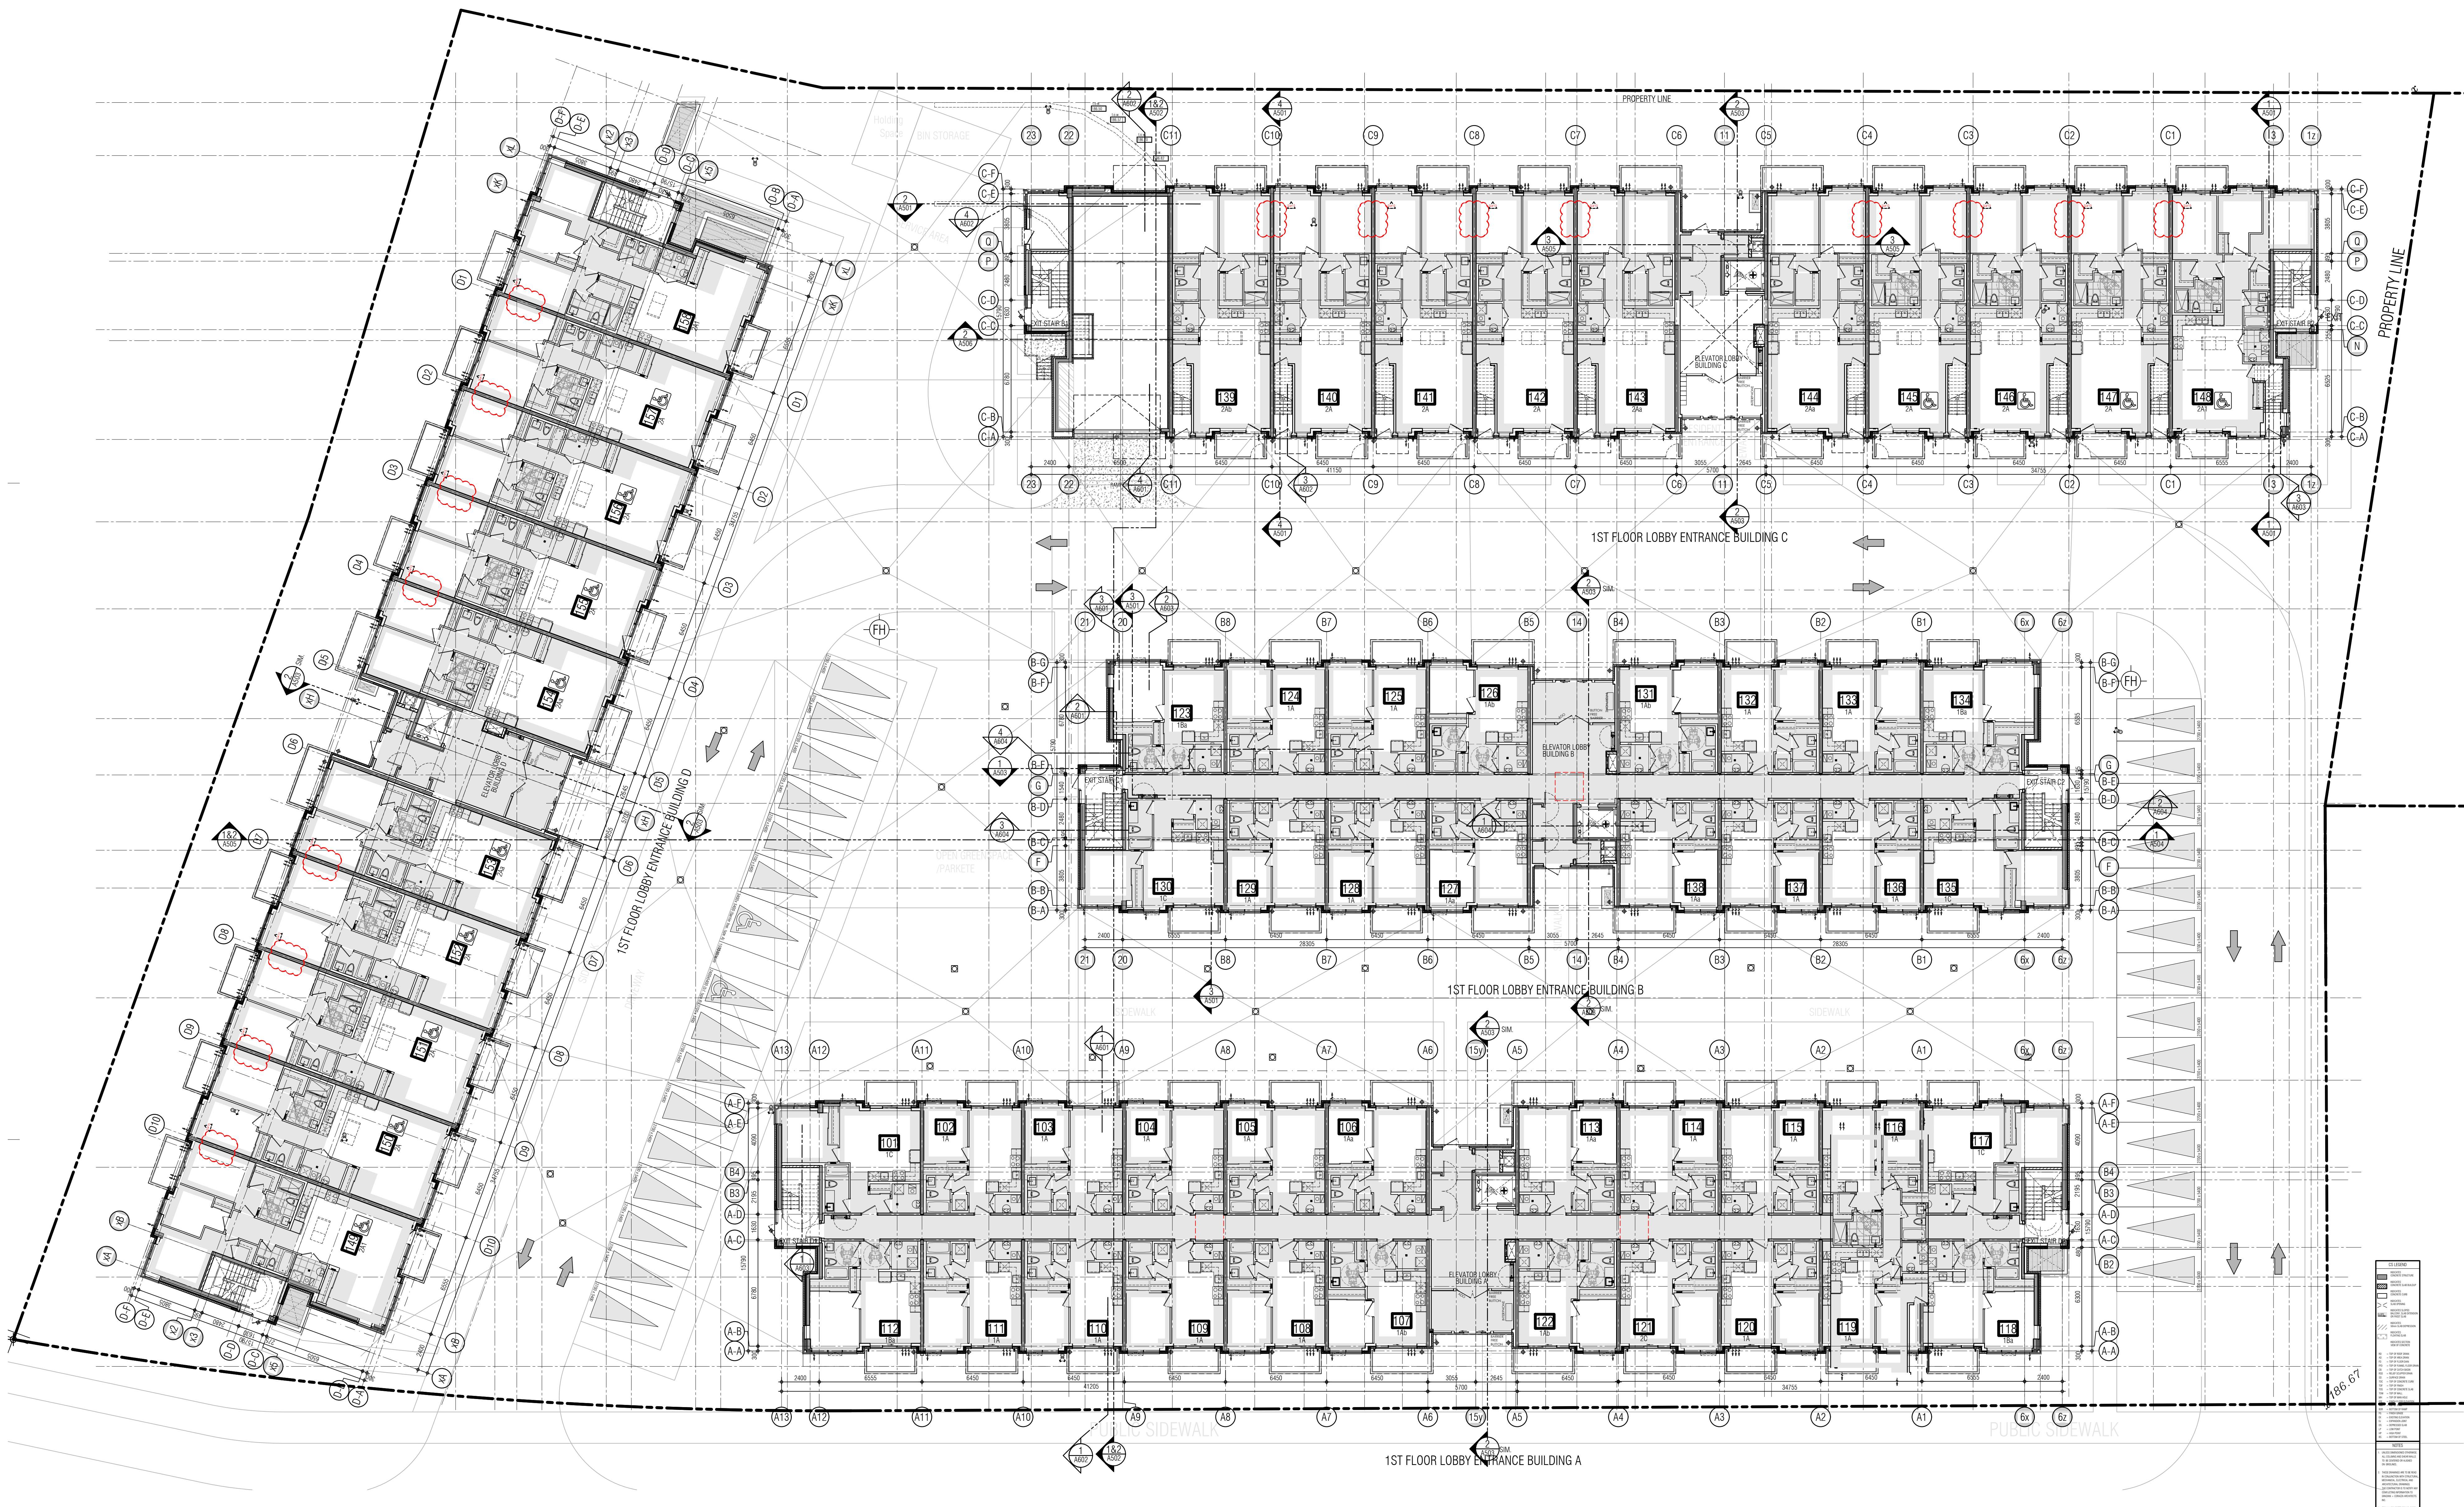

- 01. Oct.07.2019 issued for tender
- 02. Mar.13.2020 issued for design coordination #2
- 03. Mar.16.2020 issued for addendum #2
- 04. Mar.16.2020 issued for addendum #3
- 05. Aug.24.2020 issued for addendum #4
- 06. Sept.28.2020 issued for permit
- 07. Oct.20.2020 issued for addendum #5
- 08. Nov.23.2020 issued for addendum #6
- 09. Dec.14.2020 issued for addendum #7
- 10. Jan.18.2021 issued for addendum #8
- 11. Mar.2.2021 issued for permit
- 12. Mar.09.2021 issued for addendum #9
- 13. Mar.10.2021 issued for addendum #9R
- 14. Mar.26.2021 issued for progress
- 15. May.14.2021 issued for Site Instruction #1
- 16. June.15.2021 issued for Site Instruction #2
- 17. July.7.2021 re-issued for permit
- 18. July.15.2021 issued for Site Instruction #3
- 19. July.27.2021 issued for Site Instruction #4
- 20. Aug.3.2021 issued for Site Instruction #5
- 21. Aug.18.2021 issued for Site Instruction #6
- 22. Aug.29.2021 Re-issued for permit
- 23. Sept.07.2021 issued for Site Instruction #7
- 24. Sept.09.2021 issued for Site Instruction #8
- 25. Sept.16.2021 issued for Building D Permit Revisions
- 26. Sept.22.2021 issued for Site Instruction #9
- 27. Oct.6.2021 Re-issued for permit
- 28. Oct.8.2021 issued for Site Instruction #10
- 30. Oct.28.2021 issued for Site Instruction #11
- 31. Nov.05.2021 issued for Site Instruction #12
- 32. Dec.3.2021 issued for Site Instruction #13
- 33. Dec.6.2021 issued for Site Instruction #14
- 34. Dec.7.2021 issued for Site Instruction #15

- 01. SEP.18.2019 issued for Addendum 1
 - 01. Apr.19.2021 issued to client
- issued for revisions

GRAZIANI CORAZZA ARCHITECTS

1320 SHANAGHAN DRIVE, SUITE 100 MISSISSAUGA, ONTARIO L4W 1C3
905.709.7041 FAX 905.709.7042 WWW.GC-ARCHITECTS.COM

ATTMAR + PALLESCI DRIVE

BRAMPTON ONTARIO

PROJECT ARCHITECT: B. GRAZIANI
ASSISTANT DESIGNER: R. LINCOLN
DRAWN BY: G.C./F.C./M.B.
CHECKED BY: D. BIASE/G. COLANGELO
PLOT DATE: DEC.07.2021
JOB #: 1331.15

GROUND FLOOR OVERALL PLAN

THIS DRAWING IS AN INSTRUMENT OF SERVICE, IS PROVIDED BY AND IS THE PROPERTY OF GRAZIANI-CORAZZA ARCHITECTS INC. THE CONTRACTOR MUST VERIFY AND ACCEPT RESPONSIBILITY FOR ALL DIMENSIONS AND COORDINATIONS AND MUST NOTIFY GRAZIANI-CORAZZA ARCHITECTS INC. OF ANY VARIATIONS FROM THE SUPPLIED INFORMATION. GRAZIANI-CORAZZA ARCHITECTS INC. IS NOT RESPONSIBLE FOR THE ACCURACY OF SURVEY, STRUCTURAL, MECHANICAL, ELECTRICAL AND OTHER ENGINEERING INFORMATION SHOWN ON THIS DRAWING. REFER TO THE APPROPRIATE ENGINEERING DRAWINGS BEFORE PROCEEDING WITH THE WORK. CONSTRUCTION MUST COMPLY TO ALL APPLICABLE CODES AND REQUIREMENTS OF THE AUTHORITIES HAVING JURISDICTION. UNLESS OTHERWISE NOTED, NO MODIFICATION HAS BEEN MADE/NOTED AS REPORTED IN BY THIS OFFICE IN REGARDS TO THE ENVIRONMENTAL CONDITION OF THIS SITE.

THIS DRAWING IS NOT TO BE SCALED. ALL ARCHITECTURAL SYMBOLS INDICATED ON THIS DRAWING ARE GRAPHIC REPRESENTATIONS ONLY.

CONDITIONS FOR ELECTRONIC INFORMATION TRANSFER

ELECTRONIC INFORMATION IS SUPPLIED TO THE OTHER ASSOCIATED FIRMS TO ASSIST THEM IN THE EXECUTION OF THEIR WORK. REVIEW THE RECEIVED FIRMS MUST DETERMINE THE COMPLETENESS, APPROPRIATENESS, RELIANCE OF THE INFORMATION IN RESPECT TO THEIR PARTICULAR RESPONSIBILITY.


GRAZIANI-CORAZZA ARCHITECTS INC. SHALL NOT BE RESPONSIBLE FOR ERRORS, OMISSIONS, INCOMPLETENESS DUE TO LOSS OF INFORMATION IN WHOLE OR PART WHEN INFORMATION IS TRANSFERRED.

1. TRANSMISSION OF ANY LOSS OF DAMAGE TO THE RECEIVING ELECTRONIC SYSTEM WHEN INFORMATION IS TRANSFERRED.

REF A301b2 FOR CONTINUATION

- | | | | |
|-----|--------------|--|----|
| 01. | Oct.07.2019 | Issued for tender | — |
| 02. | Mar.13.2020 | Issued for design coordination #2 | — |
| 03. | Mar.16.2020 | Issued for addendum #2 | — |
| 04. | Mar.16.2020 | Issued for addendum #3 | — |
| 05. | Aug.24.2020 | Issued for addendum #4 | — |
| 06. | Dec.14.2020 | Issued for permit | bg |
| 07. | Oct.20.2020 | Issued for addendum #5 | — |
| 08. | Nov.23.2020 | Issued for addendum #6 | — |
| 09. | Dec.14.2020 | Issued for addendum #7 | — |
| 10. | Jan.15.2021 | Issued for addendum #8 | — |
| 11. | Mar.2.2021 | Issued for permit | bg |
| 12. | Mar.09.2021 | Issued for addendum #9 | — |
| 13. | Mar.10.2021 | Issued for addendum #9R | — |
| 14. | Mar.26.2021 | Issued for progress | — |
| 15. | May.14.2021 | Issued for Site Instruction #1 | — |
| 16. | June.15.2021 | Issued for Site Instruction #2 | — |
| 17. | July.7.2021 | re-issued for permit | bg |
| 18. | July.15.2021 | Issued for Site Instruction #3 | bg |
| 19. | July.27.2021 | Issued for Site Instruction #4 | bg |
| 20. | Aug.3.2021 | Issued for Site Instruction #5 | bg |
| 21. | Aug.18.2021 | Issued for Site Instruction #6 | bg |
| 22. | Aug.29.2021 | Re-issued for permit | — |
| 23. | Sept.07.2021 | Issued for Site Instruction #7 | bg |
| 24. | Sept.09.2021 | Issued for Site Instruction #8 | bg |
| 25. | Sept.16.2021 | Issued for Building D Permit Revisions | — |
| 26. | Sept.22.2021 | Issued for Site Instruction #9 | bg |
| 27. | Oct.6.2021 | Re-issued for permit | bg |
| 28. | Oct.8.2021 | Issued for Site Instruction #10 | bg |
| 30. | Oct.28.2021 | Issued for Site Instruction #11 | bg |
| 31. | Nov.05.2021 | Issued for Site Instruction #12 | bg |
| 32. | Dec.3.2021 | Issued for Site Instruction #13 | bg |
| 33. | Dec.6.2021 | Issued for Site Instruction #14 | bg |
| 34. | Dec.7.2021 | Issued for Site Instruction #15 | bg |

- | | | | |
|-----|------------|-----------------------|----|
| 01. | SEP18/2021 | Issued for addendum 1 | bg |
|-----|------------|-----------------------|----|
- Issued for revisions

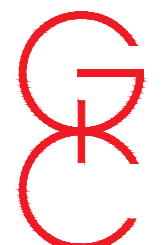

GRAZIANI
CORAZZA
ARCHITECTS

1333 SANDWICH DRIVE, SUITE 100 MISSISSAUGA, ONTARIO L4W 1C3
905.760.7001 F.905.760.7000 WWW.GC-ARCHITECTS.COM



ATTMAR + PALLESCHI DRIVE

PROJECT ARCHITECT:	B. GRAZIANI
ASSISTANT DESIGNER:	R. LINCOLN
DRAWN BY:	G.C./F.C./M.B.
CHECKED BY:	D. BIASI/G. COLANGELO
PLANT DATE:	DEC.07.2021
JOB #:	1331.15


GROUND FLOOR PLAN
BUILDING C (PARTIAL PLAN)




1:50

A-301c1

TITLEBLOCK SIZE: 915 x 1200

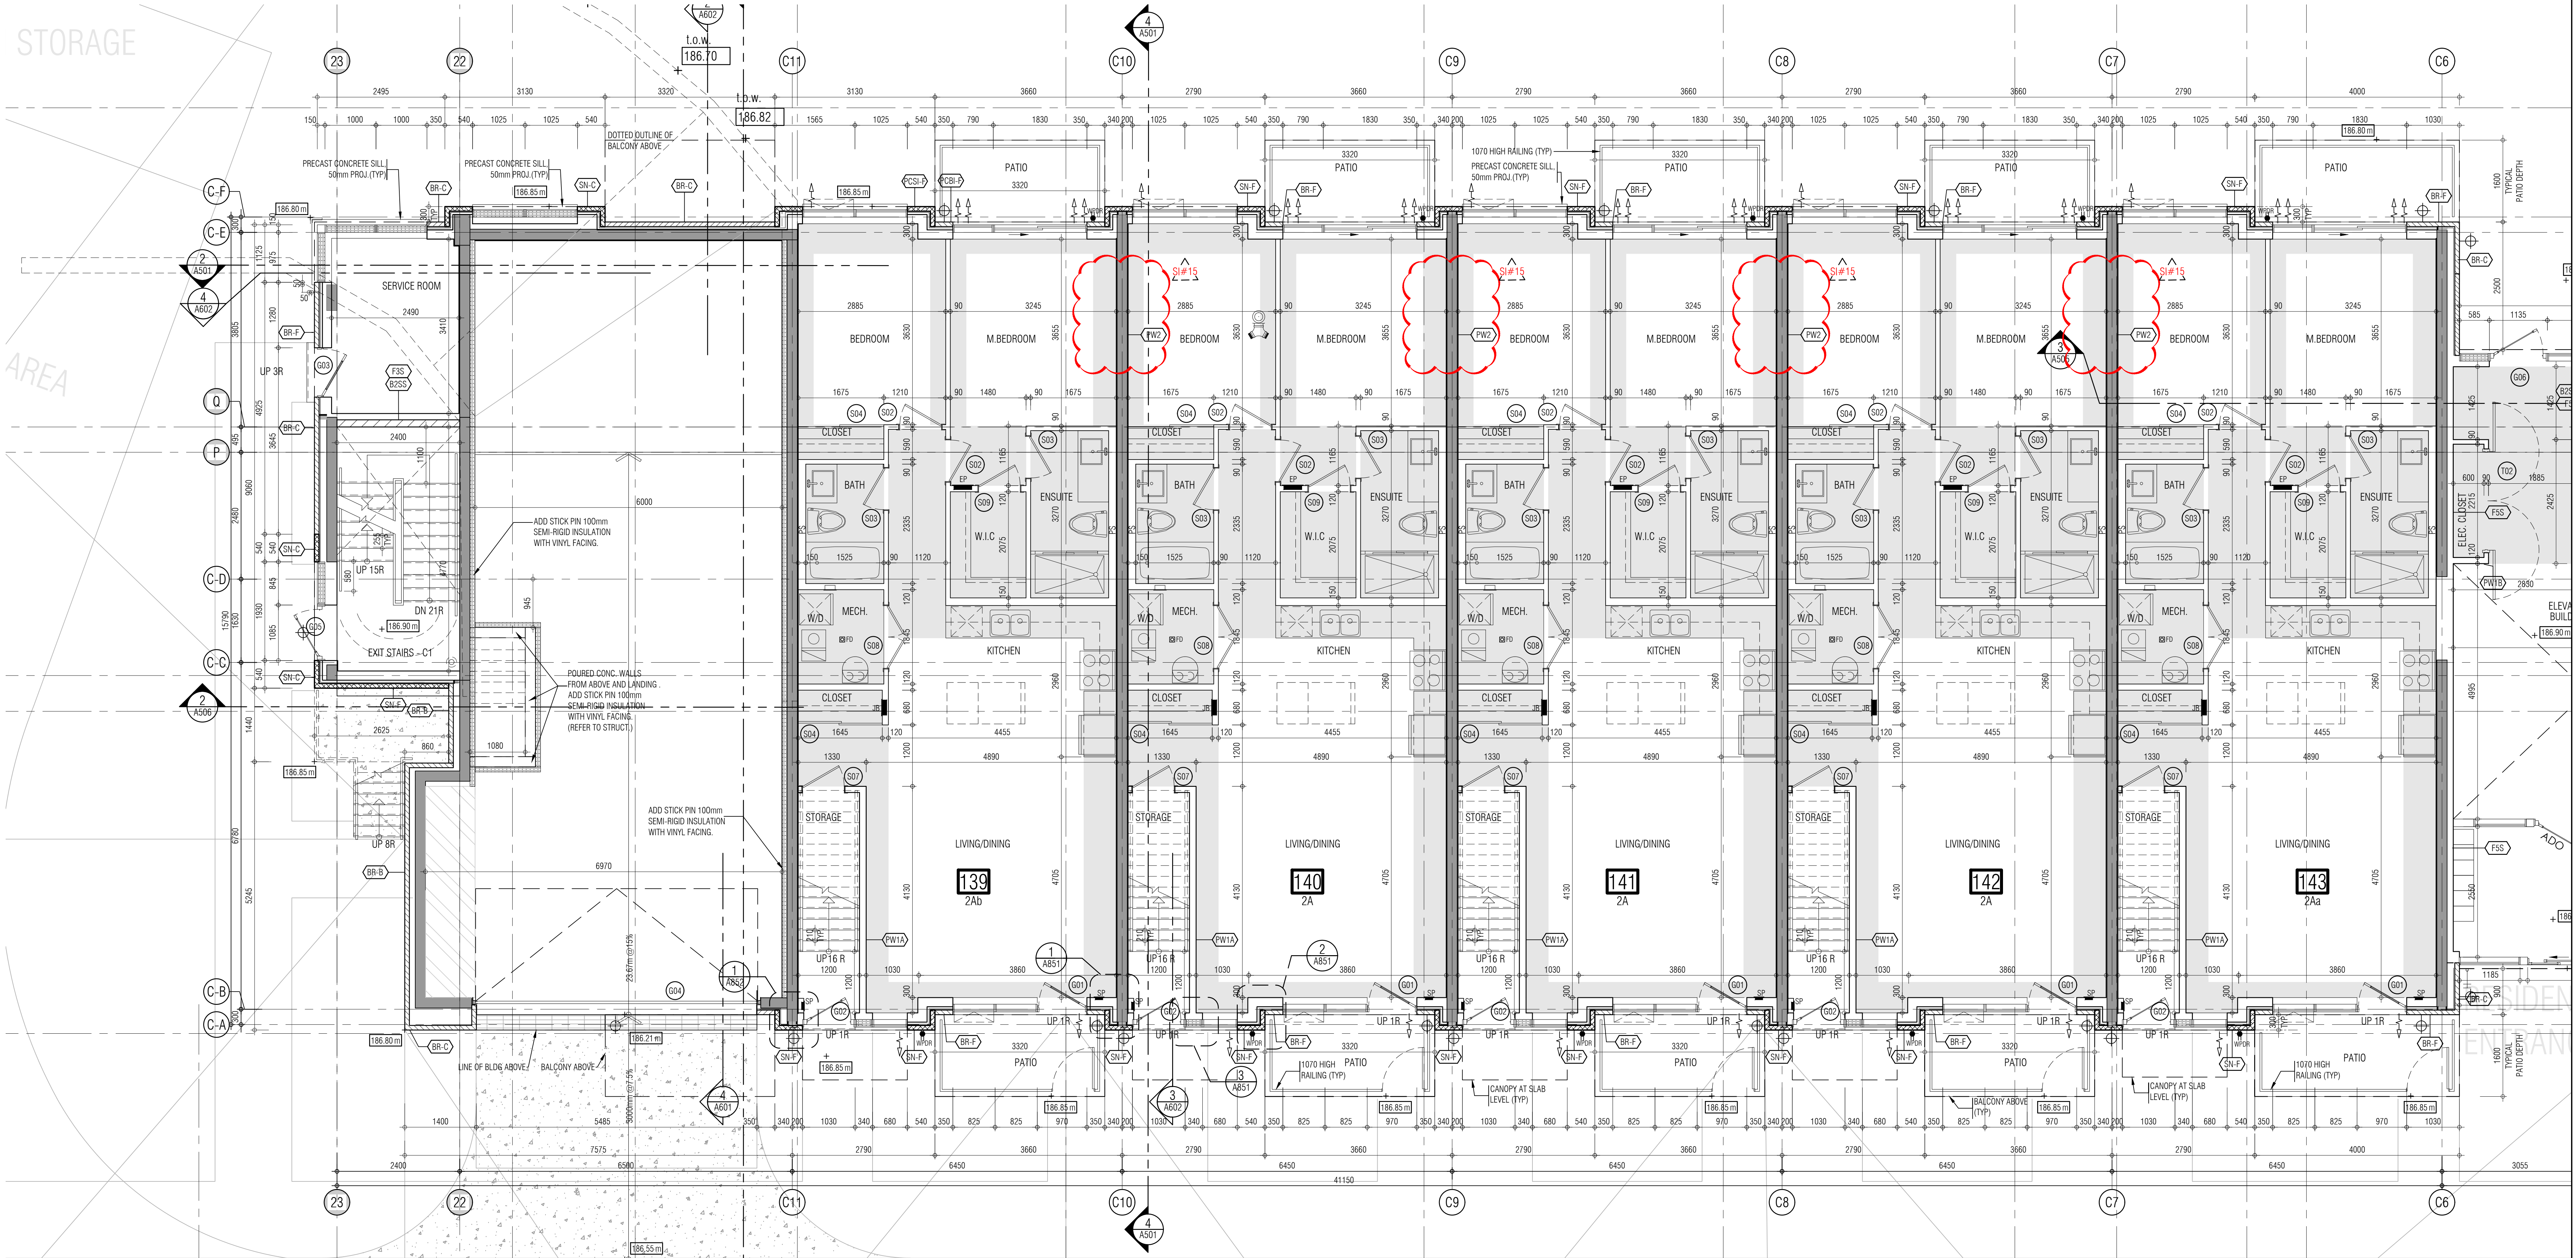

KEY PLAN

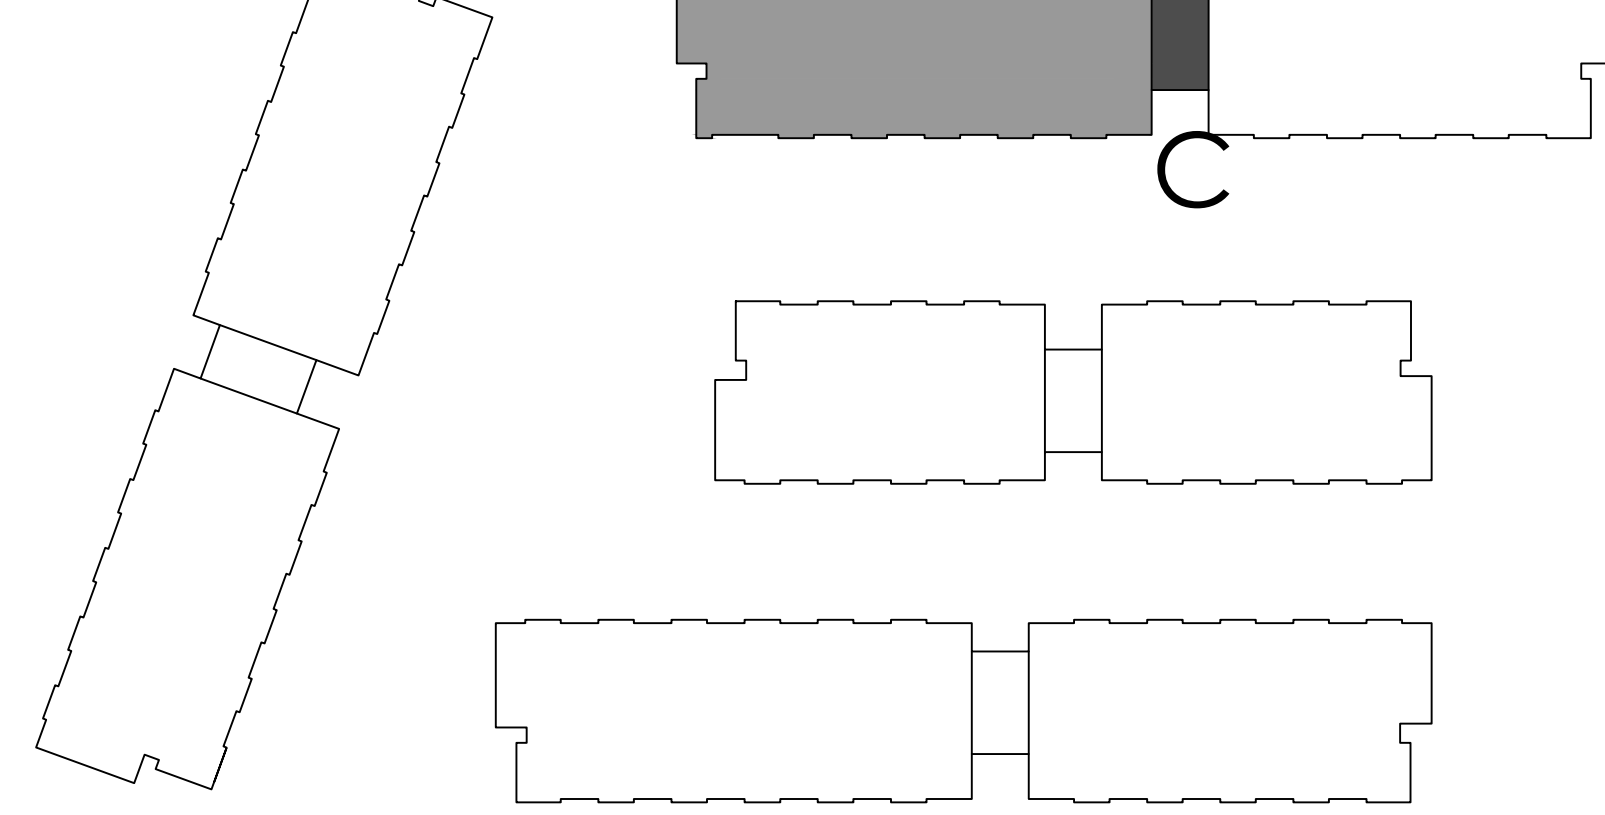

THIS DRAWING IS AN INSTRUMENT OF SERVICE, IS PROVIDED BY AND IS THE PROPERTY OF GRAZIANI-CORAZZA ARCHITECTS INC. THE CONTRACTOR MUST VERIFY AND ACCEPT RESPONSIBILITY FOR ALL DIMENSIONS AND COORDINATE THE SITE AND MUST NOTIFY GRAZIANI-CORAZZA ARCHITECTS INC. OF ANY VARIATIONS FROM THE SUPPLIED INFORMATION. GRAZIANI-CORAZZA ARCHITECTS INC. IS NOT RESPONSIBLE FOR THE ACCURACY OF SURVEY, STRUCTURAL, MECHANICAL, ELECTRICAL AND OTHER ENGINEERING INFORMATION SHOWN ON THIS DRAWING. REFER TO THE APPROPRIATE ENGINEERING DRAWINGS BEFORE PROCEEDING WITH THE WORK. CONSTRUCTION MUST COMPLY TO ALL APPLICABLE CODES AND REQUIREMENTS OF THE AUTHORITIES HAVING JURISDICTION. UNLESS OTHERWISE NOTED, NO MODIFICATION HAS BEEN MADE/NOTED AS REPORTED IN BY THIS OFFICE IN REGARDS TO THE ENVIRONMENTAL CONDITION OF THIS SITE.

THIS DRAWING IS NOT TO BE SCALED. ALL ARCHITECTURAL SYMBOLS INDICATED ON THIS DRAWING ARE GRAPHIC REPRESENTATIONS ONLY.

CONDITIONS FOR ELECTRONIC INFORMATION TRANSFER

ELECTRONIC INFORMATION IS SUPPLIED TO THE OTHER ASSOCIATED FIRMS TO ASSIST THEM IN THE EXECUTION OF THEIR WORK. REVIEW THE RECEIPT FROM MUST DETERMINE THE COMPLETENESS, APPROPRIATENESS, RELIANCE OF THE INFORMATION IN RESPECT TO THEIR PARTICULAR RESPONSIBILITY.

GRAZIANI-CORAZZA ARCHITECTS INC. SHALL NOT BE RESPONSIBLE FOR ERROR, OMISSIONS, INCOMPLETENESS DUE TO LOSS OF INFORMATION IN WHOLE OR PART WHEN INFORMATION IS TRANSMITTED.

1. TRANSMISSION OF ANY LOSS OF DAMAGE TO THE RECEIVING ELECTRONIC SYSTEM WHEN INFORMATION IS TRANSMITTED.

01. Oct.07.2019 issued for tender
02. Mar.13.2020 issued for design coordination #2
03. Mar.16.2020 issued for addendum #2
04. Mar.16.2020 issued for addendum #3
05. Aug.24.2020 issued for addendum #4
06. Sept.28.2020 issued for permit
07. Oct.20.2020 issued for addendum #5
08. Nov.23.2020 issued for addendum #6
09. Dec.14.2020 issued for addendum #7
10. Jan.15.2021 issued for addendum #8
11. Mar.2.2021 issued for permit
12. Mar.09.2021 issued for addendum #9
13. Mar.10.2021 issued for addendum #9R
14. Mar.26.2021 issued for progress
15. May.14.2021 issued for Site Instruction #1
16. June.15.2021 issued for Site Instruction #2
17. July.7.2021 re-issued for permit
18. July.15.2021 issued for Site Instruction #3
19. July.27.2021 issued for Site Instruction #4
20. Aug.3.2021 issued for Site Instruction #5
21. Aug.18.2021 issued for Site Instruction #6
22. Aug.20.2021 Re-issued for permit
23. Sept.07.2021 issued for Site Instruction #7
24. Sept.09.2021 issued for Site Instruction #8
25. Sept.16.2021 issued for Building D Permit Revisions
26. Sept.22.2021 issued for Site Instruction #9
27. Oct.6.2021 Re-issued for permit
28. Oct.8.2021 issued for Site Instruction #10
30. Oct.28.2021 issued for Site Instruction #11
31. Nov.05.2021 issued for Site Instruction #12
32. Dec.3.2021 issued for Site Instruction #13
33. Dec.6.2021 issued for Site Instruction #14
34. Dec.7.2021 issued for Site Instruction #15

01. SEP18/20219 issued for addendum 1

issued for revisions



1333 SHANAWA DRIVE, SUITE 101 MISSISSAUGA, ONTARIO L4W 1C3
905.760.7001 F.905.760.7000 WWW.GC-ARCHITECTS.COM



BRAMPTON ATTMA + PALLESCHI DRIVE ONTARIO

PROJECT ARCHITECT: B. GRAZIANI

ASSISTANT DESIGNER: R. LINCOLN

DRAWN BY: G.C./F.C./M.B.

CHECKED BY: D. BIASI/G. COLANGELO

PLANT DATE: DEC.07.2021



JOB # 1331.15

GROUND FLOOR PLAN
BUILDING C (PARTIAL PLAN)

1:50 A-301c2

TITLEBLOCK SIZE: 915 x 1200

REF.A301b1 FOR CONTINUATION

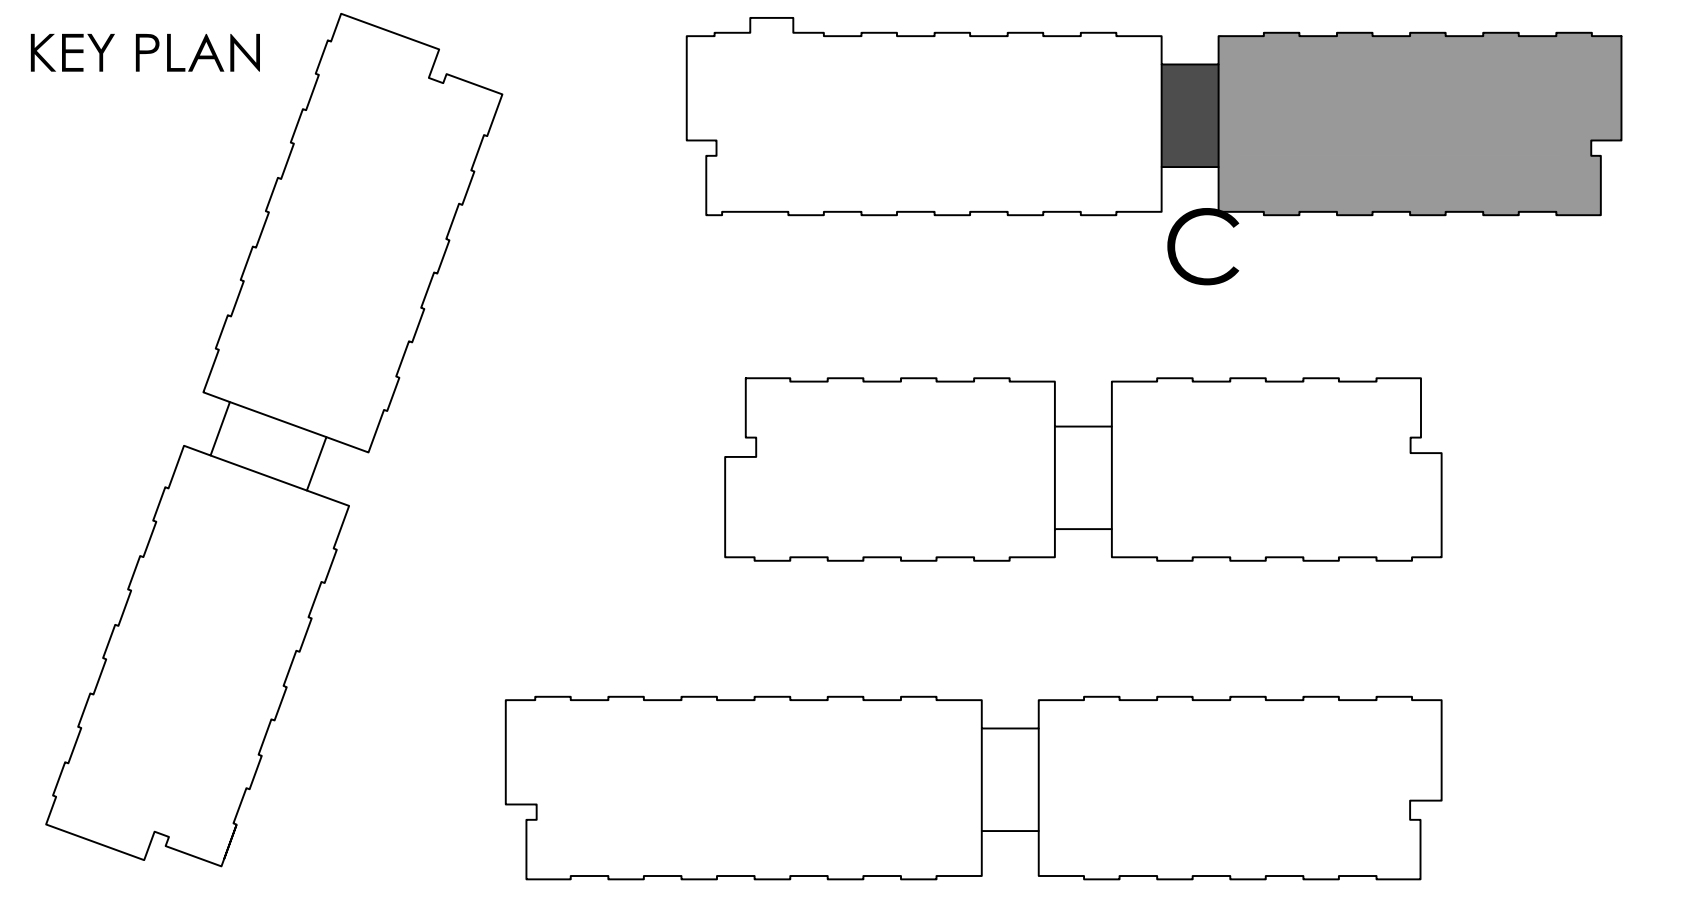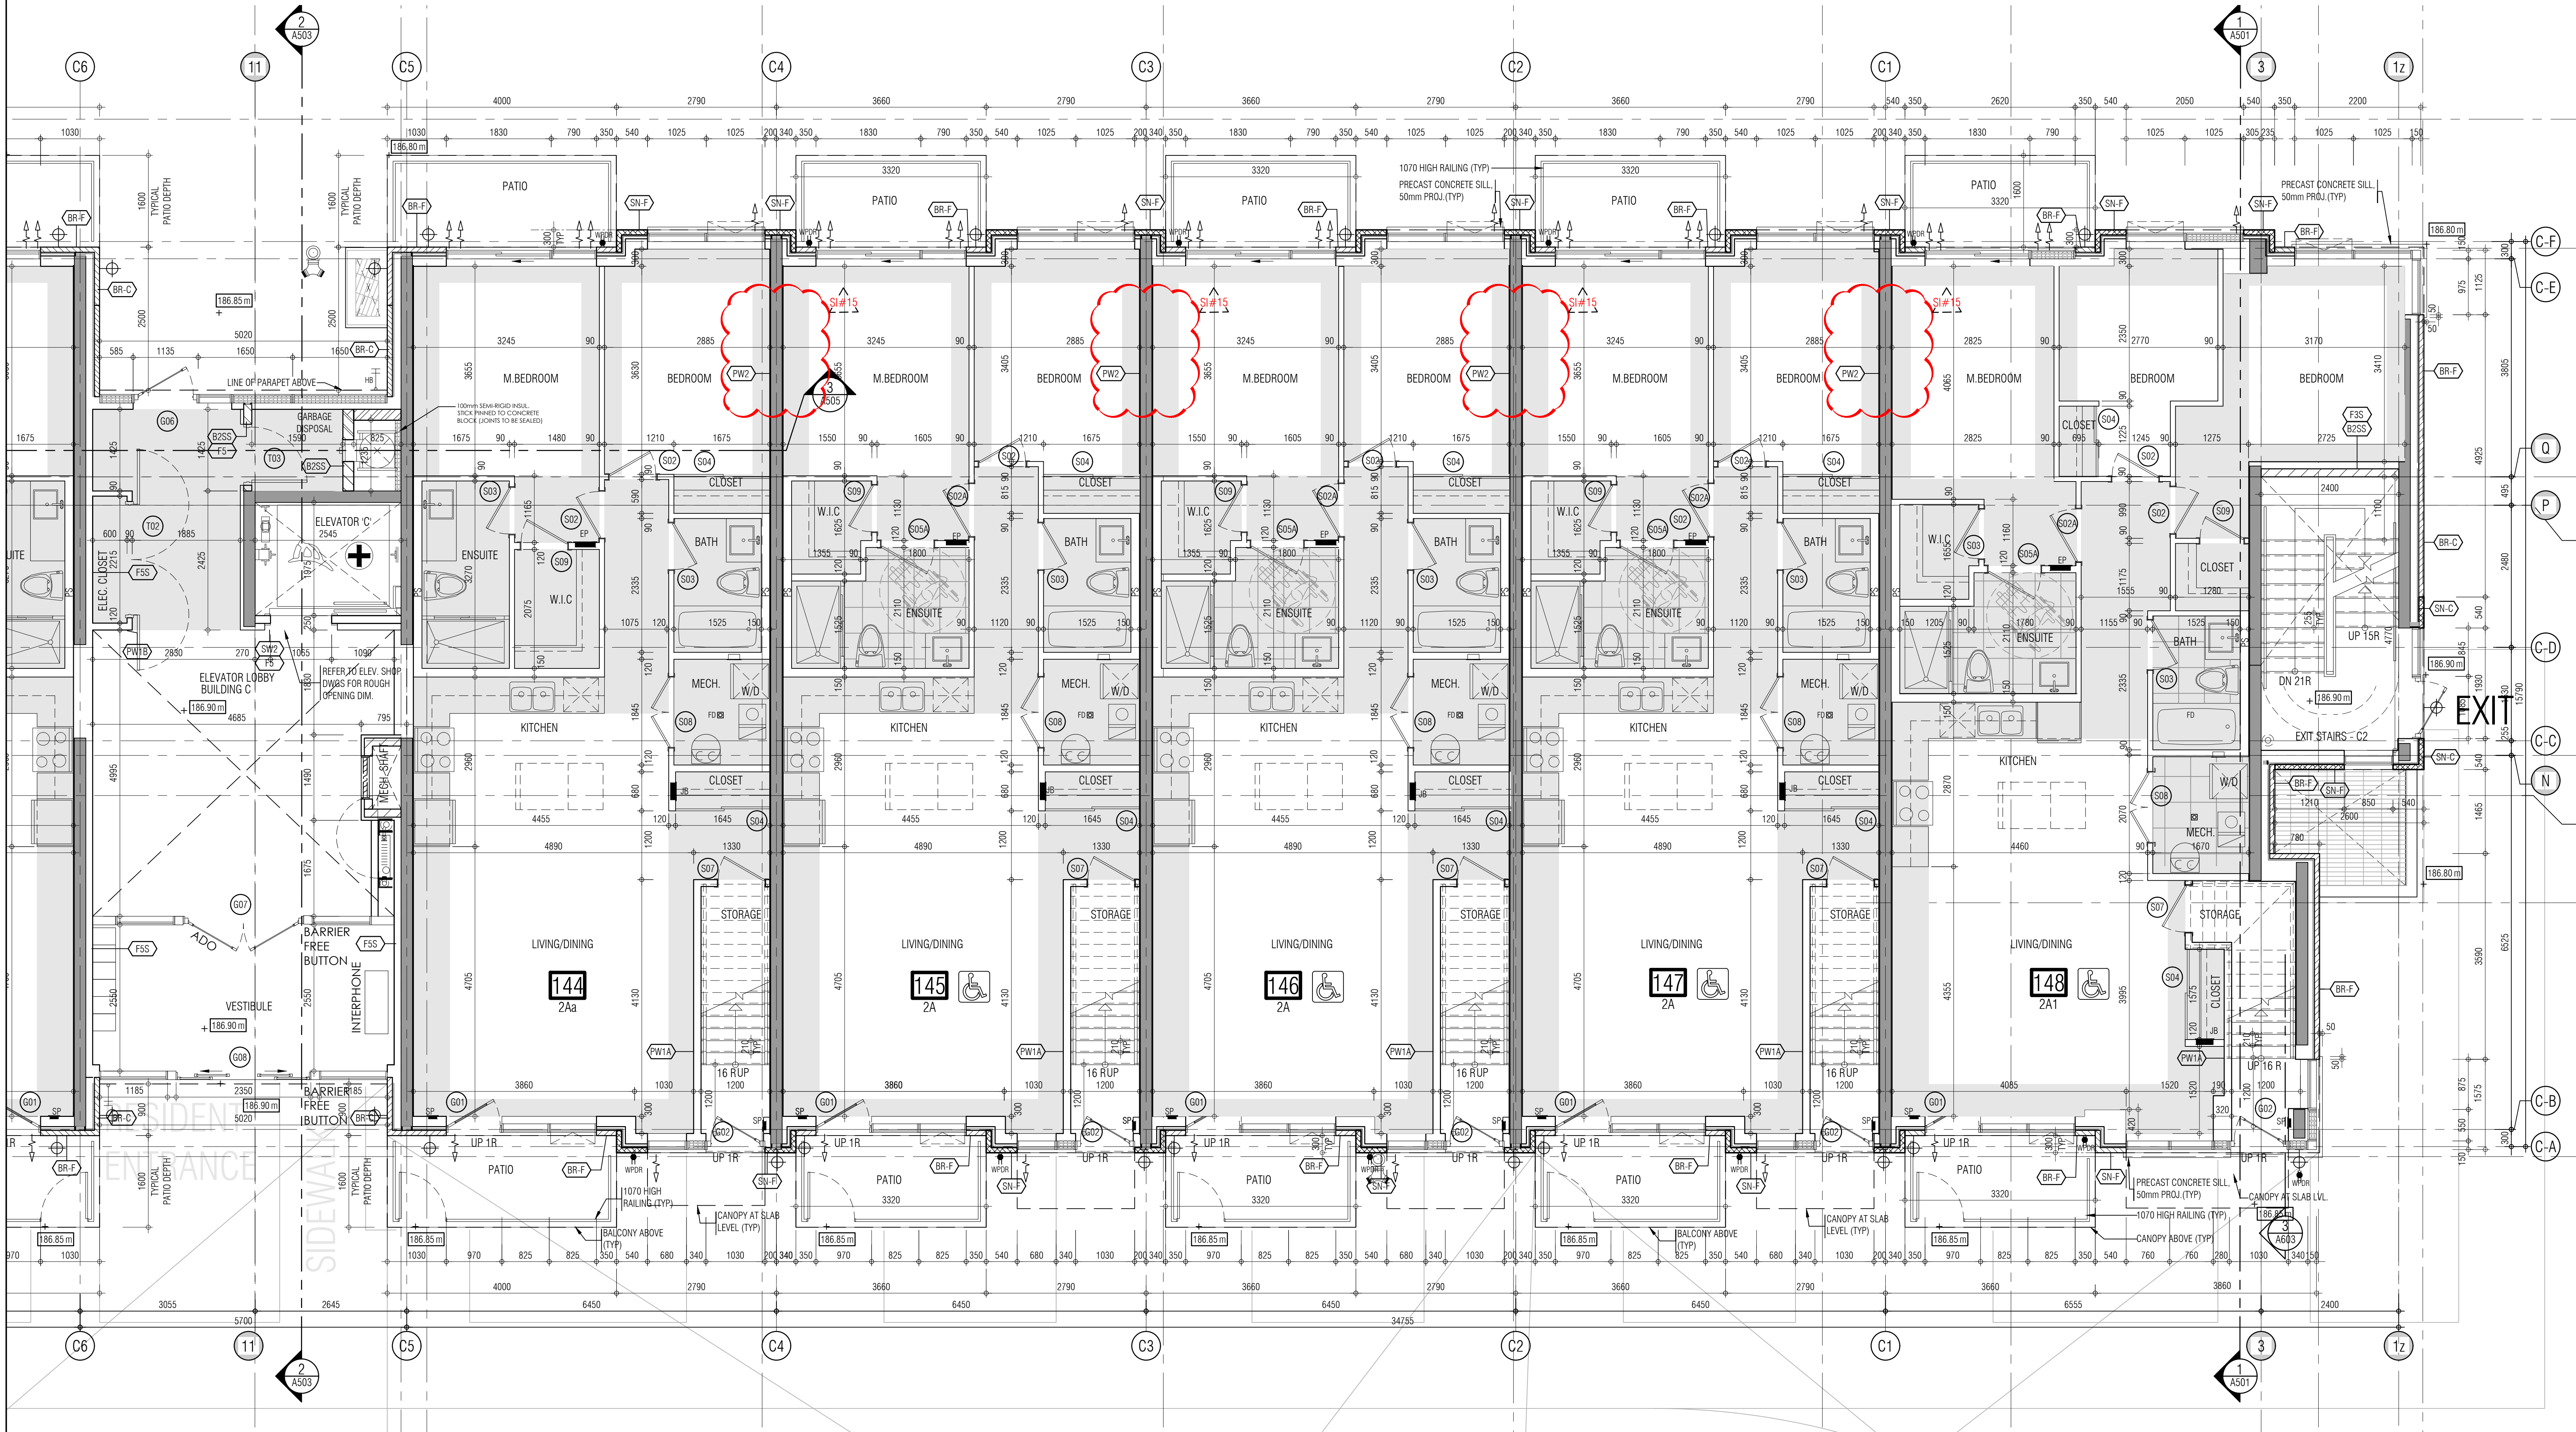

THIS DRAWING IS AN INSTRUMENT OF SERVICE, IT IS PROVIDED BY AND IS THE PROPERTY OF GRAZIANI-CORAZZA ARCHITECTS INC. THE CONTRACTOR MUST VERIFY AND ACCEPT RESPONSIBILITY FOR ALL DIMENSIONS AND COORDINATE THE SITE AND ANY OTHER INFORMATION GRAZIANI-CORAZZA ARCHITECTS INC. IS NOT RESPONSIBLE FOR THE ACCURACY OF SURVEY, STRUCTURAL, MECHANICAL, ELECTRICAL AND OTHER INFORMATION SHOWN ON THIS DRAWING. REFER TO THE APPROPRIATE ENGINEERING DRAWINGS BEFORE PROCEEDING WITH THE WORK. CONSTRUCTION MUST COMPLY TO ALL APPLICABLE CODES AND REQUIREMENTS OF THE AUTHORITIES HAVING JURISDICTION. UNLESS OTHERWISE NOTED, NO MODIFICATION HAS BEEN MADE/SHOWN OR REPORTED ON BY THIS OFFICE IN REFERENCE TO THE ENVIRONMENTAL CONDITION OF THIS SITE.

THIS DRAWING IS NOT TO BE SCALED. ALL ARCHITECTURAL SYMBOLS INDICATED ON THIS DRAWING ARE GRAPHIC REPRESENTATIONS ONLY.


CONDITIONS FOR ELECTRONIC INFORMATION TRANSFER

ELECTRONIC INFORMATION IS SUPPLIED TO THE OTHER ASSOCIATED FIRMS TO ASSIST THEM IN THE EXECUTION OF THEIR WORK. REVIEW THE RECEIPTED FIRMS MUST DETERMINE THE COMPLETENESS, APPROPRIATENESS, RELIANCE OF THE INFORMATION IN RESPECT TO THEIR PARTICULAR RESPONSIBILITY.

GRAZIANI-CORAZZA ARCHITECTS INC. SHALL NOT BE RESPONSIBLE FOR ERRORS, OMISSIONS, INCOMPLETENESS DUE TO LOSS OF INFORMATION IN WHOLE OR PART WHEN INFORMATION IS TRANSMITTED.

1. TRANSMISSION OF ANY LOSS OF DAMAGE TO THE RECEIVING ELECTRONIC SYSTEM WHEN INFORMATION IS TRANSMITTED.

REF.A301a2 FOR CONTINUATION

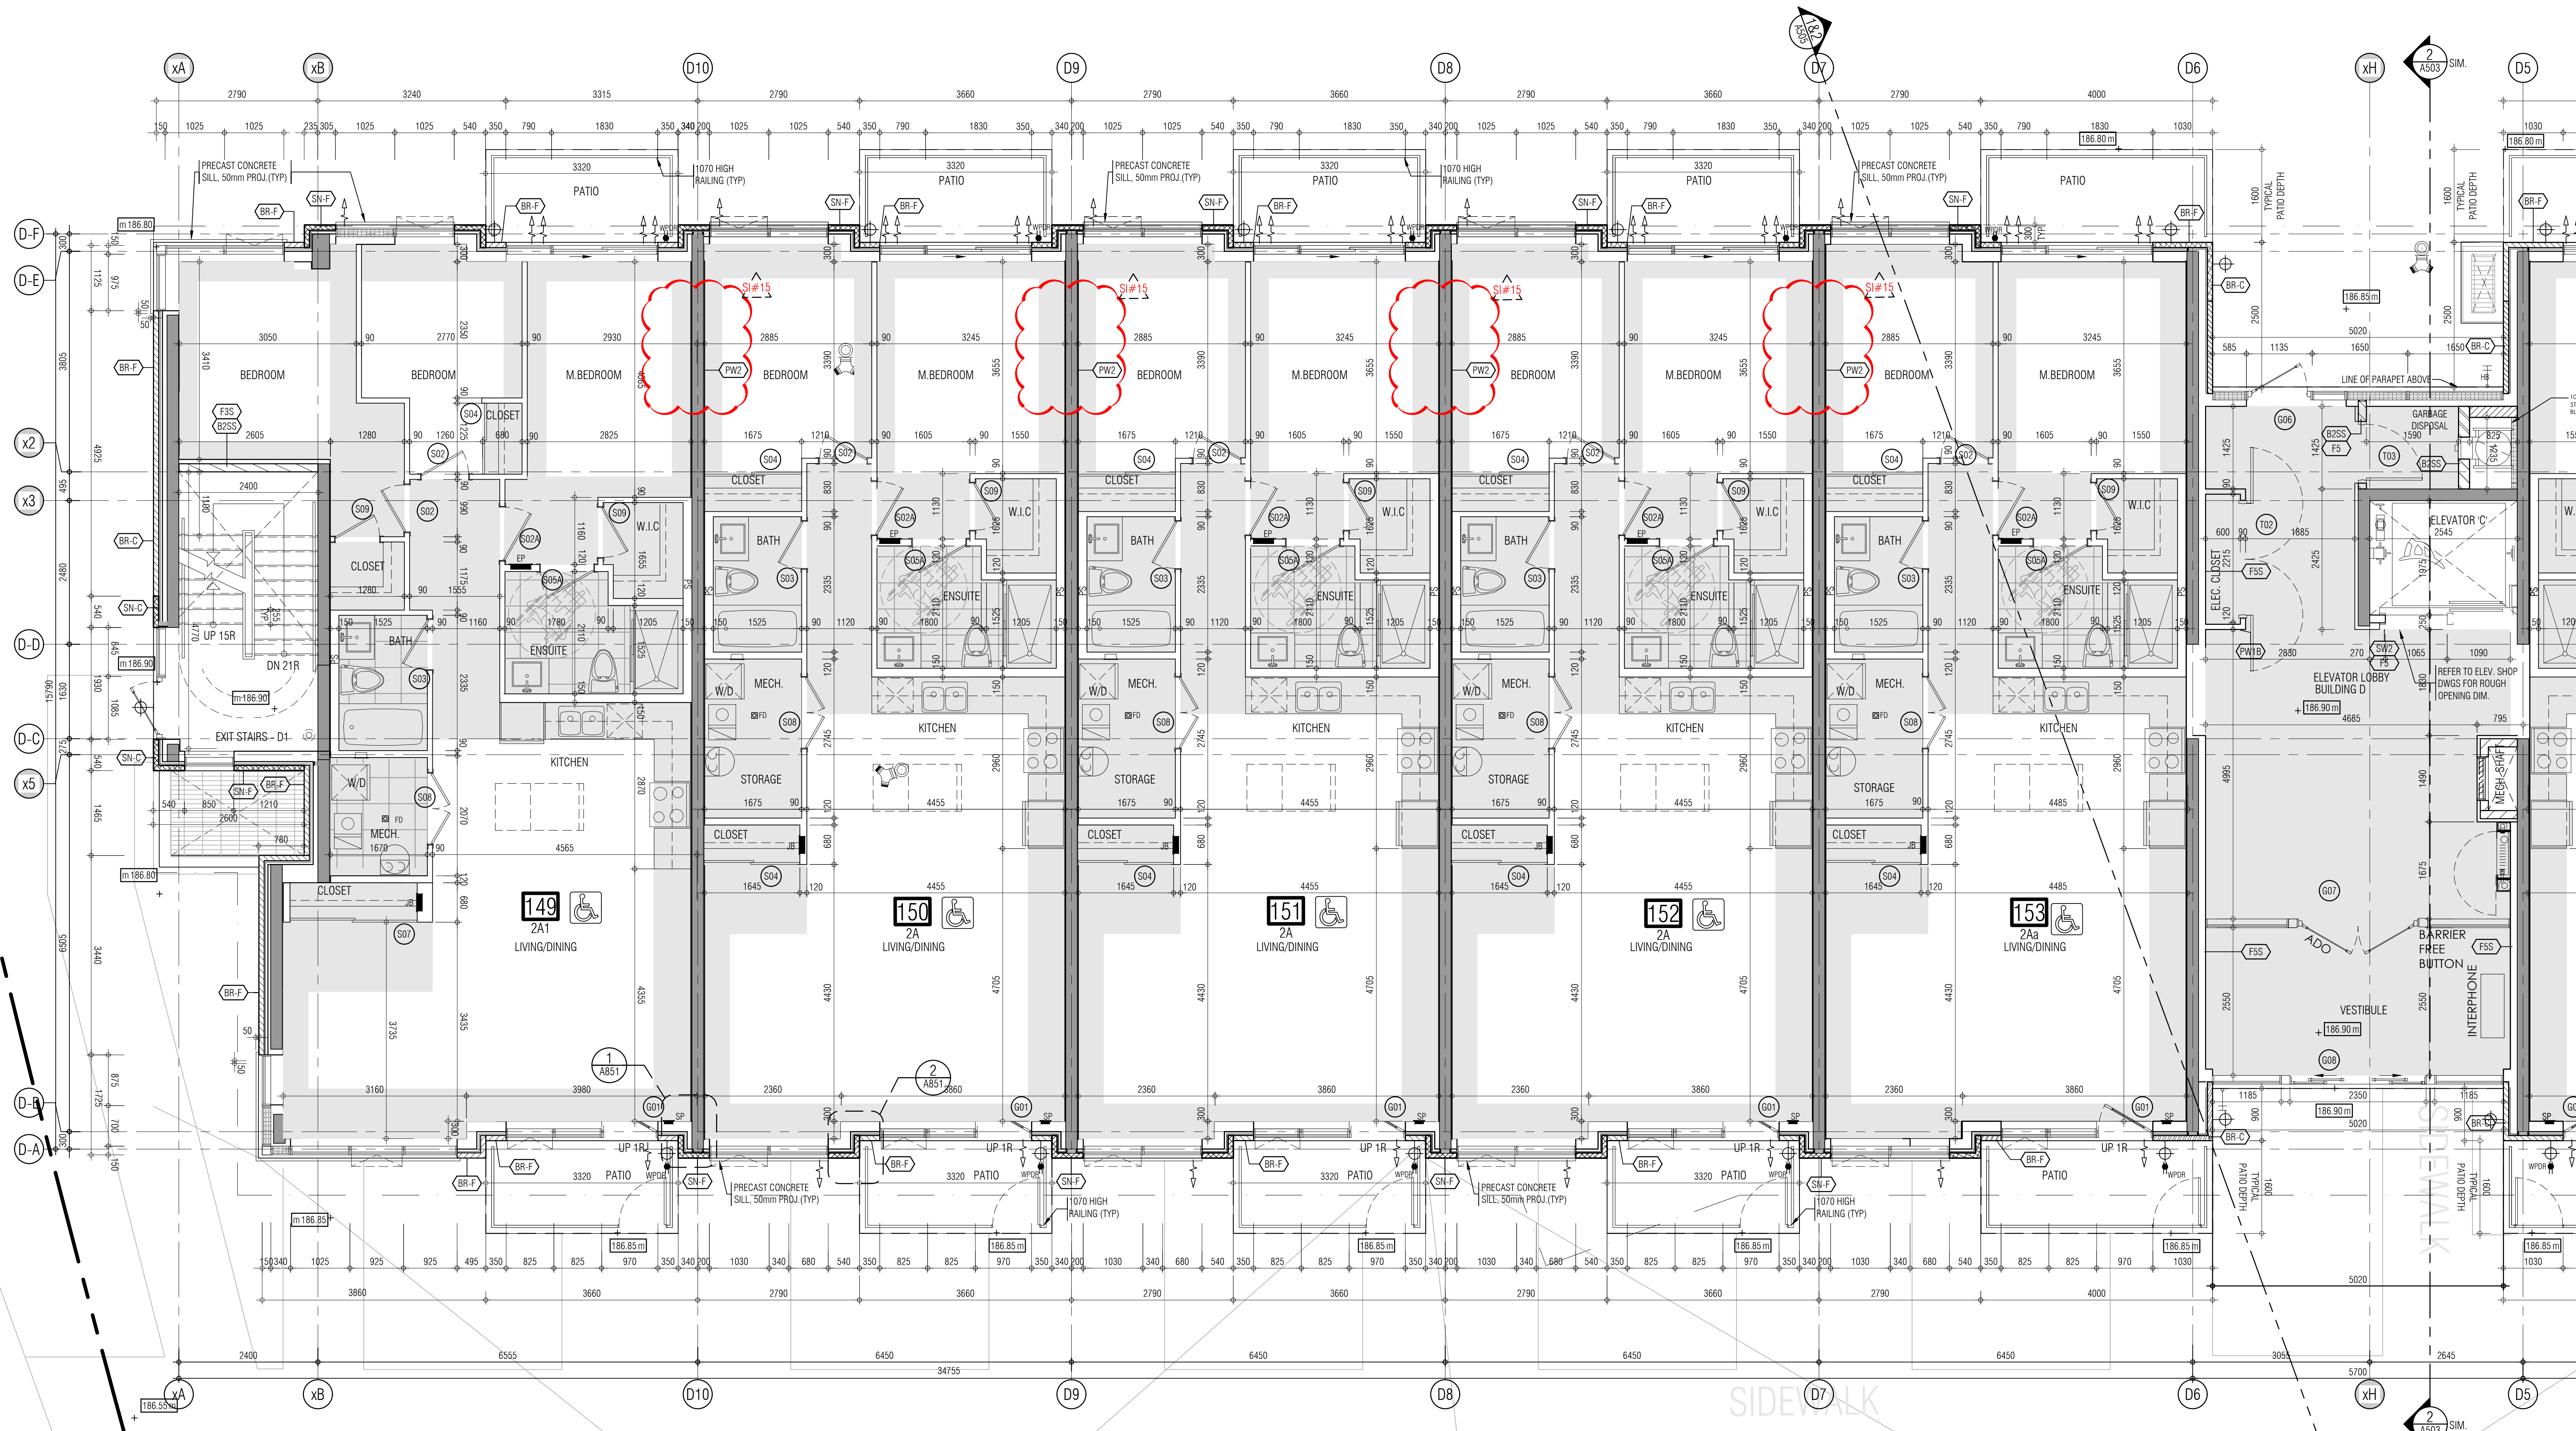

- 01. Oct.07.2019 issued for tender
- 02. Mar.13.2020 issued for design coordination #2
- 03. Mar.16.2020 issued for addendum #2
- 04. Mar.16.2020 issued for addendum #3
- 05. Aug.24.2020 issued for addendum #4
- 06. Sept.28.2020 issued for permit
- 07. Oct.20.2020 issued for addendum #5
- 08. Nov.23.2020 issued for addendum #6
- 09. Dec.14.2020 issued for addendum #7
- 10. Jan.15.2021 issued for addendum #8
- 11. Mar.2.2021 issued for permit
- 12. Mar.09.2021 issued for addendum #9
- 13. Mar.10.2021 issued for addendum #9R
- 14. Mar.26.2021 issued for progress
- 15. May.14.2021 issued for Site Instruction #1
- 16. June.15.2021 issued for Site Instruction #2
- 17. July.7.2021 re-issued for permit
- 18. July.15.2021 issued for Site Instruction #3
- 19. July.27.2021 issued for Site Instruction #4
- 20. Aug.3.2021 issued for Site Instruction #5
- 21. Aug.18.2021 issued for Site Instruction #6
- 22. Aug.20.2021 Re-issued for permit
- 23. Sept.07.2021 issued for Site Instruction #7
- 24. Sept.09.2021 issued for Site Instruction #8
- 25. Sept.16.2021 issued for Building D Permit Revisions
- 26. Sept.22.2021 issued for Site Instruction #9
- 27. Oct.6.2021 Re-issued for permit
- 28. Oct.8.2021 issued for Site Instruction #10
- 30. Oct.28.2021 issued for Site Instruction #11
- 31. Nov.05.2021 issued for Site Instruction #12
- 32. Dec.3.2021 issued for Site Instruction #13
- 33. Dec.6.2021 issued for Site Instruction #14
- 34. Dec.7.2021 issued for Site Instruction #15

01. SEP.18.2021 issued for addendum 1

issued for revisions

GRAZIANI CORAZZA ARCHITECTS

1333 SHAWANAGA DRIVE, SUITE 100 MISSISSAUGA, ONTARIO L4W 1C3
905.709.7021 P.905.709.7088 WWW.GC-ARCHITECTS.COM

ATTMAR + PALLESCI DRIVE


BRAMPTON ONTARIO

PROJECT ARCHITECT: B. GRAZIANI
ASSISTANT DESIGNER: R. LINCOLN
DRAWN BY: G.C./F.C./M.B.
CHECKED BY: D. BIASE/G. COLANGELO
PLOT DATE: DEC.07.2021
JOB #: 1331.15

**GROUND FLOOR PLAN
BUILDING D (PARTIAL PLAN)**

1:50 A-301d1

TITLEBLOCK SIZE: 915 x 1200

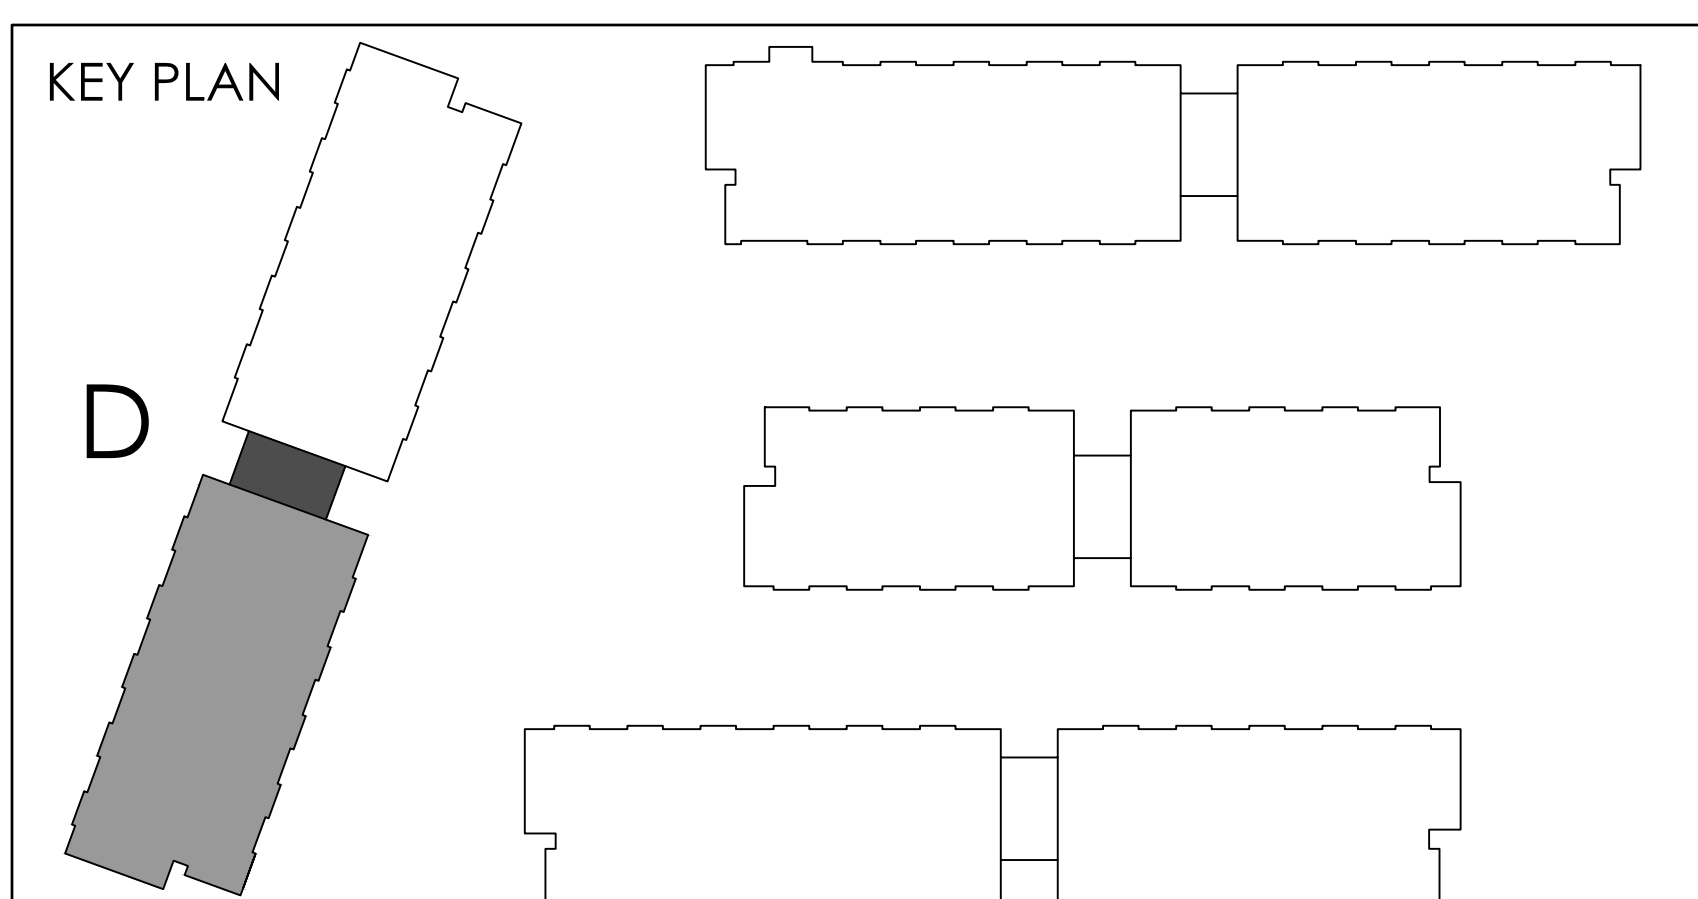

THIS DRAWING IS AN INSTRUMENT OF SERVICE. IT IS PROVIDED BY AND IS THE PROPERTY OF GRAZIANI-CORAZZA ARCHITECTS INC. THE CONTRACTOR MUST VERIFY AND ACCEPT RESPONSIBILITY FOR ALL DIMENSIONS AND COORDINATIONS. THE CONTRACTOR MUST OBTAIN ALL NECESSARY PERMITS AND APPROVALS FROM THE APPROPRIATE AUTHORITIES. GRAZIANI-CORAZZA ARCHITECTS INC. IS NOT RESPONSIBLE FOR THE ACCURACY OF SURVEY, STRUCTURAL, MECHANICAL, ELECTRICAL, AND OTHER ENGINEERING INFORMATION SHOWN ON THIS DRAWING. REFER TO THE APPROPRIATE ENGINEERING DRAWINGS BEFORE PROCEEDING WITH THE WORK. CONSTRUCTION MUST COMPLY TO ALL APPLICABLE CODES AND REQUIREMENTS OF THE AUTHORITIES HAVING JURISDICTION. UNLESS OTHERWISE NOTED, NO MODIFICATION HAS BEEN MADE TO THE INFORMATION IN THIS OFFICE IN REGARD TO THE ENVIRONMENTAL CONDITION OF THIS SITE.

THIS DRAWING IS NOT TO BE SCALED. ALL ARCHITECTURAL SYMBOLS INDICATED ON THIS DRAWING ARE GRAPHIC REPRESENTATIONS ONLY.

CONDITIONS FOR ELECTRONIC INFORMATION TRANSFER

ELECTRONIC INFORMATION IS SUPPLIED TO THE OTHER ASSOCIATED FIRMS TO ASSIST THEM IN THE EXECUTION OF THEIR WORK. REVIEW THE RECEIPT FROM MUST DETERMINE THE COMPLETENESS, APPROPRIATENESS, RELIANCE OF THE INFORMATION IN RESPECT TO THEIR PARTICULAR RESPONSIBILITY.

GRAZIANI-CORAZZA ARCHITECTS INC. SHALL NOT BE RESPONSIBLE FOR ERROR, OMISSION, INCOMPLETENESS DUE TO LOSS OF INFORMATION IN WHOLE OR PART WHEN INFORMATION IS TRANSMITTED.

1. TRANSMISSION OF ANY LOSS OF DAMAGE TO THE RECEIVING ELECTRONIC SYSTEM WHEN INFORMATION IS TRANSMITTED.

01. Oct.07.2019 issued for tender
02. Mar.13.2020 issued for design coordination #2
03. Mar.16.2020 issued for addendum #2
04. Mar.16.2020 issued for addendum #3
05. Aug.24.2020 issued for addendum #4
06. Sept.28.2020 issued for permit
07. Oct.20.2020 issued for addendum #5
08. Nov.23.2020 issued for addendum #6
09. Dec.14.2020 issued for addendum #7
10. Jan.18.2021 issued for addendum #8
11. Mar.2.2021 issued for permit
12. Mar.09.2021 issued for addendum #9
13. Mar.10.2021 issued for addendum #9R
14. Mar.26.2021 issued for progress
15. May.14.2021 issued for Site Instruction #1
16. June.15.2021 issued for Site Instruction #2
17. July.7.2021 re-issued for permit
18. July.15.2021 issued for Site Instruction #3
19. July.27.2021 issued for Site Instruction #4
20. Aug.3.2021 issued for Site Instruction #5
21. Aug.18.2021 issued for Site Instruction #6
22. Aug.20.2021 Re-issued for permit
23. Sept.07.2021 issued for Site Instruction #7
24. Sept.09.2021 issued for Site Instruction #8
25. Sept.16.2021 issued for Building D Permit Revisions
26. Sept.22.2021 issued for Site Instruction #9
27. Oct.6.2021 Re-issued for permit
28. Oct.8.2021 issued for Site Instruction #10
30. Oct.28.2021 issued for Site Instruction #11
31. Nov.05.2021 issued for Site Instruction #12
32. Dec.3.2021 issued for Site Instruction #13
33. Dec.6.2021 issued for Site Instruction #14
34. Dec.7.2021 issued for Site Instruction #15

01. SEP.18.2021 issued for addendum 1

issued for revisions

GRAZIANI CORAZZA ARCHITECTS

1333 SHAWANESSA DRIVE, SUITE 100 MISSISSAUGA, ONTARIO L4W 1C3
905.763.7001 P.905.763.7000 WWW.GC-ARCHITECTS.COM

RESIDENTIAL

ATTMARR + PALLESCHI DRIVE

BRAMPTON ONTARIO

PROJECT ARCHITECT: B. GRAZIANI

ASSISTANT DESIGNER: R. LINCOLN

DRAWN BY: G.C./F.C./M.B.

CHECKED BY: D. BIASE/G. COLANGELO

PLANT DATE: DEC.07.2021

JOB # 1331.15


GROUND FLOOR PLAN

BUILDING D (PARTIAL PLAN)

1:50 A-301d2

TITLEBLOCK SIZE: 915 x 1200

REF_A301a1 FOR CONTINUATION

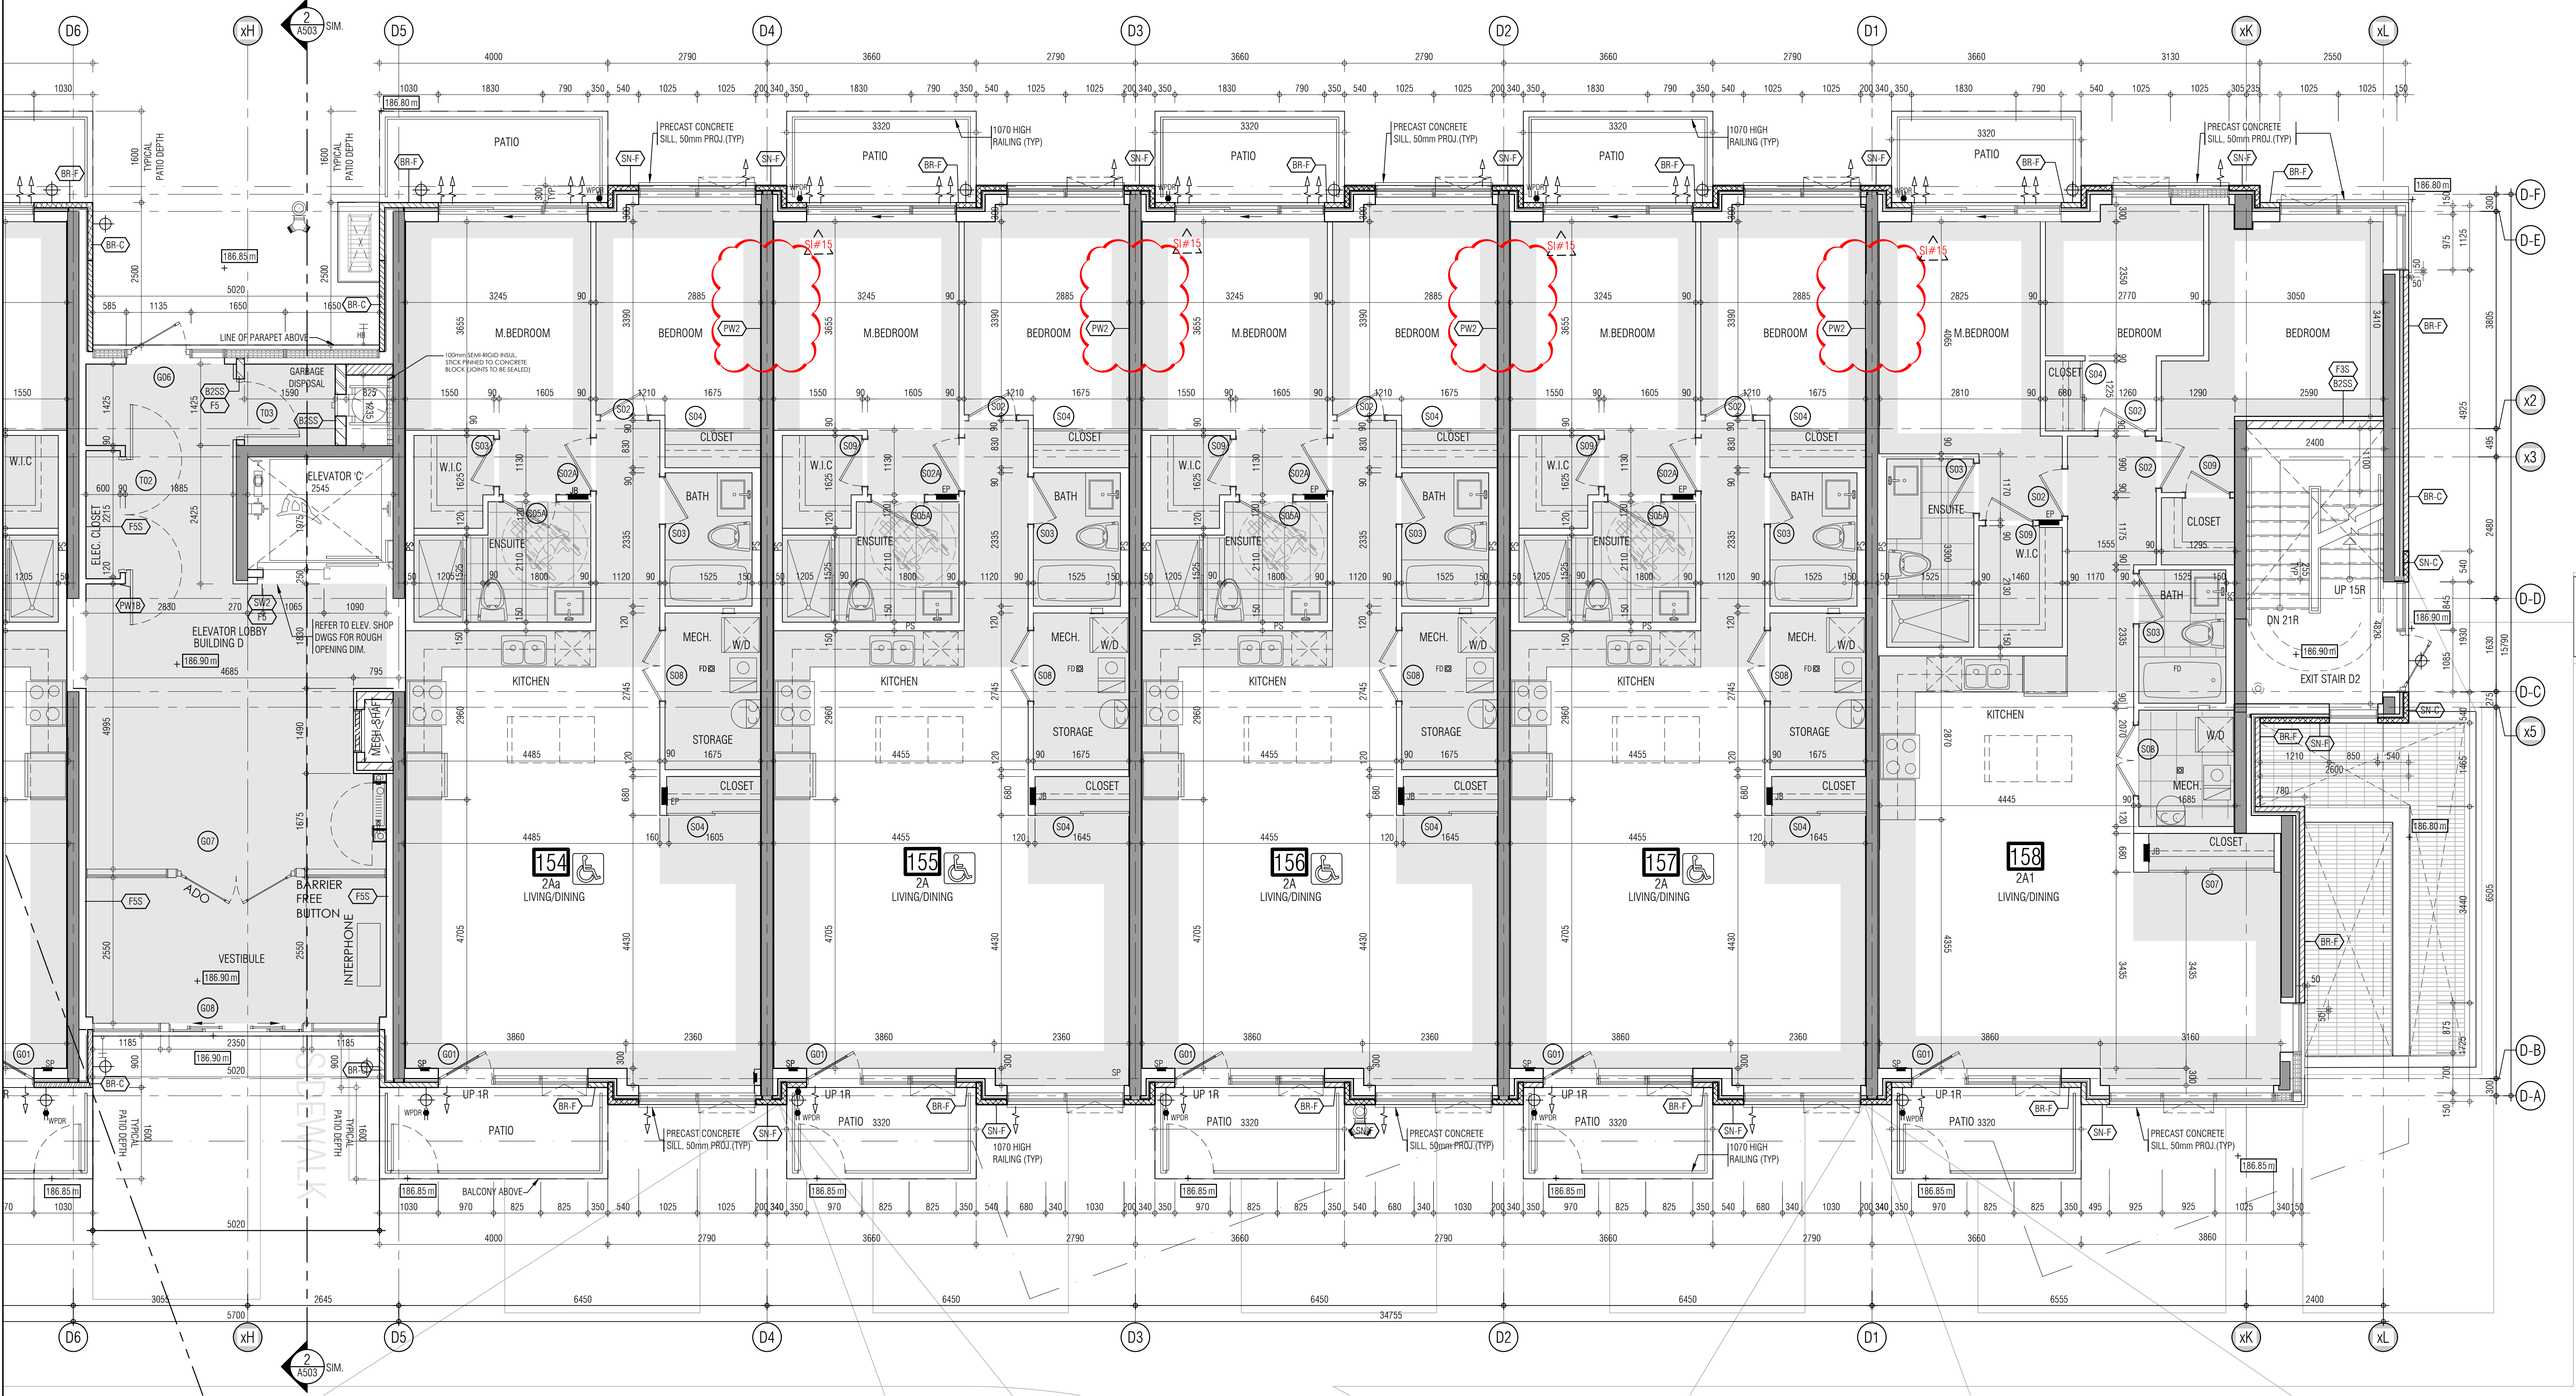

THIS DRAWING AS AN INSTRUMENT OF SERVICE, IS PROVIDED BY AND IS THE PROPERTY OF GRAZIANI-CORAZZA ARCHITECTS INC. THE CONTRACTOR MUST VERIFY AND ACCEPT RESPONSIBILITY FOR ALL DIMENSIONS AND COORDINATE THE SITE AND MUST NOTIFY GRAZIANI-CORAZZA ARCHITECTS INC. OF ANY VARIATIONS FROM THE SUPPLIED INFORMATION. GRAZIANI-CORAZZA ARCHITECTS INC. IS NOT RESPONSIBLE FOR THE ACCURACY OF SURVEY, STRUCTURAL, MECHANICAL, ELECTRICAL, AND OTHER INFORMATION SHOWN ON THE DRAWING. REFER TO THE APPROPRIATE ENGINEERING DRAWINGS BEFORE PROCEEDING WITH THE WORK. CONSTRUCTION MUST CONFORM TO ALL APPLICABLE CODES AND REQUIREMENTS OF THE AUTHORITY HAVING JURISDICTION. UNLESS OTHERWISE NOTED, NO MODIFICATION HAS BEEN MADE/MADE AS REPORTED IN BY THIS OFFICE IN REGARDS TO THE ENVIRONMENTAL CONDITION OF THIS SITE.


THIS DRAWING IS NOT TO BE SCALED. ALL ARCHITECTURAL SYMBOLS INDICATED ON THIS DRAWING ARE GRAPHIC REPRESENTATIONS ONLY.

CONDITIONS FOR ELECTRONIC INFORMATION TRANSFER

ELECTRONIC INFORMATION IS SUPPLIED TO THE OTHER ASSOCIATED FIRMS TO ASSIST THEM IN THE EXECUTION OF THEIR WORK. REVIEW THE RECIPIENT FIRMS MUST DETERMINE THE COMPLETENESS, APPROPRIATENESS, RELIANCE OF THE INFORMATION IN RESPECT TO THEIR PARTICULAR RESPONSIBILITY.

GRAZIANI-CORAZZA ARCHITECTS INC. SHALL NOT BE RESPONSIBLE FOR ERRORS, OMISSIONS, INCOMPLETENESS DUE TO LOSS OF INFORMATION IN WHOLE OR PART WHEN INFORMATION IS TRANSFERRED.

1. TRANSMISSION OF ANY LOSS OF DAMAGE TO THE RECEIVING ELECTRONIC SYSTEM WHEN INFORMATION IS TRANSFERRED.

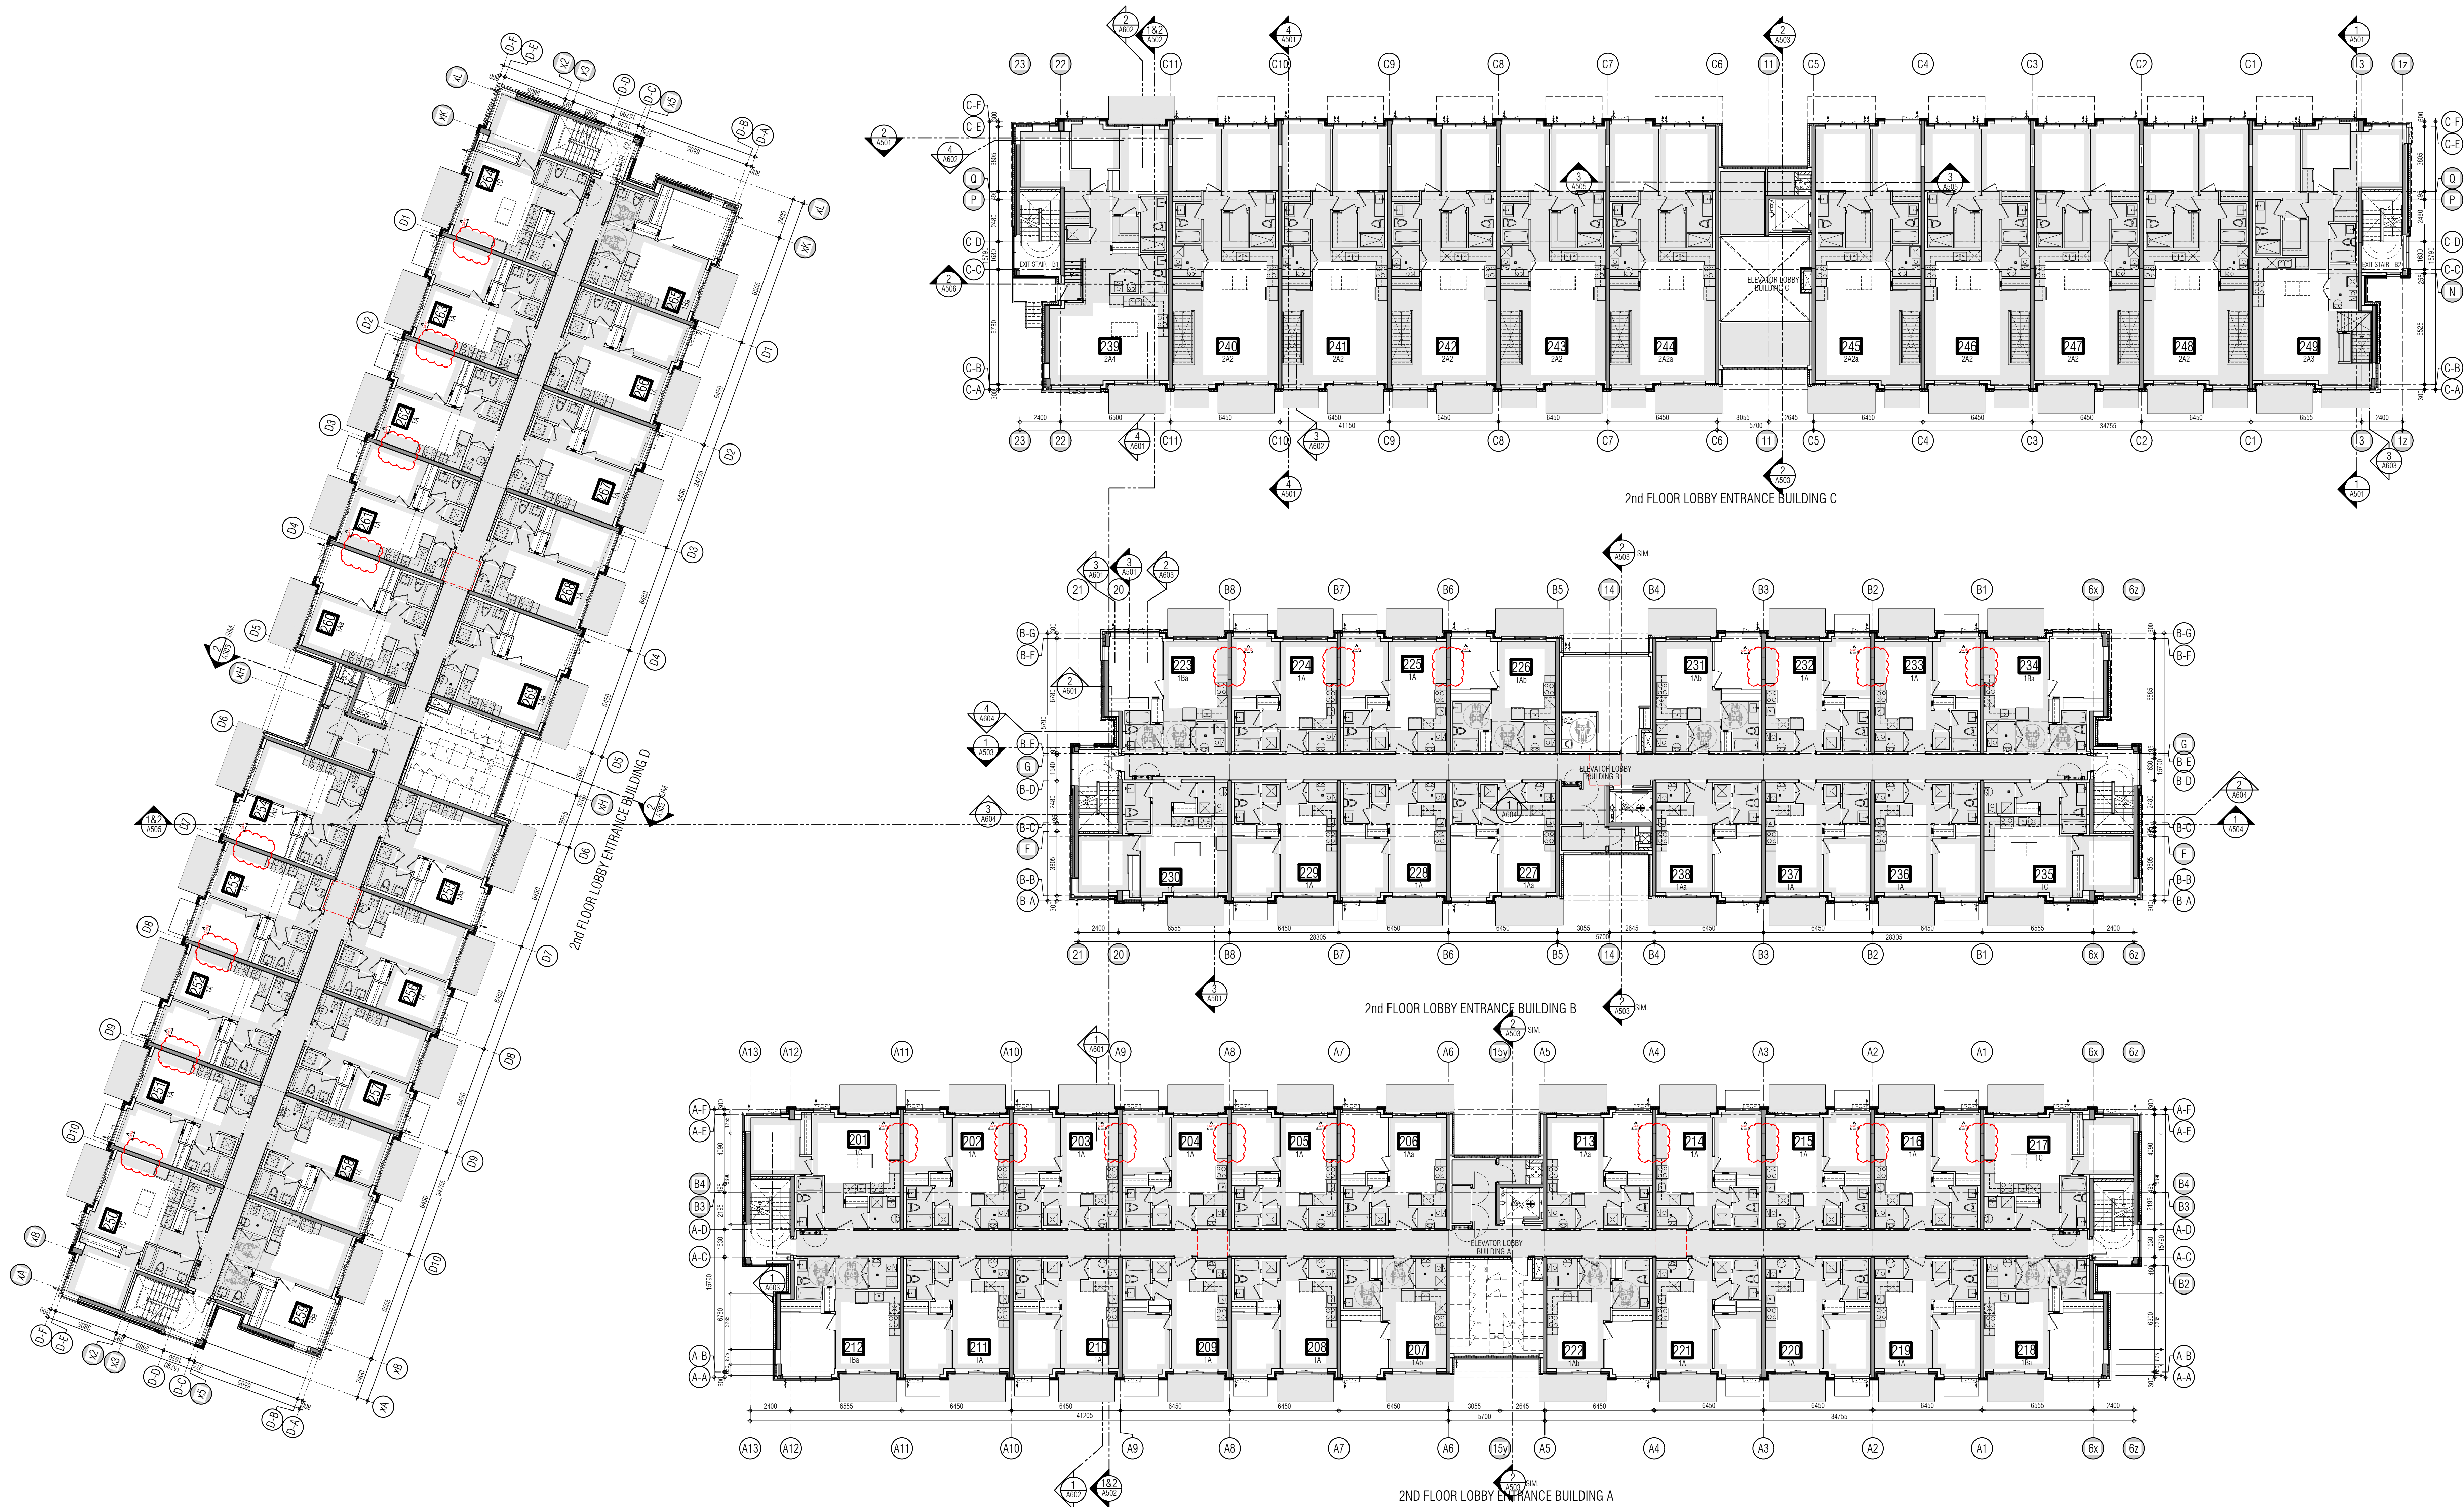

- 01. Oct.07.2019 issued for tender
- 02. Mar.13.2020 issued for design coordination #2
- 03. Mar.16.2020 issued for addendum #2
- 04. Mar.16.2020 issued for addendum #3
- 05. Aug.24.2020 issued for addendum #4
- 06. Sept.28.2020 issued for permit
- 07. Oct.20.2020 issued for addendum #5
- 08. Nov.23.2020 issued for addendum #6
- 09. Dec.14.2020 issued for addendum #7
- 10. Jan.15.2021 issued for addendum #8
- 11. Mar.2.2021 issued for permit
- 12. Mar.09.2021 issued for addendum #9
- 13. Mar.10.2021 issued for addendum #9R
- 14. Mar.26.2021 issued for progress
- 15. May.14.2021 issued for Site Instruction #1
- 16. June.15.2021 issued for Site Instruction #2
- 17. July.7.2021 re-issued for permit
- 18. July.15.2021 issued for Site Instruction #3
- 19. July.27.2021 issued for Site Instruction #4
- 20. Aug.3.2021 issued for Site Instruction #5
- 21. Aug.18.2021 issued for Site Instruction #6
- 22. Aug.20.2021 Re-issued for permit
- 23. Sept.07.2021 issued for Site Instruction #7
- 24. Sept.09.2021 issued for Site Instruction #8
- 25. Sept.16.2021 issued for Building D Permit Revisions
- 26. Sept.22.2021 issued for Site Instruction #9
- 27. Oct.6.2021 Re-issued for permit
- 28. Oct.8.2021 issued for Site Instruction #10
- 29. Oct.28.2021 issued for Site Instruction #11
- 30. Nov.05.2021 issued for Site Instruction #12
- 31. Dec.3.2021 issued for Site Instruction #13
- 32. Dec.6.2021 issued for Site Instruction #14
- 33. Dec.7.2021 issued for Site Instruction #15

- 01. SEP.18.2019 issued for Addendum 1
 - 01. Apr.19.2021 issued to client
- issued for revisions

GRAZIANI CORAZZA ARCHITECTS

1333 SHAWANIGAN DRIVE, SUITE 100 MISSISSAUGA, ONTARIO L4W 1C3
905.709.7001 P.905.709.7000 WWW.GC-ARCHITECTS.COM

ROOF LINE

ATTMOR + PALLESCHI DRIVE

BRAMPTON ONTARIO

PROJECT ARCHITECT: B.GRAZIANI
ASSISTANT DESIGNER: R.LINCOLN
DRAWN BY: G.C./F.C./M.B.
CHECKED BY: D.BIASSE/G.COLANGELO
PLOT DATE: DEC.07.2021
JOB #: 1331.15

SECOND FLOOR OVERALL PLAN

THIS DRAWING IS NOT TO BE SCALED. ALL ARCHITECTURAL SYMBOLS INDICATED ON THIS DRAWING ARE GRAPHIC REPRESENTATIONS ONLY.

CONDITIONS FOR ELECTRONIC INFORMATION TRANSFER

ELECTRONIC INFORMATION IS SUPPLIED TO THE OTHER ASSOCIATED FIRMS TO ASSIST THEM IN THE EXECUTION OF THEIR WORK. REVIEW THE RECIPIENT FIRMS BEST PRACTICES FOR THE PROTECTION OF CONFIDENTIALITY AND RELEVANCE OF THE INFORMATION IN RESPECT TO THEIR PARTICULAR RESPONSIBILITY.

GRADY+CORAZZA ARCHITECTS, INC. SHALL NOT BE RESPONSIBLE FOR:

1. DIVULGING ORIGINATING INADEQUACIES DUE TO LOSS OF INFORMATION IN WHOLE OR PART WHEN INFORMATION IS TRANSFERRED.
2. TRANSMISSION OF ANY VIRUS OR DAMAGE TO THE RECEIVING ELECTRONIC SYSTEM WHEN INFORMATION IS TRANSFERRED.

Oct. 07.2019	Issued for tender	—
Mar. 13.2020	Issued for design construction #2	—
Mar. 16.2020	Issued for addendum #2	—
Mar. 20.2020	Issued for addendum #3	—
Aug. 24.2020	Issued for addendum #4	—
Sept. 28.2020	Issued for permit	bq
Oct. 20.2020	Issued for addendum #5	—
Nov. 23.2020	Issued for addendum #6	—
Dec. 14.2020	Issued for addendum #7	—
Jan. 16.2021	Issued for addendum #8	—
Mar. 2.2021	Issued for permit	bq
Mar. 09.2021	Issued for addendum #9	—
Mar. 10.2021	Issued for addendum #9R	—
Mar. 26.2021	Issued for progress	—
May. 14.2021	Issued for Site Instruction #1	—
June 15.2021	Issued for Site Instruction #2	—
July 7.2021	Re-issued for permit	bq
July 15.2021	Issued for Site Instruction #3	—
July 27.2021	Issued for Site Instruction #4	bq
Aug. 3.2021	Issued for Site Instruction #5	—
Aug. 18.2021	Issued for Site Instruction #6	bq
Aug. 20.2021	Re-issued for permit.	—
Sept. 07.2021	Issued for Site Instruction #7	bq
Sept. 09.2021	Issued for Site Instruction #8	bq
Sept. 16.2021	Issued for Building D Permit Revisions	—
Sept. 22.2021	Issued for Site Instruction #9	—
Oct. 6.2021	Re-issued for permit.	—
Oct. 8.2021	Issued for Site Instruction #10	bq
Oct. 28.2021	Issued for Site Instruction #11	—
Nov. 05.2021	Issued for Site Instruction #12	bq
Dec. 3.2021	Issued for Site Instruction #13	—
Dec. 6.2021	Issued for Site Instruction #14	bq
Dec. 7.2021	Issued for Site Instruction #15	—







SECOND FLOOR PLAN

BUILDING A (PARTIAL PLAN)

LOCK SIZE: 915 x 1200

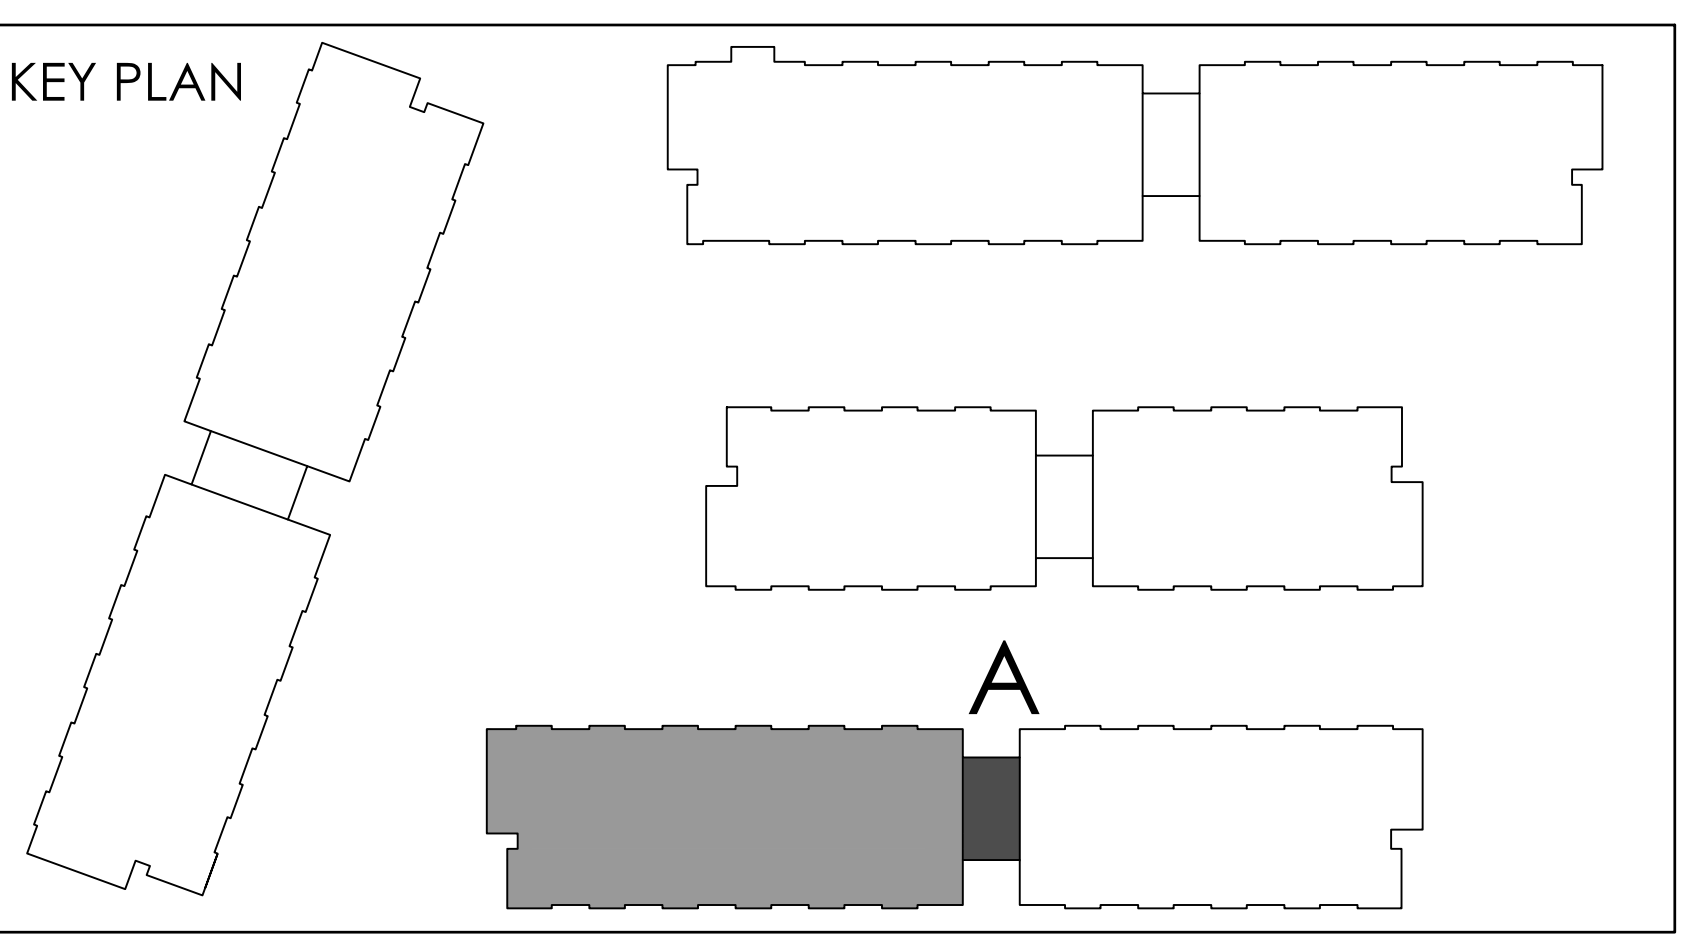

REF.A302d1 FOR CONTINUATION

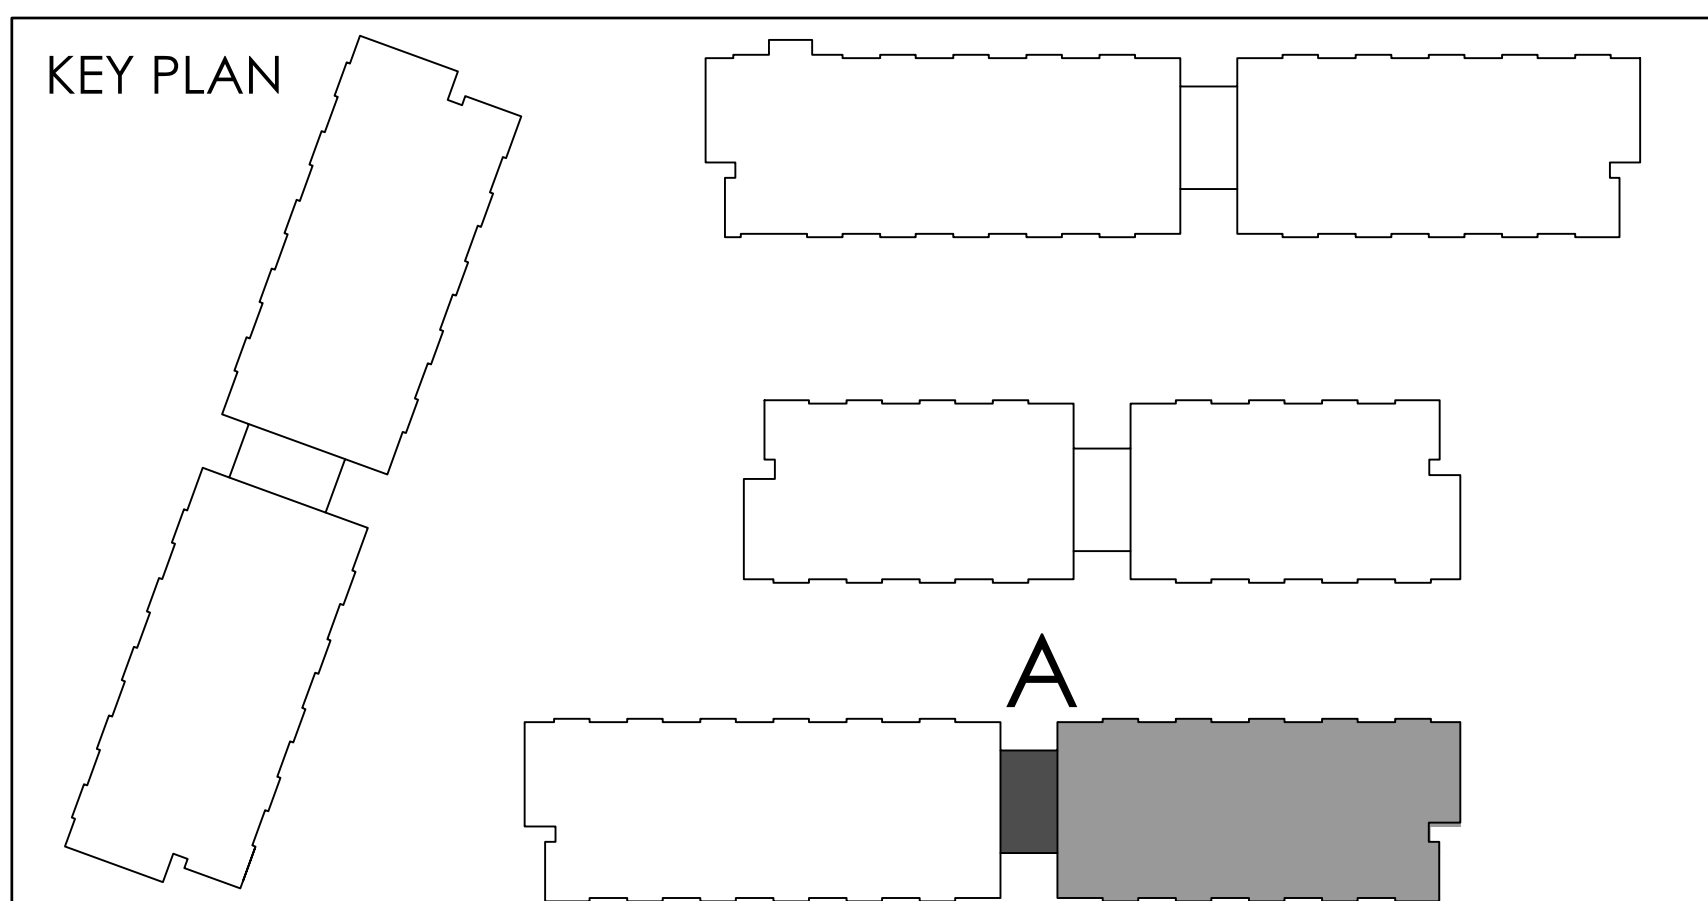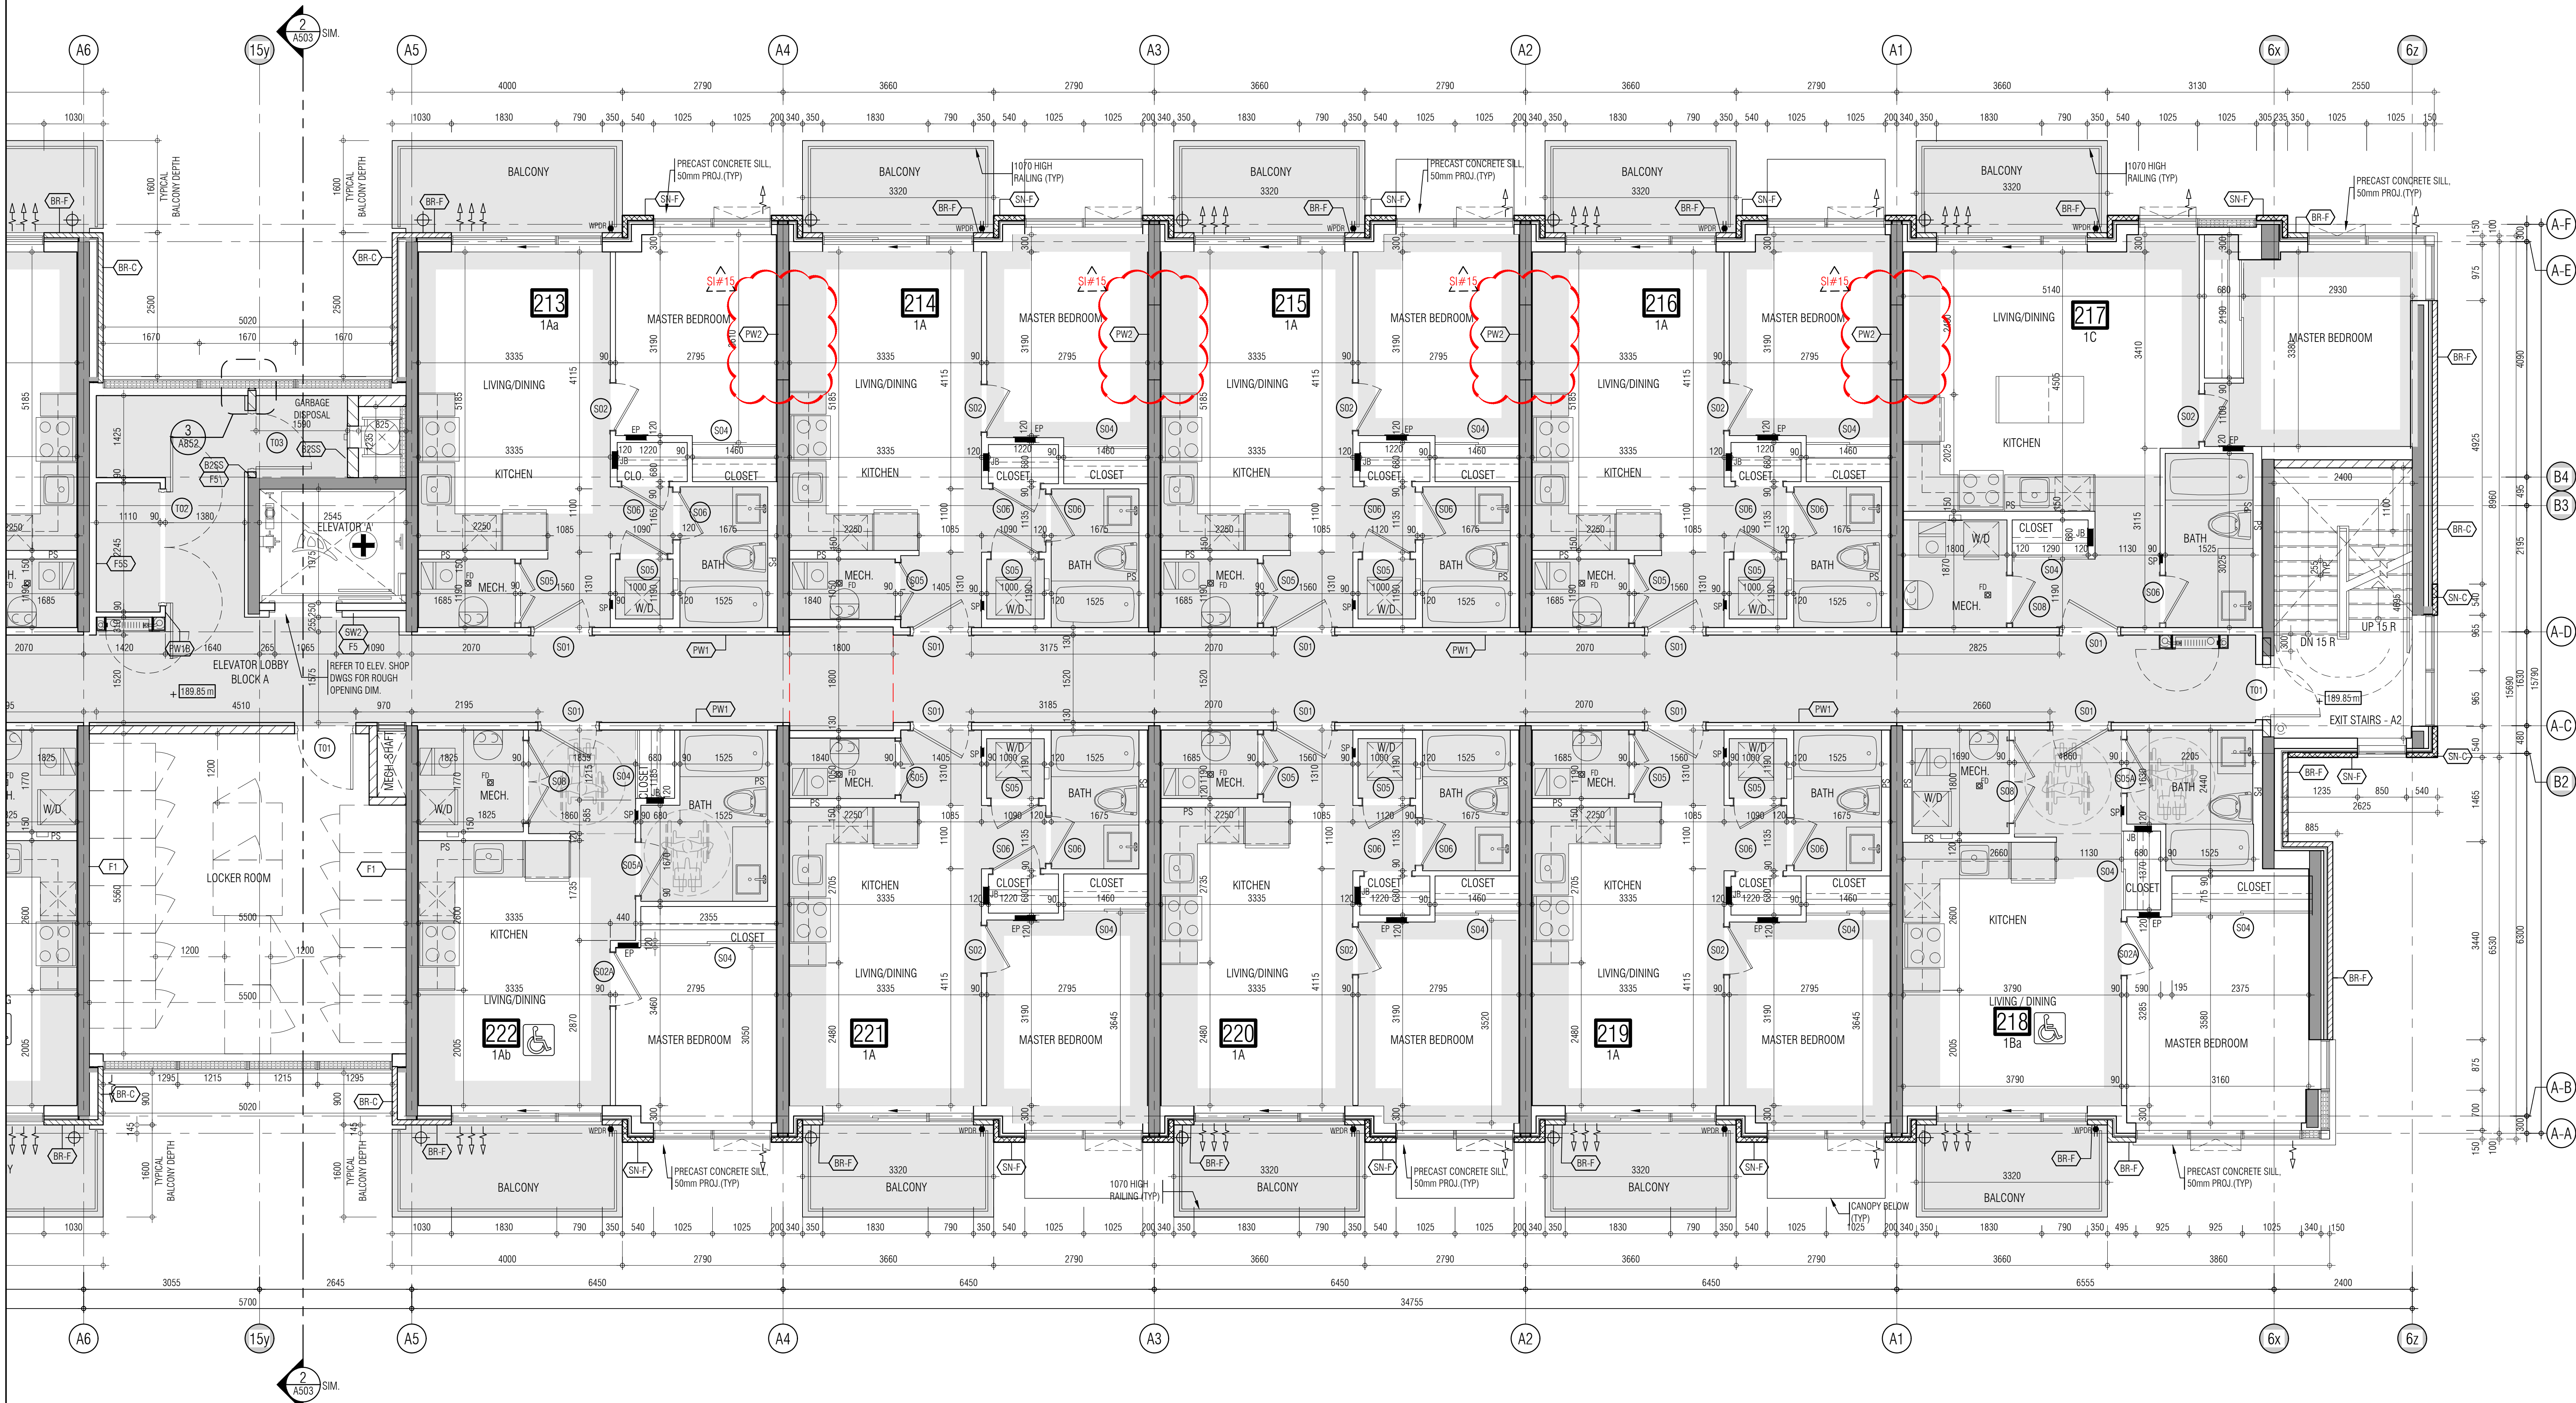

THIS DRAWING IS AN INSTRUMENT OF SERVICE, IT IS PROVIDED BY AND IS THE PROPERTY OF GRAZIANI CORAZZA ARCHITECTS INC. THE CONTRACTOR MUST VERIFY AND ACCEPT RESPONSIBILITY FOR ALL DIMENSIONS AND CONTAINING DATA AND MUST NOT REPRODUCE OR TRANSMIT ANY PART OF THIS DRAWING WITHOUT THE WRITTEN PERMISSION OF GRAZIANI CORAZZA ARCHITECTS INC. IT IS NOT RESPONSIBLE FOR THE ACCURACY OF SURVEY, STRUCTURAL, MECHANICAL, ELECTRICAL AND OTHER ENGINEERING INFORMATION SHOWN ON THIS DRAWING. REFER TO THE APPROPRIATE ENGINEERING DRAWINGS BEFORE PROCEEDING WITH THE WORK. CONSTRUCTION MUST CONFORM TO ALL APPLICABLE CODES AND REQUIREMENTS OF THE AUTHORITY HAVING JURISDICTION. UNLESS OTHERWISE NOTED, NO MODIFICATION HAS BEEN MADE TO THE INFORMATION IN THIS OFFICE IN REGARDS TO THE ENVIRONMENTAL CONDITION OF THIS SITE.

THIS DRAWING IS NOT TO BE SCALED. ALL ARCHITECTURAL SYMBOLS INDICATED ON THIS DRAWING ARE GRAPHIC REPRESENTATIONS ONLY.

CONDITIONS FOR ELECTRONIC INFORMATION TRANSFER:

ELECTRONIC INFORMATION IS SUPPLIED TO THE OTHER ASSOCIATED FIRMS TO ASSIST THEM IN THE EXECUTION OF THEIR WORK. REVIEW THE RECEIVED FIRMS MUST DETERMINE THE COMPLETENESS, APPROPRIATENESS, RELIANCE OF THE INFORMATION IN RESPECT TO THEIR PARTICULAR RESPONSIBILITY.

GRAZIANI CORAZZA ARCHITECTS INC. SHALL NOT BE RESPONSIBLE FOR:

1. ERRORS, OMISSIONS, INCOMPLETENESS DUE TO LOSS OF INFORMATION IN WHICH NO PART OF INFORMATION IS TRANSMITTED.

2. TRANSMISSION OF ANY LOSS OR DAMAGE TO THE RECEIVING ELECTRONIC SYSTEM WHEN INFORMATION IS TRANSMITTED.

- 01. Oct.07.2019 issued for tender
- 02. Mar.13.2020 issued for design coordination #2
- 03. Mar.16.2020 issued for addendum #2
- 04. Mar.16.2020 issued for addendum #3
- 05. Aug.24.2020 issued for addendum #4
- 06. Sept. 28.2020 issued for permit
- 07. Oct.20.2020 issued for addendum #5
- 08. Nov.23.2020 issued for addendum #6
- 09. Dec.14.2020 issued for addendum #7
- 10. Jan.18.2021 issued for addendum #8
- 11. Mar. 2. 2021 issued for permit
- 12. Mar.09.2021 issued for addendum #9
- 13. Mar.10.2021 issued for addendum #9R
- 14. Mar.26.2021 issued for progress
- 15. May.14. 2021 issued for Site Instruction #1
- 16. June.15. 2021 issued for Site Instruction #2
- 17. July. 7. 2021 re-issued for permit
- 18. July. 15. 2021 issued for Site Instruction #3
- 19. July. 27. 2021 issued for Site Instruction #4
- 20. Aug. 3. 2021 issued for Site Instruction #5
- 21. Aug. 18. 2021 issued for Site Instruction #6
- 22. Aug. 20. 2021 Re-issued for permit
- 23. Sept. 07. 2021 issued for Site Instruction #7
- 24. Sept. 09. 2021 issued for Site Instruction #8
- 25. Sept. 16. 2021 issued for Building D Permit Revisions
- 26. Sept. 22. 2021 issued for Site Instruction #9
- 27. Oct. 6. 2021 Re-issued for permit
- 28. Oct. 8. 2021 issued for Site Instruction #10
- 30. Oct. 28. 2021 issued for Site Instruction #11
- 31. Nov. 05. 2021 issued for Site Instruction #12
- 32. Dec. 3. 2021 issued for Site Instruction #13
- 33. Dec. 6. 2021 issued for Site Instruction #14
- 34. Dec. 7. 2021 issued for Site Instruction #15

01. SEP.18.2019 issued for revisions

GRAZIANI CORAZZA ARCHITECTS

1100 SHANAGHAN DRIVE, SUITE 100 MISSISSAUGA, ONTARIO L4W 1C3
905.709.7041 F.905.709.7040 WWW.GC-ARCHITECTS.COM

RESIDENTIAL

ATTMAR + PALLESCHI DRIVE

BRAMPTON ONTARIO

PROJECT ARCHITECT: B. GRAZIANI
ASSISTANT DESIGNER: R. LINCOLN
DRAWN BY: G.C./F.C./M.B.
CHECKED BY: D. BIASE/G. COLANGELO
PLOT DATE: DEC.07.2021
JOB #: 1331.15

**SECOND FLOOR PLAN
BUILDING A (PARTIAL PLAN)**

1:50 A-302a2

TITLEBLOCK SIZE: 915 x 1200

THIS DRAWING IS AN INSTRUMENT OF SERVICE, IT IS PROVIDED BY AND IS THE PROPERTY OF GRAZIANI CORAZZA ARCHITECTS INC. THE CONTRACTOR MUST VERIFY AND ACCEPT RESPONSIBILITY FOR ALL DIMENSIONS AND COORDINATE ON SITE AND MUST NOTIFY GRAZIANI CORAZZA ARCHITECTS INC. OF ANY VARIATIONS FROM THE SUPPLIED INFORMATION. GRAZIANI CORAZZA ARCHITECTS INC. IS NOT RESPONSIBLE FOR THE ACCURACY OF SURVEY, STRUCTURAL, MECHANICAL, ELECTRICAL AND OTHER ENGINEERING INFORMATION SHOWN ON THIS DRAWING. REFER TO THE APPROPRIATE ENGINEERING DRAWINGS BEFORE PROCEEDING WITH THE WORK. CONSTRUCTION MUST COMPLY TO ALL APPLICABLE CODES AND REQUIREMENTS OF THE AUTHORITIES HAVING JURISDICTION. UNLESS OTHERWISE NOTED, NO INVESTIGATION HAS BEEN UNDERTAKEN OR REPORTED IN BY THIS OFFICE IN REGARDS TO THE ENVIRONMENTAL CONDITION OF THIS SITE.


THIS DRAWING IS NOT TO BE SCALED. ALL ARCHITECTURAL SYMBOLS INDICATED ON THIS DRAWING ARE GRAPHIC REPRESENTATIONS ONLY.

CONDITIONS FOR ELECTRONIC INFORMATION TRANSFER:

ELECTRONIC INFORMATION IS SUPPLIED TO THE OTHER ASSOCIATED FIRMS TO ASSIST THEM IN THE EXECUTION OF THEIR WORK. REVIEW THE RECEIPT FROM MUST DETERMINE THE COMPLETENESS, APPROPRIATENESS, RELIANCE OF THE INFORMATION IN RESPECT TO THEIR PARTICULAR RESPONSIBILITY.

GRAZIANI CORAZZA ARCHITECTS INC. SHALL NOT BE RESPONSIBLE FOR ERRORS, OMISSIONS, INCOMPLETENESS DUE TO LOSS OF INFORMATION IN 1. WHICH OR PART INFORMATION IS TRANSMITTED.

2. TRANSMISSION OF ANY FILES OR DAMAGE TO THE RECEIVING ELECTRONIC SYSTEM WHEN INFORMATION IS TRANSMITTED.

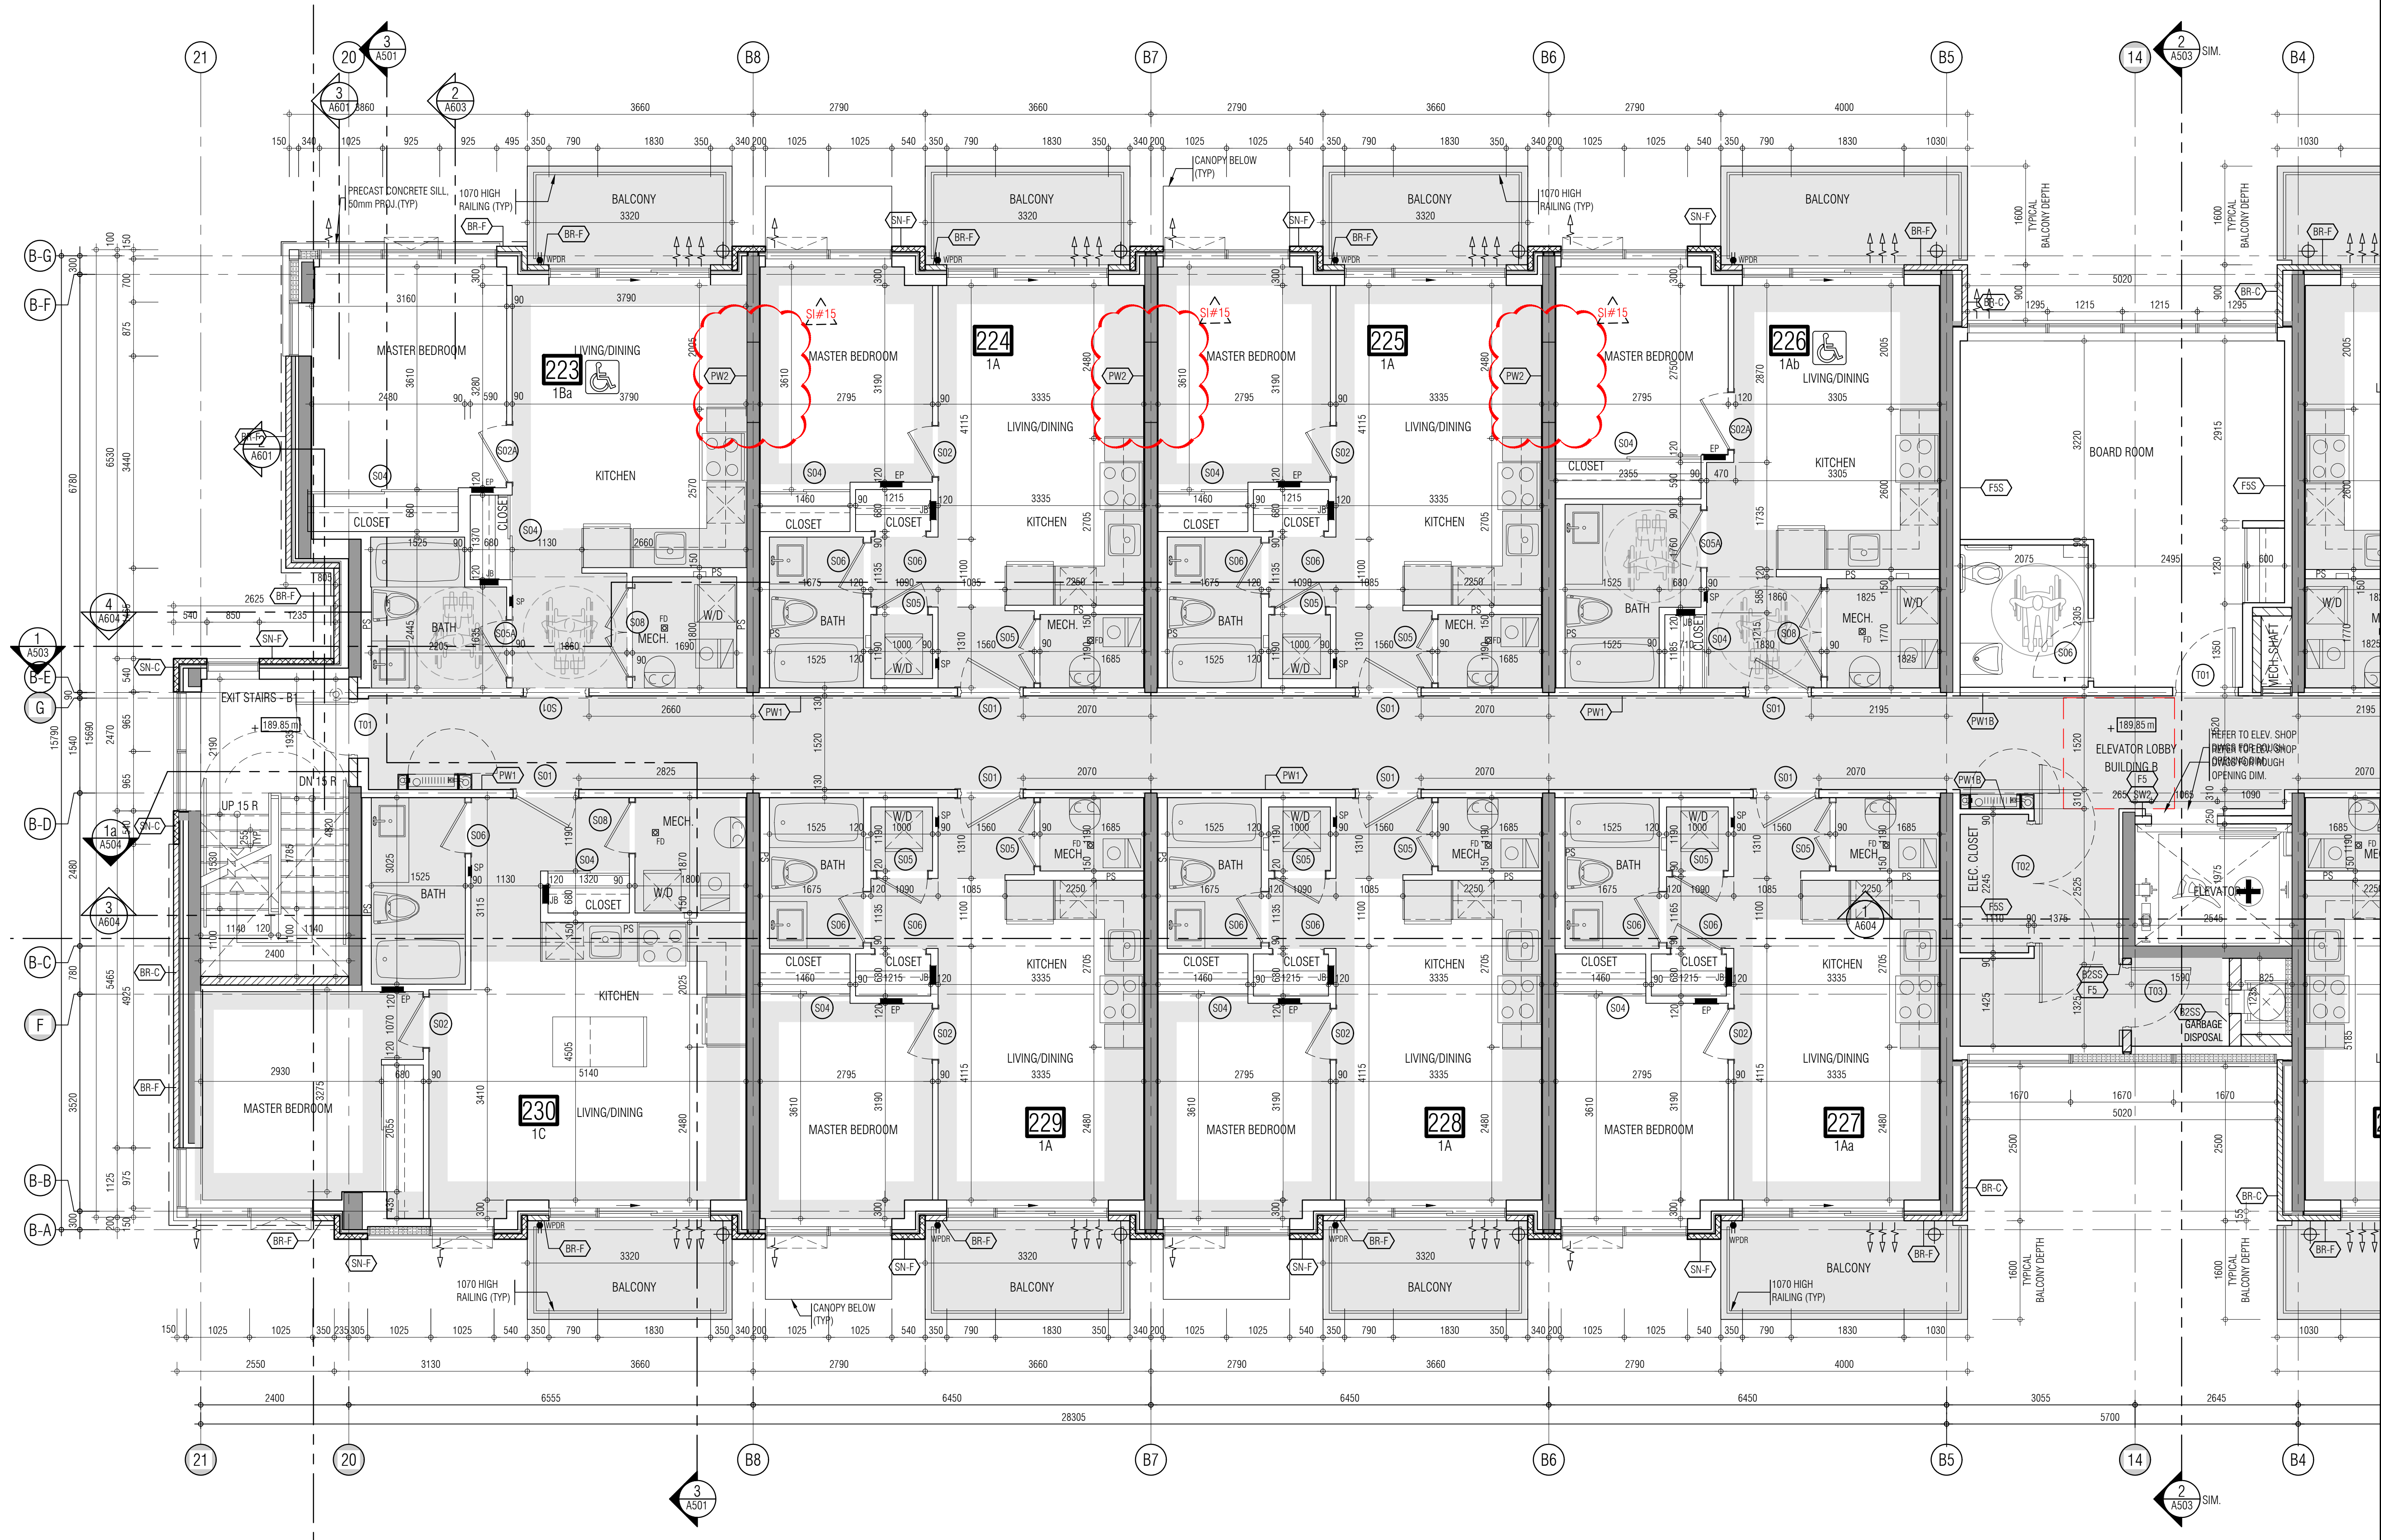

REF.A302c2 FOR CONTINUATION

- 01. Oct.07.2019 issued for tender
- 02. Mar.13.2020 issued for design coordination #2
- 03. Mar.16.2020 issued for addendum #2
- 04. Mar.16.2020 issued for addendum #3
- 05. Aug.24.2020 issued for addendum #4
- 06. Sept.28.2020 issued for permit
- 07. Oct.20.2020 issued for addendum #5
- 08. Nov.23.2020 issued for addendum #6
- 09. Dec.14.2020 issued for addendum #7
- 10. Jan.15.2021 issued for addendum #8
- 11. Mar.2.2021 issued for permit
- 12. Mar.09.2021 issued for addendum #9
- 13. Mar.10.2021 issued for addendum #9R
- 14. Mar.26.2021 issued for progress
- 15. May.14.2021 issued for Site Instruction #1
- 16. June.15.2021 issued for Site Instruction #2
- 17. July.7.2021 re-issued for permit
- 18. July.15.2021 issued for Site Instruction #3
- 19. July.27.2021 issued for Site Instruction #4
- 20. Aug.3.2021 issued for Site Instruction #5
- 21. Aug.18.2021 issued for Site Instruction #6
- 22. Aug.20.2021 Re-issued for permit
- 23. Sept.07.2021 issued for Site Instruction #7
- 24. Sept.09.2021 issued for Site Instruction #8
- 25. Sept.16.2021 issued for Building D Permit Revisions
- 26. Sept.22.2021 issued for Site Instruction #9
- 27. Oct.6.2021 Re-issued for permit
- 28. Oct.8.2021 issued for Site Instruction #10
- 29. Oct.28.2021 issued for Site Instruction #11
- 30. Nov.05.2021 issued for Site Instruction #12
- 31. Dec.3.2021 issued for Site Instruction #13
- 32. Dec.6.2021 issued for Site Instruction #14
- 33. Dec.7.2021 issued for Site Instruction #15

01. SEP.18.2019 issued for addendum 1
issued for revisions

GRAZIANI CORAZZA ARCHITECTS

1333 SHANAGARA DRIVE, SUITE 100 MISSISSAUGA, ONTARIO L4R 1C3
905.760.7001 P.905.760.7000 WWW.GC-ARCHITECTS.COM

RESIDENTIAL

ATTMAR + PALLESCI DRIVE


BRAMPTON ONTARIO

PROJECT ARCHITECT: B.GRAZIANI
ASSISTANT DESIGNER: R.LINCOLN
DRAWN BY: G.C./F.C./M.B.
CHECKED BY: D.BIASSE/G.COLANGELO
PLOT DATE: DEC.07.2021
JOB #: 1331.15


SECOND FLOOR PLAN
BUILDING B (PARTIAL PLAN)

1:50 A-302b1

TITLEBLOCK SIZE: 915 x 1200

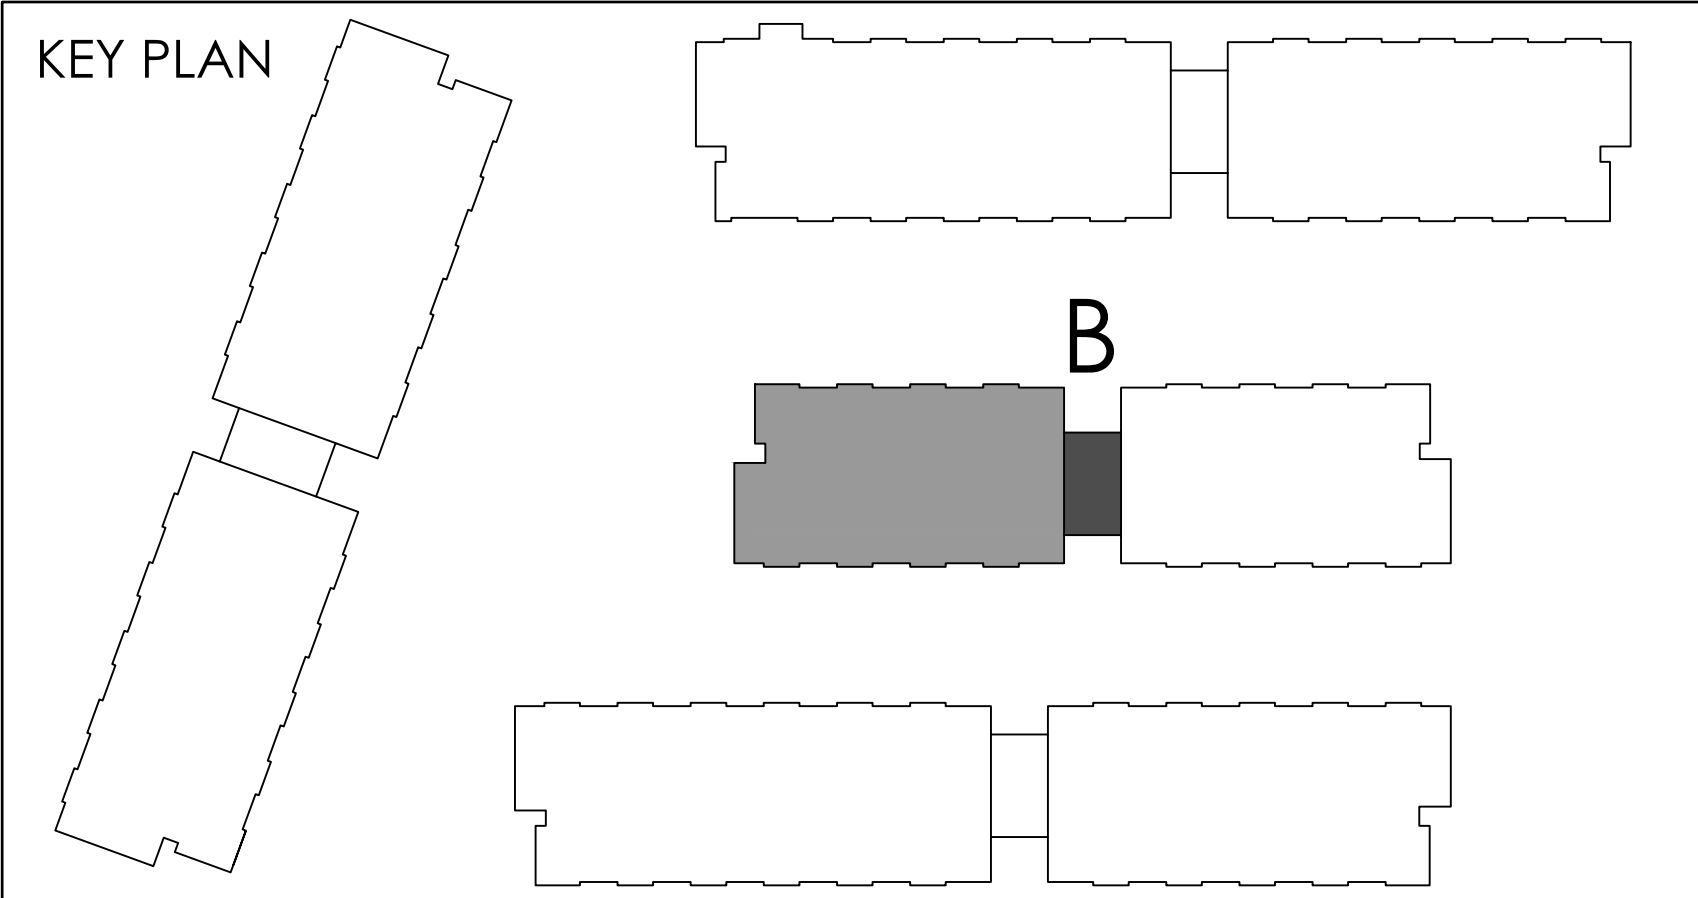

REF.A302c1 FOR CONTINUATION

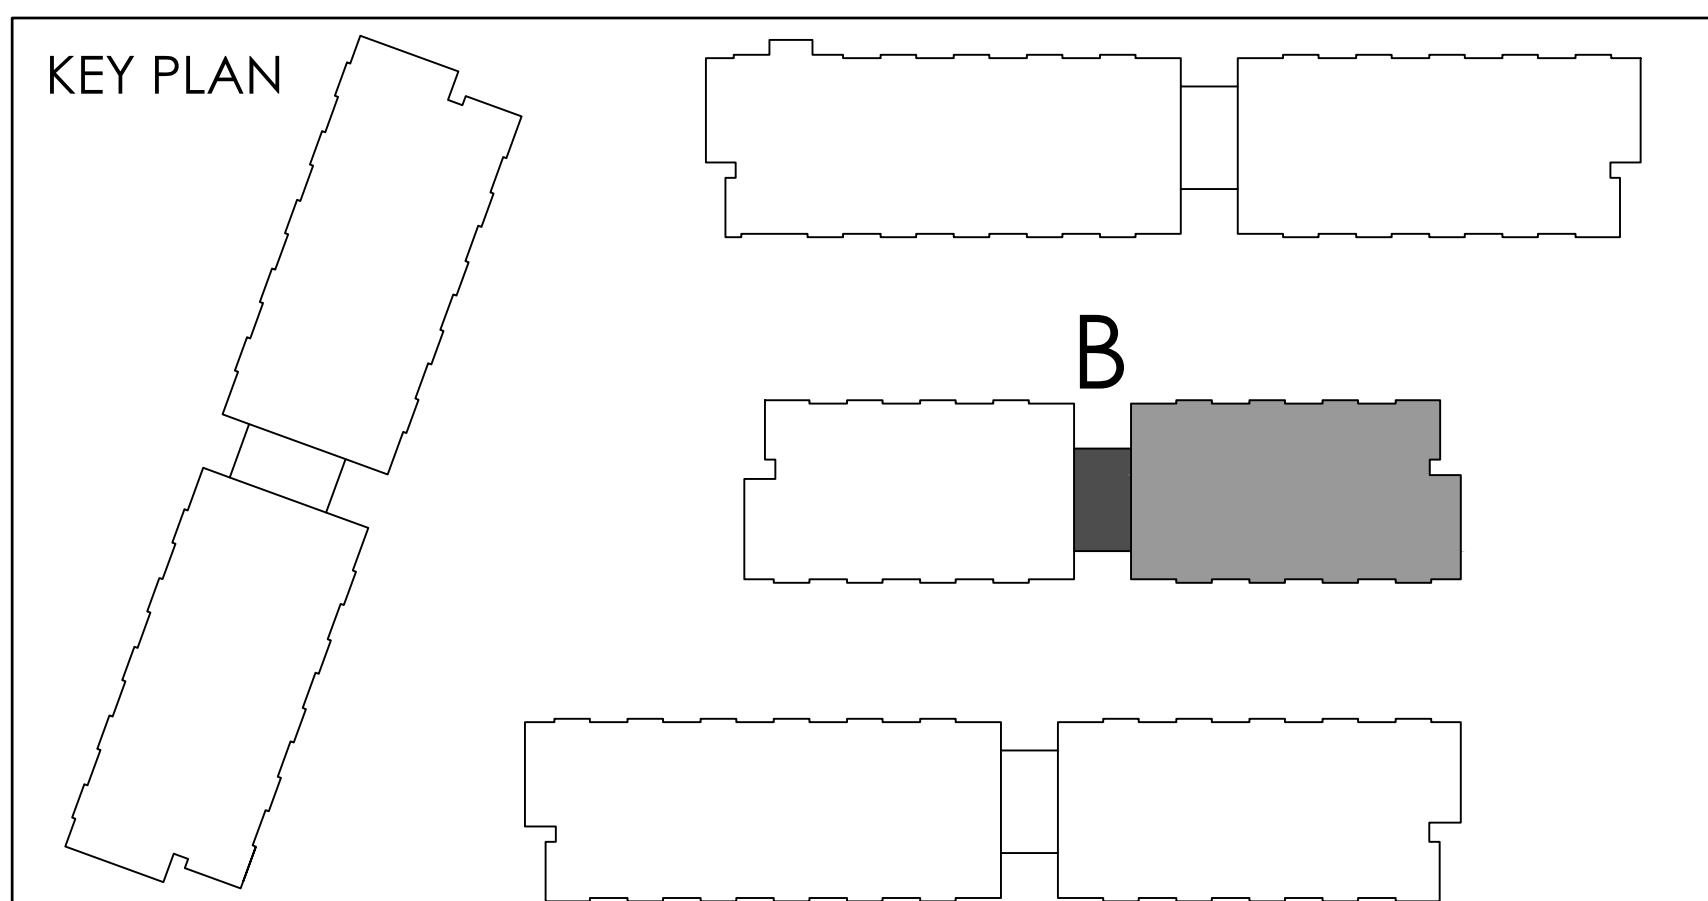

THIS DRAWING IS AN INSTRUMENT OF SERVICE, IT IS PROVIDED BY AND IS THE PROPERTY OF GRAZIANI CORAZZA ARCHITECTS INC. THE CONTRACTOR MUST VERIFY AND ACCEPT RESPONSIBILITY FOR ALL DIMENSIONS AND COORDINATE ON SITE AND MUST NOTIFY GRAZIANI CORAZZA ARCHITECTS INC. OF ANY VARIATIONS FROM THE SUPPLIED INFORMATION. GRAZIANI CORAZZA ARCHITECTS INC. IS NOT RESPONSIBLE FOR THE ACCURACY OF SURVEY, STRUCTURAL, MECHANICAL, ELECTRICAL AND OTHER ENGINEERING INFORMATION SHOWN ON THIS DRAWING. REFER TO THE APPROPRIATE ENGINEERING DRAWINGS BEFORE PROCEEDING WITH THE WORK. CONSTRUCTION MUST COMPLY TO ALL APPLICABLE CODES AND REQUIREMENTS OF THE AUTHORITIES HAVING JURISDICTION. UNLESS OTHERWISE NOTED, NO INVESTIGATION HAS BEEN UNDERTAKEN OR REPORTED ON BY THIS OFFICE IN RELATION TO THE ENVIRONMENTAL CONDITION OF THIS SITE.

THIS DRAWING IS NOT TO BE SCALED. ALL ARCHITECTURAL SYMBOLS INDICATED ON THIS DRAWING ARE GRAPHIC REPRESENTATIONS ONLY.

CONDITIONS FOR ELECTRONIC INFORMATION TRANSFER:

ELECTRONIC INFORMATION IS SUPPLIED TO THE OTHER ASSOCIATED FIRMS TO ASSIST THEM IN THE EXECUTION OF THEIR WORK. REVIEW THE RECEIPT FROM MUST DETERMINE THE COMPLETENESS, APPROPRIATENESS, RELIANCE OF THE INFORMATION IN RESPECT TO THEIR PARTICULAR RESPONSIBILITY.

GRAZIANI CORAZZA ARCHITECTS INC. SHALL NOT BE RESPONSIBLE FOR ERRORS, OMISSIONS, INCOMPLETENESS DUE TO USE OF INFORMATION IN WHICH NO PART INFORMATION IS TRANSMITTED.

1. TRANSMISSION OF ANY FILES OR DAMAGE TO THE RECEIVING ELECTRONIC SYSTEM WHEN INFORMATION IS TRANSMITTED.

- 01. Oct.07.2019 issued for tender
- 02. Mar.13.2020 issued for design coordination #2
- 03. Mar.16.2020 issued for addendum #2
- 04. Mar.16.2020 issued for addendum #3
- 05. Aug.24.2020 issued for addendum #4
- 06. Sept.28.2020 issued for permit
- 07. Oct.20.2020 issued for addendum #5
- 08. Nov.23.2020 issued for addendum #6
- 09. Dec.14.2020 issued for addendum #7
- 10. Jan.15.2021 issued for addendum #8
- 11. Mar.2.2021 issued for permit
- 12. Mar.09.2021 issued for addendum #9
- 13. Mar.10.2021 issued for addendum #9R
- 14. Mar.26.2021 issued for progress
- 15. May.14.2021 issued for Site Instruction #1
- 16. June.15.2021 issued for Site Instruction #2
- 17. July.7.2021 re-issued for permit
- 18. July.15.2021 issued for Site Instruction #3
- 19. July.27.2021 issued for Site Instruction #4
- 20. Aug.3.2021 issued for Site Instruction #5
- 21. Aug.18.2021 issued for Site Instruction #6
- 22. Aug.20.2021 Re-issued for permit
- 23. Sept.07.2021 issued for Site Instruction #7
- 24. Sept.09.2021 issued for Site Instruction #8
- 25. Sept.16.2021 issued for Building D Permit Revisions
- 26. Sept.22.2021 issued for Site Instruction #9
- 27. Oct.6.2021 Re-issued for permit
- 28. Oct.8.2021 issued for Site Instruction #10
- 29. Oct.28.2021 issued for Site Instruction #11
- 30. Nov.05.2021 issued for Site Instruction #12
- 31. Dec.3.2021 issued for Site Instruction #13
- 32. Dec.6.2021 issued for Site Instruction #14
- 33. Dec.7.2021 issued for Site Instruction #15

01. SEP.18.2019 issued for revisions



**GRAZIANI
CORAZZA
ARCHITECTS**

1333 SHANAGHAN DRIVE, SUITE 100 MISSISSAUGA, ONTARIO L4W 1C3
905.709.7201 P.905.709.7200 WWW.GC-ARCHITECTS.COM

RESIDENTIAL



ATTMAR + PALLESCHI DRIVE

BRAMPTON ONTARIO

PROJECT ARCHITECT: B.GRAZIANI
ASSISTANT DESIGNER: R.LINCOLN
DRAWN BY: G.C./F.C./M.B.
CHECKED BY: D.BIASSE/G.COLANGELO
PLOT DATE: DEC.07.2021
JOB #: 1331.15

**SECOND FLOOR PLAN
BUILDING B (PARTIAL PLAN)**

1:50 **A-302b2**

TITLEBLOCK SIZE: 915 x 1200

THIS DRAWING IS AN INSTRUMENT OF SERVICE, IT IS PROVIDED BY AND IS THE PROPERTY OF GRAZIANI-CORAZZA ARCHITECTS INC. THE CONTRACTOR MUST VERIFY AND ACCEPT RESPONSIBILITY FOR ALL DIMENSIONS AND COORDINATE ON SITE AND MUST NOTIFY GRAZIANI-CORAZZA ARCHITECTS INC. OF ANY VARIATIONS FROM THE SUPPLIED INFORMATION. GRAZIANI-CORAZZA ARCHITECTS INC. IS NOT RESPONSIBLE FOR THE ACCURACY OF SURVEY, STRUCTURAL, MECHANICAL, ELECTRICAL, AND OTHER ENGINEERING INFORMATION SHOWN ON THIS DRAWING. REFER TO THE APPROPRIATE ENGINEERING DRAWINGS BEFORE PROCEEDING WITH THE WORK. CONSTRUCTION MUST COMPLY TO ALL APPLICABLE CODES AND REQUIREMENTS OF THE AUTHORITIES HAVING JURISDICTION, UNLESS OTHERWISE NOTED. NO MODIFICATION HAS BEEN MADE/NOTED AS REPORTED IN BY THIS OFFICE IN REGARDS TO THE ENVIRONMENTAL CONDITION OF THIS SITE.

THIS DRAWING IS NOT TO BE SCALED. ALL ARCHITECTURAL SYMBOLS INDICATED ON THIS DRAWING ARE GRAPHIC REPRESENTATIONS ONLY.


CONDITIONS FOR ELECTRONIC INFORMATION TRANSFER:

ELECTRONIC INFORMATION IS SUPPLIED TO THE OTHER ASSOCIATED FIRMS TO ASSIST THEM IN THE EXECUTION OF THEIR WORK. REVIEW THE RECEIVED FIRMS MUST DETERMINE THE COMPLETENESS, APPROPRIATENESS, RELIANCE OF THE INFORMATION IN RESPECT TO THEIR PARTICULAR RESPONSIBILITY.

GRAZIANI-CORAZZA ARCHITECTS INC. SHALL NOT BE RESPONSIBLE FOR ERRORS, OMISSIONS, INCOMPLETENESS DUE TO LOSS OF INFORMATION IN WHOLE OR PART WHEN INFORMATION IS TRANSMITTED.

1. TRANSMISSION OF ANY FILES OR DAMAGE TO THE RECEIVING ELECTRONIC SYSTEM WHEN INFORMATION IS TRANSMITTED.

REF.A302a2 FOR CONTINUATION

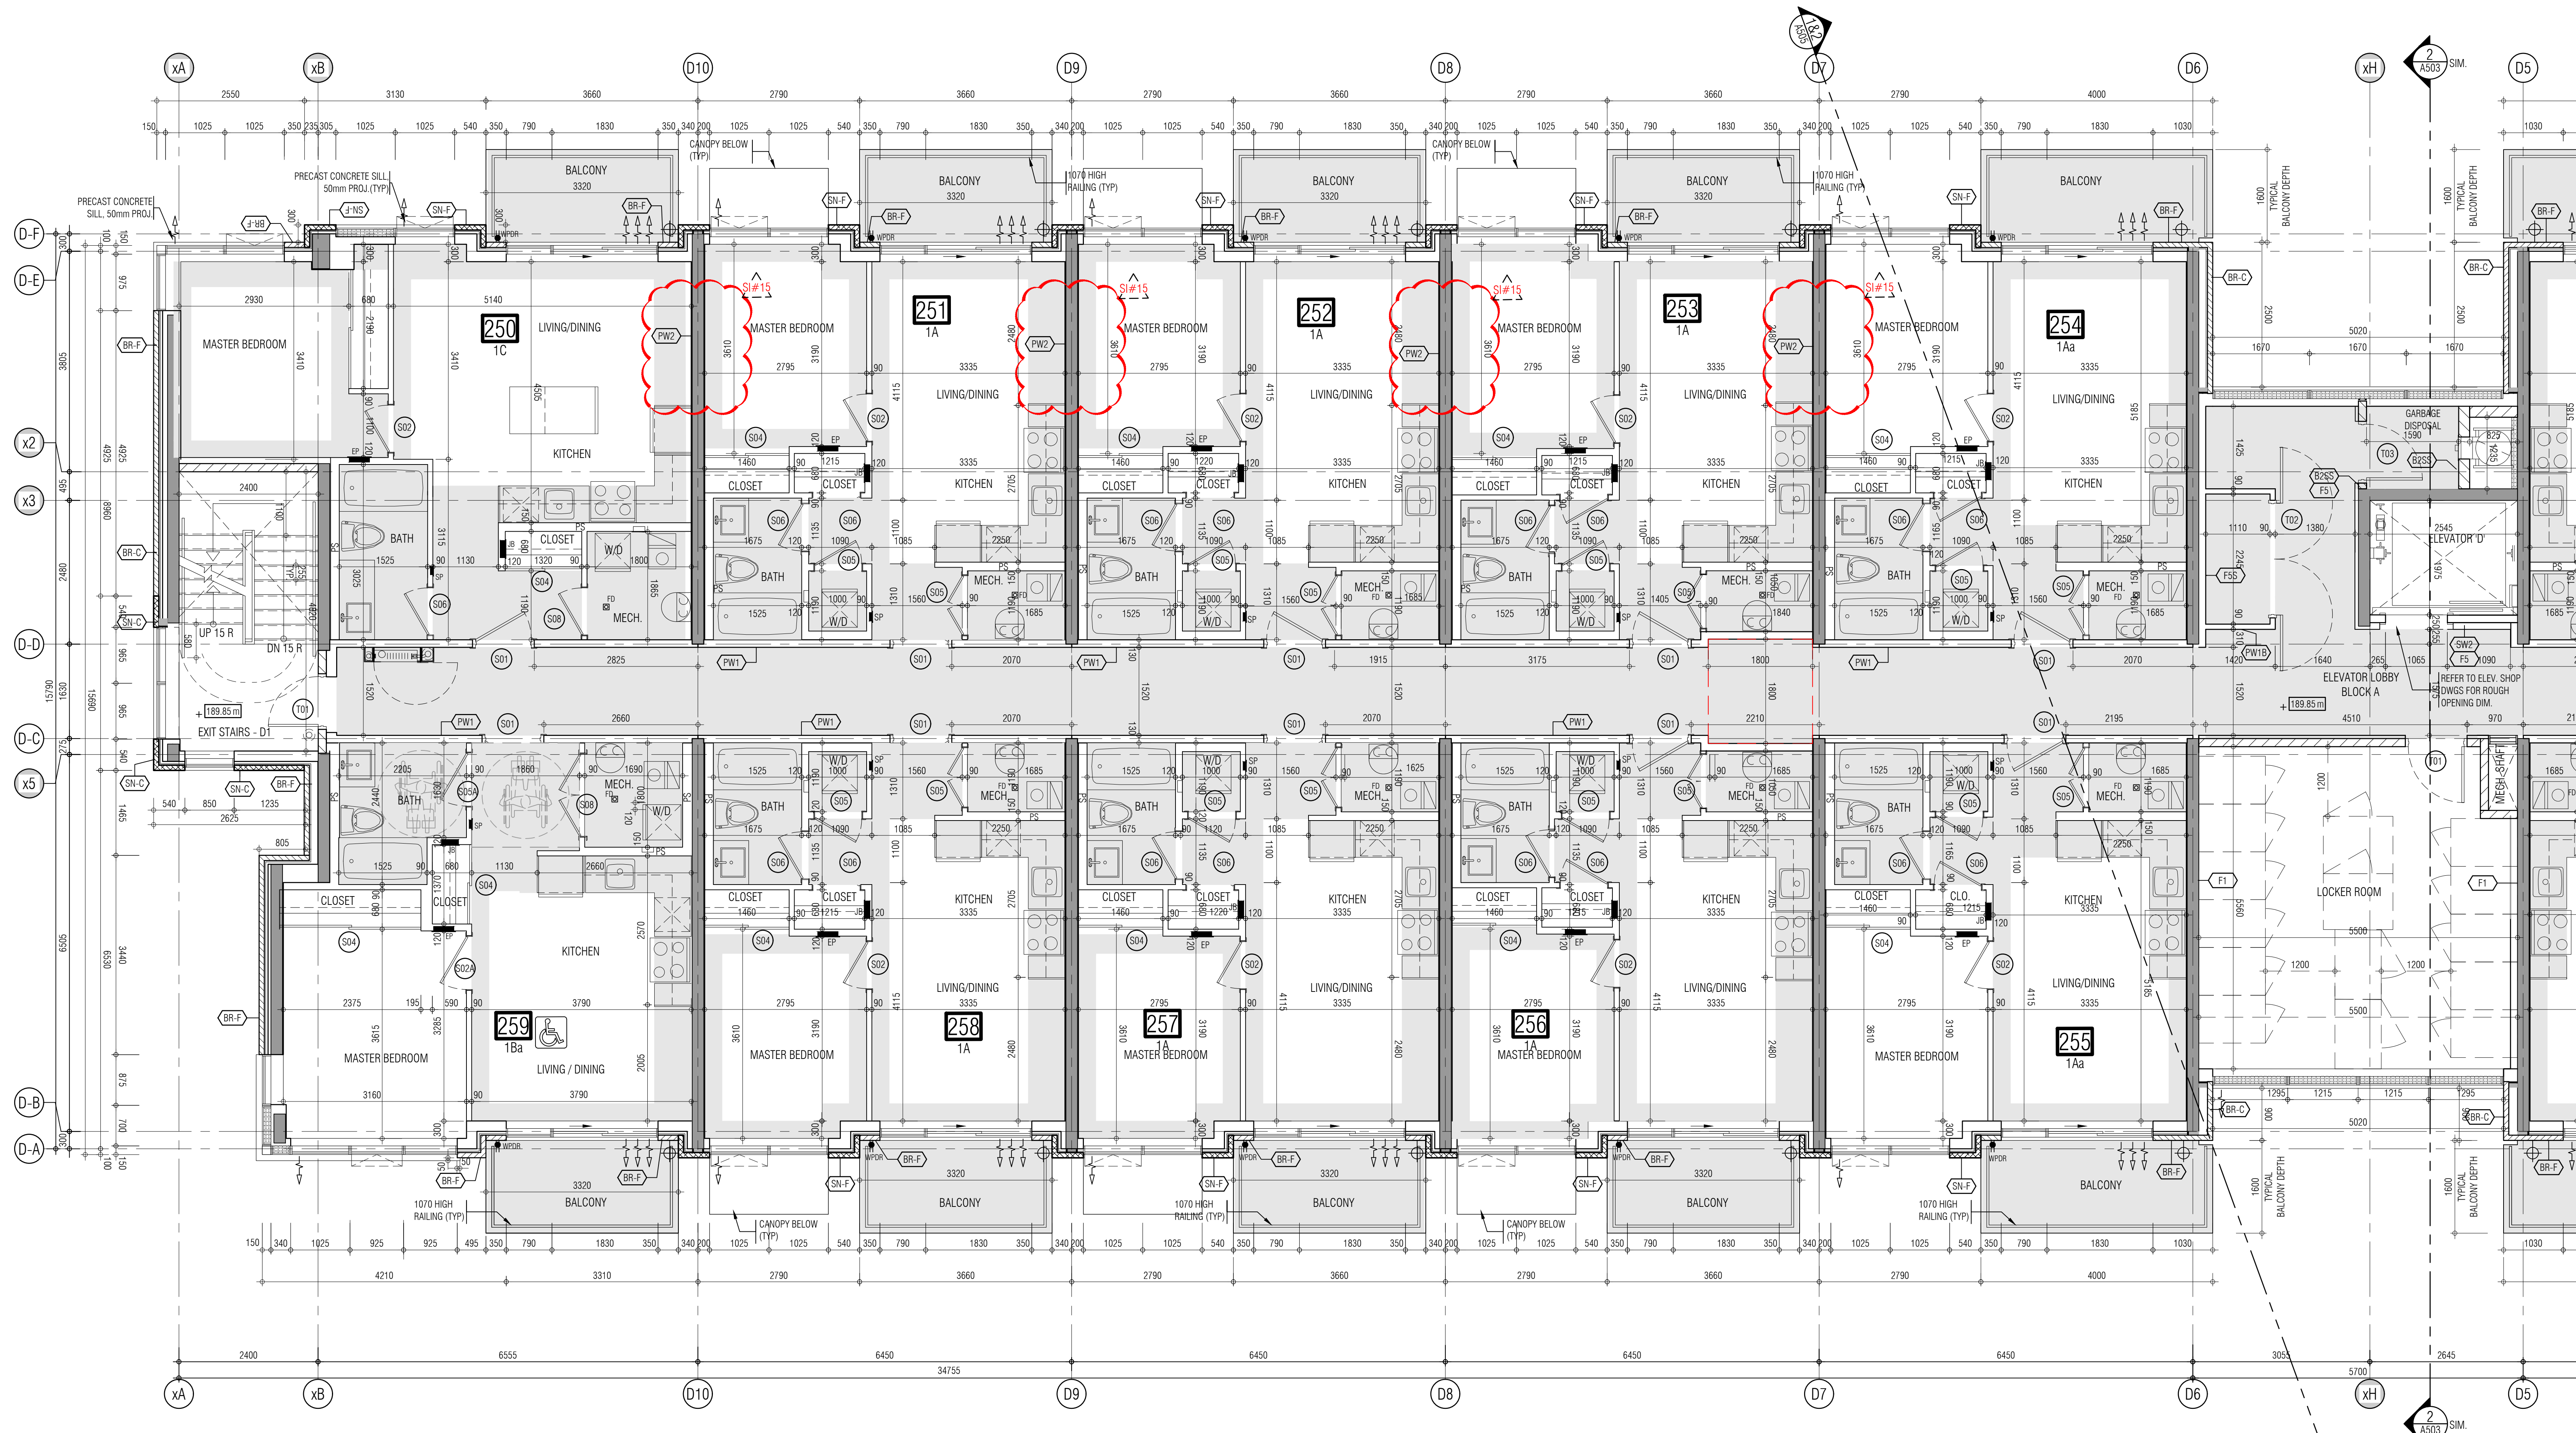

- 01. Oct.07.2019 issued for tender
- 02. Mar.13.2020 issued for design coordination #2
- 03. Mar.16.2020 issued for addendum #2
- 04. Mar.16.2020 issued for addendum #3
- 05. Aug.24.2020 issued for addendum #4
- 06. Sept.28.2020 issued for permit
- 07. Oct.20.2020 issued for addendum #5
- 08. Nov.23.2020 issued for addendum #6
- 09. Dec.14.2020 issued for addendum #7
- 10. Jan.15.2021 issued for addendum #8
- 11. Mar.2.2021 issued for permit
- 12. Mar.09.2021 issued for addendum #9
- 13. Mar.10.2021 issued for addendum #9R
- 14. Mar.26.2021 issued for progress
- 15. May.14.2021 issued for Site Instruction #1
- 16. June.15.2021 issued for Site Instruction #2
- 17. July.7.2021 re-issued for permit
- 18. July.15.2021 issued for Site Instruction #3
- 19. July.27.2021 issued for Site Instruction #4
- 20. Aug.3.2021 issued for Site Instruction #5
- 21. Aug.18.2021 issued for Site Instruction #6
- 22. Aug.20.2021 Re-issued for permit
- 23. Sept.07.2021 issued for Site Instruction #7
- 24. Sept.09.2021 issued for Site Instruction #8
- 25. Sept.16.2021 issued for Building D Permit Revisions
- 26. Sept.22.2021 issued for Site Instruction #9
- 27. Oct.6.2021 Re-issued for permit
- 28. Oct.8.2021 issued for Site Instruction #10
- 30. Oct.28.2021 issued for Site Instruction #11
- 31. Nov.05.2021 issued for Site Instruction #12
- 32. Dec.3.2021 issued for Site Instruction #13
- 33. Dec.6.2021 issued for Site Instruction #14
- 34. Dec.7.2021 issued for Site Instruction #15

01. SEP18/2019 issued for addendum 1
issued for revisions

GRAZIANI CORAZZA ARCHITECTS

1333 SANDWICH DRIVE, SUITE 101 MISSISSAUGA, ONTARIO L4W 1C3
905.709.7001 F.905.709.7000 WWW.GC-ARCHITECTS.COM

ATTMOR + PALLESCI DRIVE

PROJECT ARCHITECT: B. GRAZIANI
ASSISTANT DESIGNER: R. LINCOLN
DRAWN BY: G.C./F.C./M.B.
CHECKED BY: D. BIASI/G. COLANGELO
PLOT DATE: DEC.07.2021
JOB #: 1331.15

SECOND FLOOR PLAN
BUILDING D (PARTIAL PLAN)

1:50 A-302d1
TITLEBLOCK SIZE: 915 x 1200

THIS DRAWING IS AN INSTRUMENT OF SERVICE, IT IS PROVIDED BY AND IS THE PROPERTY OF GRAZIANI CORAZZA ARCHITECTS INC. THE CONTRACTOR MUST VERIFY AND ACCEPT RESPONSIBILITY FOR ALL DIMENSIONS AND COORDINATIONS. GRAZIANI CORAZZA ARCHITECTS INC. IS NOT RESPONSIBLE FOR THE ACCURACY OF SURVEY, STRUCTURAL, MECHANICAL, ELECTRICAL, AND OTHER ENGINEERING INFORMATION SHOWN ON THIS DRAWING. REFER TO THE APPROPRIATE ENGINEERING DRAWINGS BEFORE PROCEEDING WITH THE WORK. CONSTRUCTION MUST COMPLY TO ALL APPLICABLE CODES AND REQUIREMENTS OF THE AUTHORITIES HAVING JURISDICTION. UNLESS OTHERWISE NOTED, NO MODIFICATION HAS BEEN MADE TO THE INFORMATION IN THIS OFFICE IN REGARD TO THE ENVIRONMENTAL CONDITION OF THIS SITE.

THIS DRAWING IS NOT TO BE SCALED. ALL ARCHITECTURAL SYMBOLS INDICATED ON THIS DRAWING ARE GRAPHIC REPRESENTATIONS ONLY.

CONDITIONS FOR ELECTRONIC INFORMATION TRANSFER

ELECTRONIC INFORMATION IS SUPPLIED TO THE OTHER ASSOCIATED FIRMS TO ASSIST THEM IN THE EXECUTION OF THEIR WORK. REVIEW THE RECEIPT FROM MUST DETERMINE THE COMPLETENESS, APPROPRIATENESS, RELIANCE OF THE INFORMATION IN RESPECT TO THEIR PARTICULAR RESPONSIBILITY.

GRAZIANI CORAZZA ARCHITECTS INC. SHALL NOT BE RESPONSIBLE FOR: 1. ERRORS, OMISSIONS, INCOMPLETENESS DUE TO LOSS OF INFORMATION IN WHICH NO PART OF INFORMATION IS TRANSMITTED. 2. TRANSMISSION OF ANY LOSS OR DAMAGE TO THE RECEIVING ELECTRONIC SYSTEM WHEN INFORMATION IS TRANSMITTED.

01. Oct.07.2019 issued for tender
02. Mar.13.2020 issued for design coordination #2
03. Mar.16.2020 issued for addendum #2
04. Mar.16.2020 issued for addendum #3
05. Aug.24.2020 issued for addendum #4
06. Sept.28.2020 issued for permit
07. Oct.20.2020 issued for addendum #5
08. Nov.23.2020 issued for addendum #6
09. Dec.14.2020 issued for addendum #7
10. Jan.15.2021 issued for addendum #8
11. Mar.2.2021 issued for permit
12. Mar.09.2021 issued for addendum #9
13. Mar.10.2021 issued for addendum #9R
14. May.26.2021 issued for progress
15. May.14.2021 issued for Site Instruction #1
16. June.15.2021 issued for Site Instruction #2
17. July.7.2021 re-issued for permit
18. July.15.2021 issued for Site Instruction #3
19. July.27.2021 issued for Site Instruction #4
20. Aug.3.2021 issued for Site Instruction #5
21. Aug.18.2021 issued for Site Instruction #6
22. Aug.20.2021 Re-issued for permit
23. Sept.07.2021 issued for Site Instruction #7
24. Sept.09.2021 issued for Site Instruction #8
25. Sept.16.2021 issued for Building D Permit Revisions
26. Sept.22.2021 issued for Site Instruction #9
27. Oct.6.2021 Re-issued for permit
28. Oct.8.2021 issued for Site Instruction #10
30. Oct.28.2021 issued for Site Instruction #11
31. Nov.05.2021 issued for Site Instruction #12
32. Dec.3.2021 issued for Site Instruction #13
33. Dec.6.2021 issued for Site Instruction #14
34. Dec.7.2021 issued for Site Instruction #15

01. SEP.18.2019 issued for addendum 1
- issued for revisions

GRAZIANI CORAZZA ARCHITECTS

1320 SANDHURST DRIVE, SUITE 100 MISSISSAUGA, ONTARIO L4W 1C3
905.709.2001 F.905.709.2006 WWW.GC-ARCHITECTS.COM

RESIDENTIAL

ATTMAR + PALLESCHI DRIVE

BRAMPTON ONTARIO


PROJECT ARCHITECT: B. GRAZIANI
ASSISTANT DESIGNER: R. LINCOLN
DRAWN BY: G.C./F.C./M.B.
CHECKED BY: D. BIASSE/G. COLANGELO
PLOT DATE: DEC.07.2021
JOB #: 1331.15

**SECOND FLOOR PLAN
BUILDING D (PARTIAL PLAN)**

1:50 A-302d2

TITLEBLOCK SIZE: 915 x 1200

REF.A302a1 FOR CONTINUATION

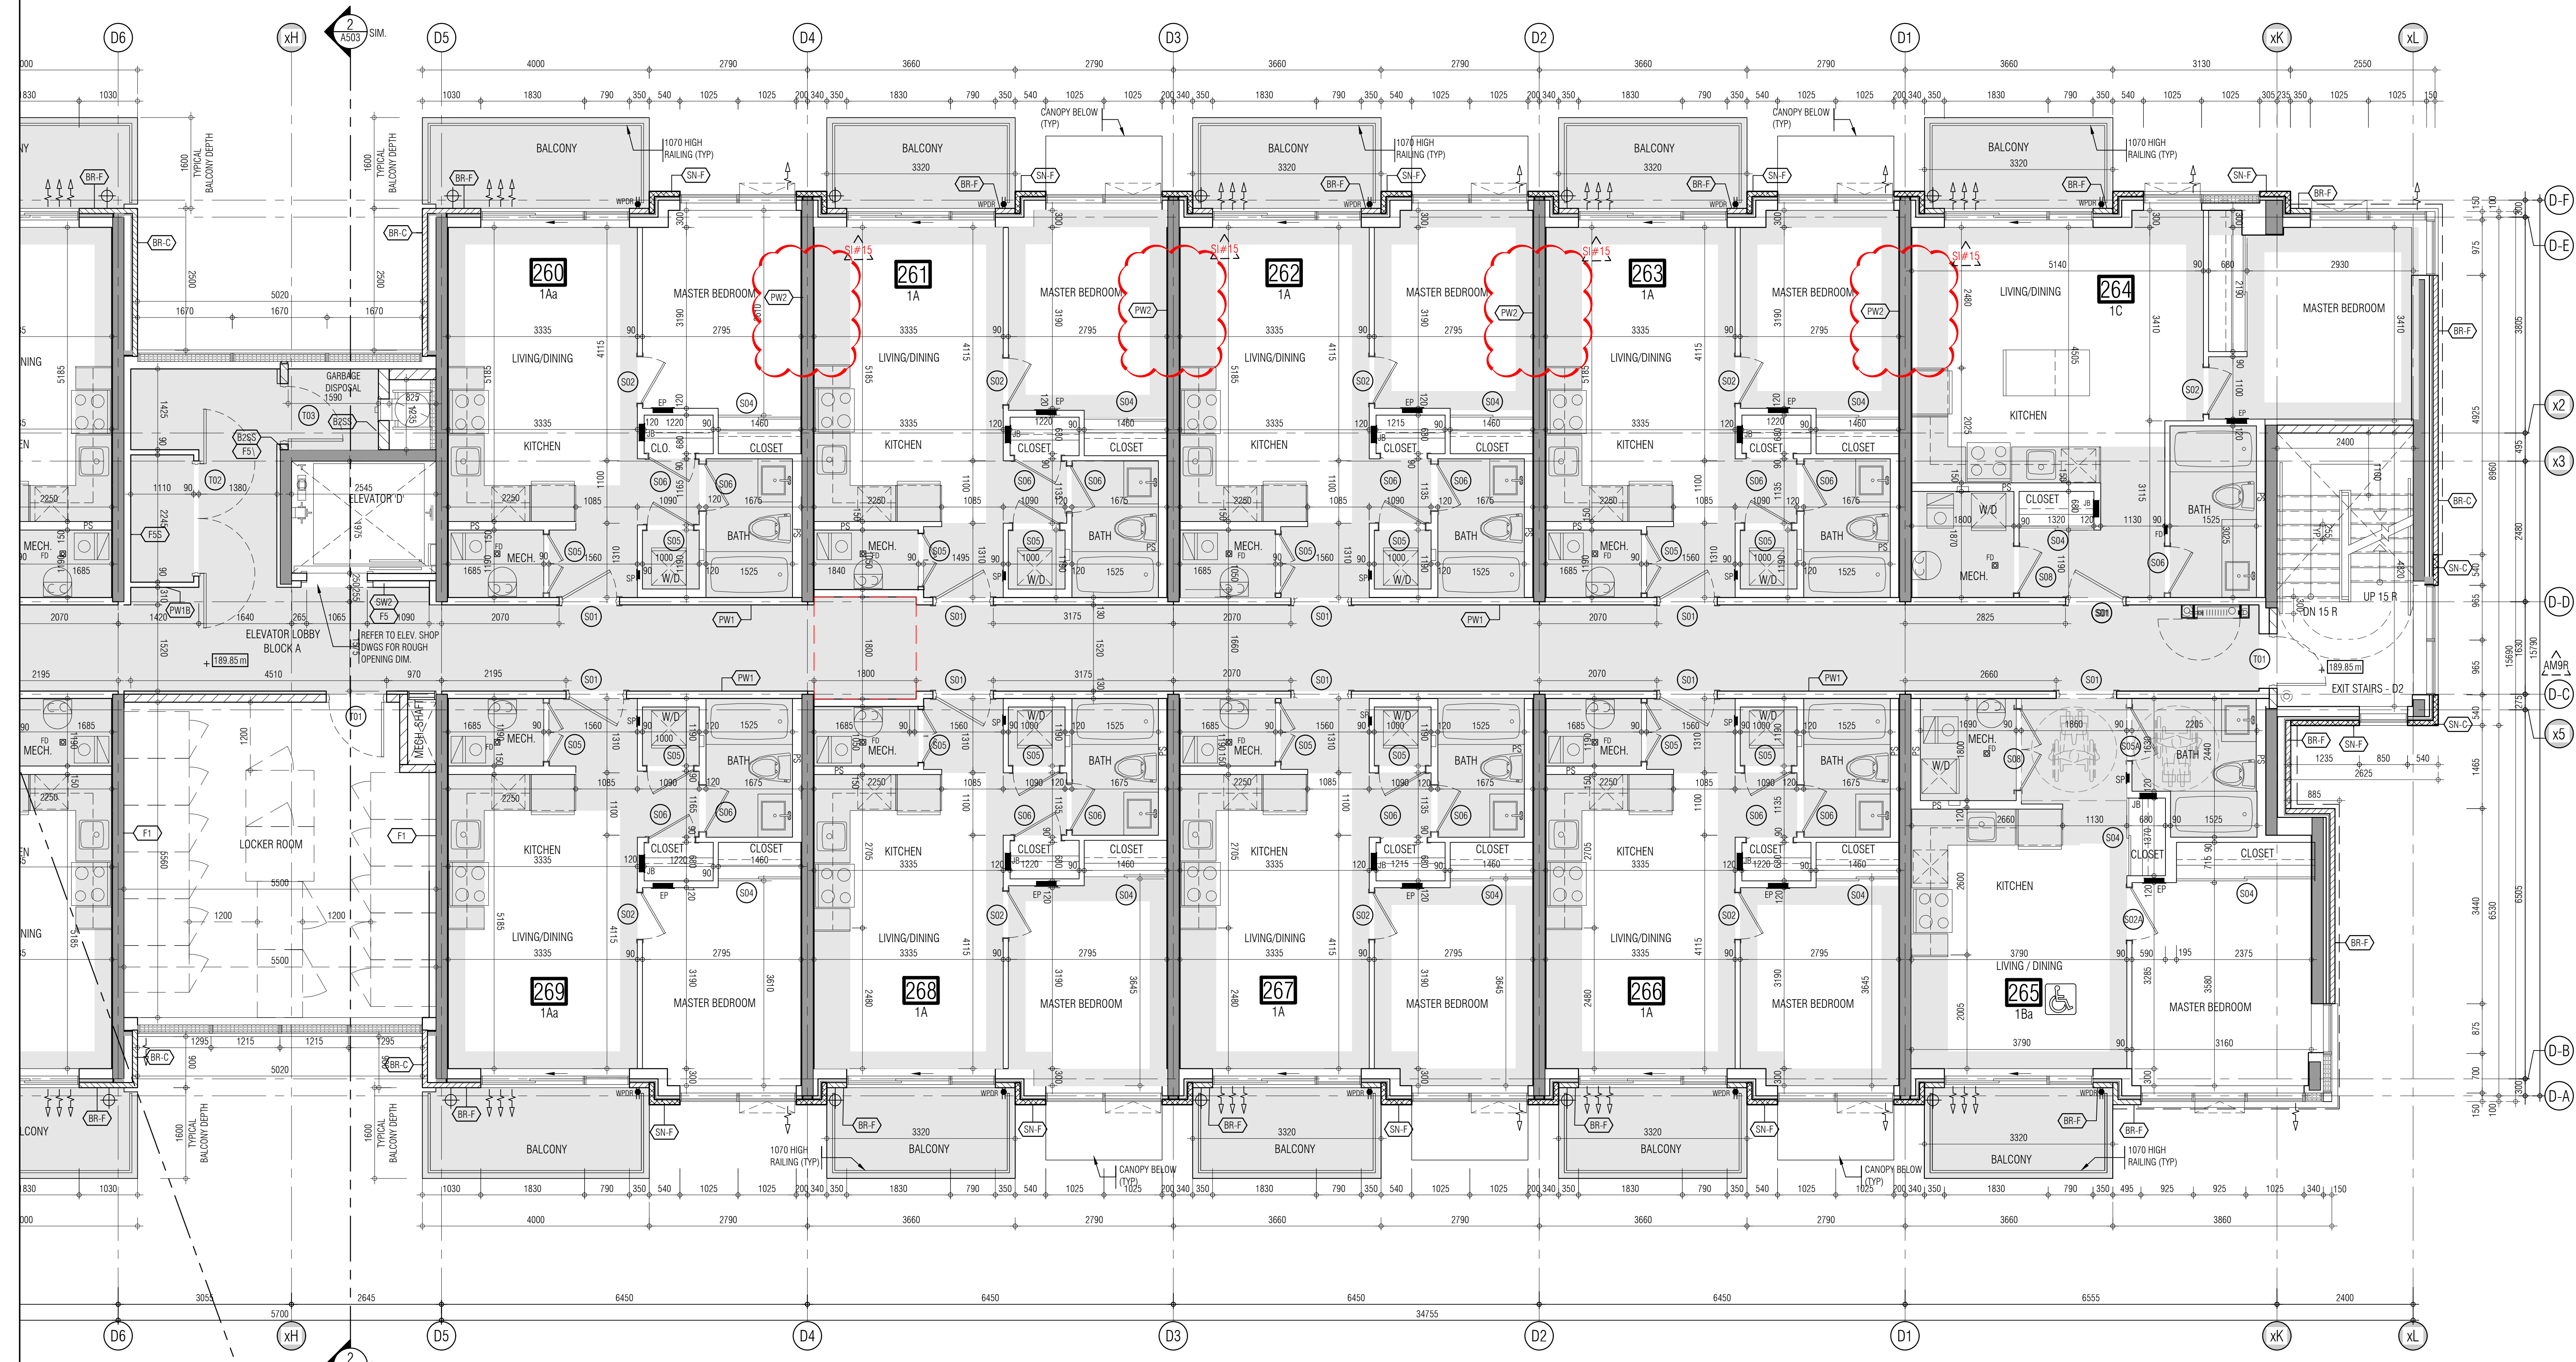

THIS DRAWING IS NOT TO BE SCALED. ALL ARCHITECTURAL SYMBOLS INDICATED ON THIS DRAWING ARE GRAPHIC REPRESENTATIONS ONLY.

CONDITIONS FOR ELECTRONIC INFORMATION TRANSFER

ELECTRONIC INFORMATION IS SUPPLIED TO THE OTHER ASSOCIATED FIRMS TO ASSIST THEM IN THE EXECUTION OF THEIR WORK. REVIEW THE RECIPIENT FIRMS BEST PRACTICES FOR THE PROTECTION OF CONFIDENTIALITY AND RELEVANCE OF THE INFORMATION IN RESPECT TO THEIR PARTICULAR RESPONSIBILITY.

GRADY+CORAZZA ARCHITECTS, INC. SHALL NOT BE RESPONSIBLE FOR:

1. DIVULGOS ORIGINATING INADEQUACIES DUE TO LOSS OF INFORMATION IN WHOLE OR PART WHEN INFORMATION IS TRANSFERRED.
2. TRANSMISSION OF ANY VIRUS OR DAMAGE TO THE RECEIVING ELECTRONIC SYSTEM WHEN INFORMATION IS TRANSFERRED.


01. SEPTEMBER 2019 Issued for circulation 1 bg
Issued for revisions



CONCRETE SLAB EDGE
GROUND FLOOR (OVERALL PLAN)

TILEBLOCK SIZE: 915 x 1200

1:150 CS301-OS

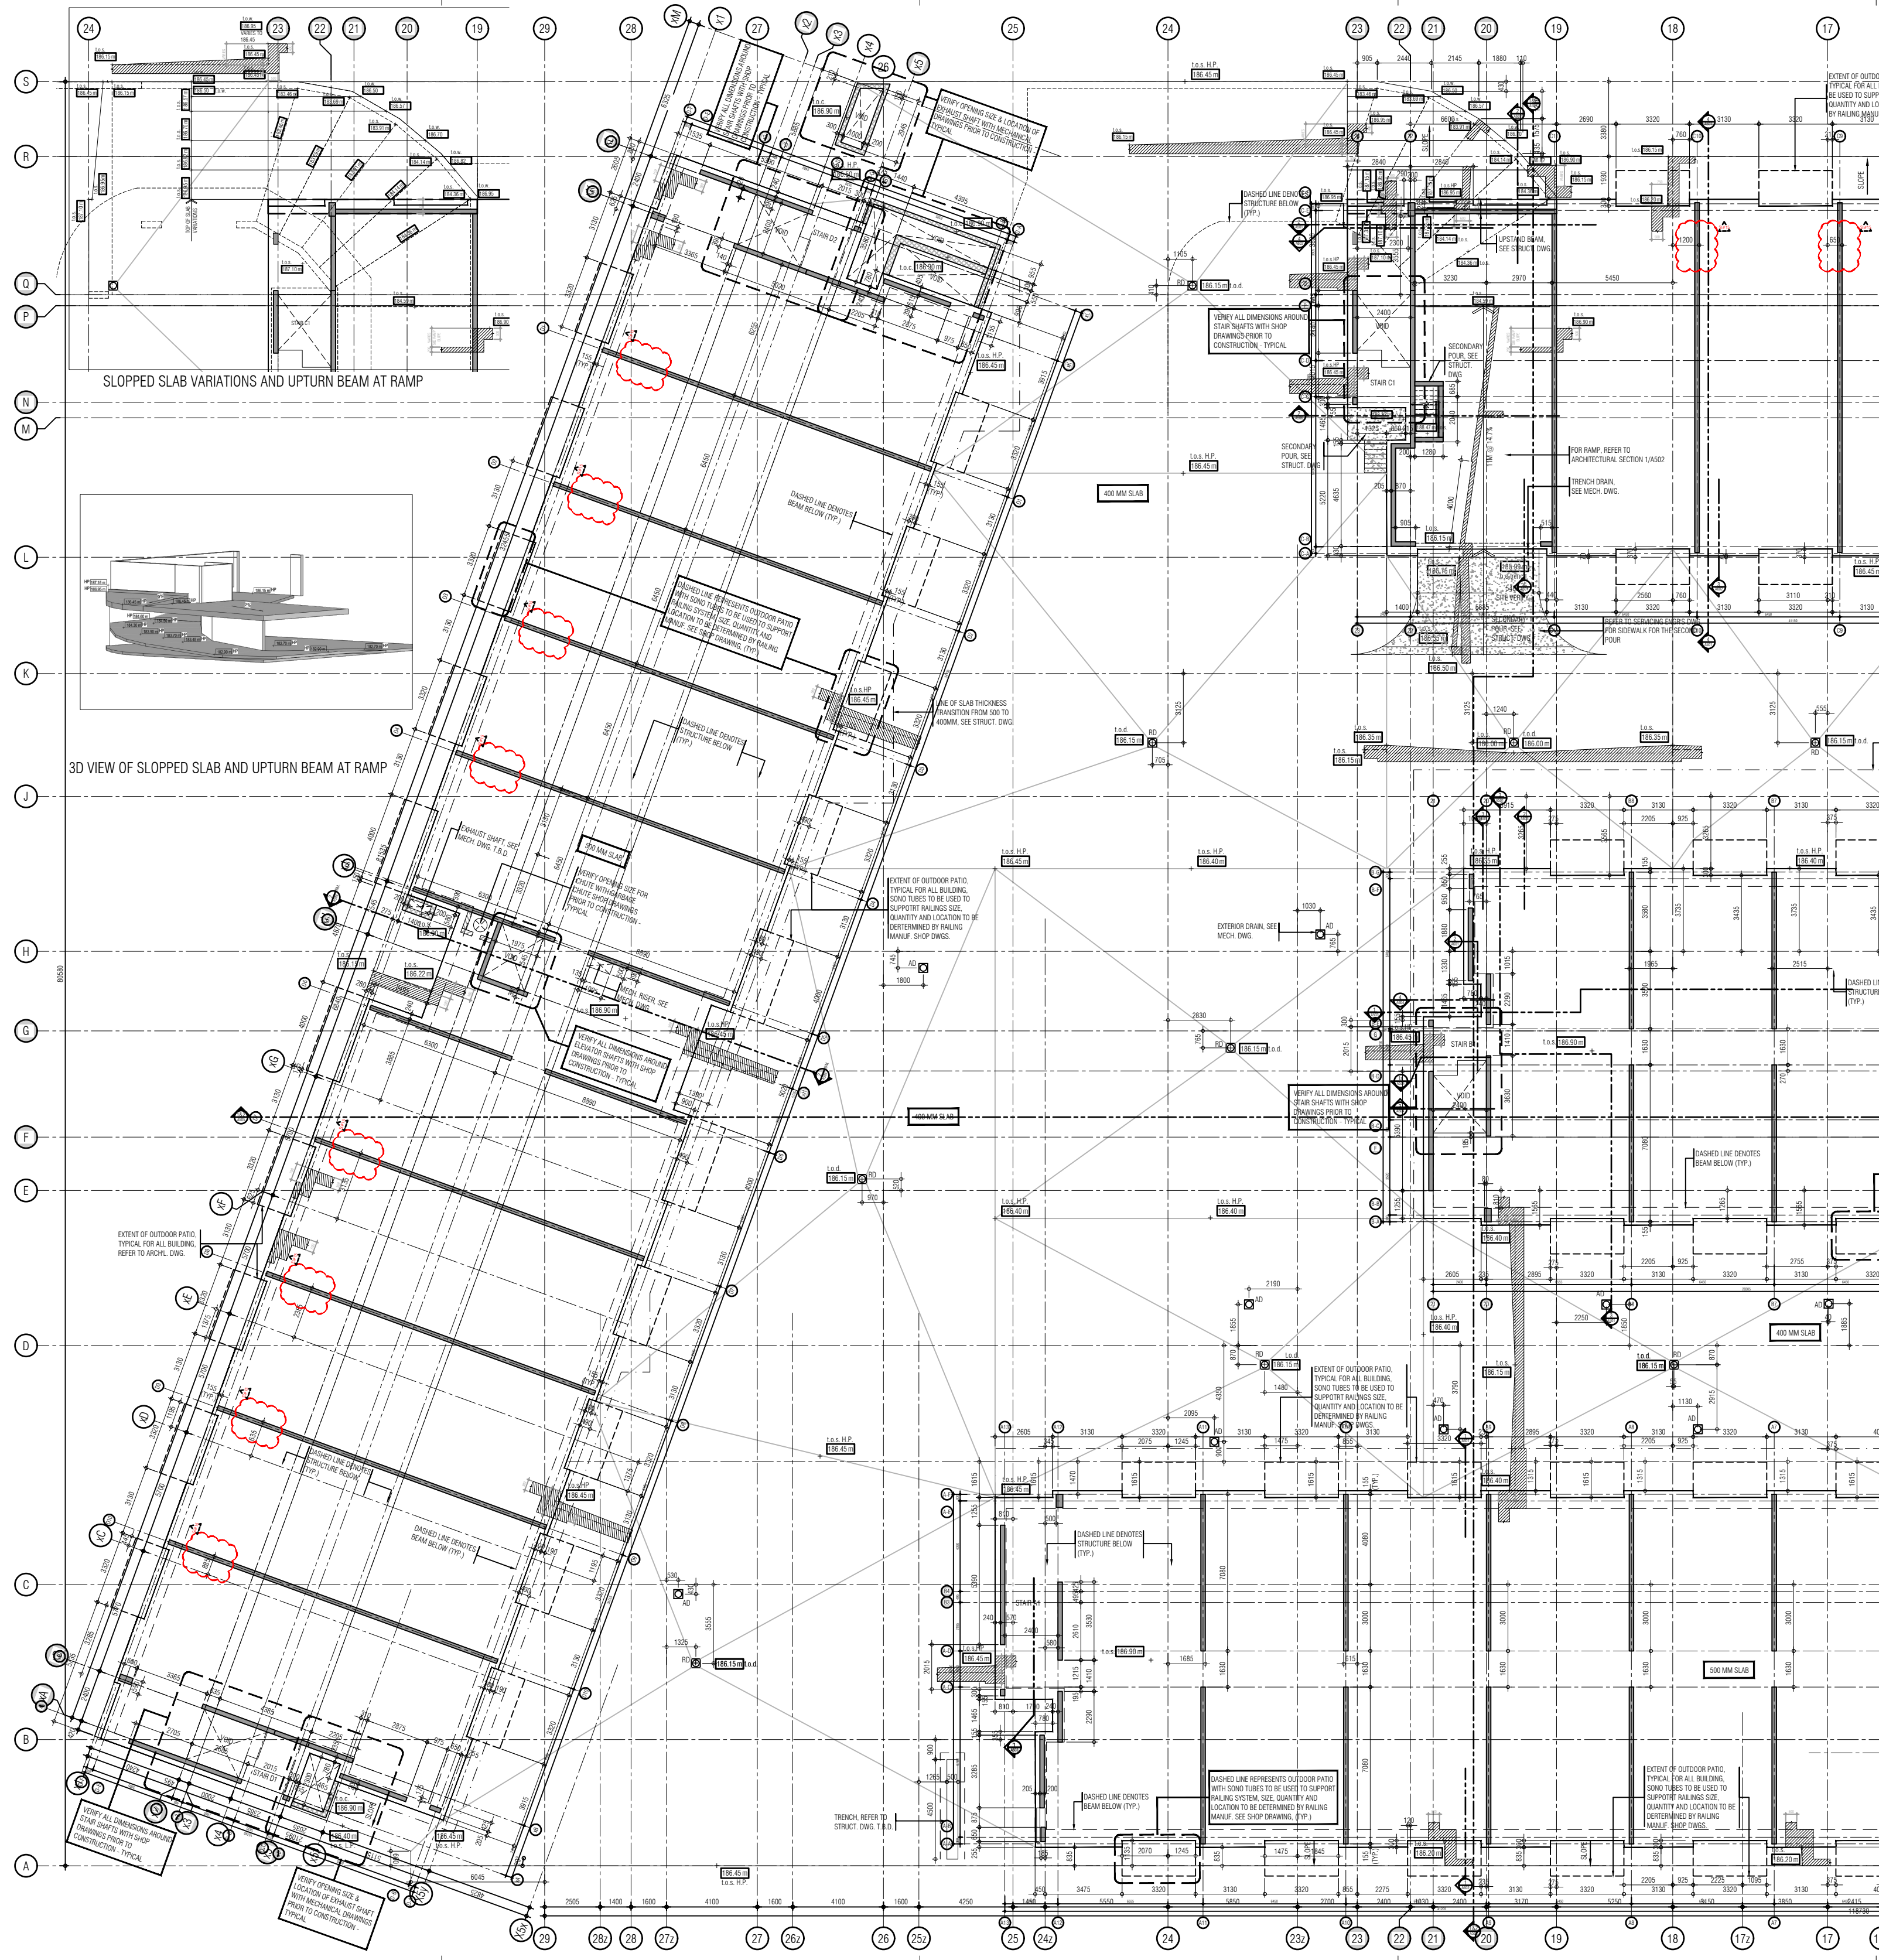

REF A211b FOR CONTINUATION

CS LEGEND	
	CONCRETE STRUCTURE
	CONCRETE SLAB BUILDUP
	CONCRETE CURB
	SLAB OPENING
	SLOPED BALCONY, SLAB EXTENSION OR FROST SLAB
	50mm SLAB DEPRESSION
	FLOATING SLAB
	INDICATES SECTION VIEW OF CONCRETE
NOTES	
1. UNLESS DIMENSIONED OTHERWISE, ALL COLUMNS AND SHEAR WALLS TO BE CENTERED OR ALIGNED ON GRIDLINES.	
2. THESE DRAWINGS ARE TO BE READ IN CONJUNCTION WITH STRUCTURAL, MECHANICAL, ELECTRICAL AND ARCHITECTURAL DRAWINGS. THE CONTRACTOR IS TO NOTIFY ANY CONFLICTING INFORMATION TO GRAZIANI + CORAZZA ARCHITECTS INC.	
3. FOR ALL CONCRETE BEAMS, DROP PANELS AND CAPITALS, REFER TO STRUCTURAL DRAWINGS.	

CONDITIONS FOR ELECTRONIC INFORMATION TRANSFER	
ELECTRONIC INFORMATION IS SUPPLIED TO THE OTHER ASSOCIATED FIRMS TO ASSIST THEM IN THE EXECUTION OF THEIR WORK / REVIEW THE RELEVANT FIRMS MUST DETERMINE THE COMPLETENESS / APPROPRIATENESS / RELIABILITY OF THE INFORMATION IN RESPECT TO THEIR PARTICULAR RESPONSIBILITY.	
DRAWING - CORAZZA ARCHITECTS INC. SHALL NOT BE RESPONSIBLE FOR: 1. ERROR, OMISSIONS, INCOMPLETENESS DUE TO LOSS OF INFORMATION IN WHOLE OR PART WHEN INFORMATION IS TRANSFERRED 2. TRANSMISSION OF ANY VIEWS OR DAMAGE TO THE RECEIVING ELECTRONIC SYSTEM WHEN INFORMATION IS TRANSFERRED	
01. Oct.07.2019	issued for tender
02. Mar.13.2020	issued for design coordination #2
03. Mar.16.2020	issued for addendum #2
04. Mar.16.2020	issued for addendum #3
05. Aug.24.2020	issued for addendum #4
06. Sept.28.2020	issued for permit
07. Oct.20.2020	issued for addendum #5
08. Nov.23.2020	issued for addendum #6
09. Dec.14.2020	issued for addendum #7
10. Jan.18.2021	issued for addendum #8
11. Mar.2.2021	issued for permit
12. Mar.09.2021	issued for addendum #9
13. Mar.10.2021	issued for addendum #9R
14. Mar.26.2021	issued for progress
15. May.14.2021	issued for Site Instruction #1
16. June.15.2021	issued for Site Instruction #2
17. July.7.2021	re-issued for permit
18. July.15.2021	issued for Site Instruction #3
19. July.27.2021	issued for Site Instruction #4
20. Aug.3.2021	issued for Site Instruction #5
21. Aug.18.2021	issued for Site Instruction #6
22. Aug.20.2021	re-issued for permit
23. Sept.07.2021	issued for Site Instruction #7
24. Sept.09.2021	issued for Site Instruction #8
25. Sept.16.2021	issued for Building D Permit Revisions
26. Sept.22.2021	issued for Site Instruction #9
27. Oct.6.2021	re-issued for permit
28. Oct.8.2021	issued for Site Instruction #10
30. Oct.28.2021	issued for Site Instruction #11
31. Nov.05.2021	issued for Site Instruction #12
32. Dec.3.2021	issued for Site Instruction #13
33. Dec.6.2021	issued for Site Instruction #14
34. Dec.7.2021	issued for Site Instruction #15

01. SEP.08.2019 issued for addendum 1
issued for revisions



1500 SHANAGHAN DRIVE, SUITE 100 MISSISSAUGA, ONTARIO L4W 1C3
905.709.7801 P.905.709.7804 WWW.GC-ARCHITECTS.COM

BRAMPTON ONTARIO
PROJECT ARCHITECT: B. GRAZIANI
ASSISTANT DESIGNER: R. LINCOLN
DRAWN BY: G.C./F.C./M.B.
CHECKED BY: D. BIASE/ COLANGELO
PLOT DATE: DEC.07.2021
JOB #: 1331.15

CONCRETE SLAB EDGE
GROUND FLOOR (ENLARGE PLAN)

1:100 CS301a1
TITLEBLOCK SIZE: 915 x 1200

THIS DRAWING IS AN INSTRUMENT OF SERVICE. IT IS PROVIDED BY AND IS THE PROPERTY OF GRAZIANI-CORAZZA ARCHITECTS INC. THE CONTRACTOR MUST VERIFY AND ACCEPT RESPONSIBILITY FOR ALL DIMENSIONS AND COORDINATIONS AND MUST NOTIFY GRAZIANI-CORAZZA ARCHITECTS INC. OF ANY DISCREPANCIES FROM THE SURVEY INFORMATION. GRAZIANI-CORAZZA ARCHITECTS INC. IS NOT RESPONSIBLE FOR THE ACCURACY OF SURVEY, STRUCTURAL, MECHANICAL, ELECTRICAL AND OTHER INFORMATION SHOWN ON THIS DRAWING. REFER TO THE APPROPRIATE ENGINEERING DRAWINGS BEFORE PROCEEDING WITH THE WORK. CONSTRUCTION MUST CONFORM TO ALL APPLICABLE CODES AND REQUIREMENTS OF THE AUTHORITY HAVING JURISDICTION. UNLESS OTHERWISE NOTED, NO MODIFICATION HAS BEEN MADE/NOTED OR REPORTED ON BY THIS OFFICE IN REGARD TO THE ENVIRONMENTAL CONDITION OF THIS SITE.

THIS DRAWING IS NOT TO BE SCALED. ALL ARCHITECTURAL SYMBOLS INDICATED ON THIS DRAWING ARE GRAPHIC REPRESENTATIONS ONLY.

CONDITIONS FOR ELECTRONIC INFORMATION TRANSFER:

ELECTRONIC INFORMATION IS SUPPLIED TO THE OTHER ASSOCIATED FIRMS TO ASSIST THEM IN THE EXECUTION OF THEIR WORK. REVIEW THE RECEIVED FIRMS MUST DETERMINE THE COMPLETENESS, APPROPRIATENESS, RELIANCE OF THE INFORMATION IN RESPECT TO THEIR PARTICULAR RESPONSIBILITY.

GRAZIANI-CORAZZA ARCHITECTS INC. SHALL NOT BE RESPONSIBLE FOR:

1. ERROR, OMISSION, INCOMPLETENESS DUE TO LOSS OF INFORMATION IN WHOLE OR PART WHEN INFORMATION IS TRANSMITTED.

2. TRANSMISSION OF ANY VIRUS OR DAMAGE TO THE RECEIVING ELECTRONIC SYSTEM WHEN INFORMATION IS TRANSMITTED.

01. Oct.07.2019 issued for tender
02. Mar.13.2020 issued for design coordination #2
03. Mar.16.2020 issued for addendum #2
04. Mar.16.2020 issued for addendum #3
05. Aug.24.2020 issued for addendum #4
06. Sept.28.2020 issued for permit
07. Oct.20.2020 issued for addendum #5
08. Nov.23.2020 issued for addendum #6
09. Dec.14.2020 issued for addendum #7
10. Jan.15.2021 issued for addendum #8
11. Mar.2.2021 issued for permit
12. Mar.09.2021 issued for addendum #9
13. Mar.10.2021 issued for addendum #9R
14. Mar.26.2021 issued for progress
15. May.14.2021 issued for Site Instruction #1
16. June.15.2021 issued for Site Instruction #2
17. July.7.2021 re-issued for permit
18. July.15.2021 issued for Site Instruction #3
19. July.27.2021 issued for Site Instruction #4
20. Aug.3.2021 issued for Site Instruction #5
21. Aug.18.2021 issued for Site Instruction #6
22. Aug.20.2021 Re-issued for permit
23. Sept.07.2021 issued for Site Instruction #7
24. Sept.09.2021 issued for Site Instruction #8
25. Sept.16.2021 issued for Building D Permit Revisions
26. Sept.22.2021 issued for Site Instruction #9
27. Oct.6.2021 Re-issued for permit
28. Oct.8.2021 issued for Site Instruction #10
30. Oct.28.2021 issued for Site Instruction #11
31. Nov.05.2021 issued for Site Instruction #12
32. Dec.3.2021 issued for Site Instruction #13
33. Dec.6.2021 issued for Site Instruction #14
34. Dec.7.2021 issued for Site Instruction #15

01. SEP/18/2021 issued for addendum 1

issued for revisions

GRAZIANI CORAZZA ARCHITECTS

1325 SHANAGHAN DRIVE, SUITE 100 MISSISSAUGA, ONTARIO L4W 1C3
905.709.7001 P.905.709.7000 WWW.GC-ARCHITECTS.COM

ATTMAR + PALLESCHI DRIVE



BRAMPTON ONTARIO

PROJECT ARCHITECT: B. GRAZIANI
ASSISTANT DESIGNER: R. LINCOLN
DRAWN BY: G.C./F.C./M.B.
CHECKED BY: D. BIASI/G. COLANGELO
PLOT DATE: DEC.07.2021
JOB # 1331.15


**SECOND FLOOR OVERALL PLAN
CONCRETE SLAB EDGE**

1:150 CS302


TITLEBLOCK SIZE: 915 x 1200

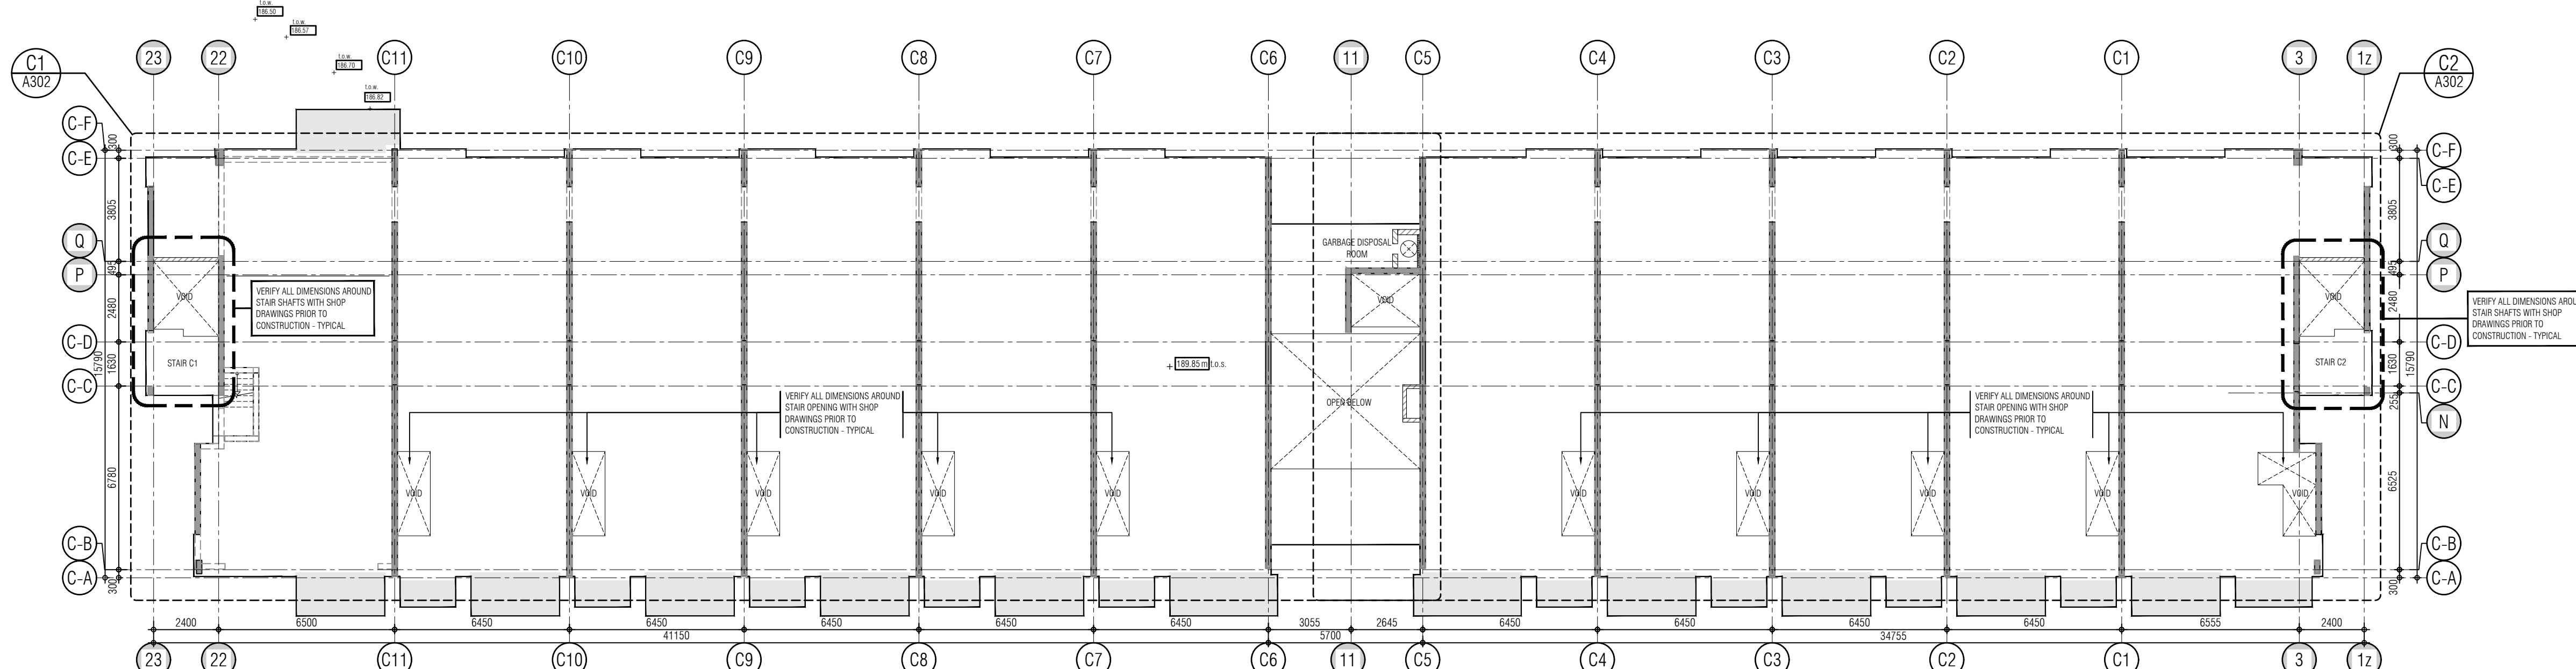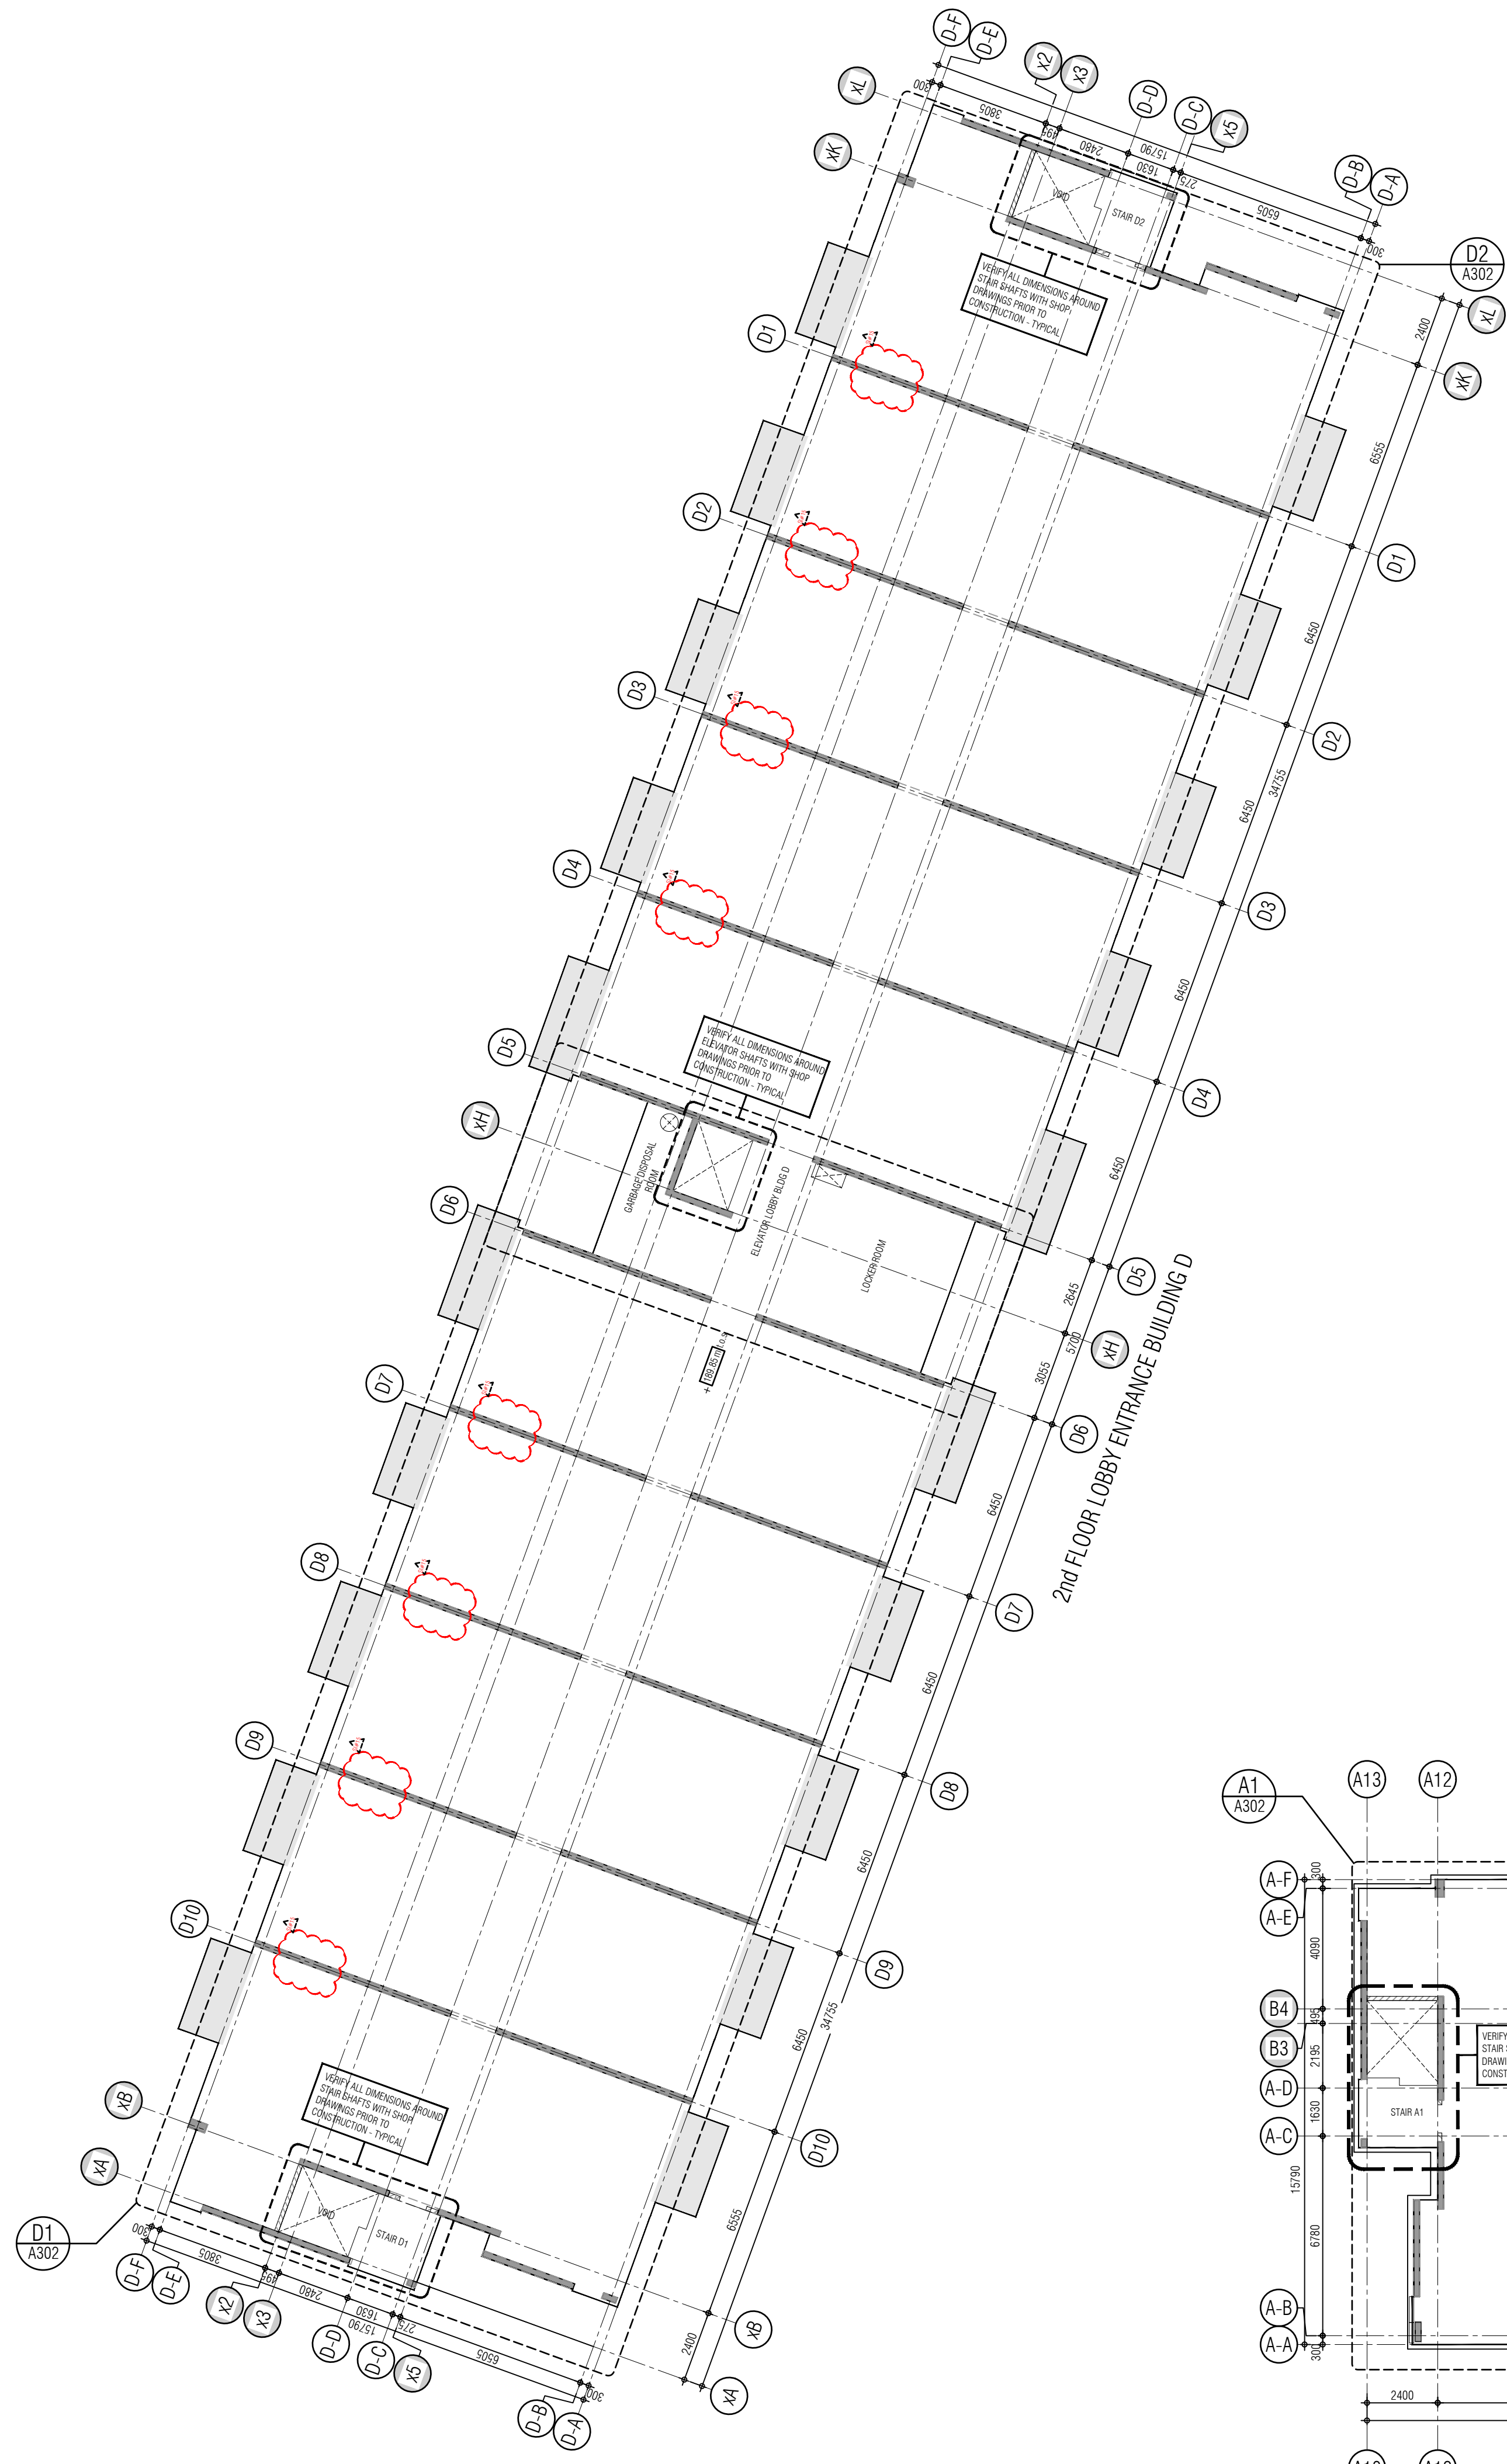

2nd FLOOR LOBBY ENTRANCE BUILDING C

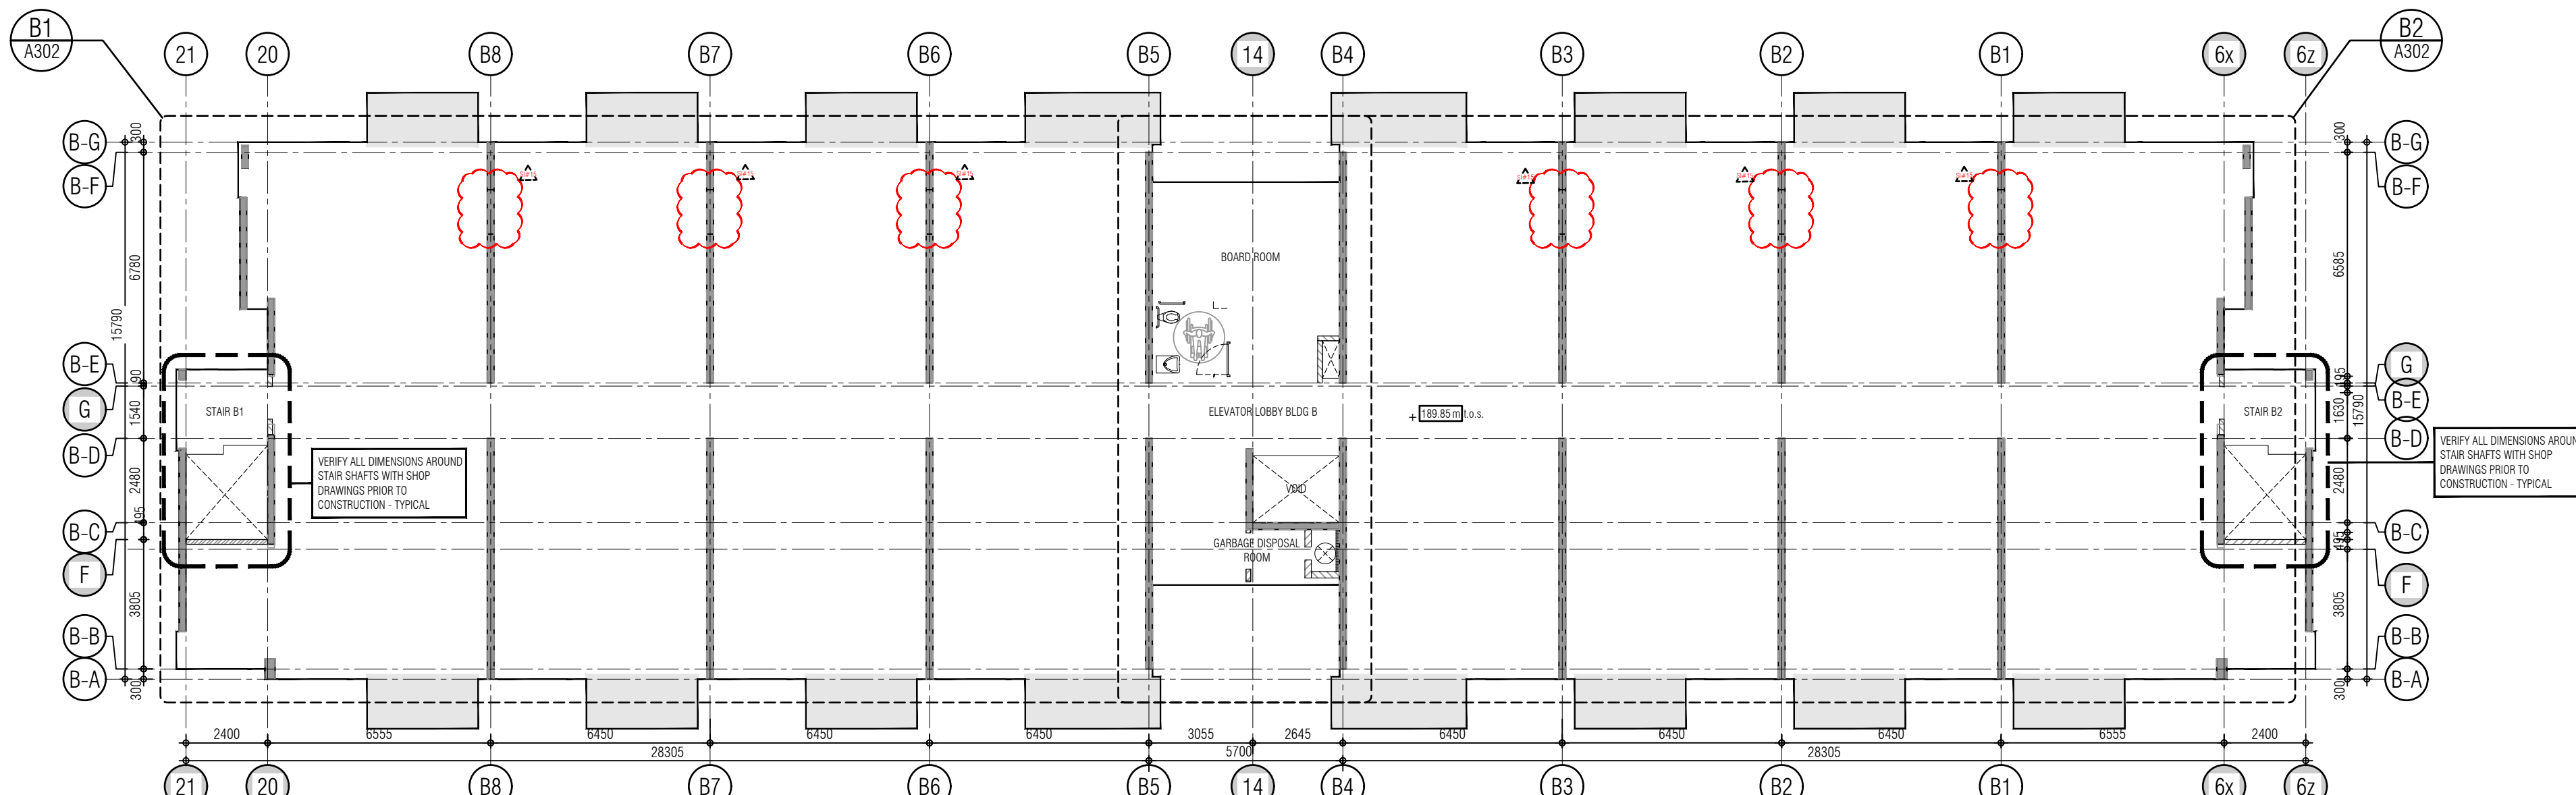

2nd FLOOR LOBBY ENTRANCE BUILDING B

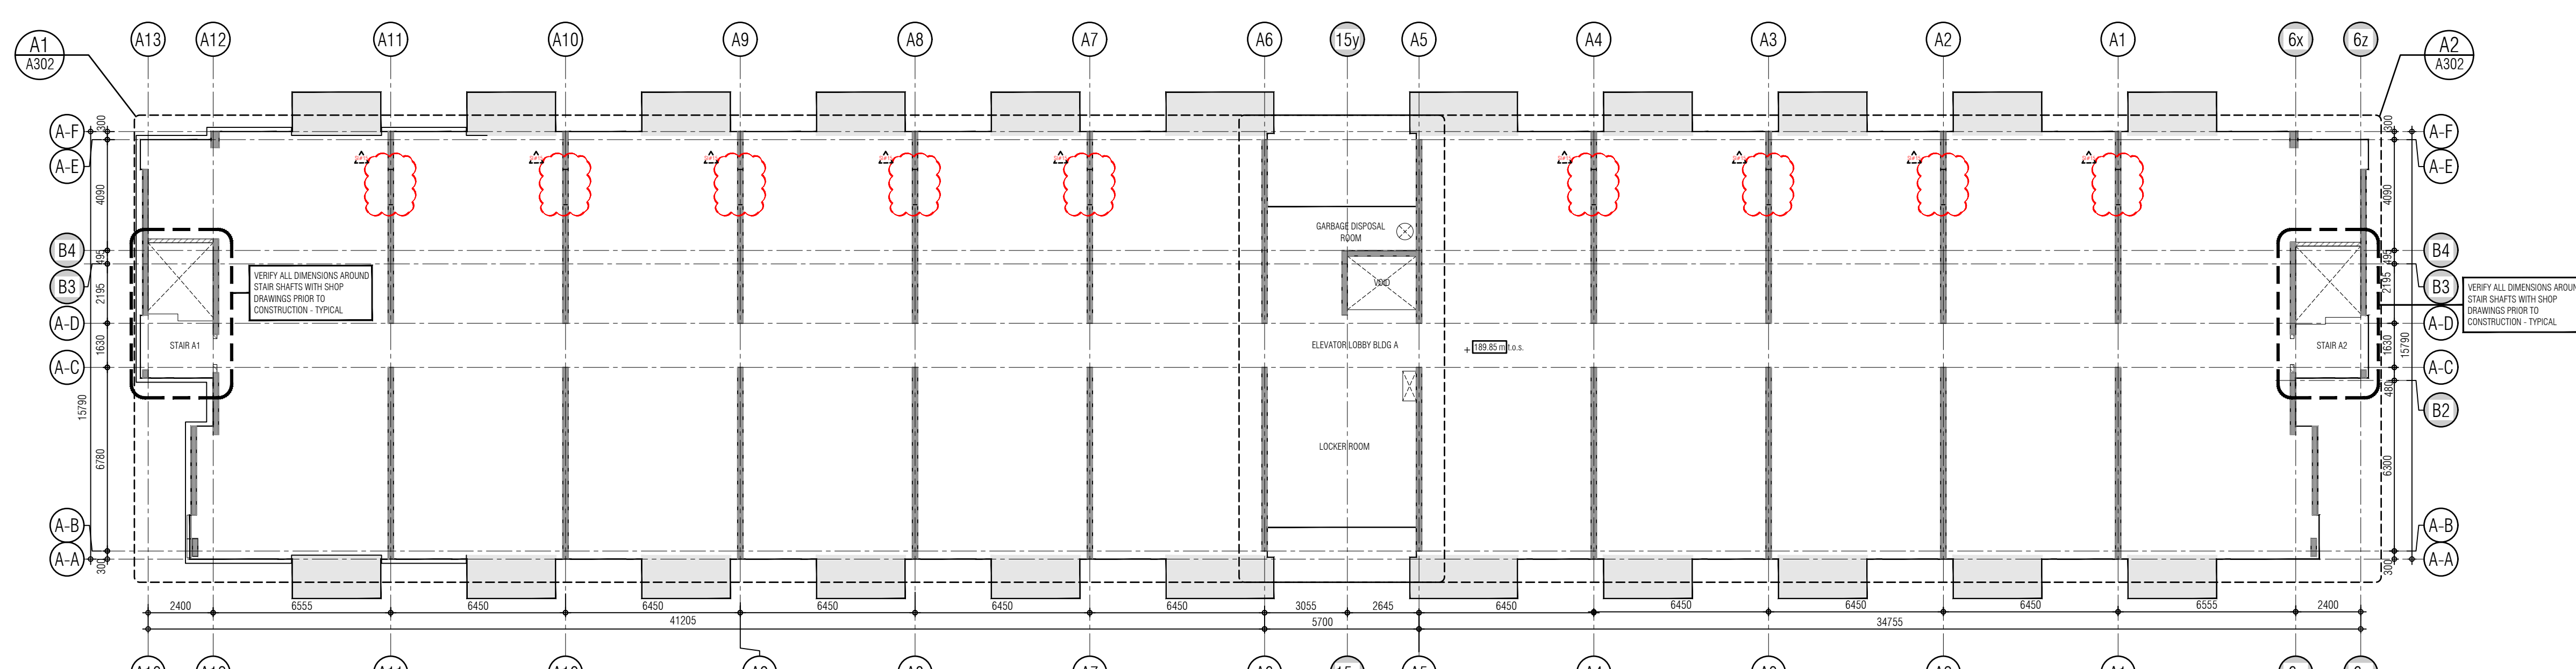

2nd FLOOR LOBBY ENTRANCE BUILDING A

THIS DRAWING IS AN INSTRUMENT OF SERVICE. IT IS PROVIDED BY AND IS THE PROPERTY OF GRAZIANI-CORAZZA ARCHITECTS INC. THE CONTRACTOR MUST VERIFY AND ACCEPT RESPONSIBILITY FOR ALL DIMENSIONS AND COORDINATE THE SITE AND MUST NOTIFY GRAZIANI-CORAZZA ARCHITECTS INC. OF ANY VARIATIONS FROM THE SUPPLIED INFORMATION. GRAZIANI-CORAZZA ARCHITECTS INC. IS NOT RESPONSIBLE FOR THE ACCURACY OF SURVEY, STRUCTURAL, MECHANICAL, ELECTRICAL AND OTHER ENGINEERING INFORMATION SHOWN ON THIS DRAWING. REFER TO THE APPROPRIATE ENGINEERING DRAWINGS BEFORE PROCEEDING WITH THE WORK. CONSTRUCTION MUST CONFORM TO ALL APPLICABLE CODES AND REQUIREMENTS OF THE AUTHORITIES HAVING JURISDICTION. UNLESS OTHERWISE NOTED, NO INVESTIGATION HAS BEEN UNDERTAKEN OR REPORTED ON BY THIS OFFICE IN REGARDS TO THE ENVIRONMENTAL CONDITION OF THIS SITE.

THIS DRAWING IS NOT TO BE SCALED. ALL ARCHITECTURAL SYMBOLS INDICATED ON THIS DRAWING ARE GRAPHIC REPRESENTATIONS ONLY.


CONDITIONS FOR ELECTRONIC INFORMATION TRANSFER:

ELECTRONIC INFORMATION IS SUPPLIED TO THE OTHER ASSOCIATED FIRMS TO ASSIST THEM IN THE EXECUTION OF THEIR WORK. REVIEW THE RECIPIENT FIRMS MUST DETERMINE THE COMPLETENESS, APPROPRIATENESS, RELIANCE OF THE INFORMATION IN RESPECT TO THEIR PARTICULAR RESPONSIBILITY.

GRAZIANI-CORAZZA ARCHITECTS INC. SHALL NOT BE RESPONSIBLE FOR ERRORS, OMISSIONS, INCOMPLETENESS DUE TO LOSS OF INFORMATION IN WHICH OR FROM WHICH INFORMATION IS TRANSMITTED.

1. TRANSMISSION OF ANY LOSS OF DAMAGE TO THE RECEIVING ELECTRONIC SYSTEM WHEN INFORMATION IS TRANSMITTED.

REF A302a2 FOR CONTINUATION

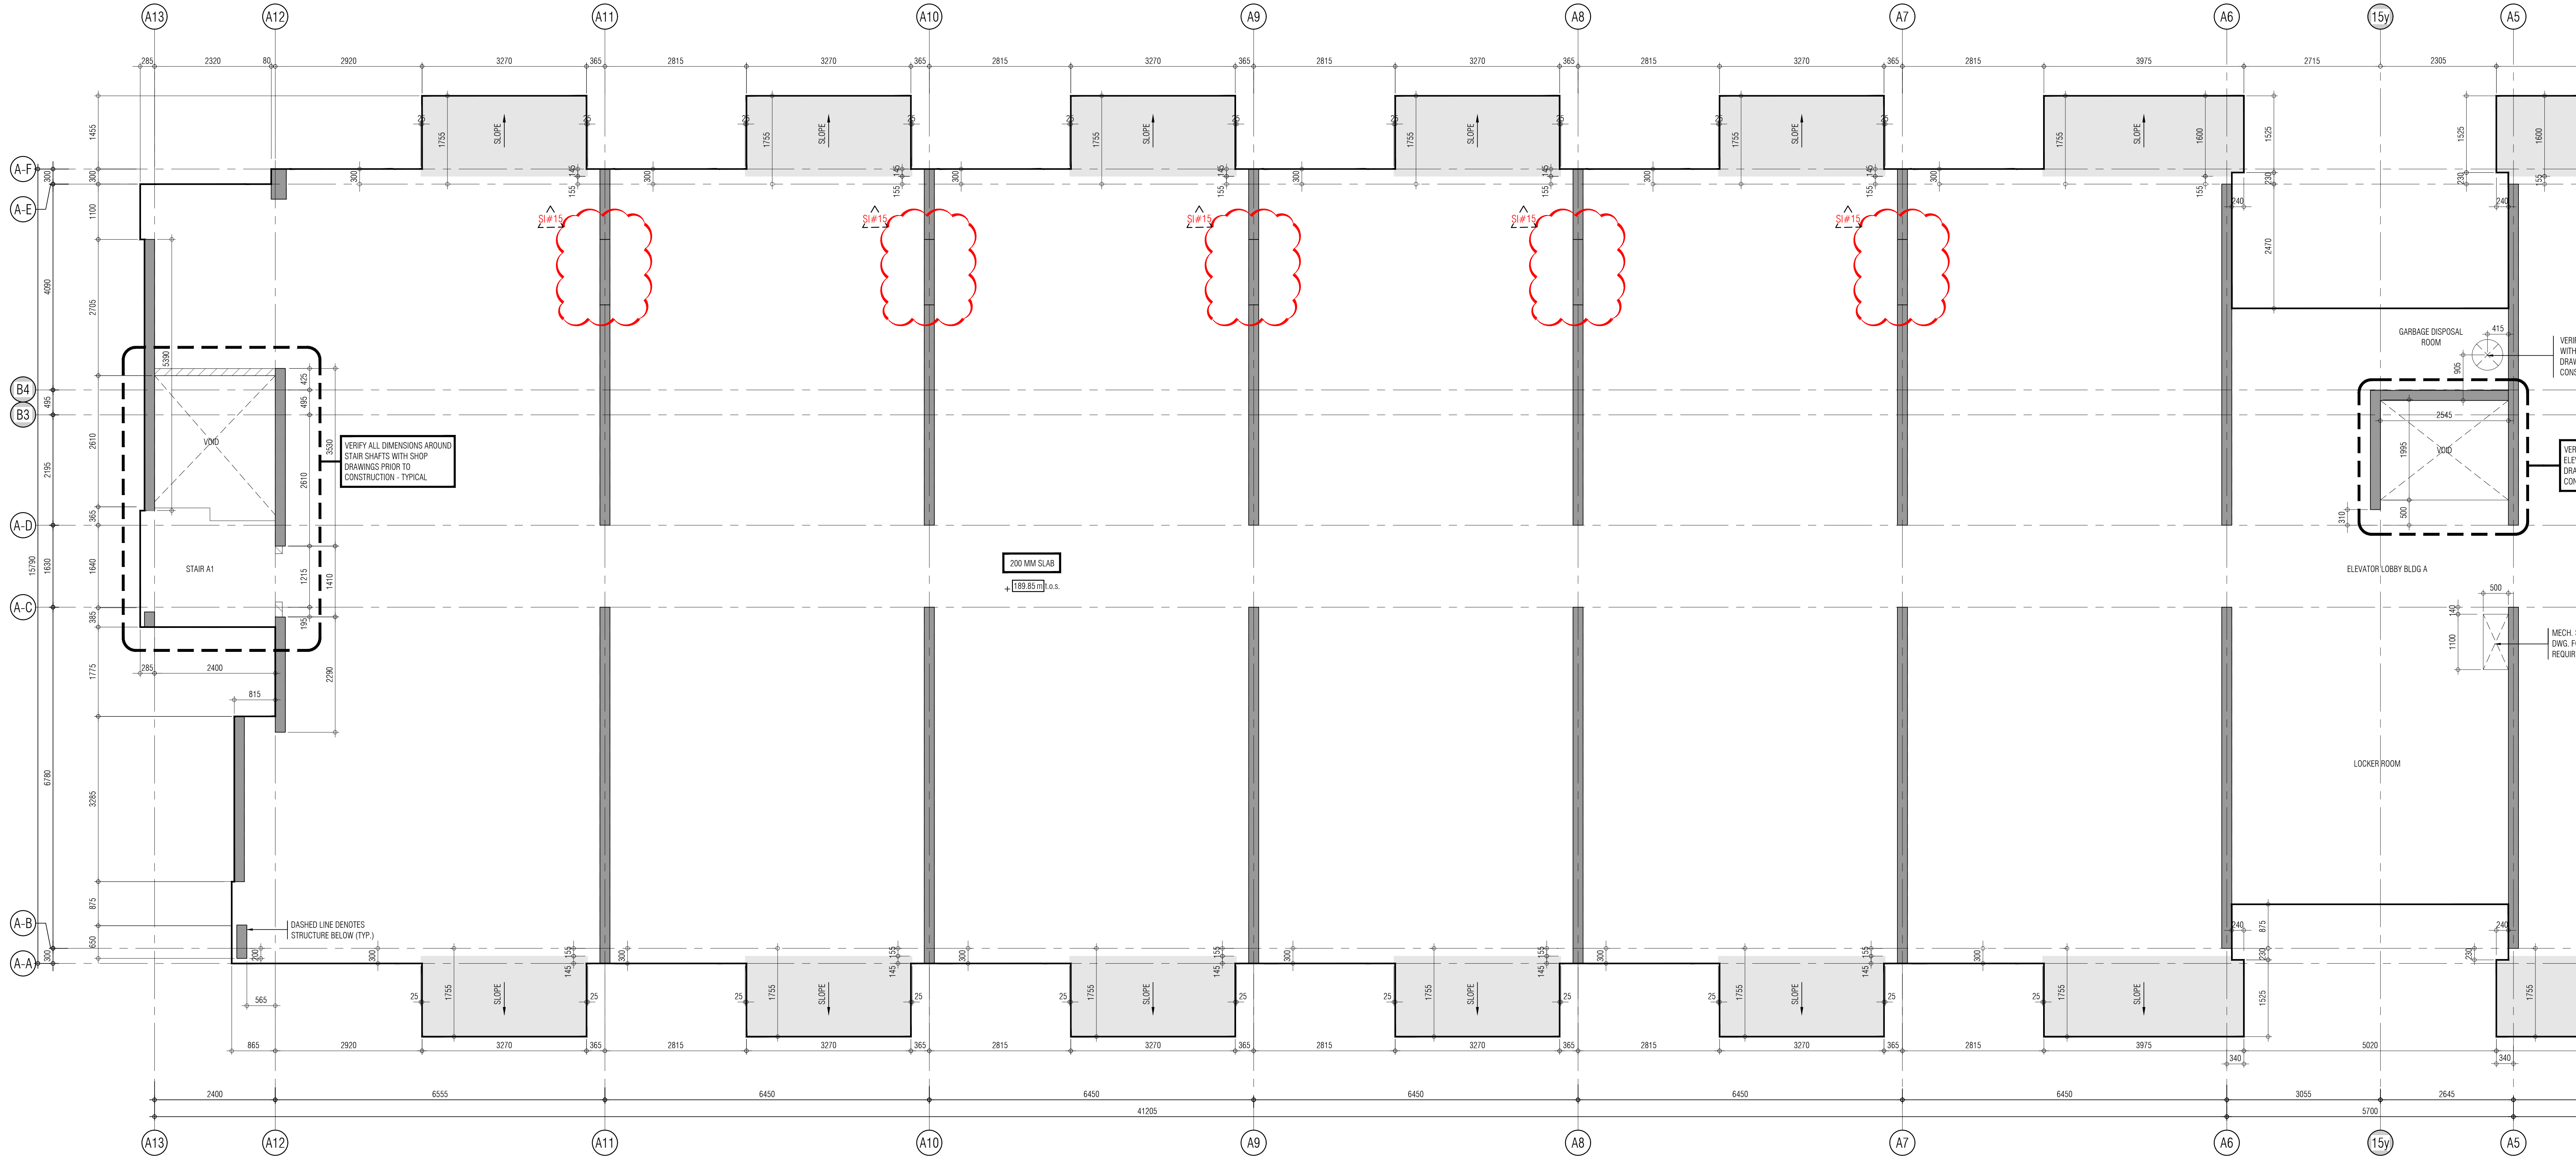

- 01. Oct.07.2019 issued for tender
- 02. Mar.13.2020 issued for design coordination #2
- 03. Mar.16.2020 issued for addendum #2
- 04. Mar.16.2020 issued for addendum #3
- 05. Aug.24.2020 issued for addendum #4
- 06. Sept.28.2020 issued for permit
- 07. Oct.20.2020 issued for addendum #5
- 08. Nov.23.2020 issued for addendum #6
- 09. Dec.14.2020 issued for addendum #7
- 10. Jan.18.2021 issued for addendum #8
- 11. Mar.2.2021 issued for permit
- 12. Mar.09.2021 issued for addendum #9
- 13. Mar.10.2021 issued for addendum #9R
- 14. May.26.2021 issued for progress
- 15. May.14.2021 issued for Site Instruction #1
- 16. June.15.2021 issued for Site Instruction #2
- 17. July.7.2021 re-issued for permit
- 18. July.15.2021 issued for Site Instruction #3
- 19. July.27.2021 issued for Site Instruction #4
- 20. Aug.3.2021 issued for Site Instruction #5
- 21. Aug.18.2021 issued for Site Instruction #6
- 22. Aug.20.2021 Re-issued for permit
- 23. Sept.07.2021 issued for Site Instruction #7
- 24. Sept.09.2021 issued for Site Instruction #8
- 25. Sept.16.2021 issued for Building O Permit Revisions
- 26. Sept.22.2021 issued for Site Instruction #9
- 27. Oct.6.2021 Re-issued for permit
- 28. Oct.8.2021 issued for Site Instruction #10
- 30. Oct.28.2021 issued for Site Instruction #11
- 31. Nov.05.2021 issued for Site Instruction #12
- 32. Dec.3.2021 issued for Site Instruction #13
- 33. Dec.6.2021 issued for Site Instruction #14
- 34. Dec.7.2021 issued for Site Instruction #15

- 01. SEP.18.2021 issued for addendum 1
- issued for revisions

GRAZIANI CORAZZA ARCHITECTS

1233 SHAWNEE DRIVE, SUITE 101 MISSISSAUGA, ONTARIO L4W 1C3
905.761.2021 P.905.761.2020 WWW.GC-ARCHITECTS.COM

RESIDENTIAL

ATTMOR + PALLESCHI DRIVE


BRAMPTON ONTARIO


PROJECT ARCHITECT: B. GRAZIANI
ASSISTANT DESIGNER: R. LINCOLN
DRAWN BY: G.C./F.C./M.B.
CHECKED BY: D. BIASE/G. COLANGELO
PLOT DATE: DEC.07.2021
JOB # 1331.15

CONCRETE SLAB EDGE 2ND FLOOR PLAN
BUILDING A (PARTIAL PLAN)

1:50 CS302a1

TITLEBLOCK SIZE: 915 x 1200

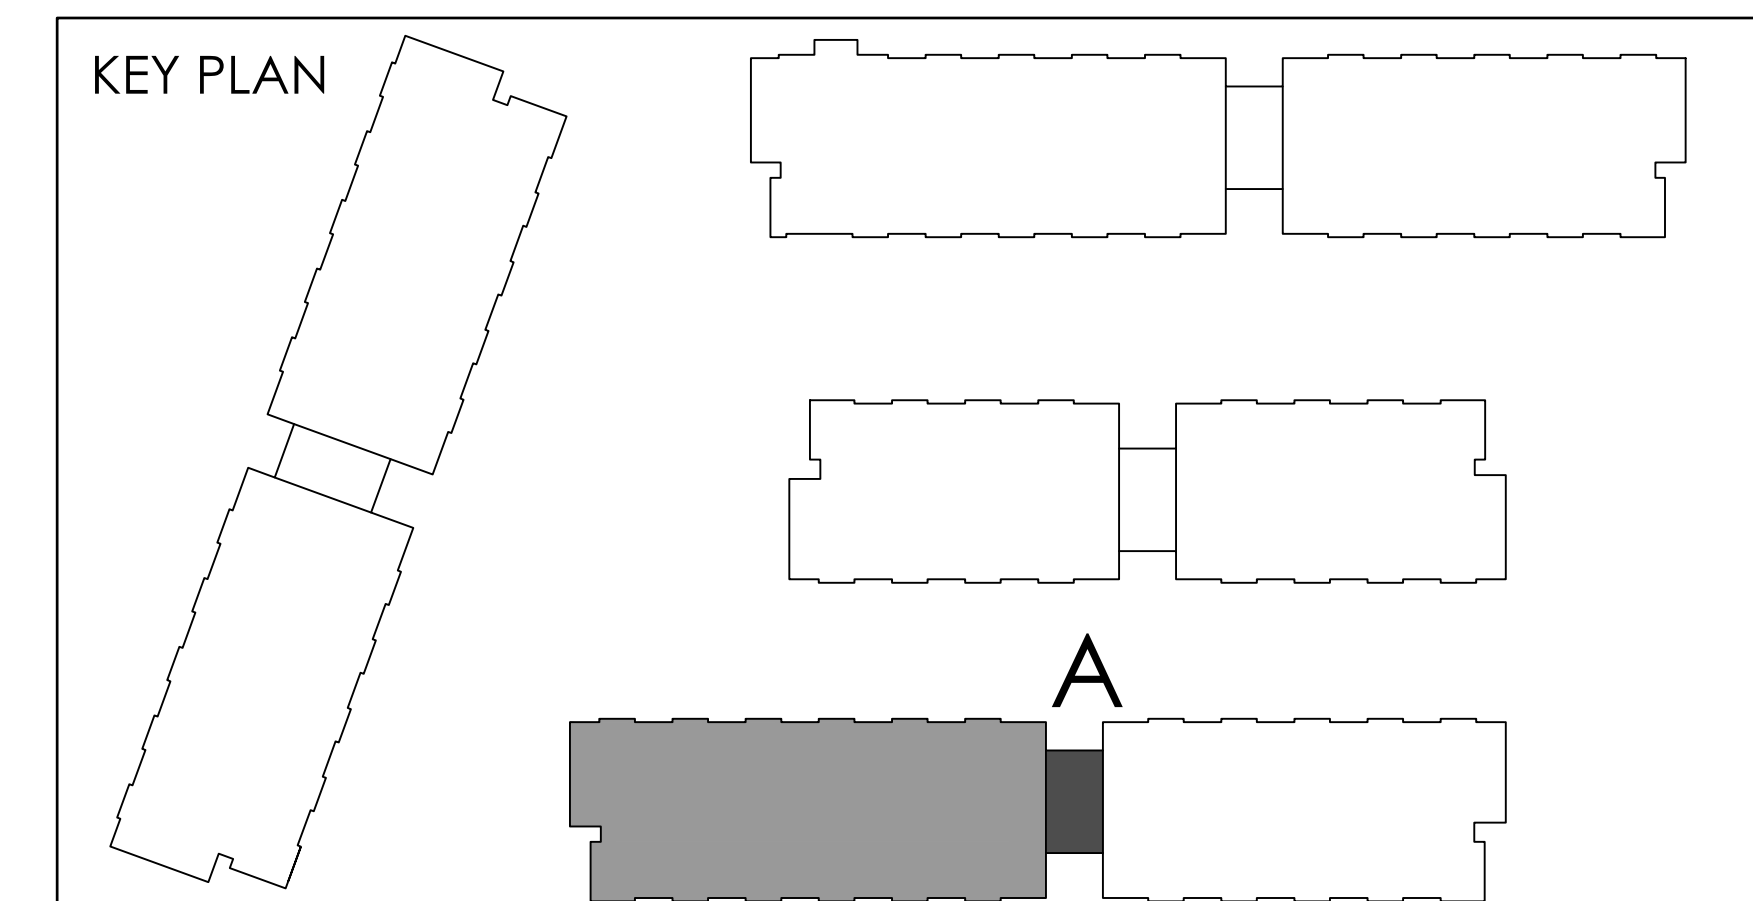

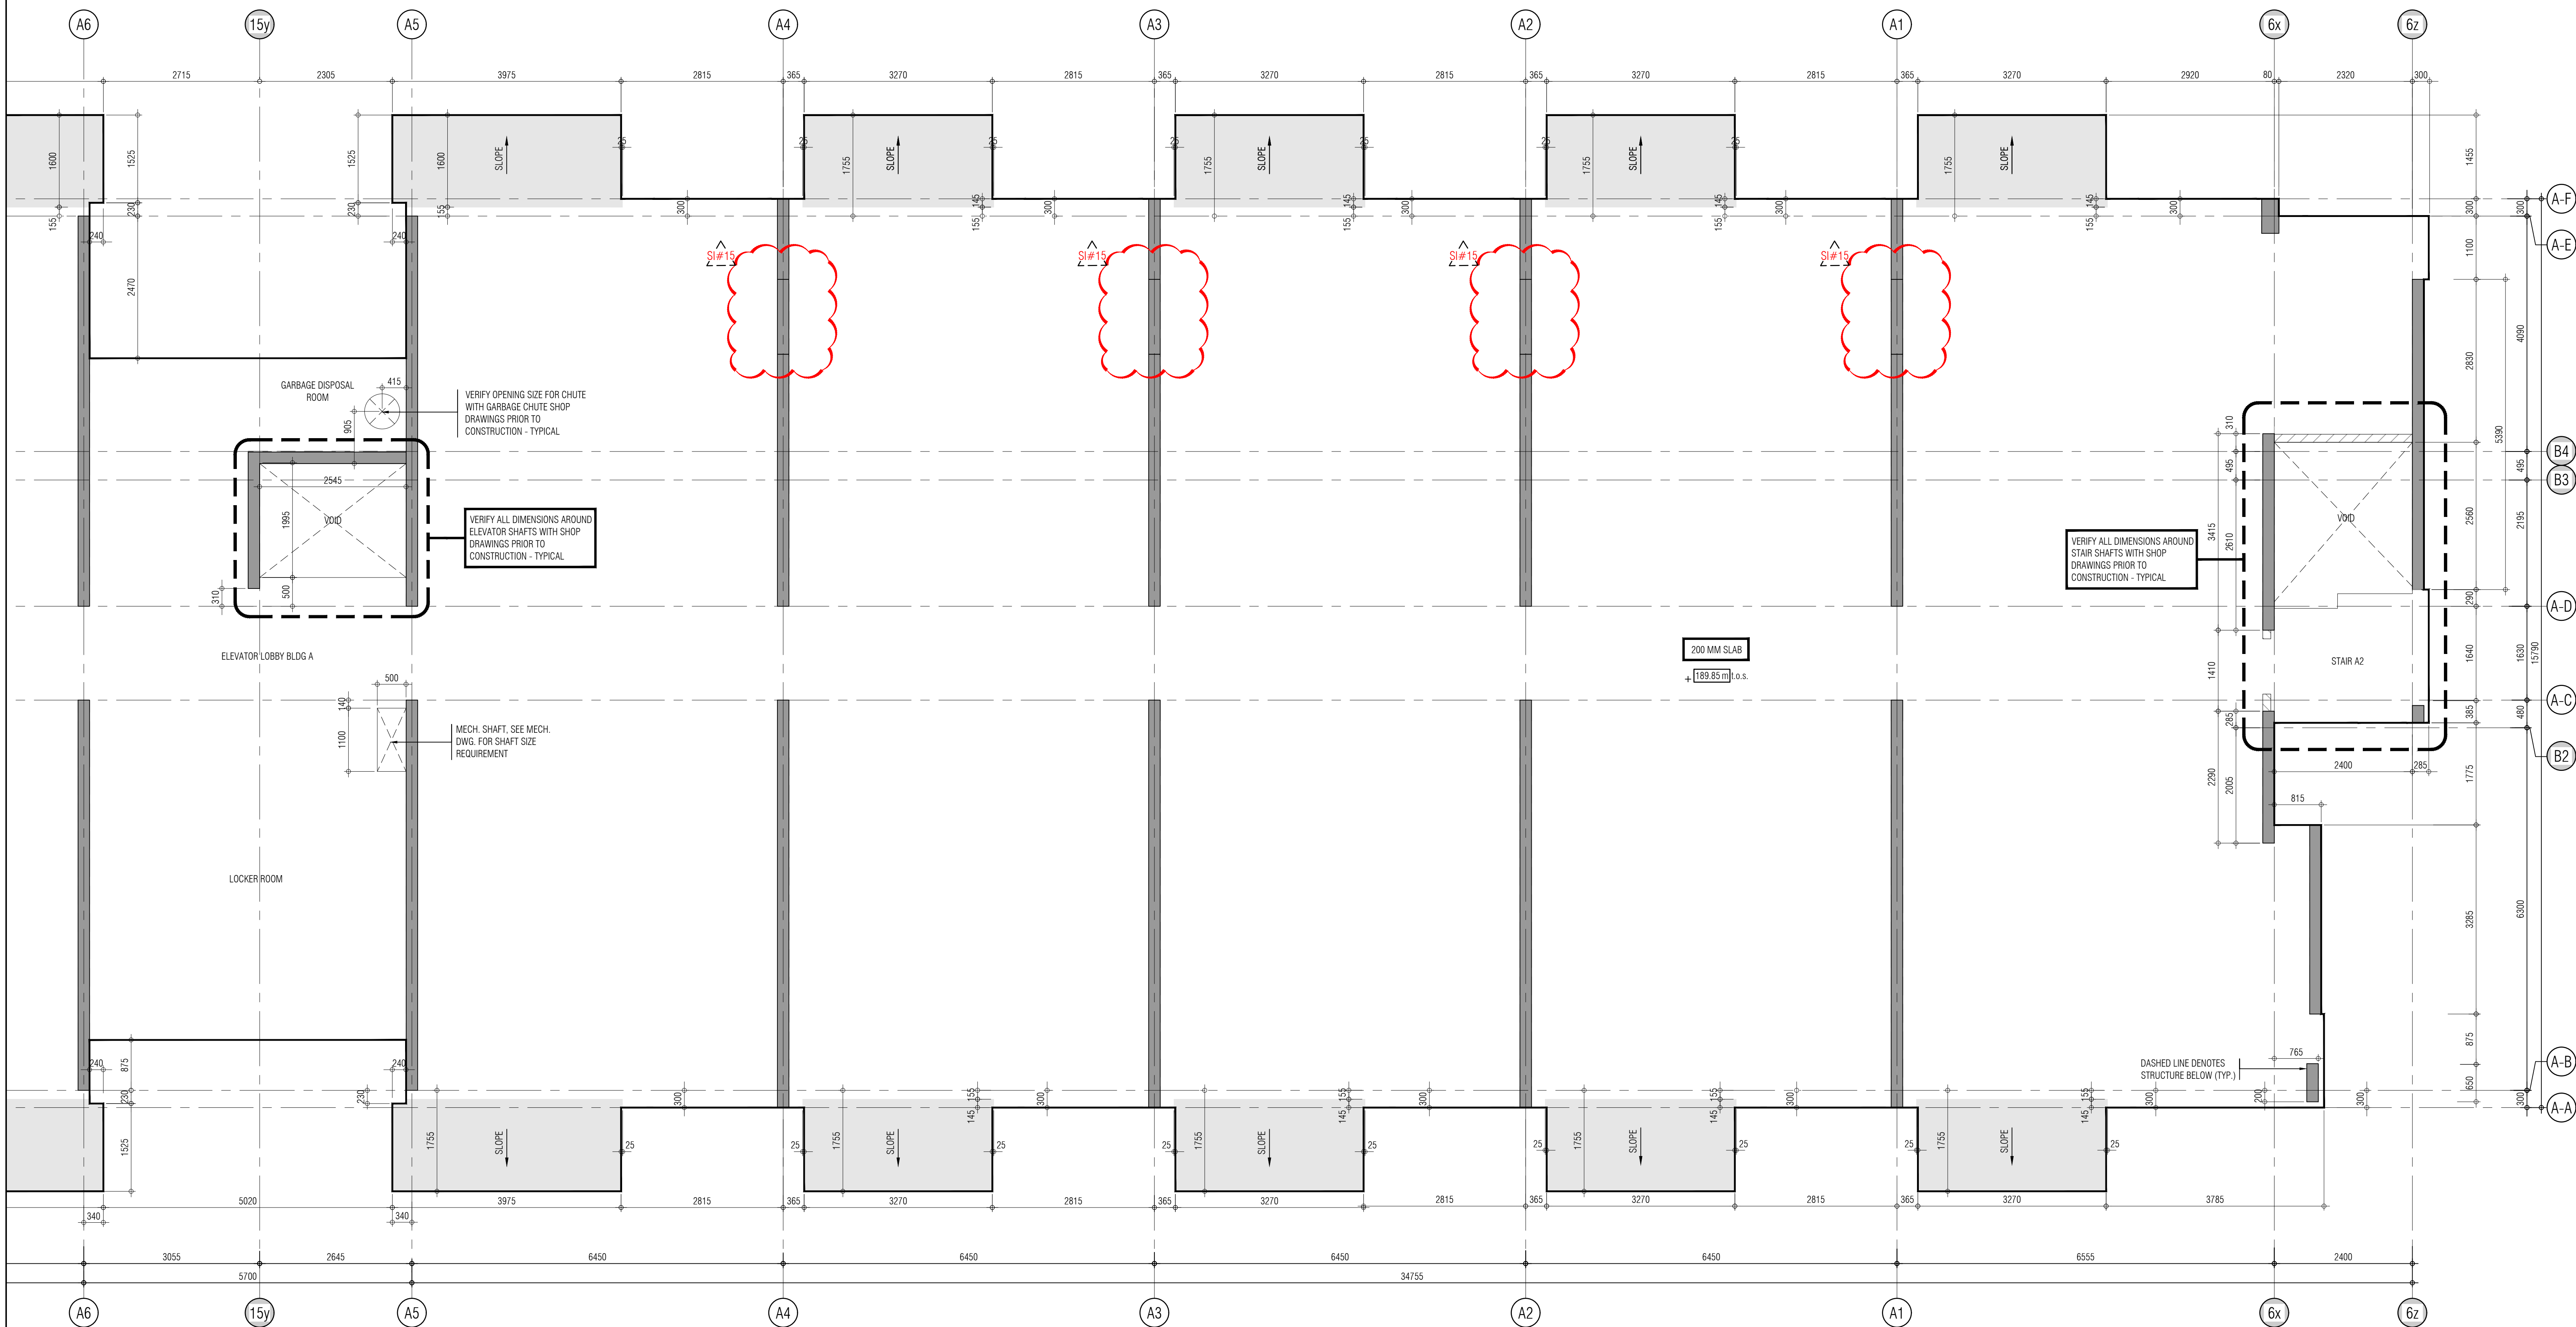

THIS DRAWING IS AN INSTRUMENT OF SERVICE, IT IS PROVIDED BY AND IS THE PROPERTY OF GRAZIANI-CORAZZA ARCHITECTS INC. THE CONTRACTOR MUST STAFF AND ACCEPT RESPONSIBILITY FOR ALL INTERPRETATION AND CONSTRUCTION OF THIS DRAWING. GRAZIANI-CORAZZA ARCHITECTS INC. IS NOT RESPONSIBLE FOR THE ACCURACY OF SURVEY, STRUCTURAL, MECHANICAL, ELECTRICAL AND OTHER ENGINEERING INFORMATION SHOWN ON THIS DRAWING. REFER TO THE APPROPRIATE ENGINEERING DRAWINGS BEFORE PROCEEDING WITH THE WORK. CONSTRUCTION MUST COMPLY TO ALL APPLICABLE CODES AND REQUIREMENTS OF THE AUTHORITIES HAVING JURISDICTION. UNLESS OTHERWISE NOTED, NO INVESTIGATION HAS BEEN UNDERTAKEN OR REPORTED BY THIS OFFICE IN REGARDS TO THE ENVIRONMENTAL CONDITION OF THIS SITE.

THIS DRAWING IS NOT TO BE SCALED. ALL ARCHITECTURAL SYMBOLS INDICATED ON THIS DRAWING ARE GRAPHIC REPRESENTATIONS ONLY.

CONDITIONS FOR ELECTRONIC INFORMATION TRANSFER:

ELECTRONIC INFORMATION IS SUPPLIED TO THE OTHER ASSOCIATED FIRMS TO ASSIST THEM IN THE EXECUTION OF THEIR WORK. REVIEW THE RECEIVED FIRMS MUST DETERMINE THE COMPLETENESS, APPROPRIATENESS, RELIANCE OF THE INFORMATION IN RESPECT TO THEIR PARTICULAR RESPONSIBILITY.

GRAZIANI-CORAZZA ARCHITECTS INC. SHALL NOT BE RESPONSIBLE FOR ERRORS, OMISSIONS, INCOMPLETENESS DUE TO LOSS OF INFORMATION IN 1. WHICH OR PART WHEN INFORMATION IS TRANSMITTED.

2. TRANSMISSION OF ANY LOSS OF DAMAGE TO THE RECEIVING ELECTRONIC SYSTEM WHEN INFORMATION IS TRANSMITTED.

01. Oct.07.2019 issued for tender
02. Mar.13.2020 issued for design coordination #2
03. Mar.16.2020 issued for addendum #2
04. Mar.16.2020 issued for addendum #3
05. Aug.24.2020 issued for addendum #4
06. Sept.28.2020 issued for permit
07. Oct.20.2020 issued for addendum #5
08. Nov.23.2020 issued for addendum #6
09. Dec.14.2020 issued for addendum #7
10. Jan.15.2021 issued for addendum #8
11. Mar.2.2021 issued for permit
12. Mar.09.2021 issued for addendum #9
13. Mar.10.2021 issued for addendum #9R
14. Mar.26.2021 issued for progress
15. May.14.2021 issued for Site Instruction #1
16. June.15.2021 issued for Site Instruction #2
17. July.7.2021 re-issued for permit
18. July.15.2021 issued for Site Instruction #3
19. July.27.2021 issued for Site Instruction #4
20. Aug.3.2021 issued for Site Instruction #5
21. Aug.18.2021 issued for Site Instruction #6
22. Aug.20.2021 Re-issued for permit.
23. Sept.07.2021 issued for Site Instruction #7
24. Sept.09.2021 issued for Site Instruction #8
25. Sept.16.2021 issued for Building D Permit Revisions
26. Sept.22.2021 issued for Site Instruction #9
27. Oct.6.2021 Re-issued for permit.
28. Oct.8.2021 issued for Site Instruction #10
30. Oct.28.2021 issued for Site Instruction #11
31. Nov.05.2021 issued for Site Instruction #12
32. Dec.3.2021 issued for Site Instruction #13
33. Dec.6.2021 issued for Site Instruction #14
34. Dec.7.2021 issued for Site Instruction #15

01. SEP/18/2021 issued for revisions

GRAZIANI CORAZZA ARCHITECTS

1320 SHAWNEE DRIVE, SUITE 100 MISSISSAUGA, ONTARIO L4W 1C3
905.709.7001 P.905.709.7000 WWW.GC-ARCHITECTS.COM

RESIDENTIAL

ATTMAR + PALLESCHI DRIVE

BRAMPTON ONTARIO

PROJECT ARCHITECT: B. GRAZIANI
ASSISTANT DESIGNER: R. LINCOLN
DRAWN BY: G.C./F.C./M.B.
CHECKED BY: D. BIASE/G. COLANGELO
PLOT DATE: DEC.07.2021
JOB # 1331.15

**CONCRETE SLAB EDGE 2ND FLOOR PLAN
BUILDING A (PARTIAL PLAN)**

1:50 CS302a2

TITLE BLOCK SIZE: 915 x 1200

THIS DRAWING IS NOT TO BE SCALED. ALL ARCHITECTURAL SYMBOLS INDICATED ON THIS DRAWING ARE GRAPHIC REPRESENTATIONS ONLY.

CONDITIONS FOR ELECTRONIC INFORMATION TRANSFER:

ELECTRONIC INFORMATION IS SUPPLIED TO THE OTHER ASSOCIATED FIRMS TO ASSIST THEM IN THE EXECUTION OF THEIR WORK/REVIEW. THE RECIPIENT FIRMS MUST DETERMINE THE COMPLETENESS/APPROPRIATENESS/RELEVANCE OF THE INFORMATION IN RESPECT TO THEIR PARTICULAR RESPONSIBILITY.



DRAWING – CARROZ ARCHITECTS INC. SHALL NOT BE RESPONSIBLE FOR:

1. ERRORS, OMISSIONS, INCOMPLETENESS DUE TO LOSS OF INFORMATION IN WHOLE OR PART WHEN INFORMATION IS TRANSFERRED.
2. TRANSMISSION OF ANY FILES OR DATABASE TO THE RECEIVING ELECTRONIC SYSTEM WHEN INFORMATION IS TRANSFERRED.



01. SEP:2019 Issued for circulation 1
issued for revisions



CONCRETE SLAB EDGE 2ND FLOOR PL
BUILDING B (PARTIAL PLAN)

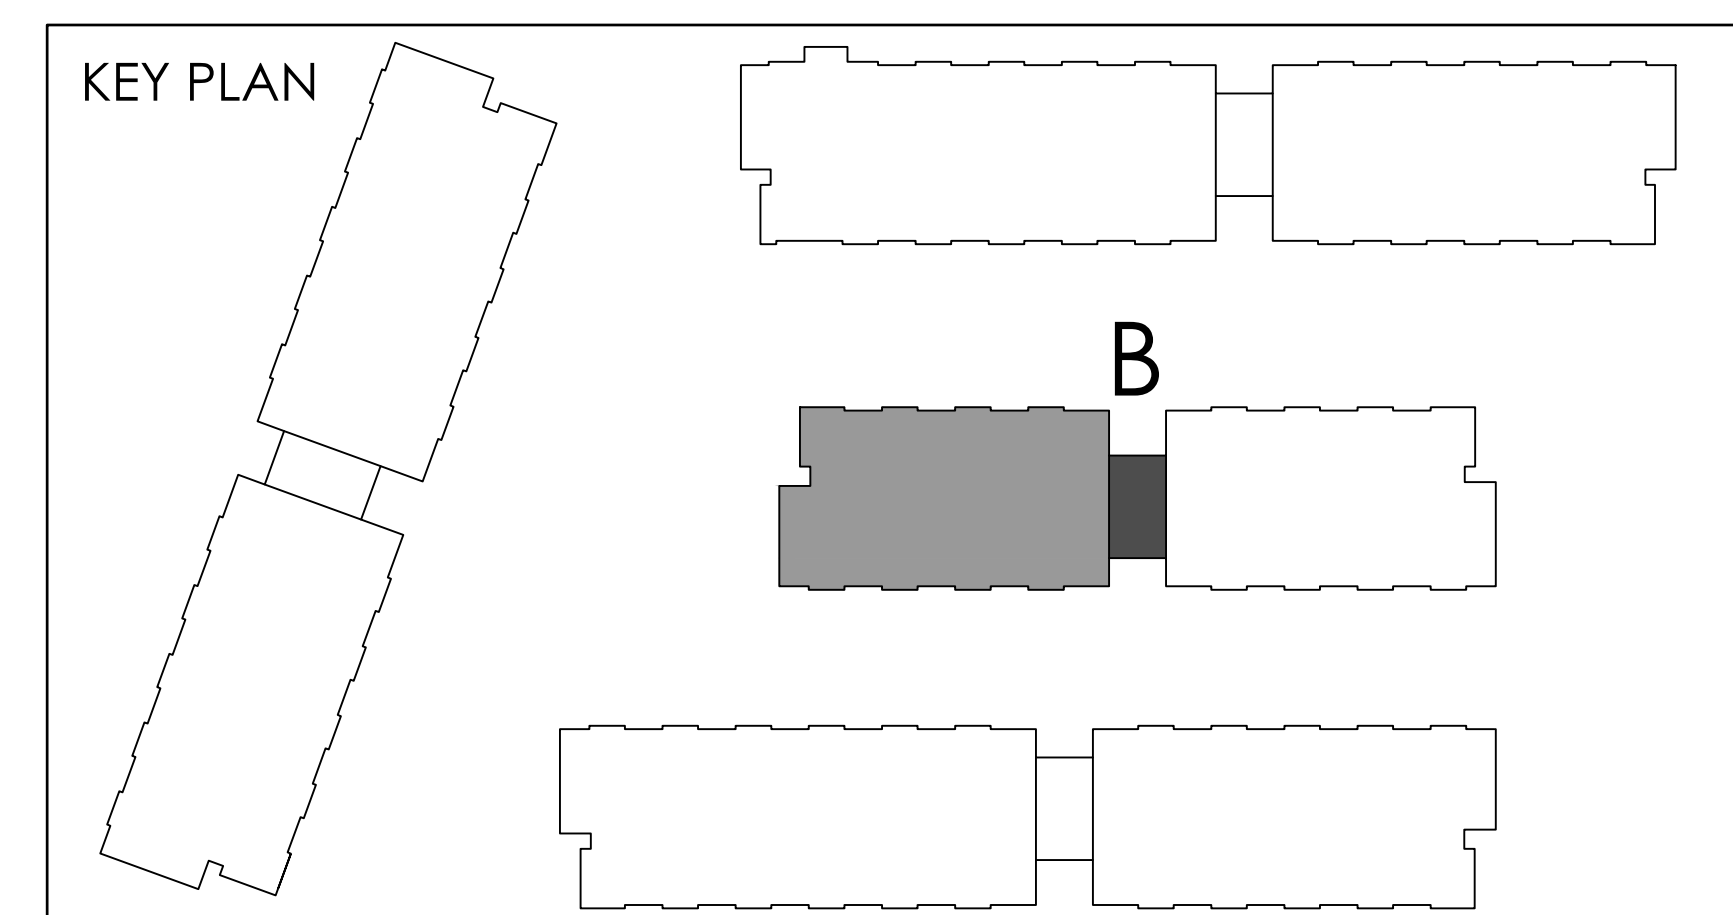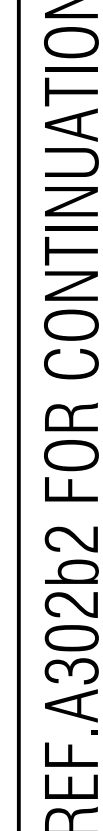

REF.A302b1 FOR CONTINUATION

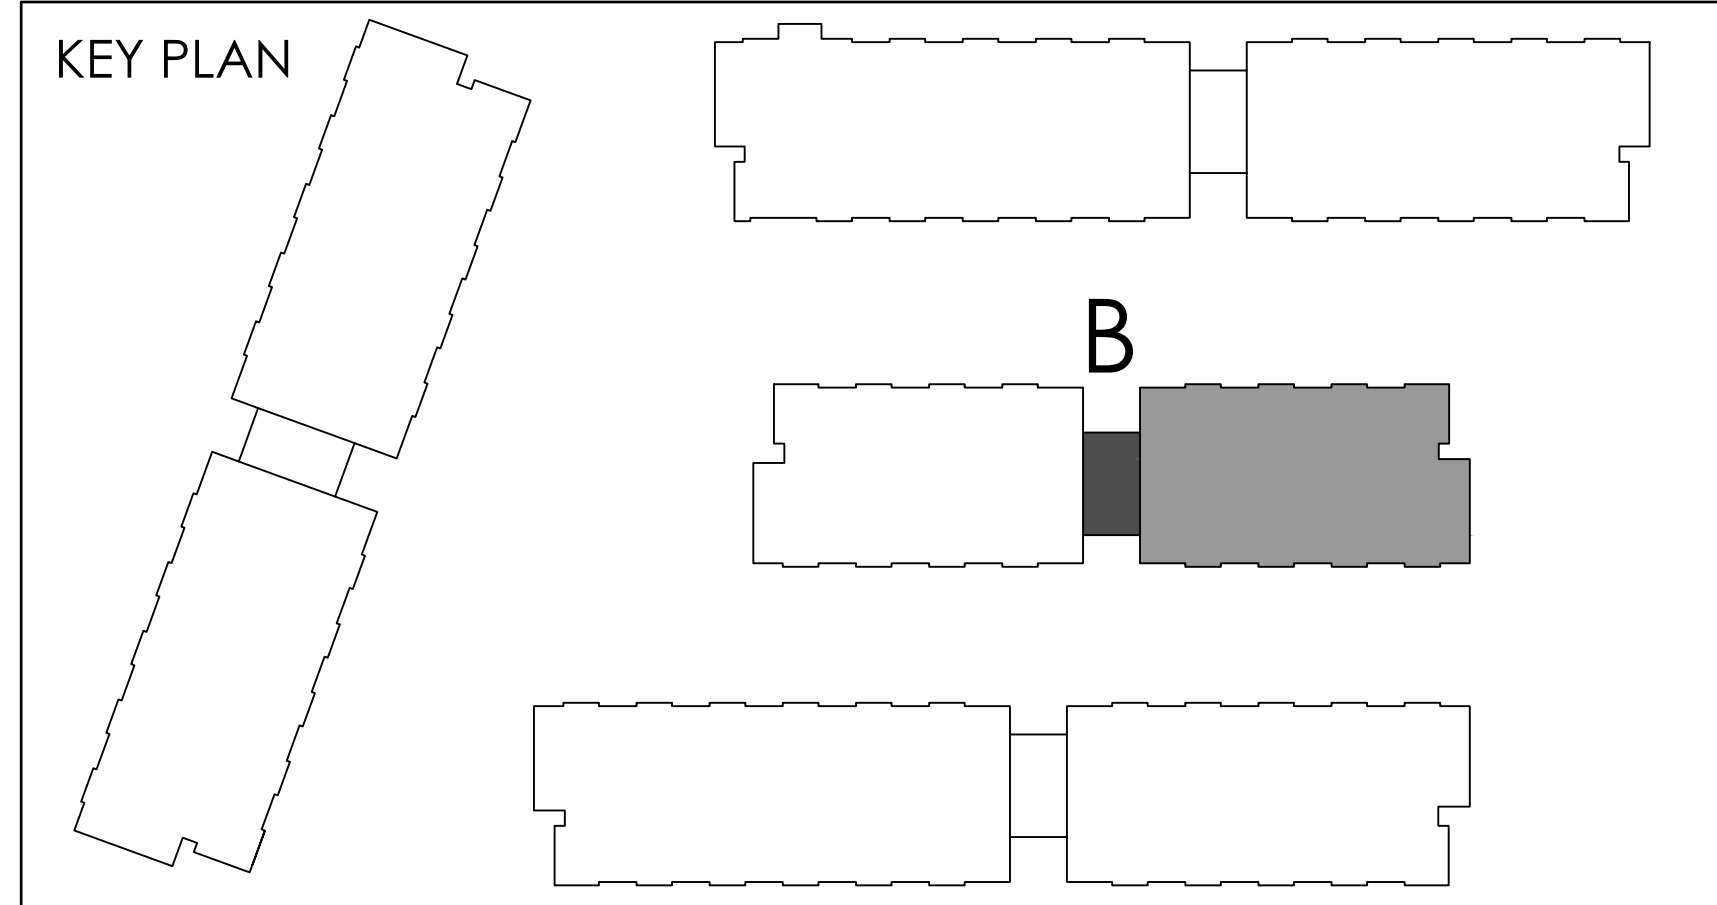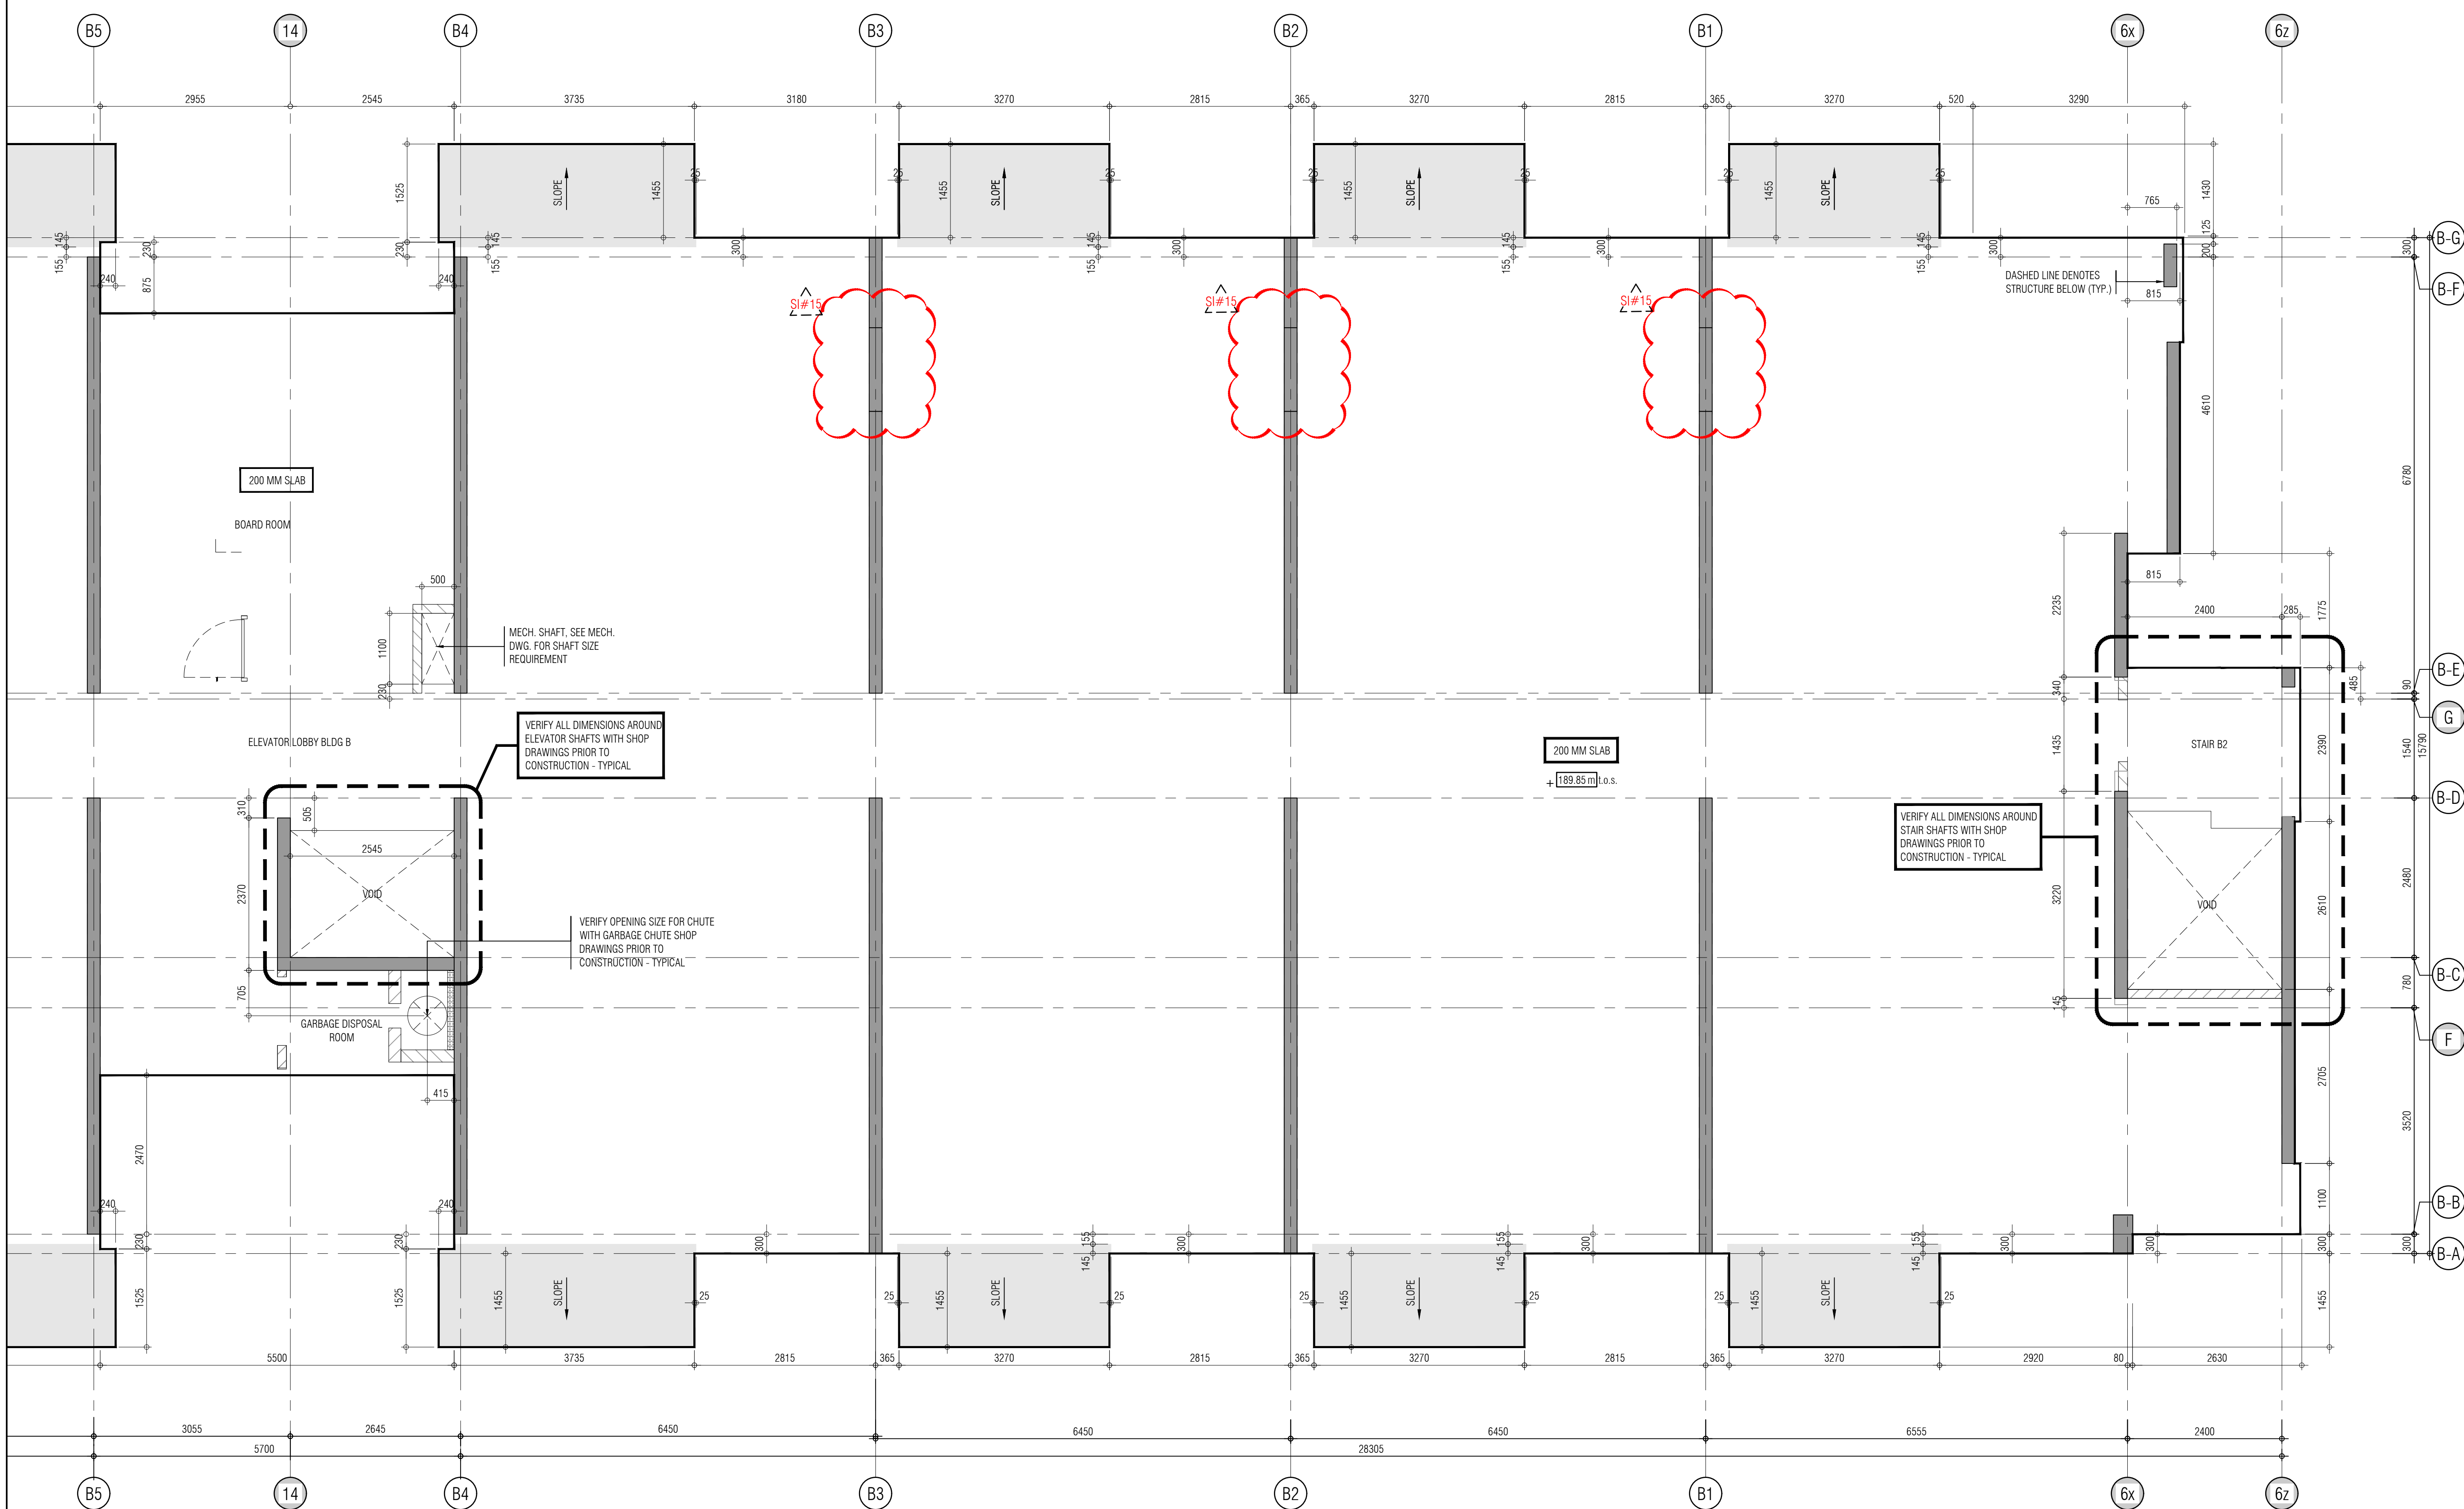

THIS DRAWING IS AN INSTRUMENT OF SERVICE, IT IS PROVIDED BY AND IS THE PROPERTY OF GRAZIANI-CORAZZANI ARCHITECTS INC. THE CONTRACTOR MUST REPLY AND ACCEPT RESPONSIBILITY FOR ALL DIMENSIONS AND COORDINATE THE SITE AND MUST VERIFY GRAZIANI-CORAZZANI ARCHITECTS INC. OF ANY VARIATIONS FROM THE SUPPLIED INFORMATION. GRAZIANI-CORAZZANI ARCHITECTS INC. IS NOT RESPONSIBLE FOR THE ACCURACY OF SURVEY, STRUCTURAL, MECHANICAL, ELECTRICAL AND OTHER ENGINEERING INFORMATION SHOWN ON THIS DRAWING. REFER TO THE APPROPRIATE ENGINEERING DRAWINGS BEFORE PROCEEDING WITH THE WORK. CONSTRUCTION MUST COMPLY TO ALL APPLICABLE CODES AND REQUIREMENTS OF THE AUTHORITIES HAVING JURISDICTION, UNLESS OTHERWISE NOTED. NO MODIFICATION AND/OR ADDITIONS OR DELETIONS BY THIS OFFICE IN REGARDS TO THE ENVIRONMENTAL CONDITION OF THIS SITE.

THIS DRAWING IS NOT TO BE SCALED. ALL ARCHITECTURAL SYMBOLS INDICATED ON THIS DRAWING ARE GRAPHIC REPRESENTATIONS ONLY.

CONDITIONS FOR ELECTRONIC INFORMATION TRANSFER:

ELECTRONIC INFORMATION IS SUPPLIED TO THE OTHER ASSOCIATED FIRMS TO ASSIST THEM IN THE EXECUTION OF THEIR WORK. REVIEW THE RECEIVED FIRMS MUST DETERMINE THE COMPLETENESS, APPROPRIATENESS, RELIANCE OF THE INFORMATION IN RESPECT TO THEIR PARTICULAR RESPONSIBILITY.

GRAZIANI-CORAZZANI ARCHITECTS INC. SHALL NOT BE RESPONSIBLE FOR ERRORS, OMISSIONS, INCOMPLETENESS DUE TO LOSS OF INFORMATION IN WHICH OR PART OF INFORMATION IS TRANSMITTED.

1. TRANSMISSION OF ANY LOSS OF DAMAGE TO THE RECEIVING ELECTRONIC SYSTEM WHEN INFORMATION IS TRANSMITTED.

- 01. Oct.07.2019 issued for tender
- 02. Mar.13.2020 issued for design coordination #2
- 03. Mar.16.2020 issued for addendum #2
- 04. Mar.16.2020 issued for addendum #3
- 05. Aug.24.2020 issued for addendum #4
- 06. Sept.28.2020 issued for permit
- 07. Oct.20.2020 issued for addendum #5
- 08. Nov.23.2020 issued for addendum #6
- 09. Dec.14.2020 issued for addendum #7
- 10. Jan.18.2021 issued for addendum #8
- 11. Mar.2.2021 issued for permit
- 12. Mar.09.2021 issued for addendum #9
- 13. Mar.10.2021 issued for addendum #9R
- 14. Mar.26.2021 issued for progress
- 15. May.14.2021 issued for Site Instruction #1
- 16. June.15.2021 issued for Site Instruction #2
- 17. July.7.2021 re-issued for permit
- 18. July.15.2021 issued for Site Instruction #3
- 19. July.27.2021 issued for Site Instruction #4
- 20. Aug.3.2021 issued for Site Instruction #5
- 21. Aug.18.2021 issued for Site Instruction #6
- 22. Aug.20.2021 Re-issued for permit
- 23. Sept.07.2021 issued for Site Instruction #7
- 24. Sept.09.2021 issued for Site Instruction #8
- 25. Sept.16.2021 issued for Building D Permit Revisions
- 26. Sept.22.2021 issued for Site Instruction #9
- 27. Oct.6.2021 Re-issued for permit
- 28. Oct.8.2021 issued for Site Instruction #10
- 30. Oct.28.2021 issued for Site Instruction #11
- 31. Nov.05.2021 issued for Site Instruction #12
- 32. Dec.3.2021 issued for Site Instruction #13
- 33. Dec.6.2021 issued for Site Instruction #14
- 34. Dec.7.2021 issued for Site Instruction #15

01. SEP.18.2021 issued for addendum 1

issued for revisions



RESIDENTIAL

ATTMIR + PALLESCHI DRIVE

BRAMPTON ONTARIO

PROJECT ARCHITECT: B. GRAZIANI

ASSISTANT DESIGNER: R. LINCOLN

DRAWN BY: G. C./F. C./M. B.

CHECKED BY: D. BIASSE/G. COLANGELO

PLANT DATE: DEC.07.2021

JOB # 1331.15

CONCRETE SLAB EDGE 2ND FLOOR PLAN

BUILDING B (PARTIAL PLAN)

1:50 CS302b2

TITLE BLOCK SIZE: 915 x 1200

THIS DRAWING IS AN INSTRUMENT OF SERVICE. IT IS PROVIDED BY AND IS THE PROPERTY OF GRAZIANI CORAZZA ARCHITECTS INC. THE CONTRACTOR MUST STAFF AND ACCEPT RESPONSIBILITY FOR ALL DIMENSIONS AND COORDINATE THE SITE AND MUST NOTIFY GRAZIANI CORAZZA ARCHITECTS INC. OF ANY VARIATIONS FROM THE SUPPLIED INFORMATION. GRAZIANI CORAZZA ARCHITECTS INC. IS NOT RESPONSIBLE FOR THE ACCURACY OF SURVEY, STRUCTURAL, MECHANICAL, ELECTRICAL AND OTHER ENGINEERING INFORMATION SHOWN ON THIS DRAWING. REFER TO THE APPROPRIATE ENGINEERING DRAWINGS BEFORE PROCEEDING WITH THE WORK. CONSTRUCTION MUST COMPLY TO ALL APPLICABLE CODES AND REQUIREMENTS OF THE AUTHORITIES HAVING JURISDICTION. UNLESS OTHERWISE NOTED, NO INVESTIGATION HAS BEEN UNDERTAKEN OR REPORTED IN BY THIS OFFICE IN REGARD TO THE ENVIRONMENTAL CONDITION OF THIS SITE.

THIS DRAWING IS NOT TO BE SCALED. ALL ARCHITECTURAL SYMBOLS INDICATED ON THIS DRAWING ARE GRAPHIC REPRESENTATIONS ONLY.


CONDITIONS FOR ELECTRONIC INFORMATION TRANSFER:

ELECTRONIC INFORMATION IS SUPPLIED TO THE OTHER ASSOCIATED FIRMS TO ASSIST THEM IN THE EXECUTION OF THEIR WORK. REVIEW THE RECEIVED FIRMS MUST DETERMINE THE COMPLETENESS, APPROPRIATENESS, RELIANCE OF THE INFORMATION IN RESPECT TO THEIR PARTICULAR RESPONSIBILITY.

GRAZIANI CORAZZA ARCHITECTS INC. SHALL NOT BE RESPONSIBLE FOR ERRORS, OMISSIONS, INCOMPLETENESS DUE TO LOSS OF INFORMATION IN WHOLE OR PART WHEN INFORMATION IS TRANSMITTED.

1. TRANSMISSION OF ANY LOSS OF DAMAGE TO THE RECEIVING ELECTRONIC SYSTEM WHEN INFORMATION IS TRANSMITTED.

REF.A30242 FOR CONTINUATION

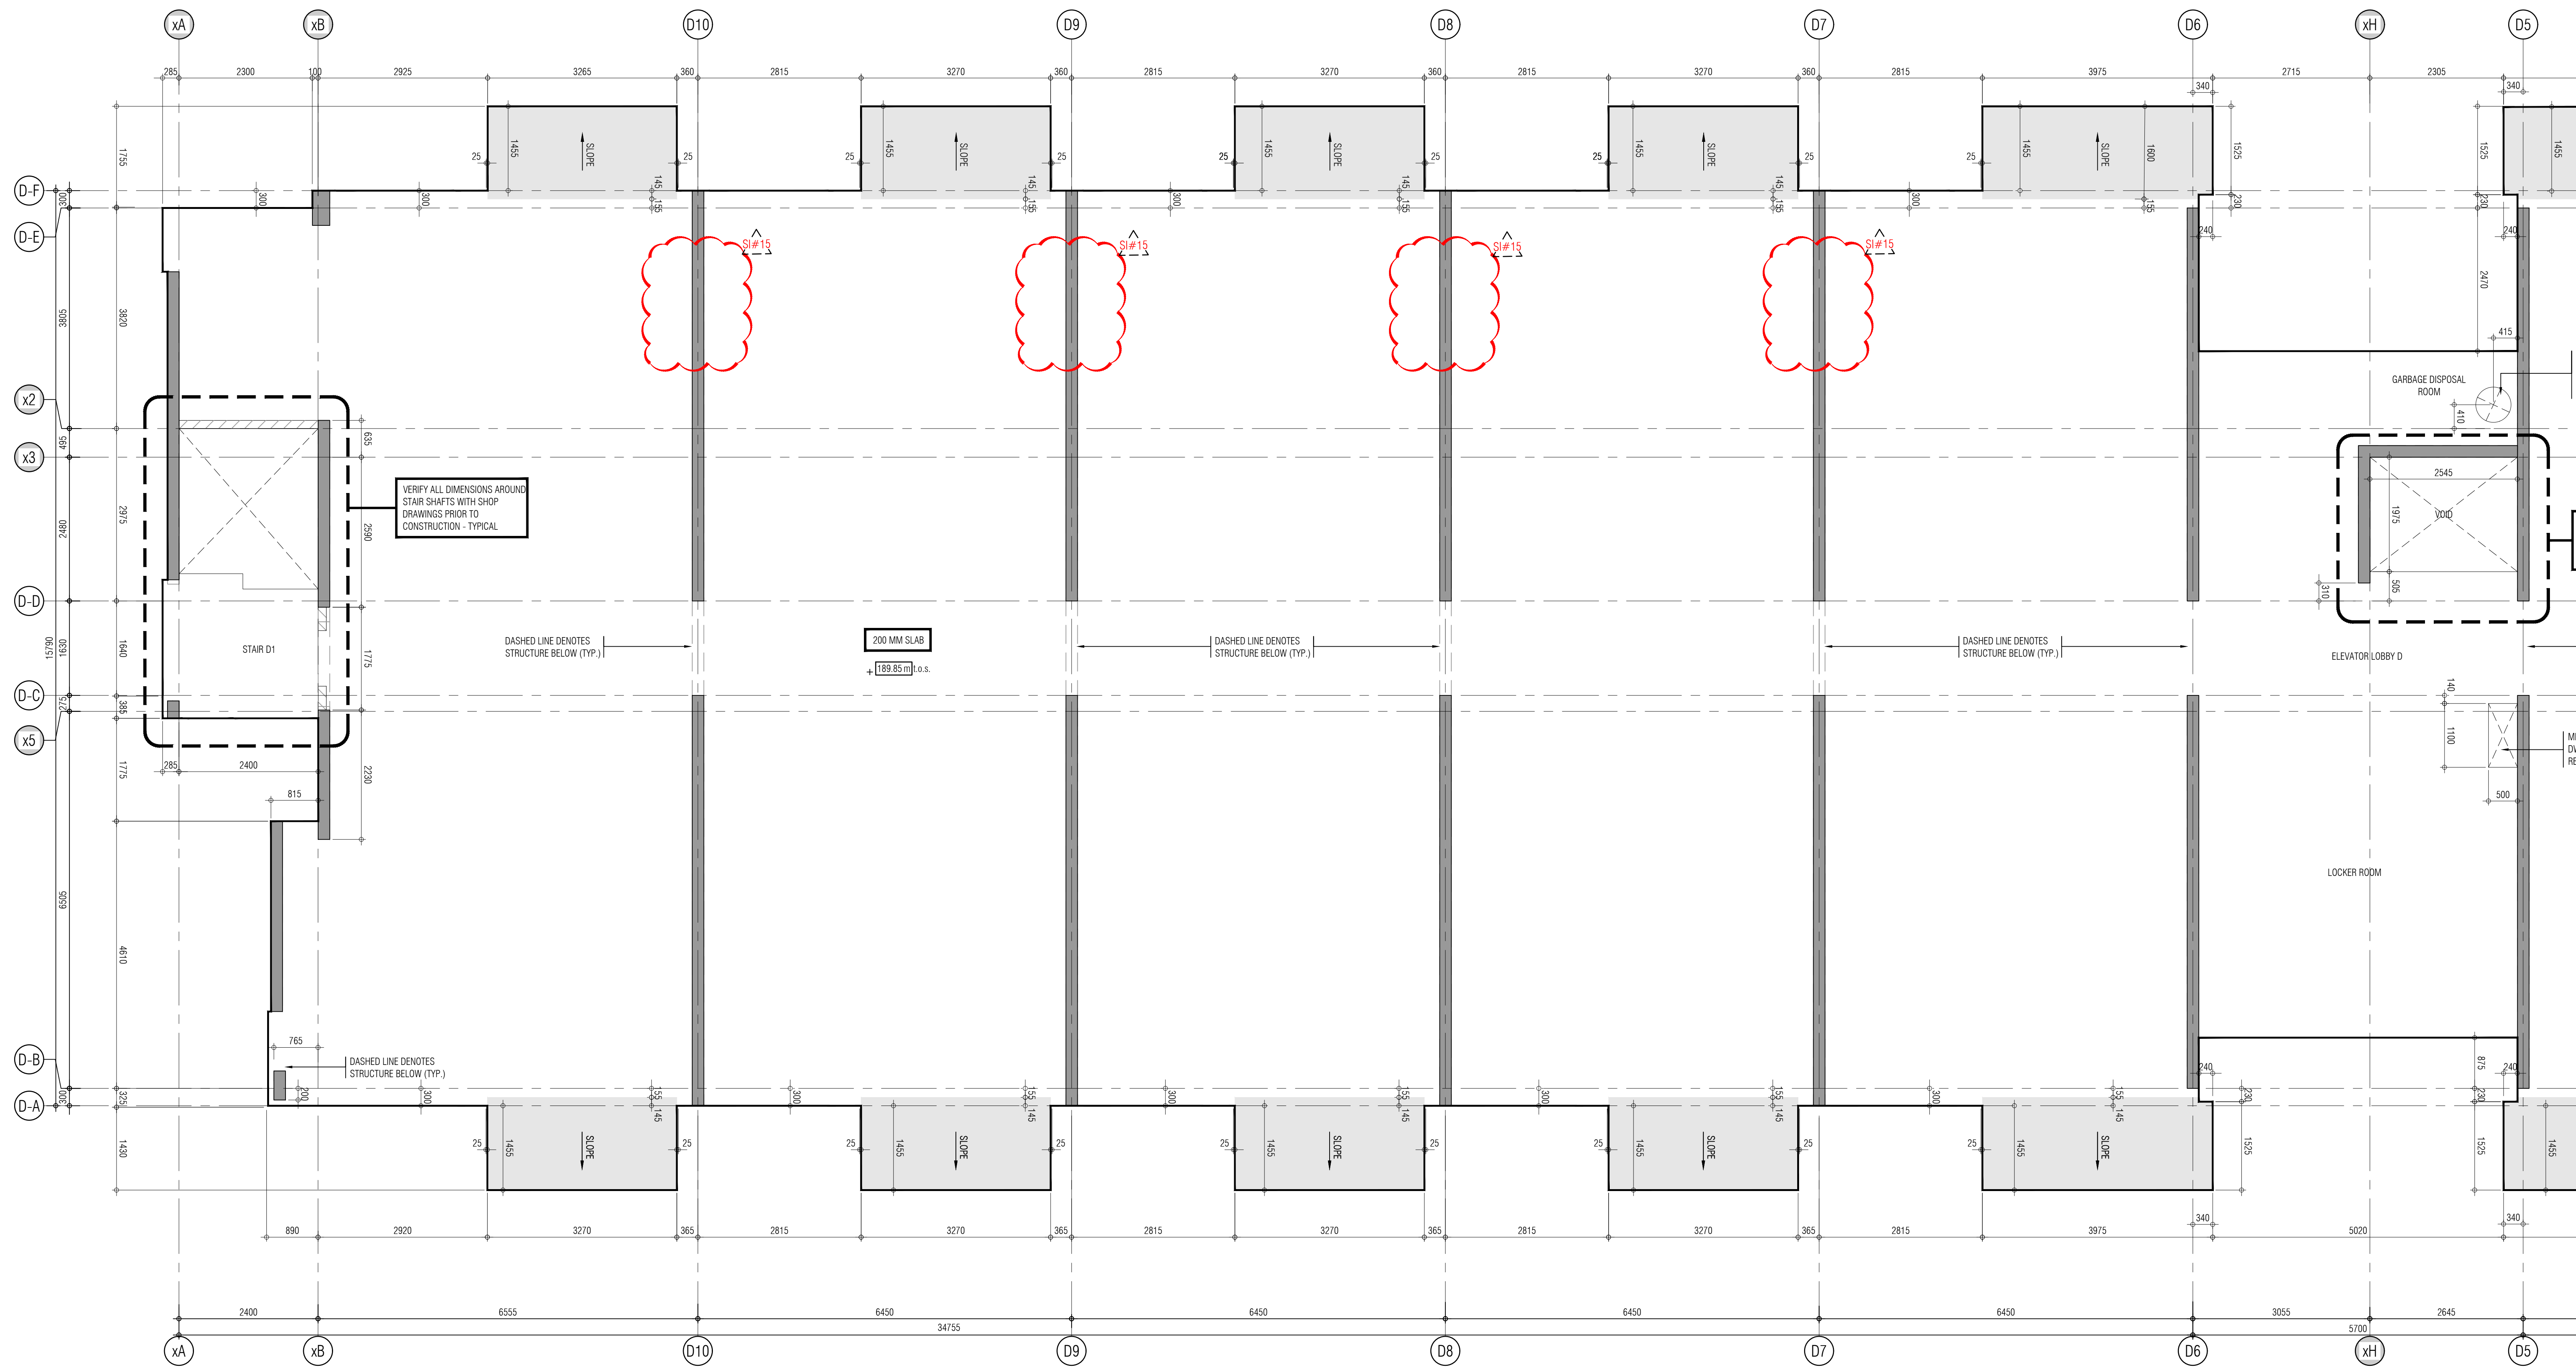

- 01. Oct.07.2019 issued for tender
- 02. Mar.13.2020 issued for design coordination #2
- 03. Mar.16.2020 issued for addendum #2
- 04. Mar.16.2020 issued for addendum #3
- 05. Aug.24.2020 issued for addendum #4
- 06. Sept.28.2020 issued for permit
- 07. Oct.20.2020 issued for addendum #5
- 08. Nov.23.2020 issued for addendum #6
- 09. Dec.14.2020 issued for addendum #7
- 10. Jan.15.2021 issued for addendum #8
- 11. Mar.2.2021 issued for permit
- 12. Mar.09.2021 issued for addendum #9
- 13. Mar.10.2021 issued for addendum #9R
- 14. Mar.26.2021 issued for progress
- 15. May.14.2021 issued for Site Instruction #1
- 16. June.15.2021 issued for Site Instruction #2
- 17. July.7.2021 re-issued for permit
- 18. July.15.2021 issued for Site Instruction #3
- 19. July.27.2021 issued for Site Instruction #4
- 20. Aug.3.2021 issued for Site Instruction #5
- 21. Aug.18.2021 issued for Site Instruction #6
- 22. Aug.20.2021 Re-issued for permit
- 23. Sept.07.2021 issued for Site Instruction #7
- 24. Sept.09.2021 issued for Site Instruction #8
- 25. Sept.16.2021 issued for Building D Permit Revisions
- 26. Sept.22.2021 issued for Site Instruction #9
- 27. Oct.6.2021 Re-issued for permit
- 28. Oct.8.2021 issued for Site Instruction #10
- 30. Oct.28.2021 issued for Site Instruction #11
- 31. Nov.05.2021 issued for Site Instruction #12
- 32. Dec.3.2021 issued for Site Instruction #13
- 33. Dec.6.2021 issued for Site Instruction #14
- 34. Dec.7.2021 issued for Site Instruction #15

01. SEP.18.2021 issued for addendum 1

issued for revisions

GRAZIANI CORAZZA ARCHITECTS

1100 SHAWNEE DRIVE, SUITE 100 MISSISSAUGA, ONTARIO L4W 1C3
905.760.2001 P.905.760.2000 WWW.GC-ARCHITECTS.COM

ATTMOR + PALLESCHI DRIVE


BRAMPTON ONTARIO

PROJECT ARCHITECT: B. GRAZIANI
ASSISTANT DESIGNER: R. LINCOLN
DRAWN BY: G.C./F.C./M.B.
CHECKED BY: D. BIASE/G. COLANGELO
PLOT DATE: DEC.07.2021
JOB #: 1331.15

**CONCRETE SLAB EDGE 2ND FLOOR PLAN
BUILDING D (PARTIAL PLAN)**

1:50 CS302d1

TITLE BLOCK SIZE: 915 x 1200

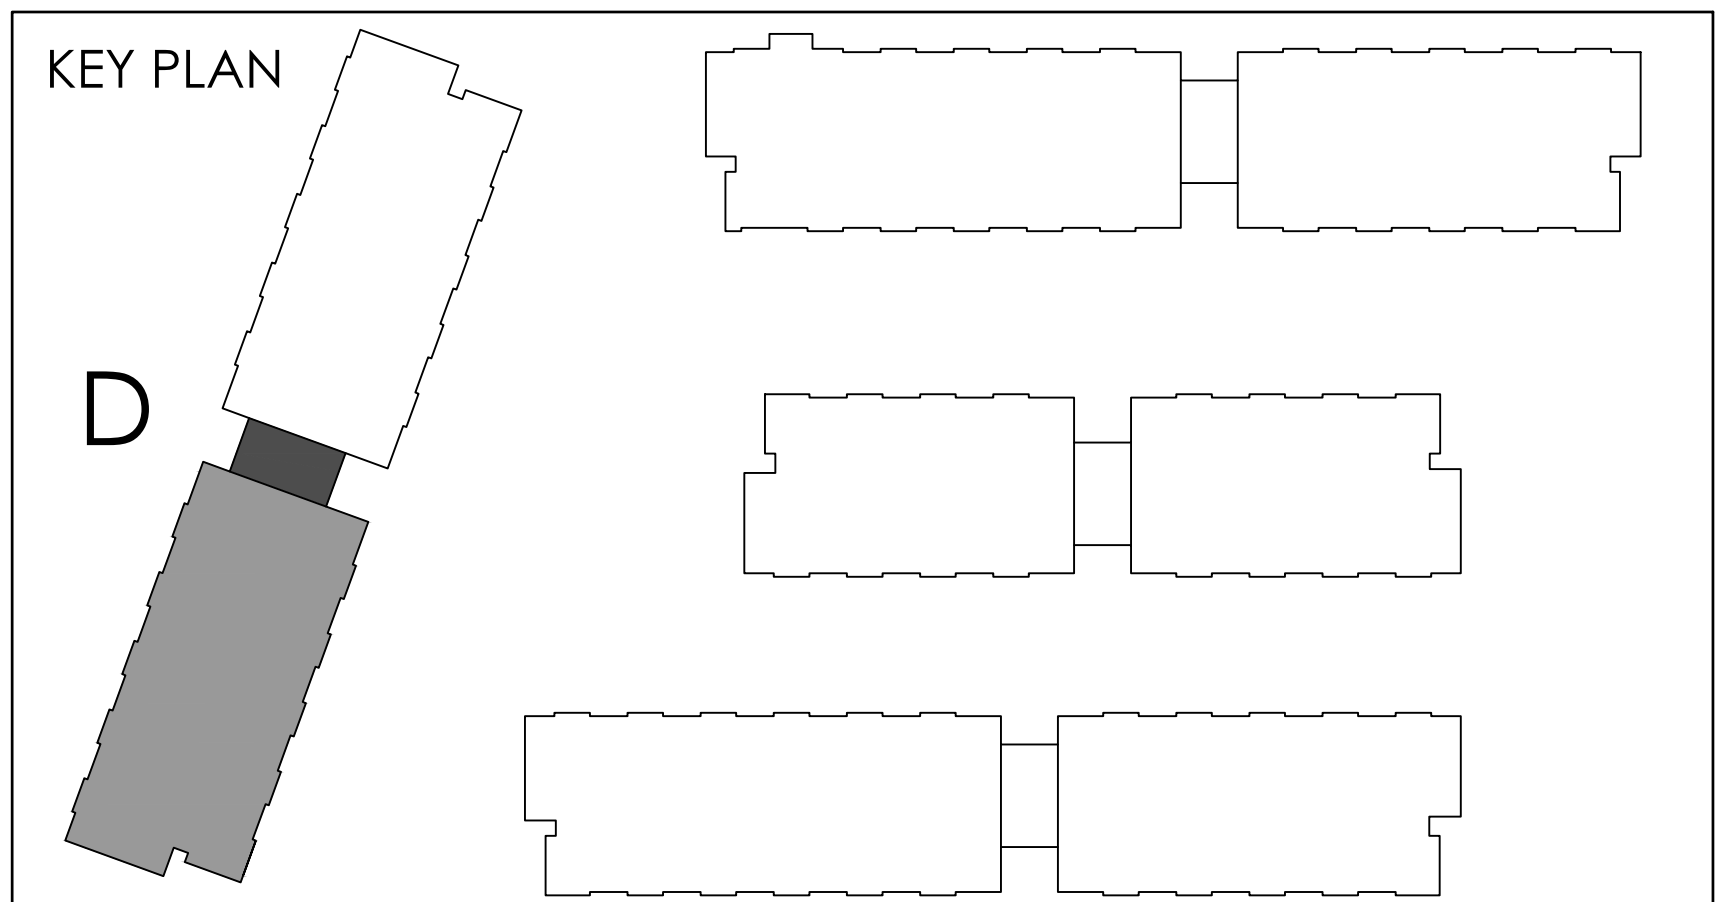

THIS DRAWING IS AN INSTRUMENT OF SERVICE, IT IS PROVIDED BY AND IS THE PROPERTY OF GRAZIANI-CORAZZA ARCHITECTS INC. THE CONTRACTOR MUST STAFF AND ACCEPT RESPONSIBILITY FOR ALL DIMENSIONS AND COORDINATE THE SITE AND MUST NOTIFY GRAZIANI-CORAZZA ARCHITECTS INC. OF ANY VARIATIONS FROM THE SUPPLIED INFORMATION. GRAZIANI-CORAZZA ARCHITECTS INC. IS NOT RESPONSIBLE FOR THE ACCURACY OF SURVEY, STRUCTURAL, MECHANICAL, ELECTRICAL AND OTHER ENGINEERING INFORMATION SHOWN ON THE DRAWING. REFER TO THE APPROPRIATE ENGINEERING DRAWINGS BEFORE PROCEEDING WITH THE WORK. CONSTRUCTION MUST COMPLY TO ALL APPLICABLE CODES AND REQUIREMENTS OF THE AUTHORITIES HAVING JURISDICTION, UNLESS OTHERWISE NOTED. NO MODIFICATION HAS BEEN UNDERTAKEN OR REPORTED IN BY THIS OFFICE IN REGARDS TO THE ENVIRONMENTAL CONDITION OF THIS SITE.

THIS DRAWING IS NOT TO BE SCALED. ALL ARCHITECTURAL DIMENSIONS INDICATED ON THIS DRAWING ARE GRAPHIC REPRESENTATIONS ONLY.

CONDITIONS FOR ELECTRONIC INFORMATION TRANSFER:


ELECTRONIC INFORMATION IS SUPPLIED TO THE OTHER ASSOCIATED FIRMS TO ASSIST THEM IN THE EXECUTION OF THEIR WORK. REVIEW THE RECEIVED FIRMS MUST DETERMINE THE COMPLETENESS, APPROPRIATENESS, RELIANCE OF THE INFORMATION IN RESPECT TO THEIR PARTICULAR RESPONSIBILITY.

GRAZIANI-CORAZZA ARCHITECTS INC. SHALL NOT BE RESPONSIBLE FOR ERRORS, OMISSIONS, INCOMPLETENESS DUE TO LOSS OF INFORMATION IN WHOLE OR PART WHEN INFORMATION IS TRANSFERRED.

1. TRANSMISSION OF ANY LOSS OF DAMAGE TO THE RECEIVING ELECTRONIC SYSTEM WHEN INFORMATION IS TRANSFERRED.

01. Oct.07.2019 issued for tender —
02. Mar.13.2020 issued for design coordination #2 —
03. Mar.16.2020 issued for addendum #2 —
04. Mar.16.2020 issued for addendum #3 —
05. Aug.24.2020 issued for addendum #4 —
06. Sept.28.2020 issued for permit bq
07. Oct.20.2020 issued for addendum #5 —
08. Nov.23.2020 issued for addendum #6 —
09. Dec.14.2020 issued for addendum #7 —
10. Jan.15.2021 issued for addendum #8 —
11. Mar.2.2021 issued for permit bq
12. Mar.09.2021 issued for addendum #9 —
13. Mar.10.2021 issued for addendum #9R —
14. Mar.26.2021 issued for progress —
15. May.14.2021 issued for Site Instruction #1 —
16. June.15.2021 issued for Site Instruction #2 —
17. July.7.2021 re-issued for permit bq
18. July.15.2021 issued for Site Instruction #3 bq
19. July.27.2021 issued for Site Instruction #4 bq
20. Aug.3.2021 issued for Site Instruction #5 bq
21. Aug.18.2021 issued for Site Instruction #6 bq
22. Aug.20.2021 Re-issued for permit. bq
23. Sept.07.2021 issued for Site Instruction #7 bq
24. Sept.09.2021 issued for Site Instruction #8 bq
25. Sept.16.2021 issued for Building D Permit Revisions bq
26. Sept.22.2021 issued for Site Instruction #9 bq
27. Oct.6.2021 Re-issued for permit. bq
28. Oct.8.2021 issued for Site Instruction #10 bq
30. Oct.28.2021 issued for Site Instruction #11 bq
31. Nov.05.2021 issued for Site Instruction #12 bq
32. Dec.3.2021 issued for Site Instruction #13 bq
33. Dec.6.2021 issued for Site Instruction #14 bq
34. Dec.7.2021 issued for Site Instruction #15 bq

01. SEP.18.2021 issued for addendum 1 bq
- issued for revisions

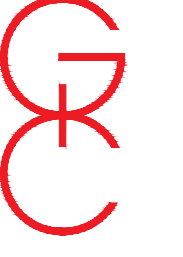

**GRAZIANI
CORAZZA
ARCHITECTS**

1120 SHARONDAVE DRIVE, SUITE 100 MISSISSAUGA, ONTARIO L4W 1C3
905.709.7201 P.905.709.7200 WWW.GC-ARCHITECTS.COM

RESIDENTIAL



ATTMAR + PALLESCHI DRIVE

BRAMPTON ONTARIO

PROJECT ARCHITECT: B. GRAZIANI
ASSISTANT DESIGNER: R. LINCOLN
DRAWN BY: G. C./F. C./M. B.
CHECKED BY: D. MIASE/G. COLANGELO
PLOT DATE: DEC.07.2021
JOB #: 1331.15

**CONCRETE SLAB EDGE 2ND FLOOR PLAN
BUILDING D (PARTIAL PLAN)**

1:50

CS302d2

TITLE BLOCK SIZE: 915 x 1200

REF.A302d1 FOR CONTINUATION

