GRAZIANI + CORAZZA ARCHITECTS INC.

SITE INSTRUCTION

Forestside Estates
Attmar & Palleschi Drive
Brampton, Ontario
Attn: **Vince Staffieri**

SI A14

PROJECT : **Forestside**
PROJECT # : 1331.15
DATE : Dec. 06, 2021

Site instructions/memos and Addendums are issued only for the purpose of recording any clarification or interpretation of the contract documents or giving direction on problems resulting from field conditions. These memos are subject to the provisions of the contract documents and unless reviewed with and authorized by the Client, will not affect the contract. Should the Contractor require a change in the contract price or project schedule, he shall submit to the Client, prior to commencement of work outlined in this memo, an itemized proposal for approval.

Title: Revisions to plans as itemized.

Reference:		Changes:
A102	Wall Schedule	• Update WW-F and WW-C wall type to show spray foam insulation.
CS301-OS & a1 CS302c1, c2	1st Floor Slab Edge 2nd Floor Slab Edge	• Update drain locations as per latest mechanical drawings. • Update poured conc. stairs, walls, and landing from second unit above at ramp.
A301's A302's, A303's A304's, A305's	1st Floor to 4th Floor and Roof Plans.	• Update poured conc. stairs, walls, and landing from second unit 239 above at ramp. Add nib wall at landing and relocate security panel. • Indicate new section markers 2/A502 and 3/A505 at link building C. • Indicate new section markers 2/A506 at stairs from second floor unit 239 at ramp in building C. • Add all Wall Section markers to floor plans. • Updated roof drain locations.
A403, A403c1, A403c3	Elevation Building C	• Update number of steps and spot elevations of steps, and landing from second floor unit to grade and from storage room to grade.
2/A501	Building Section	• Flipped section to match plan section marker view. • Revise window wall tags and move wall section back to original location.
3/501	Building Section	• Indicate PW2 wall tag to fourth floor.
4/501	Building Section	• Revise window wall tag.
1-2/502	Building Section	• Indicate and Updated stairs from second floor unit above at ramp to poured concrete walls and stairs with insulation and revise spot elevations. • Updated section views of walls, railings of unit and stairs beyond. • Updated grid tag indications. • Revised window wall tag.
2/A503	Building Section	• Show roof access hatch and ladder beyond. • Add top of concrete wall spot elevation at elevator parapet walls. • Update wall tags at elevator walls. • Rotated Grid tags.

GRAZIANI + CORAZZA ARCHITECTS INC.

1/A504	Building Sections	• Add wall tags at suite and elevator walls. • Add wall tags at stair and suite walls.
1a/A504	Building Sections	• Show spray foam insulation at ext. walls. • Add wall tags at stair and suite walls. • Update window wall.
1/505	Building Sections	• Updated exterior walls and tags. • Updated exterior wall at link and suite revised wall tags.
3/A505	Building Sections	• Updated exterior wall tags at link building. Revised mechanical room to void space.
3/A506	Building Section	• New building section 3/A506 at stairs from second floor unit 239 at ramp in building C.
A601	Wall Sections	• Updated exterior wall tags. • Updated Grid tag indications. • Added Firestop Note.
A602	Wall Sections	• Flipped section 4/A602 to match plan section marker view. • Updated exterior wall tags. • Updated Grid tag indications • Added Firestop Note.
A603	Wall Sections	• Updated exterior wall tags. • Updated Grid tag indications. • Added Firestop note.
A604	Wall Sections	• Updated exterior wall tags. • Added Firestop Note.

Reason: Revisions to plans of parapet heights, walls, stairs as per structural and window shop drawing coordination at front lobby walls.

GRAZIANI + CORAZZA
ARCHITECTS INC

D. Biase C.E.T.
Principal

GRAZIANI + CORAZZA ARCHITECTS INC.

Distribution:

Royal Pine Homes	Vince Staffieri Cinzia Caruzo	vince@royalpinehomes.com Cinzia@royalpinehomes.com
Jablonski Engineering	Kevin Deonaraine	kdeonaraine@astint.on.ca
United Engineering	Rene Cuales Leonard Matthews Susan Pan Mark Giorgi	rene@u-eng.ca Lenard@u-eng.ca susan@u-eng.ca mark@u-eng.ca
Candevcon Limited	Diarmund Hogan Dudister Damnaraign	dhorgan@candevcon.com dude@candevcon.com
Starfire Sprinkler Systems	Elite Novosselova Peter Adrian	elitecanada@hotmail.com Peter@starfiresystems.biz
Strybos Barron King Ltd.	Bryn Barron Kaleigh Gills Sydney Martel	bbarron@strybos.com kgillis@strybos.com smartel@strybos.com
Graziani + Corazza Architects	Domenic Biase Gino Colangelo Fernando Croatto	dbiase@gc-architects.com gcolangelo@gc-architects.com FCroatto@gc-architects.com

EXTERIOR WALL SCHEDULE

WALL #	MATERIALS	FRR
WW	WINDOW WALL VISION WINDOW WALL FRAMING SYSTEM INSULATED GLAZING UNIT 150	
WWS	WINDOW WALL SPANDREL WINDOW WALL FRAMING SYSTEM SPANDREL GLASS PANEL WITH 75mm MINERAL WOOL INSULATION (R12.6) METAL LINER BACKPAN (AIR/VAPOUR BARRIER) 150	
WWM	WINDOW WALL METAL PANEL WINDOW WALL FRAMING SYSTEM FLUSH METAL PANEL WITH 75mm MINERAL WOOL INSULATION (R12.6) METAL LINER BACKPAN (AIR/VAPOUR BARRIER) 150	
WW-F	WINDOW WALL - FRAME BACKUP WINDOW WALL FRAMING SYSTEM SPANDREL GLASS PANEL WITH 75mm SPRAY FORM INSULATION (R12.6) METAL LINER BACKPAN (AIR/VAPOUR BARRIER) 25mm SEMI-RIGID INSULATION (R4.2) 64/92mm METAL STUD @ 400 O.C. 12.7mm GYPSUM BOARD (SECOND AIR BARRIER) TYP. 250 280 64mm 92mm	
WW-C	WINDOW WALL - CONCRETE BACKUP WINDOW WALL FRAMING SYSTEM SPANDREL GLASS PANEL WITH 75mm MINERAL WOOL INSULATION (R12.6) METAL LINER BACKPAN (AIR/VAPOUR BARRIER) AIR SPACE STRUCTURAL CONCRETE WALL (SEE STRUCTURAL DRAWINGS) VARIES	
BR-F	BRICK - FRAME BACKUP 90mm FACEBRICK (REFER TO ELEVATION FOR COLOUR) WITH GALVANIZED METAL TIES W/ ADJUSTABLE HOOKS AT 400 O.C. HORIZ. 600 O.C. VERT. 25mm AIRSPACE 25mm - 2lb DENSITY SPRAY FOAM (R6) AIR BARRIER MEMBRANE 12.7mm EXTERIOR GRADE SHEATHING 152mm METAL STUD @ 400 O.C. WITH 90mm SPRAY FORM INSULATION (R18) 12.7mm GYPSUM BOARD 320	
BR-C	BRICK - CONCRETE BACKUP 90mm FACEBRICK (REFER TO ELEVATION FOR COLOUR) WITH GALVANIZED METAL TIES AT 400 O.C. HORIZ. 600 O.C. VERT. 25mm AIRSPACE 25mm/100mm - 2LB DENSITY SPRAY FOAM (R24) (AIR/VAPOUR BARRIER) (REFER TO PLANS) STRUCTURAL CONCRETE WALL (SEE STRUCTURAL DRAWINGS) VARIES	
SN-F	STONE - FRAME BACKUP 90mm STONE VENEER (REFER TO ELEVATION FOR COLOUR) WITH GALVANIZED METAL TIES AT 400 O.C. HORIZ. 600 O.C. VERT. 25mm AIRSPACE 25MM - 2LB DENSITY SPRAY FOAM (R6) AIR BARRIER MEMBRANE 12.7MM EXTERIOR GRADE SHEATHING 152mm METAL STUD @ 400 O.C. WITH 90MM SPRAY FORM INSULATION (R17) 12.7mm GYPSUM BOARD 320	
SN-C	STONE - CONCRETE BACKUP 90mm STONE VENEER (REFER TO ELEVATION FOR COLOUR) WITH GALVANIZED METAL TIES AT 406 O.C. HORIZ. 600 O.C. VERT. 25MM AIRSPACE 100MM - 2LB DENSITY SPRAY FOAM (R24) (AIR/VAPOUR BARRIER) STRUCTURAL CONCRETE WALL (SEE STRUCTURAL DRAWINGS) VARIES	
BR-B	BRICK - BLOCK BACKUP 90mm FACEBRICK (REFER TO ELEVATION FOR COLOUR) WITH GALVANIZED METAL TIES AT 400 O.C. HORIZ. 600 O.C. VERT. 25mm AIRSPACE AIR/VAPOUR BARRIER MEMBRANE CONCRETE BLOCK (SIZE VARIES) VARIES	
BL-C	BLOCK - CONCRETE BACKUP 90mm FACEBLOCK (REFER TOBUIDERS SPECS) WITH GALVANIZED METAL TIES AT 400 O.C. HORIZ. 600 O.C. VERT. 25MM AIRSPACE 100MM - 2LB DENSITY SPRAY FOAM (R24) (AIR/VAPOUR BARRIER) STRUCTURAL CONCRETE WALL (SEE STRUCTURAL DRAWINGS) VARIES	
SD-B	BRICK - BLOCK BACKUP METAL SIDING (AS PER BUILDERS SPECS 40MM 18 GA. Z-GIRTS (VERTICAL) @600 O.C. WITH 38MM RIGID INSULATION (RSI 1.2, R7) AIR/VAPOUR BARRIER MEMBRANE CONCRETE BLOCK (SIZE VARIES) VARIES	

SI-14

ROOF TYPE SCHEDULE

ROOF #	MATERIALS		FRR
R1	ROOF (PROTECTED MEMBRANE) GRAVEL OR STONE BALLAST PERMEABLE FILTER FABRIC 100mm XPS RIGID INSULATION (R20) MEMBRANE SYSTEM C/W PROTECTION BOARD ON CONCRETE SLAB (MEMBRANE CONTINUOUS UP INTO WALL REGLET WITH METAL FLASHING COVER AND CAULKING)	VARIES	
R2	ROOF TERRACE (TYPICAL) PRECAST CONCRETE PAVERS BEDDING SUBSTRATE PERMEABLE FILTER FABRIC 100mm XPS RIGID INSULATION (R20) MEMBRANE SYSTEM C/W PROTECTION BOARD ON CONCRETE SLAB (MEMBRANE CONTINUOUS UP INTO WALL REGLET WITH METAL FLASHING COVER AND CAULKING)	VARIES	

FLOOR TYPE SCHEDULE

FLOOR #	MATERIALS		FRR	STC
FL1	OBC SB-2 (REINFORCED CONCRETE FLOORS/ROOFS) TABLE 2.2.1.A + 2.2.1.B. 200mm MIN. POURED CONCRETE (REFER TO STRUCTURAL DRAWINGS)	VARIES	1H & 2H	xx REF: NRC xxxxx

STUD PARTITION SCHEDULE

WALL #	MATERIALS		FRR	STC
PS1	12.7mm GYPSUM BOARD 41mm METAL STUD @ 400 O.C. 12.7mm GYPSUM BOARD	70		
PS1A	12.7mm GYPSUM BOARD 41mm METAL STUD @ 400 O.C. 12.7mm ABUSE RESISTANT GYPSUM BOARD	70		
PS1G	12.7mm GYPSUM BOARD 41mm METAL STUD @ 400 O.C. 12.7mm MOISTURE RESISTANT GYPSUM BOARD (DENS SHIELD OR EQUAL)	70		
PS1S	12.7mm GYPSUM BOARD 41mm METAL STUD @ 400 O.C. WITH 38mm BATT INSULATION 12.7mm GYPSUM BOARD	70		
PS1X	ULC DESIGN NO. W453 2 LAYERS 15.9mm TYPE X GYPSUM BOARD 41mm METAL STUD @ 600 O.C. 2 LAYERS 15.9mm TYPE X GYPSUM BOARD	105	2H	
PS1SX	ULC DESIGN NO. W453 2 LAYERS 15.9mm TYPE X GYPSUM BOARD 41mm METAL STUD @ 600 O.C. WITH 38mm BATT INSULATION 2 LAYERS 15.9mm TYPE X GYPSUM BOARD	105	2H	51-54 GA-WP-5910
PS2	12.7mm GYPSUM BOARD 64mm METAL STUD @ 400 O.C. 12.7mm GYPSUM BOARD	90		
PS2A	12.7mm GYPSUM BOARD 64mm METAL STUD @ 400 O.C. 12.7mm ABUSE RESISTANT GYPSUM BOARD	90		
PS2C	12.7mm GYPSUM BOARD 64mm METAL STUD @ 400 O.C. 12.7mm CEMENT BOARD	90		
PS2G	12.7mm GYPSUM BOARD 64mm METAL STUD @ 400 O.C. 12.7mm MOISTURE RESISTANT GYPSUM BOARD (DENS SHIELD OR EQUAL)	90		
PS2S	12.7mm GYPSUM BOARD 64mm METAL STUD @ 600 O.C. WITH 65mm BATT INSULATION 12.7mm GYPSUM BOARD	90		43 (NRC) TL-93-043
PS2X	ULC DESIGN NO. W453 15.9mm TYPE X GYPSUM BOARD 64mm METAL STUD @ 600 O.C. WITH 65mm BATT INSULATION 15.9mm TYPE X GYPSUM BOARD	95	1H	44 (NRC) TL-93-033
PS2SX	ULC DESIGN NO. W453 15.9mm TYPE X GYPSUM BOARD 64mm METAL STUD @ 600 O.C. WITH 65mm BATT INSULATION 15.9mm TYPE X GYPSUM BOARD	95	1H	44 (NRC) TL-93-033
PS3	12.7mm GYPSUM BOARD 92mm METAL STUD @ 400 O.C. 12.7mm GYPSUM BOARD	120		
PS3A	12.7mm GYPSUM BOARD 92mm METAL STUD @ 400 O.C. 12.7mm ABUSE RESISTANT GYPSUM BOARD	120		
PS3C	12.7mm GYPSUM BOARD 92mm METAL STUD @ 400 O.C. 12.7mm CEMENT BOARD	120		
PS3G	12.7mm GYPSUM BOARD 92mm METAL STUD @ 400 O.C. 12.7mm MOISTURE RESISTANT GYPSUM BOARD (DENS SHIELD OR EQUAL)	120		
PS3S	12.7mm GYPSUM BOARD 92mm METAL STUD @ 400 O.C. WITH 89mm BATT INSULATION 12.7mm GYPSUM BOARD	120		47 (NRC) TL-92-413
PS3X	ULC DESIGN NO. W453 15.9mm TYPE X GYPSUM BOARD 92mm METAL STUD @ 610 O.C. WITH 65mm BATT INSULATION 15.9mm TYPE X GYPSUM BOARD	125	1H	50 REF: IIT INST. RAL-TL89-157
PS4	12.7mm GYPSUM BOARD 152mm METAL STUD @ 600 O.C. 12.7mm GYPSUM BOARD	180		
PS4A	12.7mm GYPSUM BOARD 152mm METAL STUD @ 600 O.C. 12.7mm ABUSE RESISTANT GYPSUM BOARD	180		
PS4C	12.7mm GYPSUM BOARD 152mm METAL STUD @ 600 O.C. 12.7mm CEMENT BOARD	180		
PS4G	12.7mm GYPSUM BOARD 152mm METAL STUD @ 600 O.C. 12.7mm MOISTURE RESISTANT GYPSUM BOARD (DENS SHIELD OR EQUAL)	180		
PS4S	15.9mm TYPE X GYPSUM BOARD 152mm METAL STUD @ 600 O.C. WITH 152mm BATT INSULATION 15.9mm TYPE X GYPSUM BOARD	185		52 (NRC) TL-93-299
PS4X	ULC DESIGN NO. W453 15.9mm TYPE X GYPSUM BOARD 152mm METAL STUD @ 600 O.C. 15.9mm TYPE X GYPSUM BOARD	185	1H	
PS4X2	ULC DESIGN NO. W453 2 LAYERS 15.9mm TYPE X GYPSUM BOARD 152mm METAL STUD @ 600 O.C. WITH 152mm BATT INSULATION 2 LAYERS 15.9mm TYPE X GYPSUM BOARD	215	2H	59 (NBC) S9A
PS4SX	ULC DESIGN NO. W453 15.9mm TYPE X GYPSUM BOARD 152mm METAL STUD @ 600 O.C. WITH 152mm BATT INSULATION 15.9mm TYPE X GYPSUM BOARD	185	1H	51 (NRC) TL-93-298
PS5	12.7mm GYPSUM BOARD 203mm METAL STUD @ 600 O.C. 12.7mm GYPSUM BOARD	230		
PS5S	12.7mm GYPSUM BOARD 203mm METAL STUD @ 600 O.C. WITH 200mm BATT INSULATION 12.7mm GYPSUM BOARD	230		
PS5X	ULC DESIGN NO. W453 15.9mm TYPE X GYPSUM BOARD 203mm METAL STUD @ 600 O.C. 15.9mm TYPE X GYPSUM BOARD	235	1H	
PS5X2	ULC DESIGN NO. W453 2 LAYERS 15.9mm TYPE X GYPSUM BOARD 203mm METAL STUD @ 600 O.C. 2 LAYERS 15.9mm TYPE X GYPSUM BOARD	265	2H	
PS5SX	ULC DESIGN NO. W453 15.9mm TYPE X GYPSUM BOARD 203mm METAL STUD @ 600 O.C WITH 200mm BATT INSULATION. 15.9mm TYPE X GYPSUM BOARD	235	1H	51 (NRC)

RESILIENT CHANNEL NOTES

1. SELECT SINGLE-LEG RESILIENT CHANNEL PROFILE WITH WITH LONG SLOTS ALONG LEG, NOT PUNCHED OVAL HOLES.
2. ENSURE THAT CHANNELS HAVE NOT BEEN CRUSHED DURING TRANSPORTATION TO SITE OR WHILE IN STORAGE ON SITE.
3. INSTALL CHANNELS PERPENDICULAR TO FRAMING MEMBERS, DO NOT SPACE CHANNELS CLOSER THAN SPECIFIED.
4. LEAVE SPACE BETWEEN ENDS OF CHANNELS AND ANY ABUTTING MATERIAL.
5. CHANNELS INSTALLED ON WALLS MUST BE INSTALLED WITH RESILIENT LEG FACING UP SO THAT GRAVITY PULLS THE GYPSUM BOARD AWAY FROM THE WALL.
6. LEAVE GAPS AT PERIMETER OF RESILIENT CEILINGS. GYPSUM BOARD FOR WALLS MUST BE ELEVATED OFF FLOORS AND GAP LEFT AT ADJACENT WALLS. SEAL ALL GAPS WITH ACOUSTICAL FIRESTOP SEALANT.
7. WHEN INSTALLING GYPSUM BOARD TO RESILIENT CHANNELS, DO NOT SCREW THROUGH RESILIENT CHANNEL INTO FRAMING BEYOND. SELECT SHORT SCREWS NOT CAPABLE OF BRIDGING.

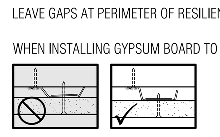

8. DO NOT CRUSH CHANNELS DURING GYPSUM BOARD INSTALLATION BY PUSHING EXCESSIVELY AGAINST THE BOARD.
9. PIPES PASSING THROUGH RESILIENTLY SUPPORTED BOARD SHALL BE ISOLATED BY LEAVING A GAP FILLED WITH ACOUSTICAL FIRESTOP SEALANT AROUND THE PIPE.
10. ELECTRICAL BOXES MUST NOT FASTEN TO RESILIENTLY SUPPORTED GYPSUM BOARD. LEAVE GAP AROUND BOX AND SEAL WITH ACOUSTICAL FIRESTOP SEALANT. DO NOT OVER-TIGHTEN FACE PLATES.
11. FRAMING FOR INTERIOR PARTITIONS AND BULKHEADS MUST BE FASTENED TO RESILIENT WALL/CEILING BOARD - DO NOT SCREW THROUGH RESILIENTLY SUPPORTED BOARD INTO FRAMING BEYOND.

FURRING TYPE SCHEDULE

FINISH #	MATERIALS	
F1	12.7mm GYPSUM BOARD	13
F1A	12.7mm ABUSE RESISTANT GYPSUM BOARD	13
F1C	12.7mm CEMENT BOARD	13
F1G	12.7mm MOISTURE RESISTANT GYPSUM BOARD (DENS SHIELD OR EQUAL)	13
F1V	6MIL POLY VAPOUR BARRIER 12.7mm GYPSUM BOARD	13
F2	22mm METAL FURRING CHANNELS @ 400 O.C. 12.7mm GYPSUM BOARD	35
F2A	22mm METAL FURRING CHANNELS @ 400 O.C. 12.7mm ABUSE RESISTANT GYPSUM BOARD	35
F2C	22mm METAL FURRING CHANNELS @ 400 O.C. 12.7mm CEMENT BOARD	35
F2G	22mm METAL FURRING CHANNELS @ 400 O.C. 12.7mm MOISTURE RESISTANT GYPSUM BOARD (DENS SHIELD OR EQUAL)	35
F2V	6MIL POLY VAPOUR BARRIER 22mm METAL FURRING CHANNELS @ 400 O.C. 12.7mm MOISTURE RESISTANT GYPSUM BOARD	35
F3	41mm METAL STUD @ 400 O.C. 12.7mm GYPSUM BOARD	55
F3A	41mm METAL STUD @ 400 O.C. 12.7mm ABUSE RESISTANT GYPSUM BOARD	55
F3C	41mm METAL STUD @ 400 O.C. 12.7mm CEMENT BOARD	55
F3G	41mm METAL STUD @ 400 O.C. 12.7mm MOISTURE RESISTANT GYPSUM BOARD (DENS SHIELD OR EQUAL)	55
F3S	10mm AIR SPACE 41mm METAL STUD @ 400 O.C. WITH 38mm BATT INSULATION 12.7mm GYPSUM BOARD	65
F3V	10mm AIR SPACE 41mm METAL STUD @ 400 O.C. WITH 38mm BATT INSULATION (R6) 6MIL POLY VAPOUR BARRIER 12.7mm GYPSUM BOARD	65
F4	64mm METAL STUD @ 400 O.C. 12.7mm GYPSUM BOARD	80
F4A	64mm METAL STUD @ 400 O.C. 12.7mm ABUSE RESISTANT GYPSUM BOARD	80
F4C	64mm METAL STUD @ 400 O.C. 12.7mm CEMENT BOARD	80
F4G	64mm METAL STUD @ 400 O.C. 12.7mm MOISTURE RESISTANT GYPSUM BOARD (DENS SHIELD OR EQUAL)	80
F4S	10mm AIR SPACE 64mm METAL STUD @ 400 O.C. WITH 64mm BATT INSULATION 12.7mm GYPSUM BOARD	90
F4V	10mm AIR SPACE 64mm METAL STUD @ 400 O.C. WITH 64mm BATT INSULATION (R10) 6MIL POLY VAPOUR BARRIER 12.7mm GYPSUM BOARD	90
F5	92mm METAL STUD @ 400 O.C. 12.7mm GYPSUM BOARD	105
F5A	92mm METAL STUD @ 400 O.C. 12.7mm ABUSE RESISTANT GYPSUM BOARD	105
F5C	92mm METAL STUD @ 400 O.C. 12.7mm CEMENT BOARD	105
F5G	92mm METAL STUD @ 400 O.C. 12.7mm MOISTURE RESISTANT GYPSUM BOARD (DENS SHIELD OR EQUAL)	105
F5S	10mm AIR SPACE 92mm METAL STUD @ 400 O.C. WITH 89mm BATT INSULATION 12.7mm GYPSUM BOARD	120
F5V	10mm AIR SPACE 92mm METAL STUD @ 400 O.C. WITH 89mm BATT INSULATION (R15) 6MIL POLY VAPOUR BARRIER 12.7mm GYPSUM BOARD	120
F5VG	10mm AIR SPACE 92mm METAL STUD @ 400 O.C. WITH 89mm BATT INSULATION (R15) 6MIL POLY VAPOUR BARRIER 12.7mm MOISTURE RESISTANT GYPSUM BOARD (DENS SHIELD OR EQUAL)	120
F6	152mm METAL STUD @ 400 O.C. 12.7mm GYPSUM BOARD	165
F6A	152mm METAL STUD @ 400 O.C. 12.7mm ABUSE RESISTANT GYPSUM BOARD	165
F6C	152mm METAL STUD @ 400 O.C. 12.7mm CEMENT BOARD	165
F6G	152mm METAL STUD @ 400 O.C. 12.7mm MOISTURE RESISTANT GYPSUM BOARD (DENS SHIELD OR EQUAL)	165
F6S	10mm AIR SPACE 152mm METAL STUD @ 400 O.C. WITH 150mm BATT INSULATION 12.7mm GYPSUM BOARD	180
F6V	10mm AIR SPACE 152mm METAL STUD @ 400 O.C. WITH 150mm BATT INSULATION (R20) 6MIL POLY VAPOUR BARRIER 12.7mm GYPSUM BOARD	180

SHAFT WALL SCHEDULE

WALL #	MATERIALS		FRR	STC
SW1	ULC DESIGN NO. W507 (SHAFTWALL) 25mm GYPSUM SHAFT LINER PANEL 64mm C-H SECTION STUDS @ 600mm O.C. 2 LAYERS 15.9mm TYPE X GYPSUM BOARD	95	2H	39
SW2	ULC DESIGN NO. W507 (SHAFTWALL) 25mm GYPSUM SHAFT LINER PANEL 102mm C-H SECTION STUDS @ 600mm O.C. WITH 75mm BATT INSULATION 2 LAYERS 15.9mm TYPE X GYPSUM BOARD	135	2H	50
SW3	ULC DESIGN NO. W507 (SHAFTWALL) 25mm GYPSUM SHAFT LINER PANEL 152mm C-H SECTION STUDS @ 600mm O.C. 2 LAYERS 15.9mm TYPE X GYPSUM BOARD	185	2H	39
SW4	GA FILE NO. WP 6800 (SHAFTWALL) 25mm GYPSUM SHAFT LINER PANEL 64mm C-H SECTION STUDS @ 600mm O.C. 15.9mm TYPE X GYPSUM BOARD	80	1H	35

PARTY, DEMISING, CORRIDOR WALL SCHEDULE

WALL #	MATERIALS		FRR	STC
PW1	ULC DESIGN NO. W453 (CORRIDOR WALL) 15.9mm TYPE X GYPSUM BOARD 92mm METAL STUD @ 600 O.C. WITH 89mm BATT INSULATION 15.9mm TYPE X GYPSUM BOARD (2 LAYERS)	140	1H	54 REF: NRC TL-92-368
PW1A	ULC DESIGN NO. W453 (CORRIDOR WALL) 15.9mm TYPE X GYPSUM BOARD (2 LAYERS) 64mm METAL STUD @ 600 O.C. WITH 65mm BATT INSULATION 15.9mm TYPE X GYPSUM BOARD (2 LAYERS)	130	2H	55 REF: NRC TL-93-037 57 REF: NBC W02784
PW1B	ULC DESIGN NO. W453 (CORRIDOR WALL) 15.9mm TYPE X GYPSUM BOARD 92mm METAL STUD @ 600 O.C. WITH 76mm MINERAL WOOL INSULATION 15.9mm TYPE X GYPSUM BOARD	125	1H	52+ REF: ROXUL RAL-TL95-195
PW1C	ULC DESIGN NO. W453 (CORRIDOR WALL) 15.9mm TYPE X GYPSUM BOARD 92mm METAL STUD @ 600 O.C. WITH 89mm FIBREGLASS BATT INSULATION (OWENS CORNING) 15.9mm TYPE X GYPSUM BOARD	125	1H	50 REF: IIT RESEARCH INST. RAL-TL89-157
PW2	ULC DESIGN NO. W483/UL U493 (PARTY WALL) 15.9mm TYPE X GYPSUM BOARD (2 LAYERS) 64mm METAL STUD @ 600 O.C. WITH 65mm BATT INSULATION 25mm (MIN.) AIRSPACE 64mm METAL STUD @ 600 O.C. WITH 65mm BATT INSULATION 15.9mm TYPE X GYPSUM BOARD (2 LAYERS)	230	1H & 2H	68 REF: NRC B3481.8
PW4	ULC DESIGN NO. W453 (PARTY WALL) 15.9mm TYPE X GYPSUM BOARD (2 LAYERS) 92mm METAL STUD @ 600 O.C. WITH 89mm BATT INSULATION 15.9mm RESILIENT CHANNEL (HORIZ.) @ 600 O.C. 15.9mm TYPE X GYPSUM BOARD	155	1H	58 REF: RAL TL90-345

NOTES:
1. ALL METAL STUDS NOTED IN THE ABOVE ASSEMBLIES ARE TO BE *25 GAUGE* UNLESS NOTED OTHERWISE.
2. ALL STUD SPACING TO BE 600mm O.C. UNLESS NOTED OTHERWISE
3. PARTY WALLS PW1 & PW3 - ADDITIONAL LAYER OF GYPSUM BOARD ADDED TO ULC DESIGN W453 ASSEMBLIES ARE PERMITTED AS PER ULC FRONT SECTION, PAGE 4, SECTION: "WALLS AND PARTIONS".

CEILING TYPE SCHEDULE

CEILING #	MATERIALS		FRR	STC
C1	ACOUSTICAL CEILING (UNDERSIDE OF MECH. PH, AMENITY) SERVICE SPACE (REFER TO MECHANICAL DRAWINGS) 210mm BATT INSULATION METAL SUSPENSION SYSTEM C/W VIBRATION ISOLATORS 2 LAYERS 15.9mm TYPE X GYPSUM BOARD (STAGGERED JOINTS) METAL SUSPENSION SYSTEM 12.7mm GYPSUM BOARD	VARIES 300		
C2	ACOUSTICAL CEILING (COMMON AREAS) 100mm SEMI-RIGID INSULATION WITH PERFORATED VINYL FACE, STICK PINNED TO UNDERSIDE OF CONCRETE (JOINTS TO BE SEALED) METAL SUSPENSION SYSTEM C/W VIBRATION ISOLATORS 12.7mm GYPSUM BOARD	VARIES		
C2A	ACOUSTICAL CEILING (COMMON AREAS) 100mm SEMI-RIGID INSUL. WITH PERFORATED VINYL FACE, STICK PINNED TO UNDERSIDE OF CONCRETE (JOINTS TO BE SEALED) T-BAR METAL SUSPENSION SYSTEM C/W VIBRATION ISOLATORS ACOUSTICAL CEILING TILES (SEE ALSO INTERIOR DESIGN DRAWINGS)	VARIES		
C3	COMPACT ACOUSTICAL CEILING (UNDERSIDE OF MECH. PH, AMENITY) 40mm MINERAL WOOL BATT INSULATION METAL CHANNEL IN PREFABRICATED SUSPENDED CEILING HANGER (BY KINETICS OR APPROVED EQUAL) 22mm METAL FURRING CHANNELS 2-LAYERS 15.9mm TYPE X GYPSUM BOARD METAL SUSPENSION SYSTEM 12.7mm GYPSUM BOARD	MANUF. SPEC. VARIES		STC 72 IIC 51 REF: NRC B-3463.9
C4	SUSPENDED TILE CEILING (PARKING GARAGE, HEATED SOFFITS) HEATED SERVICE SPACE (REFER TO MECHANICAL DRAWINGS) WITH 210mm BATT INSULATION (R32) T-BAR METAL SUSPENSION SYSTEM MOISTURE/MOLD RESISTANT ACOUSTICAL CEILING TILES	VARIES		
C4A	STICK-PIN INSULATED CEILING (PARKING GARAGE, SOFFITS) 100mm SEMI-RIGID INSULATION (R17) WITH PERFORATED VINYL FACE, STICK-PINNED TO UNDERSIDE OF CONCRETE (JOINTS TO BE SEALED)	100		
C4B	STICK-PIN INSULATED CEILING (PARKING GARAGE, SOFFITS) 150mm SEMI-RIGID INSULATION (R25) WITH PERFORATED VINYL FACE, STICK-PINNED TO UNDERSIDE OF CONCRETE (JOINTS TO BE SEALED)	150		
C5	SUSPENDED TILE CEILING (RE-CIRCULATION FLOOR, CORRIDOR) SUSPENDED ACOUSTICAL CEILING TILE SYSTEM (SEE ALSO INTERIOR DESIGN DRAWINGS)	VARIES		
C6	SUSPENDED GYPSUM CEILING (RE-CIRC. FLOOR SUITES, BATHROOMS) SUSPENDED CEILING SYSTEM / METAL STUD FRAMING (400 O.C. MAX SPACING) 12.7mm GYPSUM CEILING BOARD	VARIES		
C7	ACOUSTICAL CEILING (SERVICE SPACES BELOW SUITES) SERVICE SPACE (AIR SPACE) 150mm SOUND ATTENUATION BATT INSULATION METAL SUSPENSION SYSTEM C/W VIBRATION ISOLATORS (TYP.) 12.7mm GYPSUM BOARD (2 LAYERS) STAGGERED JOINTS	VARIES		

FIRE RESISTANCE RATINGS FOR CEILING MEMBRANES

1.	2 LAYERS 12.7mm TYPE X GYPSUM BOARD	45 MIN. RATING
2.	2 LAYERS 15.9mm TYPE X GYPSUM BOARD	1 HOUR RATING

(REFERENCE - 2012 SUPPLEMENTARY STANDARD, SB-2, PAGE 21, 2.3.12, TABLE 2.3.12)

BLOCK TYPE SCHEDULE

WALL #	MATERIALS		HOLLOW	75% SOLID	SOLID
B1	90 mm CONCRETE BLOCK (90)	NORMAL WEIGHT	B1	B1SS	B1S
		LIGHT WEIGHT	B1L	B1SSL	B1SL
	FIRE RESISTANCE RATING (HOURS)	NORMAL WEIGHT	0.8	1.1	1.4
		LIGHT WEIGHT	1.1	1.3	1.8
	SOUND PROPERTIES (STC RATING)	CSA TYPE 'A' CONCRETE	43	45	47
		CSA TYPE 'C & D' CONCRETE	40	42	45
B2	140 mm CONCRETE BLOCK (140)	NORMAL WEIGHT	B2	B2SS	B2S
		LIGHT WEIGHT	B2L	B2SSL	B2SL
	FIRE RESISTANCE RATING (HOURS)	NORMAL WEIGHT	1.1	2.0	2.9
		LIGHT WEIGHT	1.5	2.8	4+
	SOUND PROPERTIES (STC RATING)	CSA TYPE 'A' CONCRETE	46	50	52
		CSA TYPE 'C & D' CONCRETE	43	47	50
B3	190 mm CONCRETE BLOCK (190)	NORMAL WEIGHT	B3	B3SS	B3S
		LIGHT WEIGHT	B3L	B3SSL	B3SL
	FIRE RESISTANCE RATING (HOURS)	NORMAL WEIGHT	1.8	3.2	4+
		LIGHT WEIGHT	2.5	4+	4+
	SOUND PROPERTIES (STC RATING)	CSA TYPE 'A' CONCRETE	49	53	56
		CSA TYPE 'C & D' CONCRETE	46	51	53
B4	240 mm CONCRETE BLOCK (240)	NORMAL WEIGHT	B4	B4SS	B4S
		LIGHT WEIGHT	B4L	B4SSL	B4SL
	FIRE RESISTANCE RATING (HOURS)	NORMAL WEIGHT	2.4	4+	4+
		LIGHT WEIGHT	3.5	4+	4+
	SOUND PROPERTIES (STC RATING)	CSA TYPE 'A' CONCRETE	51	56	58
		CSA TYPE 'C & D' CONCRETE	49	53	56
B5	290 mm CONCRETE BLOCK (290)	NORMAL WEIGHT	B5	B5SS	B5S
		LIGHT WEIGHT	B5L	B5SSL	B5SL
	FIRE RESISTANCE RATING (HOURS)	NORMAL WEIGHT	3.2	4+	4+
		LIGHT WEIGHT	4+	4+	4+
	SOUND PROPERTIES (STC RATING)	CSA TYPE 'A' CONCRETE	53	58	58
		CSA TYPE 'C & D' CONCRETE	50	56	58

FIRE-RESISTANCE RATING FOR MASONRY AND CONCRETE WALLS - LOADBEARING AND NON-LOADBEARING

TYPE OF WALL (mm)	30MIN.	45MIN.	1 H	1.5 H	2.0 H	3.0 H	4.0 H
SOLID BRICK UNITS (80% SOLID AND OVER)	63	76	90	108	128	152	178
CORED BRICK UNITS AND HOLLOW TILE UNITS (LESS THAN 80% SOLID)	50	60	72	86	102	122	142
SOLID & HOLLOW CONCRETE MASONRY UNITS							
TYPE S OR N CONCRETE	44	59	73	95	113	142	167
TYPE L_1 20S CONCRETE	42	54	66	87	102	129	152
TYPE L_1 CONCRETE	42	54	64	82	97	122	143
TYPE L_2 20S CONCRETE	42	54	64	81	94	116	134
TYPE L_2 CONCRETE	42	54	63	79	91	111	127
MONOLITHIC CONCRETE & CONCRETE PANELS							
TYPE S CONCRETE	60	77	90	112	130	158	180
TYPE N CONCRETE	59	74	87	108	124	150	171
TYPE L40S OR TYPE L CONCRETE	49	62	72	89	103	124	140

HOLLOW CONCRETE MASONRY UNITS MADE WITH TYPE S OR N CONCRETE SHALL HAVE A MINIMUM COMPRESSIVE STRENGTH OF 15MPA BASED ON NET AREA, AS DEFINED IN CSA A165.1, "CONCRETE BLOCK MASONRY UNITS". (REFERENCE - 2012 SUPPLEMENTARY STANDARD, SB-2, PAGE 10-11, 2.1, TABLE 2.1.1.)

ABBREVIATIONS

AD = AREA DRAIN	MTL = METAL
ADJ = ADJUSTABLE	NFHB = NON FREEZE HOSE BIB (SEE ALSO MECH. DWGS)
ALUM = ALUMINIUM	NO. = NUMBER
ANOD. = ANODIZED	OBC = ONTARIO BUILDING CODE
BMF = BLACK MATTE FINISH	O.C. = ON CENTRE
℄ = CENTRE OR CENTRELINE	P.T. = PRESSURE TREATED (LUMBER)
CH = CABINET HEATER (SEE ALSO MECH. DWGS)	PTD = PAINTED
CJ = CONTROL JOINT	RD = ROOF DRAIN
CORR = CORRIDOR	RM = ROOM
CSA = CANADIAN STANDARD ASSOCIATION	RSD = RELIEF SCUPPER DRAIN
C/W = COMPLETE WITH	RSI = R-VALUE (THERMAL RESISTANCE, METRIC)
DEG = DEGREE	SC = SOLID CORE
DF = DRINKING FOUNTAIN	SP = SPANDREL PANEL
DN = DOWN	SS = STAINLESS STEEL
D.O. = DOOR OPERATOR	STC = SOUND TRANSMISSION COEFFICIENT
D.P. = DRAIN PIPE	STOR. = STORAGE
DR = DOOR	TG = TEMPERED GLASS
ELEV. = ELEVATION	T.O. = TOP OF
EQ. = EQUAL	T.O.C. = TOP OF CONCRETE
ETC. = ET CETERA	TYP. = TYPICAL
EXT = EXTERIOR	ULC = UNDERWRITERS LABORATORIES OF CANADA
FD = FLOOR DRAIN	U/S = UNDERSIDE
FFD = FUNNEL FLOOR DRAIN	W/ = WITH
FG = FIXED GLASS	WPDR = WEATHER PROOF DUPLEX RECEPTACLE
FLR = FLOOR	
FR = FRAME	
FT = FOOT OR FEET	
GA = GAUGE	
GWG = GEORGIAN WIRE GLASS	
HB = HOSE BIB (SEE ALSO MECHANICAL DRAWINGS)	
HC = HOLLOW CORE (DOOR-WOOD)	
HM = HOLLOW METAL	
HMF = HOLLOW METAL FRAME	
HMI = HOLLOW METAL INSULATED	
I.D.D. = INTERIOR DESIGN DRAWINGS	
LF = EXTERNAL LIGHT FIXTURE (SEE ELECT.DWGS)	
LIN. = LINEN CLOSET (SEE ALSO TYPICAL DETAILS)	
MAX. = MAXIMUM	
MC = MEDICINE CABINET	
MIN. = MINIMUM	
mm = MILIMETERS	
MP = METAL PANEL	

GENERAL LEGEND

- CONCRETE STRUCTURE
- DROP CEILING / BULKHEAD (FOR MECH. BULKHEADS SEE TYP. DETAILS)
- 2.0 FIRE RATED CEILING (REFER TO TYPICAL DETAILS)
- THERMALLY INSULATED CEILING
- MECHANICAL EXHAUST OR INTAKE (REFER TO MECHANICAL DWGS)
- WPDR = WEATHER PROOF DUPLEX RECEPTACLE (SEE ELECT. DWGS)
- MP = MEDIA PANEL (JUNCTION BOX)
- EP = ELECTRICAL PANEL
- SP = SECURITY PANEL
- D.O. = DOOR OPERATOR (SEE ALSO ELECTRICAL DRAWINGS)
- L.F. = LIGHT FIXTURE (SEE ALSO ELECTRICAL DRAWINGS)
- E.M. = ELECTRICAL METER
- HB = HOSE BIB (SEE ALSO MECHANICAL DRAWINGS)
- NFHB = NON FREEZE HOSE BIB (SEE ALSO MECH. DRAWINGS)
- GC = GAS CONNECTION
- GM = GAS METER
- CB = CATCH BASIN
- RD = ROOF DRAIN
- AD = AREA DRAIN
- SSD = SUB SURFACE DRAINAGE
- FD = FLOOR DRAIN
- FFD = FUNNEL FLOOR DRAIN
- RSD = RELIEF SCUPPER DRAIN
- P.S. = PIPE SPACE
- LIN. = LINEN CLOSET (SEE ALSO TYPICAL DETAILS)
- 01 — LEGAL NO.
- 1B+D — SUITE TYPE.
- 000.00 M FFE — SPOT ELEVATION
- C2 — CEILING TYPES (REFER TO SCHEDULE)
- W1 — WALL AND PARTITION TYPES (REFER TO SCHEDULE)
- R1 — ROOF TYPES (REFER TO SCHEDULE)
- D01 — DOOR TYPES (REFER TO SCHEDULE)
- WIN-01 — WINDOW TYPES
- SC-01 — SCREEN TYPES
- AM0.0 SM0.0 — ADDENDUM, SITE MEMO

KEY TO DETAIL/SECTION/ELEVATION LOCATION:

- DETAIL NUMBER / DRAWING REFERENCE NUMBER WHERE DETAIL WAS TAKEN FROM (1 / A301)
- ELEVATION / BUILDING SECTION NUMBER / DRAWING NUMBER (1 / A401)
- WALL SECTION / SECTION DETAIL NUMBER / DRAWING NUMBER (1 / A601)

GENERAL NOTES

1. INTERIOR SUITE PARTITIONS TO BE CONSTRUCTED WITH 41mm METAL STUDS WITH 12.7mm GYPSUM BOARD ON BOTH SIDES (TYPE PS1) UNLESS OTHERWISE NOTED. SEE ALSO NOTES 1A, 1B, & 1C REGARDING DESIGN FOR ALL METAL STUD WALLS/PARTITIONS:

   1A) LOADS ON "LOW" WALLS ACTING AS "GUARDS" - O.B.C. REFERENCE 4.1.5.15.
   1B) LOADS ON "VEHICLE GUARDS" - O.B.C. REFERENCE 4.1.5.16.
   1C) LOADS ON WALLS ACTING AS "GUARDS" - O.B.C. REFERENCE 4.1.5.17.

1.1 SUBSTITUTE 92mm METAL STUDS FOR 41mm METAL STUDS WHERE DENOTED:
   MC (MEDICINE CABINET)
   EP (ELECTRICAL PANEL)
   JB (JUNCTION BOX)
   SP (SECURITY PANEL)

1.2 FOR ALL HEAT PUMPS OR FAN COIL UNITS, FINISH IS TO BE TYPE F3 UNLESS OTHERWISE NOTED

1.3 FOR ALL PIPE SPACES (P.S.), FINISH IS TO BE TYPE F3 UNLESS OTHERWISE NOTED

2. ALL EXPOSED CAST-IN-PLACE CONCRETE SHEAR WALLS AND SQUARE COLUMNS TO BE FINISHED WITH LAMINATED 12.7mm GYPSUM BOARD (TYPE F1) UNLESS OTHERWISE NOTED

3. ALL EXPOSED CAST-IN-PLACE ROUND COLUMNS TO HAVE ARCHITECTURAL PLASTER FINISH.

4. BATHROOMS - THE 3 WALLS SURROUNDING BATH TUB AND/OR SHOWER AREA, SUBSTITUTE GYPSUM BOARD FOR 12.7mm "DUROCK" CEMENT BOARD OR APPROVED EQUAL. PROVIDE AT LEAST ONE (1) BATHROOM PER SUITE (TYPICALLY MAIN BATH) TO HAVE SOLID WOOD BLOCKING INSTALLED IN SHOWER/TUB AREA AND BEHIND TOILET (BETWEEN STUDS) IN PREPARATION FOR GRAB BAR INSTALLATION. SEE O.B.C. REFERENCE 3.3.4.8, 3.8.3.8.(1)(D) AND 3.8.3.13.(1)(F). REFER TO A800 SERIES DWGS FOR "DETAIL OF WOOD BLOCKING LOCATIONS AND EXTENT OF MOISTURE RESISTANT BOARD".

5. ALL BATHROOM DROP CEILINGS TO HAVE 100mm BATT INSULATION (SUITE ONLY), OR PIPES TO BE WRAPPED WITH INSULATION. REFER TO A800 SERIES FOR TYPICAL DETAIL

6. UNLESS OTHERWISE NOTED ALL CONCRETE BLOCK PARTITIONS ARE TO BE B2 (140mm TYPE NORMAL HOLLOW CONCRETE BLOCK). SEE ALSO NOTES 6A, 6B, & 6C REGARDING DESIGN FOR ALL CONCRETE BLOCK WALLS/PARTITIONS:

   6A) LOADS ON "LOW" WALLS ACTING AS "GUARDS" - O.B.C. REFERENCE 4.1.5.15.
   6B) LOADS ON "VEHICLE GUARDS" - O.B.C. REFERENCE 4.1.5.16.
   6C) LOADS ON WALLS ACTING AS "GUARDS" - O.B.C. REFERENCE 4.1.5.17.

7. UNLESS OTHERWISE NOTED ALL CONCRETE BLOCK SURROUNDING 2 HOUR RATED ENCLOSURES (STAIRS, ELEVATOR AND MECHANICAL SERVICES/EQUIPMENT) ARE TO BE P2SS (140mm TYPE NORMAL 75% SOLID CONCRETE BLOCK). SEE ALSO FIRE SEPARATION PLANS.

8. EXCEPT WHERE STANDPIPES ARE LOCATED IN STAIR SHAFTS, ALL STANDPIPES ARE TO HAVE A 1 HOUR FIRE RATED ENCLOSURE. REFER TO A800 SERIES FOR TYPICAL DETAIL.

9. ALL RESIDENTIAL SUITE-TO-SUITE DEMISING WALLS ARE TO BE TYPE PW2 UNLESS OTHERWISE NOTED

10. ALL AMENITY WALLS TO BE TYPE PS3 UNLESS OTHERWISE NOTED

11. PARKING GARAGE SUSPENDED SLABS TO BE WATERPROOFED, INCLUDING MECHANICAL ROOMS, MOVING ROOMS, AND GARBAGE ROOMS. REFER TO ARCHITECTURAL SPECIFICATIONS.

12. ALL BALCONIES TO SLOPE MINIMUM 1% OR 20-25mm TO EXTERIOR EDGE TYPICAL (SEE ALSO STRUCTURAL DRAWINGS)

13. FOR SLAB OPENINGS ADD 25mm AROUND THE PERIMETER OF DUCT SIZE AS INDICATED.

14. WHERE BUILDING HEIGHT EXCEEDS 8M ABOVE ADJACENT GROUND LEVEL, PROVISIONS FOR WINDOW WASHING AND MAINTENANCE WILL BE PROVIDED IN COMPLIANCE WITH ARTICLE 4.4.4.1. OF THE OBC.

THIS DRAWING, AS AN INSTRUMENT OF SERVICE, IS PROVIDED BY AND IS THE PROPERTY OF GRAZIANI+CORAZZA ARCHITECTS INC. THE CONTRACTOR MUST VERIFY AND ACCEPT RESPONSIBILITY FOR ALL DIMENSIONS AND CONDITIONS ON SITE AND MUST NOTIFY GRAZIANI+CORAZZA ARCHITECTS INC. OF ANY VARIATIONS FROM THE SUPPLIED INFORMATION. GRAZIANI+CORAZZA ARCHITECTS INC. IS NOT RESPONSIBLE FOR THE ACCURACY OF SURVEY, STRUCTURAL, MECHANICAL, ELECTRICAL, AND OTHER ENGINEERING INFORMATION SHOWN ON THIS DRAWING. REFER TO THE APPROPRIATE ENGINEERING DRAWINGS BEFORE PROCEEDING WITH THE WORK. CONSTRUCTION MUST CONFORM TO ALL APPLICABLE CODES AND REQUIREMENTS OF THE AUTHORITIES HAVING JURISDICTION. UNLESS OTHERWISE NOTED, NO INVESTIGATION HAS BEEN UNDERTAKEN OR REPORTED ON BY THIS OFFICE IN REGARDS TO THE ENVIRONMENTAL CONDITION OF THIS SITE.

THIS DRAWING IS NOT TO BE SCALED. ALL ARCHITECTURAL SYMBOLS INDICATED ON THIS DRAWING ARE GRAPHIC REPRESENTATIONS ONLY.

CONDITIONS FOR ELECTRONIC INFORMATION TRANSFER:

ELECTRONIC INFORMATION IS SUPPLIED TO THE OTHER ASSOCIATED FIRMS TO ASSIST THEM IN THE EXECUTION OF THEIR WORK / REVIEW. THE RECIPIENT FIRMS MUST DETERMINE THE COMPLETENESS / APPROPRIATENESS / RELEVANCE OF THE INFORMATION IN RESPECT TO THEIR PARTICULAR RESPONSIBILITY.

GRAZIANI+CORAZZA ARCHITECTS INC. SHALL NOT BE RESPONSIBLE FOR:
1. ERRORS, OMISSIONS, INCOMPLETENESS DUE TO LOSS OF INFORMATION IN WHOLE OR PART WHEN INFORMATION IS TRANSFERRED.
2. TRANSMISSION OF ANY VIRUS OR DAMAGE TO THE RECEIVING ELECTRONIC SYSTEM WHEN INFORMATION IS TRANSFERRED.

01.	Oct.07.2019	issued for tender	__
02.	Mar.13.2020	issued for design coordination #2	__
03.	Mar.16.2020	issued for addendum #2	__
04.	Mar.16.2020	issued for addendum #3	__
05.	Aug.24.2020	issued for addendum #4	__
06.	Sept. 28.2020	issued for permit	bg
07.	Oct.20.2020	issued for addendum #5	__
08.	Nov.23.2020	issued for addendum #6	__
09.	Dec.14.2020	issued for addendum #7	__
10.	Jan.18.2021	issued for addendum #8	__
11.	Mar. 2. 2021	issued for permit	bg
12.	Mar.09.2021	issued for addendum #9	__
13.	Mar.10.2021	issued for addendum #9R	__
14.	Mar.26.2021	issued for progress	__
15.	May 14. 2021	issued for Site Instruction #1	__
16.	June 15. 2021	issued for Site Instruction #2	__
17.	July. 7. 2021	re-issued for permit	bg
18.	July. 15. 2021	Issued for Site Instruction #3	bg
19.	July. 27. 2021	Issued for Site Instruction #4	bg
20.	Aug. 3. 2021	Issued for Site Instruction #5	bg
21.	Aug. 18. 2021	Issued for Site Instruction #6	bg
22.	Aug. 20. 2021	Re-issued for permit.	bg
23.	Sept. 07. 2021	Issued for Site Instruction #7	bg
24.	Sept. 09. 2021	Issued for Site Instruction #8	bg
25.	Sept. 16. 2021	Issued for Building D Permit Revisions	bg
26.	Sept. 22. 2021	Issued for Site Instruction #9	bg
27.	Oct. 6. 2021	Re-issued for permit.	bg
28.	Oct. 8. 2021	Issued for Site Instruction #10	bg
30.	Oct. 28. 2021	Issued for Site Instruction #11	bg
31.	Nov. 05. 2021	Issued for Site Instruction #12	bg
32.	Dec. 3. 2021	Issued for Site Instruction #13	bg
33.	Dec. 6. 2021	Issued for Site Instruction #14	bg
34.	Dec. 7. 2021	Issued for Site Instruction #15	bg

01.	Apr.19.2021	issued to client	bg

issued for revisions

GRAZIANI + CORAZZA ARCHITECTS
1320 SHAWSON DRIVE, SUITE 100 MISSISSAUGA, ONTARIO L4W 1C3
T.905.795.2601 F.905.795.2844 WWW.GC-ARCHITECTS.COM

RESIDENTIAL

ROYAL PINE HOMES

ATTMAR + PALLESCHI DRIVE

BRAMPTON ONTARIO

PROJECT ARCHITECT:	B.GRAZIANI
ASSISTANT DESIGNER:	R.LINCOLN
DRAWN BY:	G.C/F.C/M.B
CHECKED BY:	D.BIASE/G.COLANGELO
PLOT DATE:	DEC.08.2021
JOB #	1331.15

WALL SCHEDULE

NTS A102

TITLEBLOCK SIZE: 915 x 1200

THIS DRAWING, AS AN INSTRUMENT OF SERVICE, IS PROVIDED BY AND IS THE PROPERTY OF GRAZIANI+CORAZZA ARCHITECTS INC. THE CONTRACTOR MUST VERIFY AND ACCEPT RESPONSIBILITY FOR ALL DIMENSIONS AND CONDITIONS ON SITE AND MUST NOTIFY GRAZIANI+CORAZZA ARCHITECTS INC. OF ANY VARIATIONS FROM THE SUPPLIED INFORMATION. GRAZIANI+CORAZZA ARCHITECTS INC. IS NOT RESPONSIBLE FOR THE ACCURACY OF SURVEY, STRUCTURAL, MECHANICAL, ELECTRICAL, AND OTHER ENGINEERING INFORMATION SHOWN ON THIS DRAWING. REFER TO THE APPROPRIATE ENGINEERING DRAWINGS BEFORE PROCEEDING WITH THE WORK. CONSTRUCTION MUST CONFORM TO ALL APPLICABLE CODES AND REQUIREMENTS OF THE AUTHORITIES HAVING JURISDICTION. UNLESS OTHERWISE NOTED, NO INVESTIGATION HAS BEEN UNDERTAKEN OR REPORTED ON BY THIS OFFICE IN REGARDS TO THE ENVIRONMENTAL CONDITION OF THIS SITE.

THIS DRAWING IS NOT TO BE SCALED. ALL ARCHITECTURAL SYMBOLS INDICATED ON THIS DRAWING ARE GRAPHIC REPRESENTATIONS ONLY.

CONDITIONS FOR ELECTRONIC INFORMATION TRANSFER:

ELECTRONIC INFORMATION IS SUPPLIED TO THE OTHER ASSOCIATED FIRMS TO ASSIST THEM IN THE EXECUTION OF THEIR WORK / REVIEW. THE RECIPIENT FIRMS MUST DETERMINE THE COMPLETENESS / APPROPRIATENESS / RELEVANCE OF THE INFORMATION IN RESPECT TO THEIR PARTICULAR RESPONSIBILITY.

GRAZIANI+CORAZZA ARCHITECTS INC. SHALL NOT BE RESPONSIBLE FOR:
1. ERRORS, OMISSIONS, INCOMPLETENESS DUE TO LOSS OF INFORMATION IN WHOLE OR PART WHEN INFORMATION IS TRANSFERRED.
2. TRANSMISSION OF ANY VIRUS OR DAMAGE TO THE RECEIVING ELECTRONIC SYSTEM WHEN INFORMATION IS TRANSFERRED.

SLOPPED SLAB VARIATIONS AND UPTURN BEAM AT RAMP

3D VIEW OF SLOPPED SLAB AND UPTURN BEAM AT RAMP

01.	Oct.07.2019	issued for tender
02.	Mar.13.2020	issued for design coordination #2
03.	Mar.16.2020	issued for addendum #2
04.	Mar.16.2020	issued for addendum #3
05.	Aug.24.2020	issued for addendum #4
06.	Sept. 28.2020	issued for permit
07.	Oct.20.2020	issued for addendum #5
08.	Nov.23.2020	issued for addendum #6
09.	Dec.14.2020	issued for addendum #7
10.	Jan.18.2021	issued for addendum #8
11.	Mar. 2. 2021	issued for permit
12.	Mar.09.2021	issued for addendum #9
13.	Mar.10.2021	issued for addendum #9R
14.	Mar.26.2021	issued for progress
15.	May 14. 2021	issued for Site Instruction #1
16.	June 15. 2021	issued for Site Instruction #2
17.	July. 7. 2021	re-issued for permit
18.	July. 15. 2021	Issued for Site Instruction #3
19.	July. 27. 2021	Issued for Site Instruction #4
20.	Aug. 3. 2021	Issued for Site Instruction #5
21.	Aug. 18. 2021	Issued for Site Instruction #6
22.	Aug. 20. 2021	Re-issued for permit.
23.	Sept. 07. 2021	Issued for Site Instruction #7
24.	Sept. 09. 2021	Issued for Site Instruction #8
25.	Sept. 16. 2021	Issued for Building D Permit Revisions
26.	Sept. 22. 2021	Issued for Site Instruction #9
27.	Oct. 6. 2021	Re-issued for permit.
28.	Oct. 8. 2021	Issued for Site Instruction #10
30.	Oct. 28. 2021	Issued for Site Instruction #11
31.	Nov. 05. 2021	Issued for Site Instruction #12
32.	Dec. 3. 2021	Issued for Site Instruction #13
33.	Dec. 6. 2021	Issued for Site Instruction #14
34.	Dec. 7. 2021	Issued for Site Instruction #15

01. ~~Apr.19.2019~~ 2019 Issued for ~~Addendum~~ 1

issued for revisions

GRAZIANI + CORAZZA ARCHITECTS
1320 SHARON DRIVE, SUITE 100 MISSISSAUGA ONTARIO L4W 1C3
T 905.795.2601 F 905.795.2644 WWW.GC-ARCHITECTS.COM

RESIDENTIAL

ATTMAR + PALLESCHI DRIVE

BRAMPTON ONTARIO

PROJECT ARCHITECT:	B.GRAZIANI
ASSISTANT DESIGNER:	R.LINCOLN
DRAWN BY:	G.C/F.C/M.B
CHECKED BY:	D.BIASE/G.COLANGELO
PLOT DATE:	DEC.13.2021
JOB #	1331.15

CONCRETE SLAB EDGE GROUND FLOOR (OVERALL PLAN)

1:150

CS301-OS

TITLEBLOCK SIZE: 915 x 1200

SLOPPED SLAB VARIATIONS AND UPTURN BEAM AT RAMP

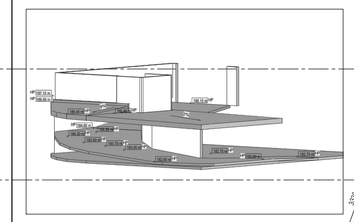

3D VIEW OF SLOPPED SLAB AND UPTURN BEAM AT RAMP

REF.A211b FOR CONTINUATION

CS LEGEND

- INDICATES CONCRETE STRUCTURE
- INDICATES CONCRETE SLAB BUILDUP
- INDICATES CONCRETE CURB
- INDICATES SLAB OPENING
- SLOPE — INDICATES SLOPED BALCONY, SLAB EXTENSION OR FROST SLAB
- INDICATES 50mm SLAB DEPRESSION
- INDICATES FLOATING SLAB
- INDICATES SECTION VIEW OF CONCRETE

RD	= TOP OF ROOF DRAIN
AD	= TOP OF AREA DRAIN
FD	= TOP OF FLOOR DAIN
FFD	= TOP OF FUNNEL FLOOR DRAIN
CB	= TOP OF CATCH BASIN
RSD	= RELIEF SCUPPER DRAIN
SD	= SURFACE DRAIN
TOC	= TOP OF CONCRETE CURB
TOF	= TOP OF FINISH
TOS	= TOP OF CONCRETE SLAB
TOW	= TOP OF WALL
MH	= TOP OF MAN HOLE
FFE	= FINISH FLOOR ELEVATION
TOR	= TOP OF RAMP
BOR	= BOTTOM OF RAMP
FG	= FINISH GRADE
EX	= EXISTING ELEVATION
EJ	= EXPANSION JOINT
DS	= DEPRESSED SLAB
LP	= LOW POINT
HP	= HIGH POINT
BS	= BOTTOM OF STEEL

NOTES

1. UNLESS DIMENSIONED OTHERWISE, ALL COLUMNS AND SHEAR WALLS TO BE CENTERED OR ALIGNED ON GRIDLINES.
2. THESE DRAWINGS ARE TO BE READ IN CONJUNCTION WITH STRUCTURAL, MECHANICAL, ELECTRICAL AND ARCHITECTURAL DRAWINGS. THE CONTRACTOR IS TO NOTIFY ANY CONFLICTING INFORMATION TO GRAZIANI + CORAZZA ARCHITECTS INC.
3. FOR ALL CONCRETE BEAMS, DROP PANELS AND CAPITALS, REFER TO STRUCTURAL DRAWINGS.

THIS DRAWING, AS AN INSTRUMENT OF SERVICE, IS PROVIDED BY AND IS THE PROPERTY OF GRAZIANI+CORAZZA ARCHITECTS INC. THE CONTRACTOR MUST VERIFY AND ACCEPT RESPONSIBILITY FOR ALL DIMENSIONS AND CONDITIONS ON SITE AND MUST NOTIFY GRAZIANI+CORAZZA ARCHITECTS INC. OF ANY VARIATIONS FROM THE SUPPLIED INFORMATION. GRAZIANI+CORAZZA ARCHITECTS INC. IS NOT RESPONSIBLE FOR THE ACCURACY OF SURVEY, STRUCTURAL, MECHANICAL, ELECTRICAL, AND OTHER ENGINEERING INFORMATION SHOWN ON THIS DRAWING. REFER TO THE APPROPRIATE ENGINEERING DRAWINGS BEFORE PROCEEDING WITH THE WORK. CONSTRUCTION MUST CONFORM TO ALL APPLICABLE CODES AND REQUIREMENTS OF THE AUTHORITIES HAVING JURISDICTION. UNLESS OTHERWISE NOTED, NO INVESTIGATION HAS BEEN UNDERTAKEN OR REPORTED ON BY THIS OFFICE IN REGARDS TO THE ENVIRONMENTAL CONDITION OF THIS SITE.

THIS DRAWING IS NOT TO BE SCALED. ALL ARCHITECTURAL SYMBOLS INDICATED ON THIS DRAWING ARE GRAPHIC REPRESENTATIONS ONLY.

CONDITIONS FOR ELECTRONIC INFORMATION TRANSFER:

ELECTRONIC INFORMATION IS SUPPLIED TO THE OTHER ASSOCIATED FIRMS TO ASSIST THEM IN THE EXECUTION OF THEIR WORK / REVIEW. THE RECIPIENT FIRMS MUST DETERMINE THE COMPLETENESS / APPROPRIATENESS / RELEVANCE OF THE INFORMATION IN RESPECT TO THEIR PARTICULAR RESPONSIBILITY.

GRAZIANI + CORAZZA ARCHITECTS INC. SHALL NOT BE RESPONSIBLE FOR:

1. ERRORS, OMISSIONS, INCOMPLETENESS DUE TO LOSS OF INFORMATION IN WHOLE OR PART WHEN INFORMATION IS TRANSFERRED.
2. TRANSMISSION OF ANY VIRUS OR DAMAGE TO THE RECEIVING ELECTRONIC SYSTEM WHEN INFORMATION IS TRANSFERRED.

01.	Oct.07.2019 Issued for tender	___
02.	Mar.13.2020 Issued for design coordination #2	___
03.	Mar.16.2020 Issued for addendum #2	___
04.	Mar.16.2020 Issued for addendum #3	___
05.	Aug.24.2020 Issued for addendum #4	___
06.	Sept. 28.2020 Issued for permit	bg
07.	Oct.20.2020 Issued for addendum #5	___
08.	Nov.23.2020 Issued for addendum #6	___
09.	Dec.14.2020 Issued for addendum #7	___
10.	Jan.18.2021 Issued for addendum #8	___
11.	Mar. 2. 2021 Issued for permit	bg
12.	Mar.09.2021 Issued for addendum #9	___
13.	Mar.10.2021 Issued for addendum #9R	___
14.	Mar.26.2021 issued for progress	___
15.	May 14. 2021 Issued for Site Instruction #1	___
16.	June 15. 2021 Issued for Site Instruction #2	___
17.	July. 7. 2021 re-issued for permit	bg
18.	July. 15. 2021 Issued for Site Instruction #3	bg
19.	July. 27. 2021 Issued for Site Instruction #4	bg
20.	Aug. 3. 2021 Issued for Site Instruction #5	bg
21.	Aug. 18. 2021 Issued for Site Instruction #6	bg
22.	Aug. 20. 2021 Re-issued for permit.	bg
23.	Sept. 07. 2021 Issued for Site Instruction #7	bg
24.	Sept. 09. 2021 Issued for Site Instruction #8	bg
25.	Sept. 16. 2021 Issued for Building D Permit Revisions	bg
26.	Sept. 22. 2021 Issued for Site Instruction #9	bg
27.	Oct. 6. 2021 Re-issued for permit.	bg
28.	Oct. 8. 2021 Issued for Site Instruction #10	bg
30.	Oct. 28. 2021 Issued for Site Instruction #11	bg
31.	Nov. 05. 2021 Issued for Site Instruction #12	bg
32.	Dec. 3. 2021 Issued for Site Instruction #13	bg
33.	Dec. 6. 2021 Issued for Site Instruction #14	bg
34.	Dec. 7. 2021 Issued for Site Instruction #15	bg

01. SEPTEMBER 2019 Issued for Addendum 1 bg

issued for revisions

GRAZIANI + CORAZZA ARCHITECTS

1320 SHAWSON DRIVE, SUITE 100, MISSISSAUGA, ONTARIO, L4W 1C5
T 905.795.2601 F 905.795.2644 WWW.GC-ARCHITECTS.COM

RESIDENTIAL

ATTMAR + PALLESCHI DRIVE

BRAMPTON ONTARIO

PROJECT ARCHITECT:	B.GRAZIANI
ASSISTANT DESIGNER:	R.LINCOLN
DRAWN BY:	G.C./F.C./M.B
CHECKED BY:	D.BIASE/G.COLANGELO
PLOT DATE:	DEC.13.2021
JOB #	1331.15

CONCRETE SLAB EDGE GROUND FLOOR (ENLARGE PLAN)

1:100

CS301a1

TITLEBLOCK SIZE: 915 x 1200

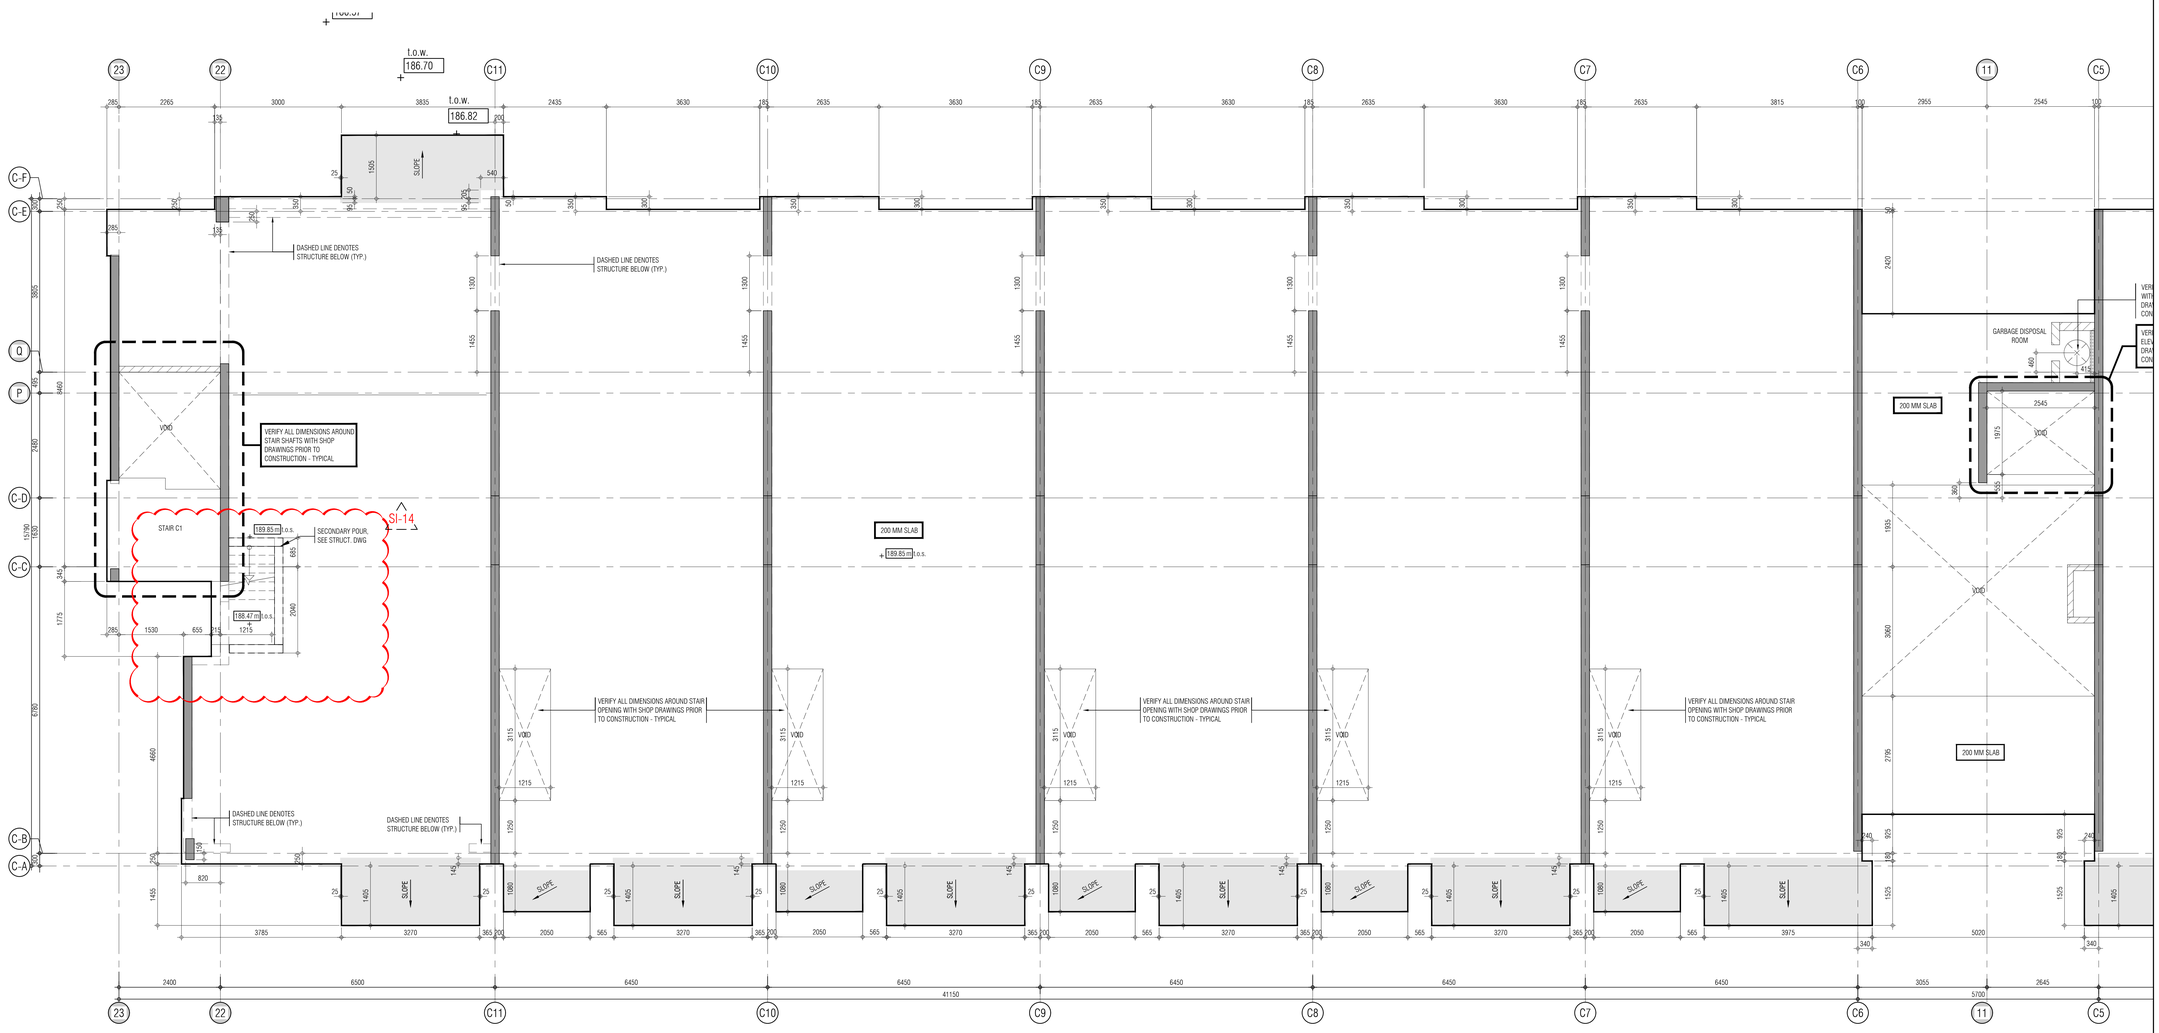

THIS DRAWING, AS AN INSTRUMENT OF SERVICE, IS PROVIDED BY AND IS THE PROPERTY OF GRAZIANI+CORAZZA ARCHITECTS INC. THE CONTRACTOR MUST VERIFY AND ACCEPT RESPONSIBILITY FOR ALL DIMENSIONS AND CONDITIONS ON SITE AND MUST NOTIFY GRAZIANI+CORAZZA ARCHITECTS INC. OF ANY VARIATIONS FROM THE SUPPLIED INFORMATION. GRAZIANI+CORAZZA ARCHITECTS INC. IS NOT RESPONSIBLE FOR THE ACCURACY OF SURVEY, STRUCTURAL, MECHANICAL, ELECTRICAL, AND OTHER ENGINEERING INFORMATION SHOWN ON THIS DRAWING. REFER TO THE APPROPRIATE ENGINEERING DRAWINGS BEFORE PROCEEDING WITH THE WORK. CONSTRUCTION MUST CONFORM TO ALL APPLICABLE CODES AND REQUIREMENTS OF THE AUTHORITIES HAVING JURISDICTION. UNLESS OTHERWISE NOTED, NO INVESTIGATION HAS BEEN UNDERTAKEN OR REPORTED ON BY THIS OFFICE IN REGARDS TO THE ENVIRONMENTAL CONDITION OF THIS SITE.

THIS DRAWING IS NOT TO BE SCALED. ALL ARCHITECTURAL SYMBOLS INDICATED ON THIS DRAWING ARE GRAPHIC REPRESENTATIONS ONLY.

CONDITIONS FOR ELECTRONIC INFORMATION TRANSFER:

ELECTRONIC INFORMATION IS SUPPLIED TO THE OTHER ASSOCIATED FIRMS TO ASSIST THEM IN THE EXECUTION OF THEIR WORK / REVIEW. THE RECIPIENT FIRMS MUST DETERMINE THE COMPLETENESS / APPROPRIATENESS / RELEVANCE OF THE INFORMATION IN RESPECT TO THEIR PARTICULAR RESPONSIBILITY.

GRAZIANI + CORAZZA ARCHITECTS INC. SHALL NOT BE RESPONSIBLE FOR:
1. ERRORS, OMISSIONS, INCOMPLETENESS DUE TO LOSS OF INFORMATION IN WHOLE OR PART WHEN INFORMATION IS TRANSFERRED.
2. TRANSMISSION OF ANY VIRUS OR DAMAGE TO THE RECEIVING ELECTRONIC SYSTEM WHEN INFORMATION IS TRANSFERRED.

REF. A302c2 FOR CONTINUATION

01.	Oct.07.2019	issued for tender	___
02.	Mar.13.2020	issued for design coordination #2	___
03.	Mar.16.2020	issued for addendum #2	___
04.	Mar.16.2020	issued for addendum #3	___
05.	Aug.24.2020	issued for addendum #4	___
06.	Sept. 28.2020	issued for permit	bg
07.	Oct.20.2020	issued for addendum #5	___
08.	Nov.23.2020	issued for addendum #6	___
09.	Dec.14.2020	issued for addendum #7	___
10.	Jan.18.2021	issued for addendum #8	___
11.	Mar. 2. 2021	issued for permit	bg
12.	Mar.09.2021	issued for addendum #9	___
13.	Mar.10.2021	issued for addendum #9R	___
14.	Mar.26.2021	issued for progress	___
15.	May 14. 2021	issued for Site Instruction #1	___
16.	June 15. 2021	issued for Site Instruction #2	___
17.	July. 7. 2021	re-issued for permit	bg
18.	July. 15. 2021	Issued for Site Instruction #3	bg
19.	July. 27. 2021	Issued for Site Instruction #4	bg
20.	Aug. 3. 2021	Issued for Site Instruction #5	bg
21.	Aug. 18. 2021	Issued for Site Instruction #6	bg
22.	Aug. 20. 2021	Re-issued for permit.	bg
23.	Sept. 07. 2021	Issued for Site Instruction #7	bg
24.	Sept. 09. 2021	Issued for Site Instruction #8	bg
25.	Sept. 16. 2021	Issued for Building D Permit Revisions	bg
26.	Sept. 22. 2021	Issued for Site Instruction #9	bg
27.	Oct. 6. 2021	Re-issued for permit.	bg
28.	Oct. 8. 2021	Issued for Site Instruction #10	bg
30.	Oct. 28. 2021	Issued for Site Instruction #11	bg
31.	Nov. 05. 2021	Issued for Site Instruction #12	bg
32.	Dec. 3. 2021	Issued for Site Instruction #13	bg
33.	Dec. 6. 2021	Issued for Site Instruction #14	bg
34.	Dec. 7. 2021	Issued for Site Instruction #15	bg

01. SEPT.19.2019 Issued for Addendum 1 bg

issued for revisions

GRAZIANI + CORAZZA ARCHITECTS
1320 SHAWSON DRIVE, SUITE 100 MISSISSAUGA, ONTARIO L4W 1C3
T 905.795.2820 F 905.795.2844 WWW.GC-ARCHITECTS.COM

RESIDENTIAL

ATTMAR + PALLESCHI DRIVE

BRAMPTON ONTARIO

PROJECT ARCHITECT:	B.GRAZIANI
ASSISTANT DESIGNER:	R.LINCOLN
DRAWN BY:	G.C/F.C/M.B
CHECKED BY:	D.BIASE/G.COLANGELO
PLOT DATE:	DEC.08.2021
JOB #	1331.15

KEY PLAN

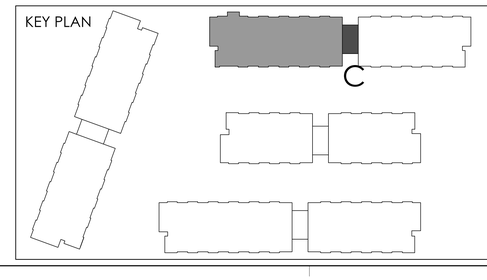

CONCRETE SLAB EDGE 2ND FLOOR PLAN BUILDING C (PARTIAL PLAN)

1:50

CS302c1

TITLEBLOCK SIZE: 915 x 1200

REF.A302c1 FOR CONTINUATION

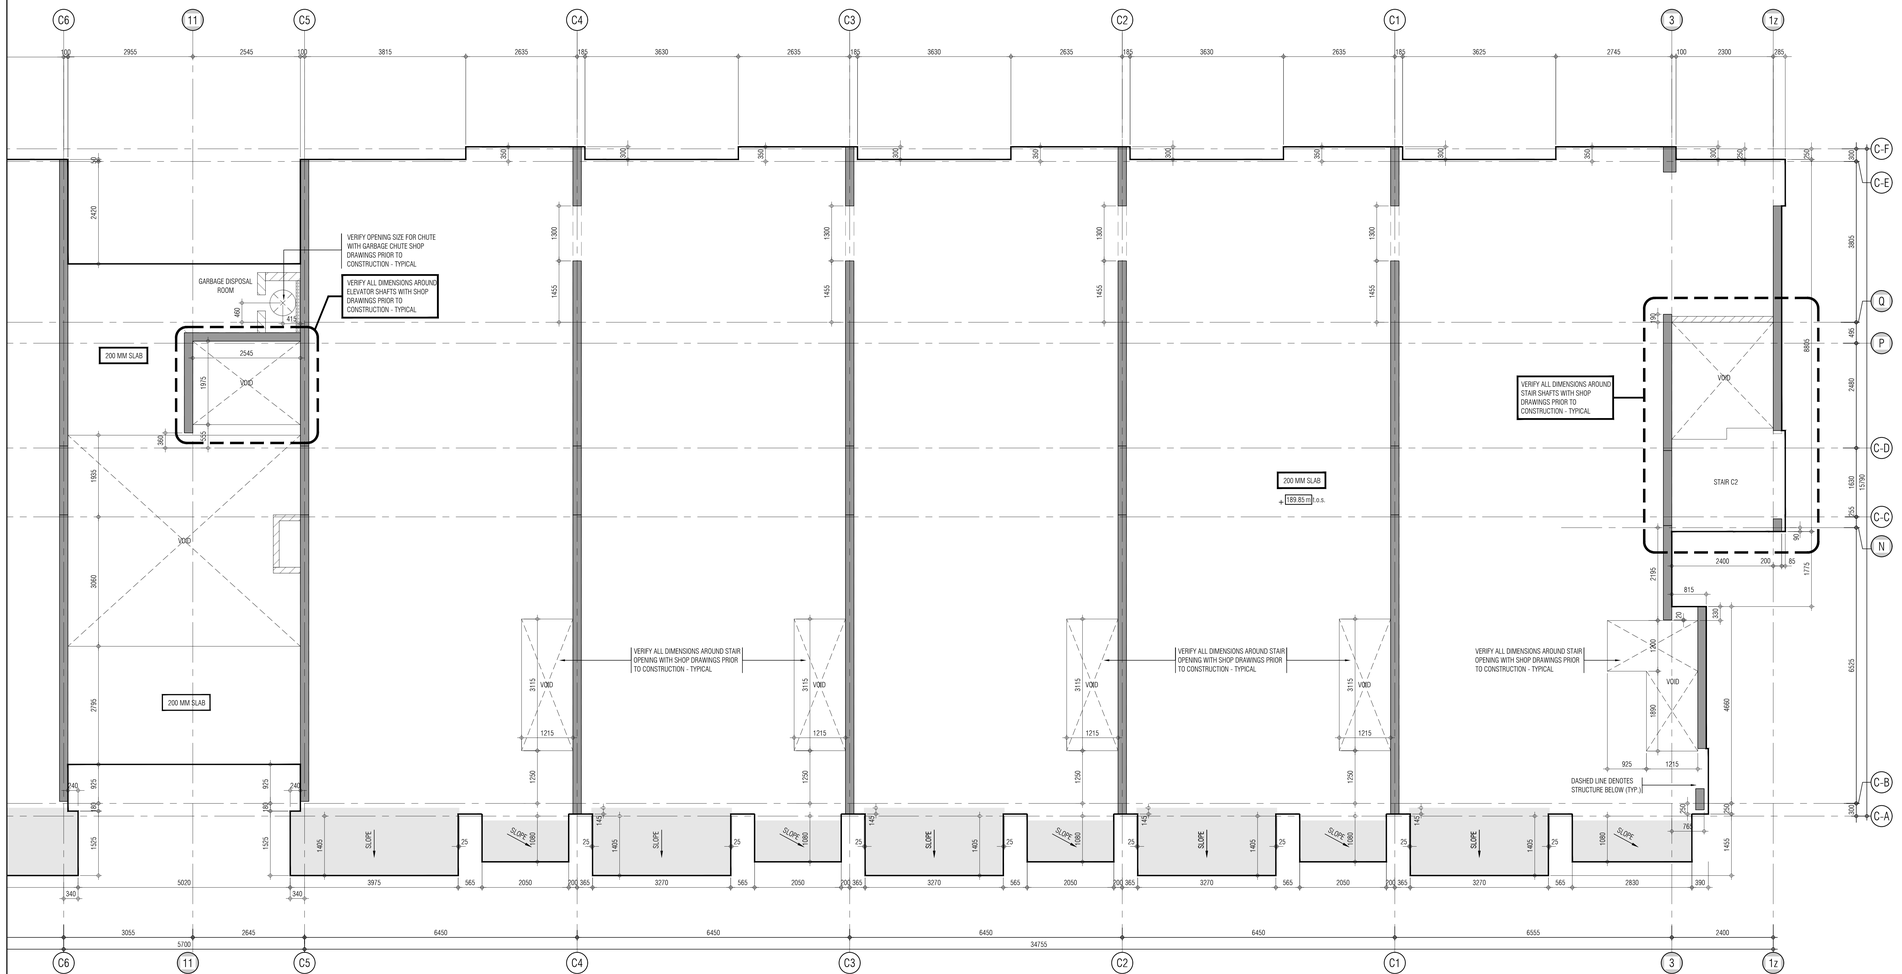

KEY PLAN

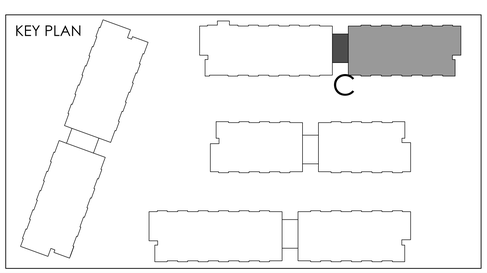

THIS DRAWING, AS AN INSTRUMENT OF SERVICE, IS PROVIDED BY AND IS THE PROPERTY OF GRAZIANI+CORAZZA ARCHITECTS INC. THE CONTRACTOR MUST VERIFY AND ACCEPT RESPONSIBILITY FOR ALL DIMENSIONS AND CONDITIONS ON SITE AND MUST NOTIFY GRAZIANI+CORAZZA ARCHITECTS INC. OF ANY VARIATIONS FROM THE SUPPLIED INFORMATION. GRAZIANI+CORAZZA ARCHITECTS INC. IS NOT RESPONSIBLE FOR THE ACCURACY OF SURVEY, STRUCTURAL, MECHANICAL, ELECTRICAL, AND OTHER ENGINEERING INFORMATION SHOWN ON THIS DRAWING. REFER TO THE APPROPRIATE ENGINEERING DRAWINGS BEFORE PROCEEDING WITH THE WORK. CONSTRUCTION MUST CONFORM TO ALL APPLICABLE CODES AND REQUIREMENTS OF THE AUTHORITIES HAVING JURISDICTION. UNLESS OTHERWISE NOTED, NO INVESTIGATION HAS BEEN UNDERTAKEN OR REPORTED ON BY THIS OFFICE IN REGARDS TO THE ENVIRONMENTAL CONDITION OF THIS SITE.

THIS DRAWING IS NOT TO BE SCALED. ALL ARCHITECTURAL SYMBOLS INDICATED ON THIS DRAWING ARE GRAPHIC REPRESENTATIONS ONLY.

CONDITIONS FOR ELECTRONIC INFORMATION TRANSFER:

ELECTRONIC INFORMATION IS SUPPLIED TO THE OTHER ASSOCIATED FIRMS TO ASSIST THEM IN THE EXECUTION OF THEIR WORK / REVIEW. THE RECIPIENT FIRMS MUST DETERMINE THE COMPLETENESS / APPROPRIATENESS / RELEVANCE OF THE INFORMATION IN RESPECT TO THEIR PARTICULAR RESPONSIBILITY.

GRAZIANI+CORAZZA ARCHITECTS INC. SHALL NOT BE RESPONSIBLE FOR:
1. ERRORS, OMISSIONS, INCOMPLETENESS DUE TO LOSS OF INFORMATION IN WHOLE OR PART WHEN INFORMATION IS TRANSFERRED.
2. TRANSMISSION OF ANY VIRUS OR DAMAGE TO THE RECEIVING ELECTRONIC SYSTEM WHEN INFORMATION IS TRANSFERRED.

01.	Oct.07.2019	issued for tender	___
02.	Mar.13.2020	issued for design coordination #2	___
03.	Mar.16.2020	issued for addendum #2	___
04.	Mar.16.2020	issued for addendum #3	___
05.	Aug.24.2020	issued for addendum #4	___
06.	Sept. 28.2020	issued for permit	bg
07.	Oct.20.2020	issued for addendum #5	___
08.	Nov.23.2020	issued for addendum #6	___
09.	Dec.14.2020	issued for addendum #7	___
10.	Jan.18.2021	issued for addendum #8	___
11.	Mar. 2. 2021	issued for permit	bg
12.	Mar.09.2021	issued for addendum #9	___
13.	Mar.10.2021	issued for addendum #9R	___
14.	Mar.26.2021	issued for progress	___
15.	May 14. 2021	issued for Site Instruction #1	___
16.	June 15. 2021	issued for Site Instruction #2	___
17.	July. 7. 2021	re-issued for permit	bg
18.	July. 15. 2021	Issued for Site Instruction #3	bg
19.	July. 27. 2021	Issued for Site Instruction #4	bg
20.	Aug. 3. 2021	Issued for Site Instruction #5	bg
21.	Aug. 18. 2021	Issued for Site Instruction #6	bg
22.	Aug. 20. 2021	Re-issued for permit.	bg
23.	Sept. 07. 2021	Issued for Site Instruction #7	bg
24.	Sept. 09. 2021	Issued for Site Instruction #8	bg
25.	Sept. 16. 2021	Issued for Building D Permit Revisions	bg
26.	Sept. 22. 2021	Issued for Site Instruction #9	bg
27.	Oct. 6. 2021	Re-issued for permit.	bg
28.	Oct. 8. 2021	Issued for Site Instruction #10	bg
30.	Oct. 28. 2021	Issued for Site Instruction #11	bg
31.	Nov. 05. 2021	Issued for Site Instruction #12	bg
32.	Dec. 3. 2021	Issued for Site Instruction #13	bg
33.	Dec. 6. 2021	Issued for Site Instruction #14	bg
34.	Dec. 7. 2021	Issued for Site Instruction #15	bg
01.	~~Oct.07.2019~~ Dec.17.2021	~~issued for tender~~ Issued for Addendum 1	bg

issued for revisions

GRAZIANI + CORAZZA ARCHITECTS
1320 SHAWSON DRIVE, SUITE 100 MISSISSAUGA, ONTARIO L4W 1C3
T 905.795.2601 F 905.795.2644 WWW.GC-ARCHITECTS.COM

RESIDENTIAL

ATTMAR + PALLESCHI DRIVE

BRAMPTON	ONTARIO
PROJECT ARCHITECT:	B.GRAZIANI
ASSISTANT DESIGNER:	R.LINCOLN
DRAWN BY:	G.C/F.C/M.B
CHECKED BY:	D.BIASE/G.COLANGELO
PLOT DATE:	DEC.08.2021
JOB #	1331.15

CONCRETE SLAB EDGE 2ND FLOOR PLAN BUILDING C (PARTIAL PLAN)

1:50

CS302c2

TITLEBLOCK SIZE: 915 x 1200

THIS DRAWING, AS AN INSTRUMENT OF SERVICE, IS PROVIDED BY AND IS THE PROPERTY OF GRAZIANI+CORAZZA ARCHITECTS INC. THE CONTRACTOR MUST VERIFY AND ACCEPT RESPONSIBILITY FOR ALL DIMENSIONS AND CONDITIONS ON SITE AND MUST NOTIFY GRAZIANI+CORAZZA ARCHITECTS INC. OF ANY VARIATIONS FROM THE SUPPLIED INFORMATION. GRAZIANI+CORAZZA ARCHITECTS INC. IS NOT RESPONSIBLE FOR THE ACCURACY OF SURVEY, STRUCTURAL, MECHANICAL, ELECTRICAL, AND OTHER ENGINEERING INFORMATION SHOWN ON THIS DRAWING. REFER TO THE APPROPRIATE ENGINEERING DRAWINGS BEFORE PROCEEDING WITH THE WORK. CONSTRUCTION MUST CONFORM TO ALL APPLICABLE CODES AND REQUIREMENTS OF THE AUTHORITIES HAVING JURISDICTION. UNLESS OTHERWISE NOTED, NO INVESTIGATION HAS BEEN UNDERTAKEN OR REPORTED ON BY THIS OFFICE IN REGARDS TO THE ENVIRONMENTAL CONDITION OF THIS SITE.

THIS DRAWING IS NOT TO BE SCALED. ALL ARCHITECTURAL SYMBOLS INDICATED ON THIS DRAWING ARE GRAPHIC REPRESENTATIONS ONLY.

CONDITIONS FOR ELECTRONIC INFORMATION TRANSFER:

ELECTRONIC INFORMATION IS SUPPLIED TO THE OTHER ASSOCIATED FIRMS TO ASSIST THEM IN THE EXECUTION OF THEIR WORK / REVIEW. THE RECIPIENT FIRMS MUST DETERMINE THE COMPLETENESS / APPROPRIATENESS / RELEVANCE OF THE INFORMATION IN RESPECT TO THEIR PARTICULAR RESPONSIBILITY.

GRAZIANI+CORAZZA ARCHITECTS INC. SHALL NOT BE RESPONSIBLE FOR:
1. ERRORS, OMISSIONS, INCOMPLETENESS DUE TO LOSS OF INFORMATION IN WHOLE OR PART WHEN INFORMATION IS TRANSFERRED.
2. TRANSMISSION OF ANY VIRUS OR DAMAGE TO THE RECEIVING ELECTRONIC SYSTEM WHEN INFORMATION IS TRANSFERRED.

01.	Oct.07.2019	issued for tender
02.	Mar.13.2020	issued for design coordination #2
03.	Mar.16.2020	issued for addendum #2
04.	Mar.16.2020	issued for addendum #3
05.	Aug.24.2020	issued for addendum #4
06.	Sept. 28.2020	issued for permit
07.	Oct.20.2020	issued for addendum #5
08.	Nov.23.2020	issued for addendum #6
09.	Dec.14.2020	issued for addendum #7
10.	Jan.18.2021	issued for addendum #8
11.	Mar. 2. 2021	issued for permit
12.	Mar.09.2021	issued for addendum #9
13.	Mar.10.2021	issued for addendum #9R
14.	Mar.26.2021	issued for progress
15.	May 14. 2021	issued for Site Instruction #1
16.	June 15. 2021	issued for Site Instruction #2
17.	July. 7. 2021	re-issued for permit
18.	July. 15. 2021	Issued for Site Instruction #3
19.	July. 27. 2021	Issued for Site Instruction #4
20.	Aug. 3. 2021	Issued for Site Instruction #5
21.	Aug. 18. 2021	Issued for Site Instruction #6
22.	Aug. 20. 2021	Re-issued for permit.
23.	Sept. 07. 2021	Issued for Site Instruction #7
24.	Sept. 09. 2021	Issued for Site Instruction #8
25.	Sept. 16. 2021	Issued for Building D Permit Revisions
26.	Sept. 22. 2021	Issued for Site Instruction #9
27.	Oct. 6. 2021	Re-issued for permit.
28.	Oct. 8. 2021	Issued for Site Instruction #10
30.	Oct. 28. 2021	Issued for Site Instruction #11
31.	Nov. 05. 2021	Issued for Site Instruction #12
32.	Dec. 3. 2021	Issued for Site Instruction #13
33.	Dec. 6. 2021	Issued for Site Instruction #14
34.	Dec. 7. 2021	Issued for Site Instruction #15

01.	SEP 18. 2019	Issued for Adendum 1
01.	Apr.19.2021	issued to client

issued for revisions

GRAZIANI + CORAZZA ARCHITECTS
1320 SHARON DRIVE, SUITE 100, MISSISSAUGA, ONTARIO, L4W 1C3
T 905.799.2600 F 905.799.2644 WWW.GC-ARCHITECTS.COM

RESIDENTIAL

ROYAL PINE

ATTMAR + PALLESCHI DRIVE

BRAMPTON, ONTARIO

PROJECT ARCHITECT:	B.GRAZIANI
ASSISTANT DESIGNER:	R.LINCOLN
DRAWN BY:	G.C/F.C/M.B
CHECKED BY:	D.BIASE/G.COLANGELO
PLOT DATE:	DEC.13.2021
JOB #	1331.15

GROUND FLOOR OVERALL PLAN

1:150

A301

TITLEBLOCK SIZE: 915 x 1200

THIS DRAWING, AS AN INSTRUMENT OF SERVICE, IS PROVIDED BY AND IS THE PROPERTY OF GRAZIANI+CORAZZA ARCHITECTS INC. THE CONTRACTOR MUST VERIFY AND ACCEPT RESPONSIBILITY FOR ALL DIMENSIONS AND CONDITIONS ON SITE AND MUST NOTIFY GRAZIANI+CORAZZA ARCHITECTS INC. OF ANY VARIATIONS FROM THE SUPPLIED INFORMATION. GRAZIANI+CORAZZA ARCHITECTS INC. IS NOT RESPONSIBLE FOR THE ACCURACY OF SURVEY, STRUCTURAL, MECHANICAL, ELECTRICAL, AND OTHER ENGINEERING INFORMATION SHOWN ON THIS DRAWING. REFER TO THE APPROPRIATE ENGINEERING DRAWINGS BEFORE PROCEEDING WITH THE WORK. CONSTRUCTION MUST CONFORM TO ALL APPLICABLE CODES AND REQUIREMENTS OF THE AUTHORITIES HAVING JURISDICTION. UNLESS OTHERWISE NOTED, NO INVESTIGATION HAS BEEN UNDERTAKEN OR REPORTED ON BY THIS OFFICE IN REGARDS TO THE ENVIRONMENTAL CONDITION OF THIS SITE.

THIS DRAWING IS NOT TO BE SCALED. ALL ARCHITECTURAL SYMBOLS INDICATED ON THIS DRAWING ARE GRAPHIC REPRESENTATIONS ONLY.

CONDITIONS FOR ELECTRONIC INFORMATION TRANSFER:

ELECTRONIC INFORMATION IS SUPPLIED TO THE OTHER ASSOCIATED FIRMS TO ASSIST THEM IN THE EXECUTION OF THEIR WORK / REVIEW. THE RECIPIENT FIRMS MUST DETERMINE THE COMPLETENESS / APPROPRIATENESS / RELEVANCE OF THE INFORMATION IN RESPECT TO THEIR PARTICULAR RESPONSIBILITY.

GRAZIANI+CORAZZA ARCHITECTS INC. SHALL NOT BE RESPONSIBLE FOR:
1. ERRORS, OMISSIONS, INCOMPLETENESS DUE TO LOSS OF INFORMATION IN WHOLE OR PART WHEN INFORMATION IS TRANSFERRED.
2. TRANSMISSION OF ANY VIRUS OR DAMAGE TO THE RECEIVING ELECTRONIC SYSTEM WHEN INFORMATION IS TRANSFERRED.

REF.A301d2 FOR CONTINUATION

01.	Oct.07.2019	issued for tender	___
02.	Mar.13.2020	issued for design coordination #2	___
03.	Mar.16.2020	issued for addendum #2	___
04.	Mar.16.2020	issued for addendum #3	___
05.	Aug.24.2020	issued for addendum #4	___
06.	Sept. 28.2020	issued for permit	bg
07.	Oct.20.2020	issued for addendum #5	___
08.	Nov.23.2020	issued for addendum #6	___
09.	Dec.14.2020	issued for addendum #7	___
10.	Jan.18.2021	issued for addendum #8	___
11.	Mar. 2. 2021	issued for permit	bg
12.	Mar.09.2021	issued for addendum #9	___
13.	Mar.10.2021	issued for addendum #9R	___
14.	Mar.26.2021	issued for progress	___
15.	May 14. 2021	issued for Site Instruction #1	___
16.	June 15. 2021	issued for Site Instruction #2	___
17.	July. 7. 2021	re-issued for permit	bg
18.	July. 15. 2021	Issued for Site Instruction #3	bg
19.	July. 27. 2021	Issued for Site Instruction #4	bg
20.	Aug. 3. 2021	Issued for Site Instruction #5	bg
21.	Aug. 18. 2021	Issued for Site Instruction #6	bg
22.	Aug. 20. 2021	Re-issued for permit.	bg
23.	Sept. 07. 2021	Issued for Site Instruction #7	bg
24.	Sept. 09. 2021	Issued for Site Instruction #8	bg
25.	Sept. 16. 2021	Issued for Building D Permit Revisions	bg
26.	Sept. 22. 2021	Issued for Site Instruction #9	bg
27.	Oct. 6. 2021	Re-issued for permit.	bg
28.	Oct. 8. 2021	Issued for Site Instruction #10	bg
30.	Oct. 28. 2021	Issued for Site Instruction #11	bg
31.	Nov. 05. 2021	Issued for Site Instruction #12	bg
32.	Dec. 3. 2021	Issued for Site Instruction #13	bg
33.	Dec. 6. 2021	Issued for Site Instruction #14	bg
34.	Dec. 7. 2021	Issued for Site Instruction #15	bg

01. SEP.13.2019 Issued for Addendum 1 bg

issued for revisions

GRAZIANI + CORAZZA ARCHITECTS
1320 SHAWSON DRIVE, SUITE 100 MISSISSAUGA, ONTARIO L4W 1C5
T 905.795.2601 F 905.795.2644 WWW.GC-ARCHITECTS.COM

RESIDENTIAL

ATTMAR + PALLESCHI DRIVE

BRAMPTON	ONTARIO
PROJECT ARCHITECT:	B.GRAZIANI
ASSISTANT DESIGNER:	R.LINCOLN
DRAWN BY:	G.C/F.C/M.B
CHECKED BY:	D.BIASE/G.COLANGELO
PLOT DATE:	DEC.13.2021
JOB #	1331.15

GROUND FLOOR PLAN
BUILDING A (PARTIAL PLAN)

1:50

A-301a1

TITLEBLOCK SIZE: 915 x 1200

KEY PLAN

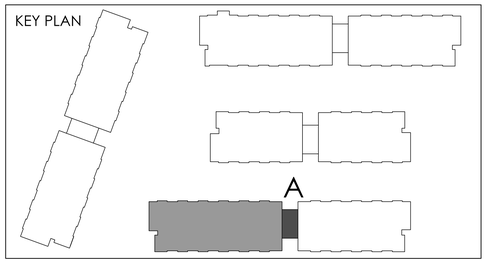

REF.A301d1 FOR CONTINUATION

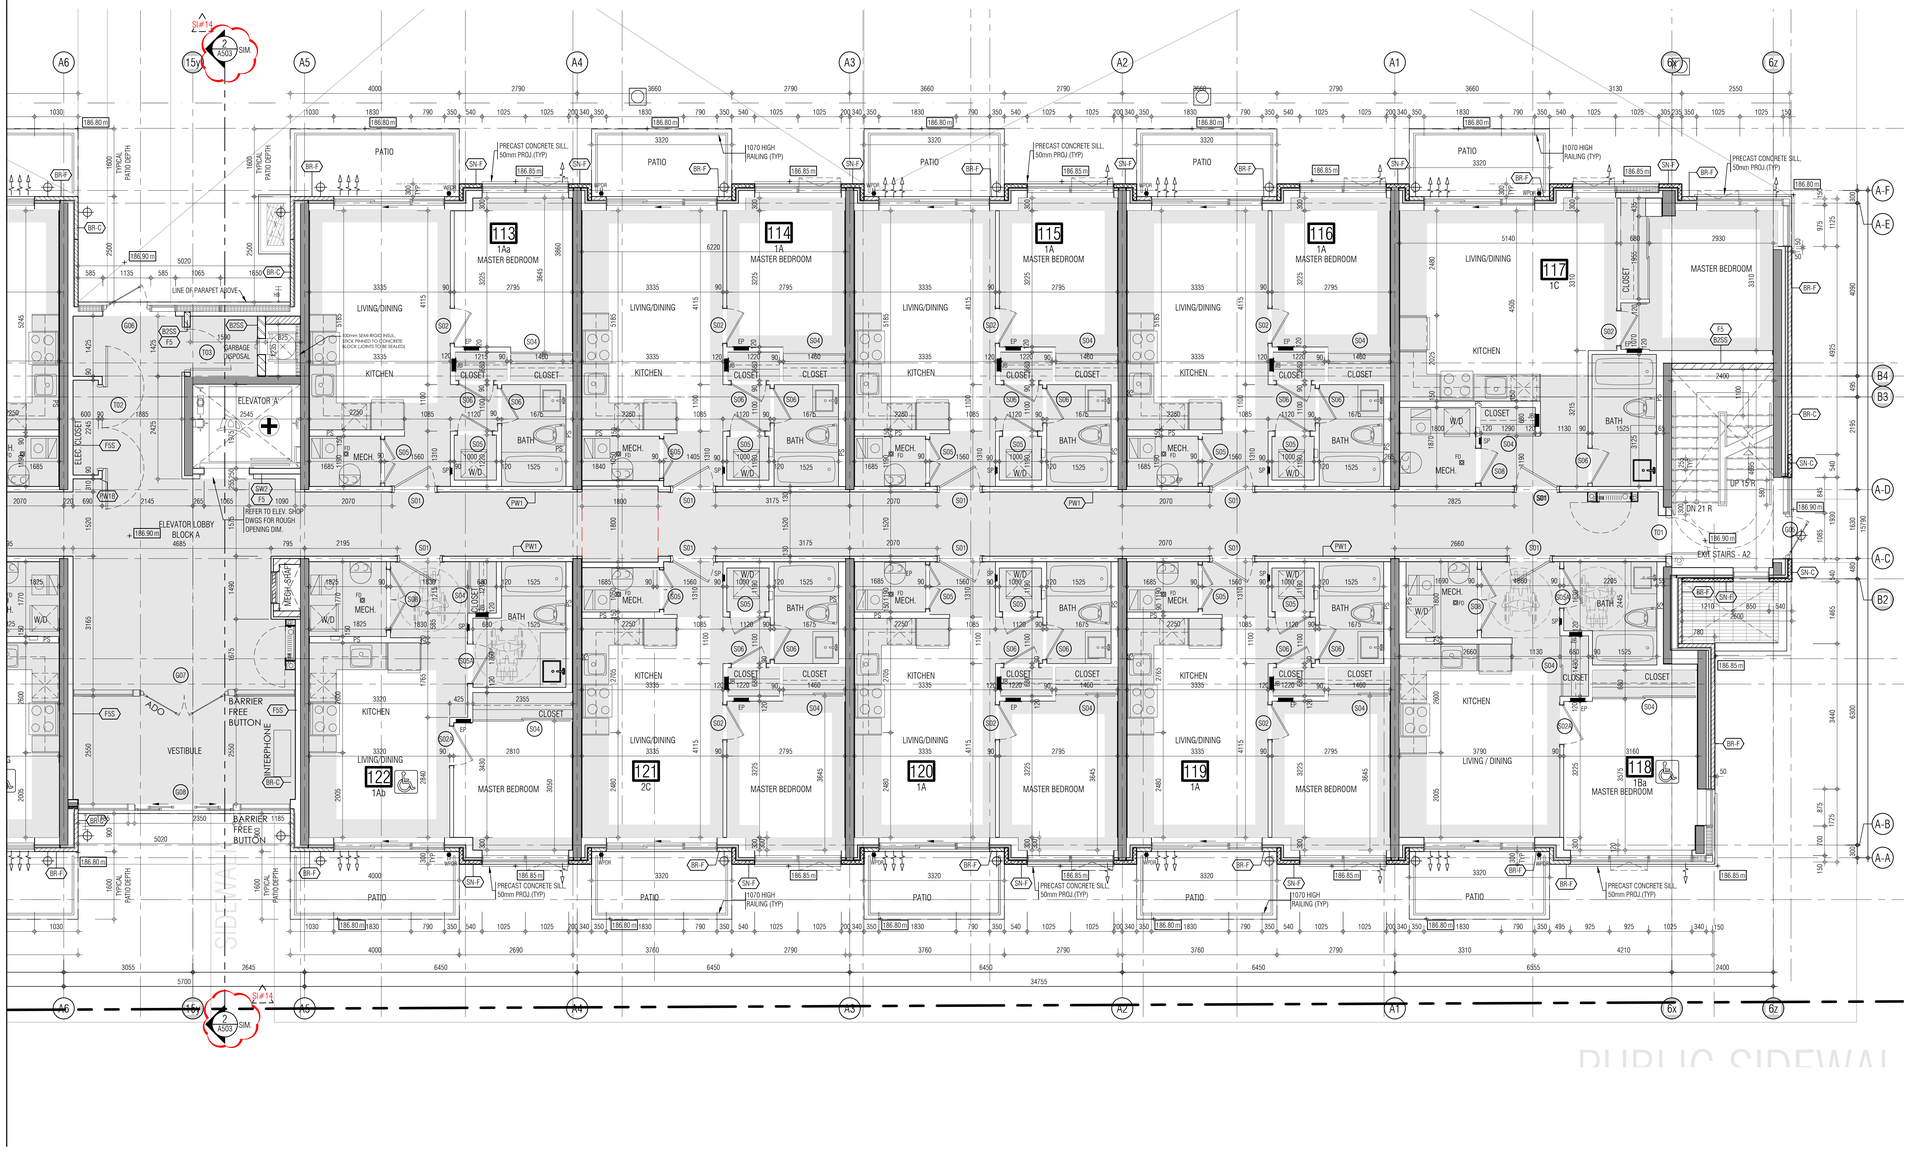

PUBLIC SIDEWALK

THIS DRAWING, AS AN INSTRUMENT OF SERVICE, IS PROVIDED BY AND IS THE PROPERTY OF GRAZIANI+CORAZZA ARCHITECTS INC. THE CONTRACTOR MUST VERIFY AND ACCEPT RESPONSIBILITY FOR ALL DIMENSIONS AND CONDITIONS ON SITE AND MUST NOTIFY GRAZIANI+CORAZZA ARCHITECTS INC. OF ANY VARIATIONS FROM THE SUPPLIED INFORMATION. GRAZIANI+CORAZZA ARCHITECTS INC. IS NOT RESPONSIBLE FOR THE ACCURACY OF SURVEY, STRUCTURAL, MECHANICAL, ELECTRICAL, AND OTHER ENGINEERING INFORMATION SHOWN ON THIS DRAWING. REFER TO THE APPROPRIATE ENGINEERING DRAWINGS BEFORE PROCEEDING WITH THE WORK. CONSTRUCTION MUST CONFORM TO ALL APPLICABLE CODES AND REQUIREMENTS OF THE AUTHORITIES HAVING JURISDICTION. UNLESS OTHERWISE NOTED, NO INVESTIGATION HAS BEEN UNDERTAKEN OR REPORTED ON BY THIS OFFICE IN REGARDS TO THE ENVIRONMENTAL CONDITION OF THIS SITE.

THIS DRAWING IS NOT TO BE SCALED. ALL ARCHITECTURAL SYMBOLS INDICATED ON THIS DRAWING ARE GRAPHIC REPRESENTATIONS ONLY.

CONDITIONS FOR ELECTRONIC INFORMATION TRANSFER:

ELECTRONIC INFORMATION IS SUPPLIED TO THE OTHER ASSOCIATED FIRMS TO ASSIST THEM IN THE EXECUTION OF THEIR WORK / REVIEW. THE RECIPIENT FIRMS MUST DETERMINE THE COMPLETENESS / APPROPRIATENESS / RELEVANCE OF THE INFORMATION IN RESPECT TO THEIR PARTICULAR RESPONSIBILITY.

GRAZIANI+CORAZZA ARCHITECTS INC. SHALL NOT BE RESPONSIBLE FOR:
1. ERRORS, OMISSIONS, INCOMPLETENESS DUE TO LOSS OF INFORMATION IN WHOLE OR PART WHEN INFORMATION IS TRANSFERRED.
2. TRANSMISSION OF ANY VIRUS OR DAMAGE TO THE RECEIVING ELECTRONIC SYSTEM WHEN INFORMATION IS TRANSFERRED.

01.	Oct.07.2019	issued for tender	___
02.	Mar.13.2020	issued for design coordination #2	___
03.	Mar.16.2020	issued for addendum #2	___
04.	Mar.16.2020	issued for addendum #3	___
05.	Aug.24.2020	issued for addendum #4	___
06.	Sept. 28.2020	issued for permit	bg
07.	Oct.20.2020	issued for addendum #5	___
08.	Nov.23.2020	issued for addendum #6	___
09.	Dec.14.2020	issued for addendum #7	___
10.	Jan.18.2021	issued for addendum #8	___
11.	Mar. 2. 2021	issued for permit	bg
12.	Mar.09.2021	issued for addendum #9	___
13.	Mar.10.2021	issued for addendum #9R	___
14.	Mar.26.2021	issued for progress	___
15.	May 14. 2021	issued for Site Instruction #1	___
16.	June 15. 2021	issued for Site Instruction #2	___
17.	July. 7. 2021	re-issued for permit	bg
18.	July. 15. 2021	Issued for Site Instruction #3	bg
19.	July. 27. 2021	Issued for Site Instruction #4	bg
20.	Aug. 3. 2021	Issued for Site Instruction #5	bg
21.	Aug. 18. 2021	Issued for Site Instruction #6	bg
22.	Aug. 20. 2021	Re-issued for permit.	bg
23.	Sept. 07. 2021	Issued for Site Instruction #7	bg
24.	Sept. 09. 2021	Issued for Site Instruction #8	bg
25.	Sept. 16. 2021	Issued for Building D Permit Revisions	bg
26.	Sept. 22. 2021	Issued for Site Instruction #9	bg
27.	Oct. 6. 2021	Re-issued for permit.	bg
28.	Oct. 8. 2021	Issued for Site Instruction #10	bg
30.	Oct. 28. 2021	Issued for Site Instruction #11	bg
31.	Nov. 05. 2021	Issued for Site Instruction #12	bg
32.	Dec. 3. 2021	Issued for Site Instruction #13	bg
33.	Dec. 6. 2021	Issued for Site Instruction #14	bg
34.	Dec. 7. 2021	Issued for Site Instruction #15	bg

01.	SEPT.13.2019	Issued for Addendum 1	bg

issued for revisions

GRAZIANI + CORAZZA ARCHITECTS
1320 SHAWSON DRIVE, SUITE 100 MISSISSAUGA, ONTARIO L4W 1C5
T 905.795.2601 F 905.795.2644 WWW.GC-ARCHITECTS.COM

RESIDENTIAL

ATTMAR + PALLESCHI DRIVE

BRAMPTON	ONTARIO
PROJECT ARCHITECT:	B.GRAZIANI
ASSISTANT DESIGNER:	R.LINCOLN
DRAWN BY:	G.C/F.C/M.B
CHECKED BY:	D.BIASE/G.COLANGELO
PLOT DATE:	DEC.13.2021
JOB #	1331.15

KEY PLAN

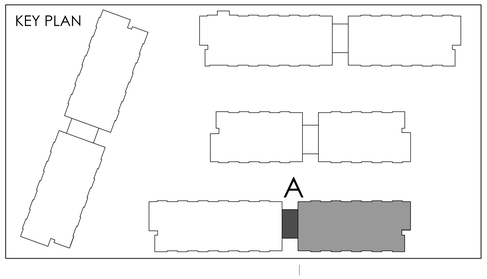

GROUND FLOOR PLAN
BUILDING A (PARTIAL PLAN)

1:50

A-301a2

TITLEBLOCK SIZE: 915 x 1200

THIS DRAWING, AS AN INSTRUMENT OF SERVICE, IS PROVIDED BY AND IS THE PROPERTY OF GRAZIANI+CORAZZA ARCHITECTS INC. THE CONTRACTOR MUST VERIFY AND ACCEPT RESPONSIBILITY FOR ALL DIMENSIONS AND CONDITIONS ON SITE AND MUST NOTIFY GRAZIANI+CORAZZA ARCHITECTS INC. OF ANY VARIATIONS FROM THE SUPPLIED INFORMATION. GRAZIANI+CORAZZA ARCHITECTS INC. IS NOT RESPONSIBLE FOR THE ACCURACY OF SURVEY, STRUCTURAL, MECHANICAL, ELECTRICAL, AND OTHER ENGINEERING INFORMATION SHOWN ON THIS DRAWING. REFER TO THE APPROPRIATE ENGINEERING DRAWINGS BEFORE PROCEEDING WITH THE WORK. CONSTRUCTION MUST CONFORM TO ALL APPLICABLE CODES AND REQUIREMENTS OF THE AUTHORITIES HAVING JURISDICTION. UNLESS OTHERWISE NOTED, NO INVESTIGATION HAS BEEN UNDERTAKEN OR REPORTED ON BY THIS OFFICE IN REGARDS TO THE ENVIRONMENTAL CONDITION OF THIS SITE.

THIS DRAWING IS NOT TO BE SCALED. ALL ARCHITECTURAL SYMBOLS INDICATED ON THIS DRAWING ARE GRAPHIC REPRESENTATIONS ONLY.

CONDITIONS FOR ELECTRONIC INFORMATION TRANSFER:

ELECTRONIC INFORMATION IS SUPPLIED TO THE OTHER ASSOCIATED FIRMS TO ASSIST THEM IN THE EXECUTION OF THEIR WORK / REVIEW. THE RECIPIENT FIRMS MUST DETERMINE THE COMPLETENESS / APPROPRIATENESS / RELEVANCE OF THE INFORMATION IN RESPECT TO THEIR PARTICULAR RESPONSIBILITY.

GRAZIANI+CORAZZA ARCHITECTS INC. SHALL NOT BE RESPONSIBLE FOR:
1. ERRORS, OMISSIONS, INCOMPLETENESS DUE TO LOSS OF INFORMATION IN WHOLE OR PART WHEN INFORMATION IS TRANSFERRED.
2. TRANSMISSION OF ANY VIRUS OR DAMAGE TO THE RECEIVING ELECTRONIC SYSTEM WHEN INFORMATION IS TRANSFERRED.

01.	Oct.07.2019	issued for tender	___
02.	Mar.13.2020	issued for design coordination #2	___
03.	Mar.16.2020	issued for addendum #2	___
04.	Mar.16.2020	issued for addendum #3	___
05.	Aug.24.2020	issued for addendum #4	___
06.	Sept. 28.2020	issued for permit	bg
07.	Oct.20.2020	issued for addendum #5	___
08.	Nov.23.2020	issued for addendum #6	___
09.	Dec.14.2020	issued for addendum #7	___
10.	Jan.18.2021	issued for addendum #8	___
11.	Mar. 2. 2021	issued for permit	bg
12.	Mar.09.2021	issued for addendum #9	___
13.	Mar.10.2021	issued for addendum #9R	___
14.	Mar.26.2021	issued for progress	___
15.	May 14. 2021	issued for Site Instruction #1	___
16.	June 15. 2021	issued for Site Instruction #2	___
17.	July. 7. 2021	re-issued for permit	bg
18.	July. 15. 2021	Issued for Site Instruction #3	bg
19.	July. 27. 2021	Issued for Site Instruction #4	bg
20.	Aug. 3. 2021	Issued for Site Instruction #5	bg
21.	Aug. 18. 2021	Issued for Site Instruction #6	bg
22.	Aug. 20. 2021	Re-issued for permit.	bg
23.	Sept. 07. 2021	Issued for Site Instruction #7	bg
24.	Sept. 09. 2021	Issued for Site Instruction #8	bg
25.	Sept. 16. 2021	Issued for Building D Permit Revisions	bg
26.	Sept. 22. 2021	Issued for Site Instruction #9	bg
27.	Oct. 6. 2021	Re-issued for permit.	bg
28.	Oct. 8. 2021	Issued for Site Instruction #10	bg
30.	Oct. 28. 2021	Issued for Site Instruction #11	bg
31.	Nov. 05. 2021	Issued for Site Instruction #12	bg
32.	Dec. 3. 2021	Issued for Site Instruction #13	bg
33.	Dec. 6. 2021	Issued for Site Instruction #14	bg
34.	Dec. 7. 2021	Issued for Site Instruction #15	bg

01. SEPT.22.2019 Issued for Addendum 1 bg

issued for revisions

GRAZIANI CORAZZA ARCHITECTS
1320 SHARON DRIVE SUITE 100 MISSISSAUGA ONTARIO L4W 1C3
T.905.795.2601 F.905.795.2644 WWW.GC-ARCHITECTS.COM

RESIDENTIAL

ATTMAR + PALLESCHI DRIVE

BRAMPTON	ONTARIO
PROJECT ARCHITECT:	B.GRAZIANI
ASSISTANT DESIGNER:	R.LINCOLN
DRAWN BY:	G.C/F.C/M.B
CHECKED BY:	D.BIASE/G.COLANGELO
PLOT DATE:	DEC.13.2021
JOB #	1331.15

KEY PLAN

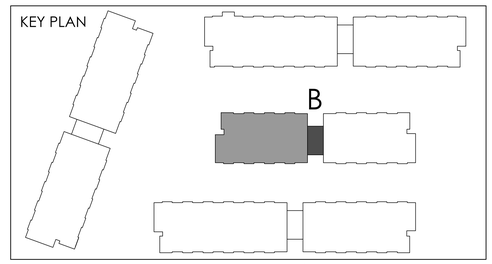

GROUND FLOOR PLAN
BUILDING B (PARTIAL PLAN)

1:50

A-301b1

TITLEBLOCK SIZE: 915 x 1200

REF.A301c1 FOR CONTINUATION

THIS DRAWING, AS AN INSTRUMENT OF SERVICE, IS PROVIDED BY AND IS THE PROPERTY OF GRAZIANI+CORAZZA ARCHITECTS INC. THE CONTRACTOR MUST VERIFY AND ACCEPT RESPONSIBILITY FOR ALL DIMENSIONS AND CONDITIONS ON SITE AND MUST NOTIFY GRAZIANI+CORAZZA ARCHITECTS INC. OF ANY VARIATIONS FROM THE SUPPLIED INFORMATION. GRAZIANI+CORAZZA ARCHITECTS INC. IS NOT RESPONSIBLE FOR THE ACCURACY OF SURVEY, STRUCTURAL, MECHANICAL, ELECTRICAL, AND OTHER ENGINEERING INFORMATION SHOWN ON THIS DRAWING. REFER TO THE APPROPRIATE ENGINEERING DRAWINGS BEFORE PROCEEDING WITH THE WORK. CONSTRUCTION MUST CONFORM TO ALL APPLICABLE CODES AND REQUIREMENTS OF THE AUTHORITIES HAVING JURISDICTION. UNLESS OTHERWISE NOTED, NO INVESTIGATION HAS BEEN UNDERTAKEN OR REPORTED ON BY THIS OFFICE IN REGARDS TO THE ENVIRONMENTAL CONDITION OF THIS SITE.

THIS DRAWING IS NOT TO BE SCALED. ALL ARCHITECTURAL SYMBOLS INDICATED ON THIS DRAWING ARE GRAPHIC REPRESENTATIONS ONLY.

CONDITIONS FOR ELECTRONIC INFORMATION TRANSFER:

ELECTRONIC INFORMATION IS SUPPLIED TO THE OTHER ASSOCIATED FIRMS TO ASSIST THEM IN THE EXECUTION OF THEIR WORK / REVIEW. THE RECIPIENT FIRMS MUST DETERMINE THE COMPLETENESS / APPROPRIATENESS / RELEVANCE OF THE INFORMATION IN RESPECT TO THEIR PARTICULAR RESPONSIBILITY.

GRAZIANI+CORAZZA ARCHITECTS INC. SHALL NOT BE RESPONSIBLE FOR:
1. ERRORS, OMISSIONS, INCOMPLETENESS DUE TO LOSS OF INFORMATION IN WHOLE OR PART WHEN INFORMATION IS TRANSFERRED.
2. TRANSMISSION OF ANY VIRUS OR DAMAGE TO THE RECEIVING ELECTRONIC SYSTEM WHEN INFORMATION IS TRANSFERRED.

01.	Oct.07.2019	issued for tender	___
02.	Mar.13.2020	issued for design coordination #2	___
03.	Mar.16.2020	issued for addendum #2	___
04.	Mar.16.2020	issued for addendum #3	___
05.	Aug.24.2020	issued for addendum #4	___
06.	Sept. 28.2020	issued for permit	bg
07.	Oct.20.2020	issued for addendum #5	___
08.	Nov.23.2020	issued for addendum #6	___
09.	Dec.14.2020	issued for addendum #7	___
10.	Jan.18.2021	issued for addendum #8	___
11.	Mar. 2. 2021	issued for permit	bg
12.	Mar.09.2021	issued for addendum #9	___
13.	Mar.10.2021	issued for addendum #9R	___
14.	Mar.26.2021	issued for progress	___
15.	May 14. 2021	issued for Site Instruction #1	___
16.	June 15. 2021	issued for Site Instruction #2	___
17.	July. 7. 2021	re-issued for permit	bg
18.	July. 15. 2021	Issued for Site Instruction #3	bg
19.	July. 27. 2021	Issued for Site Instruction #4	bg
20.	Aug. 3. 2021	Issued for Site Instruction #5	bg
21.	Aug. 18. 2021	Issued for Site Instruction #6	bg
22.	Aug. 20. 2021	Re-issued for permit.	bg
23.	Sept. 07. 2021	Issued for Site Instruction #7	bg
24.	Sept. 09. 2021	Issued for Site Instruction #8	bg
25.	Sept. 16. 2021	Issued for Building D Permit Revisions	bg
26.	Sept. 22. 2021	Issued for Site Instruction #9	bg
27.	Oct. 6. 2021	Re-issued for permit.	bg
28.	Oct. 8. 2021	Issued for Site Instruction #10	bg
30.	Oct. 28. 2021	Issued for Site Instruction #11	bg
31.	Nov. 05. 2021	Issued for Site Instruction #12	bg
32.	Dec. 3. 2021	Issued for Site Instruction #13	bg
33.	Dec. 6. 2021	Issued for Site Instruction #14	bg
34.	Dec. 7. 2021	Issued for Site Instruction #15	bg

01. SEPT.15.2021 Issued for Addendum 1 bg

issued for revisions

GRAZIANI + CORAZZA ARCHITECTS
1320 SHAWSON DRIVE, SUITE 100 MISSISSAUGA, ONTARIO L4W 1C3
T 905.795.2601 F 905.795.2644 WWW.GC-ARCHITECTS.COM

RESIDENTIAL

ATTMAR + PALLESCHI DRIVE

BRAMPTON	ONTARIO
PROJECT ARCHITECT:	B.GRAZIANI
ASSISTANT DESIGNER:	R.LINCOLN
DRAWN BY:	G.C/F.C/M.B
CHECKED BY:	D.BIASE/G.COLANGELO
PLOT DATE:	DEC.13.2021
JOB #	1331.15

KEY PLAN

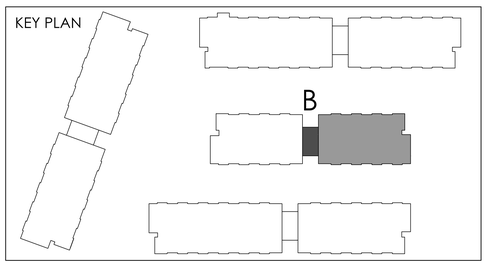

GROUND FLOOR PLAN
BUILDING B (PARTIAL PLAN)

1:50

A-301b2

TITLEBLOCK SIZE: 915 x 1200

THIS DRAWING, AS AN INSTRUMENT OF SERVICE, IS PROVIDED BY AND IS THE PROPERTY OF GRAZIANI+CORAZZA ARCHITECTS INC. THE CONTRACTOR MUST VERIFY AND ACCEPT RESPONSIBILITY FOR ALL DIMENSIONS AND CONDITIONS ON SITE AND MUST NOTIFY GRAZIANI+CORAZZA ARCHITECTS INC. OF ANY VARIATIONS FROM THE SUPPLIED INFORMATION. GRAZIANI+CORAZZA ARCHITECTS INC. IS NOT RESPONSIBLE FOR THE ACCURACY OF SURVEY, STRUCTURAL, MECHANICAL, ELECTRICAL, AND OTHER ENGINEERING INFORMATION SHOWN ON THIS DRAWING. REFER TO THE APPROPRIATE ENGINEERING DRAWINGS BEFORE PROCEEDING WITH THE WORK. CONSTRUCTION MUST CONFORM TO ALL APPLICABLE CODES AND REQUIREMENTS OF THE AUTHORITIES HAVING JURISDICTION. UNLESS OTHERWISE NOTED, NO INVESTIGATION HAS BEEN UNDERTAKEN OR REPORTED ON BY THIS OFFICE IN REGARDS TO THE ENVIRONMENTAL CONDITION OF THIS SITE.

THIS DRAWING IS NOT TO BE SCALED. ALL ARCHITECTURAL SYMBOLS INDICATED ON THIS DRAWING ARE GRAPHIC REPRESENTATIONS ONLY.

CONDITIONS FOR ELECTRONIC INFORMATION TRANSFER:

ELECTRONIC INFORMATION IS SUPPLIED TO THE OTHER ASSOCIATED FIRMS TO ASSIST THEM IN THE EXECUTION OF THEIR WORK / REVIEW. THE RECIPIENT FIRMS MUST DETERMINE THE COMPLETENESS / APPROPRIATENESS / RELEVANCE OF THE INFORMATION IN RESPECT TO THEIR PARTICULAR RESPONSIBILITY.

GRAZIANI + CORAZZA ARCHITECTS INC. SHALL NOT BE RESPONSIBLE FOR:
1. ERRORS, OMISSIONS, INCOMPLETENESS DUE TO LOSS OF INFORMATION IN WHOLE OR PART WHEN INFORMATION IS TRANSFERRED.
2. TRANSMISSION OF ANY VIRUS OR DAMAGE TO THE RECEIVING ELECTRONIC SYSTEM WHEN INFORMATION IS TRANSFERRED.

REF. A301b2 FOR CONTINUATION

01.	Oct.07.2019	issued for tender	___
02.	Mar.13.2020	issued for design coordination #2	___
03.	Mar.16.2020	issued for addendum #2	___
04.	Mar.16.2020	issued for addendum #3	___
05.	Aug.24.2020	issued for addendum #4	___
06.	Sept. 28.2020	issued for permit	bg
07.	Oct.20.2020	issued for addendum #5	___
08.	Nov.23.2020	issued for addendum #6	___
09.	Dec.14.2020	issued for addendum #7	___
10.	Jan.18.2021	issued for addendum #8	___
11.	Mar. 2. 2021	issued for permit	bg
12.	Mar.09.2021	issued for addendum #9	___
13.	Mar.10.2021	issued for addendum #9R	___
14.	Mar.26.2021	issued for progress	___
15.	May 14. 2021	issued for Site Instruction #1	___
16.	June 15. 2021	issued for Site Instruction #2	___
17.	July. 7. 2021	re-issued for permit	bg
18.	July. 15. 2021	Issued for Site Instruction #3	bg
19.	July. 27. 2021	Issued for Site Instruction #4	bg
20.	Aug. 3. 2021	Issued for Site Instruction #5	bg
21.	Aug. 18. 2021	Issued for Site Instruction #6	bg
22.	Aug. 20. 2021	Re-issued for permit.	bg
23.	Sept. 07. 2021	Issued for Site Instruction #7	bg
24.	Sept. 09. 2021	Issued for Site Instruction #8	bg
25.	Sept. 16. 2021	Issued for Building D Permit Revisions	bg
26.	Sept. 22. 2021	Issued for Site Instruction #9	bg
27.	Oct. 6. 2021	Re-issued for permit.	bg
28.	Oct. 8. 2021	Issued for Site Instruction #10	bg
30.	Oct. 28. 2021	Issued for Site Instruction #11	bg
31.	Nov. 05. 2021	Issued for Site Instruction #12	bg
32.	Dec. 3. 2021	Issued for Site Instruction #13	bg
33.	Dec. 6. 2021	Issued for Site Instruction #14	bg
34.	Dec. 7. 2021	Issued for Site Instruction #15	bg

01. SEPT.13.2019 Issued for addendum 1 bg

issued for revisions

GRAZIANI + CORAZZA ARCHITECTS
1320 SHAWSON DRIVE, SUITE 100 MISSISSAUGA ONTARIO L4W 1C3
T 905.795.2601 F 905.795.2644 WWW.GC-ARCHITECTS.COM

RESIDENTIAL

ATTMAR + PALLESCHI DRIVE

BRAMPTON	ONTARIO
PROJECT ARCHITECT:	B.GRAZIANI
ASSISTANT DESIGNER:	R.LINCOLN
DRAWN BY:	G.C/F.C/M.B
CHECKED BY:	D.BIASE/G.COLANGELO
PLOT DATE:	DEC.13.2021
JOB #	1331.15

KEY PLAN

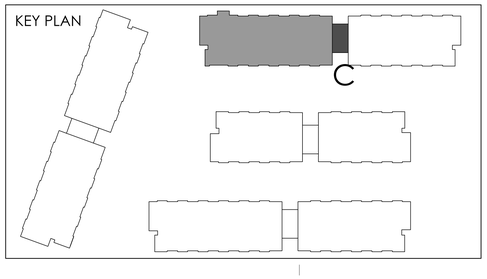

GROUND FLOOR PLAN
BUILDING C (PARTIAL PLAN)

1:50

A-301c1

TITLEBLOCK SIZE: 915 x 1200

REF. A301b1 FOR CONTINUATION

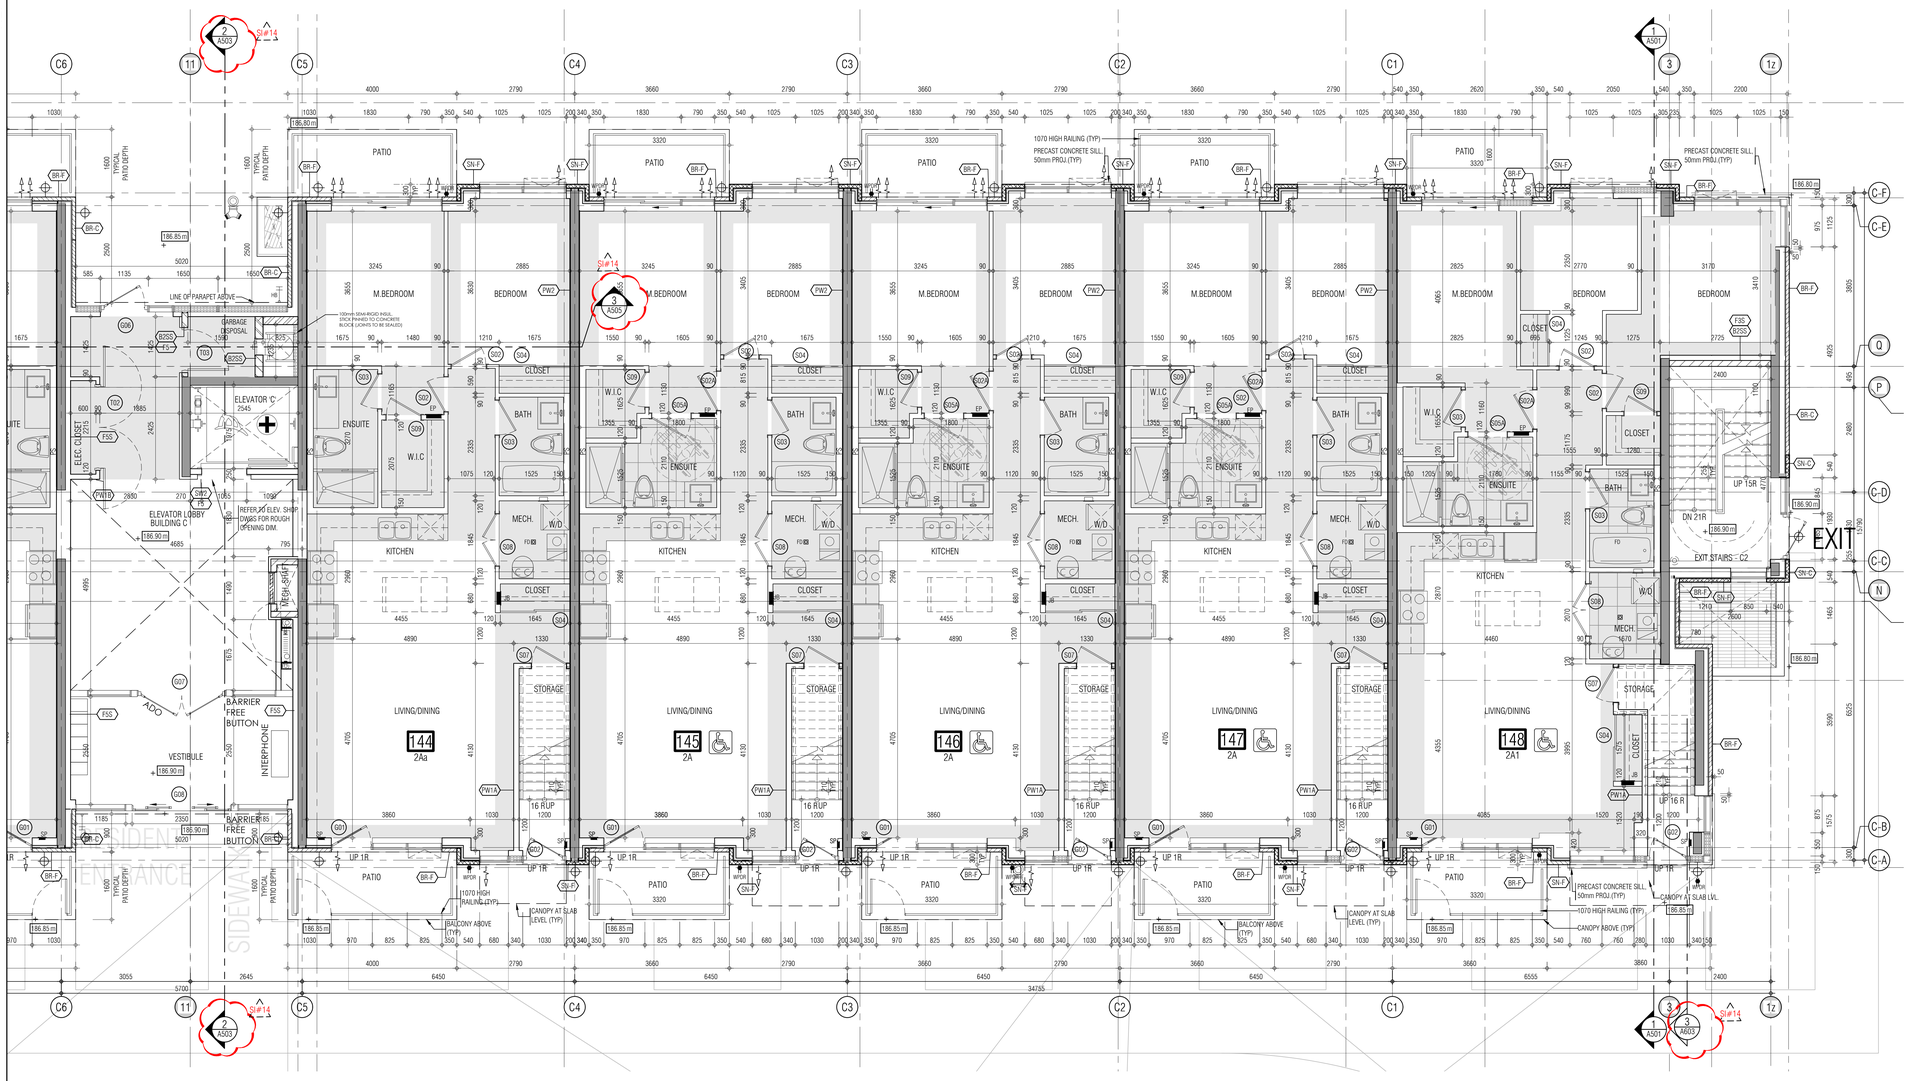

THIS DRAWING, AS AN INSTRUMENT OF SERVICE, IS PROVIDED BY AND IS THE PROPERTY OF GRAZIANI+CORAZZA ARCHITECTS INC. THE CONTRACTOR MUST VERIFY AND ACCEPT RESPONSIBILITY FOR ALL DIMENSIONS AND CONDITIONS ON SITE AND MUST NOTIFY GRAZIANI+CORAZZA ARCHITECTS INC. OF ANY VARIATIONS FROM THE SUPPLIED INFORMATION. GRAZIANI+CORAZZA ARCHITECTS INC. IS NOT RESPONSIBLE FOR THE ACCURACY OF SURVEY, STRUCTURAL, MECHANICAL, ELECTRICAL, AND OTHER ENGINEERING INFORMATION SHOWN ON THIS DRAWING. REFER TO THE APPROPRIATE ENGINEERING DRAWINGS BEFORE PROCEEDING WITH THE WORK. CONSTRUCTION MUST CONFORM TO ALL APPLICABLE CODES AND REQUIREMENTS OF THE AUTHORITIES HAVING JURISDICTION. UNLESS OTHERWISE NOTED, NO INVESTIGATION HAS BEEN UNDERTAKEN OR REPORTED ON BY THIS OFFICE IN REGARDS TO THE ENVIRONMENTAL CONDITION OF THIS SITE.

THIS DRAWING IS NOT TO BE SCALED. ALL ARCHITECTURAL SYMBOLS INDICATED ON THIS DRAWING ARE GRAPHIC REPRESENTATIONS ONLY.

CONDITIONS FOR ELECTRONIC INFORMATION TRANSFER:

ELECTRONIC INFORMATION IS SUPPLIED TO THE OTHER ASSOCIATED FIRMS TO ASSIST THEM IN THE EXECUTION OF THEIR WORK / REVIEW. THE RECIPIENT FIRMS MUST DETERMINE THE COMPLETENESS / APPROPRIATENESS / RELEVANCE OF THE INFORMATION IN RESPECT TO THEIR PARTICULAR RESPONSIBILITY.

GRAZIANI+CORAZZA ARCHITECTS INC. SHALL NOT BE RESPONSIBLE FOR:
1. ERRORS, OMISSIONS, INCOMPLETENESS DUE TO LOSS OF INFORMATION IN WHOLE OR PART WHEN INFORMATION IS TRANSFERRED.
2. TRANSMISSION OF ANY VIRUS OR DAMAGE TO THE RECEIVING ELECTRONIC SYSTEM WHEN INFORMATION IS TRANSFERRED.

01.	Oct.07.2019 issued for tender	___
02.	Mar.13.2020 issued for design coordination #2	___
03.	Mar.16.2020 issued for addendum #2	___
04.	Mar.16.2020 issued for addendum #3	___
05.	Aug.24.2020 issued for addendum #4	___
06.	Sept. 28.2020 issued for permit	bg
07.	Oct.20.2020 issued for addendum #5	___
08.	Nov.23.2020 issued for addendum #6	___
09.	Dec.14.2020 issued for addendum #7	___
10.	Jan.18.2021 issued for addendum #8	___
11.	Mar. 2. 2021 issued for permit	bg
12.	Mar.09.2021 issued for addendum #9	___
13.	Mar.10.2021 issued for addendum #9R	___
14.	Mar.26.2021 issued for progress	___
15.	May 14. 2021 issued for Site Instruction #1	___
16.	June 15. 2021 issued for Site Instruction #2	___
17.	July. 7. 2021 re-issued for permit	bg
18.	July. 15. 2021 Issued for Site Instruction #3	bg
19.	July. 27. 2021 Issued for Site Instruction #4	bg
20.	Aug. 3. 2021 Issued for Site Instruction #5	bg
21.	Aug. 18. 2021 Issued for Site Instruction #6	bg
22.	Aug. 20. 2021 Re-issued for permit.	bg
23.	Sept. 07. 2021 Issued for Site Instruction #7	bg
24.	Sept. 09. 2021 Issued for Site Instruction #8	bg
25.	Sept. 16. 2021 Issued for Building D Permit Revisions	bg
26.	Sept. 22. 2021 Issued for Site Instruction #9	bg
27.	Oct. 6. 2021 Re-issued for permit.	bg
28.	Oct. 8. 2021 Issued for Site Instruction #10	bg
30.	Oct. 28. 2021 Issued for Site Instruction #11	bg
31.	Nov. 05. 2021 Issued for Site Instruction #12	bg
32.	Dec. 3. 2021 Issued for Site Instruction #13	bg
33.	Dec. 6. 2021 Issued for Site Instruction #14	bg
34.	Dec. 7. 2021 Issued for Site Instruction #15	bg

01.	SEPT.22.2019 Issued for Addendum 1	bg

issued for revisions

GRAZIANI + CORAZZA ARCHITECTS
1320 SHARON DRIVE, SUITE 100, MISSISSAUGA, ONTARIO, L4W 1C3
T.905.795.7601 F.905.795.2844 WWW.GC-ARCHITECTS.COM

RESIDENTIAL

ATTMAR + PALLESCHI DRIVE

BRAMPTON	ONTARIO
PROJECT ARCHITECT:	B.GRAZIANI
ASSISTANT DESIGNER:	R.LINCOLN
DRAWN BY:	G.C/F.C/M.B
CHECKED BY:	D.BIASE/G.COLANGELO
PLOT DATE:	DEC.13.2021
JOB #:	1331.15

KEY PLAN

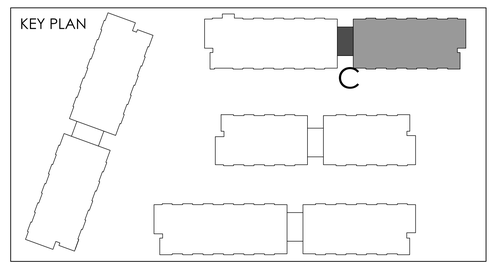

GROUND FLOOR PLAN
BUILDING C (PARTIAL PLAN)

1:50

A-301c2

TITLEBLOCK SIZE: 915 x 1200

THIS DRAWING, AS AN INSTRUMENT OF SERVICE, IS PROVIDED BY AND IS THE PROPERTY OF GRAZIANI+CORAZZA ARCHITECTS INC. THE CONTRACTOR MUST VERIFY AND ACCEPT RESPONSIBILITY FOR ALL DIMENSIONS AND CONDITIONS ON SITE AND MUST NOTIFY GRAZIANI+CORAZZA ARCHITECTS INC. OF ANY VARIATIONS FROM THE SUPPLIED INFORMATION. GRAZIANI+CORAZZA ARCHITECTS INC. IS NOT RESPONSIBLE FOR THE ACCURACY OF SURVEY, STRUCTURAL, MECHANICAL, ELECTRICAL, AND OTHER ENGINEERING INFORMATION SHOWN ON THIS DRAWING. REFER TO THE APPROPRIATE ENGINEERING DRAWINGS BEFORE PROCEEDING WITH THE WORK. CONSTRUCTION MUST CONFORM TO ALL APPLICABLE CODES AND REQUIREMENTS OF THE AUTHORITIES HAVING JURISDICTION. UNLESS OTHERWISE NOTED, NO INVESTIGATION HAS BEEN UNDERTAKEN OR REPORTED ON BY THIS OFFICE IN REGARDS TO THE ENVIRONMENTAL CONDITION OF THIS SITE.

THIS DRAWING IS NOT TO BE SCALED. ALL ARCHITECTURAL SYMBOLS INDICATED ON THIS DRAWING ARE GRAPHIC REPRESENTATIONS ONLY.

CONDITIONS FOR ELECTRONIC INFORMATION TRANSFER:

ELECTRONIC INFORMATION IS SUPPLIED TO THE OTHER ASSOCIATED FIRMS TO ASSIST THEM IN THE EXECUTION OF THEIR WORK / REVIEW. THE RECIPIENT FIRMS MUST DETERMINE THE COMPLETENESS / APPROPRIATENESS / RELEVANCE OF THE INFORMATION IN RESPECT TO THEIR PARTICULAR RESPONSIBILITY.

GRAZIANI+CORAZZA ARCHITECTS INC. SHALL NOT BE RESPONSIBLE FOR:
1. ERRORS, OMISSIONS, INCOMPLETENESS DUE TO LOSS OF INFORMATION IN WHOLE OR PART WHEN INFORMATION IS TRANSFERRED.
2. TRANSMISSION OF ANY VIRUS OR DAMAGE TO THE RECEIVING ELECTRONIC SYSTEM WHEN INFORMATION IS TRANSFERRED.

REF. A301a2 FOR CONTINUATION

01.	Oct.07.2019	issued for tender	___
02.	Mar.13.2020	issued for design coordination #2	___
03.	Mar.16.2020	issued for addendum #2	___
04.	Mar.16.2020	issued for addendum #3	___
05.	Aug.24.2020	issued for addendum #4	___
06.	Sept. 28.2020	issued for permit	bg
07.	Oct.20.2020	issued for addendum #5	___
08.	Nov.23.2020	issued for addendum #6	___
09.	Dec.14.2020	issued for addendum #7	___
10.	Jan.18.2021	issued for addendum #8	___
11.	Mar. 2. 2021	issued for permit	bg
12.	Mar.09.2021	issued for addendum #9	___
13.	Mar.10.2021	issued for addendum #9R	___
14.	Mar.26.2021	issued for progress	___
15.	May 14. 2021	issued for Site Instruction #1	___
16.	June 15. 2021	issued for Site Instruction #2	___
17.	July. 7. 2021	re-issued for permit	bg
18.	July. 15. 2021	Issued for Site Instruction #3	bg
19.	July. 27. 2021	Issued for Site Instruction #4	bg
20.	Aug. 3. 2021	Issued for Site Instruction #5	bg
21.	Aug. 18. 2021	Issued for Site Instruction #6	bg
22.	Aug. 20. 2021	Re-issued for permit.	bg
23.	Sept. 07. 2021	Issued for Site Instruction #7	bg
24.	Sept. 09. 2021	Issued for Site Instruction #8	bg
25.	Sept. 16. 2021	Issued for Building D Permit Revisions	bg
26.	Sept. 22. 2021	Issued for Site Instruction #9	bg
27.	Oct. 6. 2021	Re-issued for permit.	bg
28.	Oct. 8. 2021	Issued for Site Instruction #10	bg
30.	Oct. 28. 2021	Issued for Site Instruction #11	bg
31.	Nov. 05. 2021	Issued for Site Instruction #12	bg
32.	Dec. 3. 2021	Issued for Site Instruction #13	bg
33.	Dec. 6. 2021	Issued for Site Instruction #14	bg
34.	Dec. 7. 2021	Issued for Site Instruction #15	bg

01. SEPT.12.2019 Issued for Addendum 1 bg

issued for revisions

GRAZIANI + CORAZZA ARCHITECTS
1320 SHARON DRIVE, SUITE 100 MISSISSAUGA, ONTARIO L4W 1C3
T.905.795.7601 F.905.795.2844 WWW.GC-ARCHITECTS.COM

RESIDENTIAL

ATTMAR + PALLESCHI DRIVE

BRAMPTON	ONTARIO
PROJECT ARCHITECT:	B.GRAZIANI
ASSISTANT DESIGNER:	R.LINCOLN
DRAWN BY:	G.C/F.C/M.B
CHECKED BY:	D.BIASE/G.COLANGELO
PLOT DATE:	DEC.13.2021
JOB #:	1331.15

GROUND FLOOR PLAN
BUILDING D (PARTIAL PLAN)

1:50

A-301d1

TITLEBLOCK SIZE: 915 x 1200

KEY PLAN

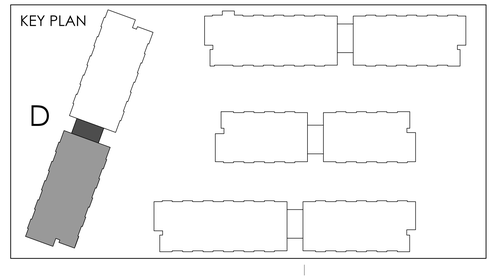

REF. A301a1 FOR CONTINUATION

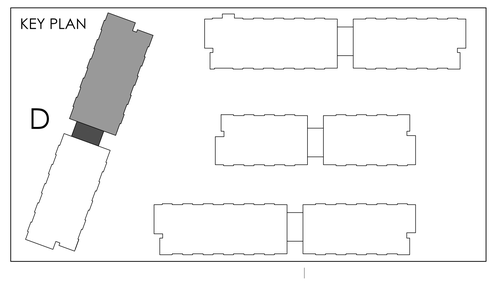

THIS DRAWING, AS AN INSTRUMENT OF SERVICE, IS PROVIDED BY AND IS THE PROPERTY OF GRAZIANI+CORAZZA ARCHITECTS INC. THE CONTRACTOR MUST VERIFY AND ACCEPT RESPONSIBILITY FOR ALL DIMENSIONS AND CONDITIONS ON SITE AND MUST NOTIFY GRAZIANI+CORAZZA ARCHITECTS INC. OF ANY VARIATIONS FROM THE SUPPLIED INFORMATION. GRAZIANI+CORAZZA ARCHITECTS INC. IS NOT RESPONSIBLE FOR THE ACCURACY OF SURVEY, STRUCTURAL, MECHANICAL, ELECTRICAL, AND OTHER ENGINEERING INFORMATION SHOWN ON THIS DRAWING. REFER TO THE APPROPRIATE ENGINEERING DRAWINGS BEFORE PROCEEDING WITH THE WORK. CONSTRUCTION MUST CONFORM TO ALL APPLICABLE CODES AND REQUIREMENTS OF THE AUTHORITIES HAVING JURISDICTION. UNLESS OTHERWISE NOTED, NO INVESTIGATION HAS BEEN UNDERTAKEN OR REPORTED ON BY THIS OFFICE IN REGARDS TO THE ENVIRONMENTAL CONDITION OF THIS SITE.

THIS DRAWING IS NOT TO BE SCALED. ALL ARCHITECTURAL SYMBOLS INDICATED ON THIS DRAWING ARE GRAPHIC REPRESENTATIONS ONLY.

CONDITIONS FOR ELECTRONIC INFORMATION TRANSFER:

ELECTRONIC INFORMATION IS SUPPLIED TO THE OTHER ASSOCIATED FIRMS TO ASSIST THEM IN THE EXECUTION OF THEIR WORK / REVIEW. THE RECIPIENT FIRMS MUST DETERMINE THE COMPLETENESS / APPROPRIATENESS / RELEVANCE OF THE INFORMATION IN RESPECT TO THEIR PARTICULAR RESPONSIBILITY.

GRAZIANI+CORAZZA ARCHITECTS INC. SHALL NOT BE RESPONSIBLE FOR:
1. ERRORS, OMISSIONS, INCOMPLETENESS DUE TO LOSS OF INFORMATION IN WHOLE OR PART WHEN INFORMATION IS TRANSFERRED.
2. TRANSMISSION OF ANY VIRUS OR DAMAGE TO THE RECEIVING ELECTRONIC SYSTEM WHEN INFORMATION IS TRANSFERRED.

01.	Oct.07.2019	issued for tender	___
02.	Mar.13.2020	issued for design coordination #2	___
03.	Mar.16.2020	issued for addendum #2	___
04.	Mar.16.2020	issued for addendum #3	___
05.	Aug.24.2020	issued for addendum #4	___
06.	Sept. 28.2020	issued for permit	bg
07.	Oct.20.2020	issued for addendum #5	___
08.	Nov.23.2020	issued for addendum #6	___
09.	Dec.14.2020	issued for addendum #7	___
10.	Jan.18.2021	issued for addendum #8	___
11.	Mar. 2. 2021	issued for permit	bg
12.	Mar.09.2021	issued for addendum #9	___
13.	Mar.10.2021	issued for addendum #9R	___
14.	Mar.26.2021	issued for progress	___
15.	May 14. 2021	issued for Site Instruction #1	___
16.	June 15. 2021	issued for Site Instruction #2	___
17.	July. 7. 2021	re-issued for permit	bg
18.	July. 15. 2021	Issued for Site Instruction #3	bg
19.	July. 27. 2021	Issued for Site Instruction #4	bg
20.	Aug. 3. 2021	Issued for Site Instruction #5	bg
21.	Aug. 18. 2021	Issued for Site Instruction #6	bg
22.	Aug. 20. 2021	Re-issued for permit.	bg
23.	Sept. 07. 2021	Issued for Site Instruction #7	bg
24.	Sept. 09. 2021	Issued for Site Instruction #8	bg
25.	Sept. 16. 2021	Issued for Building D Permit Revisions	bg
26.	Sept. 22. 2021	Issued for Site Instruction #9	bg
27.	Oct. 6. 2021	Re-issued for permit.	bg
28.	Oct. 8. 2021	Issued for Site Instruction #10	bg
30.	Oct. 28. 2021	Issued for Site Instruction #11	bg
31.	Nov. 05. 2021	Issued for Site Instruction #12	bg
32.	Dec. 3. 2021	Issued for Site Instruction #13	bg
33.	Dec. 6. 2021	Issued for Site Instruction #14	bg
34.	Dec. 7. 2021	Issued for Site Instruction #15	bg

01.	SEPT.22.2021	Issued for Addendum 1	bg

issued for revisions

GRAZIANI CORAZZA ARCHITECTS
1320 SHERATON DRIVE, SUITE 100, MISSISSAUGA, ONTARIO, L4W 1C3
T.905.795.2601 F.905.795.2644 WWW.GC-ARCHITECTS.COM

RESIDENTIAL

ATTMAR + PALLESCHI DRIVE

BRAMPTON ONTARIO

PROJECT ARCHITECT:	B.GRAZIANI
ASSISTANT DESIGNER:	R.LINCOLN
DRAWN BY:	G.C./F.C./M.B
CHECKED BY:	D.BIASE/G.COLANGELO
PLOT DATE:	DEC.13.2021
JOB #:	1331.15

GROUND FLOOR PLAN BUILDING D (PARTIAL PLAN)

1:50

A-301d2

TITLEBLOCK SIZE: 915 x 1200

THIS DRAWING, AS AN INSTRUMENT OF SERVICE, IS PROVIDED BY AND IS THE PROPERTY OF GRAZIANI+CORAZZA ARCHITECTS INC. THE CONTRACTOR MUST VERIFY AND ACCEPT RESPONSIBILITY FOR ALL DIMENSIONS AND CONDITIONS ON SITE AND MUST NOTIFY GRAZIANI+CORAZZA ARCHITECTS INC. OF ANY VARIATIONS FROM THE SUPPLIED INFORMATION. GRAZIANI+CORAZZA ARCHITECTS INC. IS NOT RESPONSIBLE FOR THE ACCURACY OF SURVEY, STRUCTURAL, MECHANICAL, ELECTRICAL, AND OTHER ENGINEERING INFORMATION SHOWN ON THIS DRAWING. REFER TO THE APPROPRIATE ENGINEERING DRAWINGS BEFORE PROCEEDING WITH THE WORK. CONSTRUCTION MUST CONFORM TO ALL APPLICABLE CODES AND REQUIREMENTS OF THE AUTHORITIES HAVING JURISDICTION. UNLESS OTHERWISE NOTED, NO INVESTIGATION HAS BEEN UNDERTAKEN OR REPORTED ON BY THIS OFFICE IN REGARDS TO THE ENVIRONMENTAL CONDITION OF THIS SITE.

THIS DRAWING IS NOT TO BE SCALED. ALL ARCHITECTURAL SYMBOLS INDICATED ON THIS DRAWING ARE GRAPHIC REPRESENTATIONS ONLY.

CONDITIONS FOR ELECTRONIC INFORMATION TRANSFER:

ELECTRONIC INFORMATION IS SUPPLIED TO THE OTHER ASSOCIATED FIRMS TO ASSIST THEM IN THE EXECUTION OF THEIR WORK / REVIEW. THE RECIPIENT FIRMS MUST DETERMINE THE COMPLETENESS / APPROPRIATENESS / RELEVANCE OF THE INFORMATION IN RESPECT TO THEIR PARTICULAR RESPONSIBILITY.

GRAZIANI + CORAZZA ARCHITECTS INC. SHALL NOT BE RESPONSIBLE FOR:
1. ERRORS, OMISSIONS, INCOMPLETENESS DUE TO LOSS OF INFORMATION IN WHOLE OR PART WHEN INFORMATION IS TRANSFERRED.
2. TRANSMISSION OF ANY VIRUS OR DAMAGE TO THE RECEIVING ELECTRONIC SYSTEM WHEN INFORMATION IS TRANSFERRED.

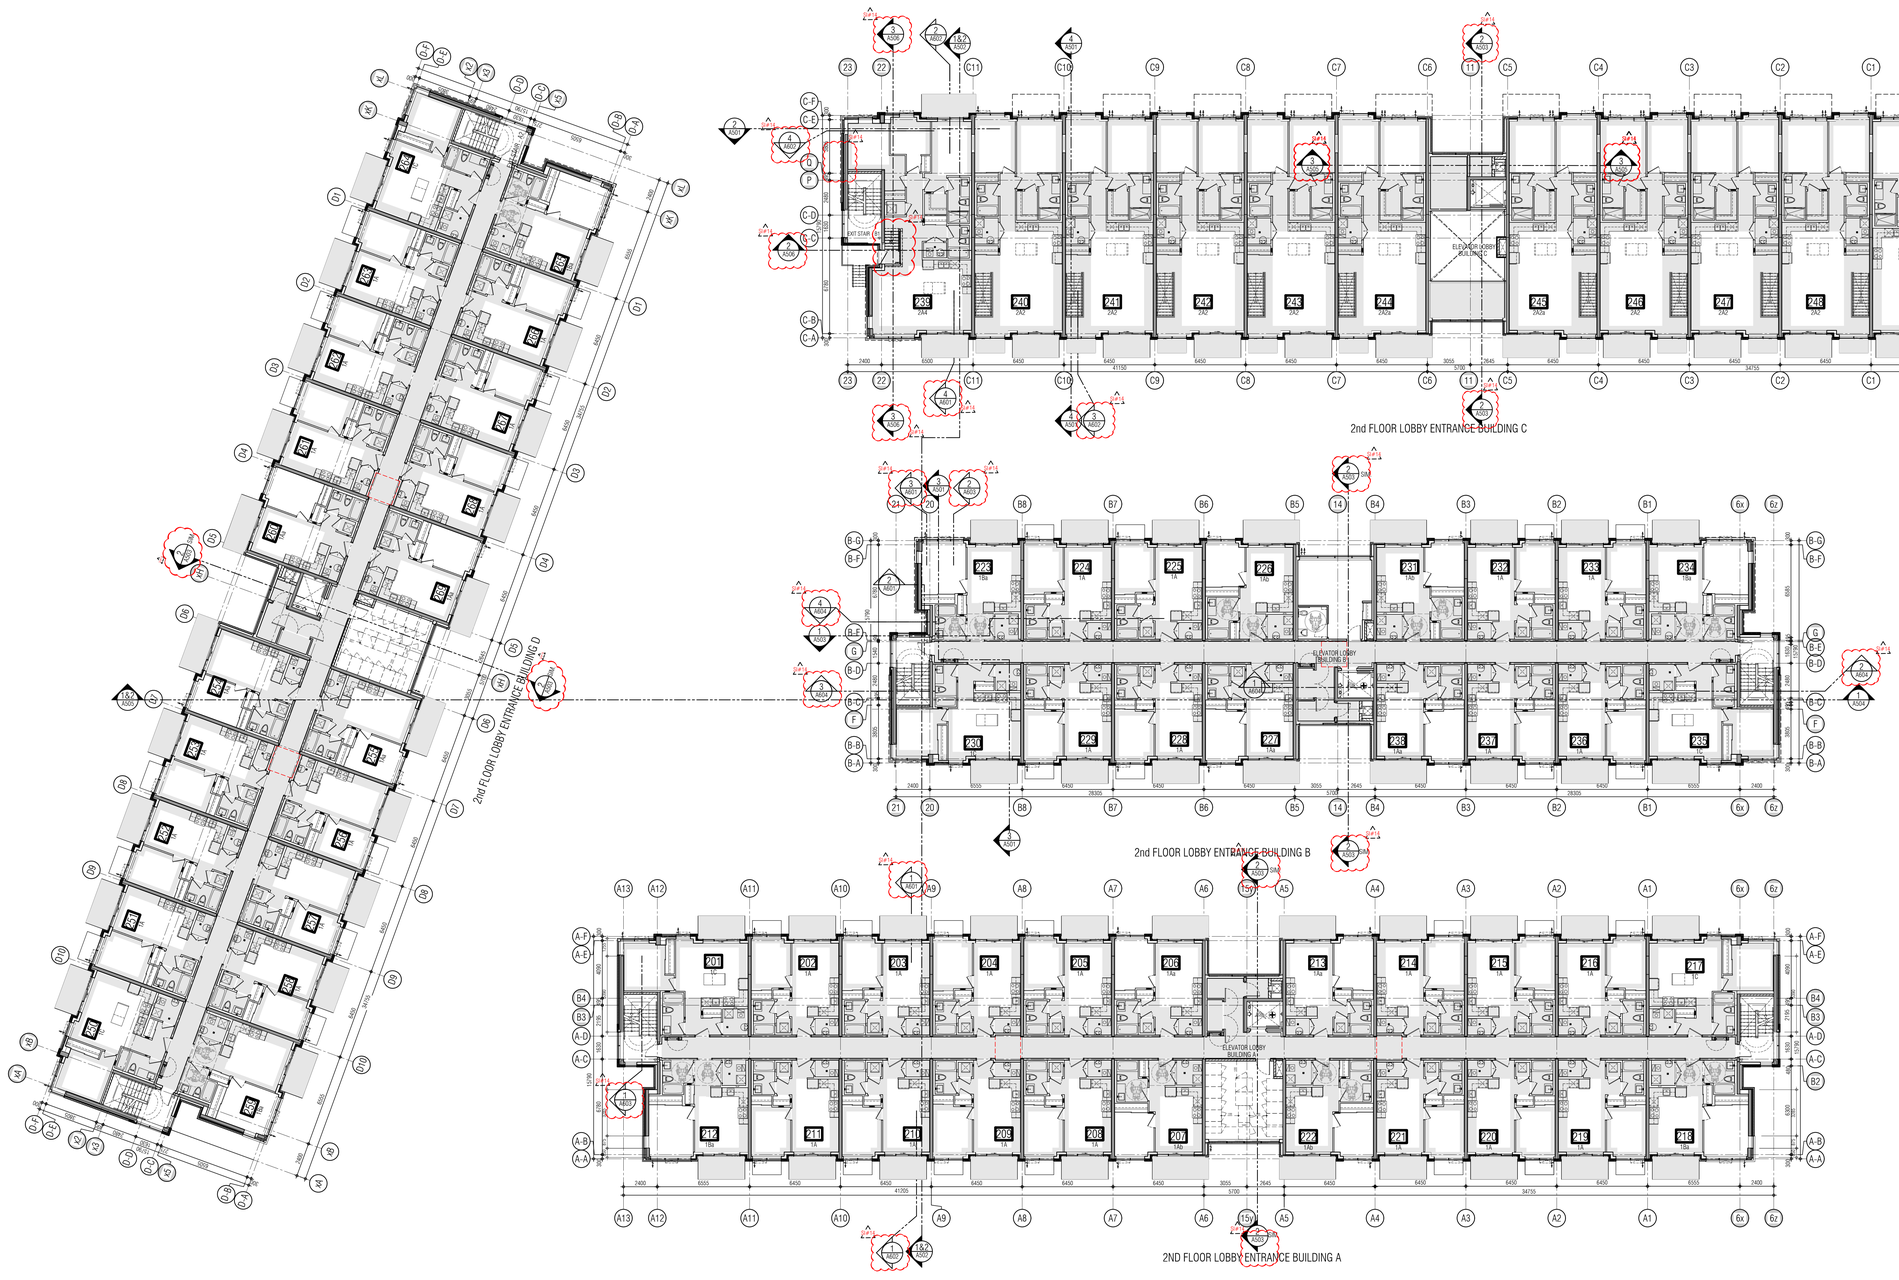

01.	Oct.07.2019	issued for tender	__
02.	Mar.13.2020	issued for design coordination #2	__
03.	Mar.16.2020	issued for addendum #2	__
04.	Mar.16.2020	issued for addendum #3	__
05.	Aug.24.2020	issued for addendum #4	__
06.	Sept. 28.2020	issued for permit	bg
07.	Oct.20.2020	issued for addendum #5	__
08.	Nov.23.2020	issued for addendum #6	__
09.	Dec.14.2020	issued for addendum #7	__
10.	Jan.18.2021	issued for addendum #8	__
11.	Mar. 2. 2021	issued for permit	bg
12.	Mar.09.2021	issued for addendum #9	__
13.	Mar.10.2021	issued for addendum #9R	__
14.	Mar.26.2021	issued for progress	__
15.	May 14. 2021	issued for Site Instruction #1	__
16.	June 15. 2021	issued for Site Instruction #2	__
17.	July. 7. 2021	re-issued for permit	bg
18.	July. 15. 2021	Issued for Site Instruction #3	bg
19.	July. 27. 2021	Issued for Site Instruction #4	bg
20.	Aug. 3. 2021	Issued for Site Instruction #5	bg
21.	Aug. 18. 2021	Issued for Site Instruction #6	bg
22.	Aug. 20. 2021	Re-issued for permit.	bg
23.	Sept. 07. 2021	Issued for Site Instruction #7	bg
24.	Sept. 09. 2021	Issued for Site Instruction #8	bg
25.	Sept. 16. 2021	Issued for Building D Permit Revisions	bg
26.	Sept. 22. 2021	Issued for Site Instruction #9	bg
27.	Oct. 6. 2021	Re-issued for permit.	bg
28.	Oct. 8. 2021	Issued for Site Instruction #10	bg
30.	Oct. 28. 2021	Issued for Site Instruction #11	bg
31.	Nov. 05. 2021	Issued for Site Instruction #12	bg
32.	Dec. 3. 2021	Issued for Site Instruction #13	bg
33.	Dec. 6. 2021	Issued for Site Instruction #14	bg
34.	Dec. 7. 2021	Issued for Site Instruction #15	bg

01.	SEP 18, 2019	Issued for Addendum 1	__
01.	Apr.19.2021	issued to client	bg

issued for revisions

GRAZIANI + CORAZZA ARCHITECTS
1320 CHARLTON DRIVE, SUITE 100, MISSISSAUGA, ONTARIO, L4W 1C3
T.905.795.2601 F.905.795.2644 WWW.GC-ARCHITECTS.COM

RESIDENTIAL

ROYAL PINE

ATTMAR + PALLESCHI DRIVE

BRAMPTON	ONTARIO
PROJECT ARCHITECT:	B.GRAZIANI
ASSISTANT DESIGNER:	R.LINCOLN
DRAWN BY:	G.C/F.C/M.B
CHECKED BY:	D.BIASE/G.COLANGELO
PLOT DATE:	DEC.13.2021
JOB #	1331.15

SECOND FLOOR OVERALL PLAN

1:150

A302

TITLEBLOCK SIZE: 915 x 1200

THIS DRAWING, AS AN INSTRUMENT OF SERVICE, IS PROVIDED BY AND IS THE PROPERTY OF GRAZIANI+CORAZZA ARCHITECTS INC. THE CONTRACTOR MUST VERIFY AND ACCEPT RESPONSIBILITY FOR ALL DIMENSIONS AND CONDITIONS ON SITE AND MUST NOTIFY GRAZIANI+CORAZZA ARCHITECTS INC. OF ANY VARIATIONS FROM THE SUPPLIED INFORMATION. GRAZIANI+CORAZZA ARCHITECTS INC. IS NOT RESPONSIBLE FOR THE ACCURACY OF SURVEY, STRUCTURAL, MECHANICAL, ELECTRICAL, AND OTHER ENGINEERING INFORMATION SHOWN ON THIS DRAWING. REFER TO THE APPROPRIATE ENGINEERING DRAWINGS BEFORE PROCEEDING WITH THE WORK. CONSTRUCTION MUST CONFORM TO ALL APPLICABLE CODES AND REQUIREMENTS OF THE AUTHORITIES HAVING JURISDICTION. UNLESS OTHERWISE NOTED, NO INVESTIGATION HAS BEEN UNDERTAKEN OR REPORTED ON BY THIS OFFICE IN REGARDS TO THE ENVIRONMENTAL CONDITION OF THIS SITE.

THIS DRAWING IS NOT TO BE SCALED. ALL ARCHITECTURAL SYMBOLS INDICATED ON THIS DRAWING ARE GRAPHIC REPRESENTATIONS ONLY.

CONDITIONS FOR ELECTRONIC INFORMATION TRANSFER:

ELECTRONIC INFORMATION IS SUPPLIED TO THE OTHER ASSOCIATED FIRMS TO ASSIST THEM IN THE EXECUTION OF THEIR WORK / REVIEW. THE RECIPIENT FIRMS MUST DETERMINE THE COMPLETENESS / APPROPRIATENESS / RELEVANCE OF THE INFORMATION IN RESPECT TO THEIR PARTICULAR RESPONSIBILITY.

GRAZIANI+CORAZZA ARCHITECTS INC. SHALL NOT BE RESPONSIBLE FOR:
1. ERRORS, OMISSIONS, INCOMPLETENESS DUE TO LOSS OF INFORMATION IN WHOLE OR PART WHEN INFORMATION IS TRANSFERRED.
2. TRANSMISSION OF ANY VIRUS OR DAMAGE TO THE RECEIVING ELECTRONIC SYSTEM WHEN INFORMATION IS TRANSFERRED.

REF. A302d2 FOR CONTINUATION

01.	Oct.07.2019	issued for tender	___
02.	Mar.13.2020	issued for design coordination #2	___
03.	Mar.16.2020	issued for addendum #2	___
04.	Mar.16.2020	issued for addendum #3	___
05.	Aug.24.2020	issued for addendum #4	___
06.	Sept. 28.2020	issued for permit	bg
07.	Oct.20.2020	issued for addendum #5	___
08.	Nov.23.2020	issued for addendum #6	___
09.	Dec.14.2020	issued for addendum #7	___
10.	Jan.18.2021	issued for addendum #8	___
11.	Mar. 2. 2021	issued for permit	bg
12.	Mar.09.2021	issued for addendum #9	___
13.	Mar.10.2021	issued for addendum #9R	___
14.	Mar.26.2021	issued for progress	___
15.	May 14. 2021	issued for Site Instruction #1	___
16.	June 15. 2021	issued for Site Instruction #2	___
17.	July. 7. 2021	re-issued for permit	bg
18.	July. 15. 2021	Issued for Site Instruction #3	bg
19.	July. 27. 2021	Issued for Site Instruction #4	bg
20.	Aug. 3. 2021	Issued for Site Instruction #5	bg
21.	Aug. 18. 2021	Issued for Site Instruction #6	bg
22.	Aug. 20. 2021	Re-issued for permit.	bg
23.	Sept. 07. 2021	Issued for Site Instruction #7	bg
24.	Sept. 09. 2021	Issued for Site Instruction #8	bg
25.	Sept. 16. 2021	Issued for Building D Permit Revisions	bg
26.	Sept. 22. 2021	Issued for Site Instruction #9	bg
27.	Oct. 6. 2021	Re-issued for permit.	bg
28.	Oct. 8. 2021	Issued for Site Instruction #10	bg
30.	Oct. 28. 2021	Issued for Site Instruction #11	bg
31.	Nov. 05. 2021	Issued for Site Instruction #12	bg
32.	Dec. 3. 2021	Issued for Site Instruction #13	bg
33.	Dec. 6. 2021	Issued for Site Instruction #14	bg
34.	Dec. 7. 2021	Issued for Site Instruction #15	bg

01.	SEPT.13.2019	Issued for tender addendum 1	bg

issued for revisions

GRAZIANI + CORAZZA ARCHITECTS
1320 SHAWSON DRIVE, SUITE 100 MISSISSAUGA, ONTARIO L4W 1C3
T 905.795.2601 F 905.795.2644 WWW.GC-ARCHITECTS.COM

RESIDENTIAL

ATTMAR + PALLESCHI DRIVE

BRAMPTON	ONTARIO
PROJECT ARCHITECT:	B.GRAZIANI
ASSISTANT DESIGNER:	R.LINCOLN
DRAWN BY:	G.C/F.C/M.B
CHECKED BY:	D.BIASE/G.COLANGELO
PLOT DATE:	DEC.13.2021
JOB #	1331.15

SECOND FLOOR PLAN
BUILDING A (PARTIAL PLAN)

1:50

A-302a1

TITLEBLOCK SIZE: 915 x 1200

KEY PLAN

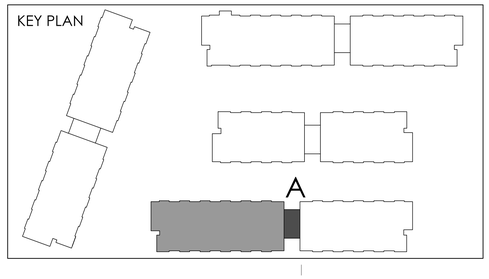

REF.A302d1 FOR CONTINUATION

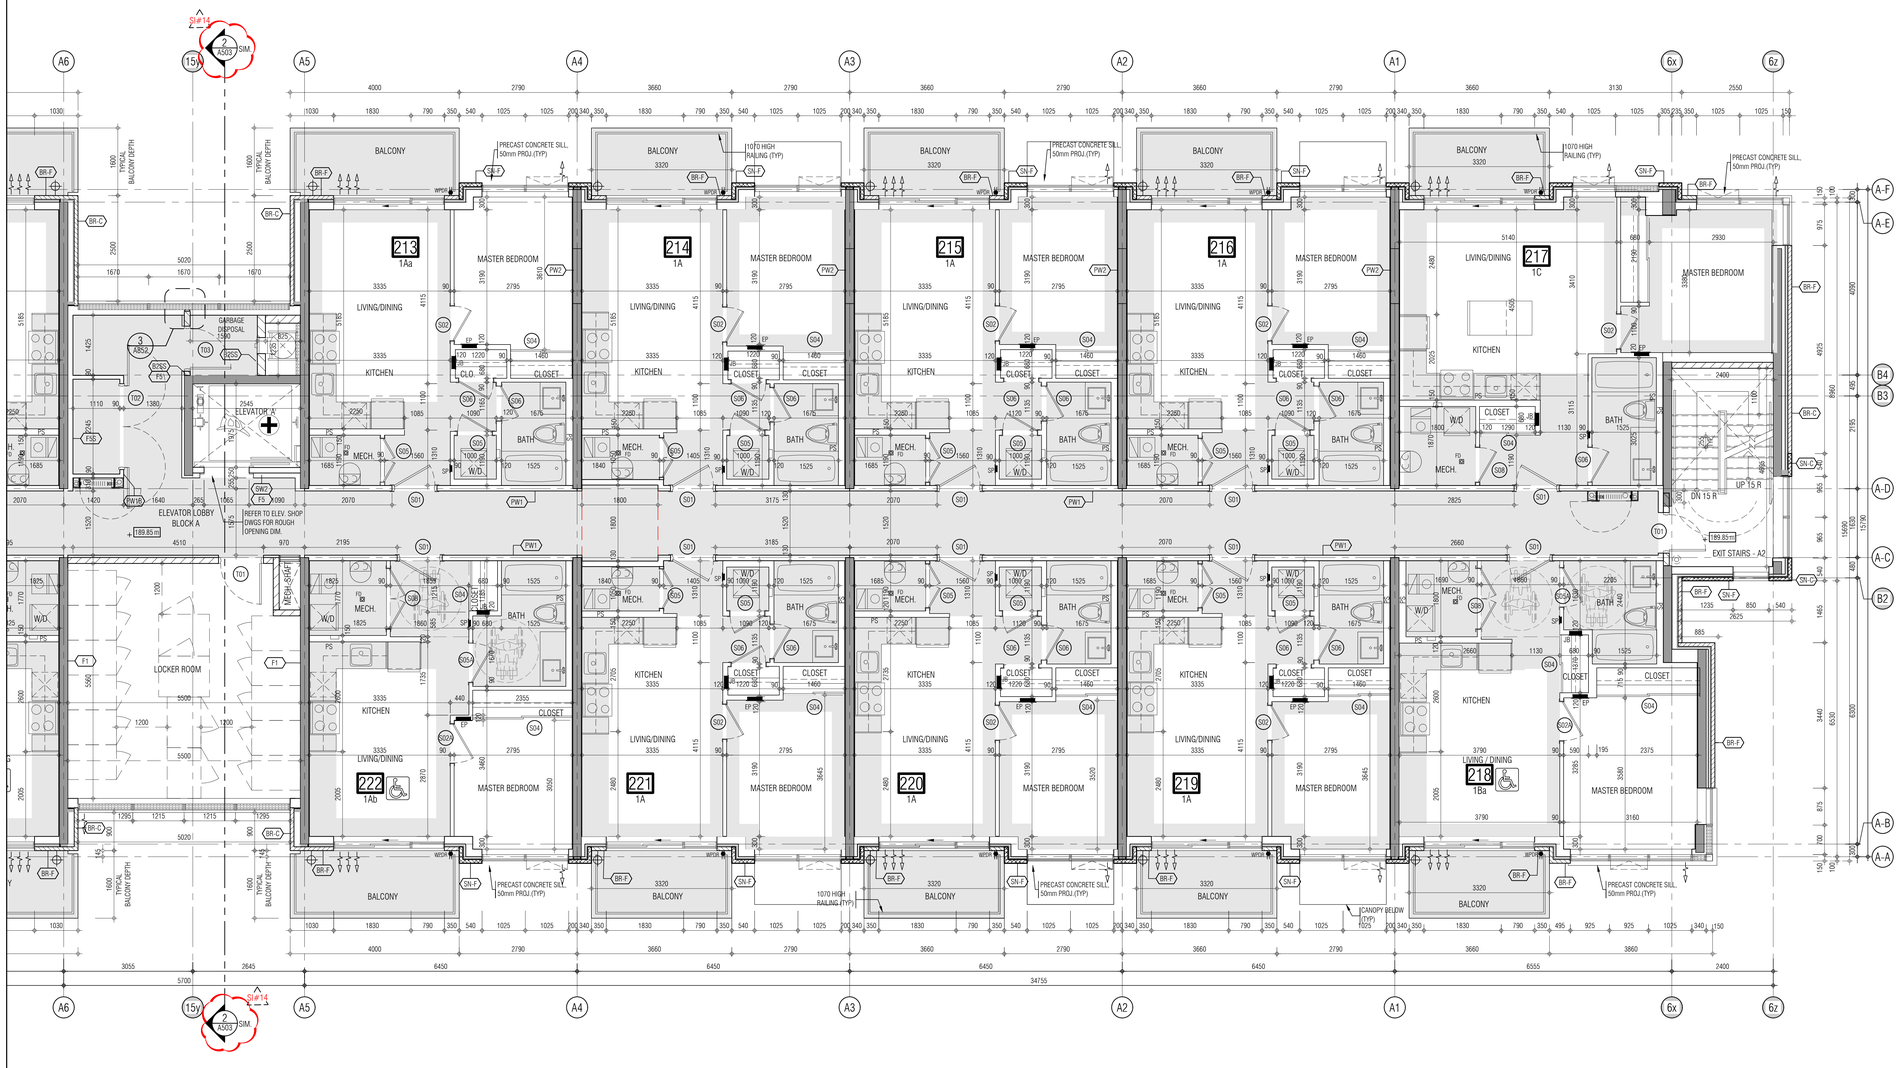

THIS DRAWING, AS AN INSTRUMENT OF SERVICE, IS PROVIDED BY AND IS THE PROPERTY OF GRAZIANI+CORAZZA ARCHITECTS INC. THE CONTRACTOR MUST VERIFY AND ACCEPT RESPONSIBILITY FOR ALL DIMENSIONS AND CONDITIONS ON SITE AND MUST NOTIFY GRAZIANI+CORAZZA ARCHITECTS INC. OF ANY VARIATIONS FROM THE SUPPLIED INFORMATION. GRAZIANI+CORAZZA ARCHITECTS INC. IS NOT RESPONSIBLE FOR THE ACCURACY OF SURVEY, STRUCTURAL, MECHANICAL, ELECTRICAL, AND OTHER ENGINEERING INFORMATION SHOWN ON THIS DRAWING. REFER TO THE APPROPRIATE ENGINEERING DRAWINGS BEFORE PROCEEDING WITH THE WORK. CONSTRUCTION MUST CONFORM TO ALL APPLICABLE CODES AND REQUIREMENTS OF THE AUTHORITIES HAVING JURISDICTION. UNLESS OTHERWISE NOTED, NO INVESTIGATION HAS BEEN UNDERTAKEN OR REPORTED ON BY THIS OFFICE IN REGARDS TO THE ENVIRONMENTAL CONDITION OF THIS SITE.

THIS DRAWING IS NOT TO BE SCALED. ALL ARCHITECTURAL SYMBOLS INDICATED ON THIS DRAWING ARE GRAPHIC REPRESENTATIONS ONLY.

CONDITIONS FOR ELECTRONIC INFORMATION TRANSFER:

ELECTRONIC INFORMATION IS SUPPLIED TO THE OTHER ASSOCIATED FIRMS TO ASSIST THEM IN THE EXECUTION OF THEIR WORK / REVIEW. THE RECIPIENT FIRMS MUST DETERMINE THE COMPLETENESS / APPROPRIATENESS / RELEVANCE OF THE INFORMATION IN RESPECT TO THEIR PARTICULAR RESPONSIBILITY.

GRAZIANI + CORAZZA ARCHITECTS INC. SHALL NOT BE RESPONSIBLE FOR:
1. ERRORS, OMISSIONS, INCOMPLETENESS DUE TO LOSS OF INFORMATION IN WHOLE OR PART WHEN INFORMATION IS TRANSFERRED.
2. TRANSMISSION OF ANY VIRUS OR DAMAGE TO THE RECEIVING ELECTRONIC SYSTEM WHEN INFORMATION IS TRANSFERRED.

01.	Oct.07.2019	issued for tender	___
02.	Mar.13.2020	issued for design coordination #2	___
03.	Mar.16.2020	issued for addendum #2	___
04.	Mar.16.2020	issued for addendum #3	___
05.	Aug.24.2020	issued for addendum #4	___
06.	Sept. 28.2020	issued for permit	bg
07.	Oct.20.2020	issued for addendum #5	___
08.	Nov.23.2020	issued for addendum #6	___
09.	Dec.14.2020	issued for addendum #7	___
10.	Jan.18.2021	issued for addendum #8	___
11.	Mar. 2. 2021	issued for permit	bg
12.	Mar.09.2021	issued for addendum #9	___
13.	Mar.10.2021	issued for addendum #9R	___
14.	Mar.26.2021	issued for progress	___
15.	May 14. 2021	issued for Site Instruction #1	___
16.	June 15. 2021	issued for Site Instruction #2	___
17.	July. 7. 2021	re-issued for permit	bg
18.	July. 15. 2021	Issued for Site Instruction #3	bg
19.	July. 27. 2021	Issued for Site Instruction #4	bg
20.	Aug. 3. 2021	Issued for Site Instruction #5	bg
21.	Aug. 18. 2021	Issued for Site Instruction #6	bg
22.	Aug. 20. 2021	Re-issued for permit.	bg
23.	Sept. 07. 2021	Issued for Site Instruction #7	bg
24.	Sept. 09. 2021	Issued for Site Instruction #8	bg
25.	Sept. 16. 2021	Issued for Building D Permit Revisions	bg
26.	Sept. 22. 2021	Issued for Site Instruction #9	bg
27.	Oct. 6. 2021	Re-issued for permit.	bg
28.	Oct. 8. 2021	Issued for Site Instruction #10	bg
30.	Oct. 28. 2021	Issued for Site Instruction #11	bg
31.	Nov. 05. 2021	Issued for Site Instruction #12	bg
32.	Dec. 3. 2021	Issued for Site Instruction #13	bg
33.	Dec. 6. 2021	Issued for Site Instruction #14	bg
34.	Dec. 7. 2021	Issued for Site Instruction #15	bg

01. SEP.13.2019 Issued for Addendum 1 bg

issued for revisions

GRAZIANI + CORAZZA ARCHITECTS
1320 SHERATON DRIVE, SUITE 100 MISSISSAUGA, ONTARIO L4W 1C3
T.905.795.2601 F.905.795.2644 WWW.GC-ARCHITECTS.COM

RESIDENTIAL

ATTMAR + PALLESCHI DRIVE

BRAMPTON ONTARIO

PROJECT ARCHITECT:	B.GRAZIANI
ASSISTANT DESIGNER:	R.LINCOLN
DRAWN BY:	G.C/F.C/M.B
CHECKED BY:	D.BIASE/G.COLANGELO
PLOT DATE:	DEC.13.2021
JOB #:	1331.15

SECOND FLOOR PLAN
BUILDING A (PARTIAL PLAN)

KEY PLAN

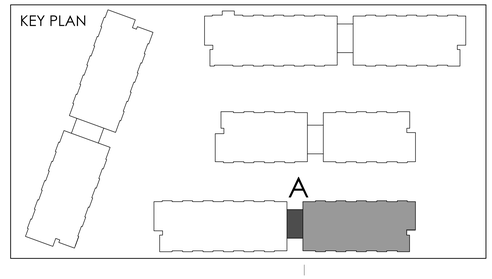

1:50

A-302a2

TITLEBLOCK SIZE: 915 x 1200

THIS DRAWING, AS AN INSTRUMENT OF SERVICE, IS PROVIDED BY AND IS THE PROPERTY OF GRAZIANI+CORAZZA ARCHITECTS INC. THE CONTRACTOR MUST VERIFY AND ACCEPT RESPONSIBILITY FOR ALL DIMENSIONS AND CONDITIONS ON SITE AND MUST NOTIFY GRAZIANI+CORAZZA ARCHITECTS INC. OF ANY VARIATIONS FROM THE SUPPLIED INFORMATION. GRAZIANI+CORAZZA ARCHITECTS INC. IS NOT RESPONSIBLE FOR THE ACCURACY OF SURVEY, STRUCTURAL, MECHANICAL, ELECTRICAL, AND OTHER ENGINEERING INFORMATION SHOWN ON THIS DRAWING. REFER TO THE APPROPRIATE ENGINEERING DRAWINGS BEFORE PROCEEDING WITH THE WORK. CONSTRUCTION MUST CONFORM TO ALL APPLICABLE CODES AND REQUIREMENTS OF THE AUTHORITIES HAVING JURISDICTION. UNLESS OTHERWISE NOTED, NO INVESTIGATION HAS BEEN UNDERTAKEN OR REPORTED ON BY THIS OFFICE IN REGARDS TO THE ENVIRONMENTAL CONDITION OF THIS SITE.

THIS DRAWING IS NOT TO BE SCALED. ALL ARCHITECTURAL SYMBOLS INDICATED ON THIS DRAWING ARE GRAPHIC REPRESENTATIONS ONLY.

CONDITIONS FOR ELECTRONIC INFORMATION TRANSFER:

ELECTRONIC INFORMATION IS SUPPLIED TO THE OTHER ASSOCIATED FIRMS TO ASSIST THEM IN THE EXECUTION OF THEIR WORK / REVIEW. THE RECIPIENT FIRMS MUST DETERMINE THE COMPLETENESS / APPROPRIATENESS / RELEVANCE OF THE INFORMATION IN RESPECT TO THEIR PARTICULAR RESPONSIBILITY.

GRAZIANI + CORAZZA ARCHITECTS INC. SHALL NOT BE RESPONSIBLE FOR:
1. ERRORS, OMISSIONS, INCOMPLETENESS DUE TO LOSS OF INFORMATION IN WHOLE OR PART WHEN INFORMATION IS TRANSFERRED.
2. TRANSMISSION OF ANY VIRUS OR DAMAGE TO THE RECEIVING ELECTRONIC SYSTEM WHEN INFORMATION IS TRANSFERRED.

REF. A302c2 FOR CONTINUATION

01.	Oct.07.2019 issued for tender	—
02.	Mar.13.2020 issued for design coordination #2	—
03.	Mar.16.2020 issued for addendum #2	—
04.	Mar.16.2020 issued for addendum #3	—
05.	Aug.24.2020 issued for addendum #4	—
06.	Sept. 28.2020 issued for permit	bg
07.	Oct.20.2020 issued for addendum #5	—
08.	Nov.23.2020 issued for addendum #6	—
09.	Dec.14.2020 issued for addendum #7	—
10.	Jan.18.2021 issued for addendum #8	—
11.	Mar. 2. 2021 issued for permit	bg
12.	Mar.09.2021 issued for addendum #9	—
13.	Mar.10.2021 issued for addendum #9R	—
14.	Mar.26.2021 issued for progress	—
15.	May 14. 2021 issued for Site Instruction #1	—
16.	June 15. 2021 issued for Site Instruction #2	—
17.	July. 7. 2021 re-issued for permit	bg
18.	July. 15. 2021 Issued for Site Instruction #3	bg
19.	July. 27. 2021 Issued for Site Instruction #4	bg
20.	Aug. 3. 2021 Issued for Site Instruction #5	bg
21.	Aug. 18. 2021 Issued for Site Instruction #6	bg
22.	Aug. 20. 2021 Re-issued for permit.	bg
23.	Sept. 07. 2021 Issued for Site Instruction #7	bg
24.	Sept. 09. 2021 Issued for Site Instruction #8	bg
25.	Sept. 16. 2021 Issued for Building D Permit Revisions	bg
26.	Sept. 22. 2021 Issued for Site Instruction #9	bg
27.	Oct. 6. 2021 Re-issued for permit.	bg
28.	Oct. 8. 2021 Issued for Site Instruction #10	bg
30.	Oct. 28. 2021 Issued for Site Instruction #11	bg
31.	Nov. 05. 2021 Issued for Site Instruction #12	bg
32.	Dec. 3. 2021 Issued for Site Instruction #13	bg
33.	Dec. 6. 2021 Issued for Site Instruction #14	bg
34.	Dec. 7. 2021 Issued for Site Instruction #15	bg

01. SEPT.12.2019 Issued for Addendum 1 bg

issued for revisions

GRAZIANI CORAZZA ARCHITECTS
1220 SHARON DRIVE, SUITE 100 MISSISSAUGA, ONTARIO L4W 1C3
T 905.795.2601 F 905.795.2644 WWW.GC-ARCHITECTS.COM

RESIDENTIAL

ATTMAR + PALLESCHI DRIVE

BRAMPTON ONTARIO

PROJECT ARCHITECT:	B.GRAZIANI
ASSISTANT DESIGNER:	R.LINCOLN
DRAWN BY:	G.C/F.C/M.B
CHECKED BY:	D.BIASE/G.COLANGELO
PLOT DATE:	DEC.13.2021
JOB #	1331.15

KEY PLAN

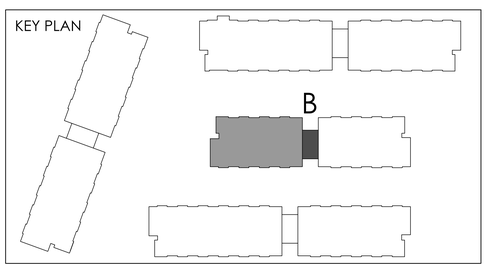

SECOND FLOOR PLAN
BUILDING B (PARTIAL PLAN)

1:50

A-302b1

TITLEBLOCK SIZE: 915 x 1200

REF.A302c1 FOR CONTINUATION

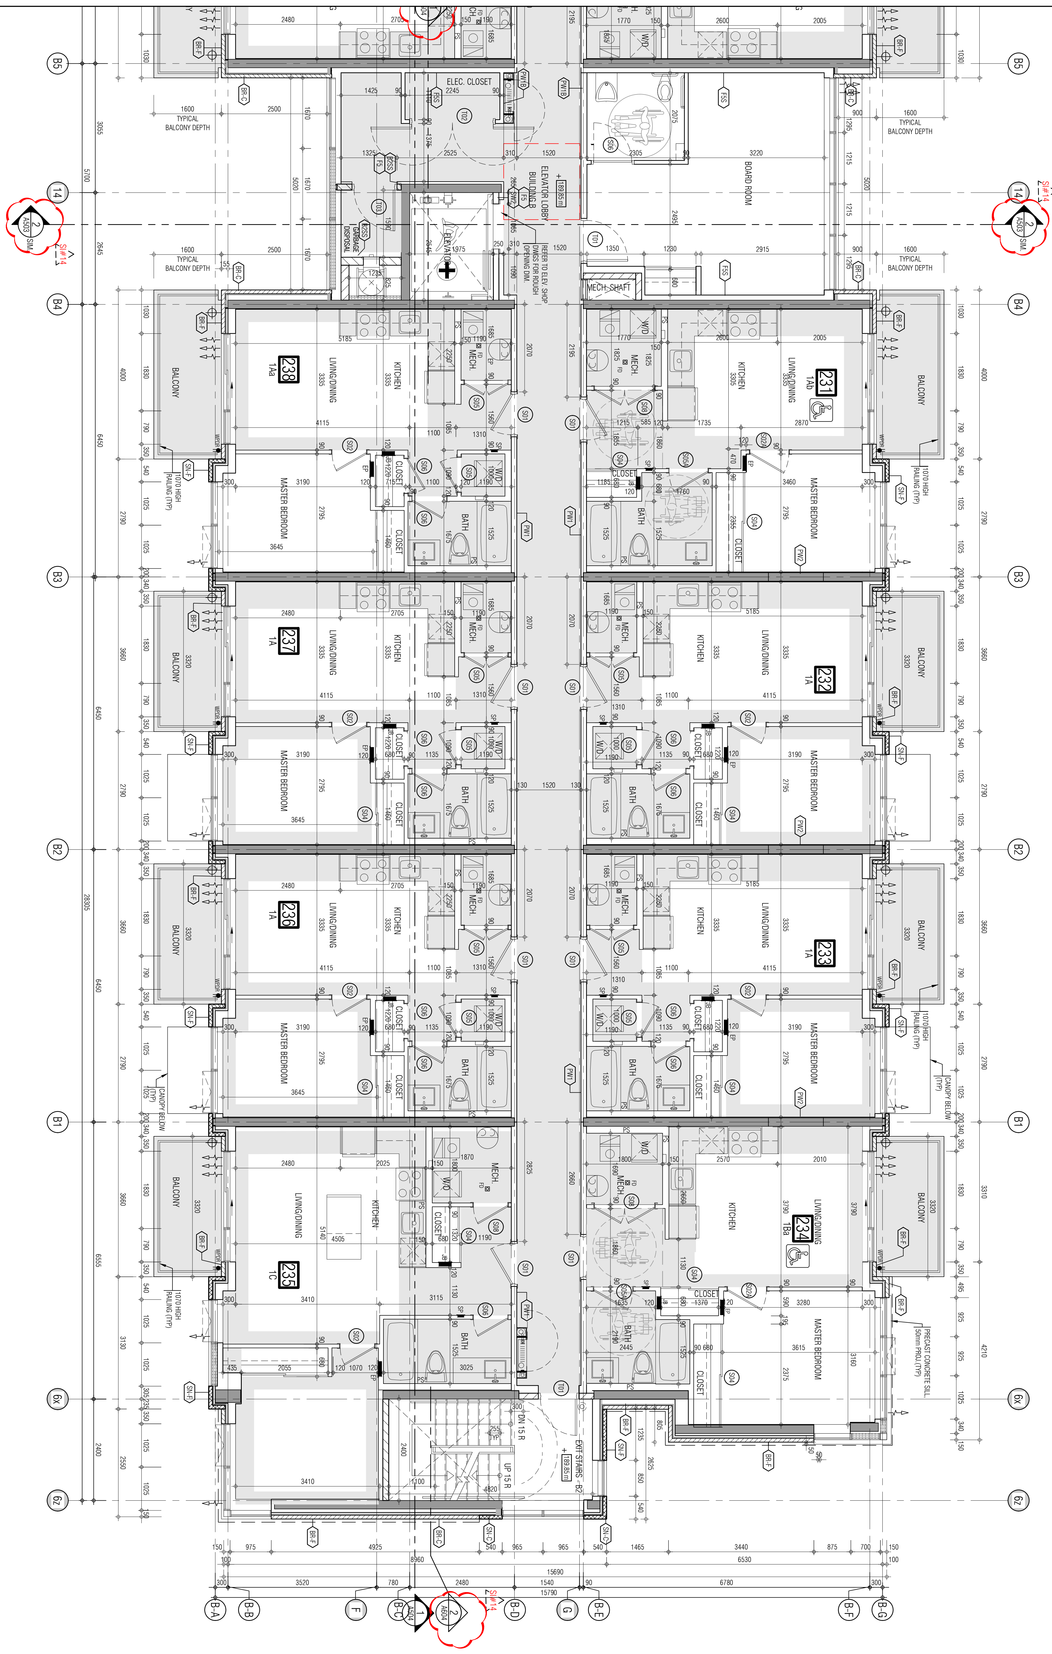

KEY PLAN

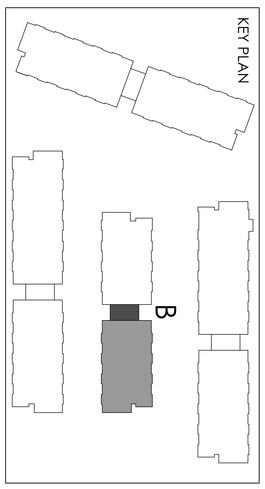








01.	Oct.07.2019	Issued for tender
02.	Mar.11.2020	issued for design coordination #2
03.	Mar.16.2020	issued for addendum #2
04.	Mar.19.2020	issued for addendum #3
05.	Aug.24.2020	issued for addendum #4
06.	Sept.28.2020	issued for permit
07.	Oct.22.2020	issued for addendum #5
08.	Nov.23.2020	issued for addendum #6
09.	Dec.14.2020	issued for addendum #7
10.	Jan.18.2021	issued for addendum #8
11.	Mar. 2.2021	issued for permit
12.	Mar.09.2021	issued for addendum #9
13.	Mar.12.2021	issued for addendum #9R
14.	Mar.26.2021	issued for progress
15.	May.14.2021	issued for Site Instruction #1
16.	June 15.2021	issued for Site Instruction #2
17.	July. 7.2021	re-issued for permit
18.	July. 15.2021	issued for Site Instruction #3
19.	July. 27.2021	issued for Site Instruction #4
20.	Aug. 3.2021	issued for Site Instruction #5
21.	Aug. 18.2021	issued for Site Instruction #6
22.	Aug. 20.2021	Re-issued for permit
23.	Sept. 07.2021	issued for Site Instruction #7
24.	Sept. 09.2021	issued for Site Instruction #8
25.	Sept. 16.2021	issued for Building D Permit Revisions
26.	Sept. 22.2021	issued for Site Instruction #9
27.	Oct. 6. 2021	Re-issued for permit
28.	Oct. 6. 2021	issued for Site Instruction #10
30.	Oct. 28. 2021	issued for Site Instruction #11
31.	Nov. 05. 2021	issued for Site Instruction #12
32.	Dec. 3. 2021	issued for Site Instruction #13
33.	Dec. 6. 2021	issued for Site Instruction #14
34.	Dec. 7. 2021	issued for Site Instruction #15


issued for revisions


RESIDENTIAL

PLOT DATE: DEC.13.2021
JOB #: 1331.15

SECOND FLOOR PLAN
BUILDING B (PARTIAL PLAN)

1:50

A-302b2

TITLEBLOCK SIZE: 915 x 1200

THIS DRAWING, AS AN INSTRUMENT OF SERVICE, IS PROVIDED BY AND IS THE PROPERTY OF GRAZIANI+CORAZZA ARCHITECTS INC. THE CONTRACTOR MUST VERIFY AND ACCEPT RESPONSIBILITY FOR ALL DIMENSIONS AND CONDITIONS ON SITE AND MUST NOTIFY GRAZIANI+CORAZZA ARCHITECTS INC. OF ANY VARIATIONS FROM THE SUPPLIED INFORMATION. GRAZIANI+CORAZZA ARCHITECTS INC. IS NOT RESPONSIBLE FOR THE ACCURACY OF SURVEY, STRUCTURAL, MECHANICAL, ELECTRICAL, AND OTHER ENGINEERING INFORMATION SHOWN ON THIS DRAWING. REFER TO THE APPROPRIATE ENGINEERING DRAWINGS BEFORE PROCEEDING WITH THE WORK. CONSTRUCTION MUST CONFORM TO ALL APPLICABLE CODES AND REQUIREMENTS OF THE AUTHORITIES HAVING JURISDICTION. UNLESS OTHERWISE NOTED, NO INVESTIGATION HAS BEEN UNDERTAKEN OR REPORTED ON BY THIS OFFICE IN REGARDS TO THE ENVIRONMENTAL CONDITION OF THIS SITE.

THIS DRAWING IS NOT TO BE SCALED. ALL ARCHITECTURAL SYMBOLS INDICATED ON THIS DRAWING ARE GRAPHIC REPRESENTATIONS ONLY.

CONDITIONS FOR ELECTRONIC INFORMATION TRANSFER:

ELECTRONIC INFORMATION IS SUPPLIED TO THE OTHER ASSOCIATED FIRMS TO ASSIST THEM IN THE EXECUTION OF THEIR WORK / REVIEW. THE RECIPIENT FIRMS MUST DETERMINE THE COMPLETENESS / APPROPRIATENESS / RELEVANCE OF THE INFORMATION IN RESPECT TO THEIR PARTICULAR RESPONSIBILITY.

GRAZIANI + CORAZZA ARCHITECTS INC. SHALL NOT BE RESPONSIBLE FOR:
1. ERRORS, OMISSIONS, INCOMPLETENESS DUE TO LOSS OF INFORMATION IN WHOLE OR PART WHEN INFORMATION IS TRANSFERRED.
2. TRANSMISSION OF ANY VIRUS OR DAMAGE TO THE RECEIVING ELECTRONIC SYSTEM WHEN INFORMATION IS TRANSFERRED.

REF. A302b2 FOR CONTINUATION

01.	Oct.07.2019	issued for tender	___
02.	Mar.13.2020	issued for design coordination #2	___
03.	Mar.16.2020	issued for addendum #2	___
04.	Mar.16.2020	issued for addendum #3	___
05.	Aug.24.2020	issued for addendum #4	___
06.	Sept. 28.2020	issued for permit	bg
07.	Oct.20.2020	issued for addendum #5	___
08.	Nov.23.2020	issued for addendum #6	___
09.	Dec.14.2020	issued for addendum #7	___
10.	Jan.18.2021	issued for addendum #8	___
11.	Mar. 2. 2021	issued for permit	bg
12.	Mar.09.2021	issued for addendum #9	___
13.	Mar.10.2021	issued for addendum #9R	___
14.	Mar.26.2021	issued for progress	___
15.	May 14. 2021	issued for Site Instruction #1	___
16.	June 15. 2021	issued for Site Instruction #2	___
17.	July. 7. 2021	re-issued for permit	bg
18.	July. 15. 2021	Issued for Site Instruction #3	bg
19.	July. 27. 2021	Issued for Site Instruction #4	bg
20.	Aug. 3. 2021	Issued for Site Instruction #5	bg
21.	Aug. 18. 2021	Issued for Site Instruction #6	bg
22.	Aug. 20. 2021	Re-issued for permit.	bg
23.	Sept. 07. 2021	Issued for Site Instruction #7	bg
24.	Sept. 09. 2021	Issued for Site Instruction #8	bg
25.	Sept. 16. 2021	Issued for Building D Permit Revisions	bg
26.	Sept. 22. 2021	Issued for Site Instruction #9	bg
27.	Oct. 6. 2021	Re-issued for permit.	bg
28.	Oct. 8. 2021	Issued for Site Instruction #10	bg
30.	Oct. 28. 2021	Issued for Site Instruction #11	bg
31.	Nov. 05. 2021	Issued for Site Instruction #12	bg
32.	Dec. 3. 2021	Issued for Site Instruction #13	bg
33.	Dec. 6. 2021	Issued for Site Instruction #14	bg
34.	Dec. 7. 2021	Issued for Site Instruction #15	bg

01. ~~Sept.15.2019~~ Issued for Addendum 1 bg

issued for revisions

GRAZIANI + CORAZZA ARCHITECTS
1320 SHAWSON DRIVE, SUITE 100 MISSISSAUGA, ONTARIO L4W 1C5
T 905.795.2821 F 905.795.2844 WWW.GC-ARCHITECTS.COM

RESIDENTIAL

ATTMAR + PALLESCHI DRIVE

BRAMPTON	ONTARIO
PROJECT ARCHITECT:	B.GRAZIANI
ASSISTANT DESIGNER:	R.LINCOLN
DRAWN BY:	G.C./F.C./M.B
CHECKED BY:	D.BIASE/G.COLANGELO
PLOT DATE:	DEC.13.2021
JOB #	1331.15

SECOND FLOOR PLAN
BUILDING C (PARTIAL PLAN)

1:50

A-302c1

TITLEBLOCK SIZE: 915 x 1200

KEY PLAN

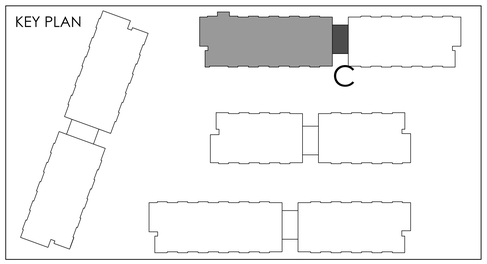

REF. A302b1 FOR CONTINUATION

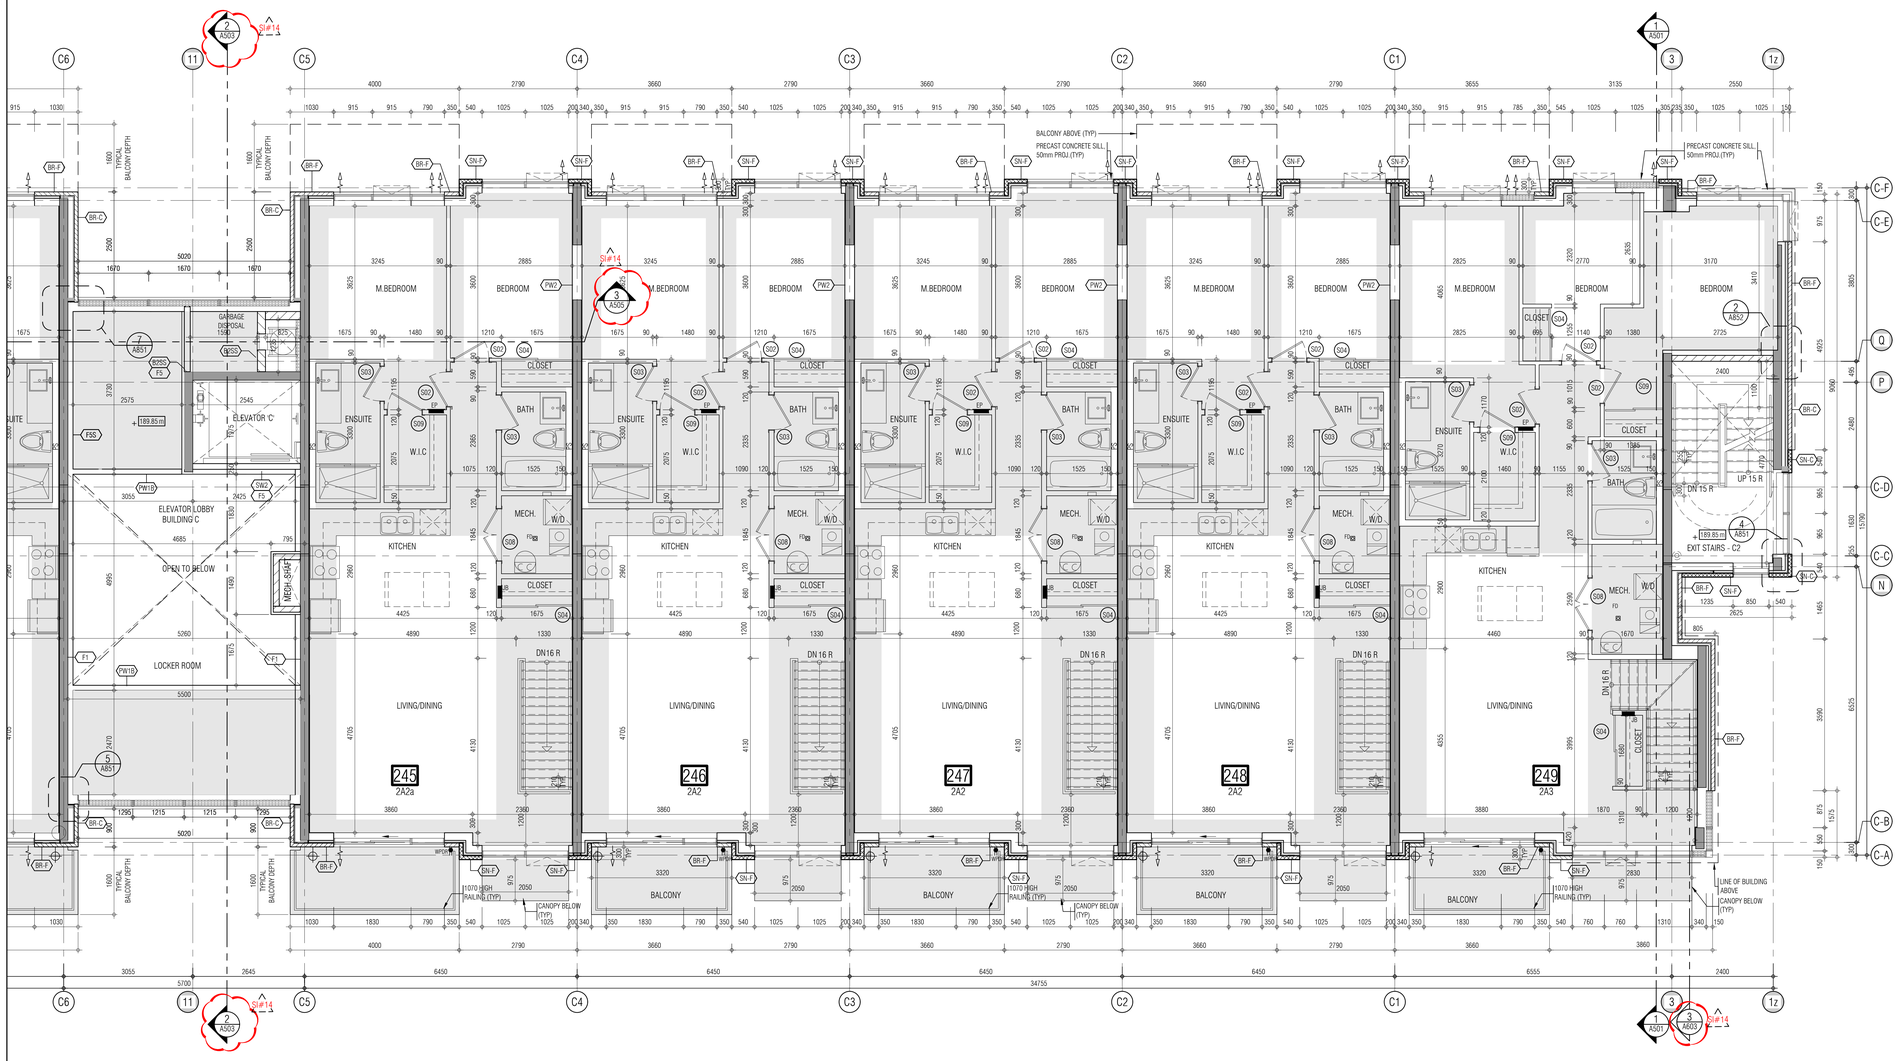

THIS DRAWING, AS AN INSTRUMENT OF SERVICE, IS PROVIDED BY AND IS THE PROPERTY OF GRAZIANI+CORAZZA ARCHITECTS INC. THE CONTRACTOR MUST VERIFY AND ACCEPT RESPONSIBILITY FOR ALL DIMENSIONS AND CONDITIONS ON SITE AND MUST NOTIFY GRAZIANI+CORAZZA ARCHITECTS INC. OF ANY VARIATIONS FROM THE SUPPLIED INFORMATION. GRAZIANI+CORAZZA ARCHITECTS INC. IS NOT RESPONSIBLE FOR THE ACCURACY OF SURVEY, STRUCTURAL, MECHANICAL, ELECTRICAL, AND OTHER ENGINEERING INFORMATION SHOWN ON THIS DRAWING. REFER TO THE APPROPRIATE ENGINEERING DRAWINGS BEFORE PROCEEDING WITH THE WORK. CONSTRUCTION MUST CONFORM TO ALL APPLICABLE CODES AND REQUIREMENTS OF THE AUTHORITIES HAVING JURISDICTION. UNLESS OTHERWISE NOTED, NO INVESTIGATION HAS BEEN UNDERTAKEN OR REPORTED ON BY THIS OFFICE IN REGARDS TO THE ENVIRONMENTAL CONDITION OF THIS SITE.

THIS DRAWING IS NOT TO BE SCALED. ALL ARCHITECTURAL SYMBOLS INDICATED ON THIS DRAWING ARE GRAPHIC REPRESENTATIONS ONLY.

CONDITIONS FOR ELECTRONIC INFORMATION TRANSFER:

ELECTRONIC INFORMATION IS SUPPLIED TO THE OTHER ASSOCIATED FIRMS TO ASSIST THEM IN THE EXECUTION OF THEIR WORK / REVIEW. THE RECIPIENT FIRMS MUST DETERMINE THE COMPLETENESS / APPROPRIATENESS / RELEVANCE OF THE INFORMATION IN RESPECT TO THEIR PARTICULAR RESPONSIBILITY.

GRAZIANI+CORAZZA ARCHITECTS INC. SHALL NOT BE RESPONSIBLE FOR:
1. ERRORS, OMISSIONS, INCOMPLETENESS DUE TO LOSS OF INFORMATION IN WHOLE OR PART WHEN INFORMATION IS TRANSFERRED.
2. TRANSMISSION OF ANY VIRUS OR DAMAGE TO THE RECEIVING ELECTRONIC SYSTEM WHEN INFORMATION IS TRANSFERRED.

01.	Oct.07.2019	issued for tender	___
02.	Mar.13.2020	issued for design coordination #2	___
03.	Mar.16.2020	issued for addendum #2	___
04.	Mar.16.2020	issued for addendum #3	___
05.	Aug.24.2020	issued for addendum #4	___
06.	Sept. 28.2020	issued for permit	bg
07.	Oct.20.2020	issued for addendum #5	___
08.	Nov.23.2020	issued for addendum #6	___
09.	Dec.14.2020	issued for addendum #7	___
10.	Jan.18.2021	issued for addendum #8	___
11.	Mar. 2. 2021	issued for permit	bg
12.	Mar.09.2021	issued for addendum #9	___
13.	Mar.10.2021	issued for addendum #9R	___
14.	Mar.26.2021	issued for progress	___
15.	May 14. 2021	issued for Site Instruction #1	___
16.	June 15. 2021	issued for Site Instruction #2	___
17.	July. 7. 2021	re-issued for permit	bg
18.	July. 15. 2021	Issued for Site Instruction #3	bg
19.	July. 27. 2021	Issued for Site Instruction #4	bg
20.	Aug. 3. 2021	Issued for Site Instruction #5	bg
21.	Aug. 18. 2021	Issued for Site Instruction #6	bg
22.	Aug. 20. 2021	Re-issued for permit.	bg
23.	Sept. 07. 2021	Issued for Site Instruction #7	bg
24.	Sept. 09. 2021	Issued for Site Instruction #8	bg
25.	Sept. 16. 2021	Issued for Building D Permit Revisions	bg
26.	Sept. 22. 2021	Issued for Site Instruction #9	bg
27.	Oct. 6. 2021	Re-issued for permit.	bg
28.	Oct. 8. 2021	Issued for Site Instruction #10	bg
30.	Oct. 28. 2021	Issued for Site Instruction #11	bg
31.	Nov. 05. 2021	Issued for Site Instruction #12	bg
32.	Dec. 3. 2021	Issued for Site Instruction #13	bg
33.	Dec. 6. 2021	Issued for Site Instruction #14	bg
34.	Dec. 7. 2021	Issued for Site Instruction #15	bg

KEY PLAN

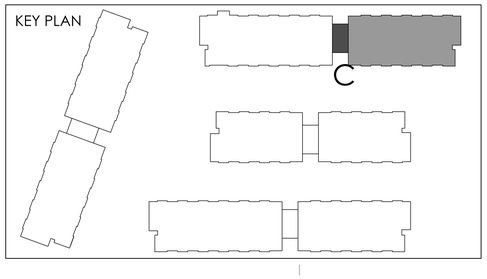

01.	SEPT.18.2019	Issued for Addendum 1	bg

issued for revisions

GRAZIANI + CORAZZA ARCHITECTS
1320 SHAWSON DRIVE, SUITE 100 MISSISSAUGA, ONTARIO L4W 1C3
T 905.795.2601 F 905.795.2644 WWW.GC-ARCHITECTS.COM

RESIDENTIAL

ATTMAR + PALLESCHI DRIVE

BRAMPTON ONTARIO

PROJECT ARCHITECT:	B.GRAZIANI
ASSISTANT DESIGNER:	R.LINCOLN
DRAWN BY:	G.C./F.C./M.B
CHECKED BY:	D.BIASE/G.COLANGELO
PLOT DATE:	DEC.13.2021
JOB #	1331.15

SECOND FLOOR PLAN
BUILDING C (PARTIAL PLAN)

1:50

A-302c2

TITLEBLOCK SIZE: 915 x 1200

THIS DRAWING, AS AN INSTRUMENT OF SERVICE, IS PROVIDED BY AND IS THE PROPERTY OF GRAZIANI+CORAZZA ARCHITECTS INC. THE CONTRACTOR MUST VERIFY AND ACCEPT RESPONSIBILITY FOR ALL DIMENSIONS AND CONDITIONS ON SITE AND MUST NOTIFY GRAZIANI+CORAZZA ARCHITECTS INC. OF ANY VARIATIONS FROM THE SUPPLIED INFORMATION. GRAZIANI+CORAZZA ARCHITECTS INC. IS NOT RESPONSIBLE FOR THE ACCURACY OF SURVEY, STRUCTURAL, MECHANICAL, ELECTRICAL, AND OTHER ENGINEERING INFORMATION SHOWN ON THIS DRAWING. REFER TO THE APPROPRIATE ENGINEERING DRAWINGS BEFORE PROCEEDING WITH THE WORK. CONSTRUCTION MUST CONFORM TO ALL APPLICABLE CODES AND REQUIREMENTS OF THE AUTHORITIES HAVING JURISDICTION. UNLESS OTHERWISE NOTED, NO INVESTIGATION HAS BEEN UNDERTAKEN OR REPORTED ON BY THIS OFFICE IN REGARDS TO THE ENVIRONMENTAL CONDITION OF THIS SITE.

THIS DRAWING IS NOT TO BE SCALED. ALL ARCHITECTURAL SYMBOLS INDICATED ON THIS DRAWING ARE GRAPHIC REPRESENTATIONS ONLY.

CONDITIONS FOR ELECTRONIC INFORMATION TRANSFER:

ELECTRONIC INFORMATION IS SUPPLIED TO THE OTHER ASSOCIATED FIRMS TO ASSIST THEM IN THE EXECUTION OF THEIR WORK / REVIEW. THE RECIPIENT FIRMS MUST DETERMINE THE COMPLETENESS / APPROPRIATENESS / RELEVANCE OF THE INFORMATION IN RESPECT TO THEIR PARTICULAR RESPONSIBILITY.

GRAZIANI+CORAZZA ARCHITECTS INC. SHALL NOT BE RESPONSIBLE FOR:
1. ERRORS, OMISSIONS, INCOMPLETENESS DUE TO LOSS OF INFORMATION IN WHOLE OR PART WHEN INFORMATION IS TRANSFERRED.
2. TRANSMISSION OF ANY VIRUS OR DAMAGE TO THE RECEIVING ELECTRONIC SYSTEM WHEN INFORMATION IS TRANSFERRED.

REF. A302a2 FOR CONTINUATION

01.	Oct.07.2019 issued for tender	___
02.	Mar.13.2020 issued for design coordination #2	___
03.	Mar.16.2020 issued for addendum #2	___
04.	Mar.16.2020 issued for addendum #3	___
05.	Aug.24.2020 issued for addendum #4	___
06.	Sept. 28.2020 issued for permit	bg
07.	Oct.20.2020 issued for addendum #5	___
08.	Nov.23.2020 issued for addendum #6	___
09.	Dec.14.2020 issued for addendum #7	___
10.	Jan.18.2021 issued for addendum #8	___
11.	Mar. 2. 2021 issued for permit	bg
12.	Mar.09.2021 issued for addendum #9	___
13.	Mar.10.2021 issued for addendum #9R	___
14.	Mar.26.2021 issued for progress	___
15.	May 14. 2021 issued for Site Instruction #1	___
16.	June 15. 2021 issued for Site Instruction #2	___
17.	July. 7. 2021 re-issued for permit	bg
18.	July. 15. 2021 Issued for Site Instruction #3	bg
19.	July. 27. 2021 Issued for Site Instruction #4	bg
20.	Aug. 3. 2021 Issued for Site Instruction #5	bg
21.	Aug. 18. 2021 Issued for Site Instruction #6	bg
22.	Aug. 20. 2021 Re-issued for permit.	bg
23.	Sept. 07. 2021 Issued for Site Instruction #7	bg
24.	Sept. 09. 2021 Issued for Site Instruction #8	bg
25.	Sept. 16. 2021 Issued for Building D Permit Revisions	bg
26.	Sept. 22. 2021 Issued for Site Instruction #9	bg
27.	Oct. 6. 2021 Re-issued for permit.	bg
28.	Oct. 8. 2021 Issued for Site Instruction #10	bg
30.	Oct. 28. 2021 Issued for Site Instruction #11	bg
31.	Nov. 05. 2021 Issued for Site Instruction #12	bg
32.	Dec. 3. 2021 Issued for Site Instruction #13	bg
33.	Dec. 6. 2021 Issued for Site Instruction #14	bg
34.	Dec. 7. 2021 Issued for Site Instruction #15	bg

01. ~~Sept 28/2019~~ Issued for Addendum 1 bg

issued for revisions

GRAZIANI + CORAZZA ARCHITECTS
1320 SHAWSON DRIVE, SUITE 100 MISSISSAUGA, ONTARIO L4W 1C3
T 905.795.2601 F 905.795.2844 WWW.GC-ARCHITECTS.COM

RESIDENTIAL

ATTMAR + PALLESCHI DRIVE

BRAMPTON ONTARIO

PROJECT ARCHITECT:	B.GRAZIANI
ASSISTANT DESIGNER:	R.LINCOLN
DRAWN BY:	G.C/F.C/M.B
CHECKED BY:	D.BIASE/G.COLANGELO
PLOT DATE:	DEC.13.2021
JOB #	1331.15

SECOND FLOOR PLAN
BUILDING D (PARTIAL PLAN)

1:50

A-302d1

TITLEBLOCK SIZE: 915 x 1200

KEY PLAN

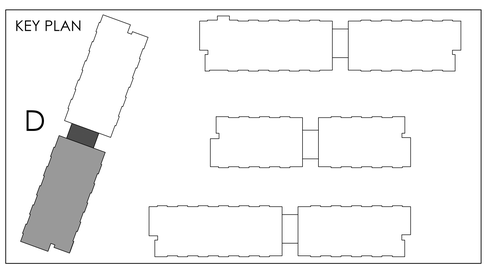

REF. A302a1 FOR CONTINUATION

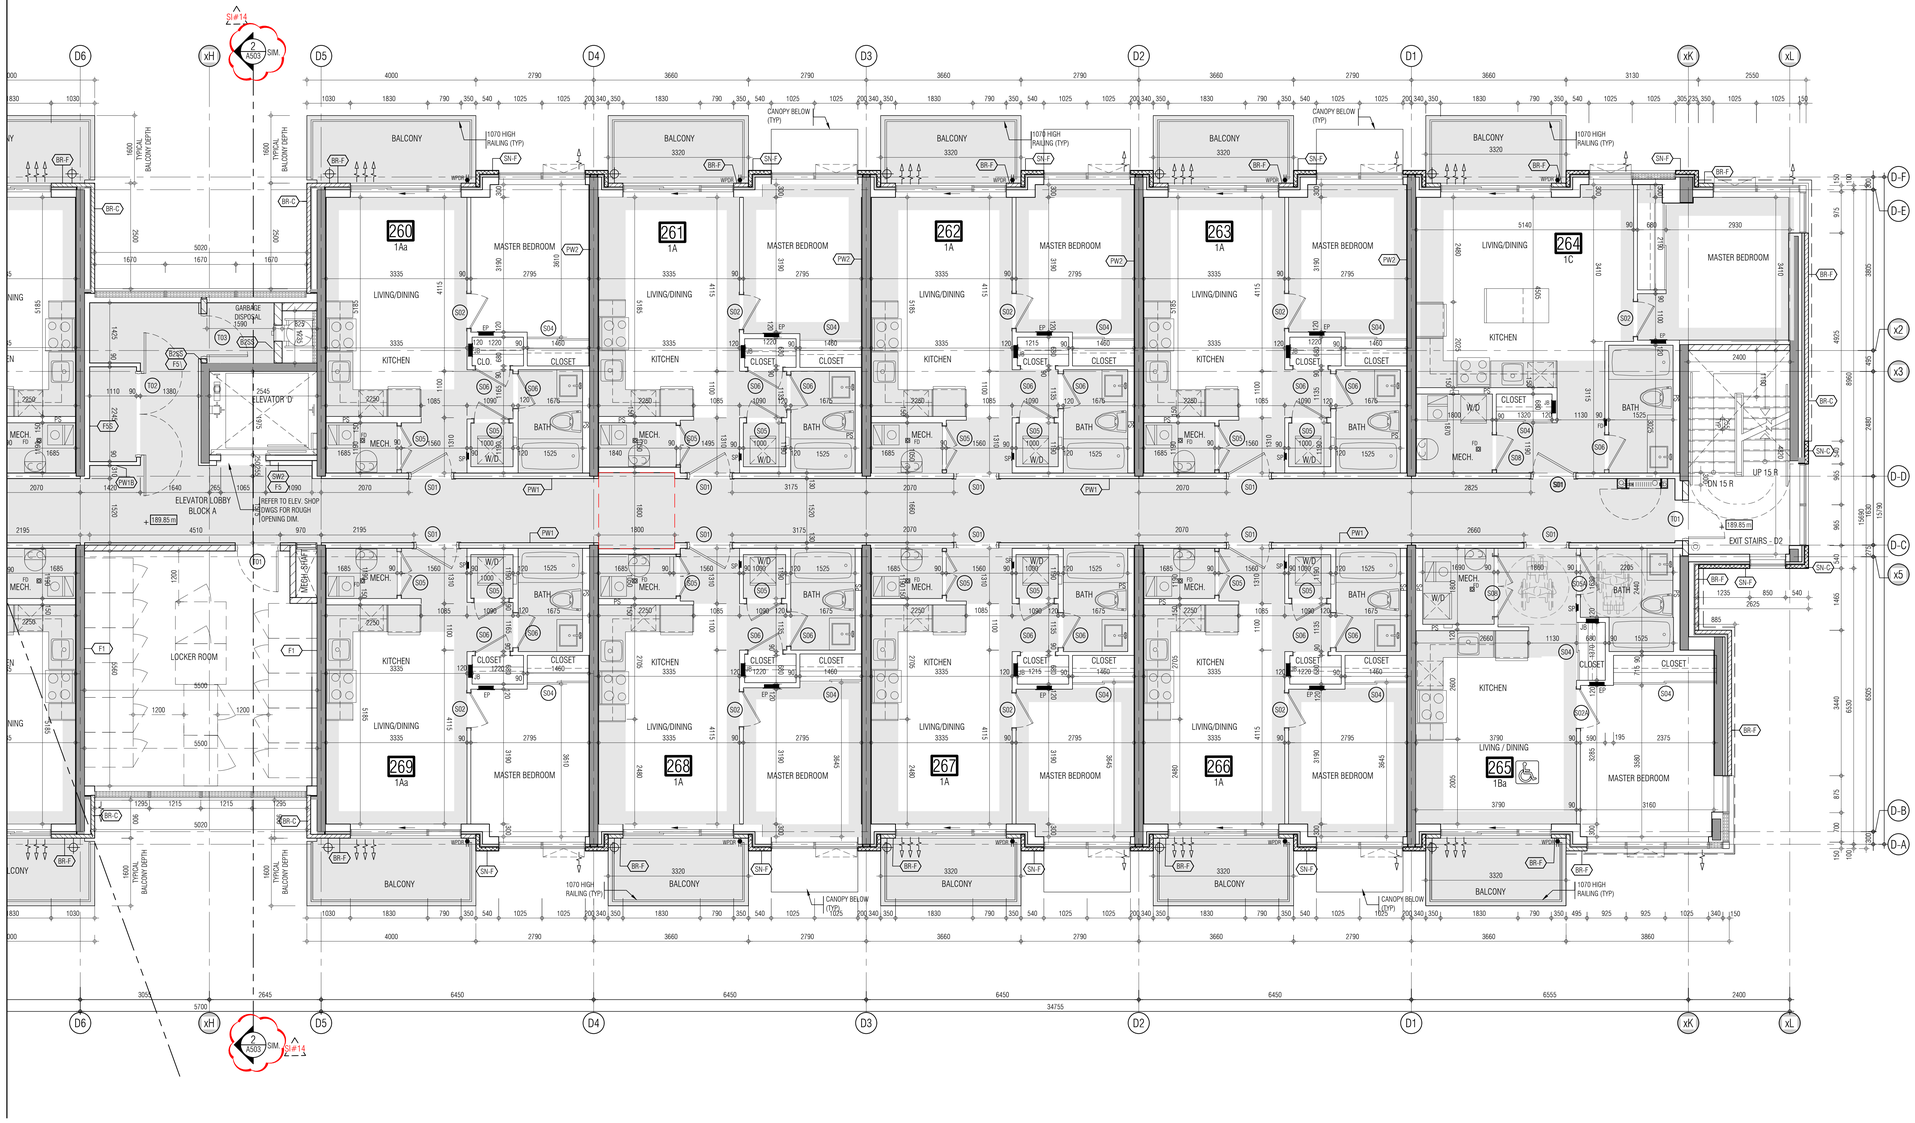

THIS DRAWING, AS AN INSTRUMENT OF SERVICE, IS PROVIDED BY AND IS THE PROPERTY OF GRAZIANI+CORAZZA ARCHITECTS INC. THE CONTRACTOR MUST VERIFY AND ACCEPT RESPONSIBILITY FOR ALL DIMENSIONS AND CONDITIONS ON SITE AND MUST NOTIFY GRAZIANI+CORAZZA ARCHITECTS INC. OF ANY VARIATIONS FROM THE SUPPLIED INFORMATION. GRAZIANI+CORAZZA ARCHITECTS INC. IS NOT RESPONSIBLE FOR THE ACCURACY OF SURVEY, STRUCTURAL, MECHANICAL, ELECTRICAL, AND OTHER ENGINEERING INFORMATION SHOWN ON THIS DRAWING. REFER TO THE APPROPRIATE ENGINEERING DRAWINGS BEFORE PROCEEDING WITH THE WORK. CONSTRUCTION MUST CONFORM TO ALL APPLICABLE CODES AND REQUIREMENTS OF THE AUTHORITIES HAVING JURISDICTION. UNLESS OTHERWISE NOTED, NO INVESTIGATION HAS BEEN UNDERTAKEN OR REPORTED ON BY THIS OFFICE IN REGARDS TO THE ENVIRONMENTAL CONDITION OF THIS SITE.

THIS DRAWING IS NOT TO BE SCALED. ALL ARCHITECTURAL SYMBOLS INDICATED ON THIS DRAWING ARE GRAPHIC REPRESENTATIONS ONLY.

CONDITIONS FOR ELECTRONIC INFORMATION TRANSFER:

ELECTRONIC INFORMATION IS SUPPLIED TO THE OTHER ASSOCIATED FIRMS TO ASSIST THEM IN THE EXECUTION OF THEIR WORK / REVIEW. THE RECIPIENT FIRMS MUST DETERMINE THE COMPLETENESS / APPROPRIATENESS / RELEVANCE OF THE INFORMATION IN RESPECT TO THEIR PARTICULAR RESPONSIBILITY.

GRAZIANI+CORAZZA ARCHITECTS INC. SHALL NOT BE RESPONSIBLE FOR:
1. ERRORS, OMISSIONS, INCOMPLETENESS DUE TO LOSS OF INFORMATION IN WHOLE OR PART WHEN INFORMATION IS TRANSFERRED.
2. TRANSMISSION OF ANY VIRUS OR DAMAGE TO THE RECEIVING ELECTRONIC SYSTEM WHEN INFORMATION IS TRANSFERRED.

01.	Oct.07.2019	issued for tender	___
02.	Mar.13.2020	issued for design coordination #2	___
03.	Mar.16.2020	issued for addendum #2	___
04.	Mar.16.2020	issued for addendum #3	___
05.	Aug.24.2020	issued for addendum #4	___
06.	Sept. 28.2020	issued for permit	bg
07.	Oct.20.2020	issued for addendum #5	___
08.	Nov.23.2020	issued for addendum #6	___
09.	Dec.14.2020	issued for addendum #7	___
10.	Jan.18.2021	issued for addendum #8	___
11.	Mar. 2. 2021	issued for permit	bg
12.	Mar.09.2021	issued for addendum #9	___
13.	Mar.10.2021	issued for addendum #9R	___
14.	Mar.26.2021	issued for progress	___
15.	May 14. 2021	issued for Site Instruction #1	___
16.	June 15. 2021	issued for Site Instruction #2	___
17.	July. 7. 2021	re-issued for permit	bg
18.	July. 15. 2021	Issued for Site Instruction #3	bg
19.	July. 27. 2021	Issued for Site Instruction #4	bg
20.	Aug. 3. 2021	Issued for Site Instruction #5	bg
21.	Aug. 18. 2021	Issued for Site Instruction #6	bg
22.	Aug. 20. 2021	Re-issued for permit.	bg
23.	Sept. 07. 2021	Issued for Site Instruction #7	bg
24.	Sept. 09. 2021	Issued for Site Instruction #8	bg
25.	Sept. 16. 2021	Issued for Building D Permit Revisions	bg
26.	Sept. 22. 2021	Issued for Site Instruction #9	bg
27.	Oct. 6. 2021	Re-issued for permit.	bg
28.	Oct. 8. 2021	Issued for Site Instruction #10	bg
30.	Oct. 28. 2021	Issued for Site Instruction #11	bg
31.	Nov. 05. 2021	Issued for Site Instruction #12	bg
32.	Dec. 3. 2021	Issued for Site Instruction #13	bg
33.	Dec. 6. 2021	Issued for Site Instruction #14	bg
34.	Dec. 7. 2021	Issued for Site Instruction #15	bg

01.	~~SEPT.22/2019~~	~~Issued for Addendum 1~~	bg

issued for revisions

GRAZIANI + CORAZZA ARCHITECTS
1320 SHAWSON DRIVE, SUITE 100 MISSISSAUGA, ONTARIO L4W 1C3
T 905.795.2601 F 905.795.2644 WWW.GC-ARCHITECTS.COM

RESIDENTIAL

ATTMAR + PALLESCHI DRIVE

BRAMPTON	ONTARIO
PROJECT ARCHITECT:	B.GRAZIANI
ASSISTANT DESIGNER:	R.LINCOLN
DRAWN BY:	G.C/F.C/M.B
CHECKED BY:	D.BIASE/G.COLANGELO
PLOT DATE:	DEC.13.2021
JOB #	1331.15

KEY PLAN

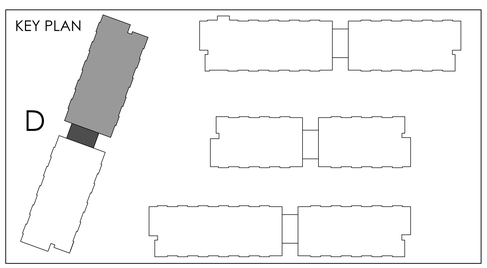

SECOND FLOOR PLAN
BUILDING D (PARTIAL PLAN)

1:50

A-302d2

TITLEBLOCK SIZE: 915 x 1200

THIS DRAWING, AS AN INSTRUMENT OF SERVICE, IS PROVIDED BY AND IS THE PROPERTY OF GRAZIANI+CORAZZA ARCHITECTS INC. THE CONTRACTOR MUST VERIFY AND ACCEPT RESPONSIBILITY FOR ALL DIMENSIONS AND CONDITIONS ON SITE AND MUST NOTIFY GRAZIANI+CORAZZA ARCHITECTS INC. OF ANY VARIATIONS FROM THE SUPPLIED INFORMATION. GRAZIANI+CORAZZA ARCHITECTS INC. IS NOT RESPONSIBLE FOR THE ACCURACY OF SURVEY. STRUCTURAL, MECHANICAL, ELECTRICAL, AND OTHER ENGINEERING INFORMATION SHOWN ON THIS DRAWING. REFER TO THE APPROPRIATE ENGINEERING DRAWINGS BEFORE PROCEEDING WITH THE WORK. CONSTRUCTION MUST CONFORM TO ALL APPLICABLE CODES AND REQUIREMENTS OF THE AUTHORITIES HAVING JURISDICTION. UNLESS OTHERWISE NOTED, NO INVESTIGATION HAS BEEN UNDERTAKEN OR REPORTED ON BY THIS OFFICE IN REGARDS TO THE ENVIRONMENTAL CONDITION OF THIS SITE.

THIS DRAWING IS NOT TO BE SCALED. ALL ARCHITECTURAL SYMBOLS INDICATED ON THIS DRAWING ARE GRAPHIC REPRESENTATIONS ONLY.

CONDITIONS FOR ELECTRONIC INFORMATION TRANSFER:

ELECTRONIC INFORMATION IS SUPPLIED TO THE OTHER ASSOCIATED FIRMS TO ASSIST THEM IN THE EXECUTION OF THEIR WORK / REVIEW. THE RECIPIENT FIRMS MUST DETERMINE THE COMPLETENESS / APPROPRIATENESS / RELEVANCE OF THE INFORMATION IN RESPECT TO THEIR PARTICULAR RESPONSIBILITY.

GRAZIANI+CORAZZA ARCHITECTS INC. SHALL NOT BE RESPONSIBLE FOR:
1. ERRORS, OMISSIONS, INCOMPLETENESS DUE TO LOSS OF INFORMATION IN WHOLE OR PART WHEN INFORMATION IS TRANSFERRED.
2. TRANSMISSION OF ANY VIRUS OR DAMAGE TO THE RECEIVING ELECTRONIC SYSTEM WHEN INFORMATION IS TRANSFERRED.

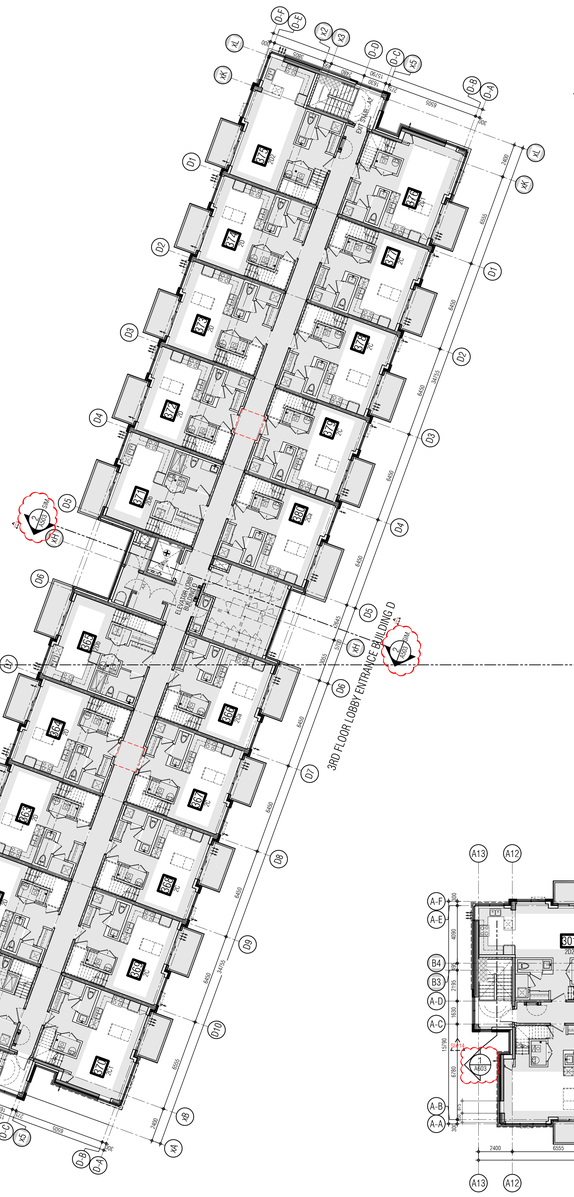

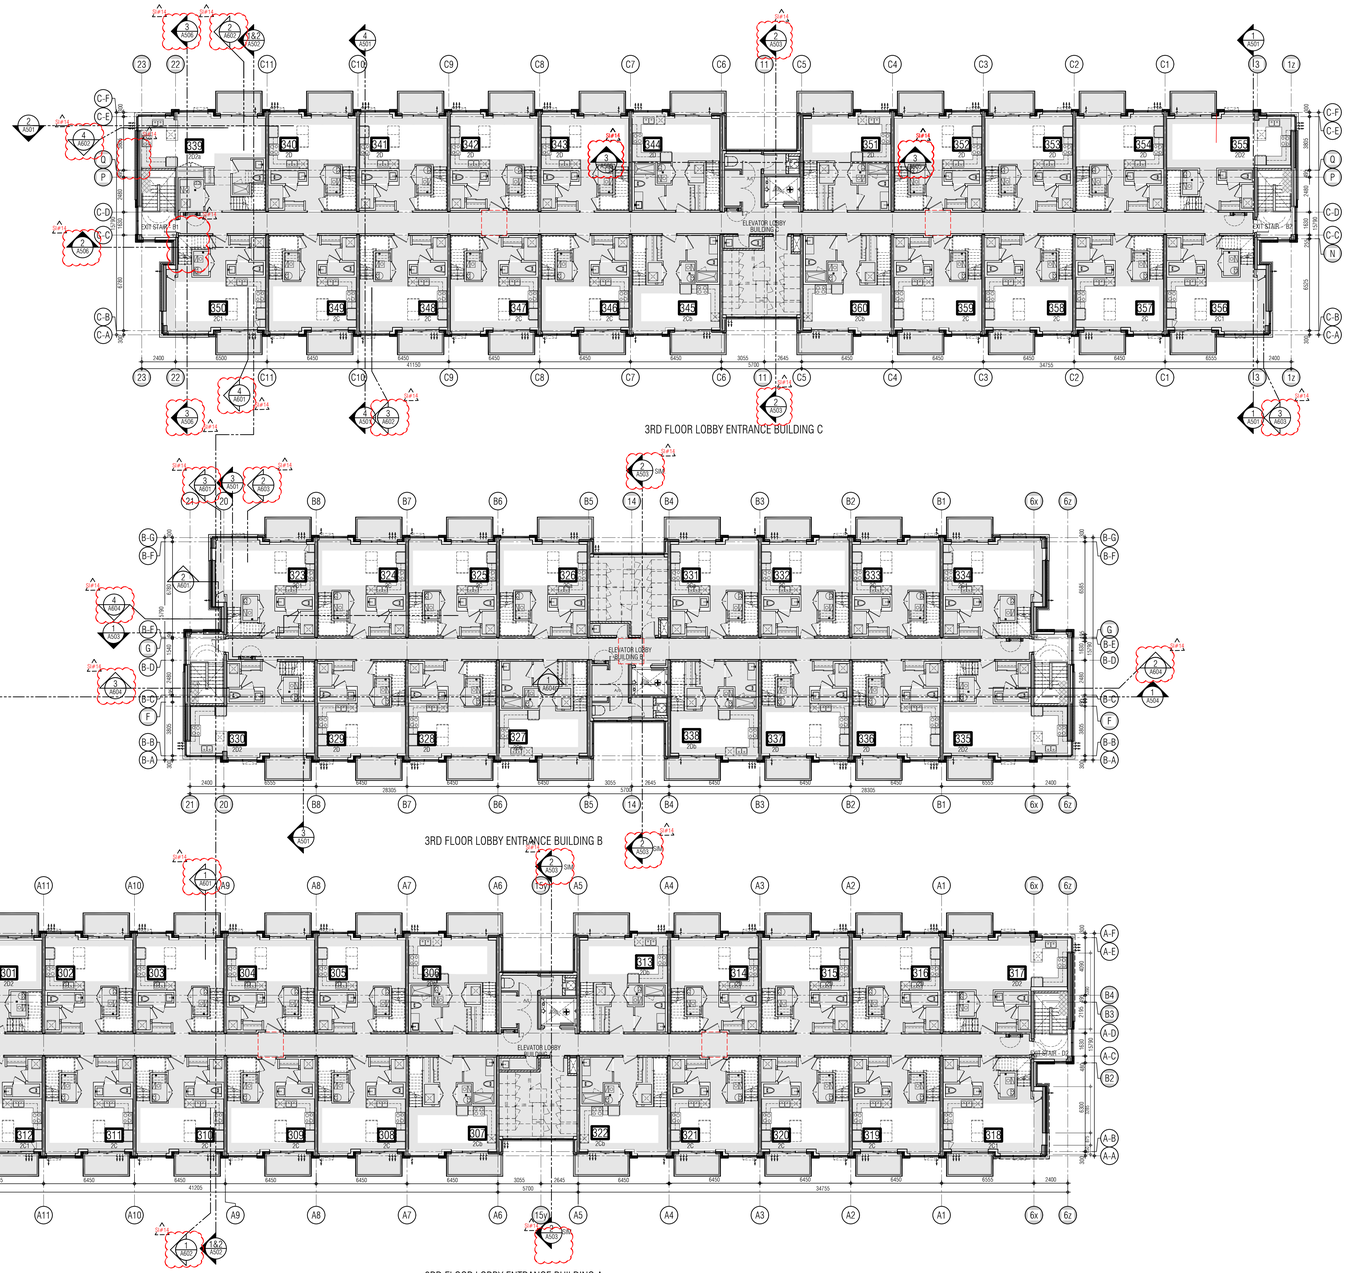

01.	Oct.07.2019	issued for tender	—
02.	Mar.13.2020	issued for design coordination #2	—
03.	Mar.16.2020	issued for addendum #2	—
04.	Mar.16.2020	issued for addendum #3	—
05.	Aug.24.2020	issued for addendum #4	—
06.	Sept. 28.2020	issued for permit	bg
07.	Oct.20.2020	issued for addendum #5	—
08.	Nov.23.2020	issued for addendum #6	—
09.	Dec.14.2020	issued for addendum #7	—
10.	Jan.18.2021	issued for addendum #8	—
11.	Mar. 2. 2021	issued for permit	bg
12.	Mar.09.2021	issued for addendum #9	—
13.	Mar.10.2021	issued for addendum #9R	—
14.	Mar.26.2021	issued for progress	—
15.	May 14. 2021	issued for Site Instruction #1	—
16.	June 15. 2021	issued for Site Instruction #2	—
17.	July. 7. 2021	re-issued for permit	bg
18.	July. 15. 2021	Issued for Site Instruction #3	bg
19.	July. 27. 2021	Issued for Site Instruction #4	bg
20.	Aug. 3. 2021	Issued for Site Instruction #5	bg
21.	Aug. 18. 2021	Issued for Site Instruction #6	bg
22.	Aug. 20. 2021	Re-issued for permit.	bg
23.	Sept. 07. 2021	Issued for Site Instruction #7	bg
24.	Sept. 09. 2021	Issued for Site Instruction #8	bg
25.	Sept. 16. 2021	Issued for Building D Permit Revisions	bg
26.	Sept. 22. 2021	Issued for Site Instruction #9	bg
27.	Oct. 6. 2021	Re-issued for permit.	bg
28.	Oct. 8. 2021	Issued for Site Instruction #10	bg
30.	Oct. 28. 2021	Issued for Site Instruction #11	bg
31.	Nov. 05. 2021	Issued for Site Instruction #12	bg
32.	Dec. 3. 2021	Issued for Site Instruction #13	bg
33.	Dec. 6. 2021	Issued for Site Instruction #14	bg
34.	Dec. 7. 2021	Issued for Site Instruction #15	bg

01.	SEP 18, 2019	Issued for Adendum 1	—
01.	Apr.19.2021	issued to client	bg

issued for revisions

GRAZIANI + CORAZZA ARCHITECTS
1320 SHARON DRIVE, SUITE 100 MISSISSAUGA, ONTARIO L4W 1C3
T.905.795.7601 F.905.795.2644 WWW.GC-ARCHITECTS.COM

RESIDENTIAL

ATTMAR + PALLESCHI DRIVE

BRAMPTON	ONTARIO
PROJECT ARCHITECT:	B.GRAZIANI
ASSISTANT DESIGNER:	R.LINCOLN
DRAWN BY:	G.C/F.C/M.B
CHECKED BY:	D.BIASE/G.COLANGELO
PLOT DATE:	DEC.13.2021
JOB #:	1331.15

THIRD FLOOR OVERALL PLAN

1:150

A303

TITLEBLOCK SIZE: 915 x 1200

THIS DRAWING, AS AN INSTRUMENT OF SERVICE, IS PROVIDED BY AND IS THE PROPERTY OF GRAZIANI+CORAZZA ARCHITECTS INC. THE CONTRACTOR MUST VERIFY AND ACCEPT RESPONSIBILITY FOR ALL DIMENSIONS AND CONDITIONS ON SITE AND MUST NOTIFY GRAZIANI+CORAZZA ARCHITECTS INC. OF ANY VARIATIONS FROM THE SUPPLIED INFORMATION. GRAZIANI+CORAZZA ARCHITECTS INC. IS NOT RESPONSIBLE FOR THE ACCURACY OF SURVEY, STRUCTURAL, MECHANICAL, ELECTRICAL, AND OTHER ENGINEERING INFORMATION SHOWN ON THIS DRAWING. REFER TO THE APPROPRIATE ENGINEERING DRAWINGS BEFORE PROCEEDING WITH THE WORK. CONSTRUCTION MUST CONFORM TO ALL APPLICABLE CODES AND REQUIREMENTS OF THE AUTHORITIES HAVING JURISDICTION. UNLESS OTHERWISE NOTED, NO INVESTIGATION HAS BEEN UNDERTAKEN OR REPORTED ON BY THIS OFFICE IN REGARDS TO THE ENVIRONMENTAL CONDITION OF THIS SITE.

THIS DRAWING IS NOT TO BE SCALED. ALL ARCHITECTURAL SYMBOLS INDICATED ON THIS DRAWING ARE GRAPHIC REPRESENTATIONS ONLY.

CONDITIONS FOR ELECTRONIC INFORMATION TRANSFER:

ELECTRONIC INFORMATION IS SUPPLIED TO THE OTHER ASSOCIATED FIRMS TO ASSIST THEM IN THE EXECUTION OF THEIR WORK / REVIEW. THE RECIPIENT FIRMS MUST DETERMINE THE COMPLETENESS / APPROPRIATENESS / RELEVANCE OF THE INFORMATION IN RESPECT TO THEIR PARTICULAR RESPONSIBILITY.

GRAZIANI+CORAZZA ARCHITECTS INC. SHALL NOT BE RESPONSIBLE FOR:
1. ERRORS, OMISSIONS, INCOMPLETENESS DUE TO LOSS OF INFORMATION IN WHOLE OR PART WHEN INFORMATION IS TRANSFERRED.
2. TRANSMISSION OF ANY VIRUS OR DAMAGE TO THE RECEIVING ELECTRONIC SYSTEM WHEN INFORMATION IS TRANSFERRED.

REF. A303d2 FOR CONTINUATION

01.	Oct.07.2019 issued for tender	___
02.	Mar.13.2020 issued for design coordination #2	___
03.	Mar.16.2020 issued for addendum #2	___
04.	Mar.16.2020 issued for addendum #3	___
05.	Aug.24.2020 issued for addendum #4	___
06.	Sept. 28.2020 issued for permit	bg
07.	Oct.20.2020 issued for addendum #5	___
08.	Nov.23.2020 issued for addendum #6	___
09.	Dec.14.2020 issued for addendum #7	___
10.	Jan.18.2021 issued for addendum #8	___
11.	Mar. 2. 2021 issued for permit	bg
12.	Mar.09.2021 issued for addendum #9	___
13.	Mar.10.2021 issued for addendum #9R	___
14.	Mar.26.2021 issued for progress	___
15.	May 14. 2021 issued for Site Instruction #1	___
16.	June 15. 2021 issued for Site Instruction #2	___
17.	July. 7. 2021 re-issued for permit	bg
18.	July. 15. 2021 Issued for Site Instruction #3	bg
19.	July. 27. 2021 Issued for Site Instruction #4	bg
20.	Aug. 3. 2021 Issued for Site Instruction #5	bg
21.	Aug. 18. 2021 Issued for Site Instruction #6	bg
22.	Aug. 20. 2021 Re-issued for permit.	bg
23.	Sept. 07. 2021 Issued for Site Instruction #7	bg
24.	Sept. 09. 2021 Issued for Site Instruction #8	bg
25.	Sept. 16. 2021 Issued for Building D Permit Revisions	bg
26.	Sept. 22. 2021 Issued for Site Instruction #9	bg
27.	Oct. 6. 2021 Re-issued for permit.	bg
28.	Oct. 8. 2021 Issued for Site Instruction #10	bg
30.	Oct. 28. 2021 Issued for Site Instruction #11	bg
31.	Nov. 05. 2021 Issued for Site Instruction #12	bg
32.	Dec. 3. 2021 Issued for Site Instruction #13	bg
33.	Dec. 6. 2021 Issued for Site Instruction #14	bg
34.	Dec. 7. 2021 Issued for Site Instruction #15	bg

01. ~~SEPT.16.2019~~ Issued for Addendum 1 bg

issued for revisions

GRAZIANI + CORAZZA ARCHITECTS
1320 SHAWSON DRIVE, SUITE 100 MISSISSAUGA, ONTARIO L4W 1C3
T 905.795.2601 F 905.795.2644 WWW.GC-ARCHITECTS.COM

RESIDENTIAL

ATTMAR + PALLESCHI DRIVE

BRAMPTON ONTARIO

PROJECT ARCHITECT:	B.GRAZIANI
ASSISTANT DESIGNER:	R.LINCOLN
DRAWN BY:	G.C/F.C/M.B
CHECKED BY:	D.BIASE/G.COLANGELO
PLOT DATE:	DEC.13.2021
JOB #	1331.15

THIRD FLOOR PLAN
BUILDING A (PARTIAL PLAN)

1:50

A-303a1

TITLEBLOCK SIZE: 915 x 1200

KEY PLAN

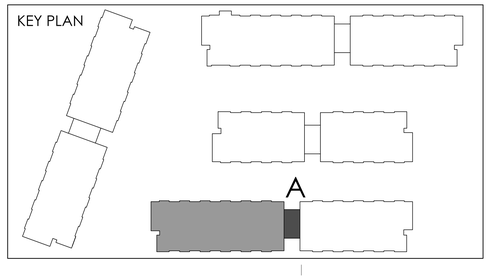

REF.A303d1 FOR CONTINUATION

THIS DRAWING, AS AN INSTRUMENT OF SERVICE, IS PROVIDED BY AND IS THE PROPERTY OF GRAZIANI+CORAZZA ARCHITECTS INC. THE CONTRACTOR MUST VERIFY AND ACCEPT RESPONSIBILITY FOR ALL DIMENSIONS AND CONDITIONS ON SITE AND MUST NOTIFY GRAZIANI+CORAZZA ARCHITECTS INC. OF ANY VARIATIONS FROM THE SUPPLIED INFORMATION. GRAZIANI+CORAZZA ARCHITECTS INC. IS NOT RESPONSIBLE FOR THE ACCURACY OF SURVEY, STRUCTURAL, MECHANICAL, ELECTRICAL, AND OTHER ENGINEERING INFORMATION SHOWN ON THIS DRAWING. REFER TO THE APPROPRIATE ENGINEERING DRAWINGS BEFORE PROCEEDING WITH THE WORK. CONSTRUCTION MUST CONFORM TO ALL APPLICABLE CODES AND REQUIREMENTS OF THE AUTHORITIES HAVING JURISDICTION. UNLESS OTHERWISE NOTED, NO INVESTIGATION HAS BEEN UNDERTAKEN OR REPORTED ON BY THIS OFFICE IN REGARDS TO THE ENVIRONMENTAL CONDITION OF THIS SITE.

THIS DRAWING IS NOT TO BE SCALED. ALL ARCHITECTURAL SYMBOLS INDICATED ON THIS DRAWING ARE GRAPHIC REPRESENTATIONS ONLY.

CONDITIONS FOR ELECTRONIC INFORMATION TRANSFER:

ELECTRONIC INFORMATION IS SUPPLIED TO THE OTHER ASSOCIATED FIRMS TO ASSIST THEM IN THE EXECUTION OF THEIR WORK / REVIEW. THE RECIPIENT FIRMS MUST DETERMINE THE COMPLETENESS / APPROPRIATENESS / RELEVANCE OF THE INFORMATION IN RESPECT TO THEIR PARTICULAR RESPONSIBILITY.

GRAZIANI+CORAZZA ARCHITECTS INC. SHALL NOT BE RESPONSIBLE FOR:
1. ERRORS, OMISSIONS, INCOMPLETENESS DUE TO LOSS OF INFORMATION IN WHOLE OR PART WHEN INFORMATION IS TRANSFERRED.
2. TRANSMISSION OF ANY VIRUS OR DAMAGE TO THE RECEIVING ELECTRONIC SYSTEM WHEN INFORMATION IS TRANSFERRED.

01.	Oct.07.2019	issued for tender	___
02.	Mar.13.2020	issued for design coordination #2	___
03.	Mar.16.2020	issued for addendum #2	___
04.	Mar.16.2020	issued for addendum #3	___
05.	Aug.24.2020	issued for addendum #4	___
06.	Sept. 28.2020	issued for permit	bg
07.	Oct.20.2020	issued for addendum #5	___
08.	Nov.23.2020	issued for addendum #6	___
09.	Dec.14.2020	issued for addendum #7	___
10.	Jan.18.2021	issued for addendum #8	___
11.	Mar. 2. 2021	issued for permit	bg
12.	Mar.09.2021	issued for addendum #9	___
13.	Mar.10.2021	issued for addendum #9R	___
14.	Mar.26.2021	issued for progress	___
15.	May 14. 2021	issued for Site Instruction #1	___
16.	June 15. 2021	issued for Site Instruction #2	___
17.	July. 7. 2021	re-issued for permit	bg
18.	July. 15. 2021	Issued for Site Instruction #3	bg
19.	July. 27. 2021	Issued for Site Instruction #4	bg
20.	Aug. 3. 2021	Issued for Site Instruction #5	bg
21.	Aug. 18. 2021	Issued for Site Instruction #6	bg
22.	Aug. 20. 2021	Re-issued for permit.	bg
23.	Sept. 07. 2021	Issued for Site Instruction #7	bg
24.	Sept. 09. 2021	Issued for Site Instruction #8	bg
25.	Sept. 16. 2021	Issued for Building D Permit Revisions	bg
26.	Sept. 22. 2021	Issued for Site Instruction #9	bg
27.	Oct. 6. 2021	Re-issued for permit.	bg
28.	Oct. 8. 2021	Issued for Site Instruction #10	bg
30.	Oct. 28. 2021	Issued for Site Instruction #11	bg
31.	Nov. 05. 2021	Issued for Site Instruction #12	bg
32.	Dec. 3. 2021	Issued for Site Instruction #13	bg
33.	Dec. 6. 2021	Issued for Site Instruction #14	bg
34.	Dec. 7. 2021	Issued for Site Instruction #15	bg

KEY PLAN

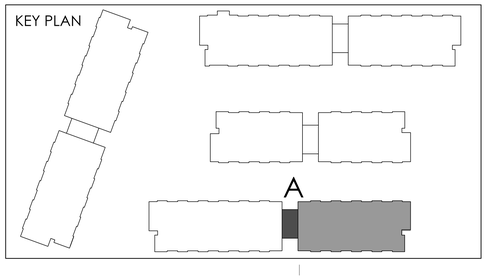

01. SEPT.12.2019 Issued for Addendum 1 bg

issued for revisions

GRAZIANI + CORAZZA ARCHITECTS
1320 SHARON DRIVE, SUITE 100 MISSISSAUGA, ONTARIO L4W 1C3
T.905.795.7601 F.905.795.2844 WWW.GC-ARCHITECTS.COM

RESIDENTIAL

ATTMAR + PALLESCHI DRIVE

BRAMPTON ONTARIO

PROJECT ARCHITECT:	B.GRAZIANI
ASSISTANT DESIGNER:	R.LINCOLN
DRAWN BY:	G.C/F.C/M.B
CHECKED BY:	D.BIASE/G.COLANGELO
PLOT DATE:	DEC.13.2021
JOB #:	1331.15

THIRD FLOOR PLAN
BUILDING A (PARTIAL PLAN)

1:50

A-303a2

TITLEBLOCK SIZE: 915 x 1200

THIS DRAWING, AS AN INSTRUMENT OF SERVICE, IS PROVIDED BY AND IS THE PROPERTY OF GRAZIANI+CORAZZA ARCHITECTS INC. THE CONTRACTOR MUST VERIFY AND ACCEPT RESPONSIBILITY FOR ALL DIMENSIONS AND CONDITIONS ON SITE AND MUST NOTIFY GRAZIANI+CORAZZA ARCHITECTS INC. OF ANY VARIATIONS FROM THE SUPPLIED INFORMATION. GRAZIANI+CORAZZA ARCHITECTS INC. IS NOT RESPONSIBLE FOR THE ACCURACY OF SURVEY, STRUCTURAL, MECHANICAL, ELECTRICAL, AND OTHER ENGINEERING INFORMATION SHOWN ON THIS DRAWING. REFER TO THE APPROPRIATE ENGINEERING DRAWINGS BEFORE PROCEEDING WITH THE WORK. CONSTRUCTION MUST CONFORM TO ALL APPLICABLE CODES AND REQUIREMENTS OF THE AUTHORITIES HAVING JURISDICTION. UNLESS OTHERWISE NOTED, NO INVESTIGATION HAS BEEN UNDERTAKEN OR REPORTED ON BY THIS OFFICE IN REGARDS TO THE ENVIRONMENTAL CONDITION OF THIS SITE.

THIS DRAWING IS NOT TO BE SCALED. ALL ARCHITECTURAL SYMBOLS INDICATED ON THIS DRAWING ARE GRAPHIC REPRESENTATIONS ONLY.

CONDITIONS FOR ELECTRONIC INFORMATION TRANSFER:

ELECTRONIC INFORMATION IS SUPPLIED TO THE OTHER ASSOCIATED FIRMS TO ASSIST THEM IN THE EXECUTION OF THEIR WORK / REVIEW. THE RECIPIENT FIRMS MUST DETERMINE THE COMPLETENESS / APPROPRIATENESS / RELEVANCE OF THE INFORMATION IN RESPECT TO THEIR PARTICULAR RESPONSIBILITY.

GRAZIANI+CORAZZA ARCHITECTS INC. SHALL NOT BE RESPONSIBLE FOR:
1. ERRORS, OMISSIONS, INCOMPLETENESS DUE TO LOSS OF INFORMATION IN WHOLE OR PART WHEN INFORMATION IS TRANSFERRED.
2. TRANSMISSION OF ANY VIRUS OR DAMAGE TO THE RECEIVING ELECTRONIC SYSTEM WHEN INFORMATION IS TRANSFERRED.

REF. A303c2 FOR CONTINUATION

01.	Oct.07.2019	issued for tender	___
02.	Mar.13.2020	issued for design coordination #2	___
03.	Mar.16.2020	issued for addendum #2	___
04.	Mar.16.2020	issued for addendum #3	___
05.	Aug.24.2020	issued for addendum #4	___
06.	Sept. 28.2020	issued for permit	bg
07.	Oct.20.2020	issued for addendum #5	___
08.	Nov.23.2020	issued for addendum #6	___
09.	Dec.14.2020	issued for addendum #7	___
10.	Jan.18.2021	issued for addendum #8	___
11.	Mar. 2. 2021	issued for permit	bg
12.	Mar.09.2021	issued for addendum #9	___
13.	Mar.10.2021	issued for addendum #9R	___
14.	Mar.26.2021	issued for progress	___
15.	May 14. 2021	issued for Site Instruction #1	___
16.	June 15. 2021	issued for Site Instruction #2	___
17.	July. 7. 2021	re-issued for permit	bg
18.	July. 15. 2021	Issued for Site Instruction #3	bg
19.	July. 27. 2021	Issued for Site Instruction #4	bg
20.	Aug. 3. 2021	Issued for Site Instruction #5	bg
21.	Aug. 18. 2021	Issued for Site Instruction #6	bg
22.	Aug. 20. 2021	Re-issued for permit.	bg
23.	Sept. 07. 2021	Issued for Site Instruction #7	bg
24.	Sept. 09. 2021	Issued for Site Instruction #8	bg
25.	Sept. 16. 2021	Issued for Building D Permit Revisions	bg
26.	Sept. 22. 2021	Issued for Site Instruction #9	bg
27.	Oct. 6. 2021	Re-issued for permit.	bg
28.	Oct. 8. 2021	Issued for Site Instruction #10	bg
30.	Oct. 28. 2021	Issued for Site Instruction #11	bg
31.	Nov. 05. 2021	Issued for Site Instruction #12	bg
32.	Dec. 3. 2021	Issued for Site Instruction #13	bg
33.	Dec. 6. 2021	Issued for Site Instruction #14	bg
34.	Dec. 7. 2021	Issued for Site Instruction #15	bg

01. SEPT.12.2019 Issued for Addendum 1 bg

issued for revisions

GRAZIANI + CORAZZA ARCHITECTS
1320 CHARLSON DRIVE, SUITE 100, MISSISSAUGA, ONTARIO, L4W 1C3
T 905.799.2601 F 905.799.2644 WWW.GC-ARCHITECTS.COM

RESIDENTIAL

ATTMAR + PALLESCHI DRIVE

BRAMPTON ONTARIO

PROJECT ARCHITECT:	B.GRAZIANI
ASSISTANT DESIGNER:	R.LINCOLN
DRAWN BY:	G.C/F.C/M.B
CHECKED BY:	D.BIASE/G.COLANGELO
PLOT DATE:	DEC.13.2021
JOB #	1331.15

THIRD FLOOR PLAN
BUILDING B (PARTIAL PLAN)

1:50

A-303b1

TITLEBLOCK SIZE: 915 x 1200

KEY PLAN

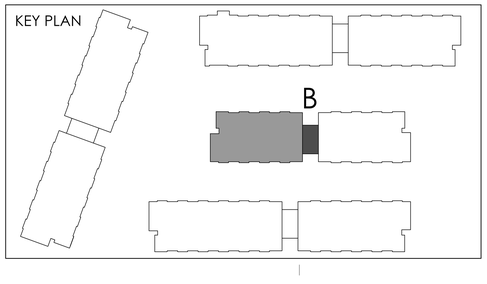

REF.A303c1 FOR CONTINUATION

THIS DRAWING, AS AN INSTRUMENT OF SERVICE, IS PROVIDED BY AND IS THE PROPERTY OF GRAZIANI+CORAZZA ARCHITECTS INC. THE CONTRACTOR MUST VERIFY AND ACCEPT RESPONSIBILITY FOR ALL DIMENSIONS AND CONDITIONS ON SITE AND MUST NOTIFY GRAZIANI+CORAZZA ARCHITECTS INC. OF ANY VARIATIONS FROM THE SUPPLIED INFORMATION. GRAZIANI+CORAZZA ARCHITECTS INC. IS NOT RESPONSIBLE FOR THE ACCURACY OF SURVEY, STRUCTURAL, MECHANICAL, ELECTRICAL, AND OTHER ENGINEERING INFORMATION SHOWN ON THIS DRAWING. REFER TO THE APPROPRIATE ENGINEERING DRAWINGS BEFORE PROCEEDING WITH THE WORK. CONSTRUCTION MUST CONFORM TO ALL APPLICABLE CODES AND REQUIREMENTS OF THE AUTHORITIES HAVING JURISDICTION. UNLESS OTHERWISE NOTED, NO INVESTIGATION HAS BEEN UNDERTAKEN OR REPORTED ON BY THIS OFFICE IN REGARDS TO THE ENVIRONMENTAL CONDITION OF THIS SITE.

THIS DRAWING IS NOT TO BE SCALED. ALL ARCHITECTURAL SYMBOLS INDICATED ON THIS DRAWING ARE GRAPHIC REPRESENTATIONS ONLY.

CONDITIONS FOR ELECTRONIC INFORMATION TRANSFER:

ELECTRONIC INFORMATION IS SUPPLIED TO THE OTHER ASSOCIATED FIRMS TO ASSIST THEM IN THE EXECUTION OF THEIR WORK / REVIEW. THE RECIPIENT FIRMS MUST DETERMINE THE COMPLETENESS / APPROPRIATENESS / RELEVANCE OF THE INFORMATION IN RESPECT TO THEIR PARTICULAR RESPONSIBILITY.

GRAZIANI + CORAZZA ARCHITECTS INC. SHALL NOT BE RESPONSIBLE FOR:
1. ERRORS, OMISSIONS, INCOMPLETENESS DUE TO LOSS OF INFORMATION IN WHOLE OR PART WHEN INFORMATION IS TRANSFERRED.
2. TRANSMISSION OF ANY VIRUS OR DAMAGE TO THE RECEIVING ELECTRONIC SYSTEM WHEN INFORMATION IS TRANSFERRED.

01.	Oct.07.2019	issued for tender	___
02.	Mar.13.2020	issued for design coordination #2	___
03.	Mar.16.2020	issued for addendum #2	___
04.	Mar.16.2020	issued for addendum #3	___
05.	Aug.24.2020	issued for addendum #4	___
06.	Sept. 28.2020	issued for permit	bg
07.	Oct.20.2020	issued for addendum #5	___
08.	Nov.23.2020	issued for addendum #6	___
09.	Dec.14.2020	issued for addendum #7	___
10.	Jan.18.2021	issued for addendum #8	___
11.	Mar. 2. 2021	issued for permit	bg
12.	Mar.09.2021	issued for addendum #9	___
13.	Mar.10.2021	issued for addendum #9R	___
14.	Mar.26.2021	issued for progress	___
15.	May 14. 2021	issued for Site Instruction #1	___
16.	June 15. 2021	issued for Site Instruction #2	___
17.	July. 7. 2021	re-issued for permit	bg
18.	July. 15. 2021	Issued for Site Instruction #3	bg
19.	July. 27. 2021	Issued for Site Instruction #4	bg
20.	Aug. 3. 2021	Issued for Site Instruction #5	bg
21.	Aug. 18. 2021	Issued for Site Instruction #6	bg
22.	Aug. 20. 2021	Re-issued for permit.	bg
23.	Sept. 07. 2021	Issued for Site Instruction #7	bg
24.	Sept. 09. 2021	Issued for Site Instruction #8	bg
25.	Sept. 16. 2021	Issued for Building D Permit Revisions	bg
26.	Sept. 22. 2021	Issued for Site Instruction #9	bg
27.	Oct. 6. 2021	Re-issued for permit.	bg
28.	Oct. 8. 2021	Issued for Site Instruction #10	bg
30.	Oct. 28. 2021	Issued for Site Instruction #11	bg
31.	Nov. 05. 2021	Issued for Site Instruction #12	bg
32.	Dec. 3. 2021	Issued for Site Instruction #13	bg
33.	Dec. 6. 2021	Issued for Site Instruction #14	bg
34.	Dec. 7. 2021	Issued for Site Instruction #15	bg

KEY PLAN

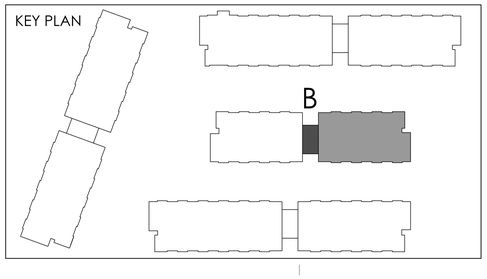

01. SEP.13.2019 Issued for Addendum 1 bg

issued for revisions

GRAZIANI + CORAZZA ARCHITECTS
1320 SHAWSON DRIVE, SUITE 100 MISSISSAUGA, ONTARIO L4W 1C3
T 905.795.7601 F 905.795.2844 WWW.GC-ARCHITECTS.COM

RESIDENTIAL

ATTMAR + PALLESCHI DRIVE

BRAMPTON	ONTARIO
PROJECT ARCHITECT:	B.GRAZIANI
ASSISTANT DESIGNER:	R.LINCOLN
DRAWN BY:	G.C/F.C/M.B
CHECKED BY:	D.BIASE/G.COLANGELO
PLOT DATE:	DEC.13.2021
JOB #:	1331.15

THIRD FLOOR PLAN
BUILDING B (PARTIAL PLAN)

1:50

A-303b2

TITLEBLOCK SIZE: 915 x 1200

THIS DRAWING, AS AN INSTRUMENT OF SERVICE, IS PROVIDED BY AND IS THE PROPERTY OF GRAZIANI+CORAZZA ARCHITECTS INC. THE CONTRACTOR MUST VERIFY AND ACCEPT RESPONSIBILITY FOR ALL DIMENSIONS AND CONDITIONS ON SITE AND MUST NOTIFY GRAZIANI+CORAZZA ARCHITECTS INC. OF ANY VARIATIONS FROM THE SUPPLIED INFORMATION. GRAZIANI+CORAZZA ARCHITECTS INC. IS NOT RESPONSIBLE FOR THE ACCURACY OF SURVEY, STRUCTURAL, MECHANICAL, ELECTRICAL, AND OTHER ENGINEERING INFORMATION SHOWN ON THIS DRAWING. REFER TO THE APPROPRIATE ENGINEERING DRAWINGS BEFORE PROCEEDING WITH THE WORK. CONSTRUCTION MUST CONFORM TO ALL APPLICABLE CODES AND REQUIREMENTS OF THE AUTHORITIES HAVING JURISDICTION. UNLESS OTHERWISE NOTED, NO INVESTIGATION HAS BEEN UNDERTAKEN OR REPORTED ON BY THIS OFFICE IN REGARDS TO THE ENVIRONMENTAL CONDITION OF THIS SITE.

THIS DRAWING IS NOT TO BE SCALED. ALL ARCHITECTURAL SYMBOLS INDICATED ON THIS DRAWING ARE GRAPHIC REPRESENTATIONS ONLY.

CONDITIONS FOR ELECTRONIC INFORMATION TRANSFER:

ELECTRONIC INFORMATION IS SUPPLIED TO THE OTHER ASSOCIATED FIRMS TO ASSIST THEM IN THE EXECUTION OF THEIR WORK / REVIEW. THE RECIPIENT FIRMS MUST DETERMINE THE COMPLETENESS / APPROPRIATENESS / RELEVANCE OF THE INFORMATION IN RESPECT TO THEIR PARTICULAR RESPONSIBILITY.

GRAZIANI + CORAZZA ARCHITECTS INC. SHALL NOT BE RESPONSIBLE FOR:
1. ERRORS, OMISSIONS, INCOMPLETENESS DUE TO LOSS OF INFORMATION IN WHOLE OR PART WHEN INFORMATION IS TRANSFERRED.
2. TRANSMISSION OF ANY VIRUS OR DAMAGE TO THE RECEIVING ELECTRONIC SYSTEM WHEN INFORMATION IS TRANSFERRED.

REF. A303b2 FOR CONTINUATION

01.	Oct.07.2019 issued for tender	___
02.	Mar.13.2020 issued for design coordination #2	___
03.	Mar.16.2020 issued for addendum #2	___
04.	Mar.16.2020 issued for addendum #3	___
05.	Aug.24.2020 issued for addendum #4	___
06.	Sept. 28.2020 issued for permit	bg
07.	Oct.20.2020 issued for addendum #5	___
08.	Nov.23.2020 issued for addendum #6	___
09.	Dec.14.2020 issued for addendum #7	___
10.	Jan.18.2021 issued for addendum #8	___
11.	Mar. 2. 2021 issued for permit	bg
12.	Mar.09.2021 issued for addendum #9	___
13.	Mar.10.2021 issued for addendum #9R	___
14.	Mar.26.2021 issued for progress	___
15.	May 14. 2021 issued for Site Instruction #1	___
16.	June 15. 2021 issued for Site Instruction #2	___
17.	July. 7. 2021 re-issued for permit	bg
18.	July. 15. 2021 Issued for Site Instruction #3	bg
19.	July. 27. 2021 Issued for Site Instruction #4	bg
20.	Aug. 3. 2021 Issued for Site Instruction #5	bg
21.	Aug. 18. 2021 Issued for Site Instruction #6	bg
22.	Aug. 20. 2021 Re-issued for permit.	bg
23.	Sept. 07. 2021 Issued for Site Instruction #7	bg
24.	Sept. 09. 2021 Issued for Site Instruction #8	bg
25.	Sept. 16. 2021 Issued for Building D Permit Revisions	bg
26.	Sept. 22. 2021 Issued for Site Instruction #9	bg
27.	Oct. 6. 2021 Re-issued for permit.	bg
28.	Oct. 8. 2021 Issued for Site Instruction #10	bg
30.	Oct. 28. 2021 Issued for Site Instruction #11	bg
31.	Nov. 05. 2021 Issued for Site Instruction #12	bg
32.	Dec. 3. 2021 Issued for Site Instruction #13	bg
33.	Dec. 6. 2021 Issued for Site Instruction #14	bg
34.	Dec. 7. 2021 Issued for Site Instruction #15	bg

01. Sept.28.2019 Issued for tender / Addendum 1 bg

issued for revisions

GRAZIANI CORAZZA ARCHITECTS
1320 DAMSON DRIVE, SUITE 100 MISSISSAUGA ONTARIO L4W 1C3
T 905.795.2501 F 905.795.2644 WWW.GC-ARCHITECTS.COM

RESIDENTIAL

ROYAL PINE

ATTMAR + PALLESCHI DRIVE

BRAMPTON ONTARIO

PROJECT ARCHITECT:	B.GRAZIANI
ASSISTANT DESIGNER:	R.LINCOLN
DRAWN BY:	G.C/F.C/M.B
CHECKED BY:	D.BIASE/G.COLANGELO
PLOT DATE:	DEC.13.2021
JOB #	1331.15

THIRD FLOOR PLAN
BUILDING C (PARTIAL PLAN)

1:50

A-303c1

TITLEBLOCK SIZE: 915 x 1200

KEY PLAN

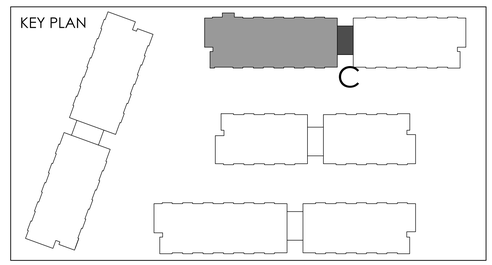

REF. A303b1 FOR CONTINUATION

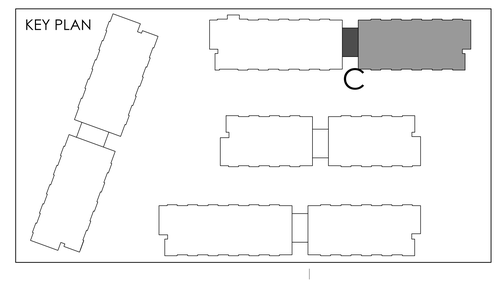

THIS DRAWING, AS AN INSTRUMENT OF SERVICE, IS PROVIDED BY AND IS THE PROPERTY OF GRAZIANI+CORAZZA ARCHITECTS INC. THE CONTRACTOR MUST VERIFY AND ACCEPT RESPONSIBILITY FOR ALL DIMENSIONS AND CONDITIONS ON SITE AND MUST NOTIFY GRAZIANI+CORAZZA ARCHITECTS INC. OF ANY VARIATIONS FROM THE SUPPLIED INFORMATION. GRAZIANI+CORAZZA ARCHITECTS INC. IS NOT RESPONSIBLE FOR THE ACCURACY OF SURVEY, STRUCTURAL, MECHANICAL, ELECTRICAL, AND OTHER ENGINEERING INFORMATION SHOWN ON THIS DRAWING. REFER TO THE APPROPRIATE ENGINEERING DRAWINGS BEFORE PROCEEDING WITH THE WORK. CONSTRUCTION MUST CONFORM TO ALL APPLICABLE CODES AND REQUIREMENTS OF THE AUTHORITIES HAVING JURISDICTION. UNLESS OTHERWISE NOTED, NO INVESTIGATION HAS BEEN UNDERTAKEN OR REPORTED ON BY THIS OFFICE IN REGARDS TO THE ENVIRONMENTAL CONDITION OF THIS SITE.

THIS DRAWING IS NOT TO BE SCALED. ALL ARCHITECTURAL SYMBOLS INDICATED ON THIS DRAWING ARE GRAPHIC REPRESENTATIONS ONLY.

CONDITIONS FOR ELECTRONIC INFORMATION TRANSFER:

ELECTRONIC INFORMATION IS SUPPLIED TO THE OTHER ASSOCIATED FIRMS TO ASSIST THEM IN THE EXECUTION OF THEIR WORK / REVIEW. THE RECIPIENT FIRMS MUST DETERMINE THE COMPLETENESS / APPROPRIATENESS / RELEVANCE OF THE INFORMATION IN RESPECT TO THEIR PARTICULAR RESPONSIBILITY.

GRAZIANI+CORAZZA ARCHITECTS INC. SHALL NOT BE RESPONSIBLE FOR:
1. ERRORS, OMISSIONS, INCOMPLETENESS DUE TO LOSS OF INFORMATION IN WHOLE OR PART WHEN INFORMATION IS TRANSFERRED.
2. TRANSMISSION OF ANY VIRUS OR DAMAGE TO THE RECEIVING ELECTRONIC SYSTEM WHEN INFORMATION IS TRANSFERRED.

01.	Oct.07.2019	issued for tender	___
02.	Mar.13.2020	issued for design coordination #2	___
03.	Mar.16.2020	issued for addendum #2	___
04.	Mar.16.2020	issued for addendum #3	___
05.	Aug.24.2020	issued for addendum #4	___
06.	Sept. 28.2020	issued for permit	bg
07.	Oct.20.2020	issued for addendum #5	___
08.	Nov.23.2020	issued for addendum #6	___
09.	Dec.14.2020	issued for addendum #7	___
10.	Jan.18.2021	issued for addendum #8	___
11.	Mar. 2. 2021	issued for permit	bg
12.	Mar.09.2021	issued for addendum #9	___
13.	Mar.10.2021	issued for addendum #9R	___
14.	Mar.26.2021	issued for progress	___
15.	May 14. 2021	issued for Site Instruction #1	___
16.	June 15. 2021	issued for Site Instruction #2	___
17.	July. 7. 2021	re-issued for permit	bg
18.	July. 15. 2021	Issued for Site Instruction #3	bg
19.	July. 27. 2021	Issued for Site Instruction #4	bg
20.	Aug. 3. 2021	Issued for Site Instruction #5	bg
21.	Aug. 18. 2021	Issued for Site Instruction #6	bg
22.	Aug. 20. 2021	Re-issued for permit.	bg
23.	Sept. 07. 2021	Issued for Site Instruction #7	bg
24.	Sept. 09. 2021	Issued for Site Instruction #8	bg
25.	Sept. 16. 2021	Issued for Building D Permit Revisions	bg
26.	Sept. 22. 2021	Issued for Site Instruction #9	bg
27.	Oct. 6. 2021	Re-issued for permit.	bg
28.	Oct. 8. 2021	Issued for Site Instruction #10	bg
30.	Oct. 28. 2021	Issued for Site Instruction #11	bg
31.	Nov. 05. 2021	Issued for Site Instruction #12	bg
32.	Dec. 3. 2021	Issued for Site Instruction #13	bg
33.	Dec. 6. 2021	Issued for Site Instruction #14	bg
34.	Dec. 7. 2021	Issued for Site Instruction #15	bg

01. ~~Apr.19.2019~~ Issued for Addendum 1 bg

issued for revisions

GRAZIANI CORAZZA ARCHITECTS
1320 DAWSON DRIVE, SUITE 100 MISSISSAUGA ONTARIO L4W 1C3
T.905.795.2501 F.905.795.2644 WWW.GC-ARCHITECTS.COM

RESIDENTIAL

ROYAL PINE

ATTMAR + PALLESCHI DRIVE

BRAMPTON ONTARIO

PROJECT ARCHITECT:	B.GRAZIANI
ASSISTANT DESIGNER:	R.LINCOLN
DRAWN BY:	G.C/F.C/M.B
CHECKED BY:	D.BIASE/G.COLANGELO
PLOT DATE:	DEC.13.2021
JOB #	1331.15

THIRD FLOOR PLAN
BUILDING C (PARTIAL PLAN)

1:50

A-303c2

TITLEBLOCK SIZE: 915 x 1200









01.	Oct.07.2019	issued for tender
02.	Mar.13.2020	issued for design coordination # 2
03.	Mar.16.2020	issued for addendum # 2
04.	Mar.19.2020	issued for addendum # 3
05.	Aug.24.2020	issued for addendum # 4
06.	Sept. 28.2020	issued for permit
07.	Oct.29.2020	issued for addendum # 5
08.	Nov.23.2020	issued for addendum # 6
09.	Dec.14.2020	issued for addendum # 7
10.	Jan.18.2021	issued for addendum # 8
11.	Mar. 2. 2021	issued for permit
12.	Mar.09.2021	issued for addendum # 9
13.	Mar.10.2021	issued for addendum #9R
14.	Mar.26.2021	issued for progress
15.	May.14.2021	issued for Site Instruction #1
16.	June.15. 2021	issued for Site Instruction #2
17.	July. 7. 2021	re-issued for permit
18.	July. 15. 2021	issued for Site Instruction #3
19.	July. 27. 2021	issued for Site Instruction #4
20.	Aug. 3. 2021	issued for Site Instruction #5
21.	Aug. 18. 2021	issued for Site Instruction #6
22.	Aug. 20. 2021	Re-issued for permit.
23.	Sept. 07. 2021	issued for Site Instruction # 7
24.	Sept. 09. 2021	issued for Site Instruction #8
25.	Sept. 16. 2021	issued for Building D Permit Revisions
26.	Sept. 22. 2021	issued for Site Instruction #9
27.	Oct. 6. 2021	Re-issued for permit.
28.	Oct. 8. 2021	issued for Site Instruction #10
29.	Oct. 28. 2021	issued for Site Instruction #11
30.	Nov. 05. 2021	issued for Site Instruction #12
31.	Dec. 3. 2021	issued for Site Instruction #13
32.	Dec. 6. 2021	issued for Site Instruction #14
33.	Dec. 7. 2021	issued for Site Instruction #15
34.	Dec. 7. 2021	issued for Site Instruction #16

01.	SEPTEMBER2019	Issued for Submission 1

issued for revisions

GRAZIANI + CORAZZA ARCHITECTS



BRAMPTON	
PROJECT ARCHITECT:	B. GRAZIANI
ASSISTANT DESIGNER:	R. LINCOLN
DRAWN BY:	G. C. F. C. / M. B
CHECKED BY:	D. BRAGA / D. COLANGELO
PLOT DATE:	DEC 13 2021
JOB #	1331.15

THIRD FLOOR PLAN

BUILDING D (PARTIAL PLAN)

1:50 A-303d

TITLEBLOCK SIZE: 915 x 1200

KEY PLAN

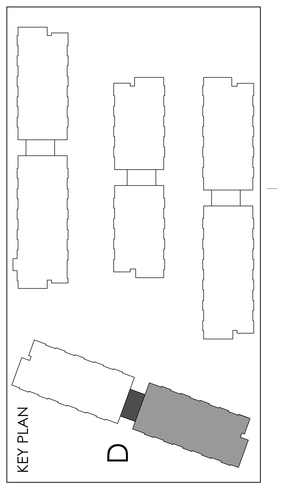

REF. A303a2 FOR CONTINUATION

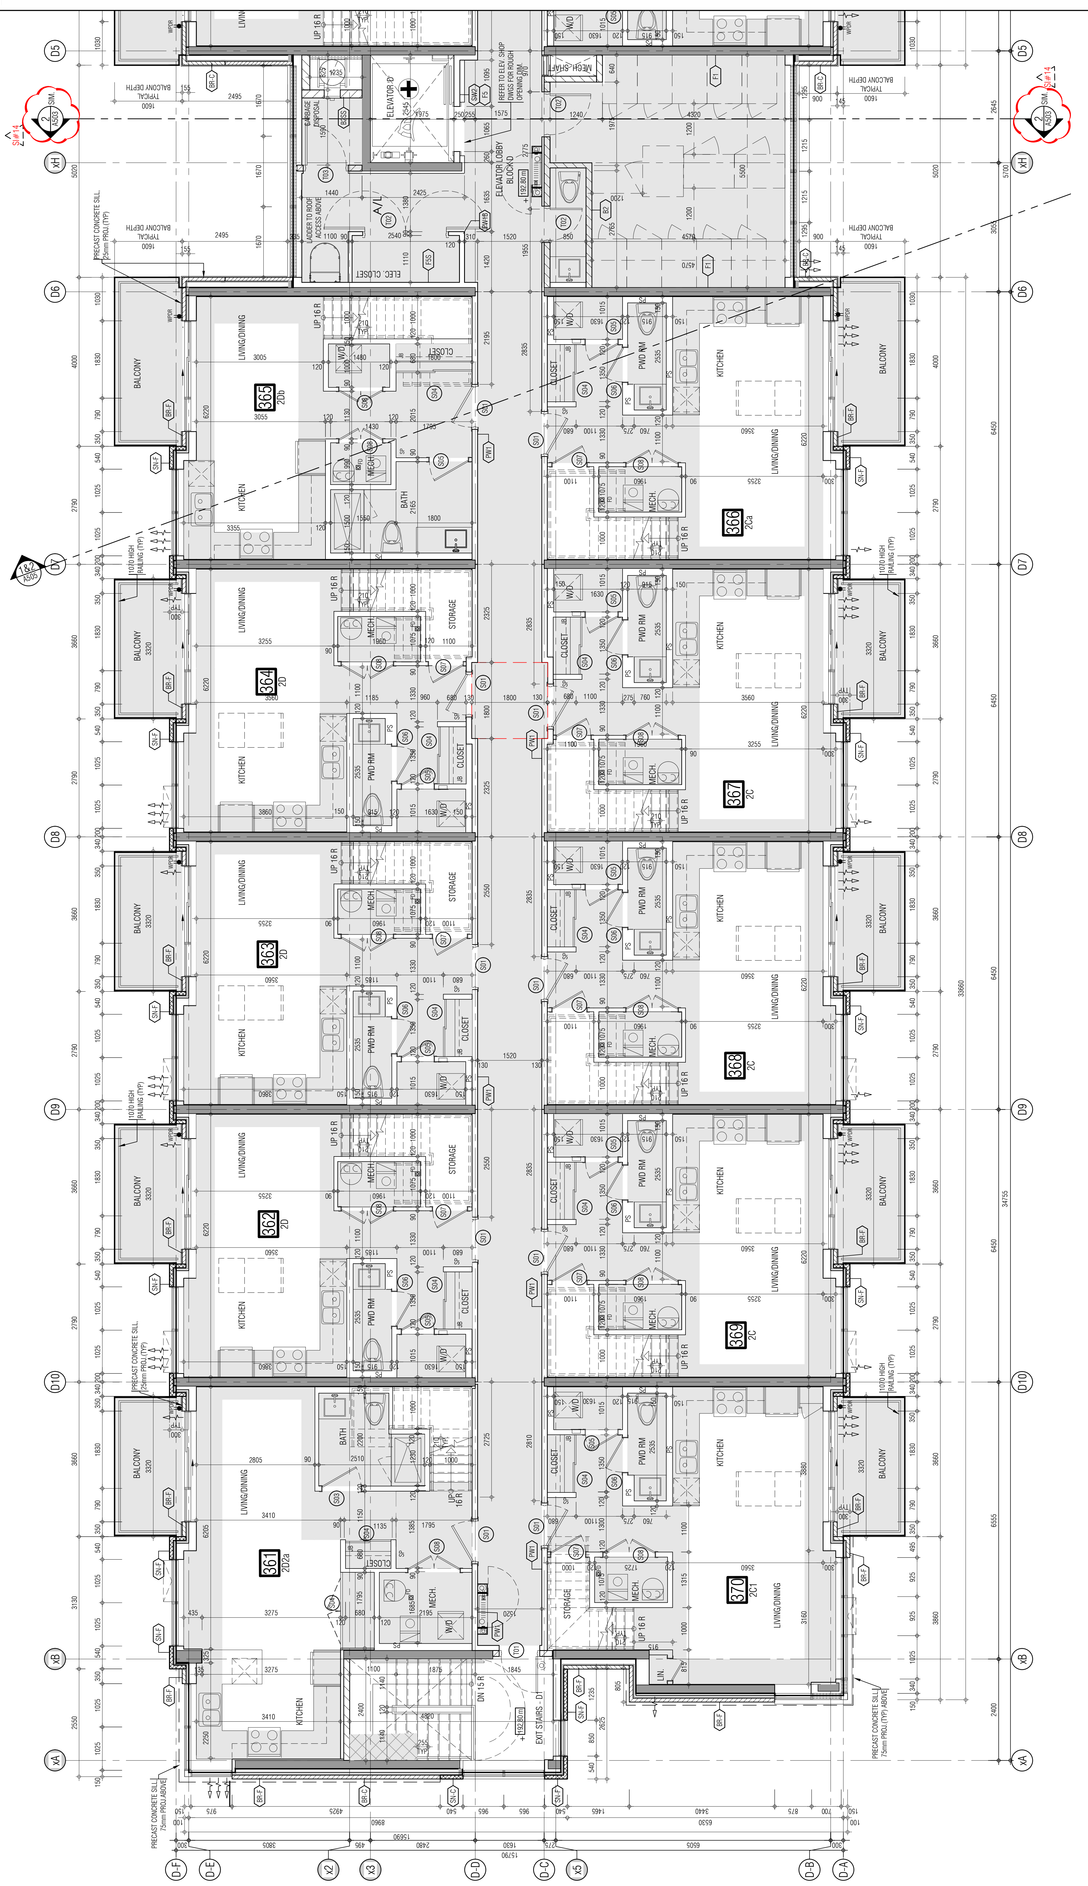

REF. A303a1 FOR CONTINUATION

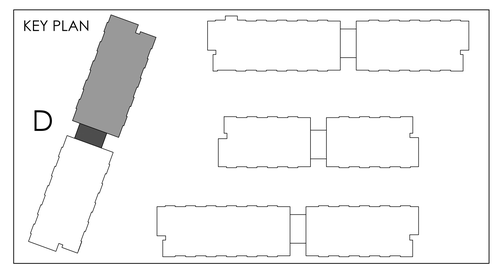

THIS DRAWING, AS AN INSTRUMENT OF SERVICE, IS PROVIDED BY AND IS THE PROPERTY OF GRAZIANI+CORAZZA ARCHITECTS INC. THE CONTRACTOR MUST VERIFY AND ACCEPT RESPONSIBILITY FOR ALL DIMENSIONS AND CONDITIONS ON SITE AND MUST NOTIFY GRAZIANI+CORAZZA ARCHITECTS INC. OF ANY VARIATIONS FROM THE SUPPLIED INFORMATION. GRAZIANI+CORAZZA ARCHITECTS INC. IS NOT RESPONSIBLE FOR THE ACCURACY OF SURVEY, STRUCTURAL, MECHANICAL, ELECTRICAL, AND OTHER ENGINEERING INFORMATION SHOWN ON THIS DRAWING. REFER TO THE APPROPRIATE ENGINEERING DRAWINGS BEFORE PROCEEDING WITH THE WORK. CONSTRUCTION MUST CONFORM TO ALL APPLICABLE CODES AND REQUIREMENTS OF THE AUTHORITIES HAVING JURISDICTION. UNLESS OTHERWISE NOTED, NO INVESTIGATION HAS BEEN UNDERTAKEN OR REPORTED ON BY THIS OFFICE IN REGARDS TO THE ENVIRONMENTAL CONDITION OF THIS SITE.

THIS DRAWING IS NOT TO BE SCALED. ALL ARCHITECTURAL SYMBOLS INDICATED ON THIS DRAWING ARE GRAPHIC REPRESENTATIONS ONLY.

CONDITIONS FOR ELECTRONIC INFORMATION TRANSFER:

ELECTRONIC INFORMATION IS SUPPLIED TO THE OTHER ASSOCIATED FIRMS TO ASSIST THEM IN THE EXECUTION OF THEIR WORK / REVIEW. THE RECIPIENT FIRMS MUST DETERMINE THE COMPLETENESS / APPROPRIATENESS / RELEVANCE OF THE INFORMATION IN RESPECT TO THEIR PARTICULAR RESPONSIBILITY.

GRAZIANI+CORAZZA ARCHITECTS INC. SHALL NOT BE RESPONSIBLE FOR:
1. ERRORS, OMISSIONS, INCOMPLETENESS DUE TO LOSS OF INFORMATION IN WHOLE OR PART WHEN INFORMATION IS TRANSFERRED.
2. TRANSMISSION OF ANY VIRUS OR DAMAGE TO THE RECEIVING ELECTRONIC SYSTEM WHEN INFORMATION IS TRANSFERRED.

01.	Oct.07.2019	issued for tender
02.	Mar.13.2020	issued for design coordination #2
03.	Mar.16.2020	issued for addendum #2
04.	Mar.16.2020	issued for addendum #3
05.	Aug.24.2020	issued for addendum #4
06.	Sept. 28.2020	issued for permit
07.	Oct.20.2020	issued for addendum #5
08.	Nov.23.2020	issued for addendum #6
09.	Dec.14.2020	issued for addendum #7
10.	Jan.18.2021	issued for addendum #8
11.	Mar. 2. 2021	issued for permit
12.	Mar.09.2021	issued for addendum #9
13.	Mar.10.2021	issued for addendum #9R
14.	Mar.26.2021	issued for progress
15.	May 14. 2021	issued for Site Instruction #1
16.	June 15. 2021	issued for Site Instruction #2
17.	July. 7. 2021	re-issued for permit
18.	July. 15. 2021	Issued for Site Instruction #3
19.	July. 27. 2021	Issued for Site Instruction #4
20.	Aug. 3. 2021	Issued for Site Instruction #5
21.	Aug. 18. 2021	Issued for Site Instruction #6
22.	Aug. 20. 2021	Re-issued for permit.
23.	Sept. 07. 2021	Issued for Site Instruction #7
24.	Sept. 09. 2021	Issued for Site Instruction #8
25.	Sept. 16. 2021	Issued for Building D Permit Revisions
26.	Sept. 22. 2021	Issued for Site Instruction #9
27.	Oct. 6. 2021	Re-issued for permit.
28.	Oct. 8. 2021	Issued for Site Instruction #10
30.	Oct. 28. 2021	Issued for Site Instruction #11
31.	Nov. 05. 2021	Issued for Site Instruction #12
32.	Dec. 3. 2021	Issued for Site Instruction #13
33.	Dec. 6. 2021	Issued for Site Instruction #14
34.	Dec. 7. 2021	Issued for Site Instruction #15

01.	SEPT.12.2019	Issued for Addendum 1

issued for revisions

GRAZIANI + CORAZZA ARCHITECTS
1320 SHAWSON DRIVE, SUITE 100 MISSISSAUGA, ONTARIO L4W 1C3
T 905.795.2601 F 905.795.2644 WWW.GC-ARCHITECTS.COM

RESIDENTIAL

ATTMAR + PALLESCHI DRIVE

BRAMPTON ONTARIO

PROJECT ARCHITECT:	B.GRAZIANI
ASSISTANT DESIGNER:	R.LINCOLN
DRAWN BY:	G.C/F.C/M.B
CHECKED BY:	D.BIASE/G.COLANGELO
PLOT DATE:	DEC.13.2021
JOB #	1331.15

THIRD FLOOR PLAN
BUILDING D (PARTIAL PLAN)

1:50

A-303d2

TITLEBLOCK SIZE: 915 x 1200

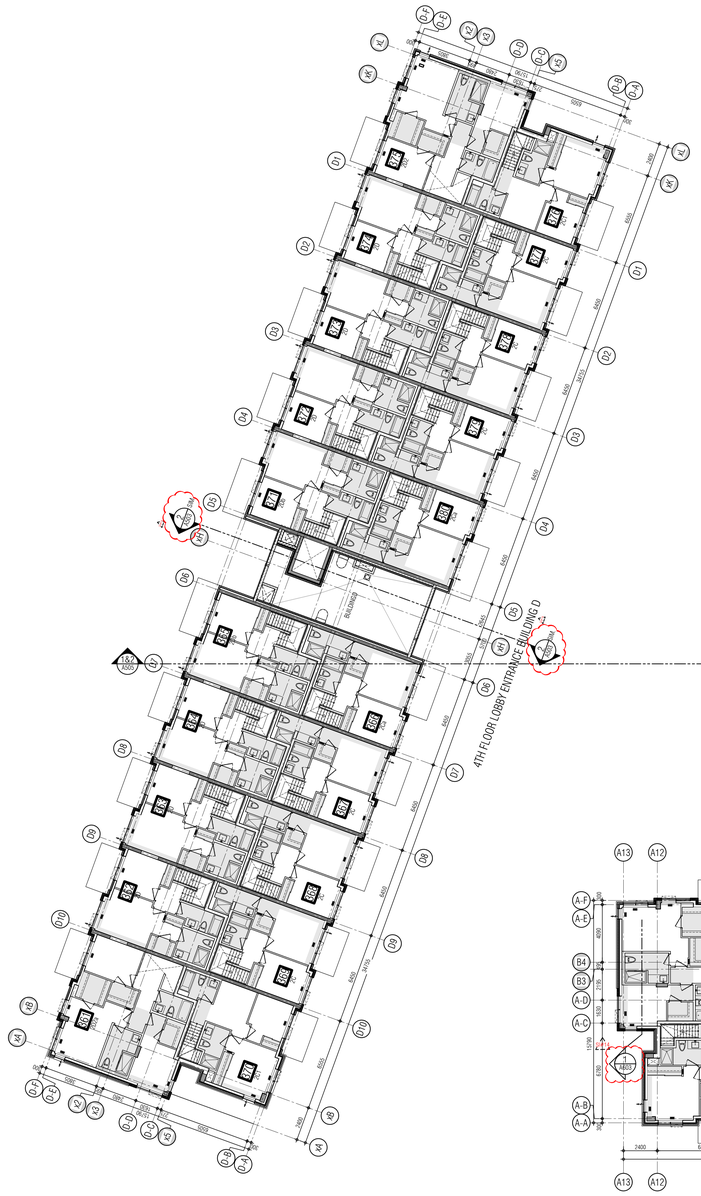

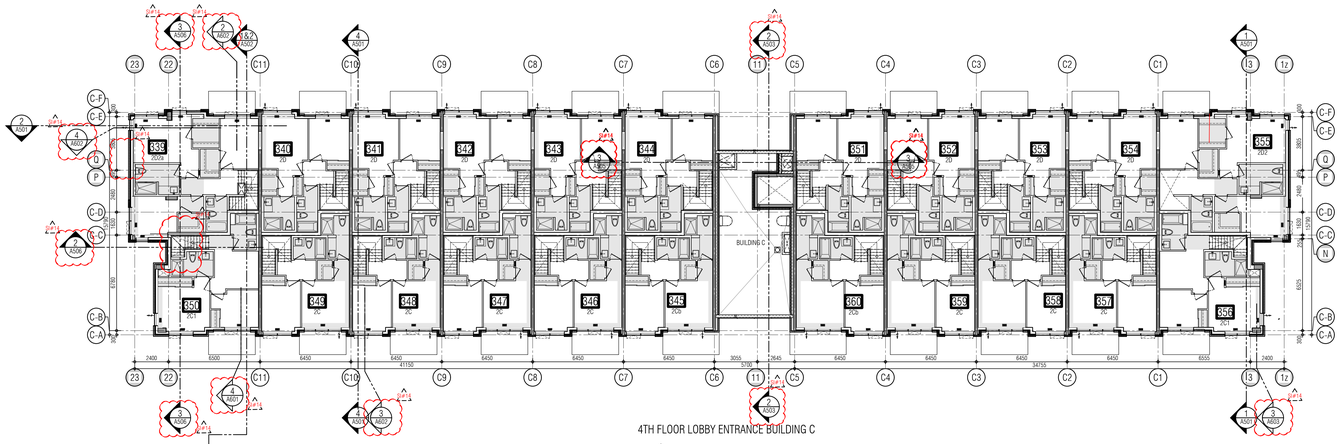

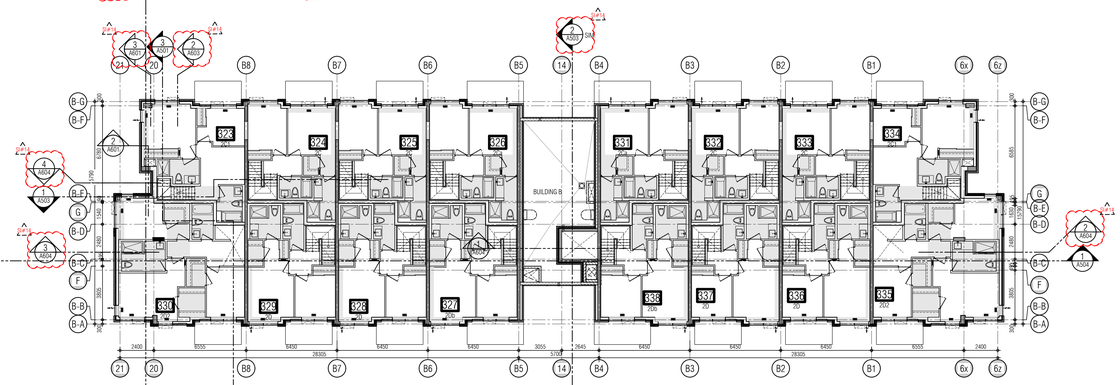

THIS DRAWING, AS AN INSTRUMENT OF SERVICE, IS PROVIDED BY AND IS THE PROPERTY OF GRAZIANI+CORAZZA ARCHITECTS INC. THE CONTRACTOR MUST VERIFY AND ACCEPT RESPONSIBILITY FOR ALL DIMENSIONS AND CONDITIONS ON SITE AND MUST NOTIFY GRAZIANI+CORAZZA ARCHITECTS INC. OF ANY VARIATIONS FROM THE SUPPLIED INFORMATION. GRAZIANI+CORAZZA ARCHITECTS INC. IS NOT RESPONSIBLE FOR THE ACCURACY OF SURVEY, STRUCTURAL, MECHANICAL, ELECTRICAL, AND OTHER ENGINEERING INFORMATION SHOWN ON THIS DRAWING. REFER TO THE APPROPRIATE ENGINEERING DRAWINGS BEFORE PROCEEDING WITH THE WORK. CONSTRUCTION MUST CONFORM TO ALL APPLICABLE CODES AND REQUIREMENTS OF THE AUTHORITIES HAVING JURISDICTION. UNLESS OTHERWISE NOTED, NO INVESTIGATION HAS BEEN UNDERTAKEN OR REPORTED ON BY THIS OFFICE IN REGARDS TO THE ENVIRONMENTAL CONDITION OF THIS SITE.

THIS DRAWING IS NOT TO BE SCALED. ALL ARCHITECTURAL SYMBOLS INDICATED ON THIS DRAWING ARE GRAPHIC REPRESENTATIONS ONLY.

CONDITIONS FOR ELECTRONIC INFORMATION TRANSFER:

ELECTRONIC INFORMATION IS SUPPLIED TO THE OTHER ASSOCIATED FIRMS TO ASSIST THEM IN THE EXECUTION OF THEIR WORK / REVIEW. THE RECIPIENT FIRMS MUST DETERMINE THE COMPLETENESS / APPROPRIATENESS / RELEVANCE OF THE INFORMATION IN RESPECT TO THEIR PARTICULAR RESPONSIBILITY.

GRAZIANI+CORAZZA ARCHITECTS INC. SHALL NOT BE RESPONSIBLE FOR:
1. ERRORS, OMISSIONS, INCOMPLETENESS DUE TO LOSS OF INFORMATION IN WHOLE OR PART WHEN INFORMATION IS TRANSFERRED.
2. TRANSMISSION OF ANY VIRUS OR DAMAGE TO THE RECEIVING ELECTRONIC SYSTEM WHEN INFORMATION IS TRANSFERRED.

01.	Oct.07.2019	issued for tender	___
02.	Mar.13.2020	issued for design coordination #2	___
03.	Mar.16.2020	issued for addendum #2	___
04.	Mar.16.2020	issued for addendum #3	___
05.	Aug.24.2020	issued for addendum #4	___
06.	Sept. 28.2020	issued for permit	bg
07.	Oct.20.2020	issued for addendum #5	___
08.	Nov.23.2020	issued for addendum #6	___
09.	Dec.14.2020	issued for addendum #7	___
10.	Jan.18.2021	issued for addendum #8	___
11.	Mar. 2. 2021	issued for permit	bg
12.	Mar.09.2021	issued for addendum #9	___
13.	Mar.10.2021	issued for addendum #9R	___
14.	Mar.26.2021	issued for progress	___
15.	May 14. 2021	issued for Site Instruction #1	___
16.	June 15. 2021	issued for Site Instruction #2	___
17.	July. 7. 2021	re-issued for permit	bg
18.	July. 15. 2021	Issued for Site Instruction #3	bg
19.	July. 27. 2021	Issued for Site Instruction #4	bg
20.	Aug. 3. 2021	Issued for Site Instruction #5	bg
21.	Aug. 18. 2021	Issued for Site Instruction #6	bg
22.	Aug. 20. 2021	Re-issued for permit.	bg
23.	Sept. 07. 2021	Issued for Site Instruction #7	bg
24.	Sept. 09. 2021	Issued for Site Instruction #8	bg
25.	Sept. 16. 2021	Issued for Building D Permit Revisions	bg
26.	Sept. 22. 2021	Issued for Site Instruction #9	bg
27.	Oct. 6. 2021	Re-issued for permit.	bg
28.	Oct. 8. 2021	Issued for Site Instruction #10	bg
30.	Oct. 28. 2021	Issued for Site Instruction #11	bg
31.	Nov. 05. 2021	Issued for Site Instruction #12	bg
32.	Dec. 3. 2021	Issued for Site Instruction #13	bg
33.	Dec. 6. 2021	Issued for Site Instruction #14	bg
34.	Dec. 7. 2021	Issued for Site Instruction #15	bg

01.	Apr.19.2021	issued to client	bg

issued for revisions

GRAZIANI + CORAZZA ARCHITECTS
1320 DAWSON DRIVE SUITE 100 MISSISSAUGA ONTARIO L4W 1C3
T.905.795.2601 F.905.795.2644 WWW.GC-ARCHITECTS.COM

RESIDENTIAL

POLARPINE

ATTMAR + PALLESCHI DRIVE

BRAMPTON ONTARIO

PROJECT ARCHITECT:	B.GRAZIANI
ASSISTANT DESIGNER:	R.LINCOLN
DRAWN BY:	G.C/F.C/M.B
CHECKED BY:	D.BIASE/G.COLANGELO
PLOT DATE:	DEC.13.2021
JOB #	1331.15

FORTH FLOOR OVERALL PLAN

1:150

A304

TITLEBLOCK SIZE: 915 x 1200

THIS DRAWING, AS AN INSTRUMENT OF SERVICE, IS PROVIDED BY AND IS THE PROPERTY OF GRAZIANI+CORAZZA ARCHITECTS INC. THE CONTRACTOR MUST VERIFY AND ACCEPT RESPONSIBILITY FOR ALL DIMENSIONS AND CONDITIONS ON SITE AND MUST NOTIFY GRAZIANI+CORAZZA ARCHITECTS INC. OF ANY VARIATIONS FROM THE SUPPLIED INFORMATION. GRAZIANI+CORAZZA ARCHITECTS INC. IS NOT RESPONSIBLE FOR THE ACCURACY OF SURVEY, STRUCTURAL, MECHANICAL, ELECTRICAL, AND OTHER ENGINEERING INFORMATION SHOWN ON THIS DRAWING. REFER TO THE APPROPRIATE ENGINEERING DRAWINGS BEFORE PROCEEDING WITH THE WORK. CONSTRUCTION MUST CONFORM TO ALL APPLICABLE CODES AND REQUIREMENTS OF THE AUTHORITIES HAVING JURISDICTION. UNLESS OTHERWISE NOTED, NO INVESTIGATION HAS BEEN UNDERTAKEN OR REPORTED ON BY THIS OFFICE IN REGARDS TO THE ENVIRONMENTAL CONDITION OF THIS SITE.

THIS DRAWING IS NOT TO BE SCALED. ALL ARCHITECTURAL SYMBOLS INDICATED ON THIS DRAWING ARE GRAPHIC REPRESENTATIONS ONLY.

CONDITIONS FOR ELECTRONIC INFORMATION TRANSFER:

ELECTRONIC INFORMATION IS SUPPLIED TO THE OTHER ASSOCIATED FIRMS TO ASSIST THEM IN THE EXECUTION OF THEIR WORK / REVIEW. THE RECIPIENT FIRMS MUST DETERMINE THE COMPLETENESS / APPROPRIATENESS / RELEVANCE OF THE INFORMATION IN RESPECT TO THEIR PARTICULAR RESPONSIBILITY.

GRAZIANI + CORAZZA ARCHITECTS INC. SHALL NOT BE RESPONSIBLE FOR:
1. ERRORS, OMISSIONS, INCOMPLETENESS DUE TO LOSS OF INFORMATION IN WHOLE OR PART WHEN INFORMATION IS TRANSFERRED.
2. TRANSMISSION OF ANY VIRUS OR DAMAGE TO THE RECEIVING ELECTRONIC SYSTEM WHEN INFORMATION IS TRANSFERRED.

REF. A304d2 FOR CONTINUATION

01.	Oct.07.2019	issued for tender	___
02.	Mar.13.2020	issued for design coordination #2	___
03.	Mar.16.2020	issued for addendum #2	___
04.	Mar.16.2020	issued for addendum #3	___
05.	Aug.24.2020	issued for addendum #4	___
06.	Sept. 28.2020	issued for permit	bg
07.	Oct.20.2020	issued for addendum #5	___
08.	Nov.23.2020	issued for addendum #6	___
09.	Dec.14.2020	issued for addendum #7	___
10.	Jan.18.2021	issued for addendum #8	___
11.	Mar. 2. 2021	issued for permit	bg
12.	Mar.09.2021	issued for addendum #9	___
13.	Mar.10.2021	issued for addendum #9R	___
14.	Mar.26.2021	issued for progress	___
15.	May 14. 2021	issued for Site Instruction #1	___
16.	June 15. 2021	issued for Site Instruction #2	___
17.	July. 7. 2021	re-issued for permit	bg
18.	July. 15. 2021	Issued for Site Instruction #3	bg
19.	July. 27. 2021	Issued for Site Instruction #4	bg
20.	Aug. 3. 2021	Issued for Site Instruction #5	bg
21.	Aug. 18. 2021	Issued for Site Instruction #6	bg
22.	Aug. 20. 2021	Re-issued for permit.	bg
23.	Sept. 07. 2021	Issued for Site Instruction #7	bg
24.	Sept. 09. 2021	Issued for Site Instruction #8	bg
25.	Sept. 16. 2021	Issued for Building D Permit Revisions	bg
26.	Sept. 22. 2021	Issued for Site Instruction #9	bg
27.	Oct. 6. 2021	Re-issued for permit.	bg
28.	Oct. 8. 2021	Issued for Site Instruction #10	bg
30.	Oct. 28. 2021	Issued for Site Instruction #11	bg
31.	Nov. 05. 2021	Issued for Site Instruction #12	bg
32.	Dec. 3. 2021	Issued for Site Instruction #13	bg
33.	Dec. 6. 2021	Issued for Site Instruction #14	bg
34.	Dec. 7. 2021	Issued for Site Instruction #15	bg

01.	Apr.19.2021	issued to client	bg

issued for revisions

GRAZIANI + CORAZZA ARCHITECTS
1320 SHAWSON DRIVE, SUITE 100 MISSISSAUGA, ONTARIO L4W 1C3
T 905.795.2601 F 905.795.2644 WWW.GC-ARCHITECTS.COM

RESIDENTIAL

ATTMAR + PALLESCHI DRIVE

BRAMPTON	ONTARIO
PROJECT ARCHITECT:	B.GRAZIANI
ASSISTANT DESIGNER:	R.LINCOLN
DRAWN BY:	G.C/F.C/M.B
CHECKED BY:	D.BIASE/G.COLANGELO
PLOT DATE:	DEC.13.2021
JOB #	1331.15

KEY PLAN

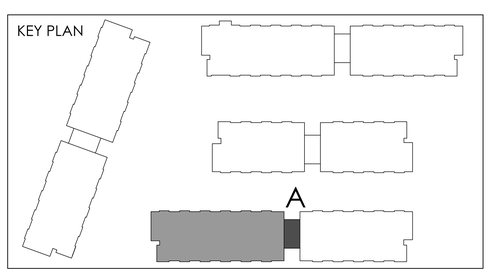

FORTH FLOOR PLAN
BUILDING A (PARTIAL PLAN)

1:50

A-304a1

TITLEBLOCK SIZE: 915 x 1200

REF.A30401 FOR CONTINUATION

KEY PLAN

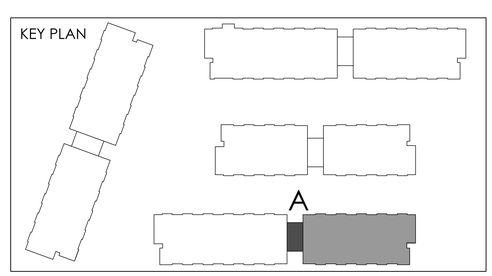

THIS DRAWING, AS AN INSTRUMENT OF SERVICE, IS PROVIDED BY AND IS THE PROPERTY OF GRAZIANI+CORAZZA ARCHITECTS INC. THE CONTRACTOR MUST VERIFY AND ACCEPT RESPONSIBILITY FOR ALL DIMENSIONS AND CONDITIONS ON SITE AND MUST NOTIFY GRAZIANI+CORAZZA ARCHITECTS INC. OF ANY VARIATIONS FROM THE SUPPLIED INFORMATION. GRAZIANI+CORAZZA ARCHITECTS INC. IS NOT RESPONSIBLE FOR THE ACCURACY OF SURVEY, STRUCTURAL, MECHANICAL, ELECTRICAL, AND OTHER ENGINEERING INFORMATION SHOWN ON THIS DRAWING. REFER TO THE APPROPRIATE ENGINEERING DRAWINGS BEFORE PROCEEDING WITH THE WORK. CONSTRUCTION MUST CONFORM TO ALL APPLICABLE CODES AND REQUIREMENTS OF THE AUTHORITIES HAVING JURISDICTION. UNLESS OTHERWISE NOTED, NO INVESTIGATION HAS BEEN UNDERTAKEN OR REPORTED ON BY THIS OFFICE IN REGARDS TO THE ENVIRONMENTAL CONDITION OF THIS SITE.

THIS DRAWING IS NOT TO BE SCALED. ALL ARCHITECTURAL SYMBOLS INDICATED ON THIS DRAWING ARE GRAPHIC REPRESENTATIONS ONLY.

CONDITIONS FOR ELECTRONIC INFORMATION TRANSFER:

ELECTRONIC INFORMATION IS SUPPLIED TO THE OTHER ASSOCIATED FIRMS TO ASSIST THEM IN THE EXECUTION OF THEIR WORK / REVIEW. THE RECIPIENT FIRMS MUST DETERMINE THE COMPLETENESS / APPROPRIATENESS / RELEVANCE OF THE INFORMATION IN RESPECT TO THEIR PARTICULAR RESPONSIBILITY.

GRAZIANI+CORAZZA ARCHITECTS INC. SHALL NOT BE RESPONSIBLE FOR:
1. ERRORS, OMISSIONS, INCOMPLETENESS DUE TO LOSS OF INFORMATION IN WHOLE OR PART WHEN INFORMATION IS TRANSFERRED.
2. TRANSMISSION OF ANY VIRUS OR DAMAGE TO THE RECEIVING ELECTRONIC SYSTEM WHEN INFORMATION IS TRANSFERRED.

01.	Oct.07.2019	issued for tender	___
02.	Mar.13.2020	issued for design coordination #2	___
03.	Mar.16.2020	issued for addendum #2	___
04.	Mar.16.2020	issued for addendum #3	___
05.	Aug.24.2020	issued for addendum #4	___
06.	Sept. 28.2020	issued for permit	bg
07.	Oct.20.2020	issued for addendum #5	___
08.	Nov.23.2020	issued for addendum #6	___
09.	Dec.14.2020	issued for addendum #7	___
10.	Jan.18.2021	issued for addendum #8	___
11.	Mar. 2. 2021	issued for permit	bg
12.	Mar.09.2021	issued for addendum #9	___
13.	Mar.10.2021	issued for addendum #9R	___
14.	Mar.26.2021	issued for progress	___
15.	May 14. 2021	issued for Site Instruction #1	___
16.	June 15. 2021	issued for Site Instruction #2	___
17.	July. 7. 2021	re-issued for permit	bg
18.	July. 15. 2021	Issued for Site Instruction #3	bg
19.	July. 27. 2021	Issued for Site Instruction #4	bg
20.	Aug. 3. 2021	Issued for Site Instruction #5	bg
21.	Aug. 18. 2021	Issued for Site Instruction #6	bg
22.	Aug. 20. 2021	Re-issued for permit.	bg
23.	Sept. 07. 2021	Issued for Site Instruction #7	bg
24.	Sept. 09. 2021	Issued for Site Instruction #8	bg
25.	Sept. 16. 2021	Issued for Building D Permit Revisions	bg
26.	Sept. 22. 2021	Issued for Site Instruction #9	bg
27.	Oct. 6. 2021	Re-issued for permit.	bg
28.	Oct. 8. 2021	Issued for Site Instruction #10	bg
30.	Oct. 28. 2021	Issued for Site Instruction #11	bg
31.	Nov. 05. 2021	Issued for Site Instruction #12	bg
32.	Dec. 3. 2021	Issued for Site Instruction #13	bg
33.	Dec. 6. 2021	Issued for Site Instruction #14	bg
34.	Dec. 7. 2021	Issued for Site Instruction #15	bg

01.	Apr.19.2021	issued to client	bg

issued for revisions

GRAZIANI + CORAZZA ARCHITECTS
1320 SHAWSON DRIVE, SUITE 100 MISSISSAUGA ONTARIO L4W 1C3
T 905.795.2921 F 905.795.2644 WWW.GC-ARCHITECTS.COM

RESIDENTIAL

ATTMAR + PALLESCHI DRIVE

BRAMPTON ONTARIO

PROJECT ARCHITECT:	B.GRAZIANI
ASSISTANT DESIGNER:	R.LINCOLN
DRAWN BY:	G.C/F.C/M.B
CHECKED BY:	D.BIASE/G.COLANGELO
PLOT DATE:	DEC.13.2021
JOB #	1331.15

FORTH FLOOR PLAN
BUILDING A (PARTIAL PLAN)

1:50

A-304a2

TITLEBLOCK SIZE: 915 x 1200

THIS DRAWING, AS AN INSTRUMENT OF SERVICE, IS PROVIDED BY AND IS THE PROPERTY OF GRAZIANI+CORAZZA ARCHITECTS INC. THE CONTRACTOR MUST VERIFY AND ACCEPT RESPONSIBILITY FOR ALL DIMENSIONS AND CONDITIONS ON SITE AND MUST NOTIFY GRAZIANI+CORAZZA ARCHITECTS INC. OF ANY VARIATIONS FROM THE SUPPLIED INFORMATION. GRAZIANI+CORAZZA ARCHITECTS INC. IS NOT RESPONSIBLE FOR THE ACCURACY OF SURVEY, STRUCTURAL, MECHANICAL, ELECTRICAL, AND OTHER ENGINEERING INFORMATION SHOWN ON THIS DRAWING. REFER TO THE APPROPRIATE ENGINEERING DRAWINGS BEFORE PROCEEDING WITH THE WORK. CONSTRUCTION MUST CONFORM TO ALL APPLICABLE CODES AND REQUIREMENTS OF THE AUTHORITIES HAVING JURISDICTION. UNLESS OTHERWISE NOTED, NO INVESTIGATION HAS BEEN UNDERTAKEN OR REPORTED ON BY THIS OFFICE IN REGARDS TO THE ENVIRONMENTAL CONDITION OF THIS SITE.

THIS DRAWING IS NOT TO BE SCALED. ALL ARCHITECTURAL SYMBOLS INDICATED ON THIS DRAWING ARE GRAPHIC REPRESENTATIONS ONLY.

CONDITIONS FOR ELECTRONIC INFORMATION TRANSFER:

ELECTRONIC INFORMATION IS SUPPLIED TO THE OTHER ASSOCIATED FIRMS TO ASSIST THEM IN THE EXECUTION OF THEIR WORK / REVIEW. THE RECIPIENT FIRMS MUST DETERMINE THE COMPLETENESS / APPROPRIATENESS / RELEVANCE OF THE INFORMATION IN RESPECT TO THEIR PARTICULAR RESPONSIBILITY.

GRAZIANI+CORAZZA ARCHITECTS INC. SHALL NOT BE RESPONSIBLE FOR:
1. ERRORS, OMISSIONS, INCOMPLETENESS DUE TO LOSS OF INFORMATION IN WHOLE OR PART WHEN INFORMATION IS TRANSFERRED.
2. TRANSMISSION OF ANY VIRUS OR DAMAGE TO THE RECEIVING ELECTRONIC SYSTEM WHEN INFORMATION IS TRANSFERRED.

REF.A304c2 FOR CONTINUATION

01.	Oct.07.2019	issued for tender	___
02.	Mar.13.2020	issued for design coordination #2	___
03.	Mar.16.2020	issued for addendum #2	___
04.	Mar.16.2020	issued for addendum #3	___
05.	Aug.24.2020	issued for addendum #4	___
06.	Sept. 28.2020	issued for permit	bg
07.	Oct.20.2020	issued for addendum #5	___
08.	Nov.23.2020	issued for addendum #6	___
09.	Dec.14.2020	issued for addendum #7	___
10.	Jan.18.2021	issued for addendum #8	___
11.	Mar. 2. 2021	issued for permit	bg
12.	Mar.09.2021	issued for addendum #9	___
13.	Mar.10.2021	issued for addendum #9R	___
14.	Mar.26.2021	issued for progress	___
15.	May 14. 2021	issued for Site Instruction #1	___
16.	June 15. 2021	issued for Site Instruction #2	___
17.	July. 7. 2021	re-issued for permit	bg
18.	July. 15. 2021	Issued for Site Instruction #3	bg
19.	July. 27. 2021	Issued for Site Instruction #4	bg
20.	Aug. 3. 2021	Issued for Site Instruction #5	bg
21.	Aug. 18. 2021	Issued for Site Instruction #6	bg
22.	Aug. 20. 2021	Re-issued for permit.	bg
23.	Sept. 07. 2021	Issued for Site Instruction #7	bg
24.	Sept. 09. 2021	Issued for Site Instruction #8	bg
25.	Sept. 16. 2021	Issued for Building D Permit Revisions	bg
26.	Sept. 22. 2021	Issued for Site Instruction #9	bg
27.	Oct. 6. 2021	Re-issued for permit.	bg
28.	Oct. 8. 2021	Issued for Site Instruction #10	bg
30.	Oct. 28. 2021	Issued for Site Instruction #11	bg
31.	Nov. 05. 2021	Issued for Site Instruction #12	bg
32.	Dec. 3. 2021	Issued for Site Instruction #13	bg
33.	Dec. 6. 2021	Issued for Site Instruction #14	bg
34.	Dec. 7. 2021	Issued for Site Instruction #15	bg

01.	Apr.19.2021	issued to client	bg

issued for revisions

GRAZIANI CORAZZA ARCHITECTS
1300 SHARKSON DRIVE, SUITE 100, MISSISSAUGA, ONTARIO, L4W 1C3
T 905.790.2601 F 905.790.2644 WWW.GC-ARCHITECTS.COM

RESIDENTIAL

ATTMAR + PALLESCHI DRIVE

BRAMPTON	ONTARIO
PROJECT ARCHITECT:	B.GRAZIANI
ASSISTANT DESIGNER:	R.LINCOLN
DRAWN BY:	G.C/F.C/M.B
CHECKED BY:	D.BIASE/G.COLANGELO
PLOT DATE:	DEC.13.2021
JOB #	1331.15

KEY PLAN

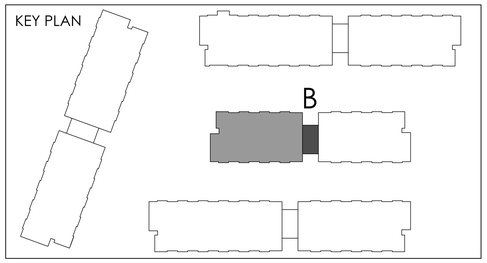

FORTH FLOOR PLAN
BUILDING B (PARTIAL PLAN)

1:50

A-304b1

TITLEBLOCK SIZE: 915 x 1200

REF.A304c1 FOR CONTINUATION

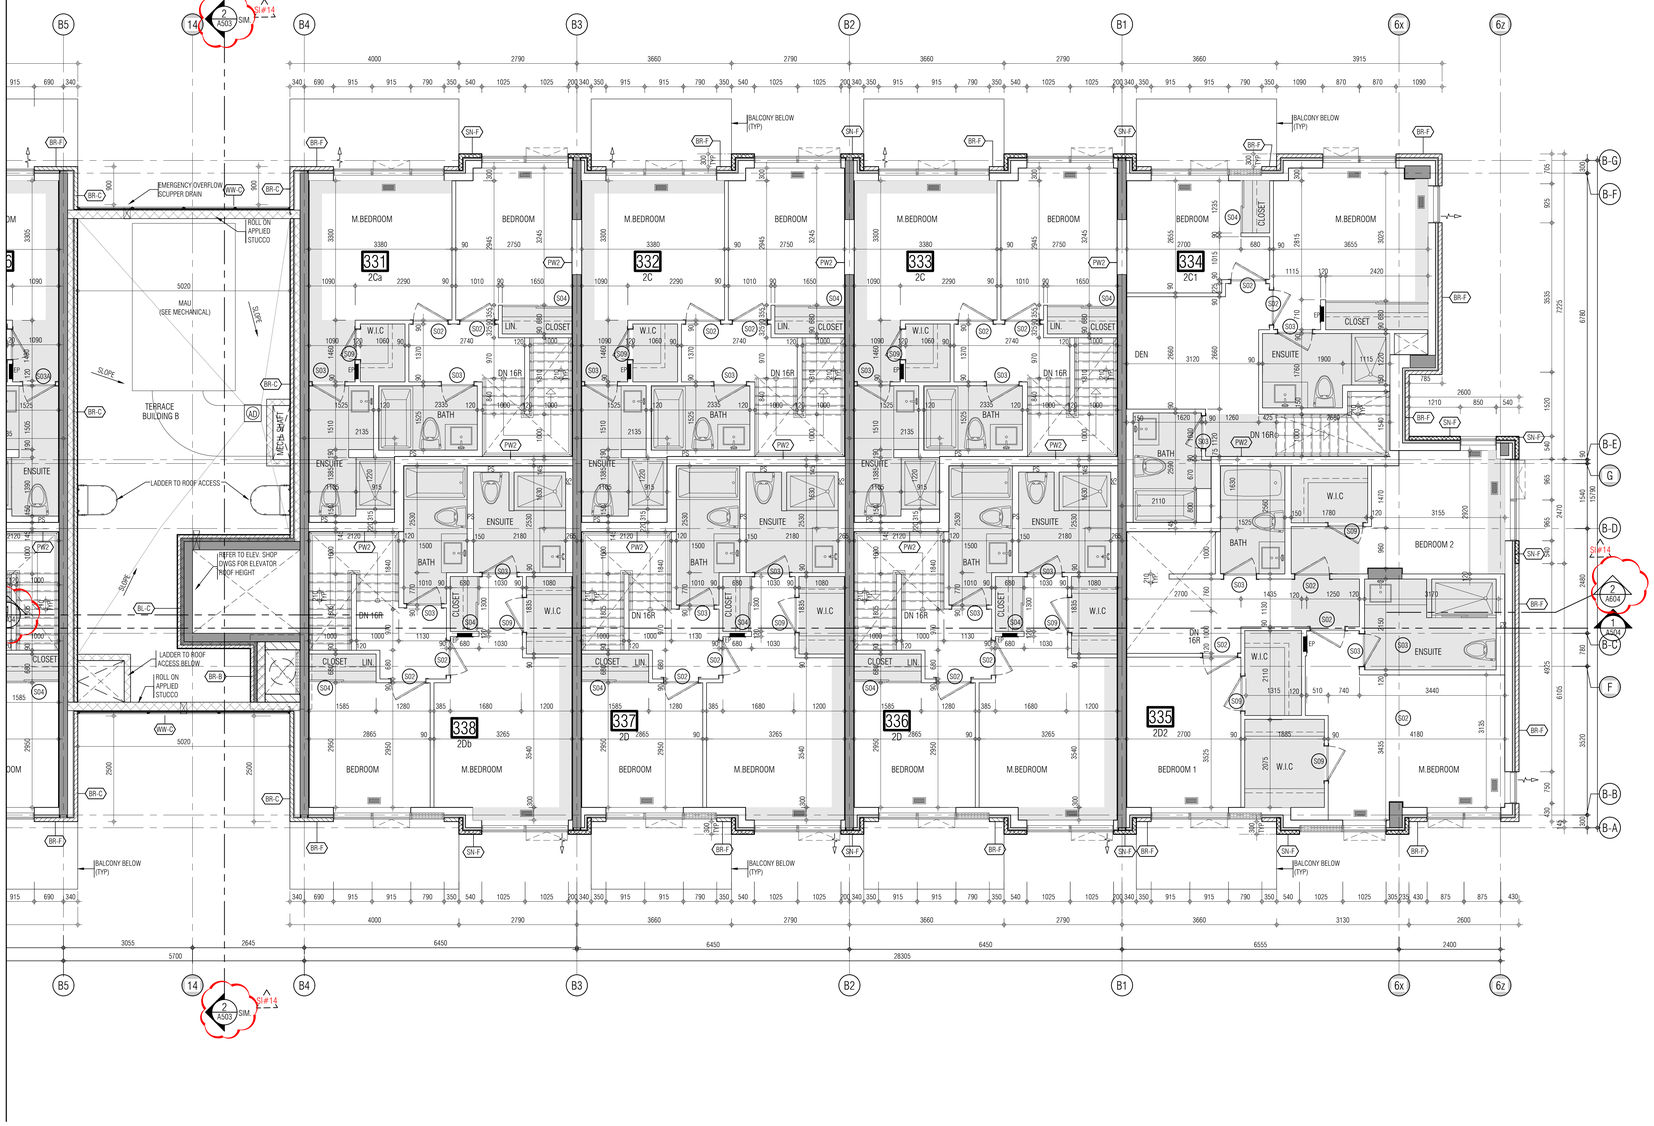

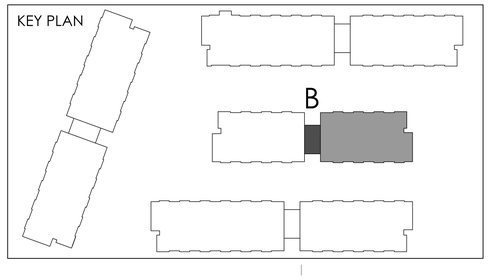

THIS DRAWING, AS AN INSTRUMENT OF SERVICE, IS PROVIDED BY AND IS THE PROPERTY OF GRAZIANI+CORAZZA ARCHITECTS INC. THE CONTRACTOR MUST VERIFY AND ACCEPT RESPONSIBILITY FOR ALL DIMENSIONS AND CONDITIONS ON SITE AND MUST NOTIFY GRAZIANI+CORAZZA ARCHITECTS INC. OF ANY VARIATIONS FROM THE SUPPLIED INFORMATION. GRAZIANI+CORAZZA ARCHITECTS INC. IS NOT RESPONSIBLE FOR THE ACCURACY OF SURVEY, STRUCTURAL, MECHANICAL, ELECTRICAL, AND OTHER ENGINEERING INFORMATION SHOWN ON THIS DRAWING. REFER TO THE APPROPRIATE ENGINEERING DRAWINGS BEFORE PROCEEDING WITH THE WORK. CONSTRUCTION MUST CONFORM TO ALL APPLICABLE CODES AND REQUIREMENTS OF THE AUTHORITIES HAVING JURISDICTION. UNLESS OTHERWISE NOTED, NO INVESTIGATION HAS BEEN UNDERTAKEN OR REPORTED ON BY THIS OFFICE IN REGARDS TO THE ENVIRONMENTAL CONDITION OF THIS SITE.

THIS DRAWING IS NOT TO BE SCALED. ALL ARCHITECTURAL SYMBOLS INDICATED ON THIS DRAWING ARE GRAPHIC REPRESENTATIONS ONLY.

CONDITIONS FOR ELECTRONIC INFORMATION TRANSFER:

ELECTRONIC INFORMATION IS SUPPLIED TO THE OTHER ASSOCIATED FIRMS TO ASSIST THEM IN THE EXECUTION OF THEIR WORK / REVIEW. THE RECIPIENT FIRMS MUST DETERMINE THE COMPLETENESS / APPROPRIATENESS / RELEVANCE OF THE INFORMATION IN RESPECT TO THEIR PARTICULAR RESPONSIBILITY.

GRAZIANI+CORAZZA ARCHITECTS INC. SHALL NOT BE RESPONSIBLE FOR:
1. ERRORS, OMISSIONS, INCOMPLETENESS DUE TO LOSS OF INFORMATION IN WHOLE OR PART WHEN INFORMATION IS TRANSFERRED.
2. TRANSMISSION OF ANY VIRUS OR DAMAGE TO THE RECEIVING ELECTRONIC SYSTEM WHEN INFORMATION IS TRANSFERRED.

01.	Oct.07.2019	issued for tender	___
02.	Mar.13.2020	issued for design coordination #2	___
03.	Mar.16.2020	issued for addendum #2	___
04.	Mar.16.2020	issued for addendum #3	___
05.	Aug.24.2020	issued for addendum #4	___
06.	Sept. 28.2020	issued for permit	bg
07.	Oct.20.2020	issued for addendum #5	___
08.	Nov.23.2020	issued for addendum #6	___
09.	Dec.14.2020	issued for addendum #7	___
10.	Jan.18.2021	issued for addendum #8	___
11.	Mar. 2. 2021	issued for permit	bg
12.	Mar.09.2021	issued for addendum #9	___
13.	Mar.10.2021	issued for addendum #9R	___
14.	Mar.26.2021	issued for progress	___
15.	May 14. 2021	issued for Site Instruction #1	___
16.	June 15. 2021	issued for Site Instruction #2	___
17.	July. 7. 2021	re-issued for permit	bg
18.	July. 15. 2021	Issued for Site Instruction #3	bg
19.	July. 27. 2021	Issued for Site Instruction #4	bg
20.	Aug. 3. 2021	Issued for Site Instruction #5	bg
21.	Aug. 18. 2021	Issued for Site Instruction #6	bg
22.	Aug. 20. 2021	Re-issued for permit.	bg
23.	Sept. 07. 2021	Issued for Site Instruction #7	bg
24.	Sept. 09. 2021	Issued for Site Instruction #8	bg
25.	Sept. 16. 2021	Issued for Building D Permit Revisions	bg
26.	Sept. 22. 2021	Issued for Site Instruction #9	bg
27.	Oct. 6. 2021	Re-issued for permit.	bg
28.	Oct. 8. 2021	Issued for Site Instruction #10	bg
30.	Oct. 28. 2021	Issued for Site Instruction #11	bg
31.	Nov. 05. 2021	Issued for Site Instruction #12	bg
32.	Dec. 3. 2021	Issued for Site Instruction #13	bg
33.	Dec. 6. 2021	Issued for Site Instruction #14	bg
34.	Dec. 7. 2021	Issued for Site Instruction #15	bg

01.	Apr.19.2021	issued to client	bg

issued for revisions

GRAZIANI + CORAZZA ARCHITECTS
1320 SHAWSON DRIVE, SUITE 100 MISSISSAUGA, ONTARIO L4W 1C5
T 905.795.2601 F 905.795.2644 WWW.GC-ARCHITECTS.COM

RESIDENTIAL

ATTMAR + PALLESCHI DRIVE

BRAMPTON ONTARIO

PROJECT ARCHITECT:	B.GRAZIANI
ASSISTANT DESIGNER:	R.LINCOLN
DRAWN BY:	G.C/F.C/M.B
CHECKED BY:	D.BIASE/G.COLANGELO
PLOT DATE:	DEC.13.2021
JOB #	1331.15

FORTH FLOOR PLAN
BUILDING B (PARTIAL PLAN)

1:50

A-304b2

TITLEBLOCK SIZE: 915 x 1200

THIS DRAWING, AS AN INSTRUMENT OF SERVICE, IS PROVIDED BY AND IS THE PROPERTY OF GRAZIANI+CORAZZA ARCHITECTS INC. THE CONTRACTOR MUST VERIFY AND ACCEPT RESPONSIBILITY FOR ALL DIMENSIONS AND CONDITIONS ON SITE AND MUST NOTIFY GRAZIANI+CORAZZA ARCHITECTS INC. OF ANY VARIATIONS FROM THE SUPPLIED INFORMATION. GRAZIANI+CORAZZA ARCHITECTS INC. IS NOT RESPONSIBLE FOR THE ACCURACY OF SURVEY, STRUCTURAL, MECHANICAL, ELECTRICAL, AND OTHER ENGINEERING INFORMATION SHOWN ON THIS DRAWING. REFER TO THE APPROPRIATE ENGINEERING DRAWINGS BEFORE PROCEEDING WITH THE WORK. CONSTRUCTION MUST CONFORM TO ALL APPLICABLE CODES AND REQUIREMENTS OF THE AUTHORITIES HAVING JURISDICTION. UNLESS OTHERWISE NOTED, NO INVESTIGATION HAS BEEN UNDERTAKEN OR REPORTED ON BY THIS OFFICE IN REGARDS TO THE ENVIRONMENTAL CONDITION OF THIS SITE.

THIS DRAWING IS NOT TO BE SCALED. ALL ARCHITECTURAL SYMBOLS INDICATED ON THIS DRAWING ARE GRAPHIC REPRESENTATIONS ONLY.

CONDITIONS FOR ELECTRONIC INFORMATION TRANSFER:

ELECTRONIC INFORMATION IS SUPPLIED TO THE OTHER ASSOCIATED FIRMS TO ASSIST THEM IN THE EXECUTION OF THEIR WORK / REVIEW. THE RECIPIENT FIRMS MUST DETERMINE THE COMPLETENESS / APPROPRIATENESS / RELEVANCE OF THE INFORMATION IN RESPECT TO THEIR PARTICULAR RESPONSIBILITY.

GRAZIANI + CORAZZA ARCHITECTS INC. SHALL NOT BE RESPONSIBLE FOR:
1. ERRORS, OMISSIONS, INCOMPLETENESS DUE TO LOSS OF INFORMATION IN WHOLE OR PART WHEN INFORMATION IS TRANSFERRED.
2. TRANSMISSION OF ANY VIRUS OR DAMAGE TO THE RECEIVING ELECTRONIC SYSTEM WHEN INFORMATION IS TRANSFERRED.

REF. A304b2 FOR CONTINUATION

01.	Oct.07.2019	issued for tender	___
02.	Mar.13.2020	issued for design coordination #2	___
03.	Mar.16.2020	issued for addendum #2	___
04.	Mar.16.2020	issued for addendum #3	___
05.	Aug.24.2020	issued for addendum #4	___
06.	Sept. 28.2020	issued for permit	bg
07.	Oct.20.2020	issued for addendum #5	___
08.	Nov.23.2020	issued for addendum #6	___
09.	Dec.14.2020	issued for addendum #7	___
10.	Jan.18.2021	issued for addendum #8	___
11.	Mar. 2. 2021	issued for permit	bg
12.	Mar.09.2021	issued for addendum #9	___
13.	Mar.10.2021	issued for addendum #9R	___
14.	Mar.26.2021	issued for progress	___
15.	May 14. 2021	issued for Site Instruction #1	___
16.	June 15. 2021	issued for Site Instruction #2	___
17.	July. 7. 2021	re-issued for permit	bg
18.	July. 15. 2021	Issued for Site Instruction #3	bg
19.	July. 27. 2021	Issued for Site Instruction #4	bg
20.	Aug. 3. 2021	Issued for Site Instruction #5	bg
21.	Aug. 18. 2021	Issued for Site Instruction #6	bg
22.	Aug. 20. 2021	Re-issued for permit.	bg
23.	Sept. 07. 2021	Issued for Site Instruction #7	bg
24.	Sept. 09. 2021	Issued for Site Instruction #8	bg
25.	Sept. 16. 2021	Issued for Building D Permit Revisions	bg
26.	Sept. 22. 2021	Issued for Site Instruction #9	bg
27.	Oct. 6. 2021	Re-issued for permit.	bg
28.	Oct. 8. 2021	Issued for Site Instruction #10	bg
30.	Oct. 28. 2021	Issued for Site Instruction #11	bg
31.	Nov. 05. 2021	Issued for Site Instruction #12	bg
32.	Dec. 3. 2021	Issued for Site Instruction #13	bg
33.	Dec. 6. 2021	Issued for Site Instruction #14	bg
34.	Dec. 7. 2021	Issued for Site Instruction #15	bg

01.	Apr.19.2021	issued to client	bg

issued for revisions

GRAZIANI CORAZZA ARCHITECTS
1320 DAWSON DRIVE, SUITE 100, MISSISSAUGA, ONTARIO, L4W 1C3
T.905.795.2601 F.905.795.2644 WWW.GC-ARCHITECTS.COM

RESIDENTIAL

ROYAL PINE HOMES

ATTMAR + PALLESCHI DRIVE

BRAMPTON ONTARIO

PROJECT ARCHITECT:	B.GRAZIANI
ASSISTANT DESIGNER:	R.LINCOLN
DRAWN BY:	G.C/F.C/M.B
CHECKED BY:	D.BIASE/G.COLANGELO
PLOT DATE:	DEC.13.2021
JOB #	1331.15

KEY PLAN

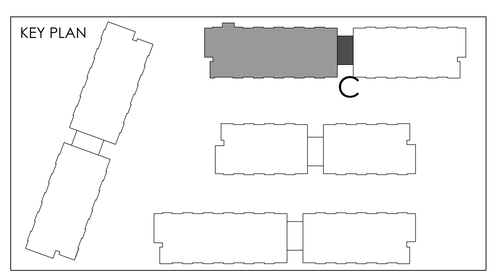

FORTH FLOOR PLAN
BUILDING C (PARTIAL PLAN)

1:50

A-304c1

TITLEBLOCK SIZE: 915 x 1200

REF.A304b1 FOR CONTINUATION

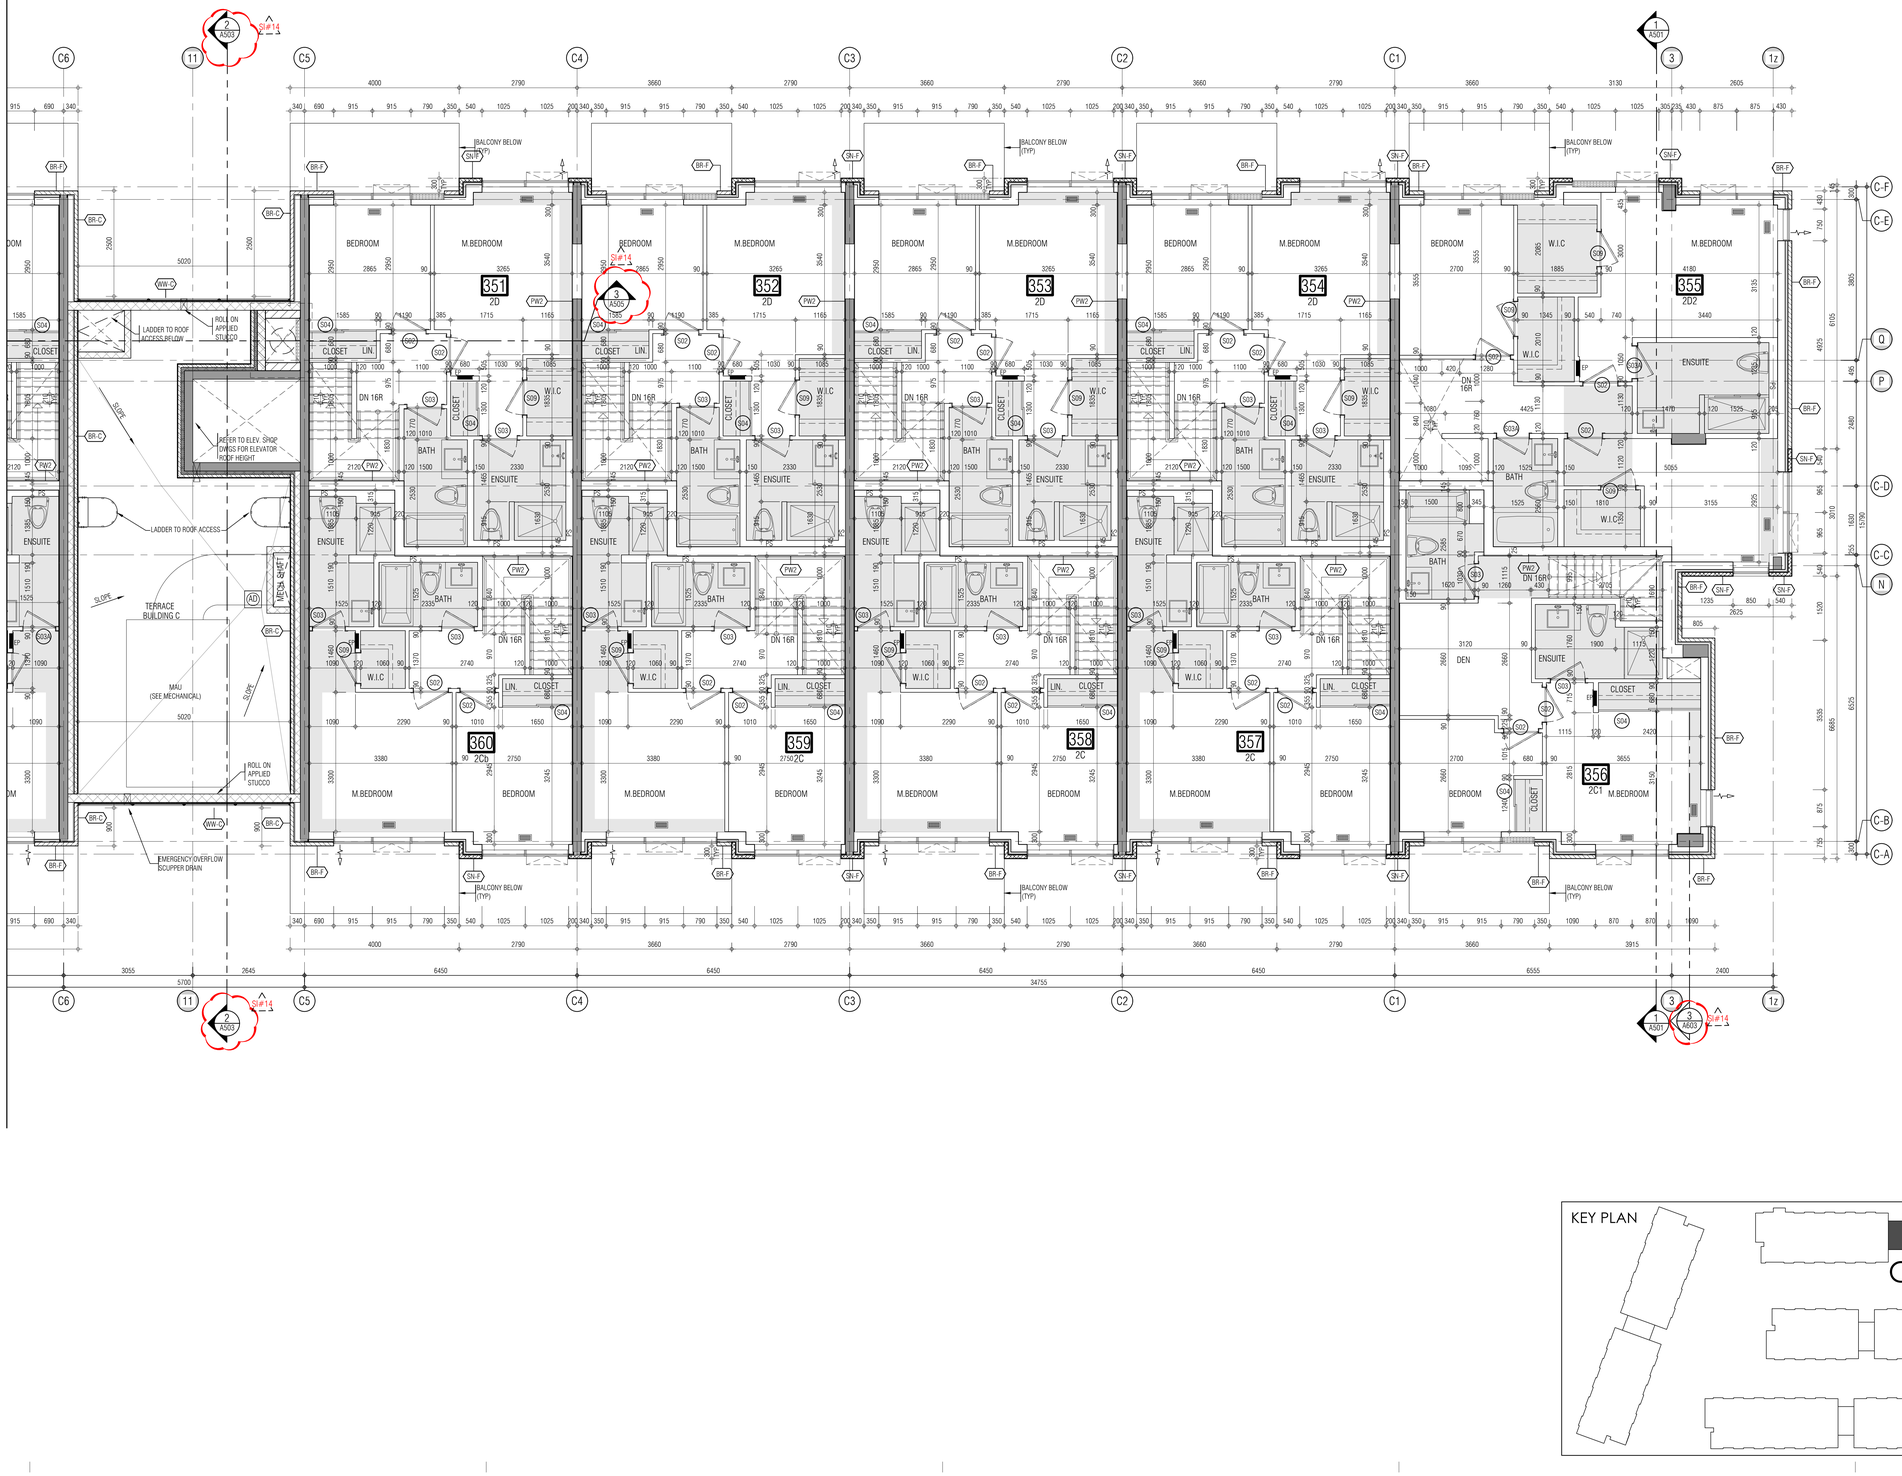

THIS DRAWING, AS AN INSTRUMENT OF SERVICE, IS PROVIDED BY AND IS THE PROPERTY OF GRAZIANI+CORAZZA ARCHITECTS INC. THE CONTRACTOR MUST VERIFY AND ACCEPT RESPONSIBILITY FOR ALL DIMENSIONS AND CONDITIONS ON SITE AND MUST NOTIFY GRAZIANI+CORAZZA ARCHITECTS INC. OF ANY VARIATIONS FROM THE SUPPLIED INFORMATION. GRAZIANI+CORAZZA ARCHITECTS INC. IS NOT RESPONSIBLE FOR THE ACCURACY OF SURVEY, STRUCTURAL, MECHANICAL, ELECTRICAL, AND OTHER ENGINEERING INFORMATION SHOWN ON THIS DRAWING. REFER TO THE APPROPRIATE ENGINEERING DRAWINGS BEFORE PROCEEDING WITH THE WORK. CONSTRUCTION MUST CONFORM TO ALL APPLICABLE CODES AND REQUIREMENTS OF THE AUTHORITIES HAVING JURISDICTION. UNLESS OTHERWISE NOTED, NO INVESTIGATION HAS BEEN UNDERTAKEN OR REPORTED ON BY THIS OFFICE IN REGARDS TO THE ENVIRONMENTAL CONDITION OF THIS SITE.

THIS DRAWING IS NOT TO BE SCALED. ALL ARCHITECTURAL SYMBOLS INDICATED ON THIS DRAWING ARE GRAPHIC REPRESENTATIONS ONLY.

CONDITIONS FOR ELECTRONIC INFORMATION TRANSFER:

ELECTRONIC INFORMATION IS SUPPLIED TO THE OTHER ASSOCIATED FIRMS TO ASSIST THEM IN THE EXECUTION OF THEIR WORK / REVIEW. THE RECIPIENT FIRMS MUST DETERMINE THE COMPLETENESS / APPROPRIATENESS / RELEVANCE OF THE INFORMATION IN RESPECT TO THEIR PARTICULAR RESPONSIBILITY.

GRAZIANI+CORAZZA ARCHITECTS INC. SHALL NOT BE RESPONSIBLE FOR:
1. ERRORS, OMISSIONS, INCOMPLETENESS DUE TO LOSS OF INFORMATION IN WHOLE OR PART WHEN INFORMATION IS TRANSFERRED.
2. TRANSMISSION OF ANY VIRUS OR DAMAGE TO THE RECEIVING ELECTRONIC SYSTEM WHEN INFORMATION IS TRANSFERRED.

01.	Oct.07.2019	issued for tender	___
02.	Mar.13.2020	issued for design coordination #2	___
03.	Mar.16.2020	issued for addendum #2	___
04.	Mar.16.2020	issued for addendum #3	___
05.	Aug.24.2020	issued for addendum #4	___
06.	Sept. 28.2020	issued for permit	bg
07.	Oct.20.2020	issued for addendum #5	___
08.	Nov.23.2020	issued for addendum #6	___
09.	Dec.14.2020	issued for addendum #7	___
10.	Jan.18.2021	issued for addendum #8	___
11.	Mar. 2. 2021	issued for permit	bg
12.	Mar.09.2021	issued for addendum #9	___
13.	Mar.10.2021	issued for addendum #9R	___
14.	Mar.26.2021	issued for progress	___
15.	May 14. 2021	issued for Site Instruction #1	___
16.	June 15. 2021	issued for Site Instruction #2	___
17.	July. 7. 2021	re-issued for permit	bg
18.	July. 15. 2021	Issued for Site Instruction #3	bg
19.	July. 27. 2021	Issued for Site Instruction #4	bg
20.	Aug. 3. 2021	Issued for Site Instruction #5	bg
21.	Aug. 18. 2021	Issued for Site Instruction #6	bg
22.	Aug. 20. 2021	Re-issued for permit.	bg
23.	Sept. 07. 2021	Issued for Site Instruction #7	bg
24.	Sept. 09. 2021	Issued for Site Instruction #8	bg
25.	Sept. 16. 2021	Issued for Building D Permit Revisions	bg
26.	Sept. 22. 2021	Issued for Site Instruction #9	bg
27.	Oct. 6. 2021	Re-issued for permit.	bg
28.	Oct. 8. 2021	Issued for Site Instruction #10	bg
30.	Oct. 28. 2021	Issued for Site Instruction #11	bg
31.	Nov. 05. 2021	Issued for Site Instruction #12	bg
32.	Dec. 3. 2021	Issued for Site Instruction #13	bg
33.	Dec. 6. 2021	Issued for Site Instruction #14	bg
34.	Dec. 7. 2021	Issued for Site Instruction #15	bg

01.	Apr.19.2021	issued to client	bg

issued for revisions

GRAZIANI + CORAZZA ARCHITECTS
1320 DAWSON DRIVE, SUITE 100, MISSISSAUGA, ONTARIO, L4W 1C3
T.905.795.2501 F.905.795.2644 WWW.GC-ARCHITECTS.COM

RESIDENTIAL

ATTMAR + PALLESCHI DRIVE

BRAMPTON ONTARIO

PROJECT ARCHITECT:	B.GRAZIANI
ASSISTANT DESIGNER:	R.LINCOLN
DRAWN BY:	G.C/F.C/M.B
CHECKED BY:	D.BIASE/G.COLANGELO
PLOT DATE:	DEC.13.2021
JOB #	1331.15

FORTH FLOOR PLAN
BUILDING C (PARTIAL PLAN)

1:50

A-304c2

TITLEBLOCK SIZE: 915 x 1200

KEY PLAN

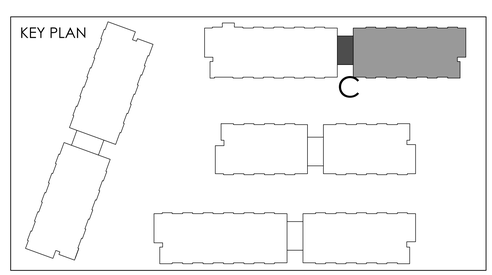

THIS DRAWING, AS AN INSTRUMENT OF SERVICE, IS PROVIDED BY AND IS THE PROPERTY OF GRAZIANI+CORAZZA ARCHITECTS INC. THE CONTRACTOR MUST VERIFY AND ACCEPT RESPONSIBILITY FOR ALL DIMENSIONS AND CONDITIONS ON SITE AND MUST NOTIFY GRAZIANI+CORAZZA ARCHITECTS INC. OF ANY VARIATIONS FROM THE SUPPLIED INFORMATION. GRAZIANI+CORAZZA ARCHITECTS INC. IS NOT RESPONSIBLE FOR THE ACCURACY OF SURVEY, STRUCTURAL, MECHANICAL, ELECTRICAL, AND OTHER ENGINEERING INFORMATION SHOWN ON THIS DRAWING. REFER TO THE APPROPRIATE ENGINEERING DRAWINGS BEFORE PROCEEDING WITH THE WORK. CONSTRUCTION MUST CONFORM TO ALL APPLICABLE CODES AND REQUIREMENTS OF THE AUTHORITIES HAVING JURISDICTION. UNLESS OTHERWISE NOTED, NO INVESTIGATION HAS BEEN UNDERTAKEN OR REPORTED ON BY THIS OFFICE IN REGARDS TO THE ENVIRONMENTAL CONDITION OF THIS SITE.

THIS DRAWING IS NOT TO BE SCALED. ALL ARCHITECTURAL SYMBOLS INDICATED ON THIS DRAWING ARE GRAPHIC REPRESENTATIONS ONLY.

CONDITIONS FOR ELECTRONIC INFORMATION TRANSFER:

ELECTRONIC INFORMATION IS SUPPLIED TO THE OTHER ASSOCIATED FIRMS TO ASSIST THEM IN THE EXECUTION OF THEIR WORK / REVIEW. THE RECIPIENT FIRMS MUST DETERMINE THE COMPLETENESS / APPROPRIATENESS / RELEVANCE OF THE INFORMATION IN RESPECT TO THEIR PARTICULAR RESPONSIBILITY.

GRAZIANI+CORAZZA ARCHITECTS INC. SHALL NOT BE RESPONSIBLE FOR:
1. ERRORS, OMISSIONS, INCOMPLETENESS DUE TO LOSS OF INFORMATION IN WHOLE OR PART WHEN INFORMATION IS TRANSFERRED.
2. TRANSMISSION OF ANY VIRUS OR DAMAGE TO THE RECEIVING ELECTRONIC SYSTEM WHEN INFORMATION IS TRANSFERRED.

REF. A304a2 FOR CONTINUATION

01.	Oct.07.2019	issued for tender	___
02.	Mar.13.2020	issued for design coordination #2	___
03.	Mar.16.2020	issued for addendum #2	___
04.	Mar.16.2020	issued for addendum #3	___
05.	Aug.24.2020	issued for addendum #4	___
06.	Sept. 28.2020	issued for permit	bg
07.	Oct.20.2020	issued for addendum #5	___
08.	Nov.23.2020	issued for addendum #6	___
09.	Dec.14.2020	issued for addendum #7	___
10.	Jan.18.2021	issued for addendum #8	___
11.	Mar. 2. 2021	issued for permit	bg
12.	Mar.09.2021	issued for addendum #9	___
13.	Mar.10.2021	issued for addendum #9R	___
14.	Mar.26.2021	issued for progress	___
15.	May 14. 2021	issued for Site Instruction #1	___
16.	June 15. 2021	issued for Site Instruction #2	___
17.	July. 7. 2021	re-issued for permit	bg
18.	July. 15. 2021	Issued for Site Instruction #3	bg
19.	July. 27. 2021	Issued for Site Instruction #4	bg
20.	Aug. 3. 2021	Issued for Site Instruction #5	bg
21.	Aug. 18. 2021	Issued for Site Instruction #6	bg
22.	Aug. 20. 2021	Re-issued for permit.	bg
23.	Sept. 07. 2021	Issued for Site Instruction #7	bg
24.	Sept. 09. 2021	Issued for Site Instruction #8	bg
25.	Sept. 16. 2021	Issued for Building D Permit Revisions	bg
26.	Sept. 22. 2021	Issued for Site Instruction #9	bg
27.	Oct. 6. 2021	Re-issued for permit.	bg
28.	Oct. 8. 2021	Issued for Site Instruction #10	bg
30.	Oct. 28. 2021	Issued for Site Instruction #11	bg
31.	Nov. 05. 2021	Issued for Site Instruction #12	bg
32.	Dec. 3. 2021	Issued for Site Instruction #13	bg
33.	Dec. 6. 2021	Issued for Site Instruction #14	bg
34.	Dec. 7. 2021	Issued for Site Instruction #15	bg

01.	Apr.19.2021	issued to client	bg

issued for revisions

GRAZIANI + CORAZZA ARCHITECTS
1320 SHERIDAN DRIVE SUITE 100 MISSISSAUGA, ONTARIO L4W 1C3
T.905.799.2601 F.905.799.2644 WWW.GC-ARCHITECTS.COM

RESIDENTIAL

ATTMAR + PALLESCHI DRIVE

BRAMPTON	ONTARIO
PROJECT ARCHITECT:	B.GRAZIANI
ASSISTANT DESIGNER:	R.LINCOLN
DRAWN BY:	G.C/F.C/M.B
CHECKED BY:	D.BIASE/G.COLANGELO
PLOT DATE:	DEC.13.2021
JOB #:	1331.15

KEY PLAN

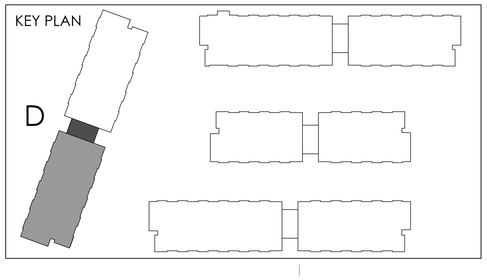

FORTH FLOOR PLAN
BUILDING D (PARTIAL PLAN)

1:50

A-304d1

TITLEBLOCK SIZE: 915 x 1200

REF. A304a1 FOR CONTINUATION

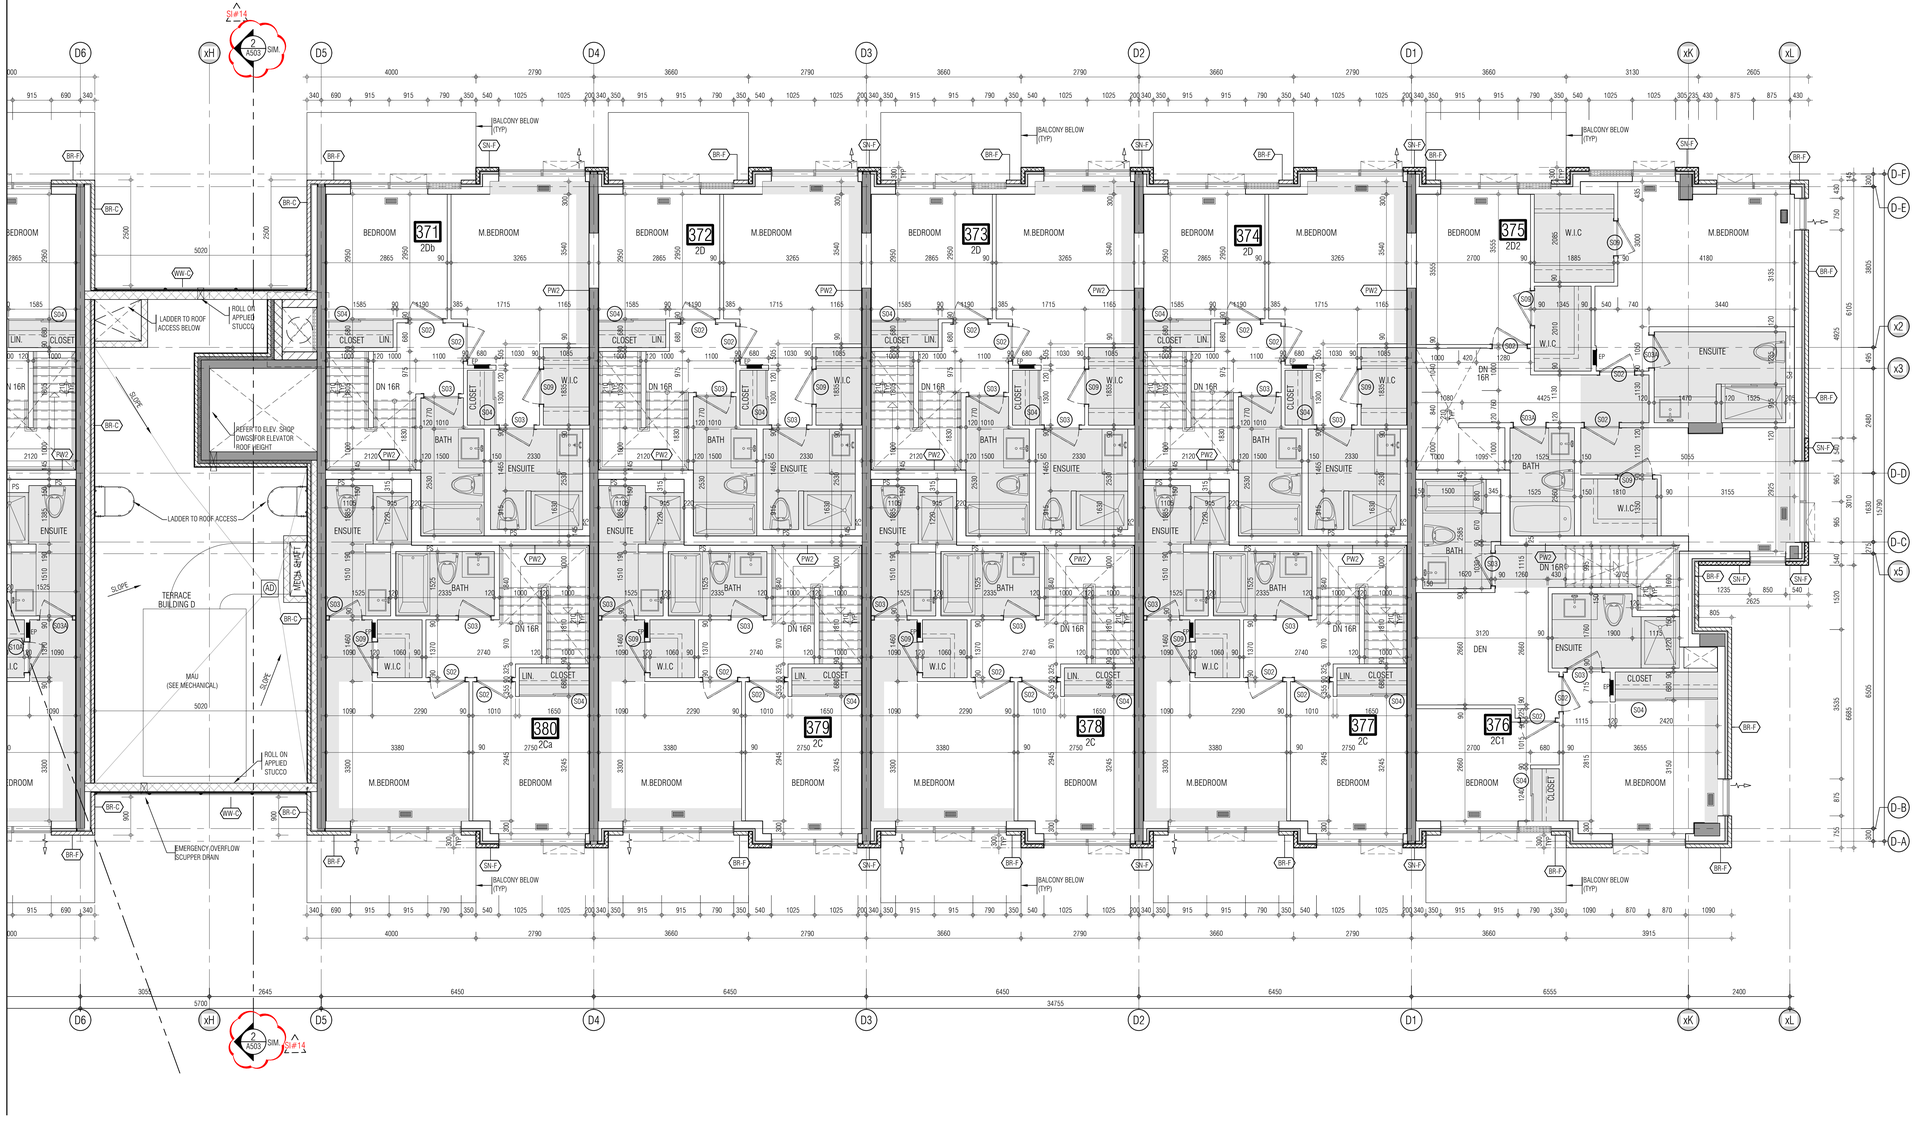

THIS DRAWING, AS AN INSTRUMENT OF SERVICE, IS PROVIDED BY AND IS THE PROPERTY OF GRAZIANI+CORAZZA ARCHITECTS INC. THE CONTRACTOR MUST VERIFY AND ACCEPT RESPONSIBILITY FOR ALL DIMENSIONS AND CONDITIONS ON SITE AND MUST NOTIFY GRAZIANI+CORAZZA ARCHITECTS INC. OF ANY VARIATIONS FROM THE SUPPLIED INFORMATION. GRAZIANI+CORAZZA ARCHITECTS INC. IS NOT RESPONSIBLE FOR THE ACCURACY OF SURVEY, STRUCTURAL, MECHANICAL, ELECTRICAL, AND OTHER ENGINEERING INFORMATION SHOWN ON THIS DRAWING. REFER TO THE APPROPRIATE ENGINEERING DRAWINGS BEFORE PROCEEDING WITH THE WORK. CONSTRUCTION MUST CONFORM TO ALL APPLICABLE CODES AND REQUIREMENTS OF THE AUTHORITIES HAVING JURISDICTION. UNLESS OTHERWISE NOTED, NO INVESTIGATION HAS BEEN UNDERTAKEN OR REPORTED ON BY THIS OFFICE IN REGARDS TO THE ENVIRONMENTAL CONDITION OF THIS SITE.

THIS DRAWING IS NOT TO BE SCALED. ALL ARCHITECTURAL SYMBOLS INDICATED ON THIS DRAWING ARE GRAPHIC REPRESENTATIONS ONLY.

CONDITIONS FOR ELECTRONIC INFORMATION TRANSFER:

ELECTRONIC INFORMATION IS SUPPLIED TO THE OTHER ASSOCIATED FIRMS TO ASSIST THEM IN THE EXECUTION OF THEIR WORK / REVIEW. THE RECIPIENT FIRMS MUST DETERMINE THE COMPLETENESS / APPROPRIATENESS / RELEVANCE OF THE INFORMATION IN RESPECT TO THEIR PARTICULAR RESPONSIBILITY.

GRAZIANI+CORAZZA ARCHITECTS INC. SHALL NOT BE RESPONSIBLE FOR:
1. ERRORS, OMISSIONS, INCOMPLETENESS DUE TO LOSS OF INFORMATION IN WHOLE OR PART WHEN INFORMATION IS TRANSFERRED.
2. TRANSMISSION OF ANY VIRUS OR DAMAGE TO THE RECEIVING ELECTRONIC SYSTEM WHEN INFORMATION IS TRANSFERRED.

01.	Oct.07.2019	issued for tender	___
02.	Mar.13.2020	issued for design coordination #2	___
03.	Mar.16.2020	issued for addendum #2	___
04.	Mar.16.2020	issued for addendum #3	___
05.	Aug.24.2020	issued for addendum #4	___
06.	Sept. 28.2020	issued for permit	bg
07.	Oct.20.2020	issued for addendum #5	___
08.	Nov.23.2020	issued for addendum #6	___
09.	Dec.14.2020	issued for addendum #7	___
10.	Jan.18.2021	issued for addendum #8	___
11.	Mar. 2. 2021	issued for permit	bg
12.	Mar.09.2021	issued for addendum #9	___
13.	Mar.10.2021	issued for addendum #9R	___
14.	Mar.26.2021	issued for progress	___
15.	May 14. 2021	issued for Site Instruction #1	___
16.	June 15. 2021	issued for Site Instruction #2	___
17.	July. 7. 2021	re-issued for permit	bg
18.	July. 15. 2021	Issued for Site Instruction #3	bg
19.	July. 27. 2021	Issued for Site Instruction #4	bg
20.	Aug. 3. 2021	Issued for Site Instruction #5	bg
21.	Aug. 18. 2021	Issued for Site Instruction #6	bg
22.	Aug. 20. 2021	Re-issued for permit.	bg
23.	Sept. 07. 2021	Issued for Site Instruction #7	bg
24.	Sept. 09. 2021	Issued for Site Instruction #8	bg
25.	Sept. 16. 2021	Issued for Building D Permit Revisions	bg
26.	Sept. 22. 2021	Issued for Site Instruction #9	bg
27.	Oct. 6. 2021	Re-issued for permit.	bg
28.	Oct. 8. 2021	Issued for Site Instruction #10	bg
30.	Oct. 28. 2021	Issued for Site Instruction #11	bg
31.	Nov. 05. 2021	Issued for Site Instruction #12	bg
32.	Dec. 3. 2021	Issued for Site Instruction #13	bg
33.	Dec. 6. 2021	Issued for Site Instruction #14	bg
34.	Dec. 7. 2021	Issued for Site Instruction #15	bg

KEY PLAN

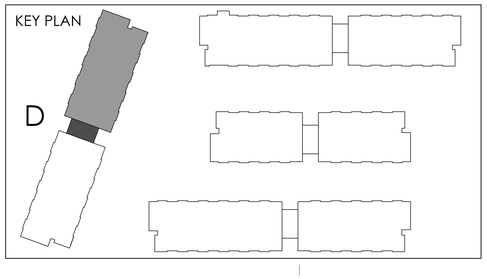

01.	Apr.19.2021	issued to client	bg

issued for revisions

GRAZIANI + CORAZZA ARCHITECTS
1300 DAMASCUS DRIVE SUITE 100 MISSISSAUGA ONTARIO L4W 1C3
T.905.795.2601 F.905.795.2644 WWW.GC-ARCHITECTS.COM

RESIDENTIAL

ATTMAR + PALLESCHI DRIVE

BRAMPTON ONTARIO

PROJECT ARCHITECT:	B.GRAZIANI
ASSISTANT DESIGNER:	R.LINCOLN
DRAWN BY:	G.C./F.C./M.B
CHECKED BY:	D.BIASE/G.COLANGELO
PLOT DATE:	DEC.13.2021
JOB #	1331.15

FORTH FLOOR PLAN
BUILDING D (PARTIAL PLAN)

1:50

A-304d2

TITLEBLOCK SIZE: 915 x 1200

THIS DRAWING, AS AN INSTRUMENT OF SERVICE, IS PROVIDED BY AND IS THE PROPERTY OF GRAZIANI+CORAZZA ARCHITECTS INC. THE CONTRACTOR MUST VERIFY AND ACCEPT RESPONSIBILITY FOR ALL DIMENSIONS AND CONDITIONS ON SITE AND MUST NOTIFY GRAZIANI+CORAZZA ARCHITECTS INC. OF ANY VARIATIONS FROM THE SUPPLIED INFORMATION. GRAZIANI+CORAZZA ARCHITECTS INC. IS NOT RESPONSIBLE FOR THE ACCURACY OF SURVEY, STRUCTURAL, MECHANICAL, ELECTRICAL, AND OTHER ENGINEERING INFORMATION SHOWN ON THIS DRAWING. REFER TO THE APPROPRIATE ENGINEERING DRAWINGS BEFORE PROCEEDING WITH THE WORK. CONSTRUCTION MUST CONFORM TO ALL APPLICABLE CODES AND REQUIREMENTS OF THE AUTHORITIES HAVING JURISDICTION. UNLESS OTHERWISE NOTED, NO INVESTIGATION HAS BEEN UNDERTAKEN OR REPORTED ON BY THIS OFFICE IN REGARDS TO THE ENVIRONMENTAL CONDITION OF THIS SITE.

THIS DRAWING IS NOT TO BE SCALED. ALL ARCHITECTURAL SYMBOLS INDICATED ON THIS DRAWING ARE GRAPHIC REPRESENTATIONS ONLY.

CONDITIONS FOR ELECTRONIC INFORMATION TRANSFER:

ELECTRONIC INFORMATION IS SUPPLIED TO THE OTHER ASSOCIATED FIRMS TO ASSIST THEM IN THE EXECUTION OF THEIR WORK / REVIEW. THE RECIPIENT FIRMS MUST DETERMINE THE COMPLETENESS / APPROPRIATENESS / RELEVANCE OF THE INFORMATION IN RESPECT TO THEIR PARTICULAR RESPONSIBILITY.

GRAZIANI+CORAZZA ARCHITECTS INC. SHALL NOT BE RESPONSIBLE FOR:
1. ERRORS, OMISSIONS, INCOMPLETENESS DUE TO LOSS OF INFORMATION IN WHOLE OR PART WHEN INFORMATION IS TRANSFERRED.
2. TRANSMISSION OF ANY VIRUS OR DAMAGE TO THE RECEIVING ELECTRONIC SYSTEM WHEN INFORMATION IS TRANSFERRED.

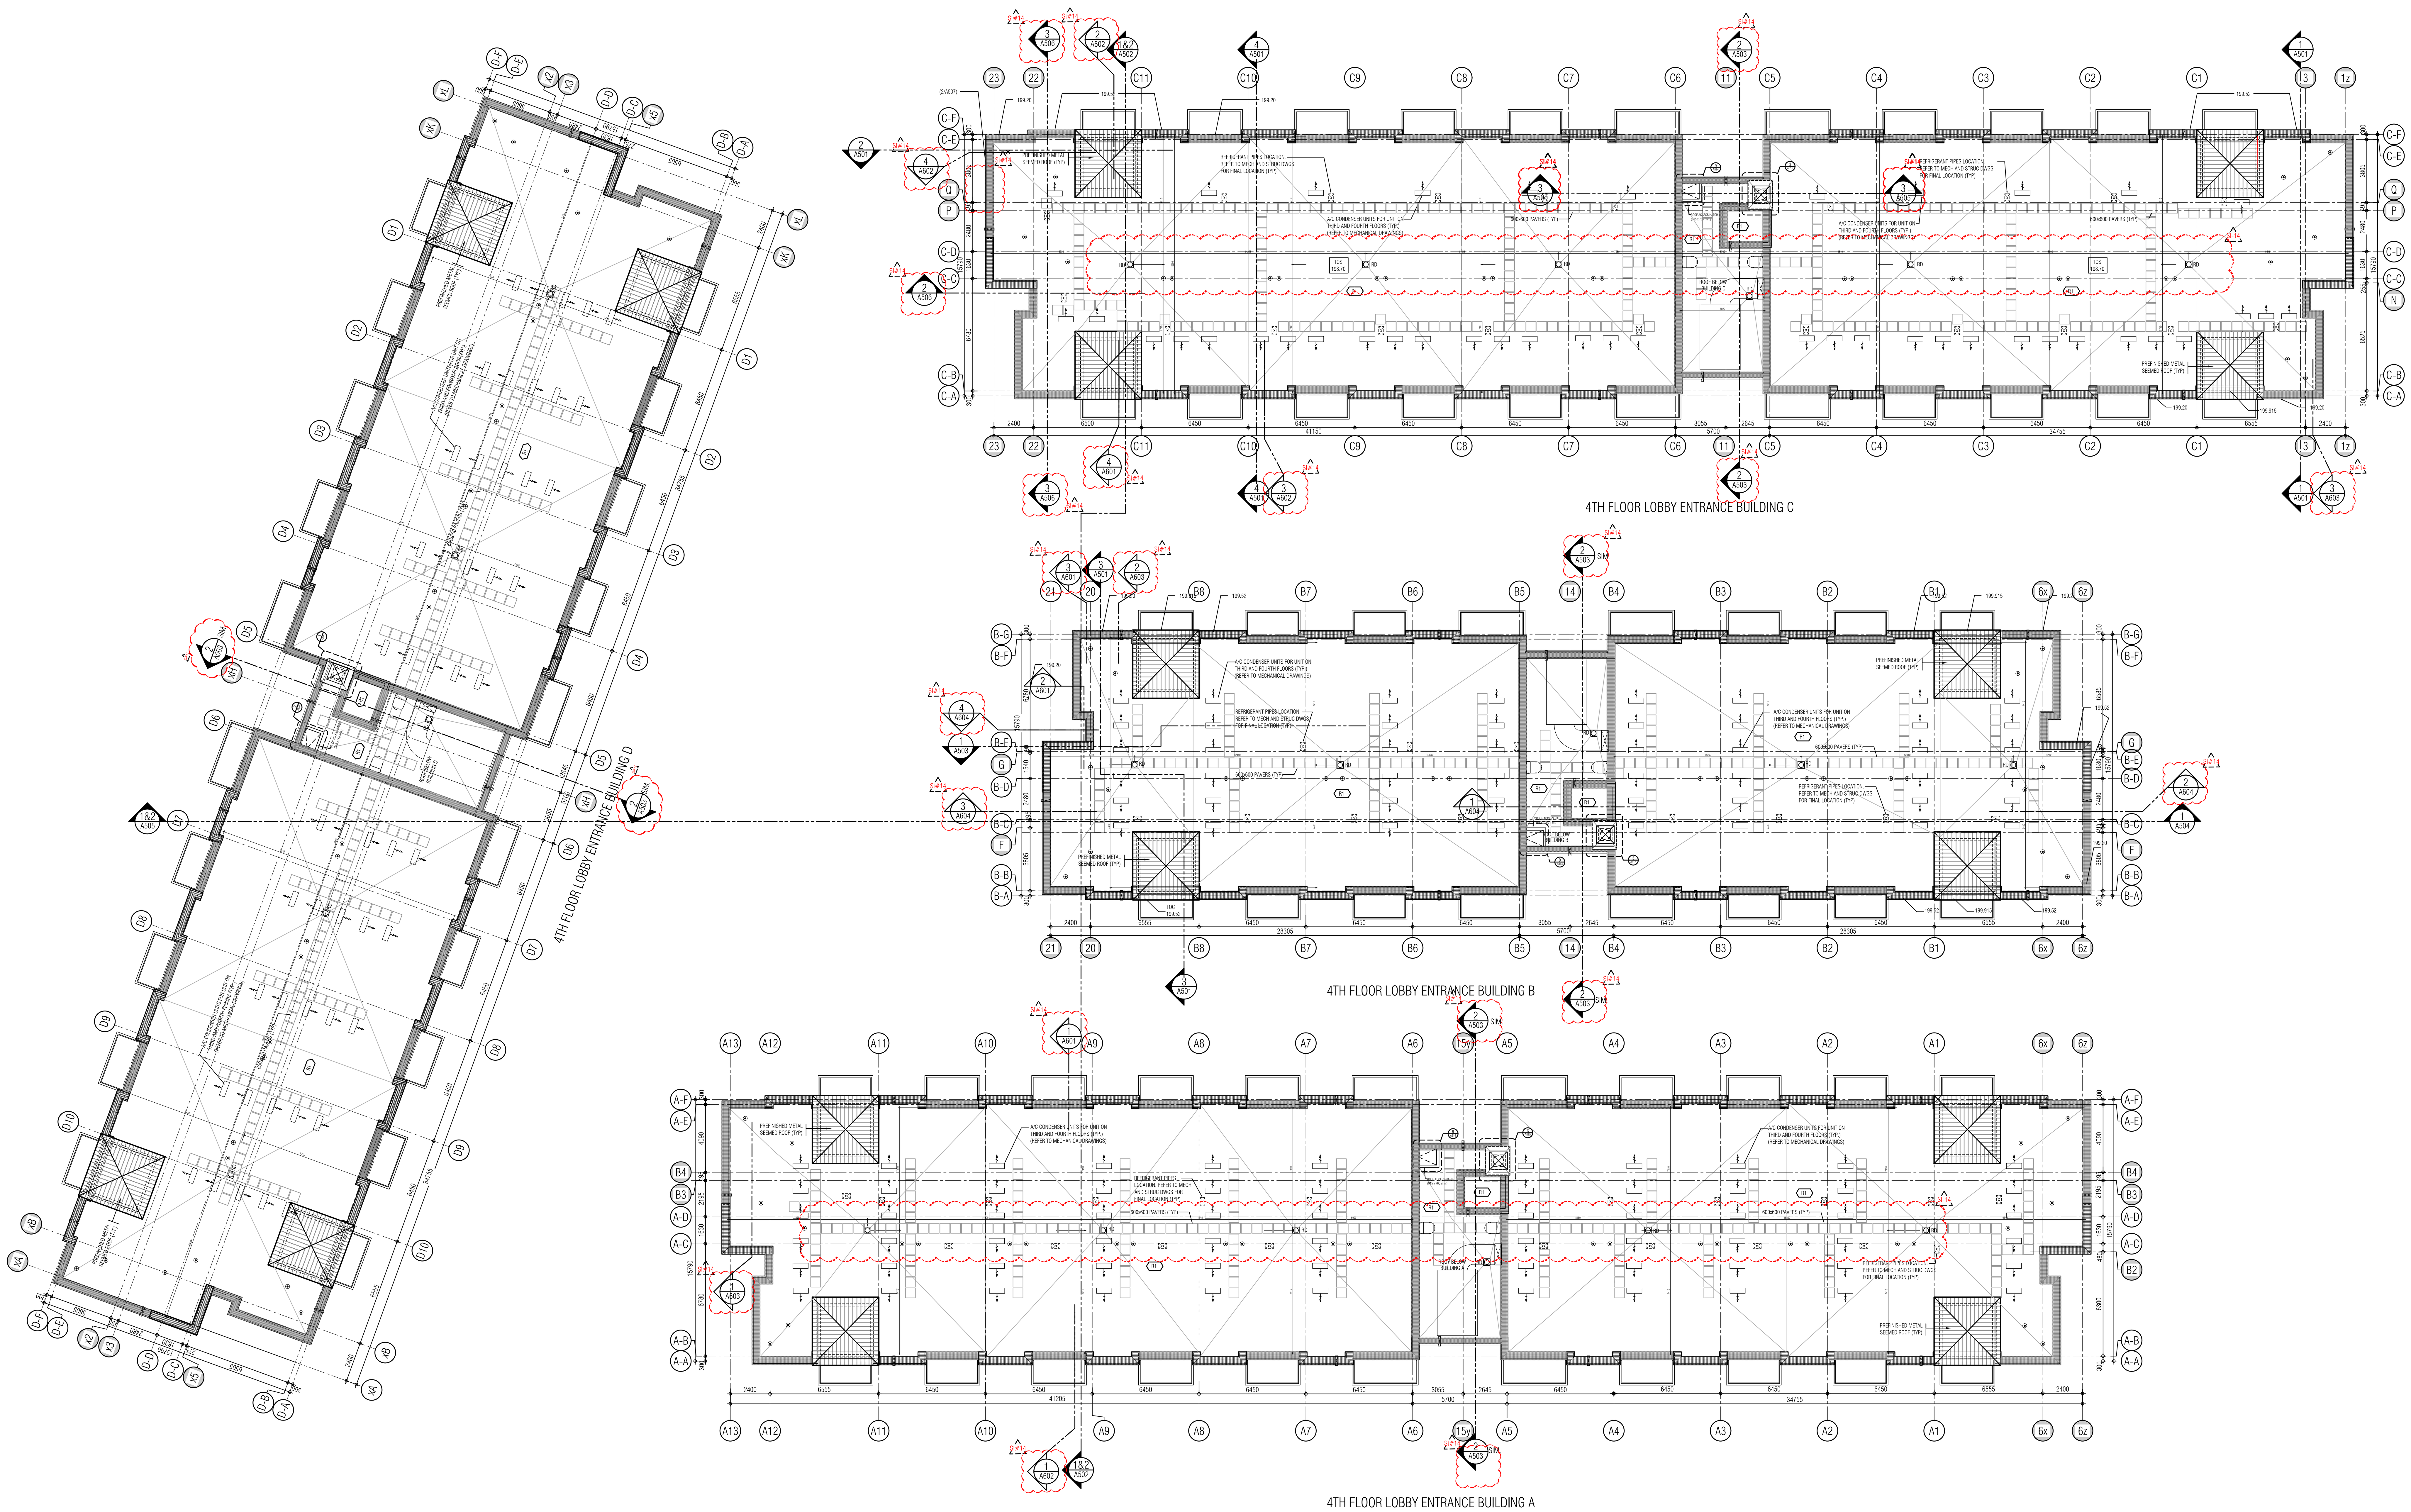

01.	Oct.07.2019	issued for tender	__
02.	Mar.13.2020	issued for design coordination #2	__
03.	Mar.16.2020	issued for addendum #2	__
04.	Mar.16.2020	issued for addendum #3	__
05.	Aug.24.2020	issued for addendum #4	__
06.	Sept. 28.2020	issued for permit	bg
07.	Oct.20.2020	issued for addendum #5	__
08.	Nov.23.2020	issued for addendum #6	__
09.	Dec.14.2020	issued for addendum #7	__
10.	Jan.18.2021	issued for addendum #8	__
11.	Mar. 2. 2021	issued for permit	bg
12.	Mar.09.2021	issued for addendum #9	__
13.	Mar.10.2021	issued for addendum #9R	__
14.	Mar.26.2021	issued for progress	__
15.	May 14. 2021	issued for Site Instruction #1	__
16.	June 15. 2021	issued for Site Instruction #2	__
17.	July. 7. 2021	re-issued for permit	bg
18.	July. 15. 2021	Issued for Site Instruction #3	bg
19.	July. 27. 2021	Issued for Site Instruction #4	bg
20.	Aug. 3. 2021	Issued for Site Instruction #5	bg
21.	Aug. 18. 2021	Issued for Site Instruction #6	bg
22.	Aug. 20. 2021	Re-issued for permit.	bg
23.	Sept. 07. 2021	Issued for Site Instruction #7	bg
24.	Sept. 09. 2021	Issued for Site Instruction #8	bg
25.	Sept. 16. 2021	Issued for Building D Permit Revisions	bg
26.	Sept. 22. 2021	Issued for Site Instruction #9	bg
27.	Oct. 6. 2021	Re-issued for permit.	bg
28.	Oct. 8. 2021	Issued for Site Instruction #10	bg
30.	Oct. 28. 2021	Issued for Site Instruction #11	bg
31.	Nov. 05. 2021	Issued for Site Instruction #12	bg
32.	Dec. 3. 2021	Issued for Site Instruction #13	bg
33.	Dec. 6. 2021	Issued for Site Instruction #14	bg
34.	Dec. 7. 2021	Issued for Site Instruction #15	bg

01.	Apr.19.2021	issued to client	bg

issued for revisions

GRAZIANI + CORAZZA ARCHITECTS

1320 SHAWSON DRIVE, SUITE 100 MISSISSAUGA, ONTARIO L4W 1C3
T.905.795.2601 F.905.795.2844 WWW.GC-ARCHITECTS.COM

RESIDENTIAL

ATTMAR + PALLESCHI DRIVE

BRAMPTON ONTARIO

PROJECT ARCHITECT:	B.GRAZIANI
ASSISTANT DESIGNER:	R.LINCOLN
DRAWN BY:	G.C/F.C/M.B
CHECKED BY:	D.BIASE/G.COLANGELO
PLOT DATE:	DEC.13.2021
JOB #	1331.15

ROOF OVERALL PLAN

1:150

A305

TITLEBLOCK SIZE: 915 x 1200

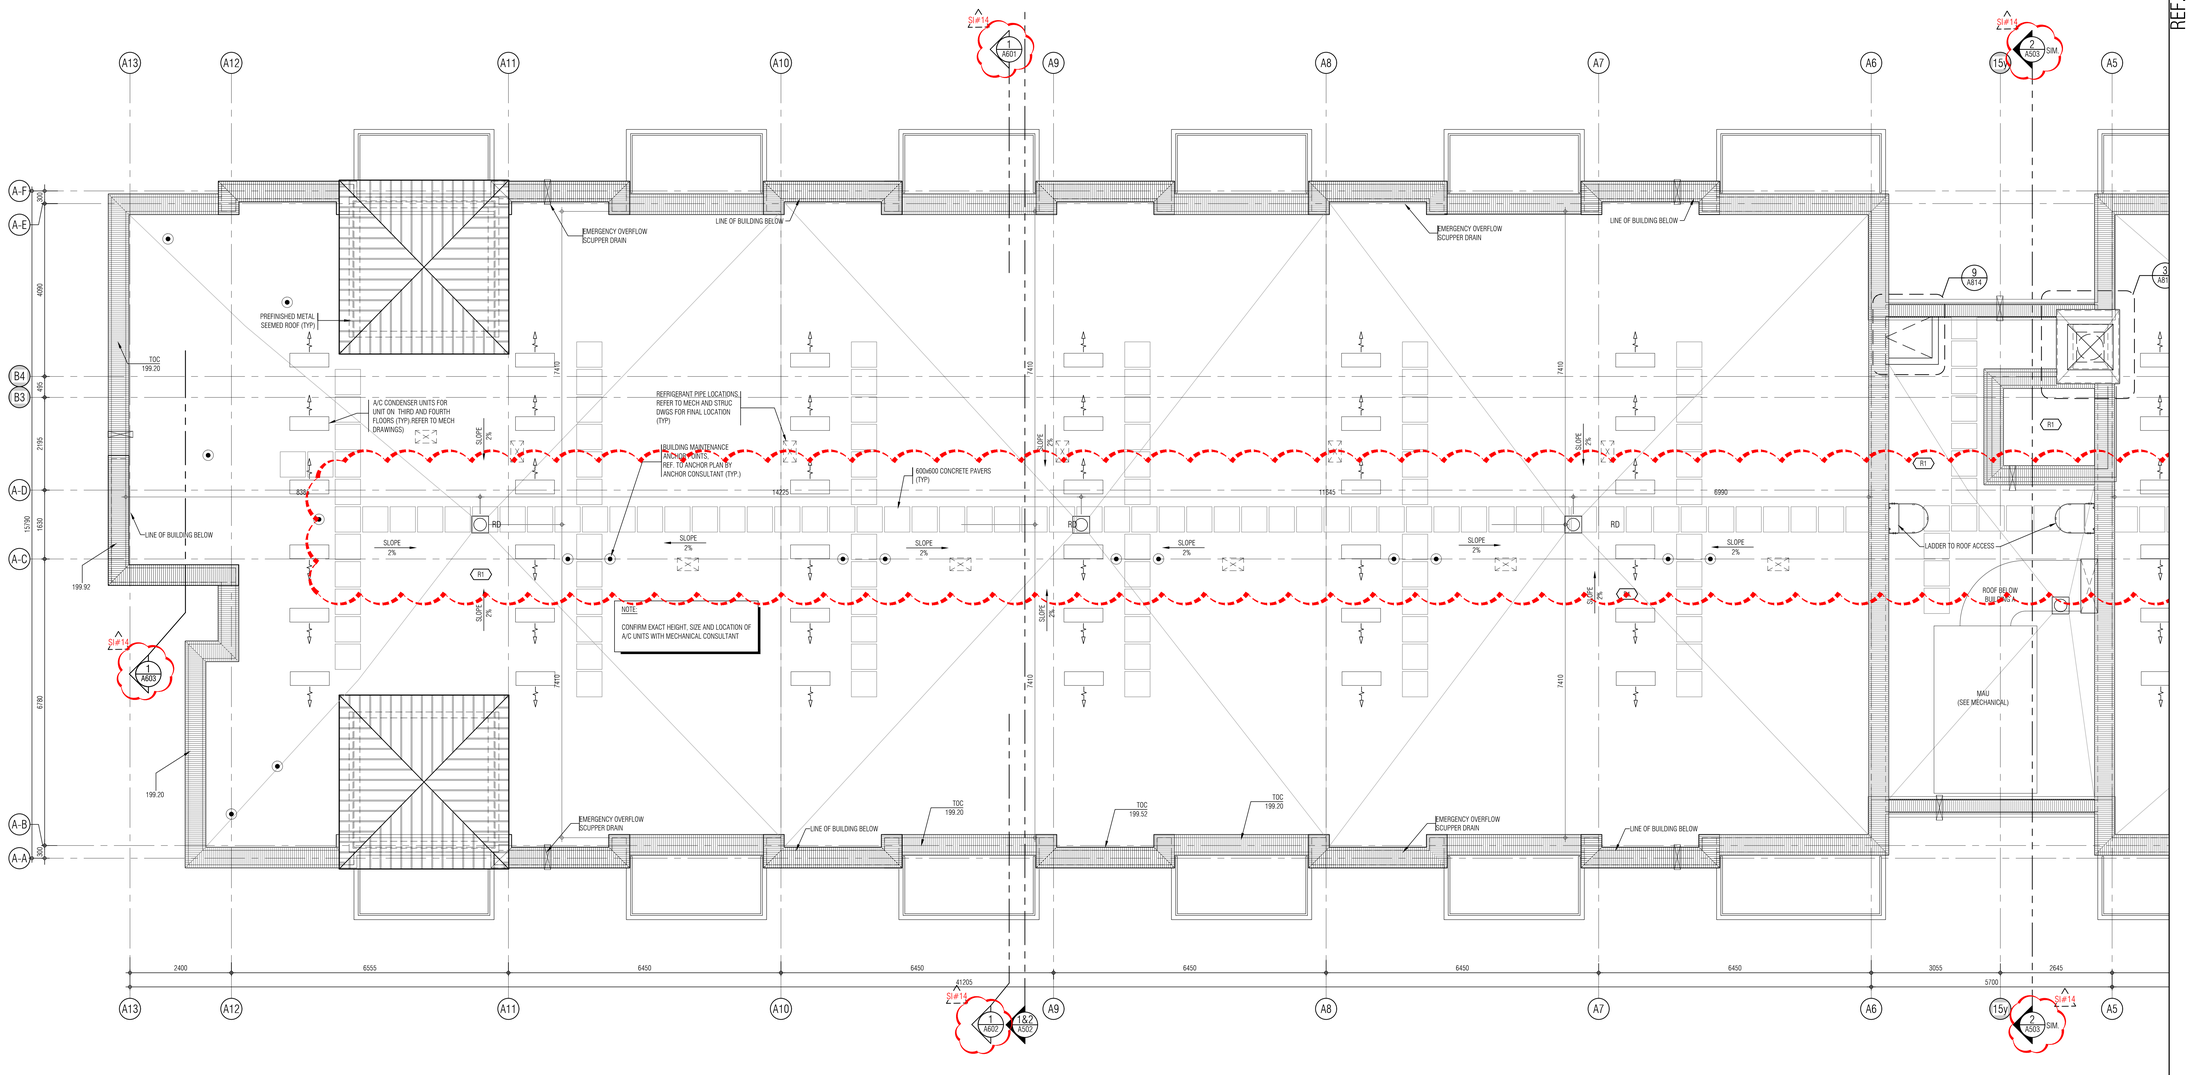

THIS DRAWING, AS AN INSTRUMENT OF SERVICE, IS PROVIDED BY AND IS THE PROPERTY OF GRAZIANI+CORAZZA ARCHITECTS INC. THE CONTRACTOR MUST VERIFY AND ACCEPT RESPONSIBILITY FOR ALL DIMENSIONS AND CONDITIONS ON SITE AND MUST NOTIFY GRAZIANI+CORAZZA ARCHITECTS INC. OF ANY VARIATIONS FROM THE SUPPLIED INFORMATION. GRAZIANI+CORAZZA ARCHITECTS INC. IS NOT RESPONSIBLE FOR THE ACCURACY OF SURVEY, STRUCTURAL, MECHANICAL, ELECTRICAL, AND OTHER ENGINEERING INFORMATION SHOWN ON THIS DRAWING. REFER TO THE APPROPRIATE ENGINEERING DRAWINGS BEFORE PROCEEDING WITH THE WORK. CONSTRUCTION MUST CONFORM TO ALL APPLICABLE CODES AND REQUIREMENTS OF THE AUTHORITIES HAVING JURISDICTION. UNLESS OTHERWISE NOTED, NO INVESTIGATION HAS BEEN UNDERTAKEN OR REPORTED ON BY THIS OFFICE IN REGARDS TO THE ENVIRONMENTAL CONDITION OF THIS SITE.

THIS DRAWING IS NOT TO BE SCALED. ALL ARCHITECTURAL SYMBOLS INDICATED ON THIS DRAWING ARE GRAPHIC REPRESENTATIONS ONLY.

CONDITIONS FOR ELECTRONIC INFORMATION TRANSFER:

ELECTRONIC INFORMATION IS SUPPLIED TO THE OTHER ASSOCIATED FIRMS TO ASSIST THEM IN THE EXECUTION OF THEIR WORK / REVIEW. THE RECIPIENT FIRMS MUST DETERMINE THE COMPLETENESS / APPROPRIATENESS / RELEVANCE OF THE INFORMATION IN RESPECT TO THEIR PARTICULAR RESPONSIBILITY.

GRAZIANI+CORAZZA ARCHITECTS INC. SHALL NOT BE RESPONSIBLE FOR:
1. ERRORS, OMISSIONS, INCOMPLETENESS DUE TO LOSS OF INFORMATION IN WHOLE OR PART WHEN INFORMATION IS TRANSFERRED.
2. TRANSMISSION OF ANY VIRUS OR DAMAGE TO THE RECEIVING ELECTRONIC SYSTEM WHEN INFORMATION IS TRANSFERRED.

REF.A305d2 FOR CONTINUATION

01.	Oct.07.2019	issued for tender	—
02.	Mar.13.2020	issued for design coordination #2	—
03.	Mar.16.2020	issued for addendum #2	—
04.	Mar.16.2020	issued for addendum #3	—
05.	Aug.24.2020	issued for addendum #4	—
06.	Sept. 28.2020	issued for permit	bg
07.	Oct.20.2020	issued for addendum #5	—
08.	Nov.23.2020	issued for addendum #6	—
09.	Dec.14.2020	issued for addendum #7	—
10.	Jan.18.2021	issued for addendum #8	—
11.	Mar. 2. 2021	issued for permit	bg
12.	Mar.09.2021	issued for addendum #9	—
13.	Mar.10.2021	issued for addendum #9R	—
14.	Mar.26.2021	issued for progress	—
15.	May 14. 2021	issued for Site Instruction #1	—
16.	June 15. 2021	issued for Site Instruction #2	—
17.	July. 7. 2021	re-issued for permit	bg
18.	July. 15. 2021	Issued for Site Instruction #3	bg
19.	July. 27. 2021	Issued for Site Instruction #4	bg
20.	Aug. 3. 2021	Issued for Site Instruction #5	bg
21.	Aug. 18. 2021	Issued for Site Instruction #6	bg
22.	Aug. 20. 2021	Re-issued for permit.	bg
23.	Sept. 07. 2021	Issued for Site Instruction #7	bg
24.	Sept. 09. 2021	Issued for Site Instruction #8	bg
25.	Sept. 16. 2021	Issued for Building D Permit Revisions	bg
26.	Sept. 22. 2021	Issued for Site Instruction #9	bg
27.	Oct. 6. 2021	Re-issued for permit.	bg
28.	Oct. 8. 2021	Issued for Site Instruction #10	bg
30.	Oct. 28. 2021	Issued for Site Instruction #11	bg
31.	Nov. 05. 2021	Issued for Site Instruction #12	bg
32.	Dec. 3. 2021	Issued for Site Instruction #13	bg
33.	Dec. 6. 2021	Issued for Site Instruction #14	bg
34.	Dec. 7. 2021	Issued for Site Instruction #15	bg

01.	Apr.19.2021	issued to client	bg

issued for revisions

GRAZIANI + CORAZZA ARCHITECTS
1320 SHERIDAN DRIVE, SUITE 100, MISSISSAUGA, ONTARIO, L4W 1C3
T 905.795.2601 F 905.795.2644 WWW.GC-ARCHITECTS.COM

RESIDENTIAL

ROYAL PINE

ATTMAR + PALLESCHI DRIVE

BRAMPTON ONTARIO

PROJECT ARCHITECT:	B.GRAZIANI
ASSISTANT DESIGNER:	R.LINCOLN
DRAWN BY:	G.C/F.C/M.B
CHECKED BY:	D.BIASE/G.COLANGELO
PLOT DATE:	DEC.13.2021
JOB #	1331.15

KEY PLAN

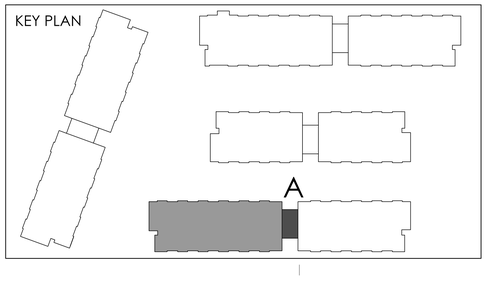

ROOF PLAN
BUILDING A (PARTIAL PLAN)

1:50

A-305a1

TITLEBLOCK SIZE: 915 x 1200

REF.A305d1 FOR CONTINUATION

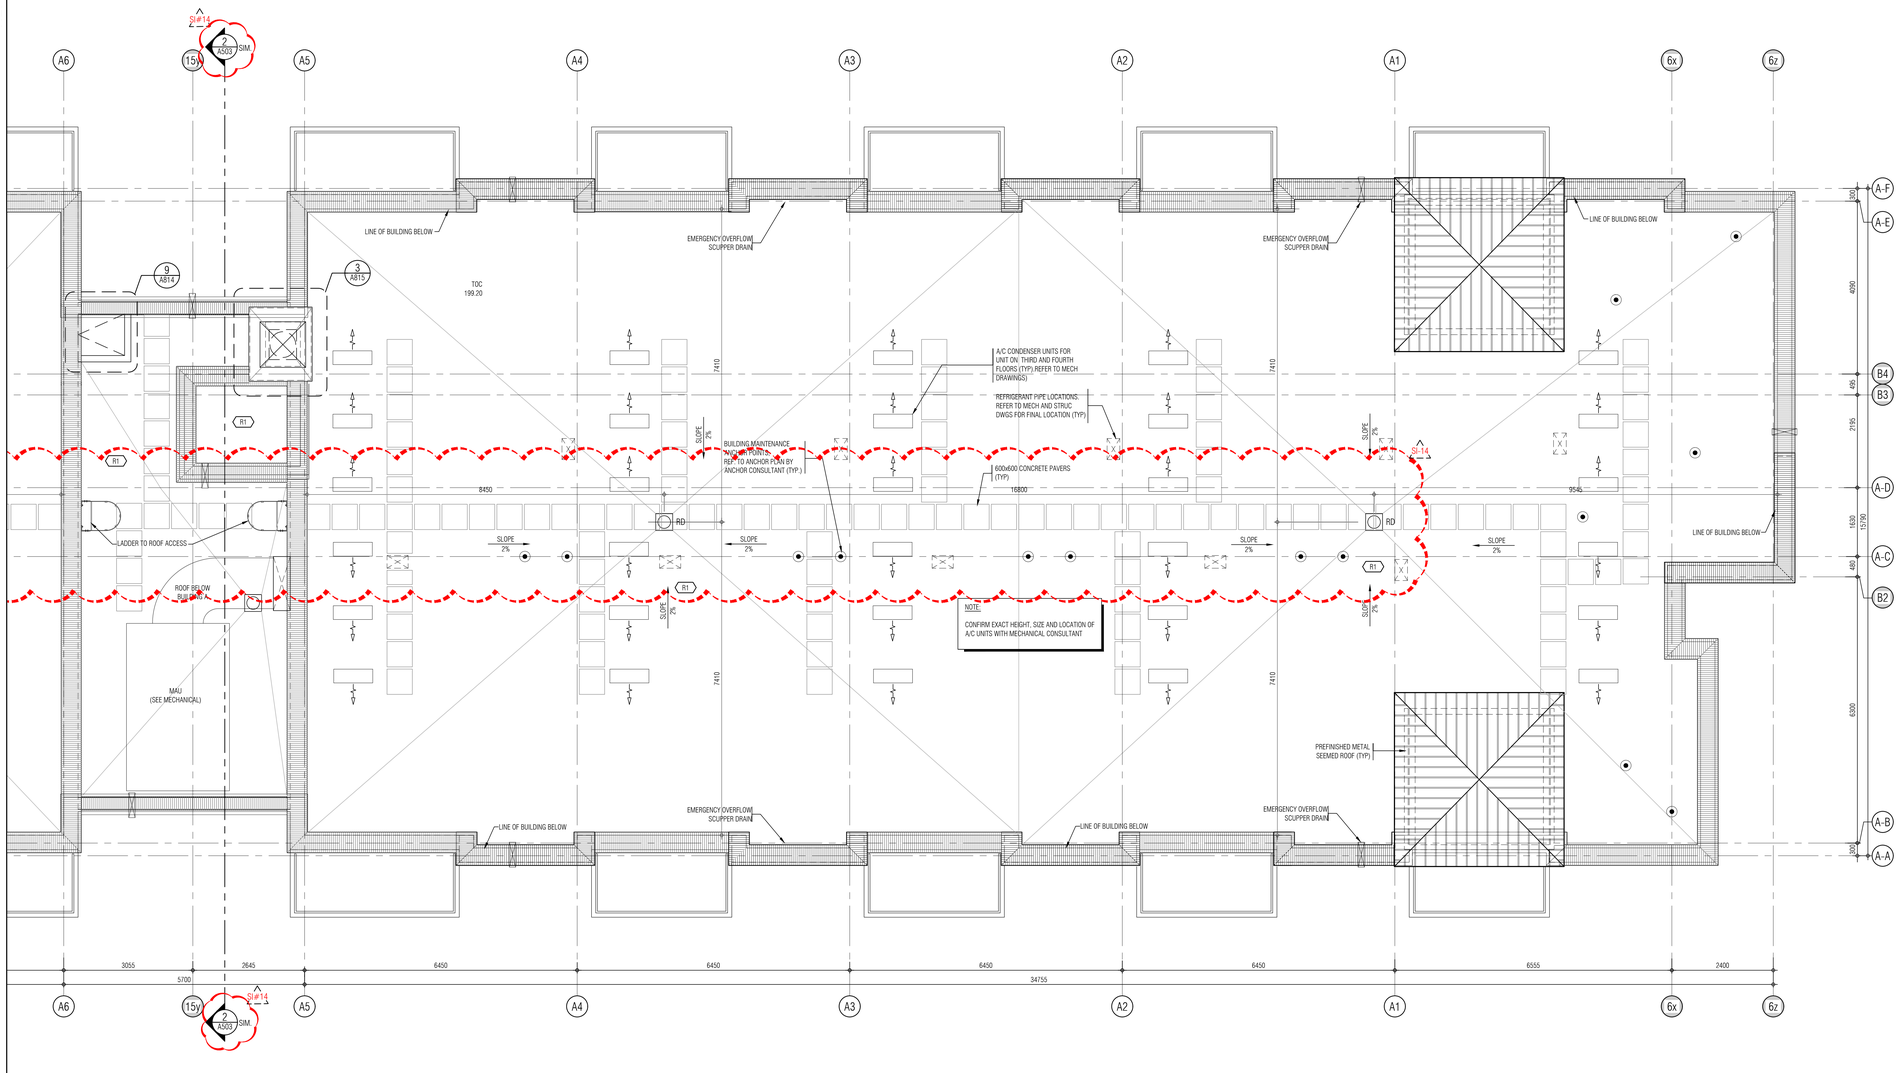

KEY PLAN

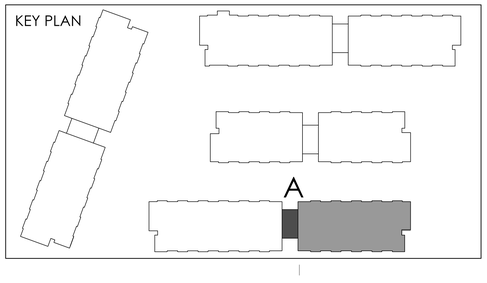

THIS DRAWING, AS AN INSTRUMENT OF SERVICE, IS PROVIDED BY AND IS THE PROPERTY OF GRAZIANI+CORAZZA ARCHITECTS INC. THE CONTRACTOR MUST VERIFY AND ACCEPT RESPONSIBILITY FOR ALL DIMENSIONS AND CONDITIONS ON SITE AND MUST NOTIFY GRAZIANI+CORAZZA ARCHITECTS INC. OF ANY VARIATIONS FROM THE SUPPLIED INFORMATION. GRAZIANI+CORAZZA ARCHITECTS INC. IS NOT RESPONSIBLE FOR THE ACCURACY OF SURVEY, STRUCTURAL, MECHANICAL, ELECTRICAL, AND OTHER ENGINEERING INFORMATION SHOWN ON THIS DRAWING. REFER TO THE APPROPRIATE ENGINEERING DRAWINGS BEFORE PROCEEDING WITH THE WORK. CONSTRUCTION MUST CONFORM TO ALL APPLICABLE CODES AND REQUIREMENTS OF THE AUTHORITIES HAVING JURISDICTION. UNLESS OTHERWISE NOTED, NO INVESTIGATION HAS BEEN UNDERTAKEN OR REPORTED ON BY THIS OFFICE IN REGARDS TO THE ENVIRONMENTAL CONDITION OF THIS SITE.

THIS DRAWING IS NOT TO BE SCALED. ALL ARCHITECTURAL SYMBOLS INDICATED ON THIS DRAWING ARE GRAPHIC REPRESENTATIONS ONLY.

CONDITIONS FOR ELECTRONIC INFORMATION TRANSFER:

ELECTRONIC INFORMATION IS SUPPLIED TO THE OTHER ASSOCIATED FIRMS TO ASSIST THEM IN THE EXECUTION OF THEIR WORK / REVIEW. THE RECIPIENT FIRMS MUST DETERMINE THE COMPLETENESS / APPROPRIATENESS / RELEVANCE OF THE INFORMATION IN RESPECT TO THEIR PARTICULAR RESPONSIBILITY.

GRAZIANI+CORAZZA ARCHITECTS INC. SHALL NOT BE RESPONSIBLE FOR:
1. ERRORS, OMISSIONS, INCOMPLETENESS DUE TO LOSS OF INFORMATION IN WHOLE OR PART WHEN INFORMATION IS TRANSFERRED.
2. TRANSMISSION OF ANY VIRUS OR DAMAGE TO THE RECEIVING ELECTRONIC SYSTEM WHEN INFORMATION IS TRANSFERRED.

01.	Oct.07.2019	issued for tender	___
02.	Mar.13.2020	issued for design coordination #2	___
03.	Mar.16.2020	issued for addendum #2	___
04.	Mar.16.2020	issued for addendum #3	___
05.	Aug.24.2020	issued for addendum #4	___
06.	Sept. 28.2020	issued for permit	bg
07.	Oct.20.2020	issued for addendum #5	___
08.	Nov.23.2020	issued for addendum #6	___
09.	Dec.14.2020	issued for addendum #7	___
10.	Jan.18.2021	issued for addendum #8	___
11.	Mar. 2. 2021	issued for permit	bg
12.	Mar.09.2021	issued for addendum #9	___
13.	Mar.10.2021	issued for addendum #9R	___
14.	Mar.26.2021	issued for progress	___
15.	May 14. 2021	issued for Site Instruction #1	___
16.	June 15. 2021	issued for Site Instruction #2	___
17.	July. 7. 2021	re-issued for permit	bg
18.	July. 15. 2021	Issued for Site Instruction #3	bg
19.	July. 27. 2021	Issued for Site Instruction #4	bg
20.	Aug. 3. 2021	Issued for Site Instruction #5	bg
21.	Aug. 18. 2021	Issued for Site Instruction #6	bg
22.	Aug. 20. 2021	Re-issued for permit.	bg
23.	Sept. 07. 2021	Issued for Site Instruction #7	bg
24.	Sept. 09. 2021	Issued for Site Instruction #8	bg
25.	Sept. 16. 2021	Issued for Building D Permit Revisions	bg
26.	Sept. 22. 2021	Issued for Site Instruction #9	bg
27.	Oct. 6. 2021	Re-issued for permit.	bg
28.	Oct. 8. 2021	Issued for Site Instruction #10	bg
30.	Oct. 28. 2021	Issued for Site Instruction #11	bg
31.	Nov. 05. 2021	Issued for Site Instruction #12	bg
32.	Dec. 3. 2021	Issued for Site Instruction #13	bg
33.	Dec. 6. 2021	Issued for Site Instruction #14	bg
34.	Dec. 7. 2021	Issued for Site Instruction #15	bg

01.	Apr.19.2021	issued to client	bg

issued for revisions

GRAZIANI + CORAZZA ARCHITECTS
1320 SHARON DRIVE SUITE 100 MISSISSAUGA ONTARIO L4W 1C3
T.905.799.2601 F.905.799.2644 WWW.GC-ARCHITECTS.COM

RESIDENTIAL

ATTMAR + PALLESCHI DRIVE

BRAMPTON ONTARIO

PROJECT ARCHITECT:	B.GRAZIANI
ASSISTANT DESIGNER:	R.LINCOLN
DRAWN BY:	G.C/F.C/M.B
CHECKED BY:	D.BIASE/G.COLANGELO
PLOT DATE:	DEC.13.2021
JOB #	1331.15

ROOF PLAN
BUILDING A (PARTIAL PLAN)

1:50

A-305a2

TITLEBLOCK SIZE: 915 x 1200

THIS DRAWING, AS AN INSTRUMENT OF SERVICE, IS PROVIDED BY AND IS THE PROPERTY OF GRAZIANI+CORAZZA ARCHITECTS INC. THE CONTRACTOR MUST VERIFY AND ACCEPT RESPONSIBILITY FOR ALL DIMENSIONS AND CONDITIONS ON SITE AND MUST NOTIFY GRAZIANI+CORAZZA ARCHITECTS INC. OF ANY VARIATIONS FROM THE SUPPLIED INFORMATION. GRAZIANI+CORAZZA ARCHITECTS INC. IS NOT RESPONSIBLE FOR THE ACCURACY OF SURVEY, STRUCTURAL, MECHANICAL, ELECTRICAL, AND OTHER ENGINEERING INFORMATION SHOWN ON THIS DRAWING. REFER TO THE APPROPRIATE ENGINEERING DRAWINGS BEFORE PROCEEDING WITH THE WORK. CONSTRUCTION MUST CONFORM TO ALL APPLICABLE CODES AND REQUIREMENTS OF THE AUTHORITIES HAVING JURISDICTION. UNLESS OTHERWISE NOTED, NO INVESTIGATION HAS BEEN UNDERTAKEN OR REPORTED ON BY THIS OFFICE IN REGARDS TO THE ENVIRONMENTAL CONDITION OF THIS SITE.

THIS DRAWING IS NOT TO BE SCALED. ALL ARCHITECTURAL SYMBOLS INDICATED ON THIS DRAWING ARE GRAPHIC REPRESENTATIONS ONLY.

CONDITIONS FOR ELECTRONIC INFORMATION TRANSFER:

ELECTRONIC INFORMATION IS SUPPLIED TO THE OTHER ASSOCIATED FIRMS TO ASSIST THEM IN THE EXECUTION OF THEIR WORK / REVIEW. THE RECIPIENT FIRMS MUST DETERMINE THE COMPLETENESS / APPROPRIATENESS / RELEVANCE OF THE INFORMATION IN RESPECT TO THEIR PARTICULAR RESPONSIBILITY.

GRAZIANI+CORAZZA ARCHITECTS INC. SHALL NOT BE RESPONSIBLE FOR:
1. ERRORS, OMISSIONS, INCOMPLETENESS DUE TO LOSS OF INFORMATION IN WHOLE OR PART WHEN INFORMATION IS TRANSFERRED.
2. TRANSMISSION OF ANY VIRUS OR DAMAGE TO THE RECEIVING ELECTRONIC SYSTEM WHEN INFORMATION IS TRANSFERRED.

REF. A305c2 FOR CONTINUATION

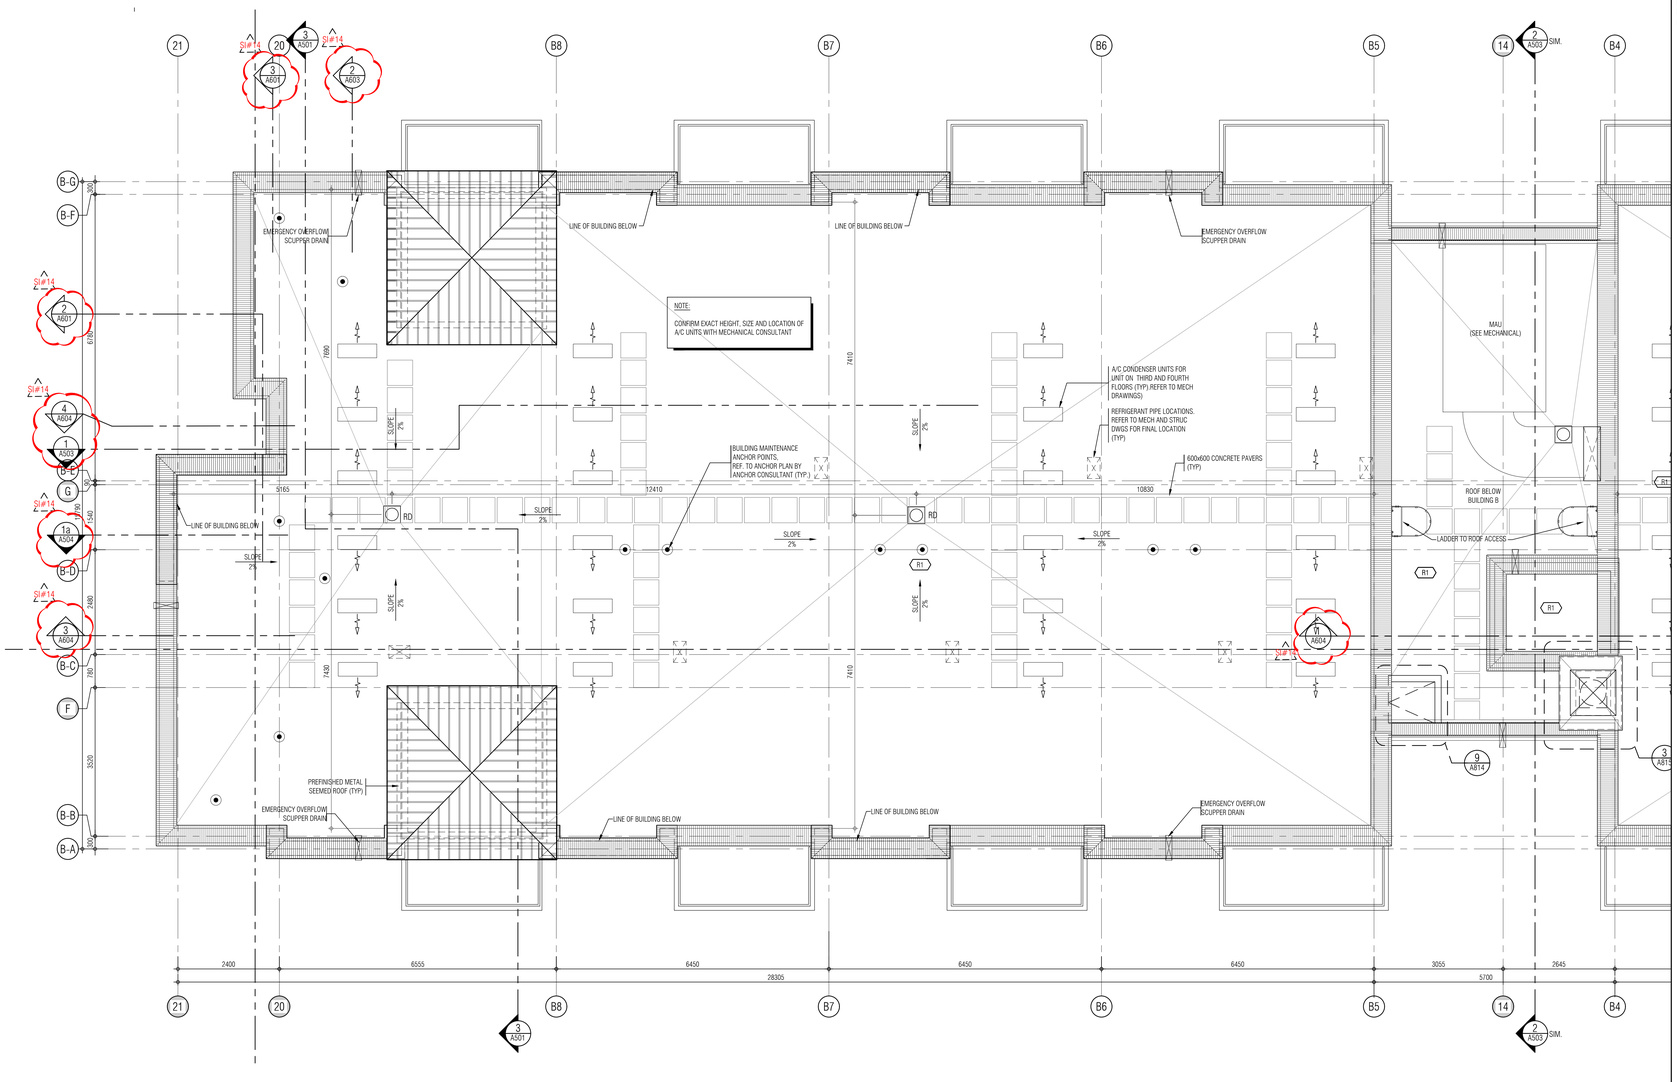

KEY PLAN

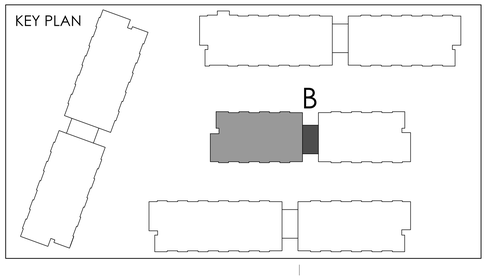

01.	Oct.07.2019	issued for tender
02.	Mar.13.2020	issued for design coordination #2
03.	Mar.16.2020	issued for addendum #2
04.	Mar.16.2020	issued for addendum #3
05.	Aug.24.2020	issued for addendum #4
06.	Sept. 28.2020	issued for permit
07.	Oct.20.2020	issued for addendum #5
08.	Nov.23.2020	issued for addendum #6
09.	Dec.14.2020	issued for addendum #7
10.	Jan.18.2021	issued for addendum #8
11.	Mar. 2. 2021	issued for permit
12.	Mar.09.2021	issued for addendum #9
13.	Mar.10.2021	issued for addendum #9R
14.	Mar.26.2021	issued for progress
15.	May 14. 2021	issued for Site Instruction #1
16.	June 15. 2021	issued for Site Instruction #2
17.	July. 7. 2021	re-issued for permit
18.	July. 15. 2021	Issued for Site Instruction #3
19.	July. 27. 2021	Issued for Site Instruction #4
20.	Aug. 3. 2021	Issued for Site Instruction #5
21.	Aug. 18. 2021	Issued for Site Instruction #6
22.	Aug. 20. 2021	Re-issued for permit.
23.	Sept. 07. 2021	Issued for Site Instruction #7
24.	Sept. 09. 2021	Issued for Site Instruction #8
25.	Sept. 16. 2021	Issued for Building D Permit Revisions
26.	Sept. 22. 2021	Issued for Site Instruction #9
27.	Oct. 6. 2021	Re-issued for permit.
28.	Oct. 8. 2021	Issued for Site Instruction #10
30.	Oct. 28. 2021	Issued for Site Instruction #11
31.	Nov. 05. 2021	Issued for Site Instruction #12
32.	Dec. 3. 2021	Issued for Site Instruction #13
33.	Dec. 6. 2021	Issued for Site Instruction #14
34.	Dec. 7. 2021	Issued for Site Instruction #15

01.	Apr.19.2021	issued to client

issued for revisions

GRAZIANI + CORAZZA ARCHITECTS
1320 SHERIDON DRIVE SUITE 100 MISSISSAUGA ONTARIO L4W 1C3
T.905.795.2601 F.905.795.2644 WWW.GC-ARCHITECTS.COM

RESIDENTIAL

ATTMAR + PALLESCHI DRIVE

BRAMPTON ONTARIO

PROJECT ARCHITECT:	B.GRAZIANI
ASSISTANT DESIGNER:	R.LINCOLN
DRAWN BY:	G.C/F.C/M.B
CHECKED BY:	D.BIASE/G.COLANGELO
PLOT DATE:	DEC.13.2021
JOB #	1331.15

ROOF PLAN
BUILDING B (PARTIAL PLAN)

1:50

A-305b1

TITLEBLOCK SIZE: 915 x 1200

THIS DRAWING, AS AN INSTRUMENT OF SERVICE, IS PROVIDED BY AND IS THE PROPERTY OF GRAZIANI+CORAZZA ARCHITECTS INC. THE CONTRACTOR MUST VERIFY AND ACCEPT RESPONSIBILITY FOR ALL DIMENSIONS AND CONDITIONS ON SITE AND MUST NOTIFY GRAZIANI+CORAZZA ARCHITECTS INC. OF ANY VARIATIONS FROM THE SUPPLIED INFORMATION. GRAZIANI+CORAZZA ARCHITECTS INC. IS NOT RESPONSIBLE FOR THE ACCURACY OF SURVEY, STRUCTURAL, MECHANICAL, ELECTRICAL, AND OTHER ENGINEERING INFORMATION SHOWN ON THIS DRAWING. REFER TO THE APPROPRIATE ENGINEERING DRAWINGS BEFORE PROCEEDING WITH THE WORK. CONSTRUCTION MUST CONFORM TO ALL APPLICABLE CODES AND REQUIREMENTS OF THE AUTHORITIES HAVING JURISDICTION. UNLESS OTHERWISE NOTED, NO INVESTIGATION HAS BEEN UNDERTAKEN OR REPORTED ON BY THIS OFFICE IN REGARDS TO THE ENVIRONMENTAL CONDITION OF THIS SITE.

THIS DRAWING IS NOT TO BE SCALED. ALL ARCHITECTURAL SYMBOLS INDICATED ON THIS DRAWING ARE GRAPHIC REPRESENTATIONS ONLY.

CONDITIONS FOR ELECTRONIC INFORMATION TRANSFER:

ELECTRONIC INFORMATION IS SUPPLIED TO THE OTHER ASSOCIATED FIRMS TO ASSIST THEM IN THE EXECUTION OF THEIR WORK / REVIEW. THE RECIPIENT FIRMS MUST DETERMINE THE COMPLETENESS / APPROPRIATENESS / RELEVANCE OF THE INFORMATION IN RESPECT TO THEIR PARTICULAR RESPONSIBILITY.

GRAZIANI+CORAZZA ARCHITECTS INC. SHALL NOT BE RESPONSIBLE FOR:
1. ERRORS, OMISSIONS, INCOMPLETENESS DUE TO LOSS OF INFORMATION IN WHOLE OR PART WHEN INFORMATION IS TRANSFERRED.
2. TRANSMISSION OF ANY VIRUS OR DAMAGE TO THE RECEIVING ELECTRONIC SYSTEM WHEN INFORMATION IS TRANSFERRED.

REF. A305c1 FOR CONTINUATION

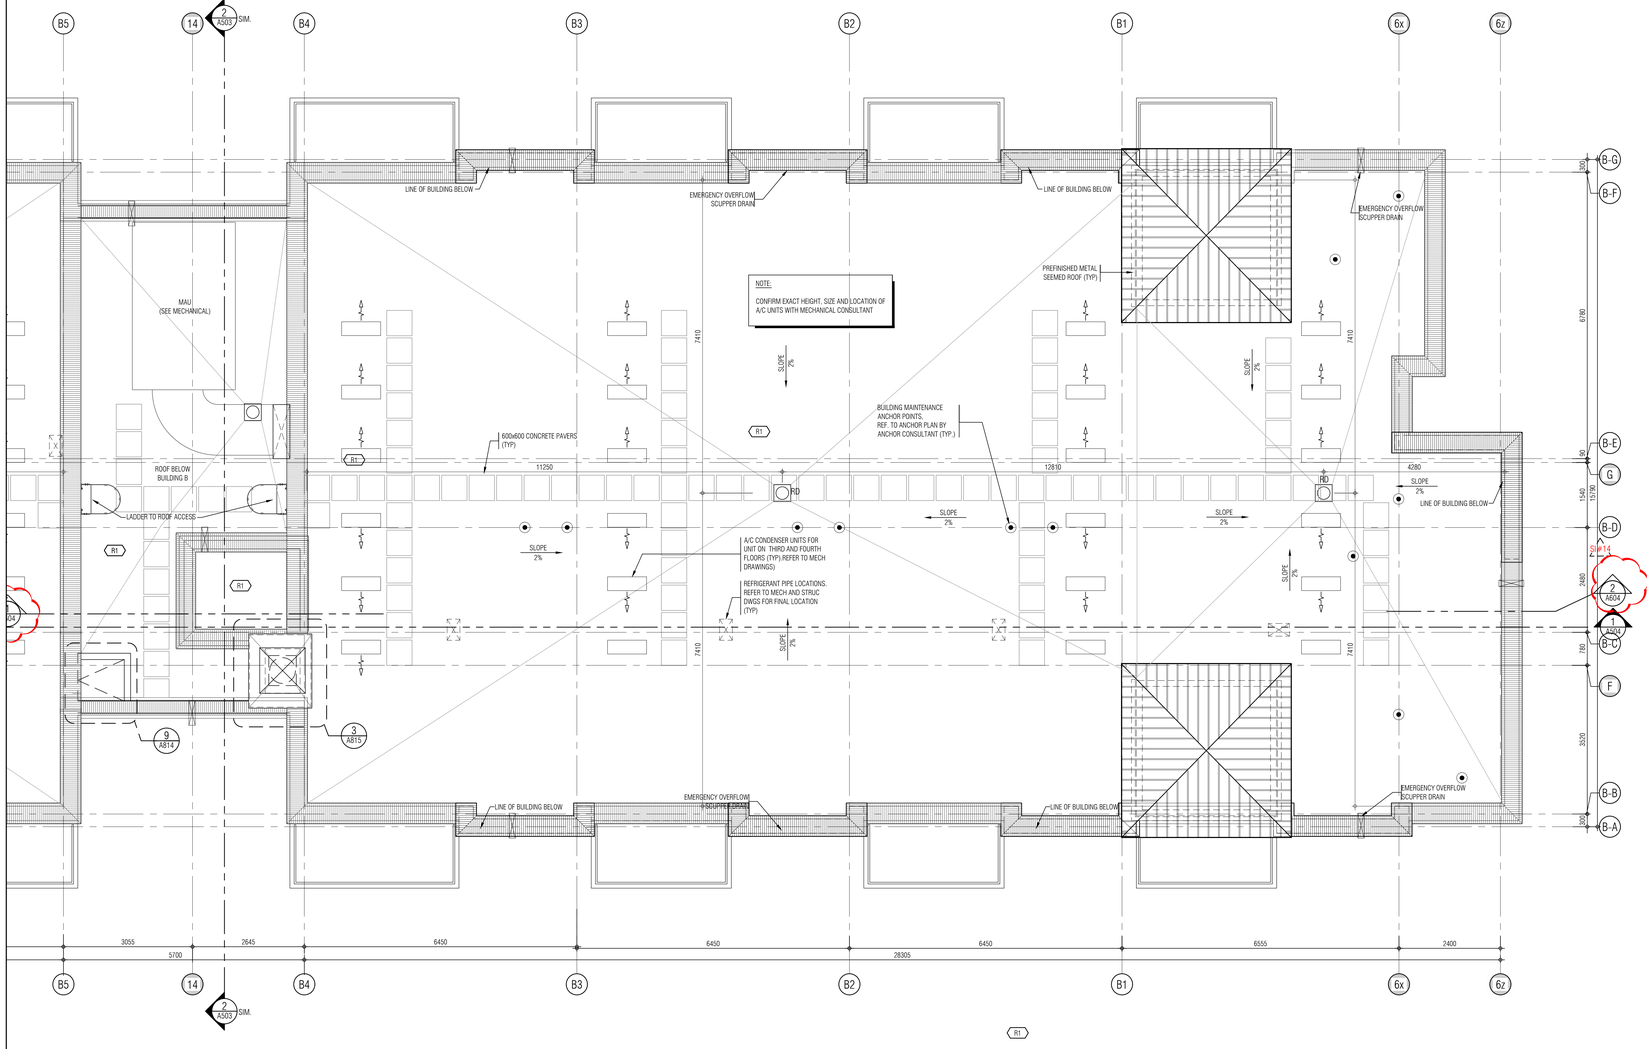

KEY PLAN

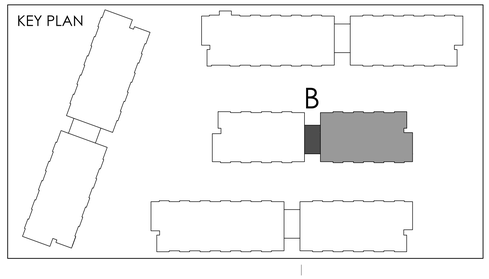

01.	Oct.07.2019	issued for tender
02.	Mar.13.2020	issued for design coordination #2
03.	Mar.16.2020	issued for addendum #2
04.	Mar.16.2020	issued for addendum #3
05.	Aug.24.2020	issued for addendum #4
06.	Sept. 28.2020	issued for permit
07.	Oct.20.2020	issued for addendum #5
08.	Nov.23.2020	issued for addendum #6
09.	Dec.14.2020	issued for addendum #7
10.	Jan.18.2021	issued for addendum #8
11.	Mar. 2. 2021	issued for permit
12.	Mar.09.2021	issued for addendum #9
13.	Mar.10.2021	issued for addendum #9R
14.	Mar.26.2021	issued for progress
15.	May 14. 2021	issued for Site Instruction #1
16.	June 15. 2021	issued for Site Instruction #2
17.	July. 7. 2021	re-issued for permit
18.	July. 15. 2021	Issued for Site Instruction #3
19.	July. 27. 2021	Issued for Site Instruction #4
20.	Aug. 3. 2021	Issued for Site Instruction #5
21.	Aug. 18. 2021	Issued for Site Instruction #6
22.	Aug. 20. 2021	Re-issued for permit.
23.	Sept. 07. 2021	Issued for Site Instruction #7
24.	Sept. 09. 2021	Issued for Site Instruction #8
25.	Sept. 16. 2021	Issued for Building D Permit Revisions
26.	Sept. 22. 2021	Issued for Site Instruction #9
27.	Oct. 6. 2021	Re-issued for permit.
28.	Oct. 8. 2021	Issued for Site Instruction #10
30.	Oct. 28. 2021	Issued for Site Instruction #11
31.	Nov. 05. 2021	Issued for Site Instruction #12
32.	Dec. 3. 2021	Issued for Site Instruction #13
33.	Dec. 6. 2021	Issued for Site Instruction #14
34.	Dec. 7. 2021	Issued for Site Instruction #15

01.	Apr.19.2021	issued to client

issued for revisions

GRAZIANI + CORAZZA ARCHITECTS
1320 SHERIDEN DRIVE SUITE 100 MISSISSAUGA ONTARIO L4W 1C3
T.905.795.2601 F.905.795.2644 WWW.GC-ARCHITECTS.COM

RESIDENTIAL

ATTMAR + PALLESCHI DRIVE

BRAMPTON ONTARIO

PROJECT ARCHITECT:	B.GRAZIANI
ASSISTANT DESIGNER:	R.LINCOLN
DRAWN BY:	G.C/F.C/M.B
CHECKED BY:	D.BIASE/G.COLANGELO
PLOT DATE:	DEC.13.2021
JOB #	1331.15

ROOF PLAN
BUILDING B (PARTIAL PLAN)

1:50

A-305b2

TITLEBLOCK SIZE: 915 x 1200

THIS DRAWING, AS AN INSTRUMENT OF SERVICE, IS PROVIDED BY AND IS THE PROPERTY OF GRAZIANI+CORAZZA ARCHITECTS INC. THE CONTRACTOR MUST VERIFY AND ACCEPT RESPONSIBILITY FOR ALL DIMENSIONS AND CONDITIONS ON SITE AND MUST NOTIFY GRAZIANI+CORAZZA ARCHITECTS INC. OF ANY VARIATIONS FROM THE SUPPLIED INFORMATION. GRAZIANI+CORAZZA ARCHITECTS INC. IS NOT RESPONSIBLE FOR THE ACCURACY OF SURVEY, STRUCTURAL, MECHANICAL, ELECTRICAL, AND OTHER ENGINEERING INFORMATION SHOWN ON THIS DRAWING. REFER TO THE APPROPRIATE ENGINEERING DRAWINGS BEFORE PROCEEDING WITH THE WORK. CONSTRUCTION MUST CONFORM TO ALL APPLICABLE CODES AND REQUIREMENTS OF THE AUTHORITIES HAVING JURISDICTION. UNLESS OTHERWISE NOTED, NO INVESTIGATION HAS BEEN UNDERTAKEN OR REPORTED ON BY THIS OFFICE IN REGARDS TO THE ENVIRONMENTAL CONDITION OF THIS SITE.

THIS DRAWING IS NOT TO BE SCALED. ALL ARCHITECTURAL SYMBOLS INDICATED ON THIS DRAWING ARE GRAPHIC REPRESENTATIONS ONLY.

CONDITIONS FOR ELECTRONIC INFORMATION TRANSFER:

ELECTRONIC INFORMATION IS SUPPLIED TO THE OTHER ASSOCIATED FIRMS TO ASSIST THEM IN THE EXECUTION OF THEIR WORK / REVIEW. THE RECIPIENT FIRMS MUST DETERMINE THE COMPLETENESS / APPROPRIATENESS / RELEVANCE OF THE INFORMATION IN RESPECT TO THEIR PARTICULAR RESPONSIBILITY.

GRAZIANI + CORAZZA ARCHITECTS INC. SHALL NOT BE RESPONSIBLE FOR:
1. ERRORS, OMISSIONS, INCOMPLETENESS DUE TO LOSS OF INFORMATION IN WHOLE OR PART WHEN INFORMATION IS TRANSFERRED.
2. TRANSMISSION OF ANY VIRUS OR DAMAGE TO THE RECEIVING ELECTRONIC SYSTEM WHEN INFORMATION IS TRANSFERRED.

REF. A305b2 FOR CONTINUATION

01.	Oct.07.2019	issued for tender	—
02.	Mar.13.2020	issued for design coordination #2	—
03.	Mar.16.2020	issued for addendum #2	—
04.	Mar.16.2020	issued for addendum #3	—
05.	Aug.24.2020	issued for addendum #4	—
06.	Sept. 28.2020	issued for permit	bg
07.	Oct.20.2020	issued for addendum #5	—
08.	Nov.23.2020	issued for addendum #6	—
09.	Dec.14.2020	issued for addendum #7	—
10.	Jan.18.2021	issued for addendum #8	—
11.	Mar. 2. 2021	issued for permit	bg
12.	Mar.09.2021	issued for addendum #9	—
13.	Mar.10.2021	issued for addendum #9R	—
14.	Mar.26.2021	issued for progress	—
15.	May 14. 2021	issued for Site Instruction #1	—
16.	June 15. 2021	issued for Site Instruction #2	—
17.	July. 7. 2021	re-issued for permit	bg
18.	July. 15. 2021	Issued for Site Instruction #3	bg
19.	July. 27. 2021	Issued for Site Instruction #4	bg
20.	Aug. 3. 2021	Issued for Site Instruction #5	bg
21.	Aug. 18. 2021	Issued for Site Instruction #6	bg
22.	Aug. 20. 2021	Re-issued for permit.	bg
23.	Sept. 07. 2021	Issued for Site Instruction #7	bg
24.	Sept. 09. 2021	Issued for Site Instruction #8	bg
25.	Sept. 16. 2021	Issued for Building D Permit Revisions	bg
26.	Sept. 22. 2021	Issued for Site Instruction #9	bg
27.	Oct. 6. 2021	Re-issued for permit.	bg
28.	Oct. 8. 2021	Issued for Site Instruction #10	bg
30.	Oct. 28. 2021	Issued for Site Instruction #11	bg
31.	Nov. 05. 2021	Issued for Site Instruction #12	bg
32.	Dec. 3. 2021	Issued for Site Instruction #13	bg
33.	Dec. 6. 2021	Issued for Site Instruction #14	bg
34.	Dec. 7. 2021	Issued for Site Instruction #15	bg

01.	Apr.19.2021	issued to client	bg

issued for revisions

GRAZIANI + CORAZZA ARCHITECTS
1320 DAWSON DRIVE, SUITE 100, MISSISSAUGA, ONTARIO, L4W 1C3
T.905.795.2501 F.905.795.2644 WWW.GC-ARCHITECTS.COM

RESIDENTIAL

ATTMAR + PALLESCHI DRIVE

BRAMPTON ONTARIO

PROJECT ARCHITECT:	B.GRAZIANI
ASSISTANT DESIGNER:	R.LINCOLN
DRAWN BY:	G.C/F.C/M.B
CHECKED BY:	D.BIASE/G.COLANGELO
PLOT DATE:	DEC.13.2021
JOB #	1331.15

ROOF PLAN
BUILDING C (PARTIAL PLAN)

1:50

A-305c1

TITLEBLOCK SIZE: 915 x 1200

KEY PLAN

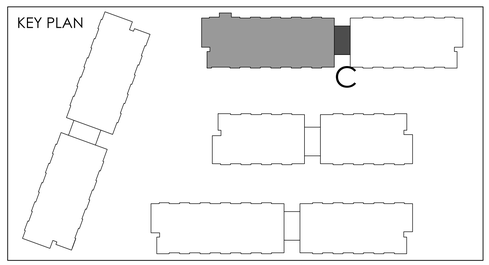

REF. A305b1 FOR CONTINUATION

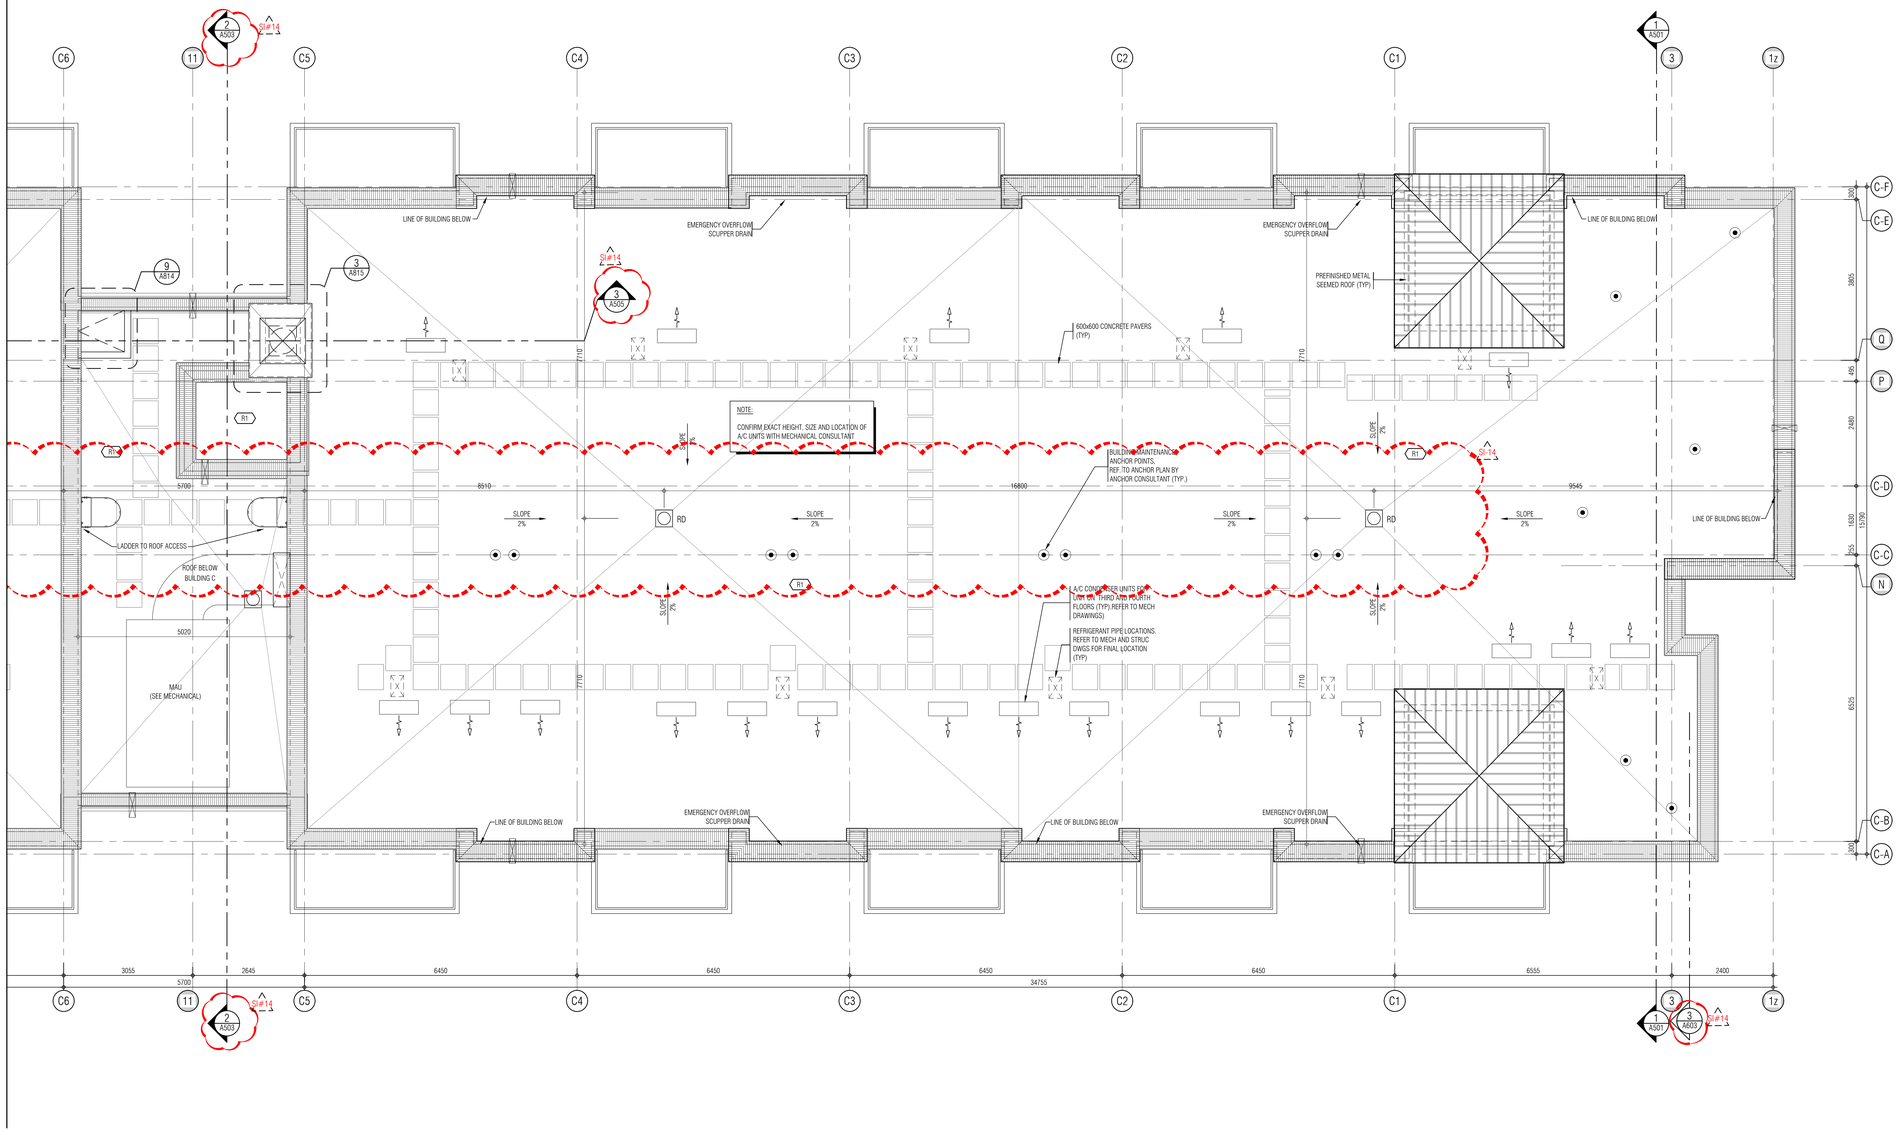

THIS DRAWING, AS AN INSTRUMENT OF SERVICE, IS PROVIDED BY AND IS THE PROPERTY OF GRAZIANI+CORAZZA ARCHITECTS INC. THE CONTRACTOR MUST VERIFY AND ACCEPT RESPONSIBILITY FOR ALL DIMENSIONS AND CONDITIONS ON SITE AND MUST NOTIFY GRAZIANI+CORAZZA ARCHITECTS INC. OF ANY VARIATIONS FROM THE SUPPLIED INFORMATION. GRAZIANI+CORAZZA ARCHITECTS INC. IS NOT RESPONSIBLE FOR THE ACCURACY OF SURVEY, STRUCTURAL, MECHANICAL, ELECTRICAL, AND OTHER ENGINEERING INFORMATION SHOWN ON THIS DRAWING. REFER TO THE APPROPRIATE ENGINEERING DRAWINGS BEFORE PROCEEDING WITH THE WORK. CONSTRUCTION MUST CONFORM TO ALL APPLICABLE CODES AND REQUIREMENTS OF THE AUTHORITIES HAVING JURISDICTION. UNLESS OTHERWISE NOTED, NO INVESTIGATION HAS BEEN UNDERTAKEN OR REPORTED ON BY THIS OFFICE IN REGARDS TO THE ENVIRONMENTAL CONDITION OF THIS SITE.

THIS DRAWING IS NOT TO BE SCALED. ALL ARCHITECTURAL SYMBOLS INDICATED ON THIS DRAWING ARE GRAPHIC REPRESENTATIONS ONLY.

CONDITIONS FOR ELECTRONIC INFORMATION TRANSFER:

ELECTRONIC INFORMATION IS SUPPLIED TO THE OTHER ASSOCIATED FIRMS TO ASSIST THEM IN THE EXECUTION OF THEIR WORK / REVIEW. THE RECIPIENT FIRMS MUST DETERMINE THE COMPLETENESS / APPROPRIATENESS / RELEVANCE OF THE INFORMATION IN RESPECT TO THEIR PARTICULAR RESPONSIBILITY.

GRAZIANI+CORAZZA ARCHITECTS INC. SHALL NOT BE RESPONSIBLE FOR:
1. ERRORS, OMISSIONS, INCOMPLETENESS DUE TO LOSS OF INFORMATION IN WHOLE OR PART WHEN INFORMATION IS TRANSFERRED.
2. TRANSMISSION OF ANY VIRUS OR DAMAGE TO THE RECEIVING ELECTRONIC SYSTEM WHEN INFORMATION IS TRANSFERRED.

01.	Oct.07.2019	issued for tender	__
02.	Mar.13.2020	issued for design coordination #2	__
03.	Mar.16.2020	issued for addendum #2	__
04.	Mar.16.2020	issued for addendum #3	__
05.	Aug.24.2020	issued for addendum #4	__
06.	Sept. 28.2020	issued for permit	bg
07.	Oct.20.2020	issued for addendum #5	__
08.	Nov.23.2020	issued for addendum #6	__
09.	Dec.14.2020	issued for addendum #7	__
10.	Jan.18.2021	issued for addendum #8	__
11.	Mar. 2. 2021	issued for permit	bg
12.	Mar.09.2021	issued for addendum #9	__
13.	Mar.10.2021	issued for addendum #9R	__
14.	Mar.26.2021	issued for progress	__
15.	May 14. 2021	issued for Site Instruction #1	__
16.	June 15. 2021	issued for Site Instruction #2	__
17.	July. 7. 2021	re-issued for permit	bg
18.	July. 15. 2021	Issued for Site Instruction #3	bg
19.	July. 27. 2021	Issued for Site Instruction #4	bg
20.	Aug. 3. 2021	Issued for Site Instruction #5	bg
21.	Aug. 18. 2021	Issued for Site Instruction #6	bg
22.	Aug. 20. 2021	Re-issued for permit.	bg
23.	Sept. 07. 2021	Issued for Site Instruction #7	bg
24.	Sept. 09. 2021	Issued for Site Instruction #8	bg
25.	Sept. 16. 2021	Issued for Building D Permit Revisions	bg
26.	Sept. 22. 2021	Issued for Site Instruction #9	bg
27.	Oct. 6. 2021	Re-issued for permit.	bg
28.	Oct. 8. 2021	Issued for Site Instruction #10	bg
30.	Oct. 28. 2021	Issued for Site Instruction #11	bg
31.	Nov. 05. 2021	Issued for Site Instruction #12	bg
32.	Dec. 3. 2021	Issued for Site Instruction #13	bg
33.	Dec. 6. 2021	Issued for Site Instruction #14	bg
34.	Dec. 7. 2021	Issued for Site Instruction #15	bg

01.	Apr.19.2021	issued to client	bg

issued for revisions

GRAZIANI + CORAZZA ARCHITECTS
1320 SHARON DRIVE SUITE 100 MISSISSAUGA ONTARIO L4W 1C3
T.905.799.2601 F.905.799.2644 WWW.GC-ARCHITECTS.COM

RESIDENTIAL

ATTMAR + PALLESCHI DRIVE

BRAMPTON ONTARIO

PROJECT ARCHITECT:	B.GRAZIANI
ASSISTANT DESIGNER:	R.LINCOLN
DRAWN BY:	G.C/F.C/M.B
CHECKED BY:	D.BIASE/G.COLANGELO
PLOT DATE:	DEC.13.2021
JOB #	1331.15

KEY PLAN

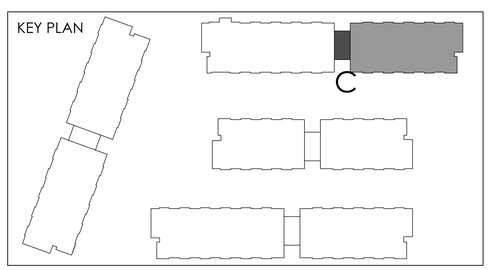

ROOF PLAN
BUILDING C (PARTIAL PLAN)

1:50

A-305c2

TITLEBLOCK SIZE: 915 x 1200

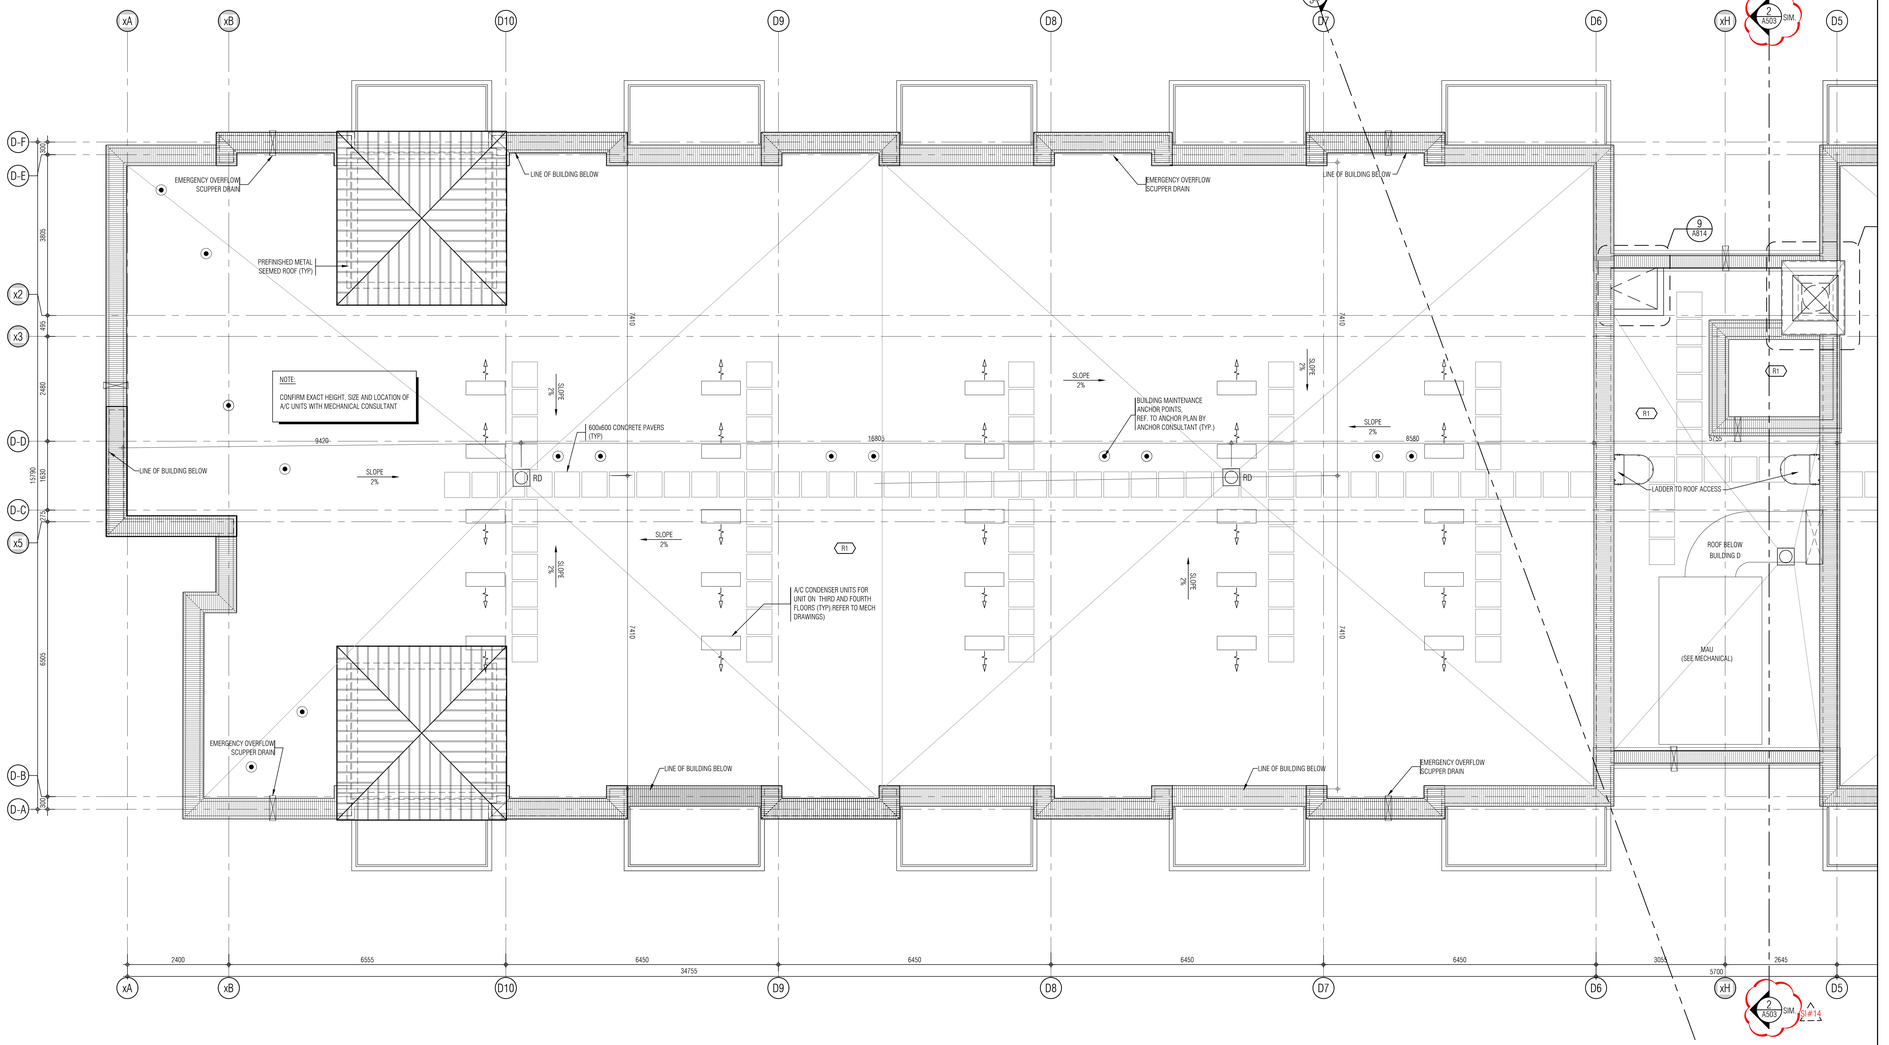

REF. A305a2 FOR CONTINUATION

THIS DRAWING, AS AN INSTRUMENT OF SERVICE, IS PROVIDED BY AND IS THE PROPERTY OF GRAZIANI+CORAZZA ARCHITECTS INC. THE CONTRACTOR MUST VERIFY AND ACCEPT RESPONSIBILITY FOR ALL DIMENSIONS AND CONDITIONS ON SITE AND MUST NOTIFY GRAZIANI+CORAZZA ARCHITECTS INC. OF ANY VARIATIONS FROM THE SUPPLIED INFORMATION. GRAZIANI+CORAZZA ARCHITECTS INC. IS NOT RESPONSIBLE FOR THE ACCURACY OF SURVEY, STRUCTURAL, MECHANICAL, ELECTRICAL, AND OTHER ENGINEERING INFORMATION SHOWN ON THIS DRAWING. REFER TO THE APPROPRIATE ENGINEERING DRAWINGS BEFORE PROCEEDING WITH THE WORK. CONSTRUCTION MUST CONFORM TO ALL APPLICABLE CODES AND REQUIREMENTS OF THE AUTHORITIES HAVING JURISDICTION. UNLESS OTHERWISE NOTED, NO INVESTIGATION HAS BEEN UNDERTAKEN OR REPORTED ON BY THIS OFFICE IN REGARDS TO THE ENVIRONMENTAL CONDITION OF THIS SITE.

THIS DRAWING IS NOT TO BE SCALED. ALL ARCHITECTURAL SYMBOLS INDICATED ON THIS DRAWING ARE GRAPHIC REPRESENTATIONS ONLY.

CONDITIONS FOR ELECTRONIC INFORMATION TRANSFER:

ELECTRONIC INFORMATION IS SUPPLIED TO THE OTHER ASSOCIATED FIRMS TO ASSIST THEM IN THE EXECUTION OF THEIR WORK / REVIEW. THE RECIPIENT FIRMS MUST DETERMINE THE COMPLETENESS / APPROPRIATENESS / RELEVANCE OF THE INFORMATION IN RESPECT TO THEIR PARTICULAR RESPONSIBILITY.

GRAZIANI+CORAZZA ARCHITECTS INC. SHALL NOT BE RESPONSIBLE FOR:
1. ERRORS, OMISSIONS, INCOMPLETENESS DUE TO LOSS OF INFORMATION IN WHOLE OR PART WHEN INFORMATION IS TRANSFERRED.
2. TRANSMISSION OF ANY VIRUS OR DAMAGE TO THE RECEIVING ELECTRONIC SYSTEM WHEN INFORMATION IS TRANSFERRED.

01.	Oct.07.2019	issued for tender	___
02.	Mar.13.2020	issued for design coordination #2	___
03.	Mar.16.2020	issued for addendum #2	___
04.	Mar.16.2020	issued for addendum #3	___
05.	Aug.24.2020	issued for addendum #4	___
06.	Sept. 28.2020	issued for permit	bg
07.	Oct.20.2020	issued for addendum #5	___
08.	Nov.23.2020	issued for addendum #6	___
09.	Dec.14.2020	issued for addendum #7	___
10.	Jan.18.2021	issued for addendum #8	___
11.	Mar. 2. 2021	issued for permit	bg
12.	Mar.09.2021	issued for addendum #9	___
13.	Mar.10.2021	issued for addendum #9R	___
14.	Mar.26.2021	issued for progress	___
15.	May 14. 2021	issued for Site Instruction #1	___
16.	June 15. 2021	issued for Site Instruction #2	___
17.	July. 7. 2021	re-issued for permit	bg
18.	July. 15. 2021	Issued for Site Instruction #3	bg
19.	July. 27. 2021	Issued for Site Instruction #4	bg
20.	Aug. 3. 2021	Issued for Site Instruction #5	bg
21.	Aug. 18. 2021	Issued for Site Instruction #6	bg
22.	Aug. 20. 2021	Re-issued for permit.	bg
23.	Sept. 07. 2021	Issued for Site Instruction #7	bg
24.	Sept. 09. 2021	Issued for Site Instruction #8	bg
25.	Sept. 16. 2021	Issued for Building D Permit Revisions	bg
26.	Sept. 22. 2021	Issued for Site Instruction #9	bg
27.	Oct. 6. 2021	Re-issued for permit.	bg
28.	Oct. 8. 2021	Issued for Site Instruction #10	bg
30.	Oct. 28. 2021	Issued for Site Instruction #11	bg
31.	Nov. 05. 2021	Issued for Site Instruction #12	bg
32.	Dec. 3. 2021	Issued for Site Instruction #13	bg
33.	Dec. 6. 2021	Issued for Site Instruction #14	bg
34.	Dec. 7. 2021	Issued for Site Instruction #15	bg

KEY PLAN

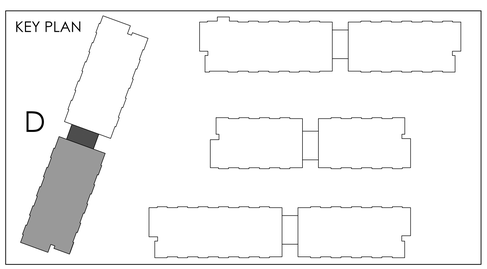

01.	Apr.19.2021	issued to client	bg

issued for revisions

GRAZIANI CORAZZA ARCHITECTS
1320 SHERIDON DRIVE SUITE 100 MISSISSAUGA ONTARIO L4W 1C3
T.905.795.2601 F.905.795.2644 WWW.GC-ARCHITECTS.COM

RESIDENTIAL

ATTMAR + PALLESCHI DRIVE

BRAMPTON	ONTARIO
PROJECT ARCHITECT:	B.GRAZIANI
ASSISTANT DESIGNER:	R.LINCOLN
DRAWN BY:	G.C/F.C/M.B
CHECKED BY:	D.BIASE/G.COLANGELO
PLOT DATE:	DEC.13.2021
JOB #:	1331.15

ROOF PLAN
BUILDING D (PARTIAL PLAN)

1:50

A-305d1

TITLEBLOCK SIZE: 915 x 1200

REF. A305a1 FOR CONTINUATION

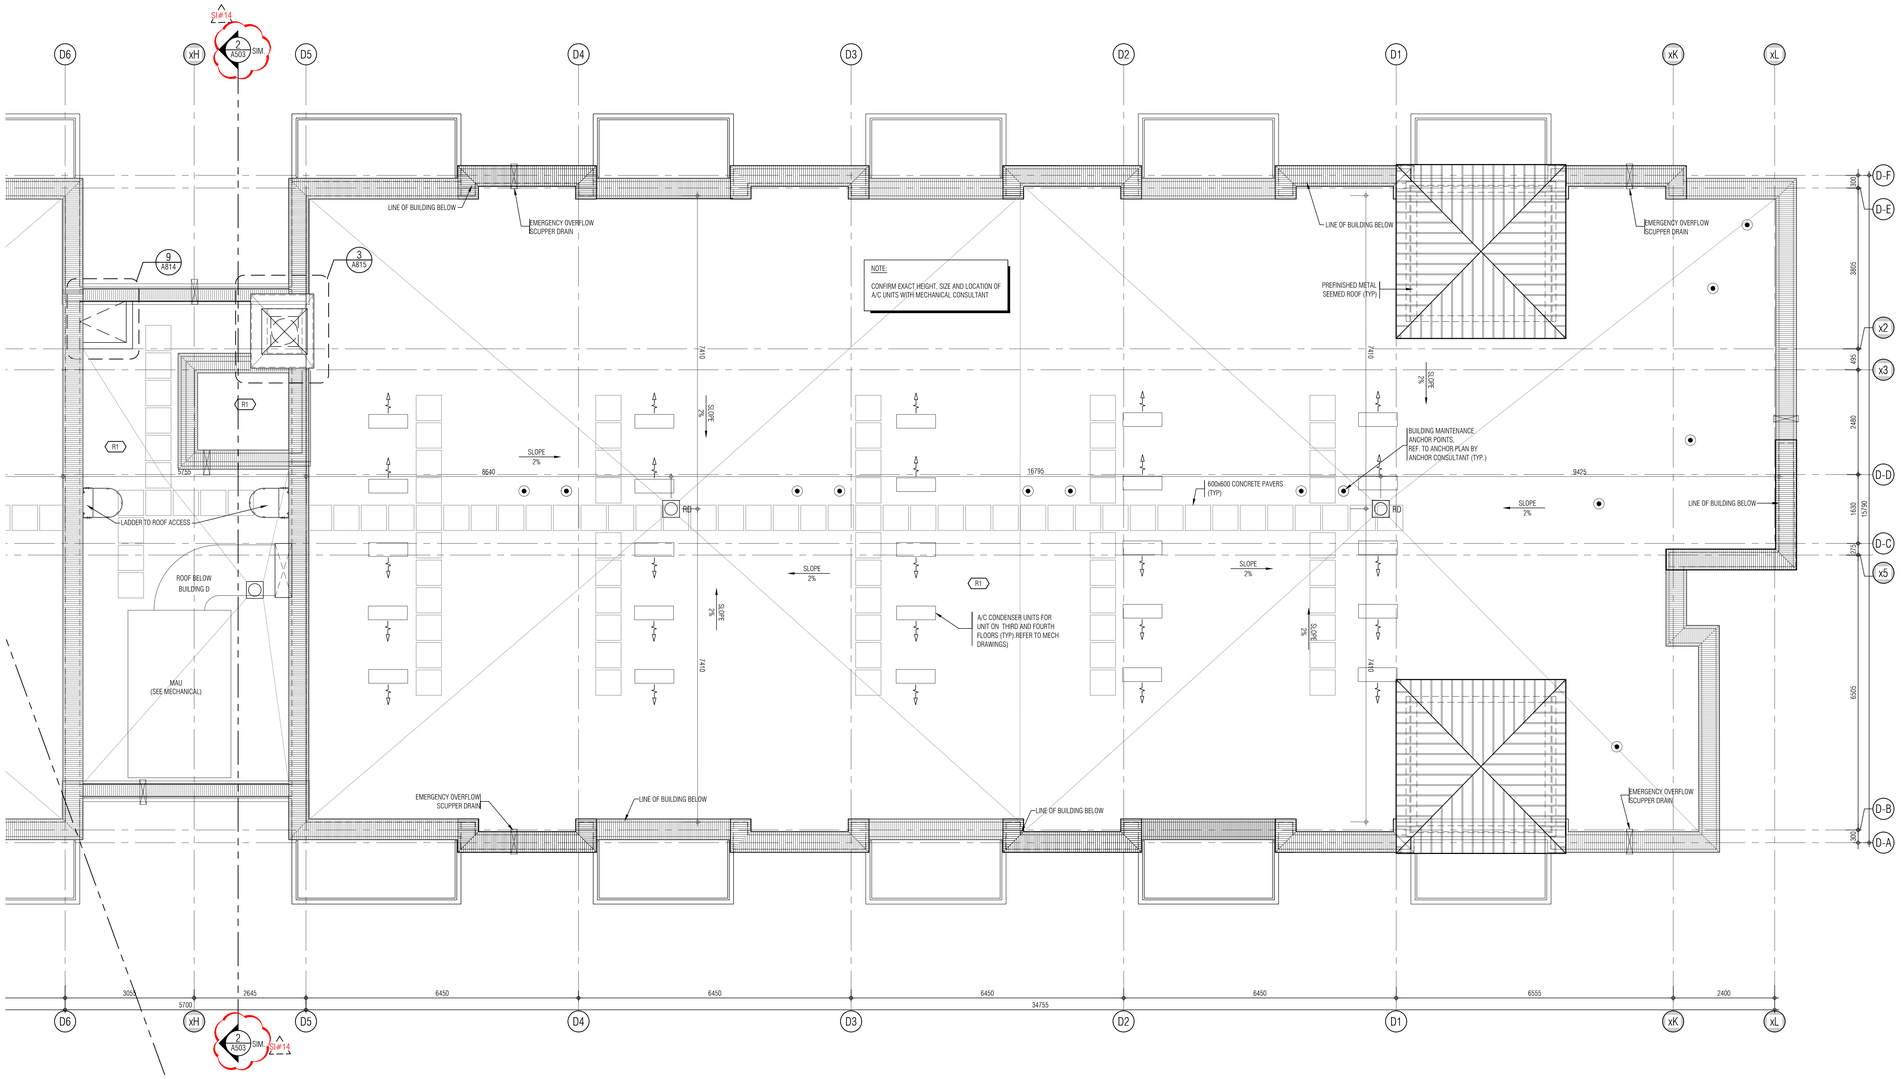

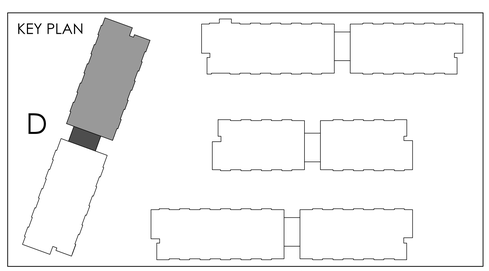

THIS DRAWING, AS AN INSTRUMENT OF SERVICE, IS PROVIDED BY AND IS THE PROPERTY OF GRAZIANI+CORAZZA ARCHITECTS INC. THE CONTRACTOR MUST VERIFY AND ACCEPT RESPONSIBILITY FOR ALL DIMENSIONS AND CONDITIONS ON SITE AND MUST NOTIFY GRAZIANI+CORAZZA ARCHITECTS INC. OF ANY VARIATIONS FROM THE SUPPLIED INFORMATION. GRAZIANI+CORAZZA ARCHITECTS INC. IS NOT RESPONSIBLE FOR THE ACCURACY OF SURVEY, STRUCTURAL, MECHANICAL, ELECTRICAL, AND OTHER ENGINEERING INFORMATION SHOWN ON THIS DRAWING. REFER TO THE APPROPRIATE ENGINEERING DRAWINGS BEFORE PROCEEDING WITH THE WORK. CONSTRUCTION MUST CONFORM TO ALL APPLICABLE CODES AND REQUIREMENTS OF THE AUTHORITIES HAVING JURISDICTION. UNLESS OTHERWISE NOTED, NO INVESTIGATION HAS BEEN UNDERTAKEN OR REPORTED ON BY THIS OFFICE IN REGARDS TO THE ENVIRONMENTAL CONDITION OF THIS SITE.

THIS DRAWING IS NOT TO BE SCALED. ALL ARCHITECTURAL SYMBOLS INDICATED ON THIS DRAWING ARE GRAPHIC REPRESENTATIONS ONLY.

CONDITIONS FOR ELECTRONIC INFORMATION TRANSFER:

ELECTRONIC INFORMATION IS SUPPLIED TO THE OTHER ASSOCIATED FIRMS TO ASSIST THEM IN THE EXECUTION OF THEIR WORK / REVIEW. THE RECIPIENT FIRMS MUST DETERMINE THE COMPLETENESS / APPROPRIATENESS / RELEVANCE OF THE INFORMATION IN RESPECT TO THEIR PARTICULAR RESPONSIBILITY.

GRAZIANI+CORAZZA ARCHITECTS INC. SHALL NOT BE RESPONSIBLE FOR:
1. ERRORS, OMISSIONS, INCOMPLETENESS DUE TO LOSS OF INFORMATION IN WHOLE OR PART WHEN INFORMATION IS TRANSFERRED.
2. TRANSMISSION OF ANY VIRUS OR DAMAGE TO THE RECEIVING ELECTRONIC SYSTEM WHEN INFORMATION IS TRANSFERRED.

01.	Oct.07.2019	issued for tender	___
02.	Mar.13.2020	issued for design coordination #2	___
03.	Mar.16.2020	issued for addendum #2	___
04.	Mar.16.2020	issued for addendum #3	___
05.	Aug.24.2020	issued for addendum #4	___
06.	Sept. 28.2020	issued for permit	bg
07.	Oct.20.2020	issued for addendum #5	___
08.	Nov.23.2020	issued for addendum #6	___
09.	Dec.14.2020	issued for addendum #7	___
10.	Jan.18.2021	issued for addendum #8	___
11.	Mar. 2. 2021	issued for permit	bg
12.	Mar.09.2021	issued for addendum #9	___
13.	Mar.10.2021	issued for addendum #9R	___
14.	Mar.26.2021	issued for progress	___
15.	May 14. 2021	issued for Site Instruction #1	___
16.	June 15. 2021	issued for Site Instruction #2	___
17.	July. 7. 2021	re-issued for permit	bg
18.	July. 15. 2021	Issued for Site Instruction #3	bg
19.	July. 27. 2021	Issued for Site Instruction #4	bg
20.	Aug. 3. 2021	Issued for Site Instruction #5	bg
21.	Aug. 18. 2021	Issued for Site Instruction #6	bg
22.	Aug. 20. 2021	Re-issued for permit.	bg
23.	Sept. 07. 2021	Issued for Site Instruction #7	bg
24.	Sept. 09. 2021	Issued for Site Instruction #8	bg
25.	Sept. 16. 2021	Issued for Building D Permit Revisions	bg
26.	Sept. 22. 2021	Issued for Site Instruction #9	bg
27.	Oct. 6. 2021	Re-issued for permit.	bg
28.	Oct. 8. 2021	Issued for Site Instruction #10	bg
30.	Oct. 28. 2021	Issued for Site Instruction #11	bg
31.	Nov. 05. 2021	Issued for Site Instruction #12	bg
32.	Dec. 3. 2021	Issued for Site Instruction #13	bg
33.	Dec. 6. 2021	Issued for Site Instruction #14	bg
34.	Dec. 7. 2021	Issued for Site Instruction #15	bg

01.	Apr.19.2021	issued to client	bg

issued for revisions

GRAZIANI + CORAZZA ARCHITECTS
1320 SHAWSON DRIVE, SUITE 100 MISSISSAUGA, ONTARIO L4W 1C5
T 905.795.2601 F 905.795.2644 WWW.GC-ARCHITECTS.COM

RESIDENTIAL

ROYAL PINE

ATTMAR + PALLESCHI DRIVE

BRAMPTON	ONTARIO
PROJECT ARCHITECT:	B.GRAZIANI
ASSISTANT DESIGNER:	R.LINCOLN
DRAWN BY:	G.C/F.C/M.B
CHECKED BY:	D.BIASE/G.COLANGELO
PLOT DATE:	DEC.13.2021
JOB #	1331.15

ROOF PLAN
BUILDING D (PARTIAL PLAN)

1:50

A-305d2

TITLEBLOCK SIZE: 915 x 1200

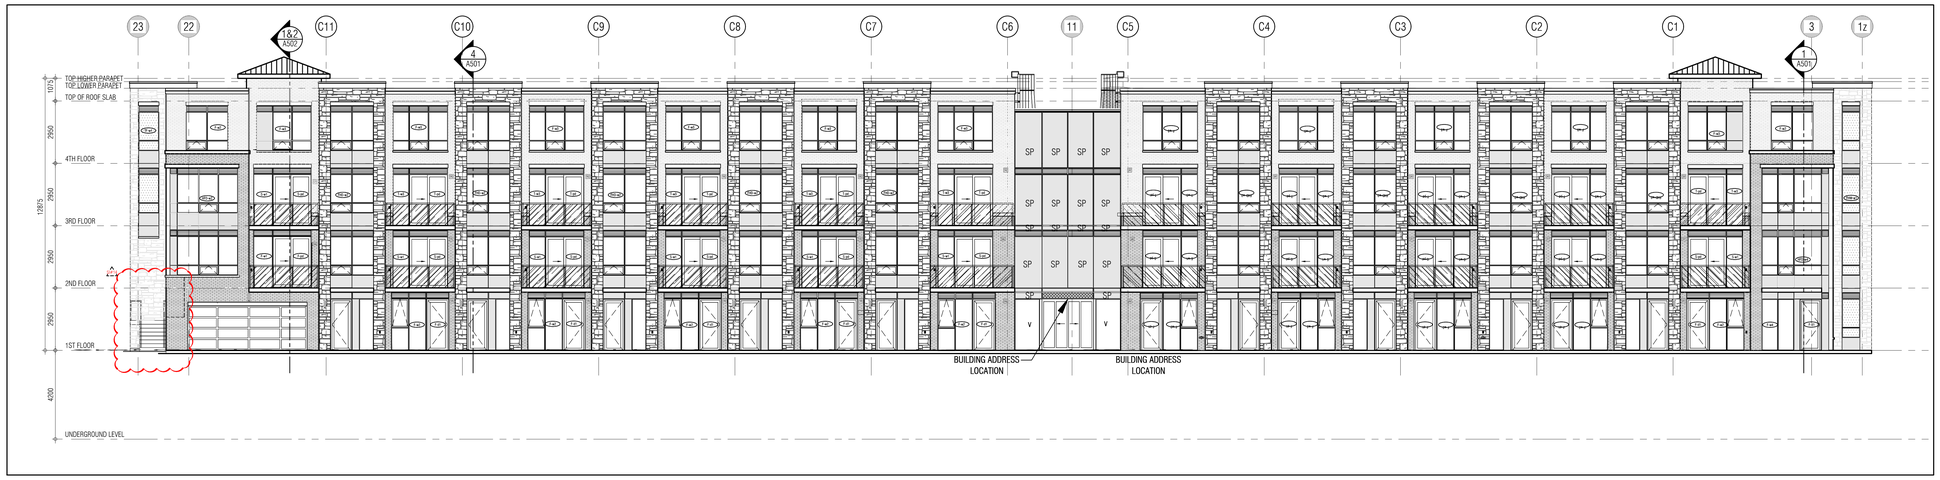

SOUTH ELEVATION 1 / A403
1:100

NORTH ELEVATION 2 / A403
1:100

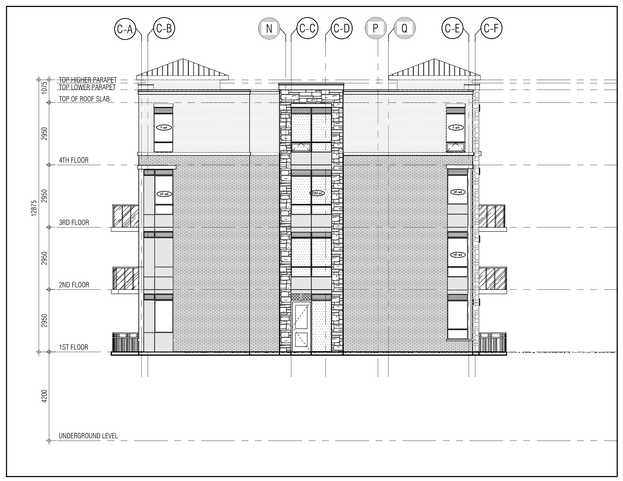

EAST ELEVATION 3 / A403
1:100

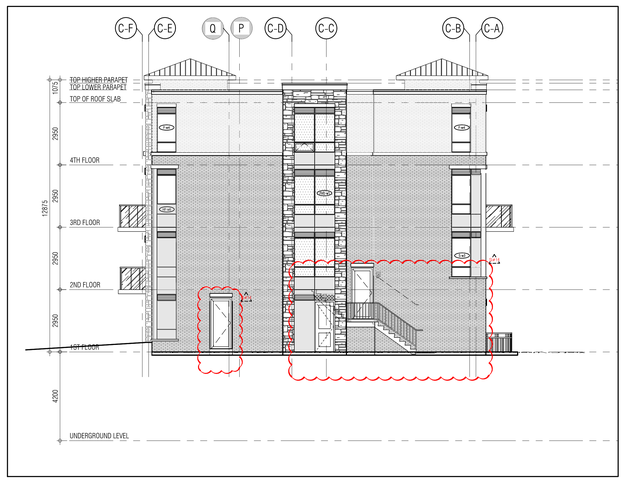

WEST ELEVATION 4 / A403
1:100

THIS DRAWING, AS AN INSTRUMENT OF SERVICE, IS PROVIDED BY AND IS THE PROPERTY OF GRAZIANI+CORAZZA ARCHITECTS INC. THE CONTRACTOR MUST VERIFY AND ACCEPT RESPONSIBILITY FOR ALL DIMENSIONS AND CONDITIONS ON SITE AND MUST NOTIFY GRAZIANI+CORAZZA ARCHITECTS INC. OF ANY VARIATIONS FROM THE SUPPLIED INFORMATION. GRAZIANI+CORAZZA ARCHITECTS INC. IS NOT RESPONSIBLE FOR THE ACCURACY OF SURVEY, STRUCTURAL, MECHANICAL, ELECTRICAL, AND OTHER ENGINEERING INFORMATION SHOWN ON THIS DRAWING. REFER TO THE APPROPRIATE ENGINEERING DRAWINGS BEFORE PROCEEDING WITH THE WORK. CONSTRUCTION MUST CONFORM TO ALL APPLICABLE CODES AND REQUIREMENTS OF THE AUTHORITIES HAVING JURISDICTION. UNLESS OTHERWISE NOTED, NO INVESTIGATION HAS BEEN UNDERTAKEN OR REPORTED ON BY THIS OFFICE IN REGARDS TO THE ENVIRONMENTAL CONDITION OF THIS SITE.

THIS DRAWING IS NOT TO BE SCALED. ALL ARCHITECTURAL SYMBOLS INDICATED ON THIS DRAWING ARE GRAPHIC REPRESENTATIONS ONLY.

CONDITIONS FOR ELECTRONIC INFORMATION TRANSFER:

ELECTRONIC INFORMATION IS SUPPLIED TO THE OTHER ASSOCIATED FIRMS TO ASSIST THEM IN THE EXECUTION OF THEIR WORK / REVIEW. THE RECIPIENT FIRMS MUST DETERMINE THE COMPLETENESS / APPROPRIATENESS / RELEVANCE OF THE INFORMATION IN RESPECT TO THEIR PARTICULAR RESPONSIBILITY.

GRAZIANI+CORAZZA ARCHITECTS INC. SHALL NOT BE RESPONSIBLE FOR:
1. ERRORS, OMISSIONS, INCOMPLETENESS DUE TO LOSS OF INFORMATION IN WHOLE OR PART WHEN INFORMATION IS TRANSFERRED.
2. TRANSMISSION OF ANY VIRUS OR DAMAGE TO THE RECEIVING ELECTRONIC SYSTEM WHEN INFORMATION IS TRANSFERRED.

01.	Oct.07.2019	issued for tender	___
02.	Mar.13.2020	issued for design coordination #2	___
03.	Mar.16.2020	issued for addendum #2	___
04.	Mar.16.2020	issued for addendum #3	___
05.	Aug.24.2020	issued for addendum #4	___
06.	Sept. 28.2020	issued for permit	bg
07.	Oct.20.2020	issued for addendum #5	___
08.	Nov.23.2020	issued for addendum #6	___
09.	Dec.14.2020	issued for addendum #7	___
10.	Jan.18.2021	issued for addendum #8	___
11.	Mar. 2. 2021	issued for permit	bg
12.	Mar.09.2021	issued for addendum #9	___
13.	Mar.10.2021	issued for addendum #9R	___
14.	Mar.26.2021	issued for progress	___
15.	May 14. 2021	issued for Site Instruction #1	___
16.	June 15. 2021	issued for Site Instruction #2	___
17.	July. 7. 2021	re-issued for permit	bg
18.	July. 15. 2021	Issued for Site Instruction #3	bg
19.	July. 27. 2021	Issued for Site Instruction #4	bg
20.	Aug. 3. 2021	Issued for Site Instruction #5	bg
21.	Aug. 18. 2021	Issued for Site Instruction #6	bg
22.	Aug. 20. 2021	Re-issued for permit.	bg
23.	Sept. 07. 2021	Issued for Site Instruction #7	bg
24.	Sept. 09. 2021	Issued for Site Instruction #8	bg
25.	Sept. 16. 2021	Issued for Building D Permit Revisions	bg
26.	Sept. 22. 2021	Issued for Site Instruction #9	bg
27.	Oct. 6. 2021	Re-issued for permit.	bg
28.	Oct. 8. 2021	Issued for Site Instruction #10	bg
30.	Oct. 28. 2021	Issued for Site Instruction #11	bg
31.	Nov. 05. 2021	Issued for Site Instruction #12	bg
32.	Dec. 3. 2021	Issued for Site Instruction #13	bg
33.	Dec. 6. 2021	Issued for Site Instruction #14	bg
34.	Dec. 7. 2021	Issued for Site Instruction #15	bg

01.	Apr.19.2021	issued to client	bg

issued for revisions

GRAZIANI + CORAZZA ARCHITECTS

RESIDENTIAL


ATTMAR + PALLESCHI DRIVE

BRAMPTON ONTARIO

PROJECT ARCHITECT:	B.GRAZIANI
ASSISTANT DESIGNER:	R.LINCOLN
DRAWN BY:	G.C/F.C/M.B
CHECKED BY:	D.BIASE/G.COLANGELO
PLOT DATE:	DEC.08.2021
JOB #	1331.15

KEY PLAN

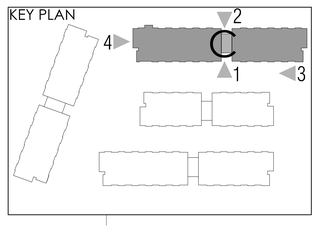

BUILDING C ELEVATIONS
OVERALL ELVATIONS

1:100 A403

TITLEBLOCK SIZE: 915 x 1200

BUILDING C-SOUTH ELEVATION 1
1:50 A-403c1

REF.2-A-402b1 FOR CONTINUATION

BUILDING C-SOUTH ELEVATION 2
1:50 A-403c1

REF.1-A-402b1 FOR CONTINUATION

THIS DRAWING, AS AN INSTRUMENT OF SERVICE, IS PROVIDED BY AND IS THE PROPERTY OF GRAZIANI+CORAZZA ARCHITECTS INC. THE CONTRACTOR MUST VERIFY AND ACCEPT RESPONSIBILITY FOR ALL DIMENSIONS AND CONDITIONS ON SITE AND MUST NOTIFY GRAZIANI+CORAZZA ARCHITECTS INC. OF ANY VARIATIONS FROM THE SUPPLIED INFORMATION. GRAZIANI+CORAZZA ARCHITECTS INC. IS NOT RESPONSIBLE FOR THE ACCURACY OF SURVEY, STRUCTURAL, MECHANICAL, ELECTRICAL, AND OTHER ENGINEERING INFORMATION SHOWN ON THIS DRAWING. REFER TO THE APPROPRIATE ENGINEERING DRAWINGS BEFORE PROCEEDING WITH THE WORK. CONSTRUCTION MUST CONFORM TO ALL APPLICABLE CODES AND REQUIREMENTS OF THE AUTHORITIES HAVING JURISDICTION. UNLESS OTHERWISE NOTED, NO INVESTIGATION HAS BEEN UNDERTAKEN OR REPORTED ON BY THIS OFFICE IN REGARDS TO THE ENVIRONMENTAL CONDITION OF THIS SITE.

THIS DRAWING IS NOT TO BE SCALED. ALL ARCHITECTURAL SYMBOLS INDICATED ON THIS DRAWING ARE GRAPHIC REPRESENTATIONS ONLY.

CONDITIONS FOR ELECTRONIC INFORMATION TRANSFER:

ELECTRONIC INFORMATION IS SUPPLIED TO THE OTHER ASSOCIATED FIRMS TO ASSIST THEM IN THE EXECUTION OF THEIR WORK / REVIEW. THE RECIPIENT FIRMS MUST DETERMINE THE COMPLETENESS / APPROPRIATENESS / RELEVANCE OF THE INFORMATION IN RESPECT TO THEIR PARTICULAR RESPONSIBILITY.

GRAZIANI + CORAZZA ARCHITECTS INC. SHALL NOT BE RESPONSIBLE FOR:
1. ERRORS, OMISSIONS, INCOMPLETENESS DUE TO LOSS OF INFORMATION IN WHOLE OR PART WHEN INFORMATION IS TRANSFERRED.
2. TRANSMISSION OF ANY VIRUS OR DAMAGE TO THE RECEIVING ELECTRONIC SYSTEM WHEN INFORMATION IS TRANSFERRED.

01.	Oct.07.2019	issued for tender	__
02.	Mar.13.2020	issued for design coordination #2	__
03.	Mar.16.2020	issued for addendum #2	__
04.	Mar.16.2020	issued for addendum #3	__
05.	Aug.24.2020	issued for addendum #4	__
06.	Sept. 28.2020	issued for permit	bg
07.	Oct.20.2020	issued for addendum #5	__
08.	Nov.23.2020	issued for addendum #6	__
09.	Dec.14.2020	issued for addendum #7	__
10.	Jan.18.2021	issued for addendum #8	__
11.	Mar. 2. 2021	issued for permit	bg
12.	Mar.09.2021	issued for addendum #9	__
13.	Mar.10.2021	issued for addendum #9R	__
14.	Mar.26.2021	issued for progress	__
15.	May 14. 2021	issued for Site Instruction #1	__
16.	June 15. 2021	issued for Site Instruction #2	__
17.	July. 7. 2021	re-issued for permit	bg
18.	July. 15. 2021	Issued for Site Instruction #3	bg
19.	July. 27. 2021	Issued for Site Instruction #4	bg
20.	Aug. 3. 2021	Issued for Site Instruction #5	bg
21.	Aug. 18. 2021	Issued for Site Instruction #6	bg
22.	Aug. 20. 2021	Re-issued for permit.	bg
23.	Sept. 07. 2021	Issued for Site Instruction #7	bg
24.	Sept. 09. 2021	Issued for Site Instruction #8	bg
25.	Sept. 16. 2021	Issued for Building D Permit Revisions	bg
26.	Sept. 22. 2021	Issued for Site Instruction #9	bg
27.	Oct. 6. 2021	Re-issued for permit.	bg
28.	Oct. 8. 2021	Issued for Site Instruction #10	bg
30.	Oct. 28. 2021	Issued for Site Instruction #11	bg
31.	Nov. 05. 2021	Issued for Site Instruction #12	bg
32.	Dec. 3. 2021	Issued for Site Instruction #13	bg
33.	Dec. 6. 2021	Issued for Site Instruction #14	bg
34.	Dec. 7. 2021	Issued for Site Instruction #15	bg

MATERIALS LEGEND

GL-1	VISION GLASS	GLASS: CLEAR 6mm LOZ FRAME: ACRYMAR UCFX1313 WINDSWEPT SMOKE
GL-S	GLAZED SPANDREL PANEL	3-1114-1 (AVAN LIMITED)
ML	PREFINISHED METAL LOUVRE/GRILLE	ACRYMAR UCFX1313 WINDSWEPT SMOKE
GL-3	VISION GLASS	GLASS: CLEAR 6mm LOZ FRAME: ACRYMAR UCFX1313 WINDSWEPT SMOKE
STV	STONE VENEER	SHOULDICE SMITH STONE - CHENDEN
BR-D	BRICK VENEER (DARK)	MERIDIAN BRICK TRINITY
BR-L	BRICK VENEER (LIGHT)	MERIDIAN BRICK WOOLCLIFF
PC	PRECAST CONCRETE HEADER/SILL	BUFF
GR	GLASS RAILING	GLASS: 8MM - THE HARLOW (TRULITE) FRAME: ACRYMAR UCFX1313 WINDSWEPT SMOKE
FM1	PREFINISHED METAL (FLASHING)	ACRYMAR UCFX1313 WINDSWEPT SMOKE

** BALCONY EDGE, UNDERNEATH BALCONY, BALCONY FLOORS: ACRYMAR UCFX1313 WINDSWEPT SMOKE; BUFF - SAME COLOUR AS PRECAST HEADER/SILL; TRAFFIC TOPPING: CHARCOAL GREY

NOTE: IF EXACT SPECIFIED COLOUR IS NOT AVAILABLE, ATTEMPT COLOUR MATCH AND SUBMIT ALTERNATIVE SAMPLES FOR ARCHITECTS APPROVAL.

01.	Apr.19.2021	issued to client	bg

issued for revisions

GRAZIANI
CORAZZA
ARCHITECTS
1320 SHAWSON DRIVE, SUITE 100 MISSISSAUGA ONTARIO L4W 1C3
T 905.790.2601 F 905.790.2664 WWW.GC-ARCHITECTS.COM

RESIDENTIAL


ATTMAR + PALLESCHI DRIVE

BRAMPTON ONTARIO

PROJECT ARCHITECT:	B.GRAZIANI
ASSISTANT DESIGNER:	R.LINCOLN
DRAWN BY:	G.C/F.C/M.B
CHECKED BY:	D.BIASE/G.COLANGELO
PLOT DATE:	DEC.08.2021
JOB #	1331.15

SOUTH ELEVATION
BUILDING C

1:50 A-403c1

TITLEBLOCK SIZE: 915 x 1200

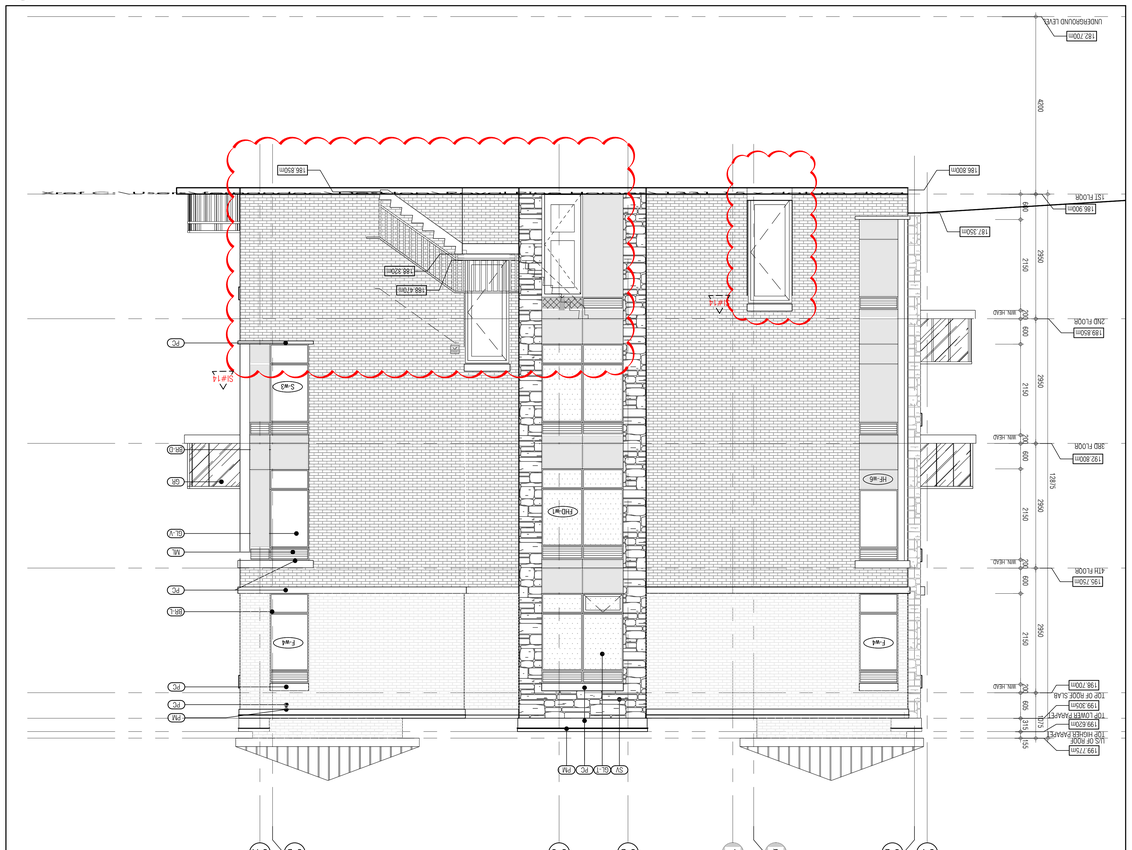

BUILDING C-EAST ELEVATION
1 1:50 A-403c3

BUILDING C-WEST ELEVATION
2 1:50 A-403c3

MATERIALS LEGEND		

NOTE: IF EXACT SPECIFIED COLOUR IS NOT AVAILABLE, ATTEMPT CLOSER MATCH AND SUBMIT ALTERNATIVE SAMPLES FOR ARCHITECTS APPROVAL


UNLESS OTHERWISE NOTED, NO ASSUMPTION HAS BEEN UNDERTAKEN OR IMPORTED ON BY THIS OFFICE IN REGARDS TO THE ENVIRONMENTAL CONDITION OF THIS SITE.

THIS DRAWING IS NOT TO BE SCALED. ALL ARCHITECTURAL SYMBOLS INDICATED ON THIS DRAWING ARE GRAPHIC REPRESENTATIONS ONLY.

CONSTRUCTION FOR ELECTRONIC INFORMATION TRANSFER

ELECTRONIC INFORMATION IS SUPPLIED TO THE OWNER ASSOCIATED PARTIES TO ASSIST THEM IN THE EXECUTION OF THEIR WORK. REVIEW THE REPORT PARTS MUST DETERMINE THE COMPATIBILITY/APPROPRIATE/RELIANCE OF THE INFORMATION IN RESPECT TO THEIR PARTICULAR RESPONSIBILITY.

GRAZIANI + CORAZZA ARCHITECTS INC SHALL NOT BE RESPONSIBLE FOR
1. ENGINEERING OMISSIONS, INCONSISTENCIES DUE TO USE OF INFORMATION IN WHOLE OR PART WHEN APPROPRIATE IS TRANSFERRED.
2. TRANSMISSION OF ANY VIRUS OR DAMAGE TO THE RECEIVING ELECTRONIC SYSTEM WHEN APPROPRIATE IS TRANSFERRED.

01.	Oct.07.2019	Issued for tender
02.	Mar.13.2020	Issued for design coordination #2
03.	Mar.16.2020	Issued for addendum #2
04.	Mar.16.2020	Issued for addendum #3
05.	Aug.24.2020	Issued for addendum #4
06.	Sept.28.2020	Issued for permit
07.	Oct.20.2020	Issued for addendum #5
08.	Nov.23.2020	Issued for addendum #6
09.	Dec.14.2020	Issued for addendum #7
10.	Jan.18.2021	Issued for addendum #8
11.	Mar. 2. 2021	Issued for permit
12.	Mar.09.2021	Issued for addendum #9
13.	Mar.10.2021	Issued for addendum #9R
14.	Mar.26.2021	Issued for progress
15.	May 14. 2021	Issued for Site Instruction #1
16.	June 15. 2021	Issued for Site Instruction #2
17.	July 7. 2021	re-issued for permit
18.	July 15. 2021	Issued for Site Instruction #3
19.	July 27. 2021	Issued for Site Instruction #4
20.	Aug. 3. 2021	Issued for Site Instruction #5
21.	Aug. 18. 2021	Issued for Site Instruction #6
22.	Aug. 20. 2021	Re-issued for permit.
23.	Sept. 07. 2021	Issued for Site Instruction #7
24.	Sept. 09. 2021	Issued for Site Instruction #8
25.	Sept. 16. 2021	Issued for Building D Permit Revisions
26.	Sept. 22. 2021	Issued for Site Instruction #9
27.	Oct. 6. 2021	Re-issued for permit.
28.	Oct. 8. 2021	Issued for Site Instruction #10
29.	Oct. 28. 2021	Issued for Site Instruction #11
31.	Nov. 05. 2021	Issued for Site Instruction #12
32.	Dec. 3. 2021	Issued for Site Instruction #13
33.	Dec. 6. 2021	Issued for Site Instruction #14
34.	Dec. 7. 2021	Issued for Site Instruction #15

TITLEBLOCK SIZE: 915 x 1200

EAST & WEST ELEVATION
BUILDING C

1:50 A-403c3

GRAZIANI + CORAZZA ARCHITECTS
1323 CHAMPION DRIVE, SUITE 100, MISSISSAUGA, ONTARIO, L4W 1C3
T 905.795.3661 F 905.795.3664 WWW.GC-ARCHITECTS.COM

RESIDENTIAL

ATTMAR + PALLESCHI DRIVE
BRAMPTON ONTARIO

PROJECT ARCHITECT:	R.GRAZIANI
ASSISTANT DESIGNER:	R.LINCOLN
DRAWN BY:	G.C/F.C/M.B
CHECKED BY:	D.BIASE/G.COLANGELO
PLOT DATE:	DEC.08.2021
JOB #	1331.1S

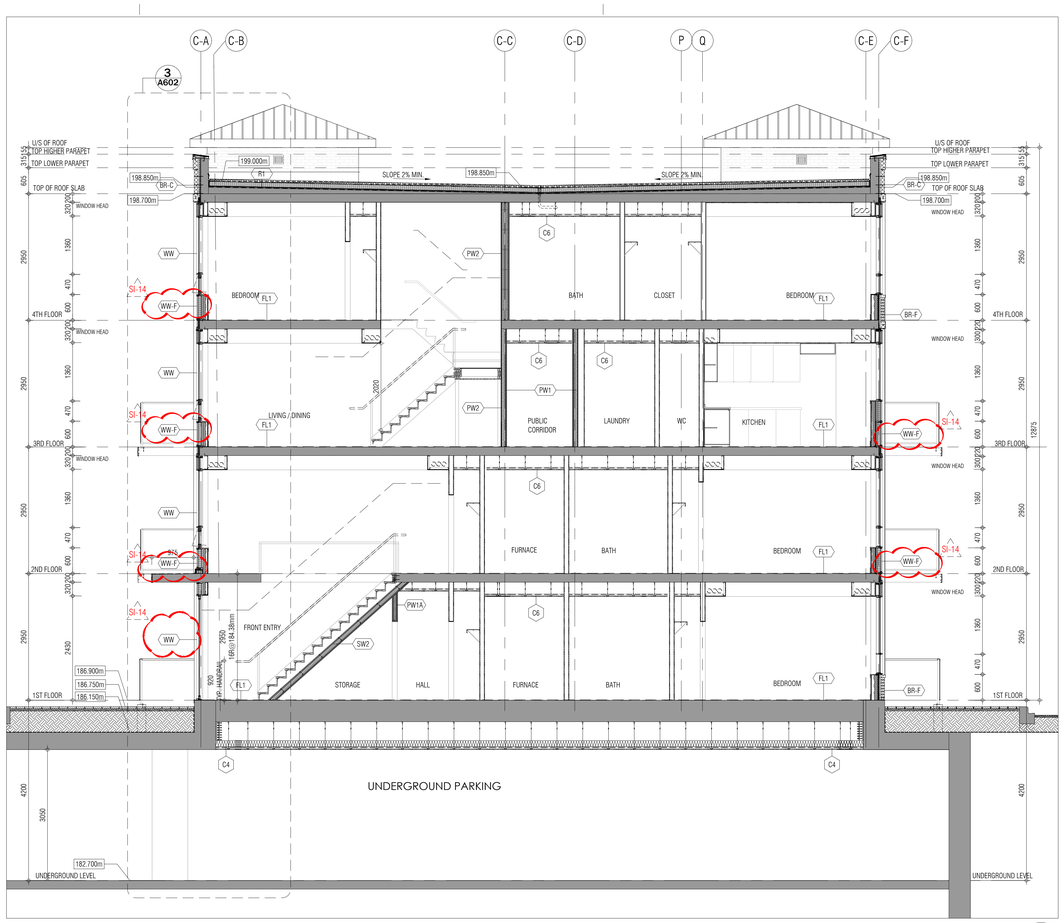

BUILDING SECTION 4
1:50 A501

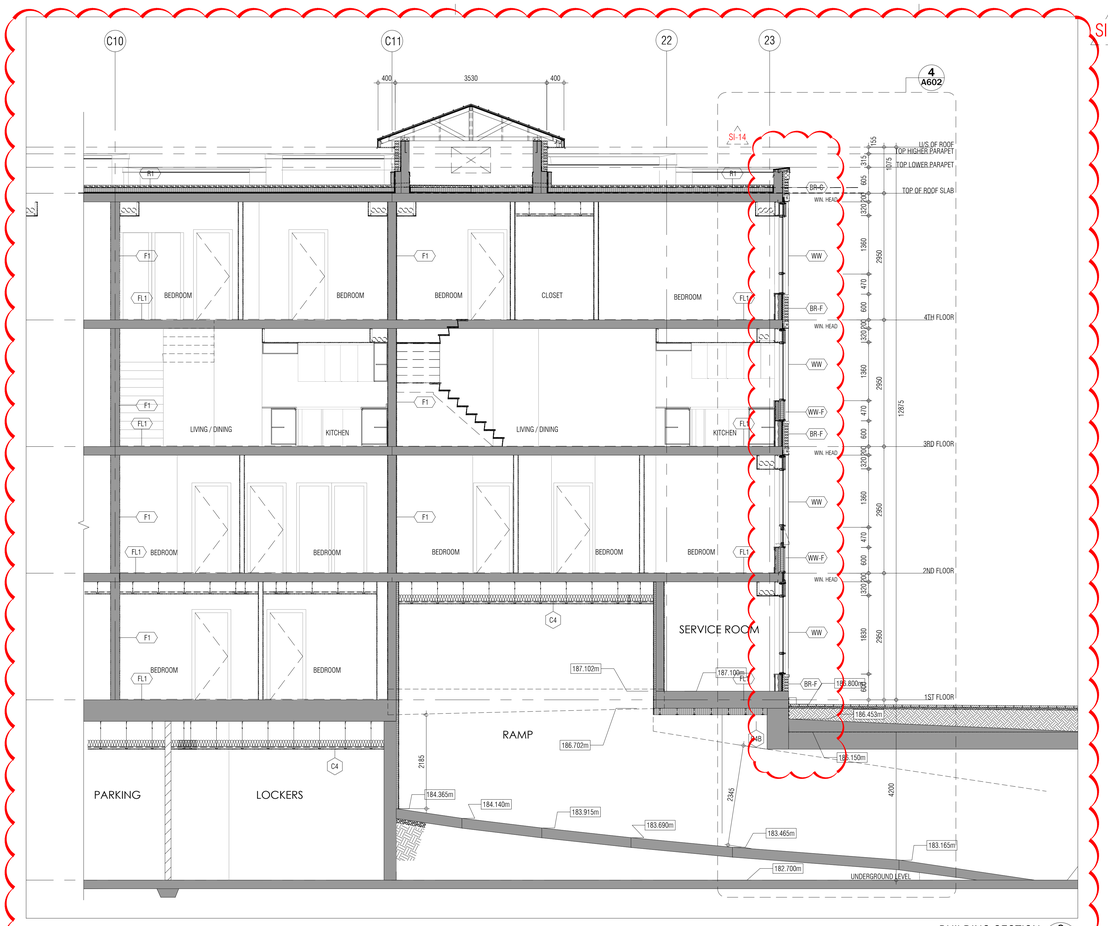

BUILDING SECTION 2
1:50 A501

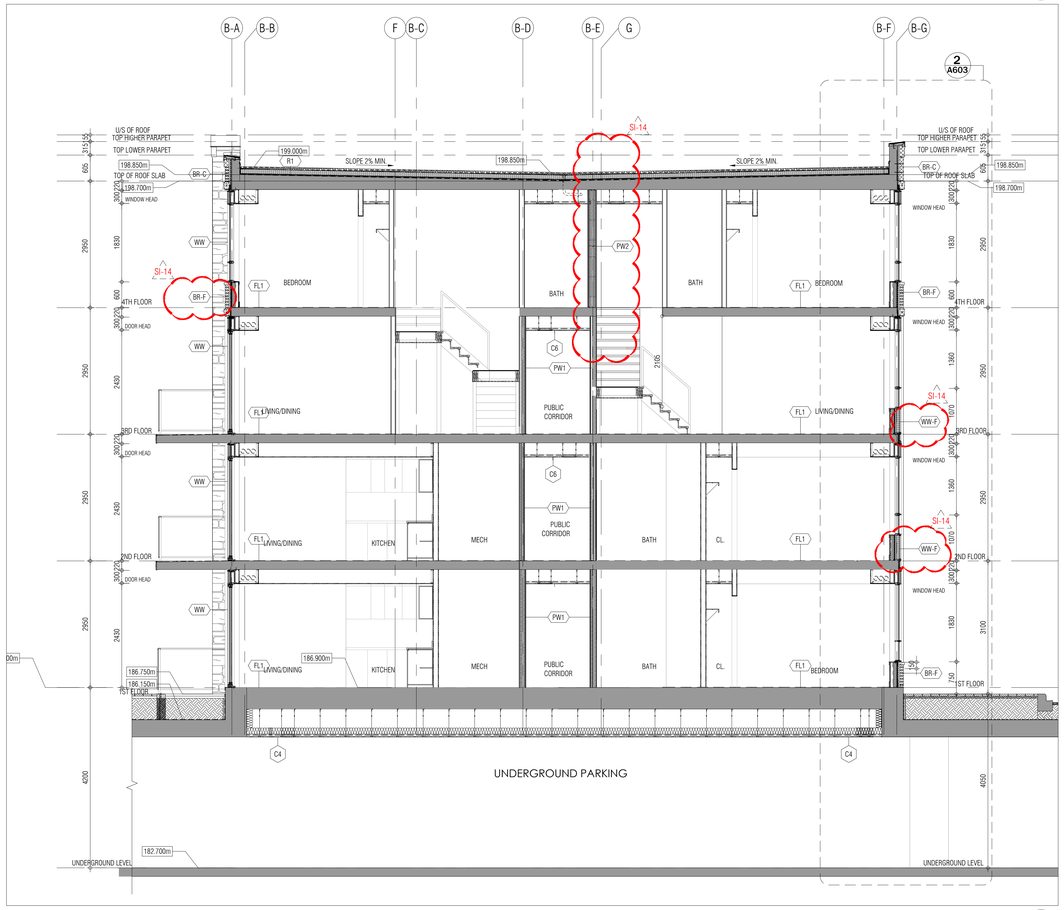

BUILDING SECTION 3
1:50 A501

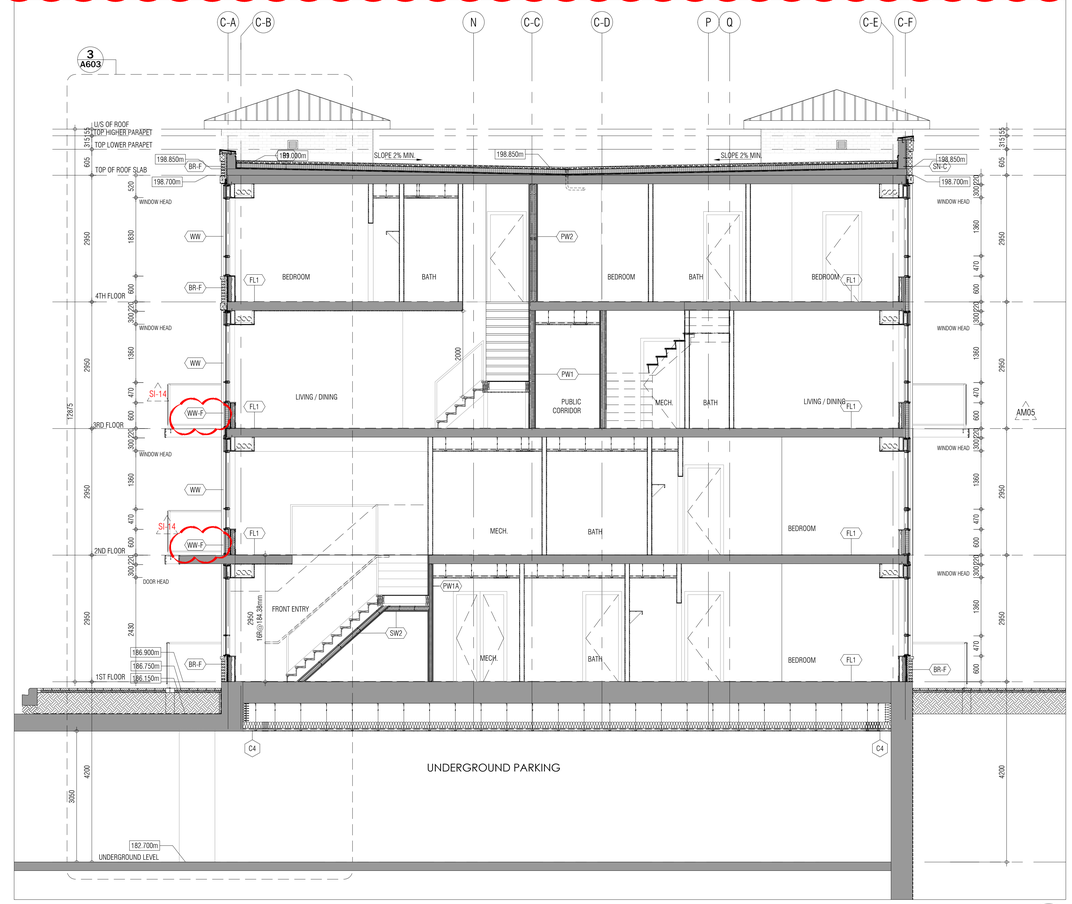

BUILDING SECTION 1
1:50 A501

SI-14

THIS DRAWING, AS AN INSTRUMENT OF SERVICE, IS PROVIDED BY AND IS THE PROPERTY OF GRAZIANI+CORAZZA ARCHITECTS INC. THE CONTRACTOR MUST VERIFY AND ACCEPT RESPONSIBILITY FOR ALL DIMENSIONS AND CONDITIONS ON SITE AND MUST NOTIFY GRAZIANI+CORAZZA ARCHITECTS INC. OF ANY VARIATIONS FROM THE SUPPLIED INFORMATION. GRAZIANI+CORAZZA ARCHITECTS INC. IS NOT RESPONSIBLE FOR THE ACCURACY OF SURVEY, STRUCTURAL, MECHANICAL, ELECTRICAL, AND OTHER ENGINEERING INFORMATION SHOWN ON THIS DRAWING. REFER TO THE APPROPRIATE ENGINEERING DRAWINGS BEFORE PROCEEDING WITH THE WORK. CONSTRUCTION MUST CONFORM TO ALL APPLICABLE CODES AND REQUIREMENTS OF THE AUTHORITIES HAVING JURISDICTION. UNLESS OTHERWISE NOTED, NO INVESTIGATION HAS BEEN UNDERTAKEN OR REPORTED ON BY THIS OFFICE IN REGARDS TO THE ENVIRONMENTAL CONDITION OF THIS SITE.

THIS DRAWING IS NOT TO BE SCALED. ALL ARCHITECTURAL SYMBOLS INDICATED ON THIS DRAWING ARE GRAPHIC REPRESENTATIONS ONLY.

CONDITIONS FOR ELECTRONIC INFORMATION TRANSFER:

ELECTRONIC INFORMATION IS SUPPLIED TO THE OTHER ASSOCIATED FIRMS TO ASSIST THEM IN THE EXECUTION OF THEIR WORK / REVIEW. THE RECIPIENT FIRMS MUST DETERMINE THE COMPLETENESS / APPROPRIATENESS / RELEVANCE OF THE INFORMATION IN RESPECT TO THEIR PARTICULAR RESPONSIBILITY.

GRAZIANI+CORAZZA ARCHITECTS INC. SHALL NOT BE RESPONSIBLE FOR:
1. ERRORS, OMISSIONS, INCOMPLETENESS DUE TO LOSS OF INFORMATION IN WHOLE OR PART WHEN INFORMATION IS TRANSFERRED.
2. TRANSMISSION OF ANY VIRUS OR DAMAGE TO THE RECEIVING ELECTRONIC SYSTEM WHEN INFORMATION IS TRANSFERRED.

01.	Oct.07.2019	issued for tender	
02.	Mar.13.2020	issued for design coordination #2	
03.	Mar.16.2020	issued for addendum #2	
04.	Mar.16.2020	issued for addendum #3	
05.	Aug.24.2020	issued for addendum #4	
06.	Sept. 28.2020	issued for permit	bg
07.	Oct.20.2020	issued for addendum #5	
08.	Nov.23.2020	issued for addendum #6	
09.	Dec.14.2020	issued for addendum #7	
10.	Jan.18.2021	issued for addendum #8	
11.	Mar. 2. 2021	issued for permit	bg
12.	Mar.09.2021	issued for addendum #9	
13.	Mar.10.2021	issued for addendum #9R	
14.	Mar.26.2021	issued for progress	
15.	May 14. 2021	issued for Site Instruction #1	
16.	June 15. 2021	issued for Site Instruction #2	
17.	July. 7. 2021	re-issued for permit	bg
18.	July. 15. 2021	Issued for Site Instruction #3	bg
19.	July. 27. 2021	Issued for Site Instruction #4	bg
20.	Aug. 3. 2021	Issued for Site Instruction #5	bg
21.	Aug. 18. 2021	Issued for Site Instruction #6	bg
22.	Aug. 20. 2021	Re-issued for permit.	bg
23.	Sept. 07. 2021	Issued for Site Instruction #7	bg
24.	Sept. 09. 2021	Issued for Site Instruction #8	bg
25.	Sept. 16. 2021	Issued for Building D Permit Revisions	bg
26.	Sept. 22. 2021	Issued for Site Instruction #9	bg
27.	Oct. 6. 2021	Re-issued for permit.	bg
28.	Oct. 8. 2021	Issued for Site Instruction #10	bg
30.	Oct. 28. 2021	Issued for Site Instruction #11	bg
31.	Nov. 05. 2021	Issued for Site Instruction #12	bg
32.	Dec. 3. 2021	Issued for Site Instruction #13	bg
33.	Dec. 6. 2021	Issued for Site Instruction #14	bg
34.	Dec. 7. 2021	Issued for Site Instruction #15	bg

01.	Apr.19.2021	issued to client	bg

issued for revisions

GRAZIANI + CORAZZA ARCHITECTS
1320 SHARON DRIVE, SUITE 100 MISSISSAUGA, ONTARIO L4W 1C3
T.905.795.2601 F.905.795.2644 WWW.GC-ARCHITECTS.COM

RESIDENTIAL

ATTMAR + PALLESCHI DRIVE

BRAMPTON ONTARIO

PROJECT ARCHITECT:	B.GRAZIANI
ASSISTANT DESIGNER:	R.LINCOLN
DRAWN BY:	G.C./F.C/M.B
CHECKED BY:	D.BIASE/G.COLANGELO
PLOT DATE:	DEC.13.2021
JOB #	1331.15

BUILDING SECTIONS

1:50 A501

TITLEBLOCK SIZE: 915 x 1200

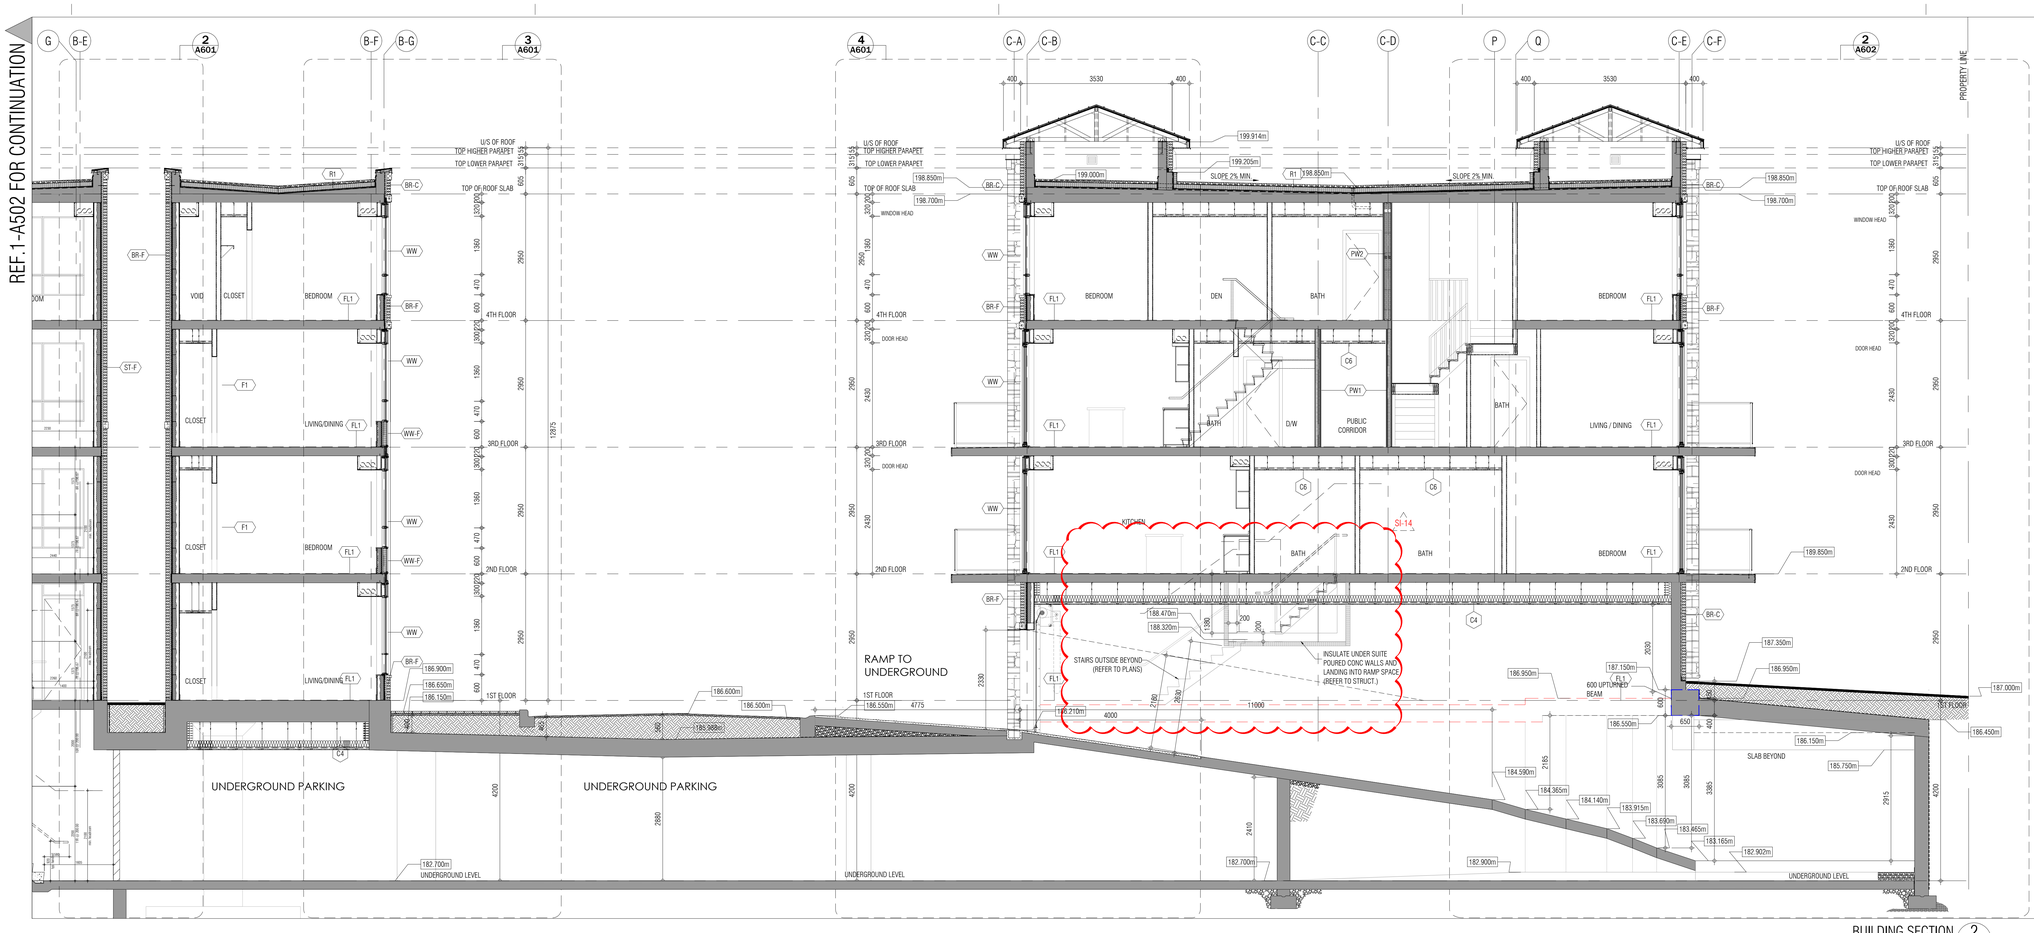

THIS DRAWING, AS AN INSTRUMENT OF SERVICE, IS PROVIDED BY AND IS THE PROPERTY OF GRAZIANI+CORAZZA ARCHITECTS INC. THE CONTRACTOR MUST VERIFY AND ACCEPT RESPONSIBILITY FOR ALL DIMENSIONS AND CONDITIONS ON SITE AND MUST NOTIFY GRAZIANI+CORAZZA ARCHITECTS INC. OF ANY VARIATIONS FROM THE SUPPLIED INFORMATION. GRAZIANI+CORAZZA ARCHITECTS INC. IS NOT RESPONSIBLE FOR THE ACCURACY OF SURVEY, STRUCTURAL, MECHANICAL, ELECTRICAL, AND OTHER ENGINEERING INFORMATION SHOWN ON THIS DRAWING. REFER TO THE APPROPRIATE ENGINEERING DRAWINGS BEFORE PROCEEDING WITH THE WORK. CONSTRUCTION MUST CONFORM TO ALL APPLICABLE CODES AND REQUIREMENTS OF THE AUTHORITIES HAVING JURISDICTION. UNLESS OTHERWISE NOTED, NO INVESTIGATION HAS BEEN UNDERTAKEN OR REPORTED ON BY THIS OFFICE IN REGARDS TO THE ENVIRONMENTAL CONDITION OF THIS SITE.

THIS DRAWING IS NOT TO BE SCALED. ALL ARCHITECTURAL SYMBOLS INDICATED ON THIS DRAWING ARE GRAPHIC REPRESENTATIONS ONLY.

CONDITIONS FOR ELECTRONIC INFORMATION TRANSFER:

ELECTRONIC INFORMATION IS SUPPLIED TO THE OTHER ASSOCIATED FIRMS TO ASSIST THEM IN THE EXECUTION OF THEIR WORK / REVIEW. THE RECIPIENT FIRMS MUST DETERMINE THE COMPLETENESS / APPROPRIATENESS / RELEVANCE OF THE INFORMATION IN RESPECT TO THEIR PARTICULAR RESPONSIBILITY.

GRAZIANI+CORAZZA ARCHITECTS INC. SHALL NOT BE RESPONSIBLE FOR:
1. ERRORS, OMISSIONS, INCOMPLETENESS DUE TO LOSS OF INFORMATION IN WHOLE OR PART WHEN INFORMATION IS TRANSFERRED.
2. TRANSMISSION OF ANY VIRUS OR DAMAGE TO THE RECEIVING ELECTRONIC SYSTEM WHEN INFORMATION IS TRANSFERRED.

01.	Oct.07.2019	issued for tender	—
02.	Mar.13.2020	issued for design coordination #2	—
03.	Mar.16.2020	issued for addendum #2	—
04.	Mar.16.2020	issued for addendum #3	—
05.	Aug.24.2020	issued for addendum #4	—
06.	Sept. 28.2020	issued for permit	bg
07.	Oct.20.2020	issued for addendum #5	—
08.	Nov.23.2020	issued for addendum #6	—
09.	Dec.14.2020	issued for addendum #7	—
10.	Jan.18.2021	issued for addendum #8	—
11.	Mar. 2. 2021	issued for permit	bg
12.	Mar.09.2021	issued for addendum #9	—
13.	Mar.10.2021	issued for addendum #9R	—
14.	Mar.26.2021	issued for progress	—
15.	May 14. 2021	issued for Site Instruction #1	—
16.	June 15. 2021	issued for Site Instruction #2	—
17.	July. 7. 2021	re-issued for permit	bg
18.	July. 15. 2021	Issued for Site Instruction #3	bg
19.	July. 27. 2021	Issued for Site Instruction #4	bg
20.	Aug. 3. 2021	Issued for Site Instruction #5	bg
21.	Aug. 18. 2021	Issued for Site Instruction #6	bg
22.	Aug. 20. 2021	Re-issued for permit.	bg
23.	Sept. 07. 2021	Issued for Site Instruction #7	bg
24.	Sept. 09. 2021	Issued for Site Instruction #8	bg
25.	Sept. 16. 2021	Issued for Building D Permit Revisions	bg
26.	Sept. 22. 2021	Issued for Site Instruction #9	bg
27.	Oct. 6. 2021	Re-issued for permit.	bg
28.	Oct. 8. 2021	Issued for Site Instruction #10	bg
30.	Oct. 28. 2021	Issued for Site Instruction #11	bg
31.	Nov. 05. 2021	Issued for Site Instruction #12	bg
32.	Dec. 3. 2021	Issued for Site Instruction #13	bg
33.	Dec. 6. 2021	Issued for Site Instruction #14	bg
34.	Dec. 7. 2021	Issued for Site Instruction #15	bg
01.	Apr.19.2021	issued to client	bg

issued for revisions

GRAZIANI + CORAZZA ARCHITECTS
1320 SHARON DRIVE, SUITE 100 MISSISSAUGA, ONTARIO L4W 1C3
T 905.795.2621 F 905.795.2644 WWW.GC-ARCHITECTS.COM

RESIDENTIAL

ATTMAR + PALLESCHI DRIVE

BRAMPTON ONTARIO

PROJECT ARCHITECT:	B.GRAZIANI
ASSISTANT DESIGNER:	R.LINCOLN
DRAWN BY:	G.C./F.C./M.B
CHECKED BY:	D.BIASE/G.COLANGELO
PLOT DATE:	DEC.13.2021
JOB #	1331.15

BUILDING SECTION

1:50 A502

TITLEBLOCK SIZE: 915 x 1200

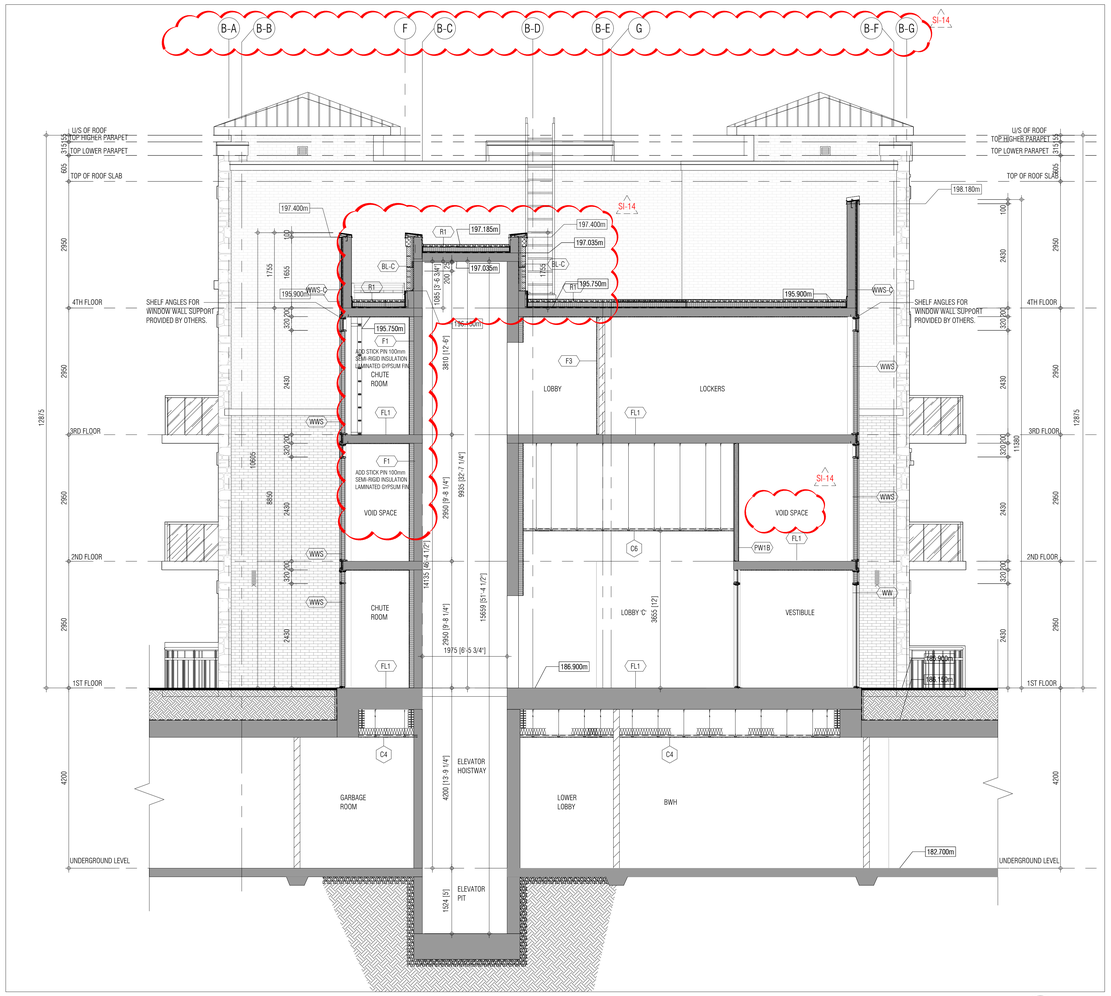

BUILDING SECTION 2
1:50 A503

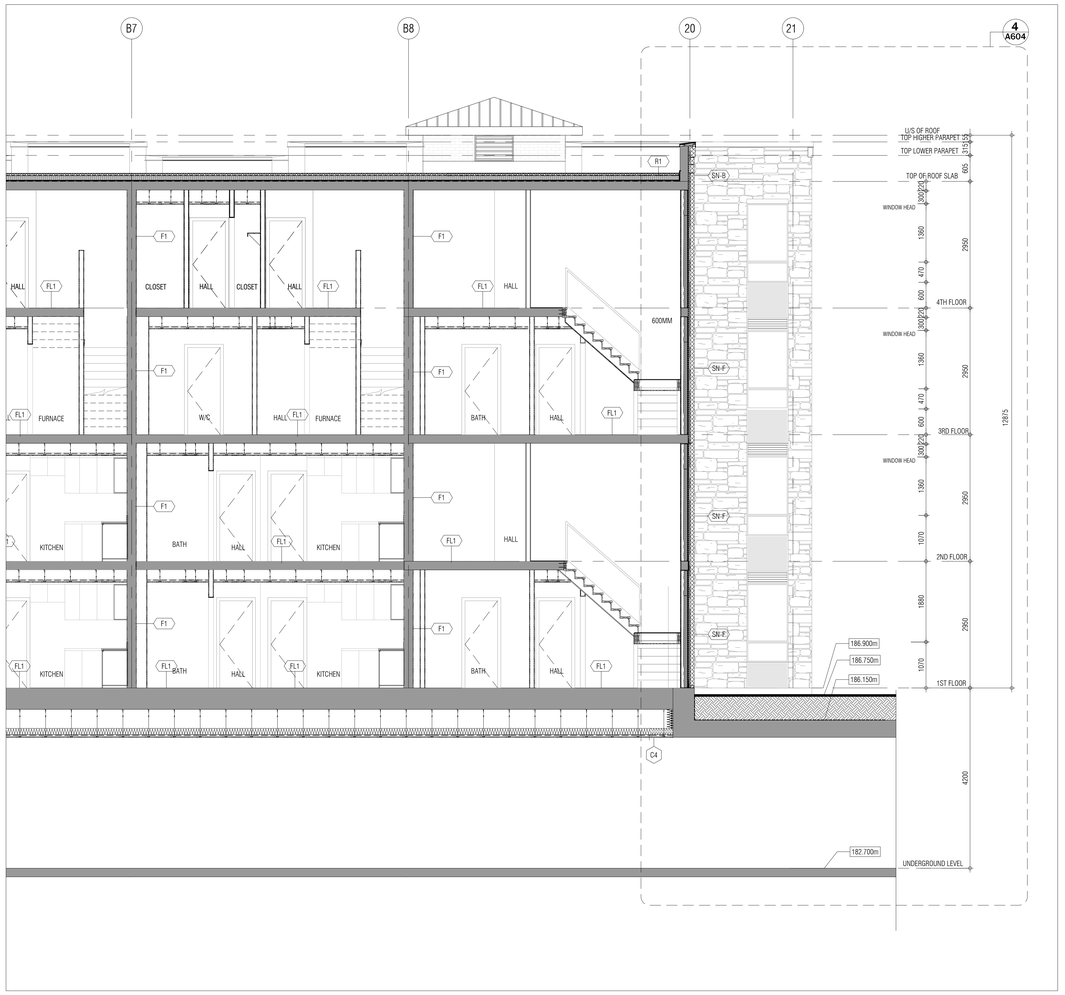

BUILDING SECTION 1
1:50 A503

THIS DRAWING, AS AN INSTRUMENT OF SERVICE, IS PROVIDED BY AND IS THE PROPERTY OF GRAZIANI+CORAZZA ARCHITECTS INC. THE CONTRACTOR MUST VERIFY AND ACCEPT RESPONSIBILITY FOR ALL DIMENSIONS AND CONDITIONS ON SITE AND MUST NOTIFY GRAZIANI+CORAZZA ARCHITECTS INC. OF ANY VARIATIONS FROM THE SUPPLIED INFORMATION. GRAZIANI+CORAZZA ARCHITECTS INC. IS NOT RESPONSIBLE FOR THE ACCURACY OF SURVEY, STRUCTURAL, MECHANICAL, ELECTRICAL, AND OTHER ENGINEERING INFORMATION SHOWN ON THIS DRAWING. REFER TO THE APPROPRIATE ENGINEERING DRAWINGS BEFORE PROCEEDING WITH THE WORK. CONSTRUCTION MUST CONFORM TO ALL APPLICABLE CODES AND REQUIREMENTS OF THE AUTHORITIES HAVING JURISDICTION. UNLESS OTHERWISE NOTED, NO INVESTIGATION HAS BEEN UNDERTAKEN OR REPORTED ON BY THIS OFFICE IN REGARDS TO THE ENVIRONMENTAL CONDITION OF THIS SITE.

THIS DRAWING IS NOT TO BE SCALED. ALL ARCHITECTURAL SYMBOLS INDICATED ON THIS DRAWING ARE GRAPHIC REPRESENTATIONS ONLY.

CONDITIONS FOR ELECTRONIC INFORMATION TRANSFER:

ELECTRONIC INFORMATION IS SUPPLIED TO THE OTHER ASSOCIATED FIRMS TO ASSIST THEM IN THE EXECUTION OF THEIR WORK / REVIEW. THE RECIPIENT FIRMS MUST DETERMINE THE COMPLETENESS / APPROPRIATENESS / RELEVANCE OF THE INFORMATION IN RESPECT TO THEIR PARTICULAR RESPONSIBILITY.

GRAZIANI+CORAZZA ARCHITECTS INC. SHALL NOT BE RESPONSIBLE FOR:
1. ERRORS, OMISSIONS, INCOMPLETENESS DUE TO LOSS OF INFORMATION IN WHOLE OR PART WHEN INFORMATION IS TRANSFERRED.
2. TRANSMISSION OF ANY VIRUS OR DAMAGE TO THE RECEIVING ELECTRONIC SYSTEM WHEN INFORMATION IS TRANSFERRED.

01.	Oct.07.2019	issued for tender	
02.	Mar.13.2020	issued for design coordination #2	
03.	Mar.16.2020	issued for addendum #2	
04.	Mar.16.2020	issued for addendum #3	
05.	Aug.24.2020	issued for addendum #4	
06.	Sept. 28.2020	issued for permit	bg
07.	Oct.20.2020	issued for addendum #5	
08.	Nov.23.2020	issued for addendum #6	
09.	Dec.14.2020	issued for addendum #7	
10.	Jan.18.2021	issued for addendum #8	
11.	Mar. 2. 2021	issued for permit	bg
12.	Mar.09.2021	issued for addendum #9	
13.	Mar.10.2021	issued for addendum #9R	
14.	Mar.26.2021	issued for progress	
15.	May 14. 2021	issued for Site Instruction #1	
16.	June 15. 2021	issued for Site Instruction #2	
17.	July. 7. 2021	re-issued for permit	bg
18.	July. 15. 2021	Issued for Site Instruction #3	bg
19.	July. 27. 2021	Issued for Site Instruction #4	bg
20.	Aug. 3. 2021	Issued for Site Instruction #5	bg
21.	Aug. 18. 2021	Issued for Site Instruction #6	bg
22.	Aug. 20. 2021	Re-issued for permit.	bg
23.	Sept. 07. 2021	Issued for Site Instruction #7	bg
24.	Sept. 09. 2021	Issued for Site Instruction #8	bg
25.	Sept. 16. 2021	Issued for Building D Permit Revisions	bg
26.	Sept. 22. 2021	Issued for Site Instruction #9	bg
27.	Oct. 6. 2021	Re-issued for permit.	bg
28.	Oct. 8. 2021	Issued for Site Instruction #10	bg
30.	Oct. 28. 2021	Issued for Site Instruction #11	bg
31.	Nov. 05. 2021	Issued for Site Instruction #12	bg
32.	Dec. 3. 2021	Issued for Site Instruction #13	bg
33.	Dec. 6. 2021	Issued for Site Instruction #14	bg
34.	Dec. 7. 2021	Issued for Site Instruction #15	bg

01.	Apr.19.2021	issued to client	bg

issued for revisions

GRAZIANI + CORAZZA ARCHITECTS
1320 SHARON DRIVE, SUITE 100 MISSISSAUGA, ONTARIO L4W 1C3
T.905.795.2601 F.905.795.2644 WWW.GC-ARCHITECTS.COM

RESIDENTIAL

ATTMAR + PALLESCHI DRIVE

BRAMPTON ONTARIO

PROJECT ARCHITECT:	B.GRAZIANI
ASSISTANT DESIGNER:	R.LINCOLN
DRAWN BY:	G.C./F.C/M.B
CHECKED BY:	D.BIASE/G.COLANGELO
PLOT DATE:	DEC.13.2021
JOB #	1331.15

BUILDING SECTION

1:50 A503

TITLEBLOCK SIZE: 915 x 1200

THIS DRAWING, AS AN INSTRUMENT OF SERVICE, IS PROVIDED BY AND IS THE PROPERTY OF GRAZIANI+CORAZZA ARCHITECTS INC. THE CONTRACTOR MUST VERIFY AND ACCEPT RESPONSIBILITY FOR ALL DIMENSIONS AND CONDITIONS ON SITE AND MUST NOTIFY GRAZIANI+CORAZZA ARCHITECTS INC. OF ANY VARIATIONS FROM THE SUPPLIED INFORMATION. GRAZIANI+CORAZZA ARCHITECTS INC. IS NOT RESPONSIBLE FOR THE ACCURACY OF SURVEY, STRUCTURAL, MECHANICAL, ELECTRICAL, AND OTHER ENGINEERING INFORMATION SHOWN ON THIS DRAWING. REFER TO THE APPROPRIATE ENGINEERING DRAWINGS BEFORE PROCEEDING WITH THE WORK. CONSTRUCTION MUST CONFORM TO ALL APPLICABLE CODES AND REQUIREMENTS OF THE AUTHORITIES HAVING JURISDICTION. UNLESS OTHERWISE NOTED, NO INVESTIGATION HAS BEEN UNDERTAKEN OR REPORTED ON BY THIS OFFICE IN REGARDS TO THE ENVIRONMENTAL CONDITION OF THIS SITE.

THIS DRAWING IS NOT TO BE SCALED. ALL ARCHITECTURAL SYMBOLS INDICATED ON THIS DRAWING ARE GRAPHIC REPRESENTATIONS ONLY.

CONDITIONS FOR ELECTRONIC INFORMATION TRANSFER:

ELECTRONIC INFORMATION IS SUPPLIED TO THE OTHER ASSOCIATED FIRMS TO ASSIST THEM IN THE EXECUTION OF THEIR WORK / REVIEW. THE RECIPIENT FIRMS MUST DETERMINE THE COMPLETENESS / APPROPRIATENESS / RELEVANCE OF THE INFORMATION IN RESPECT TO THEIR PARTICULAR RESPONSIBILITY.

GRAZIANI+CORAZZA ARCHITECTS INC. SHALL NOT BE RESPONSIBLE FOR:
1. ERRORS, OMISSIONS, INCOMPLETENESS DUE TO LOSS OF INFORMATION IN WHOLE OR PART WHEN INFORMATION IS TRANSFERRED.
2. TRANSMISSION OF ANY VIRUS OR DAMAGE TO THE RECEIVING ELECTRONIC SYSTEM WHEN INFORMATION IS TRANSFERRED.

REF.1-A505 FOR CONTINUATION

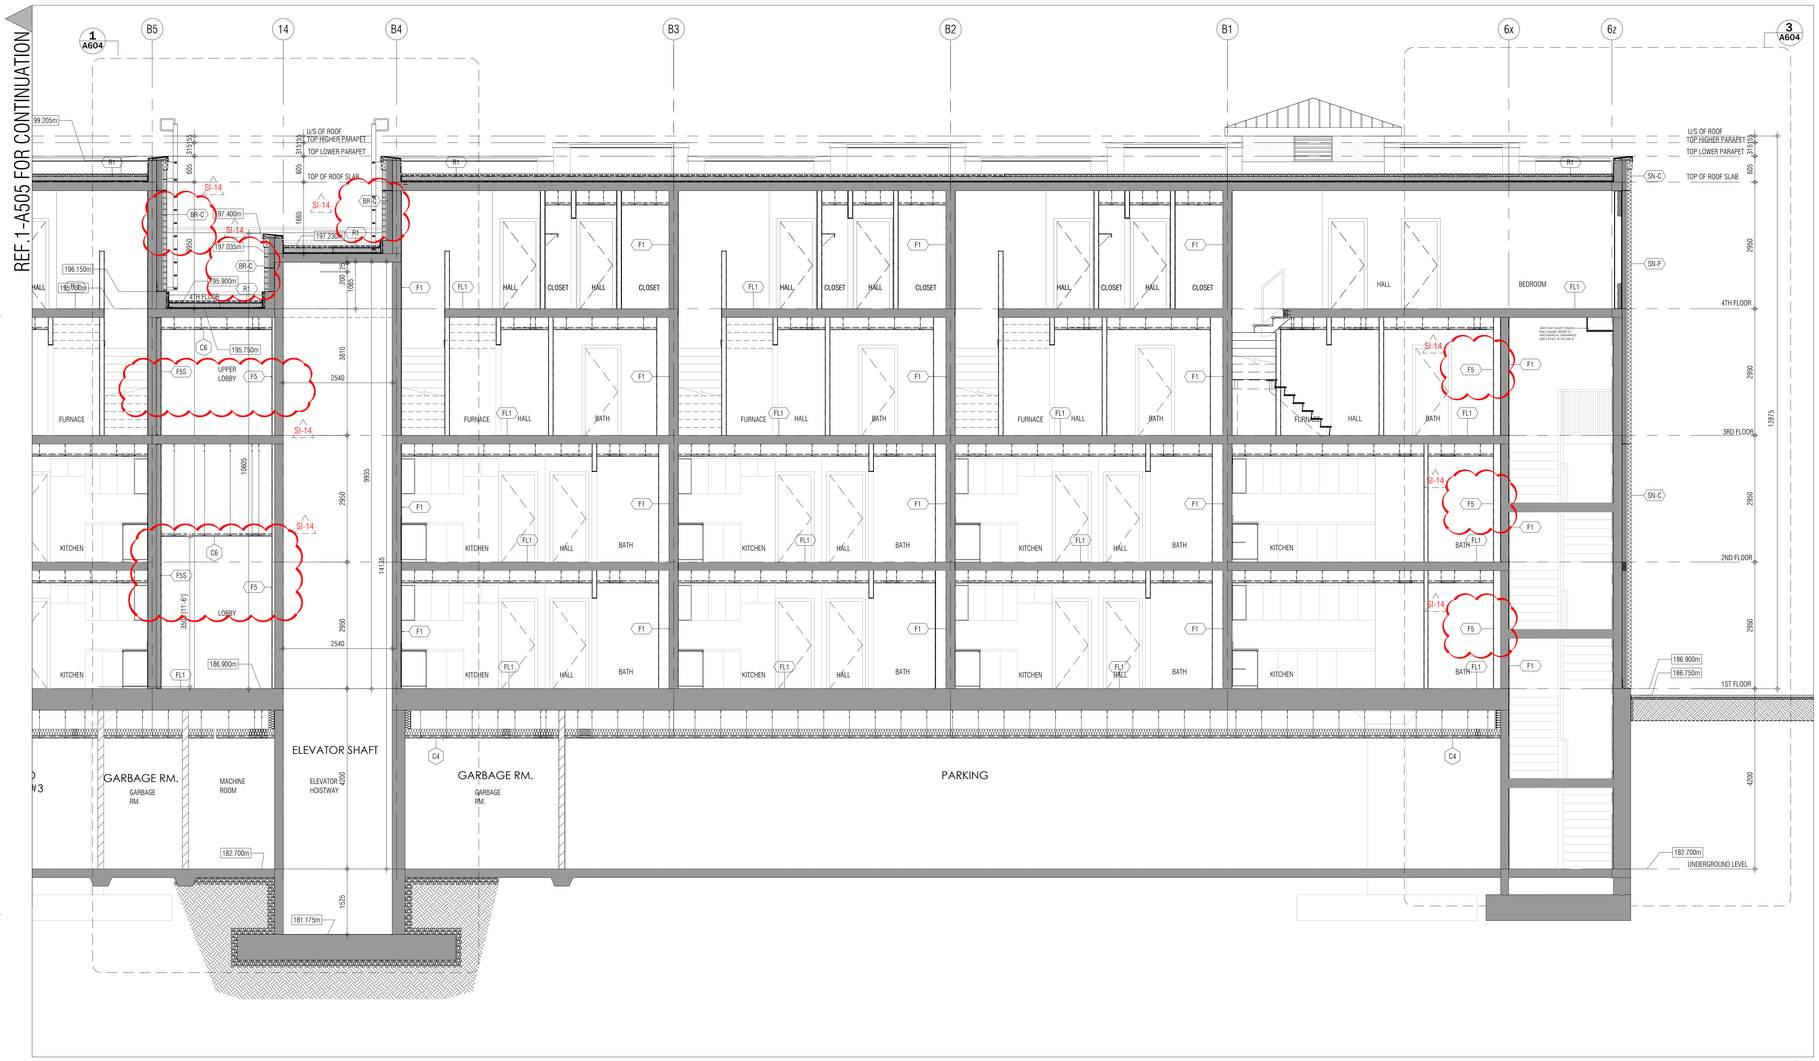

BUILDING SECTION 1 / A504 — 1:50

BLDG SEC.(WINDOW CONDITION) 1a / A504 — 1:50

01.	Oct.07.2019	issued for tender
02.	Mar.13.2020	issued for design coordination #2
03.	Mar.16.2020	issued for addendum #2
04.	Mar.16.2020	issued for addendum #3
05.	Aug.24.2020	issued for addendum #4
06.	Sept. 28.2020	issued for permit bg
07.	Oct.20.2020	issued for addendum #5
08.	Nov.23.2020	issued for addendum #6
09.	Dec.14.2020	issued for addendum #7
10.	Jan.18.2021	issued for addendum #8
11.	Mar. 2. 2021	issued for permit bg
12.	Mar.09.2021	issued for addendum #9
13.	Mar.10.2021	issued for addendum #9R
14.	Mar.26.2021	issued for progress
15.	May 14. 2021	issued for Site Instruction #1
16.	June 15. 2021	issued for Site Instruction #2
17.	July. 7. 2021	re-issued for permit bg
18.	July. 15. 2021	Issued for Site Instruction #3 bg
19.	July. 27. 2021	Issued for Site Instruction #4 bg
20.	Aug. 3. 2021	Issued for Site Instruction #5 bg
21.	Aug. 18. 2021	Issued for Site Instruction #6 bg
22.	Aug. 20. 2021	Re-issued for permit. bg
23.	Sept. 07. 2021	Issued for Site Instruction #7 bg
24.	Sept. 09. 2021	Issued for Site Instruction #8 bg
25.	Sept. 16. 2021	Issued for Building D Permit Revisions bg
26.	Sept. 22. 2021	Issued for Site Instruction #9 bg
27.	Oct. 6. 2021	Re-issued for permit. bg
28.	Oct. 8. 2021	Issued for Site Instruction #10 bg
30.	Oct. 28. 2021	Issued for Site Instruction #11 bg
31.	Nov. 05. 2021	Issued for Site Instruction #12 bg
32.	Dec. 3. 2021	Issued for Site Instruction #13 bg
33.	Dec. 6. 2021	Issued for Site Instruction #14 bg
34.	Dec. 7. 2021	Issued for Site Instruction #15 bg

01.	Apr.19.2021	issued to client bg

issued for revisions

GRAZIANI + CORAZZA ARCHITECTS
1370 SHARMON DRIVE, SUITE 100 MISSISSAUGA, ONTARIO L4W 1C3
T 905.795.2601 F 905.795.2644 WWW.GC-ARCHITECTS.COM

RESIDENTIAL

ATTMAR + PALLESCHI DRIVE

BRAMPTON ONTARIO

PROJECT ARCHITECT:	B.GRAZIANI
ASSISTANT DESIGNER:	R.LINCOLN
DRAWN BY:	G.C./F.C/M.B
CHECKED BY:	D.BIASE/G.COLANGELO
PLOT DATE:	DEC.13.2021
JOB #	1331.15

BUILDING SECTION

1:50 A504

TITLEBLOCK SIZE: 915 x 1200

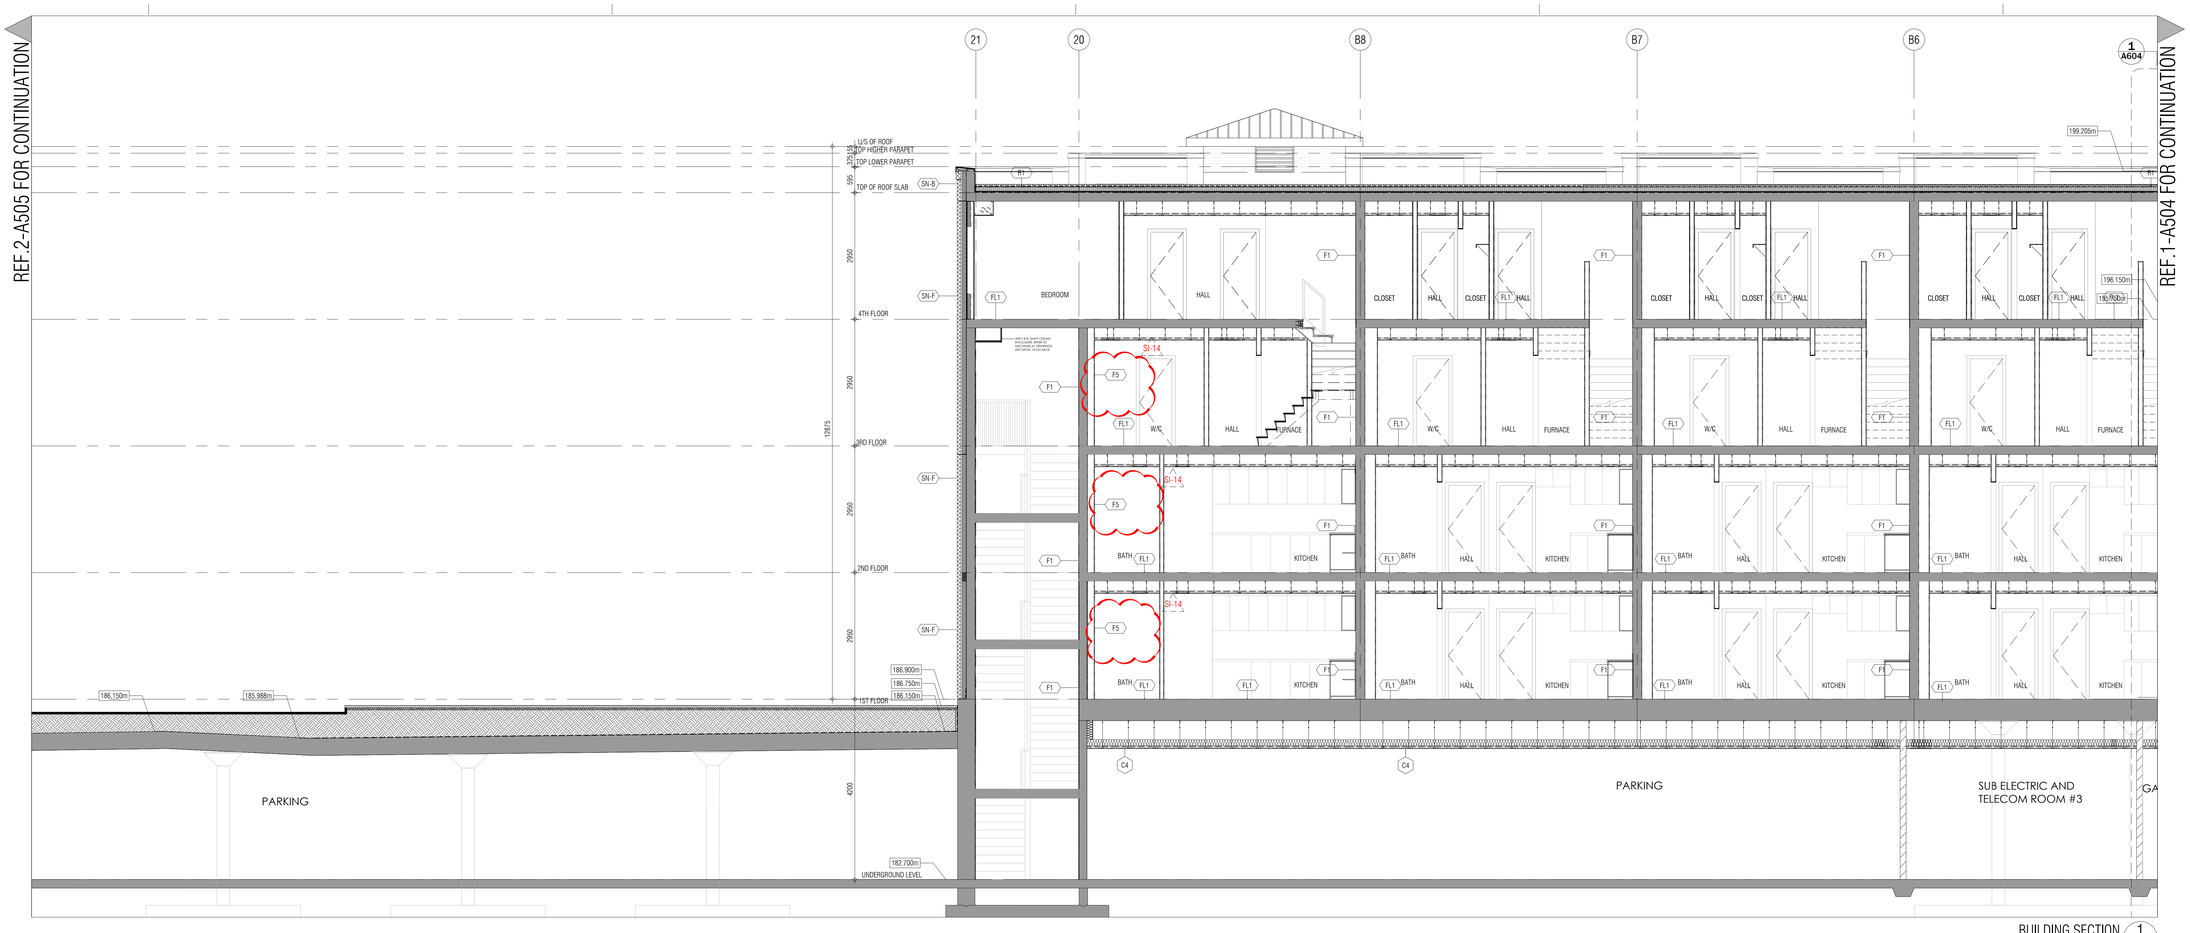

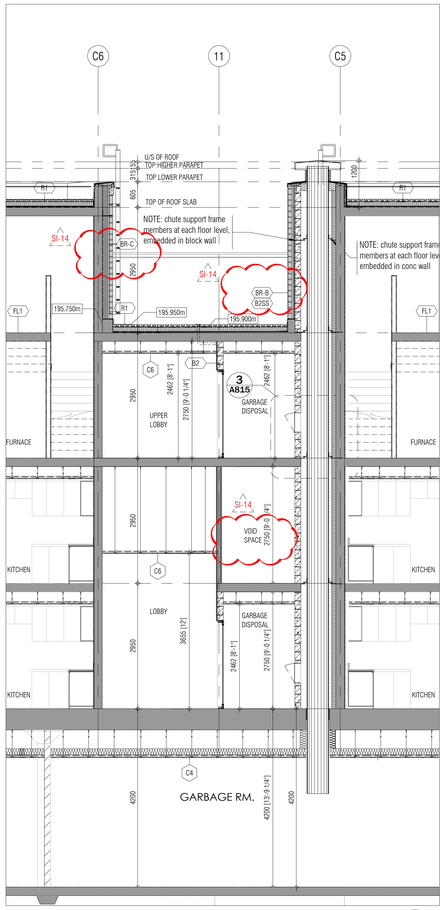

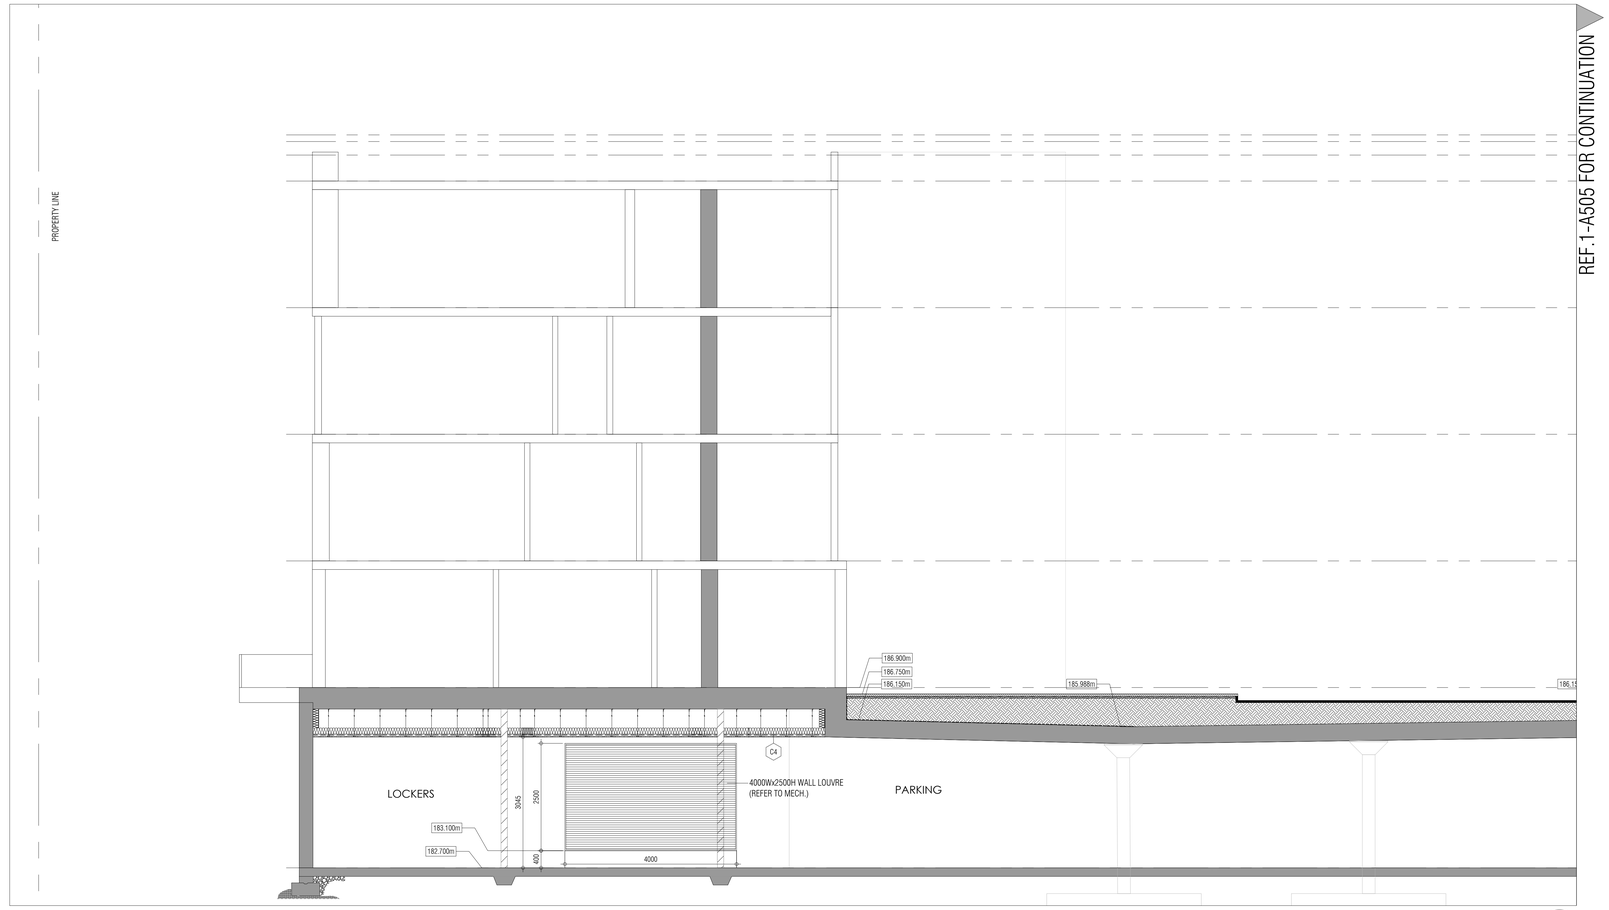

THIS DRAWING, AS AN INSTRUMENT OF SERVICE, IS PROVIDED BY AND IS THE PROPERTY OF GRAZIANI+CORAZZA ARCHITECTS INC. THE CONTRACTOR MUST VERIFY AND ACCEPT RESPONSIBILITY FOR ALL DIMENSIONS AND CONDITIONS ON SITE AND MUST NOTIFY GRAZIANI+CORAZZA ARCHITECTS INC. OF ANY VARIATIONS FROM THE SUPPLIED INFORMATION. GRAZIANI+CORAZZA ARCHITECTS INC. IS NOT RESPONSIBLE FOR THE ACCURACY OF SURVEY, STRUCTURAL, MECHANICAL, ELECTRICAL, AND OTHER ENGINEERING INFORMATION SHOWN ON THIS DRAWING. REFER TO THE APPROPRIATE ENGINEERING DRAWINGS BEFORE PROCEEDING WITH THE WORK. CONSTRUCTION MUST CONFORM TO ALL APPLICABLE CODES AND REQUIREMENTS OF THE AUTHORITIES HAVING JURISDICTION. UNLESS OTHERWISE NOTED, NO INVESTIGATION HAS BEEN UNDERTAKEN OR REPORTED ON BY THIS OFFICE IN REGARD TO THE ENVIRONMENTAL CONDITION OF THIS SITE.

THIS DRAWING IS NOT TO BE SCALED. ALL ARCHITECTURAL SYMBOLS INDICATED ON THIS DRAWING ARE GRAPHIC REPRESENTATIONS ONLY.

CONDITIONS FOR ELECTRONIC INFORMATION TRANSFER:

ELECTRONIC INFORMATION IS SUPPLIED TO THE OTHER ASSOCIATED FIRMS TO ASSIST THEM IN THE EXECUTION OF THEIR WORK / REVIEW. THE RECIPIENT FIRMS MUST DETERMINE THE COMPLETENESS / APPROPRIATENESS / RELEVANCE OF THE INFORMATION IN RESPECT TO THEIR PARTICULAR RESPONSIBILITY.

GRAZIANI+CORAZZA ARCHITECTS INC. SHALL NOT BE RESPONSIBLE FOR:
1. ERRORS, OMISSIONS, INCOMPLETENESS DUE TO LOSS OF INFORMATION IN WHOLE OR PART WHEN INFORMATION IS TRANSFERRED.
2. TRANSMISSION OF ANY VIRUS OR DAMAGE TO THE RECEIVING ELECTRONIC SYSTEM WHEN INFORMATION IS TRANSFERRED.

01.	Oct.07.2019	issued for tender	
02.	Mar.13.2020	issued for design coordination #2	
03.	Mar.16.2020	issued for addendum #2	
04.	Mar.16.2020	issued for addendum #3	
05.	Aug.24.2020	issued for addendum #4	
06.	Sept. 28.2020	issued for permit	bg
07.	Oct.20.2020	issued for addendum #5	
08.	Nov.23.2020	issued for addendum #6	
09.	Dec.14.2020	issued for addendum #7	
10.	Jan.18.2021	issued for addendum #8	
11.	Mar. 2. 2021	issued for permit	bg
12.	Mar.09.2021	issued for addendum #9	
13.	Mar.10.2021	issued for addendum #9R	
14.	Mar.26.2021	issued for progress	
15.	May 14. 2021	issued for Site Instruction #1	
16.	June 15. 2021	issued for Site Instruction #2	
17.	July. 7. 2021	re-issued for permit	bg
18.	July. 15. 2021	Issued for Site Instruction #3	bg
19.	July. 27. 2021	Issued for Site Instruction #4	bg
20.	Aug. 3. 2021	Issued for Site Instruction #5	bg
21.	Aug. 18. 2021	Issued for Site Instruction #6	bg
22.	Aug. 20. 2021	Re-issued for permit.	bg
23.	Sept. 07. 2021	Issued for Site Instruction #7	bg
24.	Sept. 09. 2021	Issued for Site Instruction #8	bg
25.	Sept. 16. 2021	Issued for Building D Permit Revisions	bg
26.	Sept. 22. 2021	Issued for Site Instruction #9	bg
27.	Oct. 6. 2021	Re-issued for permit.	bg
28.	Oct. 8. 2021	Issued for Site Instruction #10	bg
30.	Oct. 28. 2021	Issued for Site Instruction #11	bg
31.	Nov. 05. 2021	Issued for Site Instruction #12	bg
32.	Dec. 3. 2021	Issued for Site Instruction #13	bg
33.	Dec. 6. 2021	Issued for Site Instruction #14	bg
34.	Dec. 7. 2021	Issued for Site Instruction #15	bg

01. Apr.19.2021 issued to client bg

issued for revisions

GRAZIANI + CORAZZA ARCHITECTS
1320 SHAWSON DRIVE, SUITE 100 MISSISSAUGA, ONTARIO L4W 1C3
T 905.790.2921 F 905.790.2644 WWW.GC-ARCHITECTS.COM

RESIDENTIAL

ATTMAR + PALLESCHI DRIVE

BRAMPTON ONTARIO

PROJECT ARCHITECT:	B.GRAZIANI
ASSISTANT DESIGNER:	R.LINCOLN
DRAWN BY:	G.C./F.C./M.B
CHECKED BY:	D.BIASE/G.COLANGELO
PLOT DATE:	DEC.13.2021
JOB #	1331.15

BUILDING SECTION

1:50 A505

TITLEBLOCK SIZE: 915 x 1200

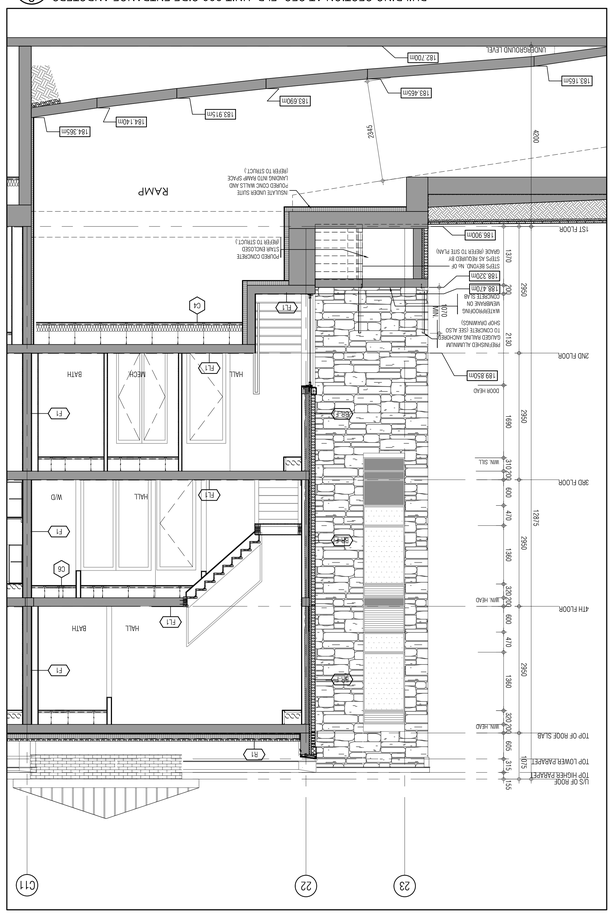

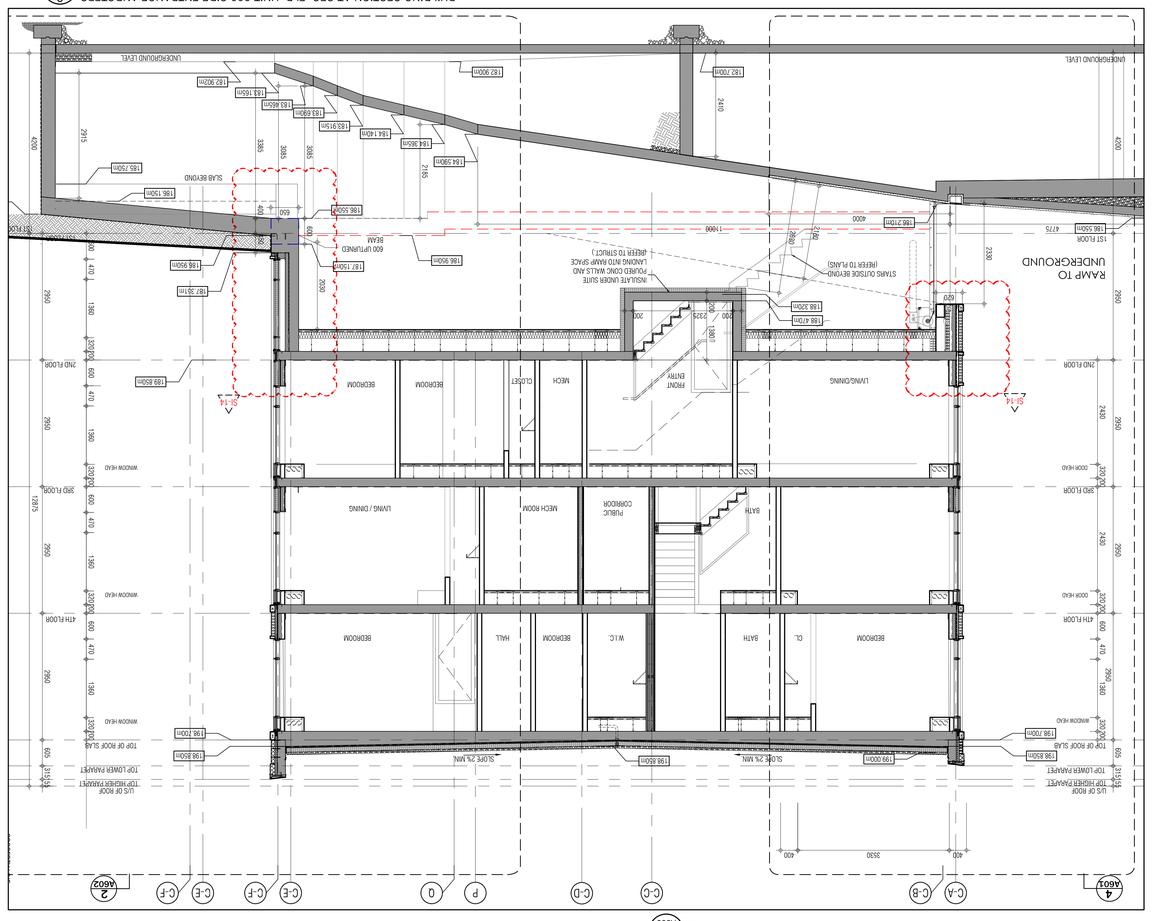

01.	Oct.07.2019	Issued for Master
02.	Mar.13.2020	Issued for design coordination #2
03.	Mar.16.2020	Issued for addendum #2
04.	Mar.16.2020	Issued for addendum #3
05.	Aug.24.2020	Issued for addendum #4
06.	Sept.28.2020	Issued for permit
07.	Oct.20.2020	Issued for addendum #5
08.	Nov.23.2020	Issued for addendum #6
09.	Dec.14.2020	Issued for addendum #7
10.	Jun.18.2021	Issued for addendum #8
11.	May. 2. 2021	Issued for permit
12.	Mar.09.2021	Issued for addendum #9
13.	Mar.10.2021	Issued for addendum #9R
14.	Mar.26.2021	Issued for progress
15.	May.14.2021	Issued for Site instruction #1
16.	June.15.2021	Issued for Site instruction #2
17.	July. 7. 2021	re-issued for permit
18.	July.15.2021	Issued for Site instruction #3
19.	July.27.2021	Issued for Site instruction #4
20.	Aug.3.2021	Issued for Site instruction #5
21.	Aug.18.2021	Issued for Site instruction #6
22.	Aug.20.2021	Re-issued for permit.
23.	Sept.07.2021	Issued for Site instruction #7
24.	Sept.09.2021	Issued for Site instruction #8
25.	Sept.16.2021	Issued for Building D Permit Revisions
26.	Sept.22.2021	Issued for Site instruction #9
27.	Oct.6.2021	Re-issued for permit.
28.	Oct.8.2021	Issued for Site instruction #10
30.	Oct.28.2021	Issued for Site instruction #11
31.	Nov.05.2021	Issued for Site instruction #12
32.	Dec.3.2021	Issued for Site instruction #13
33.	Dec.6.2021	Issued for Site instruction #14
34.	Dec.7.2021	Issued for Site instruction #15

Issued for revisions

01.	Apr.19.2021	Issued to client

GRAZIANI CORAZZA ARCHITECTS
1325 SHEPPARD AVENUE EAST, SUITE 100 MISSISSAUGA, ONTARIO L4W 1Z3
T 905.795.2601 F 905.795.2644 WWW.GC-ARCHITECTS.COM

RESIDENTIAL

ATTIMA + PALLESCHI DRIVE
BRAMPTON ONTARIO

PROJECT ARCHITECT: R.GRAZIANI
ASSISTANT DESIGNER: R.LINCOLN
DRAWN BY: G.L./F.C./M.B.
CHECKED BY: D.BLASE/G.COLANGELO
PLOT DATE: DEC.13.2021
JOB #: 1331.15

BUILDING SECTION

A506
1:50

TITLEBLOCK SIZE: 915 x 1200







THIS DRAWING AS AN INSTRUMENT OF SERVICE IS PROVIDED BY AND IS THE PROPERTY OF GRAZIANI+CORAZZA ARCHITECTS INC. THE CONTRACTOR MUST VERIFY AND ACCEPT RESPONSIBILITY FOR ALL DIMENSIONS AND CONDITIONS ON SITE AND MUST NOTIFY GRAZIANI+CORAZZA ARCHITECTS INC. OF ANY VARIATIONS FROM THE SPECIFIED INFORMATION. GRAZIANI+CORAZZA ARCHITECTS INC. IS NOT RESPONSIBLE FOR THE ACCURACY OR SUFFICIENCY OF STRUCTURAL, MECHANICAL, ELECTRICAL, AND OTHER ENGINEERING DRAWINGS SHOWN ON THIS DRAWING. THE WORK CONSTRUCTED MUST CONFORM TO ALL APPLICABLE CODES AND REGULATIONS OF THE MUNICIPALITY HAVING JURISDICTION. UNLESS OTHERWISE NOTED, NO ALTERATIONS HAS BEEN UNDERTAKEN OR REPORTED ON BY THIS OFFICE IN REGARDS TO THE ENVIRONMENTAL CONDITION OF THIS SITE.

CONTRACTORS FOR ELECTRONIC INFORMATION TRANSFERS

THIS DRAWING IS NOT TO BE SCALED. ALL ARCHITECTURAL DRAWINGS INDICATED ON THIS DRAWING ARE GRAPHIC REPRESENTATIONS ONLY.

1. DRAWING INFORMATION IS SUPPLIED TO THE OTHER ASSOCIATED PARTIES TO ASSIST THEM IN THE EXECUTION OF THEIR WORK / DUTIES. THE RECIPIENT PARTIES MUST DETERMINE THE CONSTRUCTION / APPROPRIATENESS / SUITABILITY OF THE INFORMATION IN RESPECT TO THEIR SPECIFIC APPLICATIONS.

GRAZIANI+CORAZZA ARCHITECTS INC. SHALL NOT BE RESPONSIBLE FOR ERRORS, OMISSIONS, INCONSISTENCIES DUE TO LOSS OF INFORMATION IN WHOLE OR PART WHEN INFORMATION IS TRANSFERRED.

2. TRANSMISSION OF ANY INPUT OR DAMAGE TO THE RESPECTIVE ELECTRONIC SYSTEM WHEN INFORMATION IS TRANSFERRED.

01.	Apr.19.2021	Issued to client

Issued for revisions

01.	Oct.07.2019	Issued for tender
02.	Mar.13.2020	Issued for design coordination # 2
03.	Mar.16.2020	Issued for addendum # 2
04.	Mar.16.2020	Issued for addendum # 3
05.	Apr.24.2020	Issued for addendum # 4
06.	Sept. 28.2020	Issued for permit
07.	Oct.23.2020	Issued for addendum # 5
08.	Nov.23.2020	Issued for addendum # 6
09.	Dec.14.2020	Issued for addendum # 7
10.	Jan.18.2021	Issued for addendum # 8
11.	Mar. 2. 2021	Issued for permit
12.	Mar.09.2021	Issued for addendum # 9
13.	Mar.10.2021	Issued for addendum # 9R
14.	Mar.26.2021	Issued for progress
15.	May.14.2021	Issued for addendum # 1
16.	June.15.2021	Issued for Site Instruction # 2
17.	July. 7. 2021	re-issued for permit
18.	July.15.2021	Issued for Site Instruction # 3
19.	July.27.2021	Issued for Site Instruction # 4
20.	Aug. 3.2021	Issued for Site Instruction # 5
21.	Aug.18.2021	Issued for Site Instruction # 6
22.	Aug.20.2021	Re-issued for permit.
23.	Sept. 07.2021	Issued for Site Instruction # 7
24.	Sept. 09.2021	Issued for Site Instruction # 8
25.	Sept. 16.2021	Issued for Building D Permit Revisions
26.	Sept. 22.2021	Issued for Site Instruction # 9
27.	Oct. 6. 2021	Re-issued for permit.
28.	Oct. 8. 2021	Issued for Site Instruction # 10
29.	Oct. 28.2021	Issued for Site Instruction # 11
30.	Nov. 05. 2021	Issued for Site Instruction # 12
31.	Dec. 3. 2021	Issued for Site Instruction # 13
32.	Dec. 3.2021	Issued for Site Instruction # 13
33.	Dec. 6. 2021	Issued for Site Instruction # 14
34.	Dec. 7. 2021	Issued for Site Instruction # 15

GRAZIANI
CORAZZA
ARCHITECTS
1323 CHARDON ROAD, SUITE 100 MISSISSAUGA, ONTARIO L4W 1C3
T 905.795.9494 F 905.795.9494 WWW.GC-ARCHITECTS.COM

RESIDENTIAL

RAMPTON
ATTMAR + FALLECCHI DRIVE
ONTARIO

PROJECT ARCHITECT:	R.GRAZIANI
ASSISTANT DESIGNER:	R.LINCOLN
DRAWN BY:	G.C.F.C.M.B
CHECKED BY:	D.BIASE/G.COLANGELO
PLOT DATE:	DEC.13.2021
JOB #	1331.1.5

WALL SECTIONS

1:25 A601

TITLEBLOCK SIZE: 915 x 1200

WALL SECTION 1 — A601 — 1:25

WALL SECTION 2 — A601 — 1:25

WALL SECTION 3 — A601 — 1:25

WALL SECTION 4 — A601 — 1:25

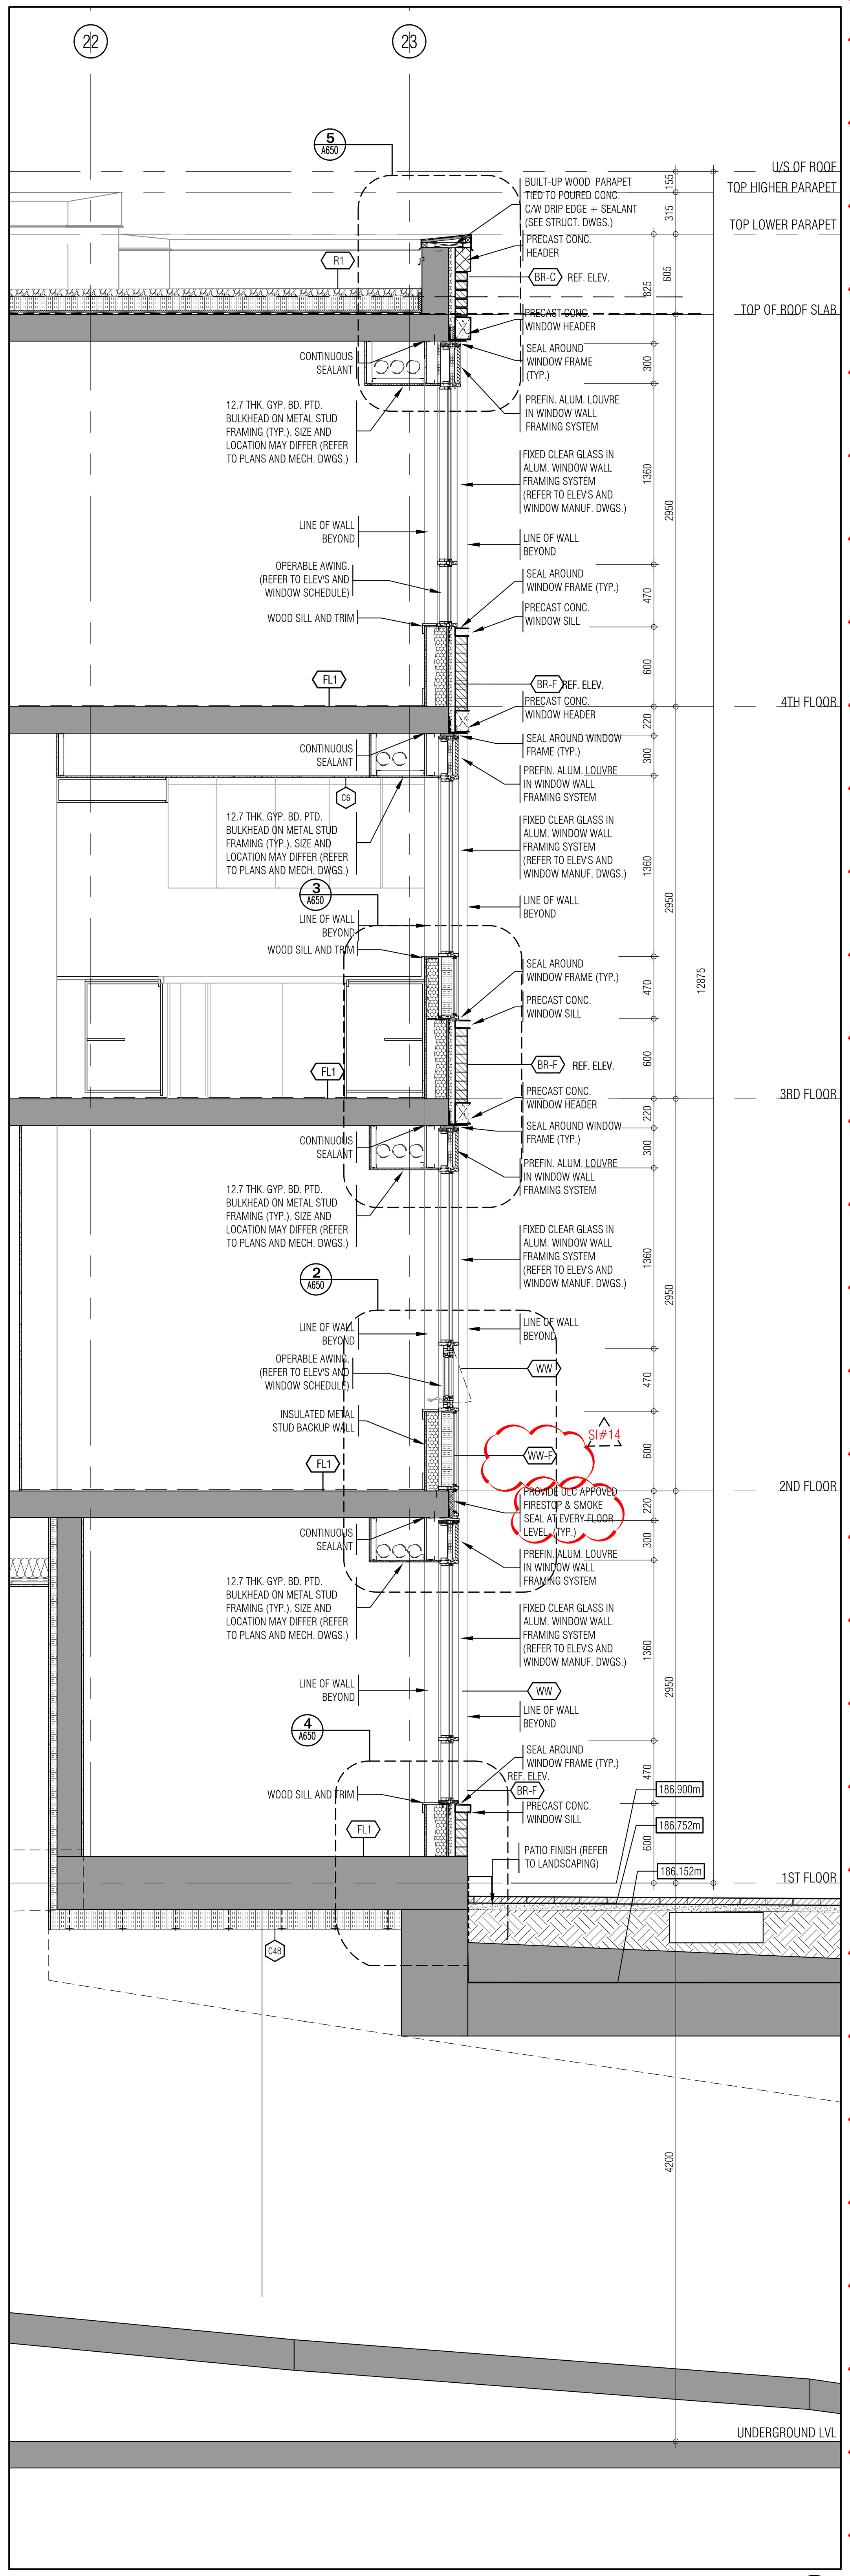

WALL SECTION 4 A602
1:25

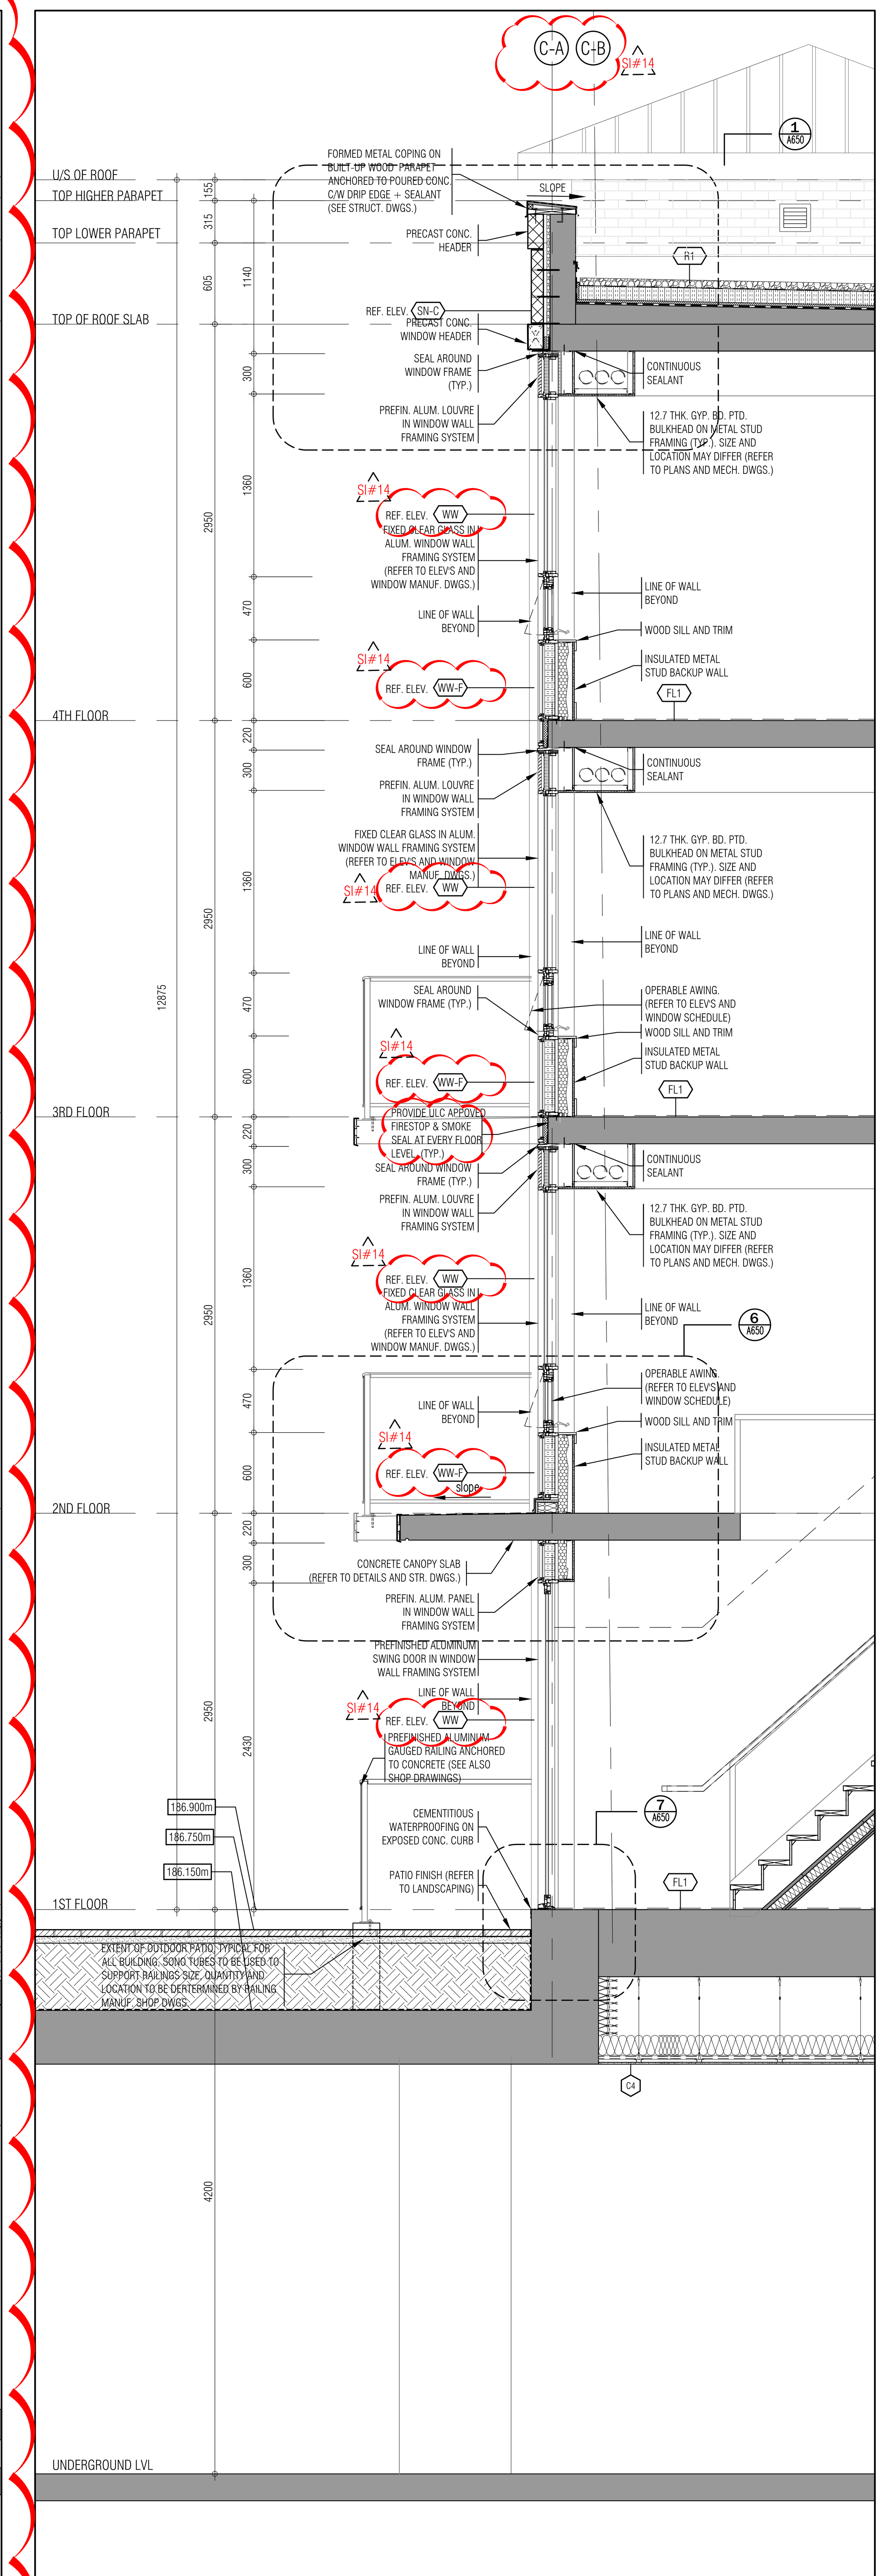

WALL SECTION 3 A602
1:25

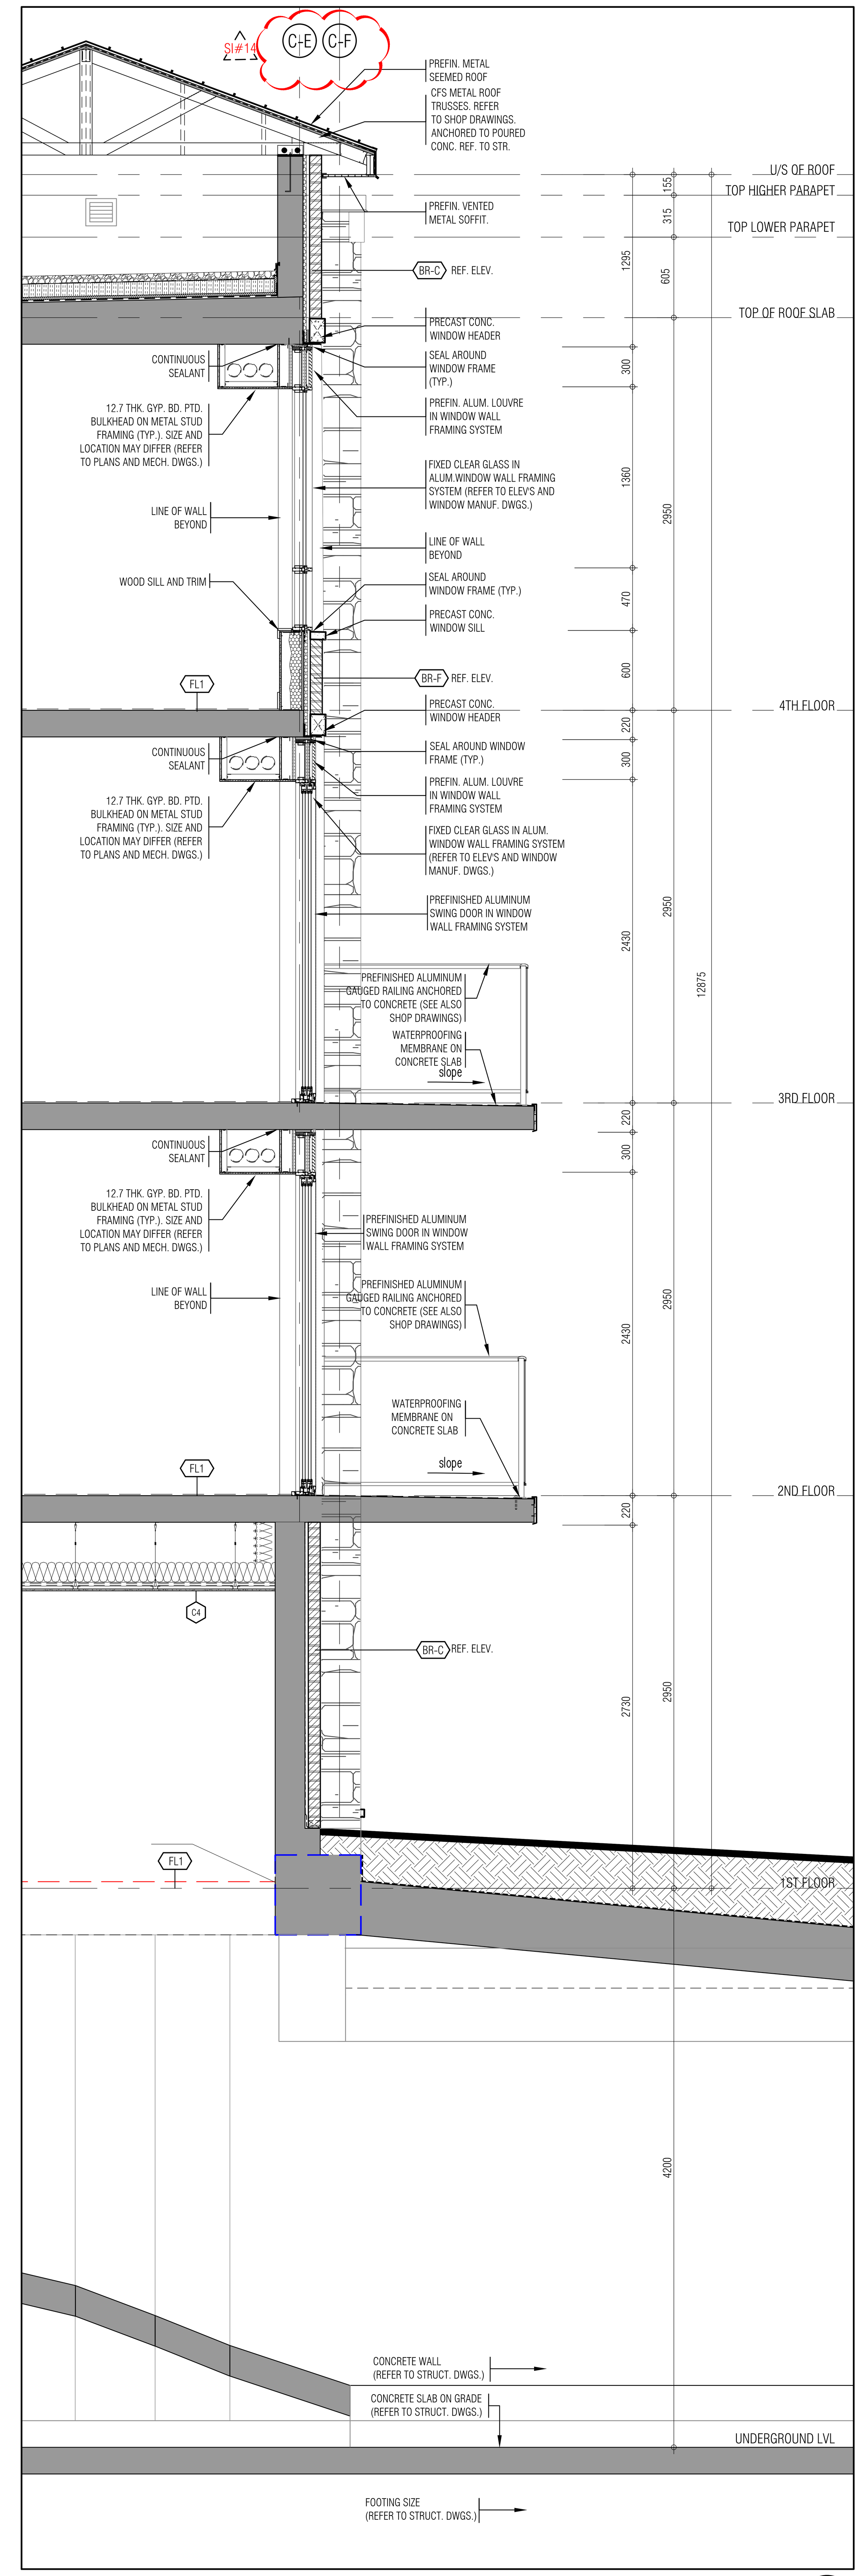

WALL SECTION 2 A602
1:25

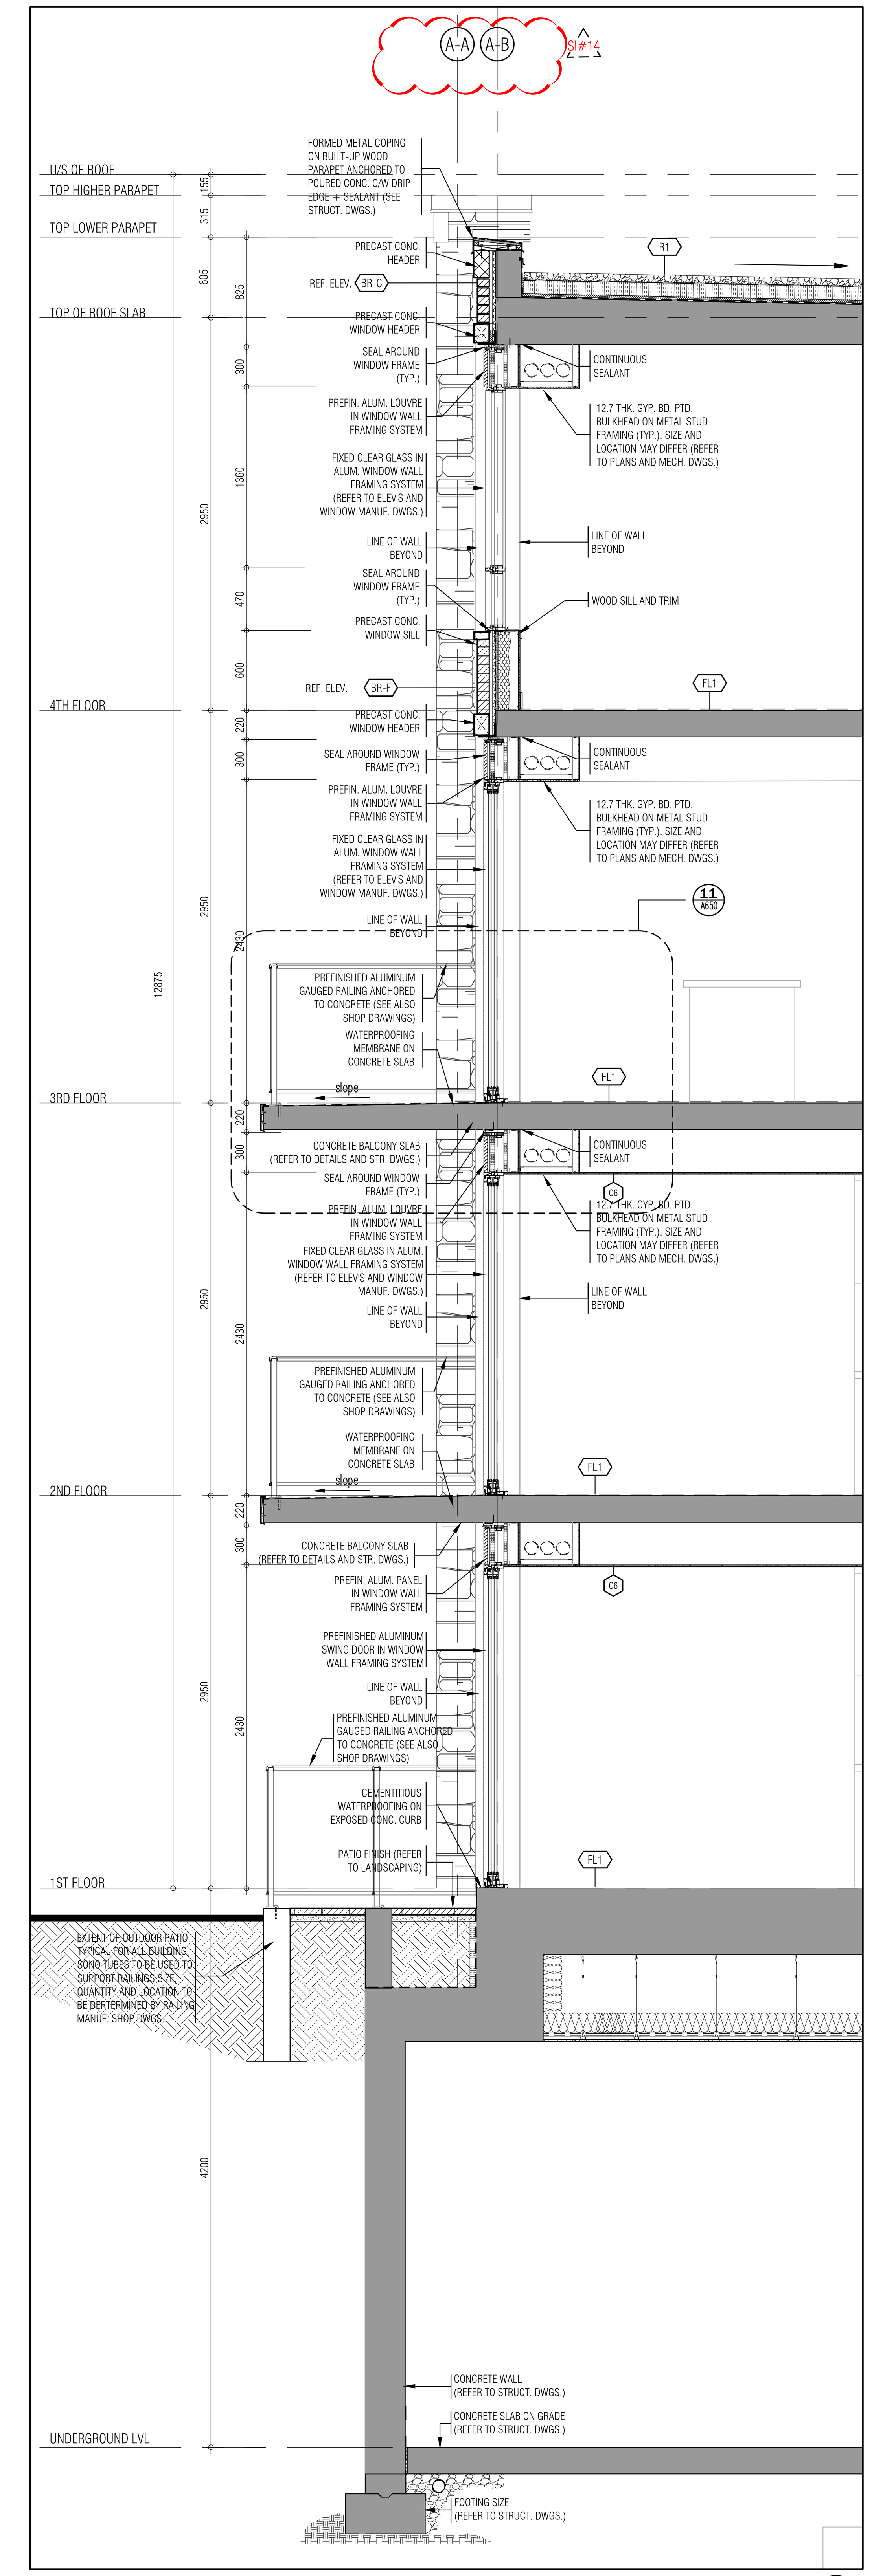

WALL SECTION 1 A602
1:25

THIS DRAWING, AS AN INSTRUMENT OF SERVICE, IS PROVIDED BY AND IS THE PROPERTY OF GRAZIANI+CORAZZA ARCHITECTS INC. THE CONTRACTOR MUST VERIFY AND ACCEPT RESPONSIBILITY FOR ALL DIMENSIONS AND CONDITIONS ON SITE AND MUST NOTIFY GRAZIANI+CORAZZA ARCHITECTS INC. OF ANY VARIATIONS FROM THE SUPPLIED INFORMATION. GRAZIANI+CORAZZA ARCHITECTS INC. IS NOT RESPONSIBLE FOR THE ACCURACY OF SURVEY, STRUCTURAL, MECHANICAL, ELECTRICAL, AND OTHER ENGINEERING INFORMATION SHOWN ON THIS DRAWING. REFER TO THE APPROPRIATE ENGINEERING DRAWINGS BEFORE PROCEEDING WITH THE WORK. CONSTRUCTION MUST CONFORM TO ALL APPLICABLE CODES AND REQUIREMENTS OF THE AUTHORITIES HAVING JURISDICTION. UNLESS OTHERWISE NOTED, NO INVESTIGATION HAS BEEN UNDERTAKEN OR REPORTED ON BY THIS OFFICE IN REGARDS TO THE ENVIRONMENTAL CONDITION OF THIS SITE.

THIS DRAWING IS NOT TO BE SCALED. ALL ARCHITECTURAL SYMBOLS INDICATED ON THIS DRAWING ARE GRAPHIC REPRESENTATIONS ONLY.

CONDITIONS FOR ELECTRONIC INFORMATION TRANSFER:

ELECTRONIC INFORMATION IS SUPPLIED TO THE OTHER ASSOCIATED FIRMS TO ASSIST THEM IN THE EXECUTION OF THEIR WORK / REVIEW. THE RECIPIENT FIRMS MUST DETERMINE THE COMPLETENESS / APPROPRIATENESS / RELEVANCE OF THE INFORMATION IN RESPECT TO THEIR PARTICULAR RESPONSIBILITY.

GRAZIANI+CORAZZA ARCHITECTS INC. SHALL NOT BE RESPONSIBLE FOR:
1. ERRORS, OMISSIONS, INCOMPLETENESS DUE TO LOSS OF INFORMATION IN WHOLE OR PART WHEN INFORMATION IS TRANSFERRED.
2. TRANSMISSION OF ANY VIRUS OR DAMAGE TO THE RECEIVING ELECTRONIC SYSTEM WHEN INFORMATION IS TRANSFERRED.

01.	Oct.07.2019	issued for tender	_
02.	Mar.13.2020	issued for design coordination #2	_
03.	Mar.16.2020	issued for addendum #2	_
04.	Mar.16.2020	issued for addendum #3	_
05.	Aug.24.2020	issued for addendum #4	_
06.	Sept. 28.2020	issued for permit	bg
07.	Oct.20.2020	issued for addendum #5	_
08.	Nov.23.2020	issued for addendum #6	_
09.	Dec.14.2020	issued for addendum #7	_
10.	Jan.18.2021	issued for addendum #8	_
11.	Mar. 2. 2021	issued for permit	bg
12.	Mar.09.2021	issued for addendum #9	_
13.	Mar.10.2021	issued for addendum #9R	_
14.	Mar.26.2021	issued for progress	_
15.	May 14. 2021	issued for Site Instruction #1	_
16.	June 15. 2021	issued for Site Instruction #2	_
17.	July. 7. 2021	re-issued for permit	bg
18.	July. 15. 2021	Issued for Site Instruction #3	bg
19.	July. 27. 2021	Issued for Site Instruction #4	bg
20.	Aug. 3. 2021	Issued for Site Instruction #5	bg
21.	Aug. 18. 2021	Issued for Site Instruction #6	bg
22.	Aug. 20. 2021	Re-issued for permit.	bg
23.	Sept. 07. 2021	Issued for Site Instruction #7	bg
24.	Sept. 09. 2021	Issued for Site Instruction #8	bg
25.	Sept. 16. 2021	Issued for Building D Permit Revisions	bg
26.	Sept. 22. 2021	Issued for Site Instruction #9	bg
27.	Oct. 6. 2021	Re-issued for permit.	bg
28.	Oct. 8. 2021	Issued for Site Instruction #10	bg
30.	Oct. 28. 2021	Issued for Site Instruction #11	bg
31.	Nov. 05. 2021	Issued for Site Instruction #12	bg
32.	Dec. 3. 2021	Issued for Site Instruction #13	bg
33.	Dec. 6. 2021	Issued for Site Instruction #14	bg
34.	Dec. 7. 2021	Issued for Site Instruction #15	bg

01.	Apr.19.2021	issued to client	bg

issued for revisions

GRAZIANI + CORAZZA ARCHITECTS
1320 SHAWSON DRIVE, SUITE 100 MISSISSAUGA, ONTARIO L4W 1C3
T.905.795.2601 F.905.795.2844 WWW.GC-ARCHITECTS.COM

RESIDENTIAL

ATTMAR + PALLESCHI DRIVE
BRAMPTON ONTARIO

PROJECT ARCHITECT:	B.GRAZIANI
ASSISTANT DESIGNER:	R.LINCOLN
DRAWN BY:	G.C/F.C/M.B
CHECKED BY:	D.BIASE/G.COLANGELO
PLOT DATE:	DEC.13.2021
JOB #	1331.15

WALL SECTIONS

1:25 A602

TITLEBLOCK SIZE: 915 x 1200

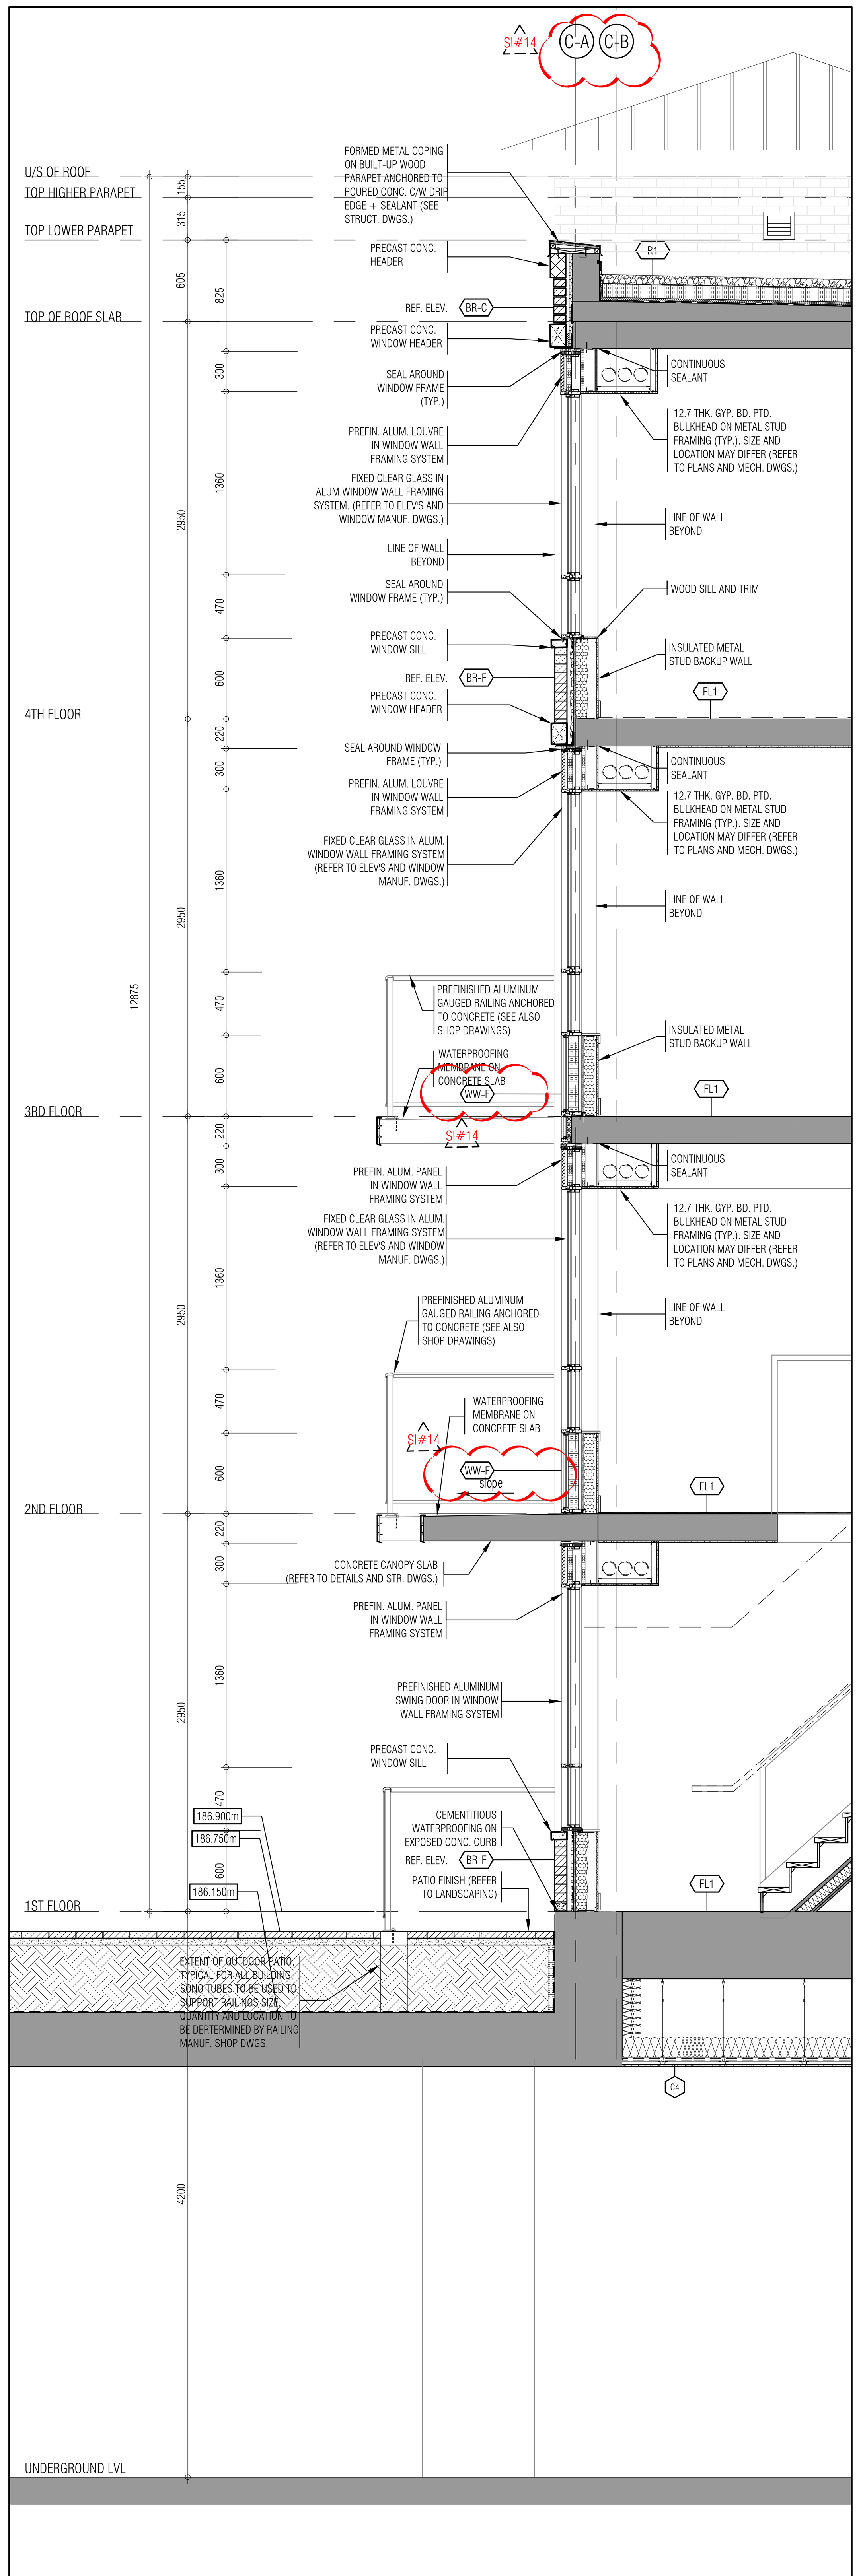

WALL SECTION 3
1:25 A603

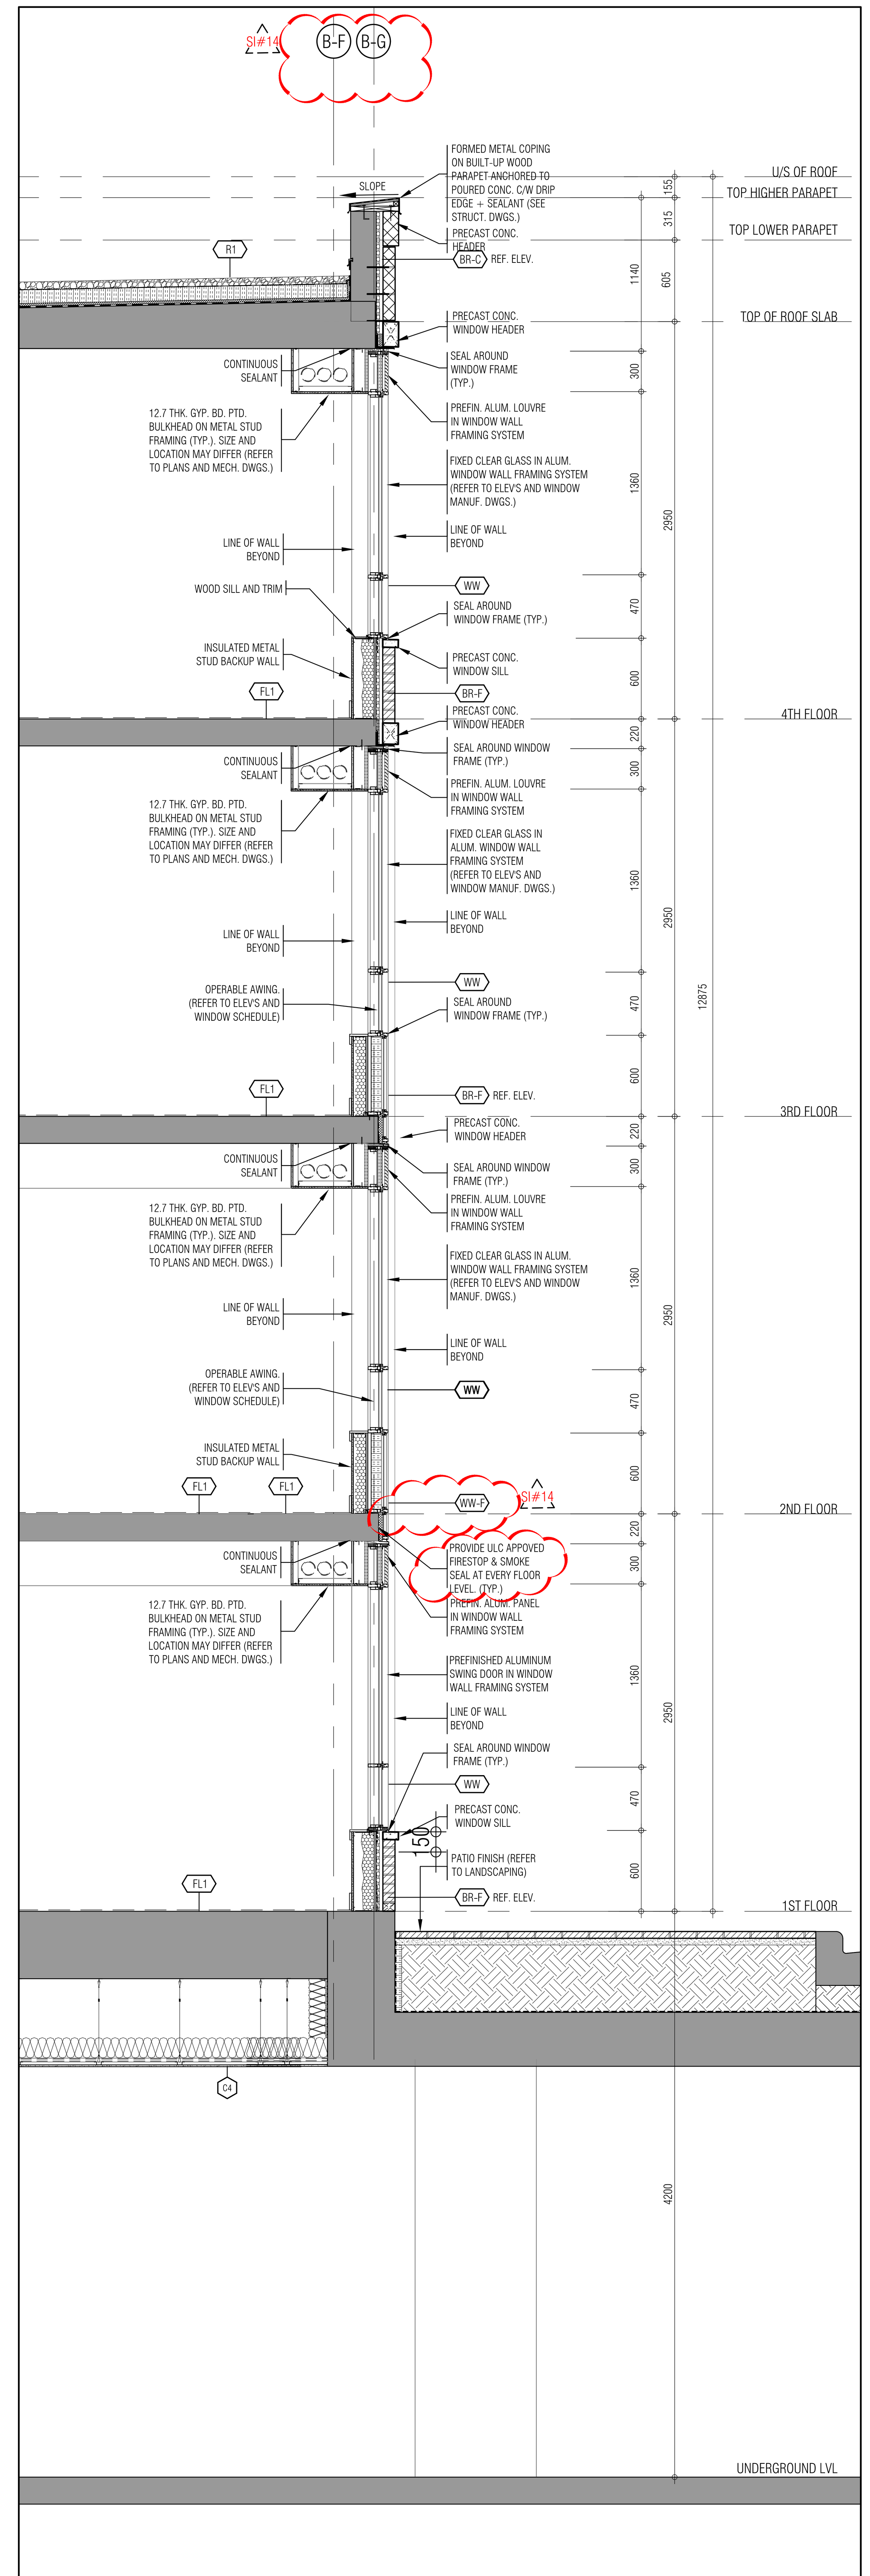

WALL SECTION 2
1:25 A603

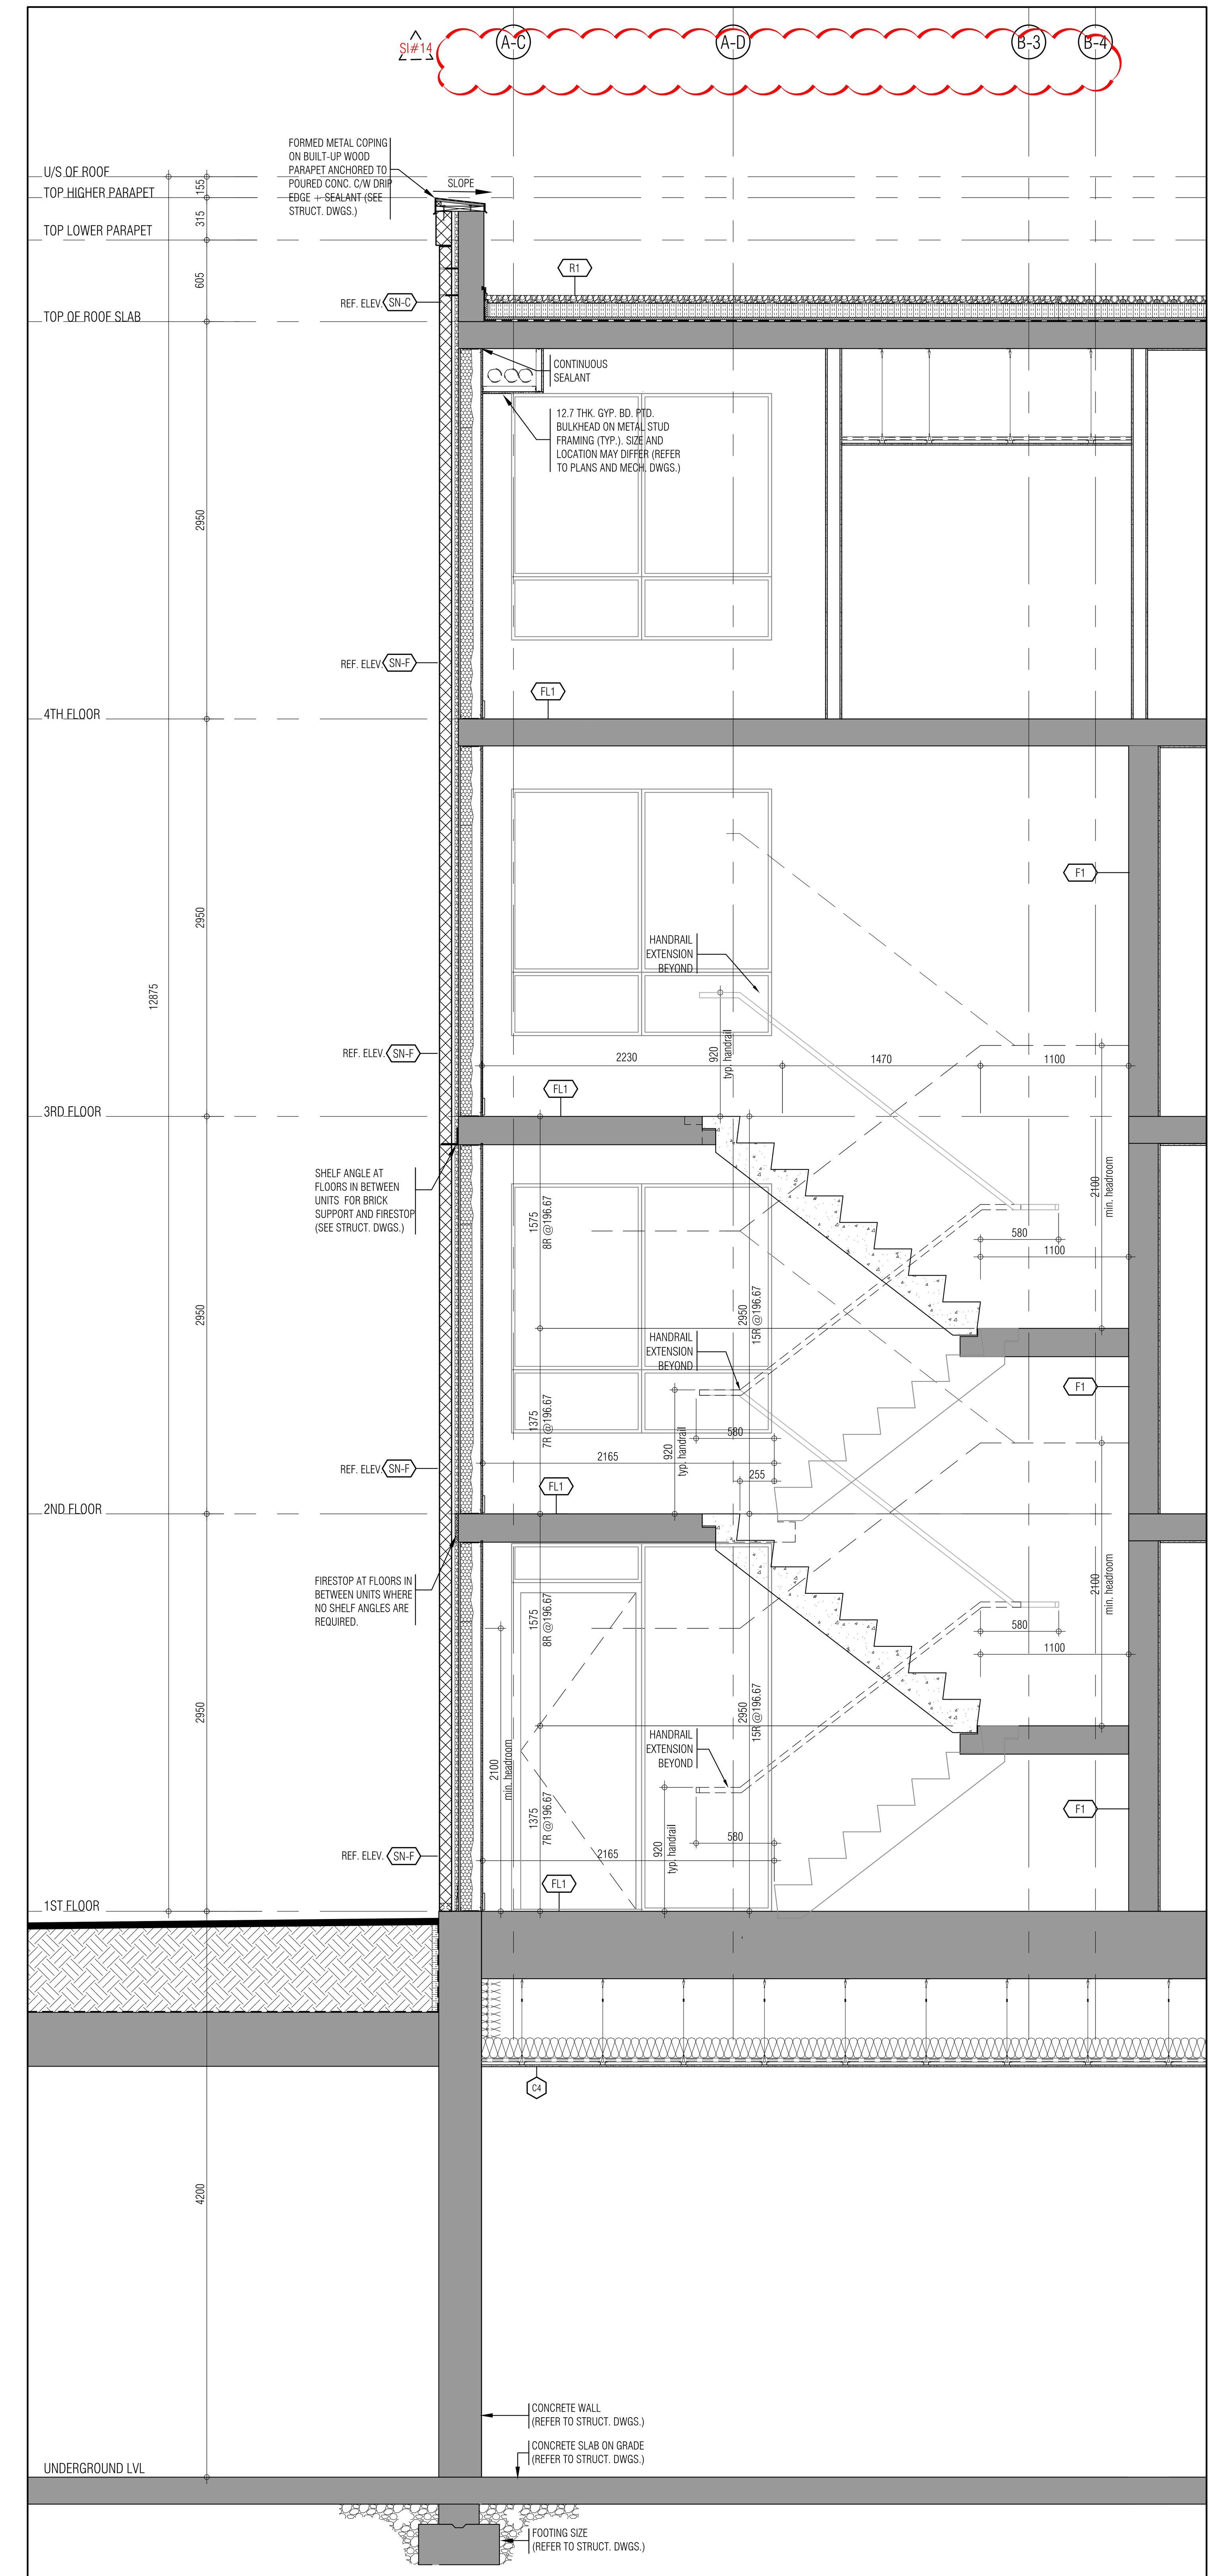

WALL SECTION 1
1:25 A603

THIS DRAWING, AS AN INSTRUMENT OF SERVICE, IS PROVIDED BY AND IS THE PROPERTY OF GRAZIANI+CORAZZA ARCHITECTS INC. THE CONTRACTOR MUST VERIFY AND ACCEPT RESPONSIBILITY FOR ALL DIMENSIONS AND CONDITIONS ON SITE AND MUST NOTIFY GRAZIANI+CORAZZA ARCHITECTS INC. OF ANY VARIATIONS FROM THE SUPPLIED INFORMATION. GRAZIANI+CORAZZA ARCHITECTS INC. IS NOT RESPONSIBLE FOR THE ACCURACY OF SURVEY, STRUCTURAL, MECHANICAL, ELECTRICAL, AND OTHER ENGINEERING INFORMATION SHOWN ON THIS DRAWING. REFER TO THE APPROPRIATE ENGINEERING DRAWINGS BEFORE PROCEEDING WITH THE WORK. CONSTRUCTION MUST CONFORM TO ALL APPLICABLE CODES AND REQUIREMENTS OF THE AUTHORITIES HAVING JURISDICTION. UNLESS OTHERWISE NOTED, NO INVESTIGATION HAS BEEN UNDERTAKEN OR REPORTED ON BY THIS OFFICE IN REGARDS TO THE ENVIRONMENTAL CONDITION OF THIS SITE.

THIS DRAWING IS NOT TO BE SCALED. ALL ARCHITECTURAL SYMBOLS INDICATED ON THIS DRAWING ARE GRAPHIC REPRESENTATIONS ONLY.

CONDITIONS FOR ELECTRONIC INFORMATION TRANSFER:

ELECTRONIC INFORMATION IS SUPPLIED TO THE OTHER ASSOCIATED FIRMS TO ASSIST THEM IN THE EXECUTION OF THEIR WORK / REVIEW. THE RECIPIENT FIRMS MUST DETERMINE THE COMPLETENESS / APPROPRIATENESS / RELEVANCE OF THE INFORMATION IN RESPECT TO THEIR PARTICULAR RESPONSIBILITY.

GRAZIANI+CORAZZA ARCHITECTS INC. SHALL NOT BE RESPONSIBLE FOR:
1. ERRORS, OMISSIONS, INCOMPLETENESS DUE TO LOSS OF INFORMATION IN WHOLE OR PART WHEN INFORMATION IS TRANSFERRED.
2. TRANSMISSION OF ANY VIRUS OR DAMAGE TO THE RECEIVING ELECTRONIC SYSTEM WHEN INFORMATION IS TRANSFERRED.

01.	Oct.07.2019	issued for tender	_
02.	Mar.13.2020	issued for design coordination #2	_
03.	Mar.16.2020	issued for addendum #2	_
04.	Mar.16.2020	issued for addendum #3	_
05.	Aug.24.2020	issued for addendum #4	_
06.	Sept. 28.2020	issued for permit	bg
07.	Oct.20.2020	issued for addendum #5	_
08.	Nov.23.2020	issued for addendum #6	_
09.	Dec.14.2020	issued for addendum #7	_
10.	Jan.18.2021	issued for addendum #8	_
11.	Mar. 2. 2021	issued for permit	bg
12.	Mar.09.2021	issued for addendum #9	_
13.	Mar.10.2021	issued for addendum #9R	_
14.	Mar.26.2021	issued for progress	_
15.	May 14. 2021	issued for Site Instruction #1	_
16.	June 15. 2021	issued for Site Instruction #2	_
17.	July. 7. 2021	re-issued for permit	bg
18.	July. 15. 2021	Issued for Site Instruction #3	bg
19.	July. 27. 2021	Issued for Site Instruction #4	bg
20.	Aug. 3. 2021	Issued for Site Instruction #5	bg
21.	Aug. 18. 2021	Issued for Site Instruction #6	bg
22.	Aug. 20. 2021	Re-issued for permit.	bg
23.	Sept. 07. 2021	Issued for Site Instruction #7	bg
24.	Sept. 09. 2021	Issued for Site Instruction #8	bg
25.	Sept. 16. 2021	Issued for Building D Permit Revisions	bg
26.	Sept. 22. 2021	Issued for Site Instruction #9	bg
27.	Oct. 6. 2021	Re-issued for permit.	bg
28.	Oct. 8. 2021	Issued for Site Instruction #10	bg
30.	Oct. 28. 2021	Issued for Site Instruction #11	bg
31.	Nov. 05. 2021	Issued for Site Instruction #12	bg
32.	Dec. 3. 2021	Issued for Site Instruction #13	bg
33.	Dec. 6. 2021	Issued for Site Instruction #14	bg
34.	Dec. 7. 2021	Issued for Site Instruction #15	bg

01.	Apr.19.2021	issued to client	bg

issued for revisions

GRAZIANI + CORAZZA ARCHITECTS
1320 SHAWSON DRIVE, SUITE 100 MISSISSAUGA, ONTARIO L4W 1C3
T.905.795.2601 F.905.795.2844 WWW.GC-ARCHITECTS.COM

RESIDENTIAL

ATTMAR + PALLESCHI DRIVE
BRAMPTON ONTARIO

PROJECT ARCHITECT:	B.GRAZIANI
ASSISTANT DESIGNER:	R.LINCOLN
DRAWN BY:	G.C/F.C/M.B
CHECKED BY:	D.BIASE/G.COLANGELO
PLOT DATE:	DEC.13.2021
JOB #	1331.15

WALL SECTIONS

1:25 A603

TITLEBLOCK SIZE: 915 x 1200

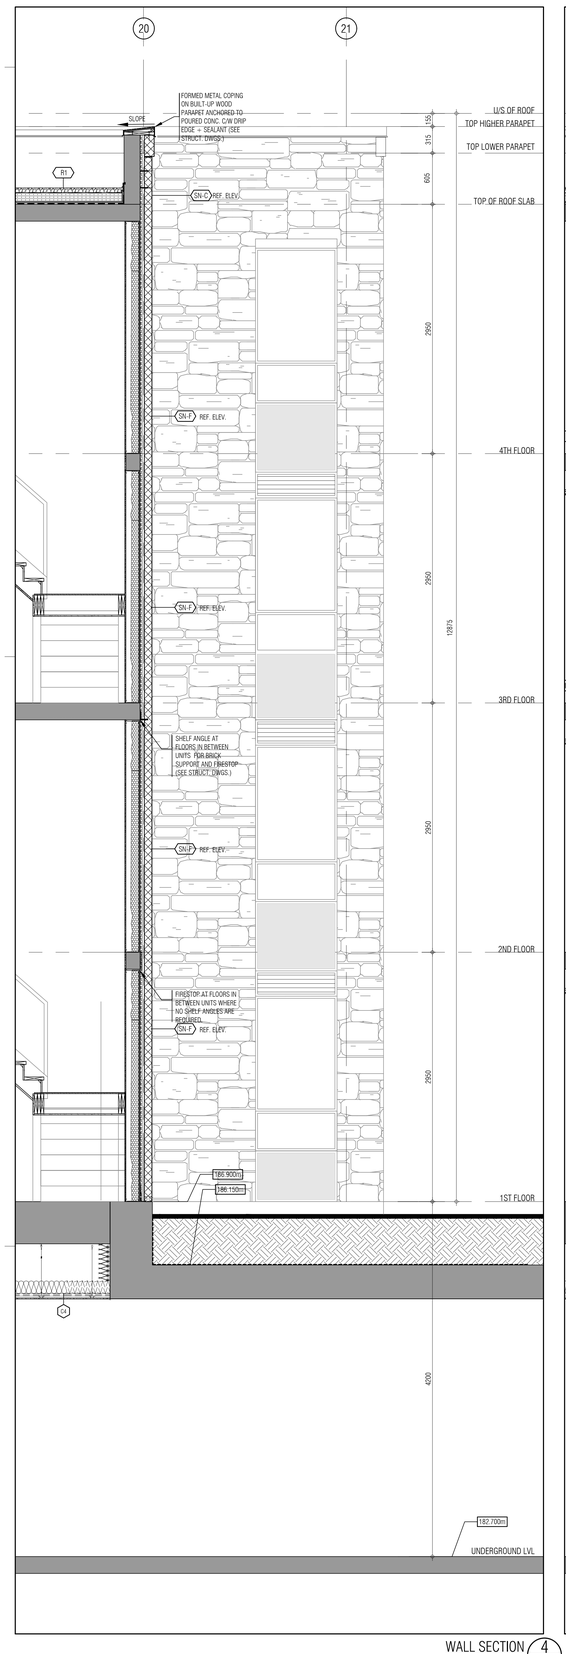

WALL SECTION 4 — 1:25 — A604

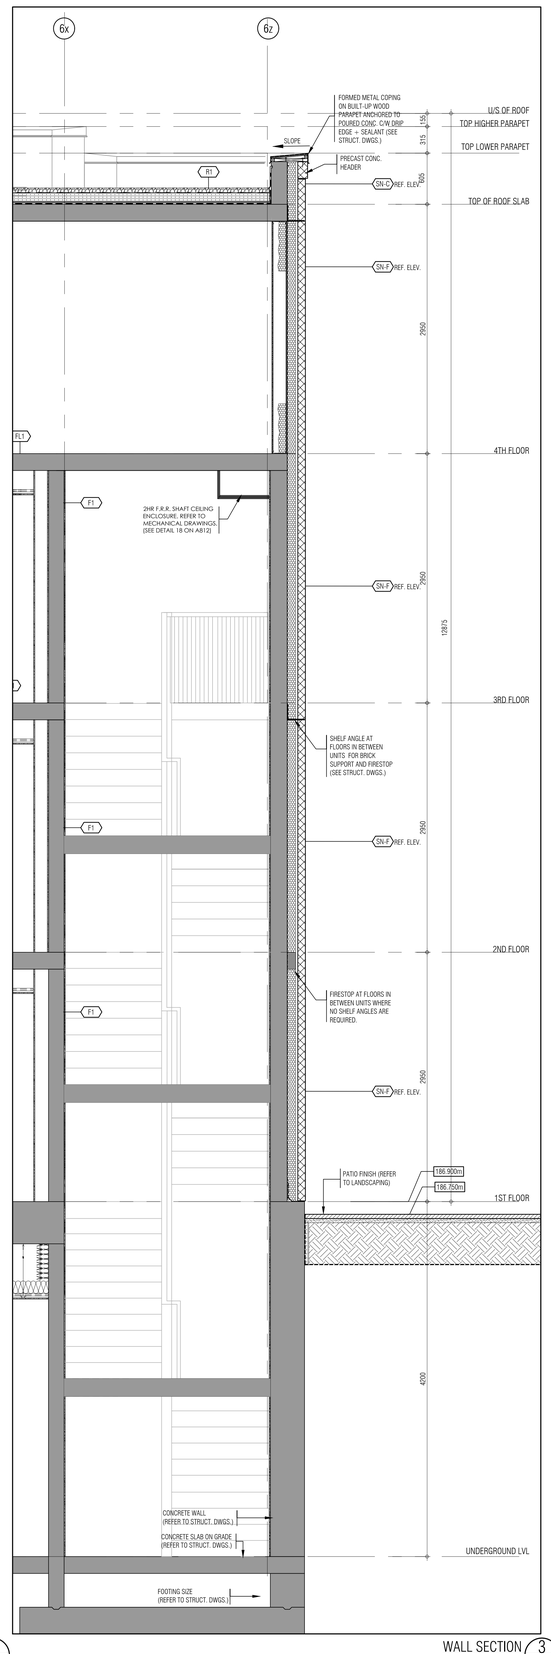

WALL SECTION 3 — 1:25 — A604

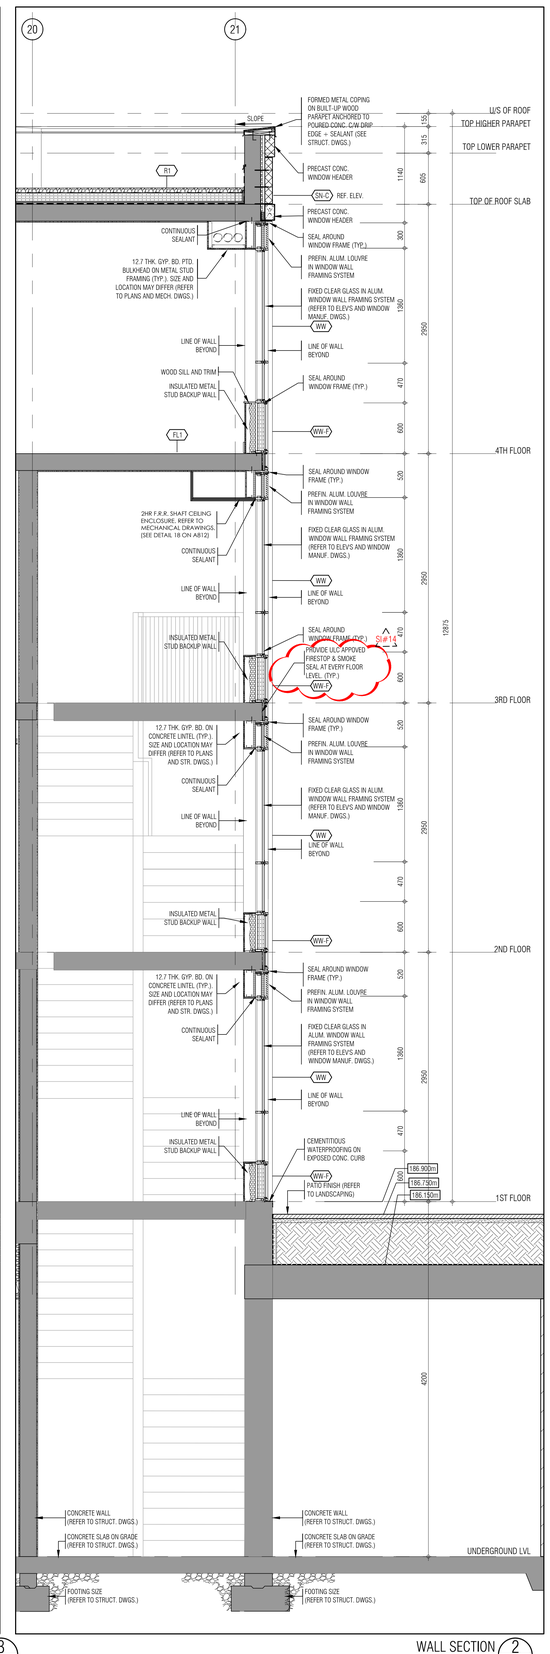

WALL SECTION 2 — 1:25 — A604

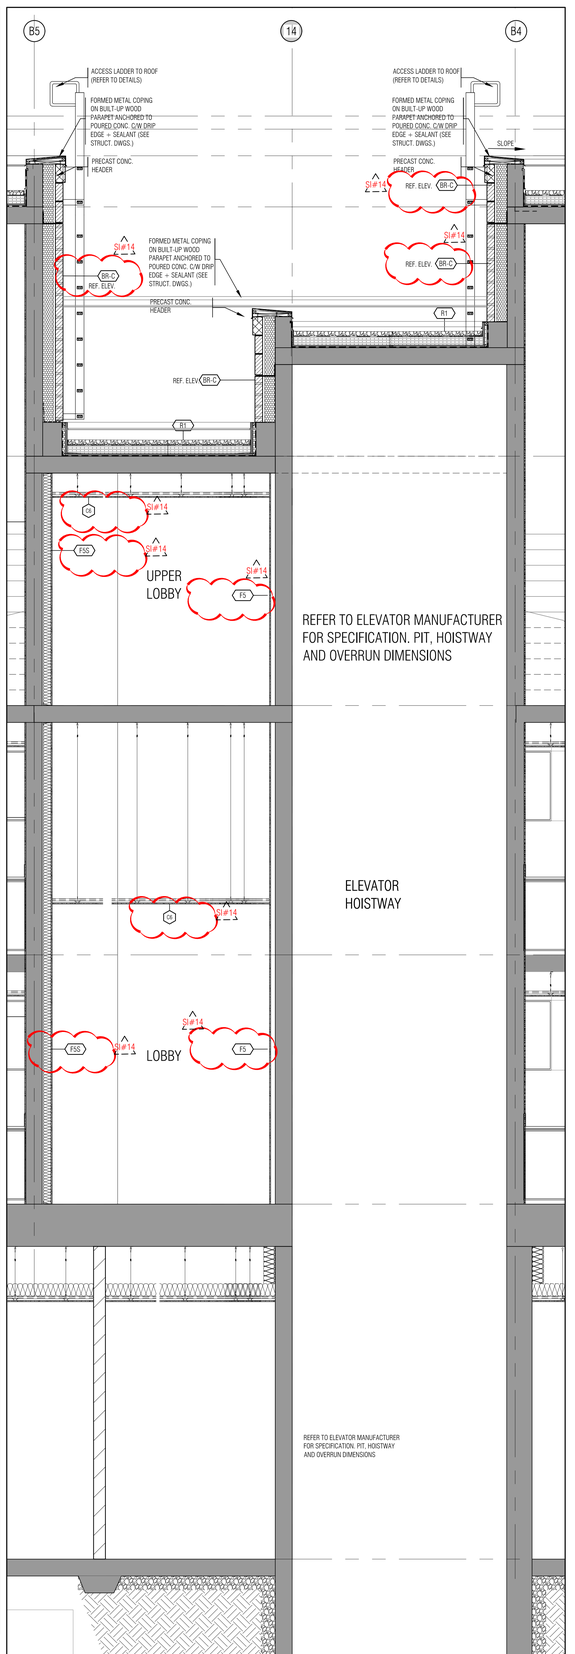

WALL SECTION 1 — 1:25 — A604

THIS DRAWING, AS AN INSTRUMENT OF SERVICE, IS PROVIDED BY AND IS THE PROPERTY OF GRAZIANI+CORAZZA ARCHITECTS INC. THE CONTRACTOR MUST VERIFY AND ACCEPT RESPONSIBILITY FOR ALL DIMENSIONS AND CONDITIONS ON SITE AND MUST NOTIFY GRAZIANI+CORAZZA ARCHITECTS INC. OF ANY VARIATIONS FROM THE SUPPLIED INFORMATION. GRAZIANI+CORAZZA ARCHITECTS INC. IS NOT RESPONSIBLE FOR THE ACCURACY OF SURVEY, STRUCTURAL, MECHANICAL, ELECTRICAL, AND OTHER ENGINEERING INFORMATION SHOWN ON THIS DRAWING. REFER TO THE APPROPRIATE ENGINEERING DRAWINGS BEFORE PROCEEDING WITH THE WORK. CONSTRUCTION MUST CONFORM TO ALL APPLICABLE CODES AND REQUIREMENTS OF THE AUTHORITIES HAVING JURISDICTION. UNLESS OTHERWISE NOTED, NO INVESTIGATION HAS BEEN UNDERTAKEN OR REPORTED ON BY THIS OFFICE IN REGARDS TO THE ENVIRONMENTAL CONDITION OF THIS SITE.

THIS DRAWING IS NOT TO BE SCALED. ALL ARCHITECTURAL SYMBOLS INDICATED ON THIS DRAWING ARE GRAPHIC REPRESENTATIONS ONLY.

CONDITIONS FOR ELECTRONIC INFORMATION TRANSFER:

ELECTRONIC INFORMATION IS SUPPLIED TO THE OTHER ASSOCIATED FIRMS TO ASSIST THEM IN THE EXECUTION OF THEIR WORK / REVIEW. THE RECIPIENT FIRMS MUST DETERMINE THE COMPLETENESS / APPROPRIATENESS / RELEVANCE OF THE INFORMATION IN RESPECT TO THEIR PARTICULAR RESPONSIBILITY.

GRAZIANI + CORAZZA ARCHITECTS INC. SHALL NOT BE RESPONSIBLE FOR:
1. ERRORS, OMISSIONS, INCOMPLETNESS DUE TO LOSS OF INFORMATION IN WHOLE OR PART WHEN INFORMATION IS TRANSFERRED.
2. TRANSMISSION OF ANY VIRUS OR DAMAGE TO THE RECEIVING ELECTRONIC SYSTEM WHEN INFORMATION IS TRANSFERRED.

01.	Oct.07.2019	issued for tender	___
02.	Mar.13.2020	issued for design coordination #2	___
03.	Mar.16.2020	issued for addendum #2	___
04.	Mar.16.2020	issued for addendum #3	___
05.	Aug.24.2020	issued for addendum #4	___
06.	Sept. 28.2020	issued for permit	bg
07.	Oct.20.2020	issued for addendum #5	___
08.	Nov.23.2020	issued for addendum #6	___
09.	Dec.14.2020	issued for addendum #7	___
10.	Jan.18.2021	issued for addendum #8	___
11.	Mar. 2. 2021	issued for permit	bg
12.	Mar.09.2021	issued for addendum #9	___
13.	Mar.10.2021	issued for addendum #9R	___
14.	Mar.26.2021	issued for progress	___
15.	May 14. 2021	issued for Site Instruction #1	___
16.	June 15. 2021	issued for Site Instruction #2	___
17.	July. 7. 2021	re-issued for permit	bg
18.	July. 15. 2021	Issued for Site Instruction #3	bg
19.	July. 27. 2021	Issued for Site Instruction #4	bg
20.	Aug. 3. 2021	Issued for Site Instruction #5	bg
21.	Aug. 18. 2021	Issued for Site Instruction #6	bg
22.	Aug. 20. 2021	Re-issued for permit.	bg
23.	Sept. 07. 2021	Issued for Site Instruction #7	bg
24.	Sept. 09. 2021	Issued for Site Instruction #8	bg
25.	Sept. 16. 2021	Issued for Building D Permit Revisions	bg
26.	Sept. 22. 2021	Issued for Site Instruction #9	bg
27.	Oct. 6. 2021	Re-issued for permit.	bg
28.	Oct. 8. 2021	Issued for Site Instruction #10	bg
30.	Oct. 28. 2021	Issued for Site Instruction #11	bg
31.	Nov. 05. 2021	Issued for Site Instruction #12	bg
32.	Dec. 3. 2021	Issued for Site Instruction #13	bg
33.	Dec. 6. 2021	Issued for Site Instruction #14	bg
34.	Dec. 7. 2021	Issued for Site Instruction #15	bg

01.	Apr.19.2021	issued to client	bg

issued for revisions

GRAZIANI + CORAZZA ARCHITECTS
1320 SHAWSON DRIVE, SUITE 100 MISSISSAUGA, ONTARIO L4W 1C5
T 905.795.2601 F 905.795.2644 WWW.GC-ARCHITECTS.COM

RESIDENTIAL

ATTMAR + PALLESCHI DRIVE

BRAMPTON ONTARIO

PROJECT ARCHITECT:	B.GRAZIANI
ASSISTANT DESIGNER:	R.LINCOLN
DRAWN BY:	G.C/F.C/M.B
CHECKED BY:	D.BIASE/G.COLANGELO
PLOT DATE:	DEC.13.2021
JOB #	1331.15

WALL SECTIONS

1:25 A604

TITLEBLOCK SIZE: 915 x 1200