

BUILDING AREA
INCLUDING COLD CELLARS

4129 sq ft
384 sq m

GENERAL NOTES

1. PROVIDE FIRESTOPS AS REQUIRED BY O.B.C. 9.10.16
2. REFER TO UNIT WORKING DRAWINGS, ENGINEERS DRAWINGS AND SITEPLAN FOR ADDITIONAL INFORMATION AND VERIFICATION.
3. REFER TO ROOF TRUSS MANUFACTURERS DRAWINGS FOR LAYOUT, SPACING, INSTALLATION DETAILS AND HANGER SIZES.
4. CONTRACTOR MUST VERIFY ALL DIMENSIONS ON THE JOB REPORT ANY DISCREPANCIES TO HUNT DESIGN ASSOCIATES INC. (H.D.A.I.) BEFORE PROCEEDING WITH THE WORK. ALL DRAWINGS AND SPECIFICATIONS ARE INSTRUMENTS OF SERVICE AND ARE THE PROPERTY OF H.D.A.I..
5. COMBUSTIBLE PROJECTIONS ON THE EXTERIOR OF A WALL THAT ARE MORE THAN 1100mm (3 ft 3 in) ABOVE GROUND SHALL NOT BE PERMITTED WITHIN 1.2m (3 ft 11 in) OF A PROPERTY LINE OR CENTRE LINE OF A PUBLIC WAY OR 2.4m (7 ft 10 in) OF A COMBUSTIBLE PROJECTION ON ANOTHER BUILDING ON THE SAME PROPERTY AS PER PART 9 SECTION 9.10.14.5.(5)

LEGEND

- △ POURED IN PLACE STEPS WITH MASONRY VENEER ON SIDES.
- △ DROP OR RAISE BANDING BY AMOUNT INDICATED.
- △ ADD BANDING AND/OR TRIM AS INDICATED.
- △ ADDED CAMBERED HEADERS.
- △ 8'-0" X 8'-0" GARAGE DOORS.
- △ DROPPED OR RAISED SOFFIT AS INDICATED.
- △ ADJUSTED ROOF OVERHANG AS INDICATED ON ROOF PLAN.
- △ PROVIDE GUARD PER CONSTRUCTION NOTE 11.
- △ FOYER SUNKEN AS INDICATED
- △ LIGHT FIXTURE RELOCATED AS INDICATED.

WALL TYPE LEGEND

FRR	LINE TYPE	DETAILS
45 MIN	---	SECTION 1, 2 & 3
60 MIN	---	SECTION 8 (BLOCK SECTION 9 & WINDOW SET)
120 MIN	---	SECTION 10

DETAILS

No.	TITLE
01-1-1	MASONRY VENEER, 24" STUDS, 2 STOREY WALL SECTION
01-1-2	MASONRY VENEER, 24" STUDS, 1 STOREY GARAGE WALL SECTION
08-8-1	TYP. 1 HR PARTY WALL SECTION PARALLEL ROOF TRUSSES, P CONIC BLOCK
08-8-2	TYP. 1 HR PARTY WALL SECTION AT GARAGE, PARALLEL ROOF TRUSSES, P CONIC BLOCK
08-8-3	TYP. 1 HR PARTY WALL SECTION AT GARAGE, PARALLEL ROOF TRUSSES, P CONIC BLOCK
COMPLIANCE PACKAGE	58-12 (SECTION 21.1)
A1	

5.	ISSUED FOR FINAL	2021.07.15	DS
4.	REVISED AS PER ENGINEER COMMENTS	-	-
3.	REVISED AS PER A/C COMMENTS	2020.06.03	MM
2.	REVISED AS PER CLIENT COMMENTS	2020.06.11	MM
1.	ISSUED FOR CLIENT REVIEW	2020.06.19	MM
0.	DESCRIPTION	YYYYMMDD	BY

NO.	DESCRIPTION	DATE	BY
1.	ISSUED FOR FINAL	2021.07.15	DS
2.	REVISED AS PER CLIENT COMMENTS	2020.06.11	MM
3.	REVISED AS PER A/C COMMENTS	2020.06.03	MM
4.	REVISED AS PER ENGINEER COMMENTS	-	-
5.	ISSUED FOR FINAL	2021.07.15	DS

QUALIFICATION INFORMATION	
NAME	DEREK SANTOS
REGISTRATION NUMBER	37508
REGISTRATION EXPIRATION DATE	2025
REGISTRATION INFORMATION	HUNT DESIGN ASSOCIATES INC.
REGISTRATION EXPIRATION DATE	1999


DESIGN ASSOCIATES INC.	
www.hunt-design.ca	
9956 Woodbine Ave., Markham, ON L3R 0J7	
T 905.737.5133 F 905.737.7326 email: hda@hunt-design.ca	

ROYAL PINE HOMES - 216102
WEST GORMLEY, RICHMOND HILL, ONTARIO

BLOCK 282
LOTS 9 - 12

ELEVATIONS
Per: danielle.devitt
REV. 2021.07.15

Scale	Drawn By	Checked By
1/8" = 1'-0"	MM	DS
216102(WT)-BLOCKS 20		2 of 2

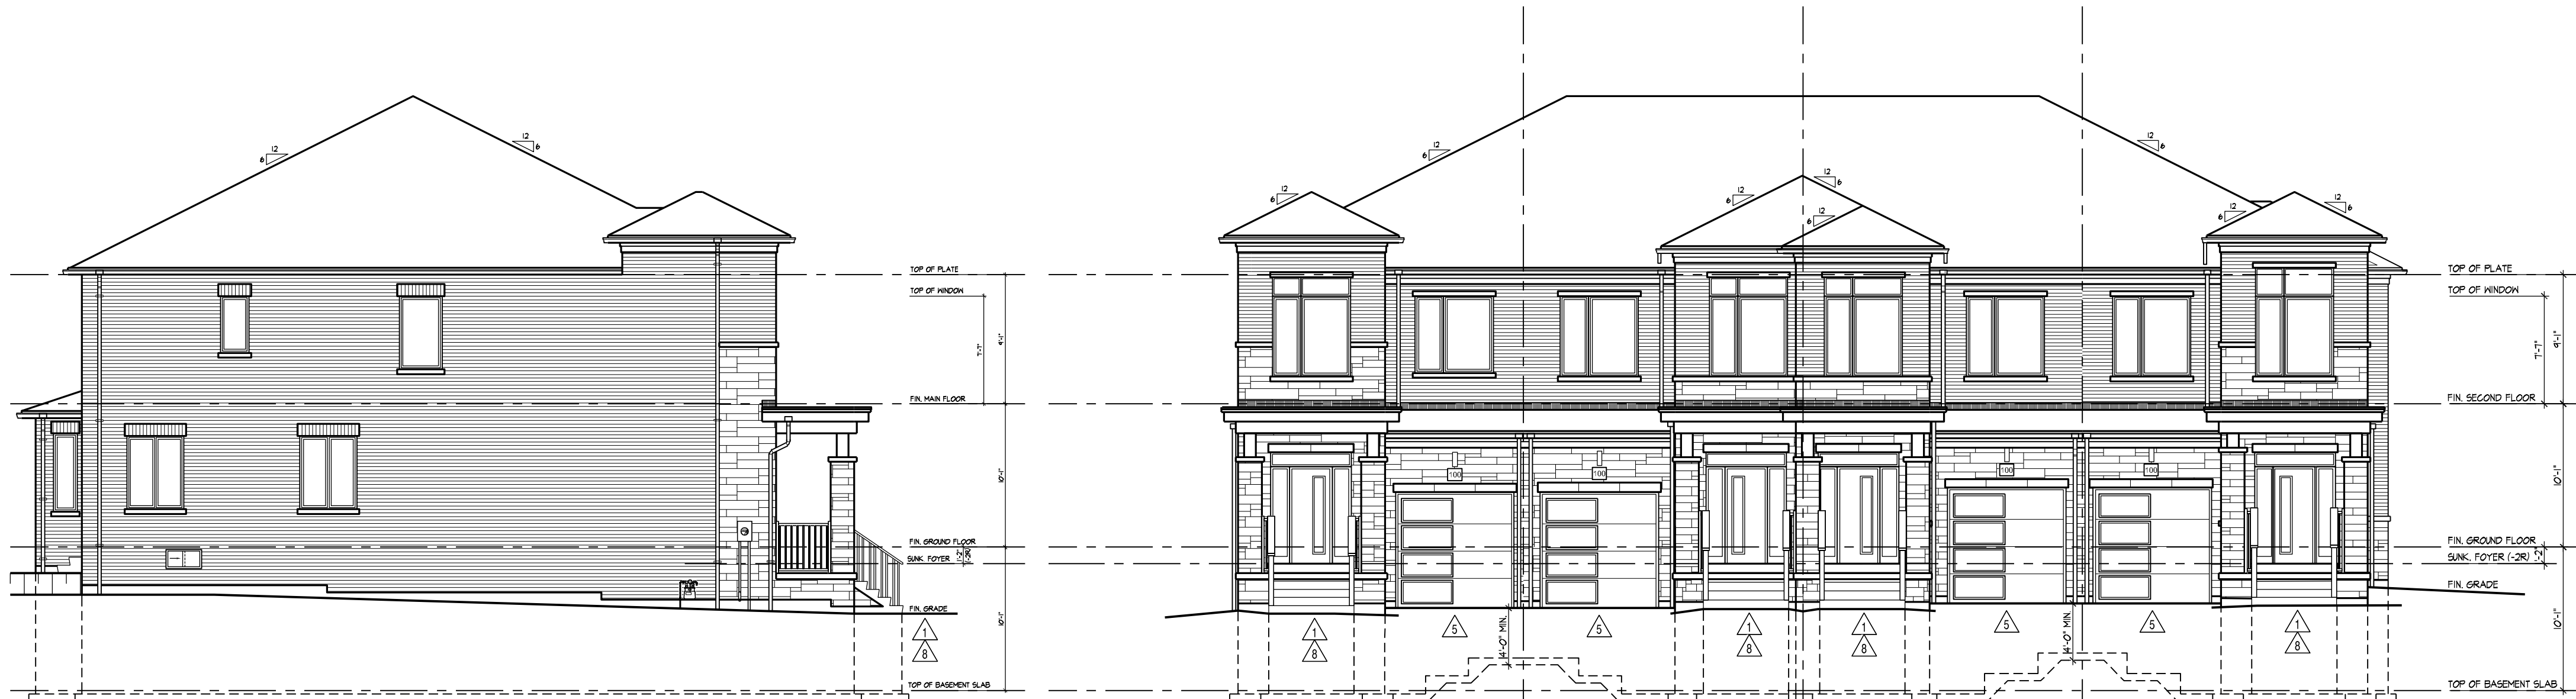


12 2009-END
56 EL. B'
LEFT SIDE ELEVATION

No unprotected openings permitted within 1.2 meters of the lot line as per article 9.10.14 of the Ontario Building Code.

12 2009-END
56 EL. B'
11 2007
56 EL. B' (REV)
10 2008
56 EL. B'
9 2010-FLANKAGE
56 EL. B' (REV)
FRONT ELEVATION

As per OBC 2012, Div.B, 9.10.14.5(5), projections such as balconies, eaves, stairs, etc., that are more than 1m above grade, shall be non-combustible when within 1.2m of a property line or 2.4m of a combustible projection on another building on the same property.

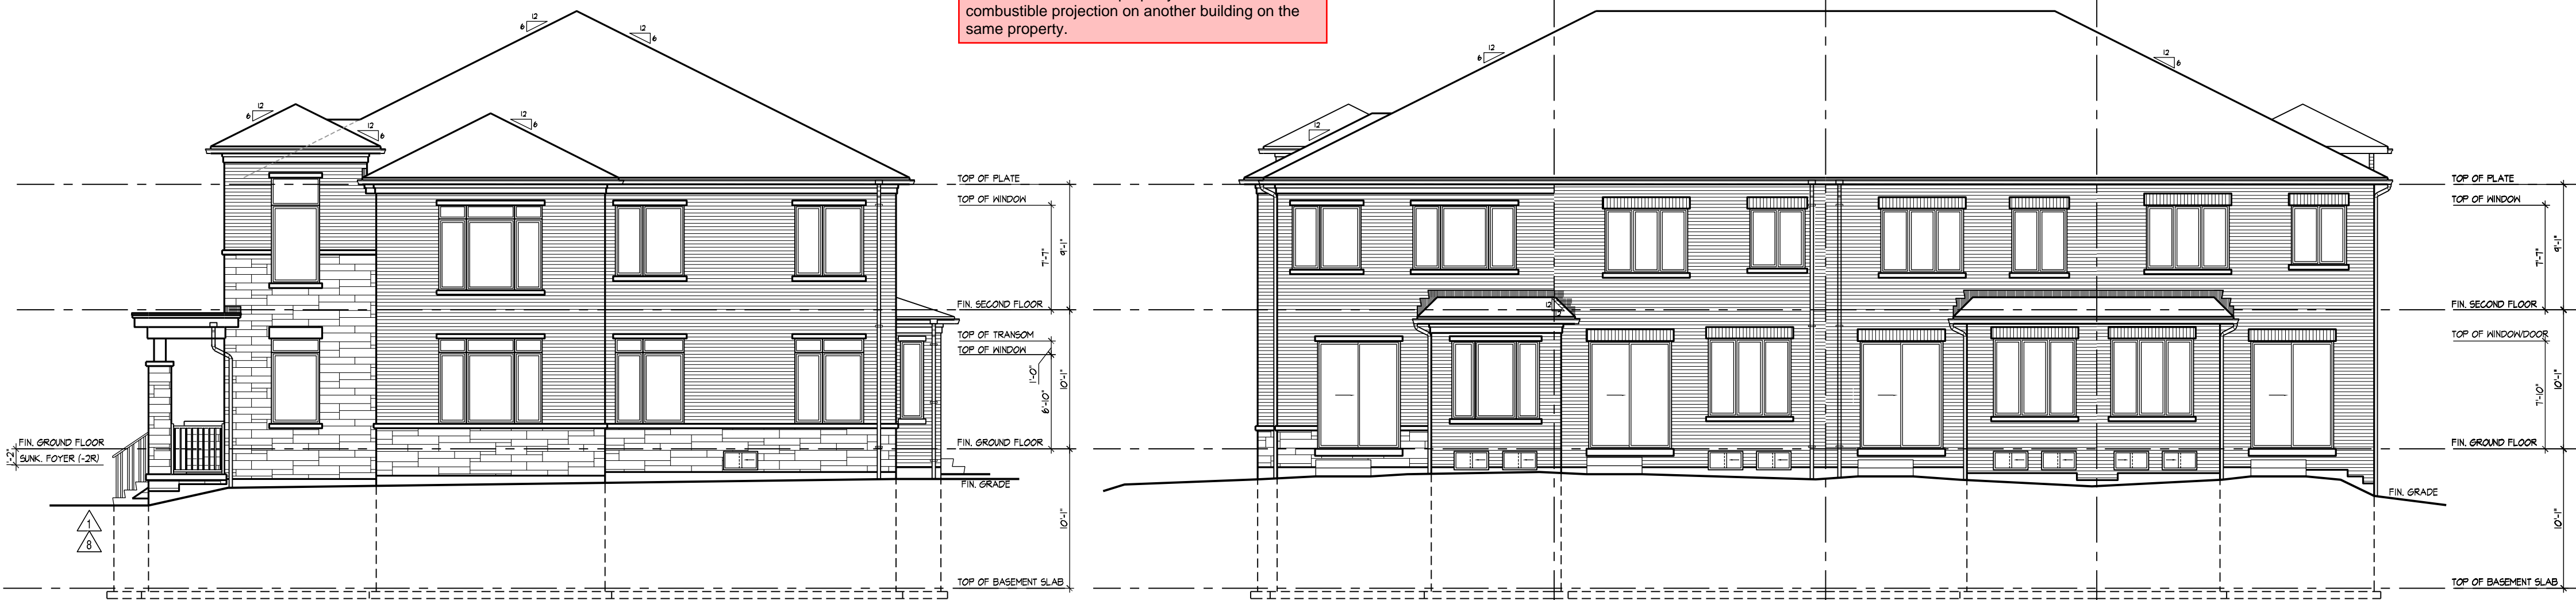

9 2010-FLANKAGE
56 EL. B' (REV)
FLANKAGE ELEVATION

9 2010-FLANKAGE
56 EL. B' (REV)
10 2008
56 EL. B'
11 2007
56 EL. B' (REV)
12 2009-END
56 EL. B'
REAR ELEVATION

W Architect Inc.
DESIGN CONTROL REVIEW
JUL. 22, 2021
FINAL BY: MM

This stamp is only for the purpose of design control and does not constitute a professional seal or signature.

DESIGN ASSOCIATES INC.

ROYAL PINE HOMES - 216102

BLOCK 282

ELEVATIONS

Scale: 1/8" = 1'-0"

216102(WT)-BLOCKS 20

BLOCK NUMBER 56