



GRAZIANI
+
CORAZZA
ARCHITECTS INC.

SITE INSTRUCTION

Forestside Estates
Attmar & Palleschi Drive
Brampton, Ontario
Attn: **Vince Staffieri**

SI A21

PROJECT : Forestside
PROJECT # : 1331.15
DATE : May. 24, 2022

Site instructions/memos and Addendums are issued only for the purpose of recording any clarification or interpretation of the contract documents or giving direction on problems resulting from field conditions. These memos are subject to the provisions of the contract documents and unless reviewed with and authorized by the Client, will not affect the contract. Should the Contractor require a change in the contract price or project schedule, he shall submit to the Client, prior to commencement of work outlined in this memo, an itemized proposal for approval.

Title: Revisions to plans as itemized.

	Reference:	Changes:
A900	Window Schedule	<ul style="list-style-type: none"> Revise front lobby entrance door to large sliding door on buildings A B C, and D.
A301a1, A301a2 A301b1, A301b2 A301c1, A301c2 A301d1, A301d2	Ground Floor Plan	<ul style="list-style-type: none"> Revise front lobby entrance door to large sliding door on buildings A B C, and D.

Reason: Revise front lobby entrance door to large sliding door on buildings A B C, and D. as per client request.

GRAZIANI + CORAZZA
ARCHITECTS INC

D. Biase C.E.T.
Principal

**Distribution:**

Royal Pine Homes	Vince Staffieri Cinzia Caruzo	vince@royalpinehomes.com Cinzia@royalpinehomes.com
Jablonski Engineering	Kevin Deonaraine	kdeonaraine@astint.on.ca
United Engineering	Rene Cuales Leonard Matthews Susan Pan Mark Giorgi	rene@u-eng.ca Lenard@u-eng.ca susan@u-eng.ca mark@u-eng.ca
Candevcon Limited	Diarmund Hogan Dudister Damnaraigh	dhorgan@candevcon.com dude@candevcon.com
Starfire Sprinkler Systems	Elite Novosselova Peter Adrian	elitecanada@hotmail.com Peter@starfiresystems.biz
Strybos Barron King Ltd.	Bryn Barron Kaleigh Gills Sydney Martel	bbarron@strybos.com kgillis@strybos.com smartel@strybos.com
Graziani + Corazza Architects	Domenic Biase Gino Colangelo Fernando Croatto	dbiase@gc-architects.com gcolangelo@gc-architects.com FCroatto@gc-architects.com

THIS DRAWING IS AN INSTRUMENT OF SERVICE, IT IS PROVIDED BY AND IS THE PROPERTY OF GRAZIANI-CORAZZA ARCHITECTS INC. THE CONTRACTOR MUST OBTAIN WRITTEN PERMISSION FROM GRAZIANI-CORAZZA ARCHITECTS INC. BEFORE ANY REPRODUCTION OR TRANSMISSION OF ANY INFORMATION CONTAINED HEREIN. 

THIS DRAWING IS NOT TO BE SCALED. ALL ARCHITECTURAL DIMENSIONS INDICATED ON THIS DRAWING ARE GRAPHIC REPRESENTATIONS ONLY.


CONFORMING FOR ELECTRONIC INFORMATION TRANSFER

ELECTRONIC INFORMATION IS SUPPLIED TO THE OTHER ASSOCIATED FIRMS TO ASSIST THEM IN THE EXECUTION OF THEIR WORK. REVIEW THE RECEIVED FIRMS MUST DETERMINE THE COMPLETENESS, APPROPRIATENESS, RELIANCE OF THE INFORMATION IN RESPECT TO THEIR PARTICULAR RESPONSIBILITY.

GRAZIANI-CORAZZA ARCHITECTS INC. SHALL BE RESPONSIBLE FOR ANY ERRORS, OMISSIONS, INCOMPLETENESS DUE TO USE OF INFORMATION IN WHICH OF THEIR OWN INFORMATION IS TRANSMITTED.

1. TRANSMISSION OF ANY INFO OR DAMAGE TO THE RECEIVING ELECTRONIC SYSTEM WHEN INFORMATION IS TRANSMITTED

REF: A301d2 FOR CONTINUATION

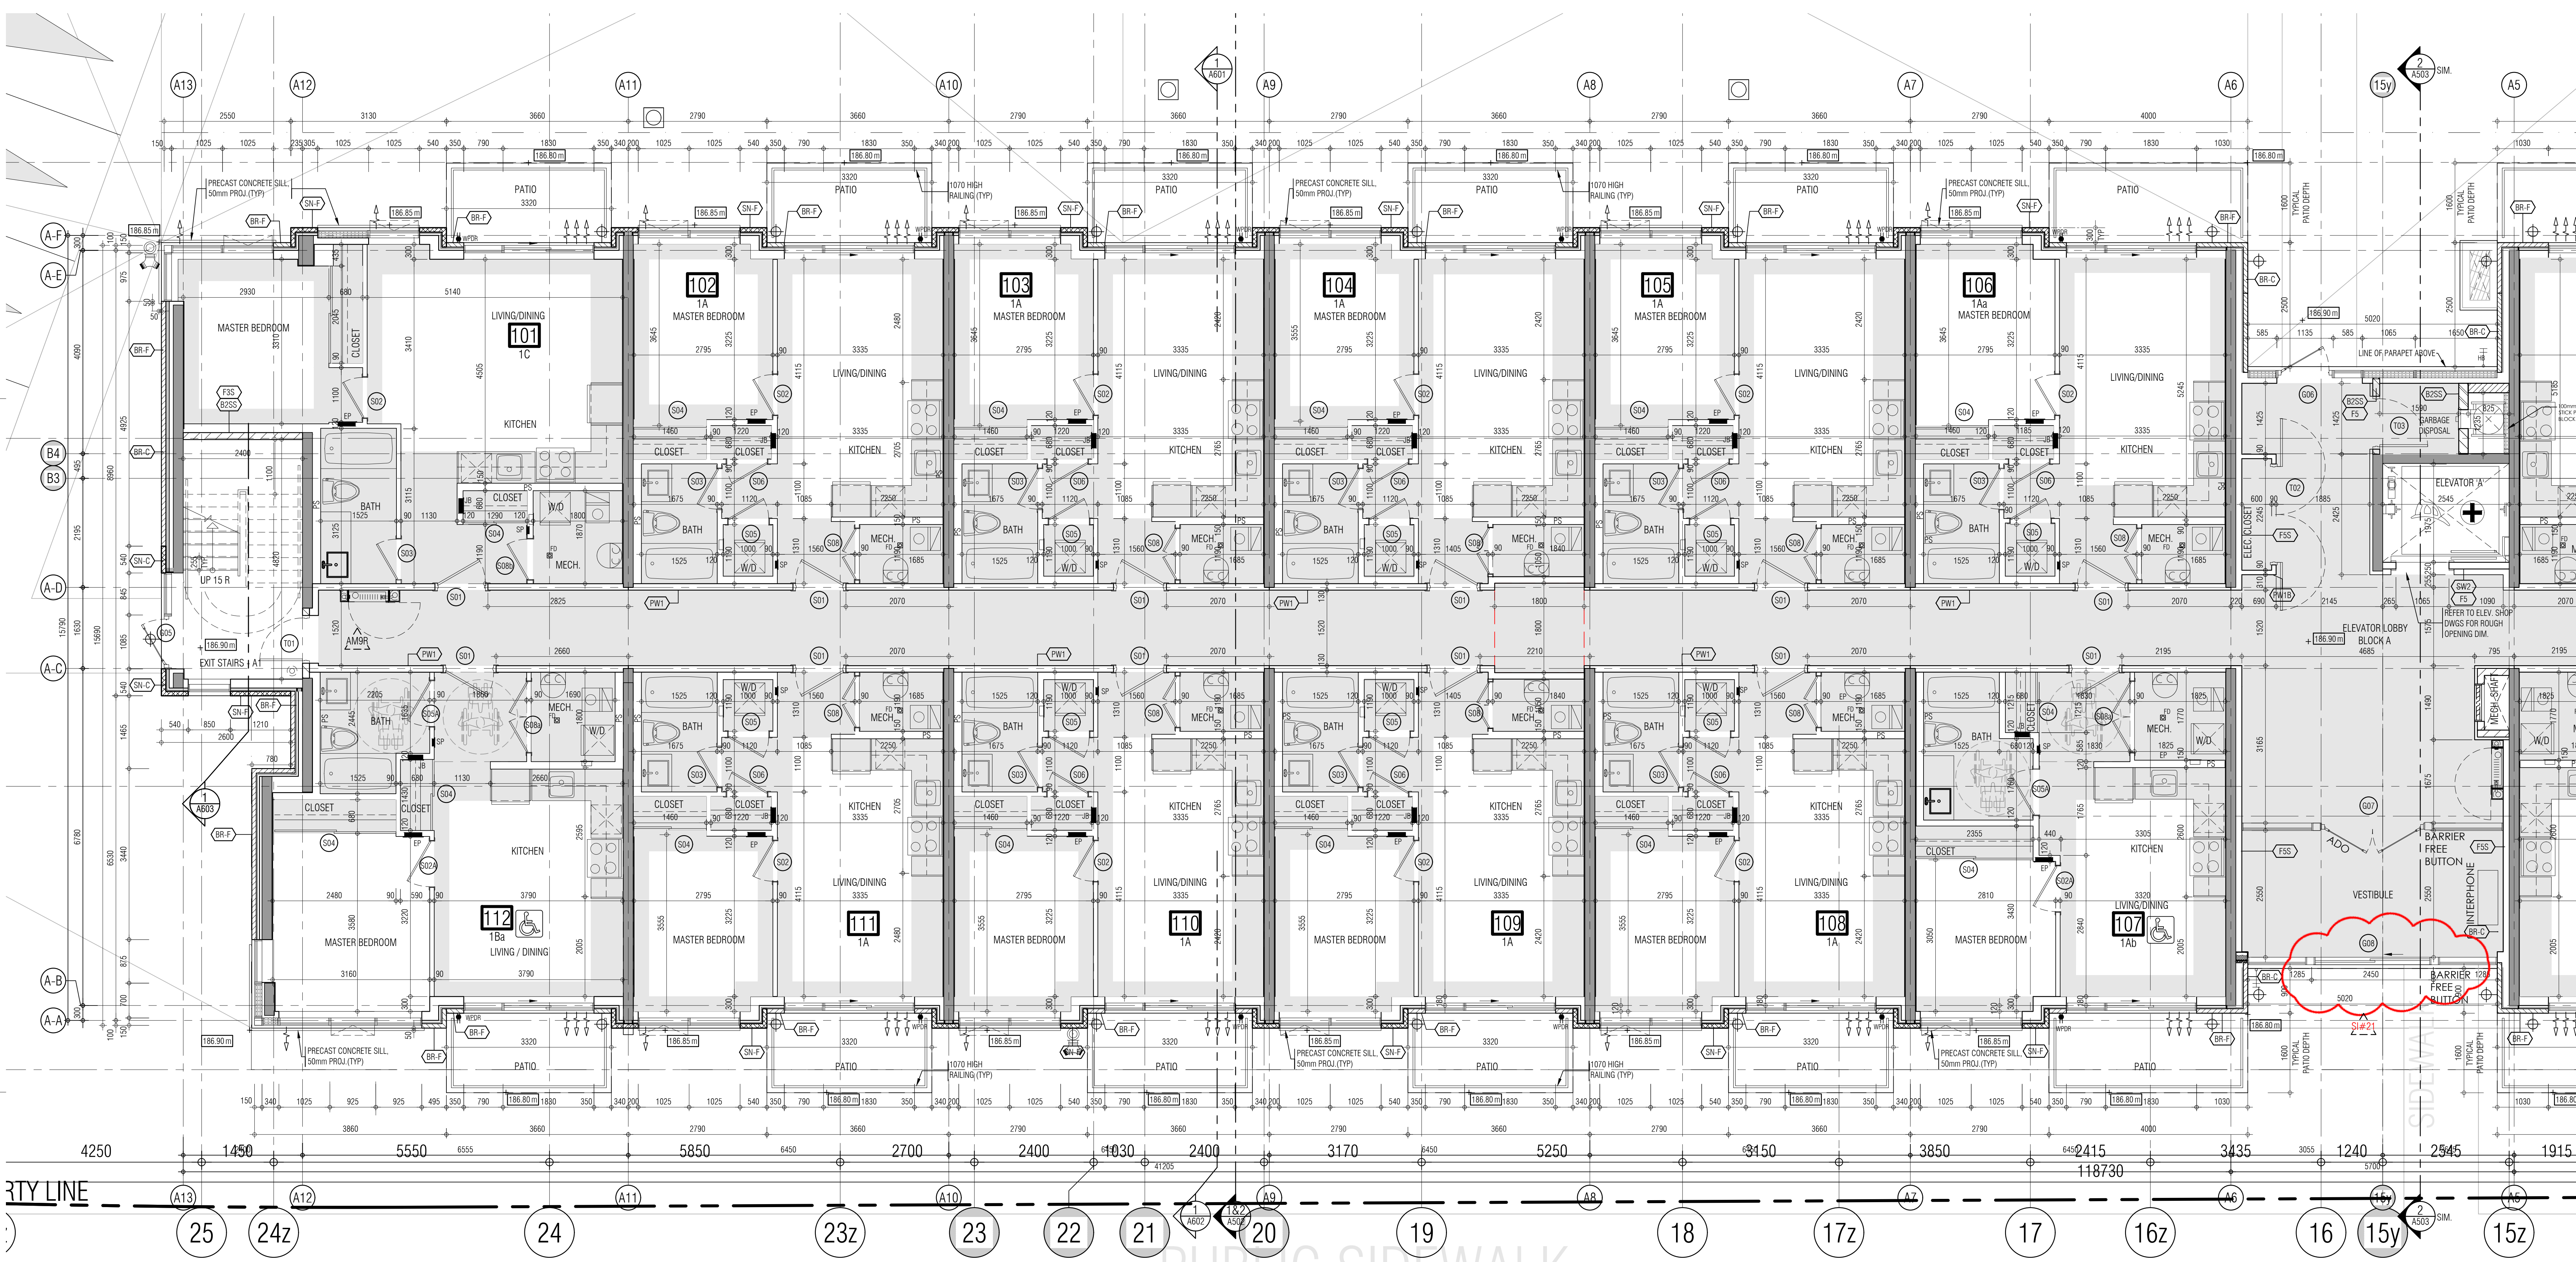

- 01. Oct.07.2019 issued for tender
- 02. Mar.13.2020 issued for design coordination #2
- 03. Mar.16.2020 issued for addendum #2
- 04. Mar.16.2020 issued for addendum #3
- 05. Aug.24.2020 issued for addendum #4
- 06. Sept.28.2020 issued for permit
- 07. Oct.20.2020 issued for addendum #5
- 08. Nov.23.2020 issued for addendum #6
- 09. Dec.14.2020 issued for addendum #7
- 10. Jan.18.2021 issued for addendum #8
- 11. Mar.7.2021 issued for permit
- 12. Mar.09.2021 issued for addendum #9
- 13. Mar.10.2021 issued for addendum #9R
- 14. Mar.26.2021 issued for progress
- 15. May.14.2021 issued for Site Instruction #1
- 16. June.15.2021 issued for Site Instruction #2
- 17. July.7.2021 re-issued for permit
- 18. July.15.2021 issued for Site Instruction #3
- 19. July.27.2021 issued for Site Instruction #4
- 20. Aug.3.2021 issued for Site Instruction #5
- 21. Aug.18.2021 issued for Site Instruction #6
- 22. Aug.28.2021 Re-issued for permit
- 23. Sept.07.2021 issued for Site Instruction #7
- 24. Sept.09.2021 issued for Site Instruction #8
- 25. Sept.16.2021 issued for Building D Permit Revisions
- 26. Sept.22.2021 issued for Site Instruction #9
- 27. Oct.6.2021 Re-issued for permit
- 28. Oct.8.2021 issued for Site Instruction #10
- 29. Oct.28.2021 issued for Site Instruction #11
- 30. Nov.05.2021 issued for Site Instruction #12
- 31. Dec.3.2021 issued for Site Instruction #13
- 32. Dec.6.2021 issued for Site Instruction #14
- 33. Dec.7.2021 issued for Site Instruction #15
- 34. Jan.26.2022 issued for Site Instruction #16
- 35. Jan.31.2022 issued for Site Instruction #17
- 37. Mar.11.2022 issued for Site Instruction #18
- 38. Apr.29.2022 issued for Site Instruction #19
- 39. May.10.2022 issued for Site Instruction #20
- 40. May.24.2022 issued for Site Instruction #21

01. SEP.19.2021 issued for addendum 1
issued for revisions

GRAZIANI CORAZZA ARCHITECTS

1205 SHANAGHAN DRIVE, SUITE 103 MISSISSAUGA, ONTARIO L4W 1C3
905-880-0201 FAX: 905-880-3888 WWW.GCA-ARCHITECTS.COM

RESIDENTIAL


BRAMPTON + PALLESCHI DRIVE ONTARIO

PROJECT ARCHITECT: B. GRAZIANI
ASSISTANT DESIGNER: R. LINCOLN
DRAWN BY: G. C. F. M. B.
CHECKED BY: D. BIASE/G. COLANGELO
PLOT DATE: MAY 24, 2022
JOB #: 1331.15

**GROUND FLOOR PLAN
BUILDING A (PARTIAL PLAN)**

1:50 A-301a1

TITLEBLOCK SIZE: 915 x 1200

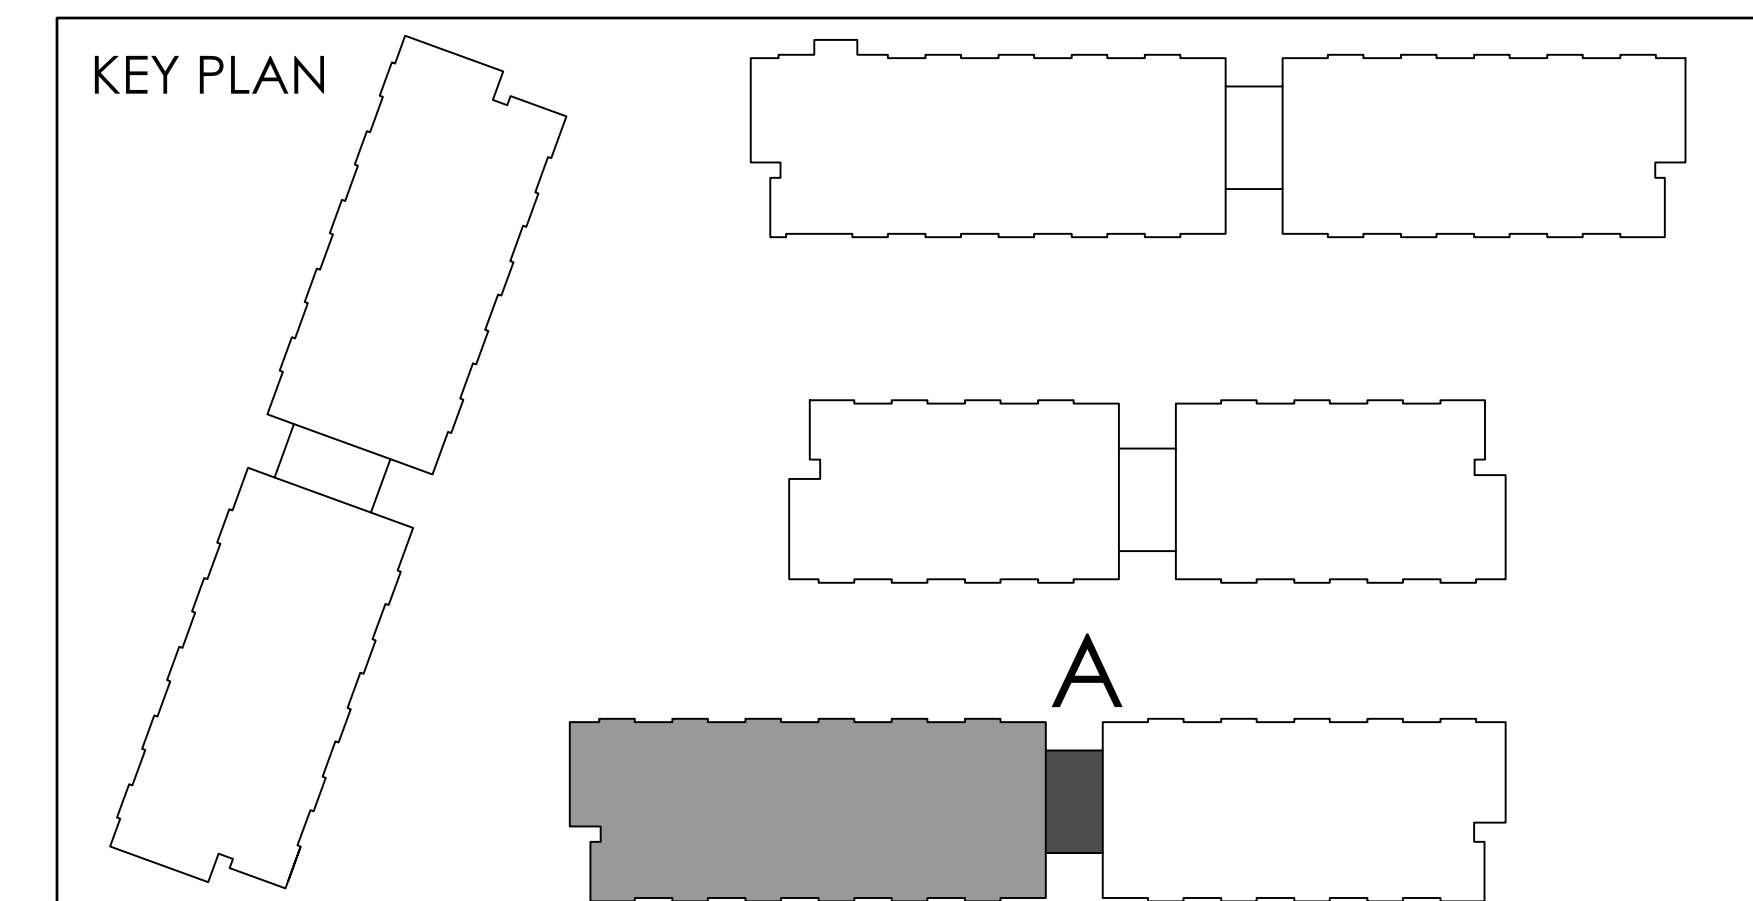

THIS DRAWING IS AN INSTRUMENT OF SERVICE, IT IS PROVIDED BY AND IS THE PROPERTY OF GRAZIANI-CORAZZA ARCHITECTS INC. THE CONTRACTOR MUST VERIFY AND ACCEPT RESPONSIBILITY FOR ALL DIMENSIONS AND CONDITIONS ON SITE AND MUST NOTIFY GRAZIANI-CORAZZA ARCHITECTS INC. OF ANY VARIATIONS FROM THE SUPPLIED INFORMATION. GRAZIANI-CORAZZA ARCHITECTS INC. IS NOT RESPONSIBLE FOR THE ACCURACY OF SURVEY, STRUCTURAL, MECHANICAL, ELECTRICAL AND OTHER ENGINEERING INFORMATION SHOWN IN THIS DRAWING. REFER TO THE APPROPRIATE ENGINEERING DRAWINGS BEFORE PROCEEDING WITH THE WORK. CONSTRUCTION MUST COMPLY TO ALL APPLICABLE CODES AND REQUIREMENTS OF THE APPLICABLE JURISDICTION, UNLESS OTHERWISE NOTED. NO WARRANTY HAS BEEN MADE OR IS REPORTED BY THIS OFFICE IN RESPECT TO THE ENVIRONMENTAL CONDITION OF THIS SITE.

THIS DRAWING IS NOT TO BE SCALED. ALL ARCHITECTURAL DIMENSIONS INDICATED ON THIS DRAWING ARE GRAPHIC REPRESENTATIONS ONLY.

CONDITIONS FOR ELECTRONIC INFORMATION TRANSFER:

ELECTRONIC INFORMATION IS SUPPLIED TO THE OTHER ASSOCIATED FIRMS TO ASSIST THEM IN THE EXECUTION OF THEIR WORK. REVIEW THE RECEIVED FIRMS MUST DETERMINE THE COMPLETENESS, APPROPRIATENESS, RELIANCE OF THE INFORMATION IN RESPECT TO THEIR PARTICULAR RESPONSIBILITY.

GRAZIANI-CORAZZA ARCHITECTS INC. SHALL NOT BE RESPONSIBLE FOR:

1. ERRORS, OMISSIONS, INCOMPLETENESS DUE TO USE OF INFORMATION IN WHICH THE INFORMATION IS TRANSMITTED;
2. TRANSMISSION OF ANY VIRUS OR DAMAGE TO THE RECEIVING ELECTRONIC SYSTEM WHEN INFORMATION IS TRANSMITTED.

- 01. Oct.07.2019 issued for tender
- 02. Mar.13.2020 issued for design coordination #2
- 03. Mar.16.2020 issued for addendum #2
- 04. Mar.16.2020 issued for addendum #3
- 05. Aug.24.2020 issued for addendum #4
- 06. Sept.28.2020 issued for permit
- 07. Oct.20.2020 issued for addendum #5
- 08. Nov.23.2020 issued for addendum #6
- 09. Dec.14.2020 issued for addendum #7
- 10. Jan.18.2021 issued for addendum #8
- 11. Mar.2.2021 issued for permit
- 12. Mar.09.2021 issued for addendum #9
- 13. Mar.10.2021 issued for addendum #9R
- 14. Mar.26.2021 issued for progress
- 15. May.14.2021 issued for Site Instruction #1
- 16. June.15.2021 issued for Site Instruction #2
- 17. July.7.2021 re-issued for permit
- 18. July.15.2021 issued for Site Instruction #3
- 19. July.27.2021 issued for Site Instruction #4
- 20. Aug.3.2021 issued for Site Instruction #5
- 21. Aug.18.2021 issued for Site Instruction #6
- 22. Aug.30.2021 Re-issued for permit
- 23. Sept.07.2021 issued for Site Instruction #7
- 24. Sept.09.2021 issued for Site Instruction #8
- 25. Sept.16.2021 issued for Building D Permit Revisions
- 26. Sept.22.2021 issued for Site Instruction #9
- 27. Oct.6.2021 Re-issued for permit
- 28. Oct.8.2021 issued for Site Instruction #10
- 29. Oct.28.2021 issued for Site Instruction #11
- 30. Nov.05.2021 issued for Site Instruction #12
- 31. Nov.05.2021 issued for Site Instruction #13
- 32. Dec.3.2021 issued for Site Instruction #14
- 33. Dec.6.2021 issued for Site Instruction #14
- 34. Dec.7.2021 issued for Site Instruction #15
- 35. Jan.26.2022 issued for Site Instruction #16
- 36. Jan.31.2022 issued for Site Instruction #17
- 37. Mar.1.2022 issued for Site Instruction #18
- 38. Apr.29.2022 issued for Site Instruction #19
- 39. May.10.2022 issued for Site Instruction #20
- 40. May.24.2022 issued for Site Instruction #21

01. SEP.19.2019 issued for addendum 1
 issued for revisions




ATTMAR + PALLESCI DRIVE
 BRAMPTON ONTARIO

PROJECT ARCHITECT: B. GRAZIANI
 ASSISTANT DESIGNER: R. LINCOLN
 DRAWN BY: G. C.F./M.B.
 CHECKED BY: D. BIASE/G. COLANGELO
 JOB DATE: MAY 24 2022
 JOB #: 1331.15

GROUND FLOOR PLAN
 BUILDING A (PARTIAL PLAN)

1:50 A-301a2
 TILEBLOCK SIZE: 915 x 1200

REF.A301d1 FOR CONTINUATION

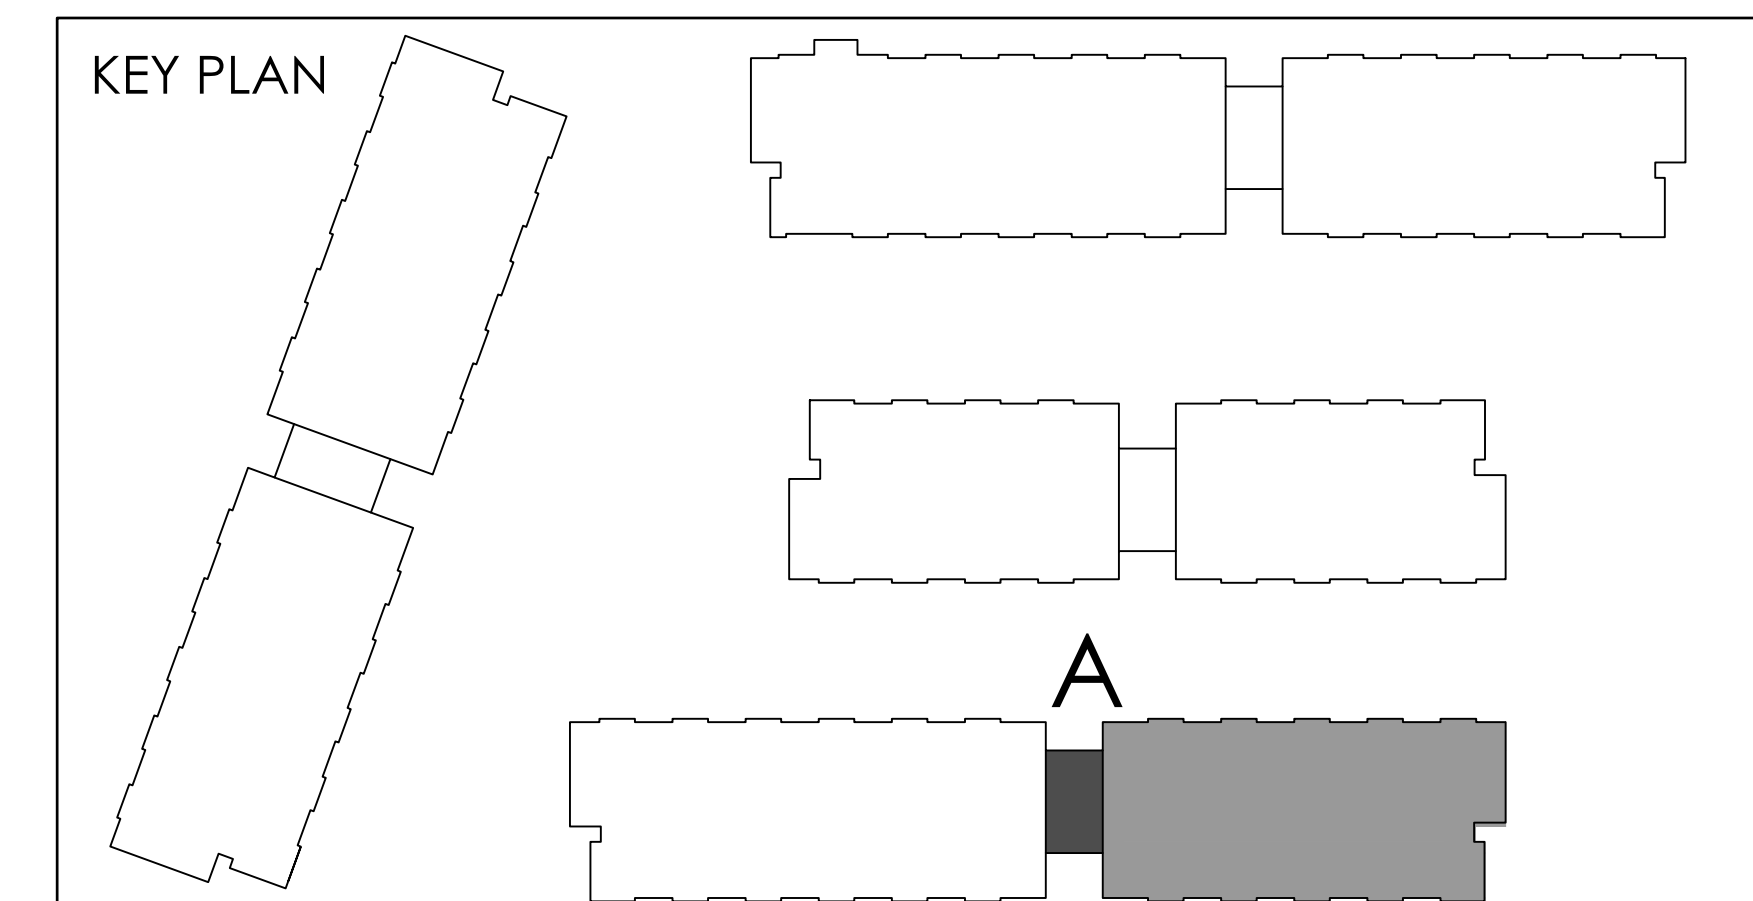


THIS DRAWING IS AN INSTRUMENT OF SERVICE, IT IS PROVIDED BY AND IS THE PROPERTY OF GRAZIANI-CORAZZA ARCHITECTS INC. THE CONTRACTOR MUST VERIFY AND ACCEPT RESPONSIBILITY FOR ALL DIMENSIONS AND CONDITIONS ON SITE AND MUST NOTIFY GRAZIANI-CORAZZA ARCHITECTS INC. OF ANY VARIATIONS FROM THE SUPPLIED INFORMATION. GRAZIANI-CORAZZA ARCHITECTS INC. IS NOT RESPONSIBLE FOR THE ACCURACY OF SURVEY, STRUCTURAL, MECHANICAL, ELECTRICAL AND OTHER ENGINEERING INFORMATION SHOWN ON THIS DRAWING. REFER TO THE APPROPRIATE ENGINEERING DRAWINGS BEFORE PROCEEDING WITH THE WORK. CONSTRUCTION MUST CONFORM TO ALL APPLICABLE CODES AND REQUIREMENTS OF THE APPLICABLE JURISDICTION. UNLESS OTHERWISE NOTED, NO INVESTIGATION HAS BEEN UNDERTAKEN OR REPORTED BY THIS OFFICE IN RESPECT TO THE ENVIRONMENTAL CONDITION OF THIS SITE.

THIS DRAWING IS NOT TO BE SCALED. ALL ARCHITECTURAL DIMENSIONS INDICATED ON THIS DRAWING ARE GRAPHIC REPRESENTATIONS ONLY.

CONDITIONS FOR ELECTRONIC INFORMATION TRANSFER:
ELECTRONIC INFORMATION IS SUPPLIED TO THE OTHER ASSOCIATED FIRMS TO ASSIST THEM IN THE EXECUTION OF THEIR WORK. REVIEW THE RECEIVED FIRMS MUST DETERMINE THE COMPLETENESS, APPROPRIATENESS, RELIANCE OF THE INFORMATION IN RESPECT TO THEIR PARTICULAR RESPONSIBILITY.

GRAZIANI-CORAZZA ARCHITECTS INC. SHALL NOT BE RESPONSIBLE FOR:
1. ERRORS, OMISSIONS, INCOMPLETENESS DUE TO USE OF INFORMATION IN WHOLE OR PART FROM INFORMATION IN TRANSMISSION
2. TRANSMISSION OF ANY INFO. OF DAMAGE TO THE RECEIVING ELECTRONIC SYSTEM WHEN INFORMATION IS TRANSMITTED

REF. A301c2 FOR CONTINUATION

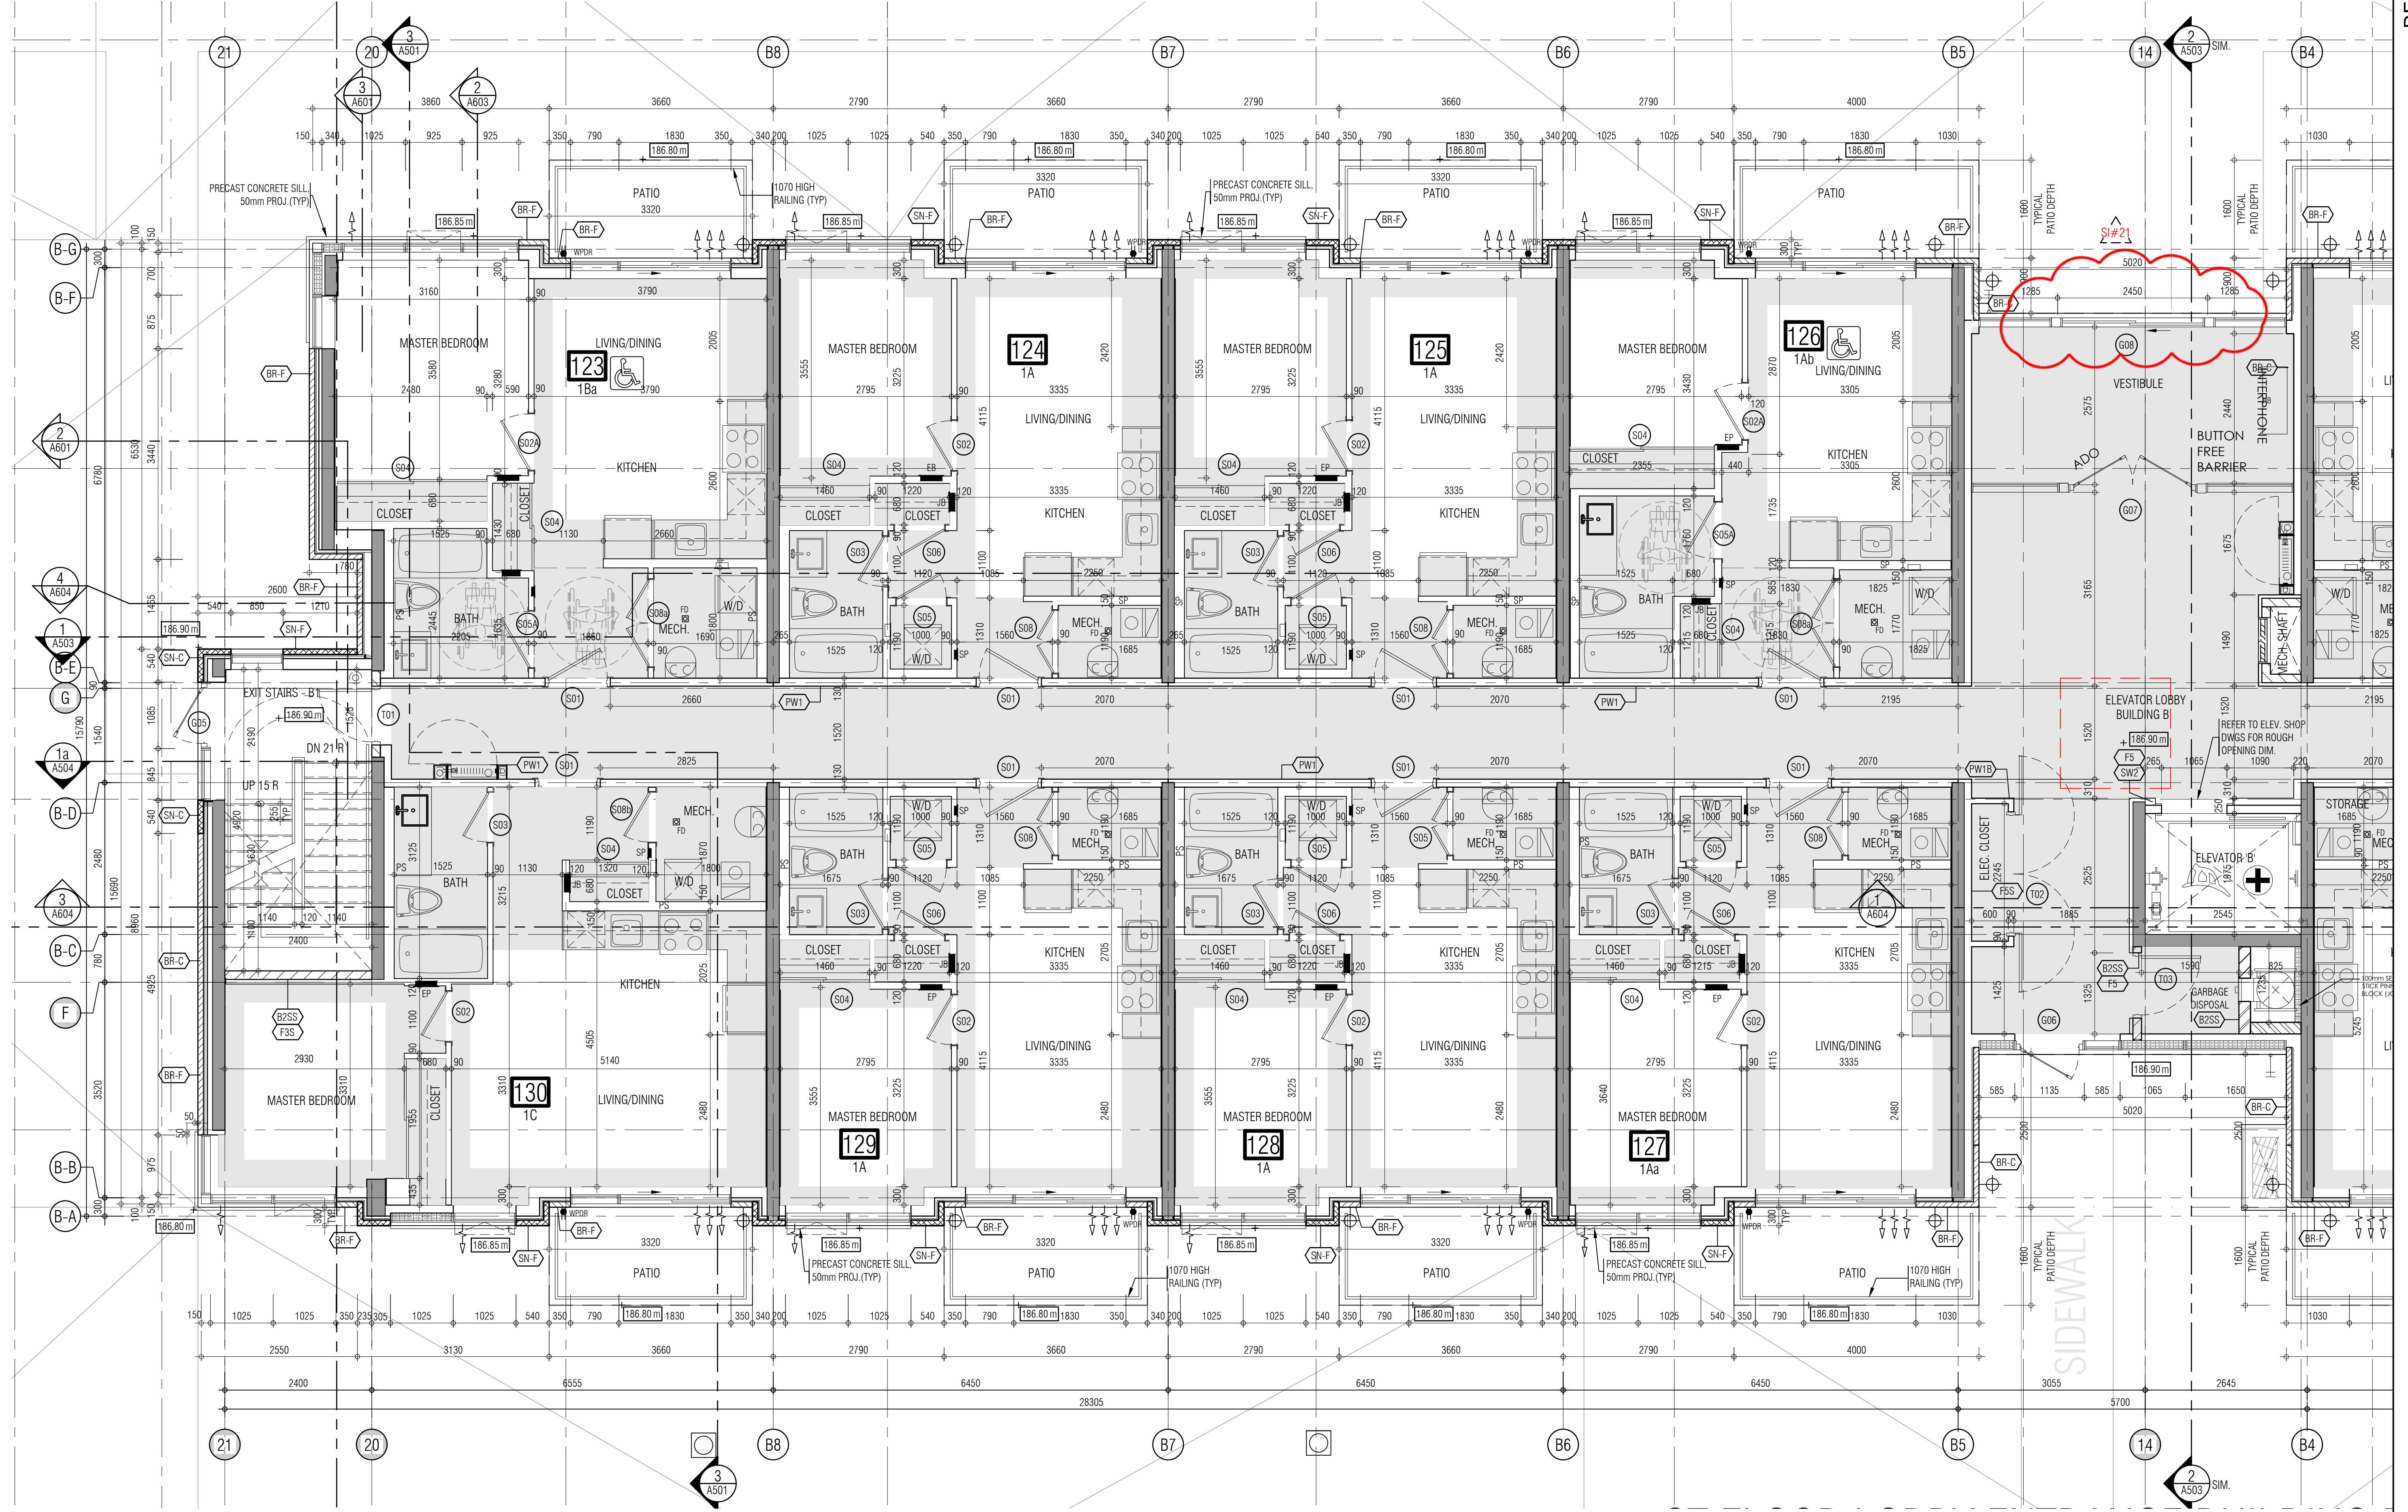

- 01. Oct.07.2019 issued for tender
- 02. Mar.13.2020 issued for design coordination #2
- 03. Mar.16.2020 issued for addendum #2
- 04. Mar.16.2020 issued for addendum #3
- 05. Aug.24.2020 issued for addendum #4
- 06. Sept. 28.2020 issued for permit
- 07. Oct.20.2020 issued for addendum #5
- 08. Nov.23.2020 issued for addendum #6
- 09. Dec.14.2020 issued for addendum #7
- 10. Jan.18.2021 issued for addendum #8
- 11. Mar. 2. 2021 issued for permit
- 12. Mar.09.2021 issued for addendum #9
- 13. Mar.10.2021 issued for addendum #9R
- 14. Mar.26.2021 issued for progress
- 15. May.14. 2021 issued for Site Instruction #1
- 16. June.15. 2021 issued for Site Instruction #2
- 17. July. 7. 2021 re-issued for permit
- 18. July.15. 2021 issued for Site Instruction #3
- 19. July.27. 2021 issued for Site Instruction #4
- 20. Aug. 3. 2021 issued for Site Instruction #5
- 21. Aug.18. 2021 issued for Site Instruction #6
- 22. Aug. 29. 2021 Re-issued for permit
- 23. Sept. 07. 2021 issued for Site Instruction #7
- 24. Sept. 09. 2021 issued for Site Instruction #8
- 25. Sept. 16. 2021 issued for Building D Permit Revisions
- 26. Sept. 22. 2021 issued for Site Instruction #9
- 27. Oct. 6. 2021 Re-issued for permit
- 28. Oct. 8. 2021 issued for Site Instruction #10
- 29. Oct. 28. 2021 issued for Site Instruction #11
- 30. Nov. 05. 2021 issued for Site Instruction #12
- 31. Dec. 3. 2021 issued for Site Instruction #13
- 32. Dec. 6. 2021 issued for Site Instruction #14
- 33. Dec. 7. 2021 issued for Site Instruction #15
- 34. Dec. 7. 2021 issued for Site Instruction #15
- 35. Jan. 26. 2022 issued for Site Instruction #16
- 36. Jan. 31. 2022 issued for Site Instruction #17
- 37. Mar. 11. 2022 issued for Site Instruction #18
- 38. Apr. 29. 2022 issued for Site Instruction #19
- 39. May. 10. 2022 issued for Site Instruction #20
- 40. May. 24. 2022 issued for Site Instruction #21

01. SEP.19.2021 issued for addendum 1

issued for revisions

**GRAZIANI
CORAZZA
ARCHITECTS**

1325 SHANAGAS DRIVE SUITE 103 MISSISSAUGA, ONTARIO L4W 1C3
905-270-0241 FAX: 905-270-3988 WWW.GC-ARCHITECTS.COM

RESIDENTIAL


ATTMAR + PALLESCI DRIVE ONTARIO

PROJECT ARCHITECT: B. GRAZIANI
ASSISTANT DESIGNER: R. LINCOLN
DRAWN BY: G. C.F./M.B.
CHECKED BY: D. BIASE/G. COLANGELO
PLOT DATE: MAY 24, 2022
JOB #: 1331.15


**GROUND FLOOR PLAN
BUILDING B (PARTIAL PLAN)**

1:50 A-301b1

TITLEBLOCK SIZE: 915 x 1200

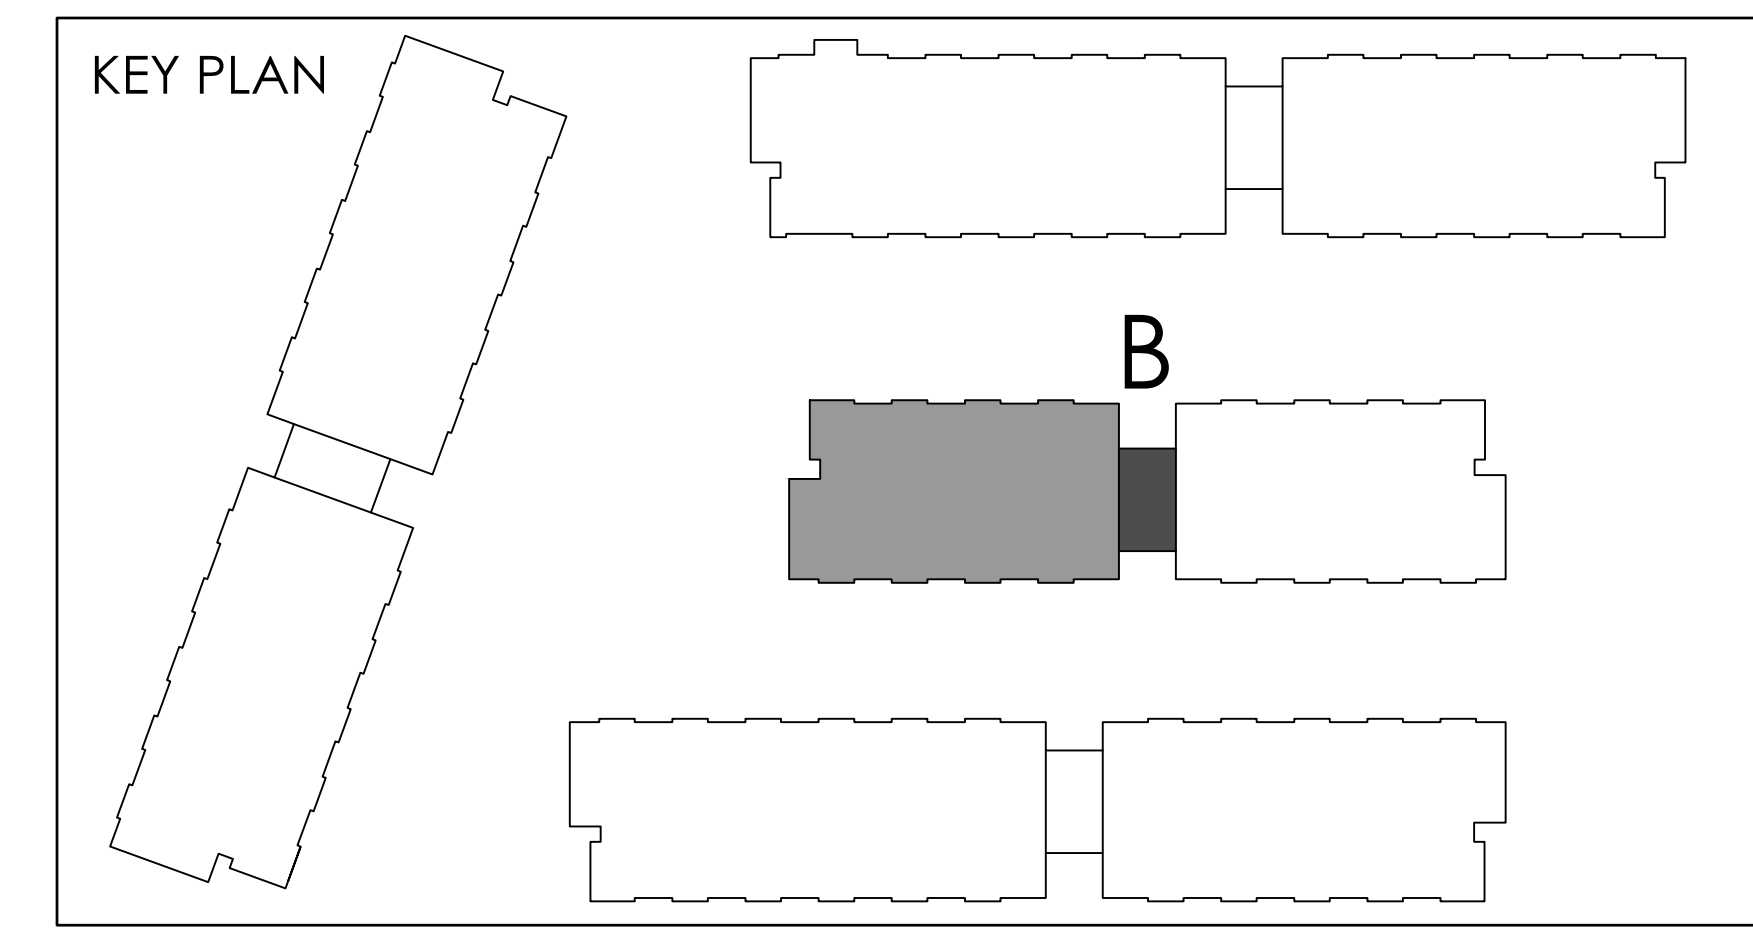

REF.A301c1 FOR CONTINUATION

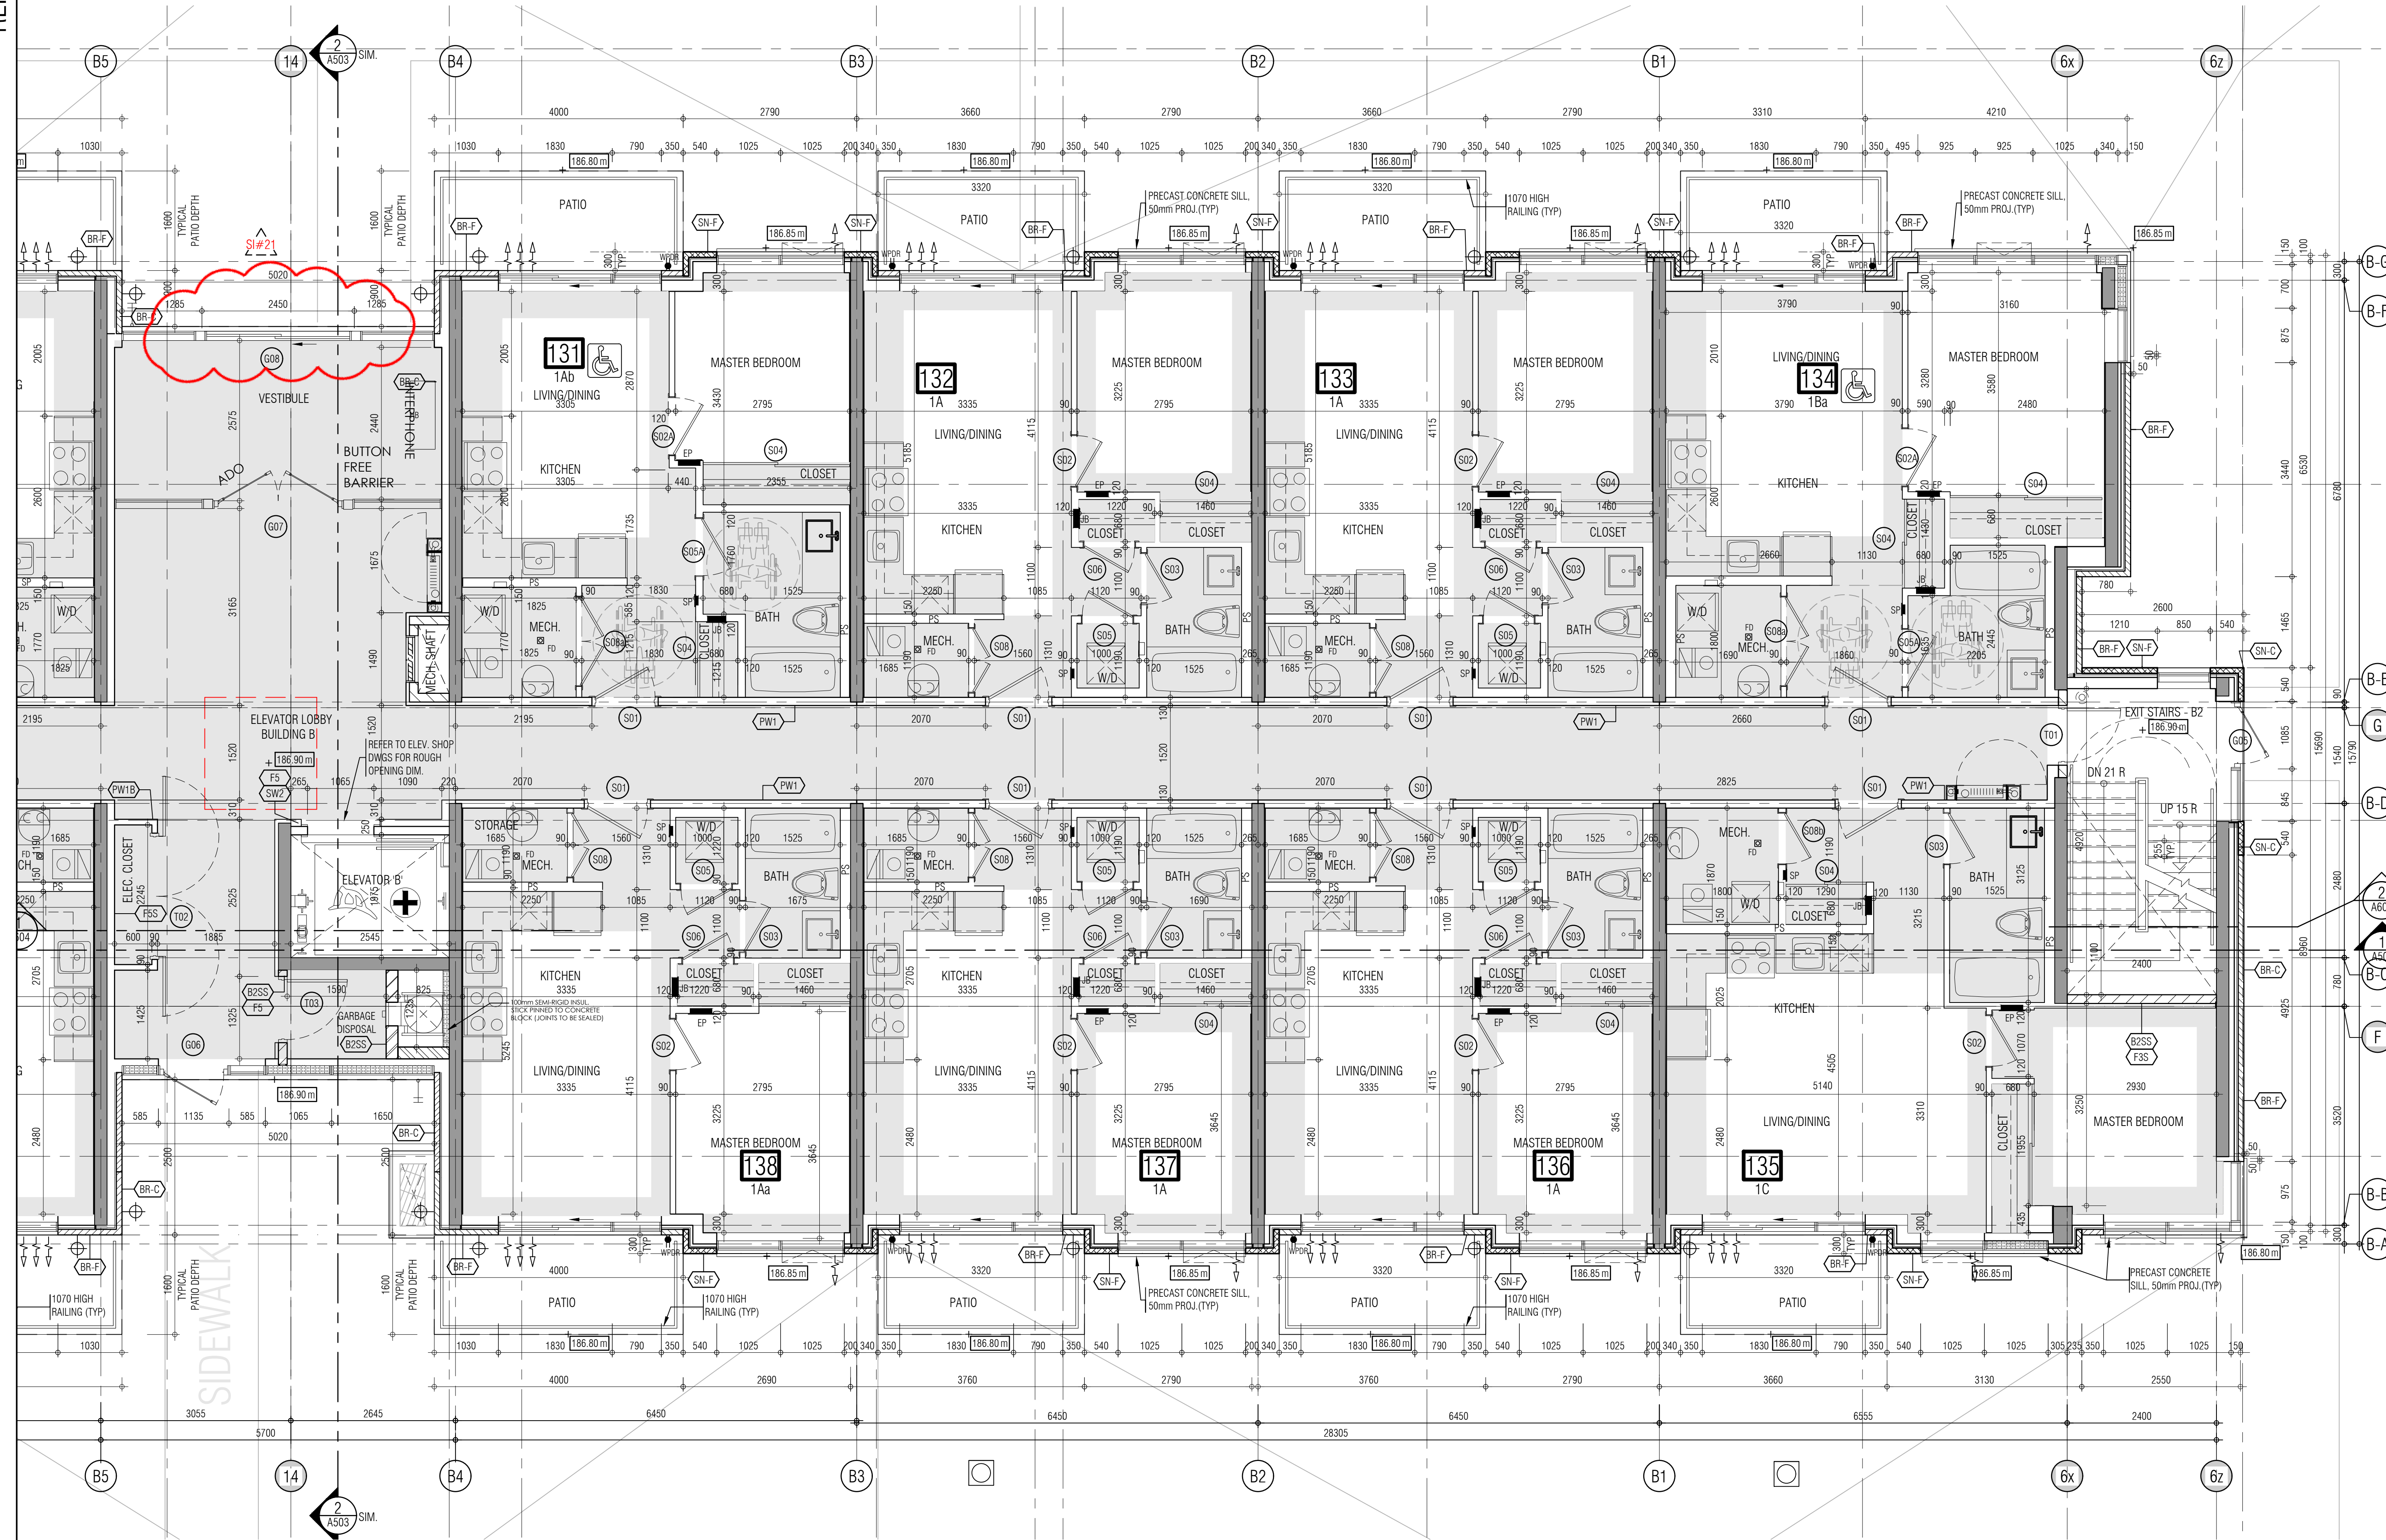

THIS DRAWING IS AN INSTRUMENT OF SERVICE, IT IS PROVIDED BY AND IS THE PROPERTY OF GRAZIANI-CORAZZA ARCHITECTS INC. THE CONTRACTOR MUST VERIFY AND ACCEPT RESPONSIBILITY FOR ALL DIMENSIONS AND CONDITIONS ON SITE AND MUST NOTIFY GRAZIANI-CORAZZA ARCHITECTS INC. OF ANY VARIATIONS FROM THE SUPPLIED INFORMATION. GRAZIANI-CORAZZA ARCHITECTS INC. IS NOT RESPONSIBLE FOR THE ACCURACY OF SURVEY, STRUCTURAL, MECHANICAL, ELECTRICAL AND OTHER ENGINEERING INFORMATION SHOWN ON THIS DRAWING. REFER TO THE APPROPRIATE ENGINEERING DRAWINGS BEFORE PROCEEDING WITH THE WORK. CONSTRUCTION MUST CONFORM TO ALL APPLICABLE CODES AND REQUIREMENTS OF THE AUTHORITY HAVING JURISDICTION, UNLESS OTHERWISE NOTED. NO MODIFICATION HAS BEEN OBSERVED OR REPORTED BY THIS OFFICE IN RESPECT TO THE ENVIRONMENTAL CONDITION OF THIS SITE.

THIS DRAWING IS NOT TO BE SCALED. ALL ARCHITECTURAL DIMENSIONS INDICATED ON THIS DRAWING ARE GRAPHIC REPRESENTATIONS ONLY.

CONDITIONS FOR ELECTRONIC INFORMATION TRANSFER:

ELECTRONIC INFORMATION IS SUPPLIED TO THE OTHER ASSOCIATED FIRMS TO ASSIST THEM IN THE EXECUTION OF THEIR WORK. REVIEW THE RECEIVED FIRMS MUST DETERMINE THE COMPLETENESS, APPROPRIATENESS, RELIANCE OF THE INFORMATION IN RESPECT TO THEIR PARTICULAR RESPONSIBILITY.

GRAZIANI-CORAZZA ARCHITECTS INC. SHALL NOT BE RESPONSIBLE FOR:

1. ERROR, OMISSIONS, INCOMPLETENESS DUE TO USE OF INFORMATION IN WHICH NO PART INFORMATION IS TRANSMITTED
2. TRANSMISSION OF ANY KIND OF DAMAGE TO THE RECEIVING ELECTRONIC SYSTEM WHEN INFORMATION IS TRANSMITTED

- 01. Oct.07.2019 issued for tender
- 02. Mar.13.2020 issued for design coordination #2
- 03. Mar.16.2020 issued for addendum #2
- 04. Mar.16.2020 issued for addendum #3
- 05. Aug.24.2020 issued for addendum #4
- 06. Sept. 28.2020 issued for permit
- 07. Oct.20.2020 issued for addendum #5
- 08. Nov.23.2020 issued for addendum #6
- 09. Dec.14.2020 issued for addendum #7
- 10. Jan.18.2021 issued for addendum #8
- 11. Mar. 2. 2021 issued for permit
- 12. Mar.09.2021 issued for addendum #9
- 13. Mar.10.2021 issued for addendum #9R
- 14. Mar.26.2021 issued for progress
- 15. May.15. 2021 issued for Site Instruction #1
- 16. June.15. 2021 issued for Site Instruction #2
- 17. July. 7. 2021 re-issued for permit
- 18. July. 15. 2021 issued for Site Instruction #3
- 19. July. 27. 2021 issued for Site Instruction #4
- 20. Aug. 3. 2021 issued for Site Instruction #5
- 21. Aug. 18. 2021 issued for Site Instruction #6
- 22. Aug. 20. 2021 Re-issued for permit
- 23. Sept. 07. 2021 issued for Site Instruction #7
- 24. Sept. 09. 2021 issued for Site Instruction #8
- 25. Sept. 16. 2021 issued for Building D Permit Revisions
- 26. Sept. 22. 2021 issued for Site Instruction #9
- 27. Oct. 6. 2021 Re-issued for permit
- 28. Oct. 8. 2021 issued for Site Instruction #10
- 30. Oct. 28. 2021 issued for Site Instruction #11
- 31. Nov. 05. 2021 issued for Site Instruction #12
- 32. Dec. 3. 2021 issued for Site Instruction #13
- 33. Dec. 6. 2021 issued for Site Instruction #14
- 34. Dec. 7. 2021 issued for Site Instruction #15
- 35. Jan. 26. 2022 issued for Site Instruction #16
- 36. Jan. 31. 2022 issued for Site Instruction #17
- 37. Mar. 1. 2022 issued for Site Instruction #18
- 38. Apr. 29. 2022 issued for Site Instruction #19
- 39. May. 10. 2022 issued for Site Instruction #20
- 40. May. 24. 2022 issued for Site Instruction #21

01. SEP.18.2019 issued for addendum 1

GRAZIANI
CORAZZA
ARCHITECTS

1305 SHANAGONG DRIVE, SUITE 103 MISSISSAUGA, ONTARIO L4W 1C3
905-890-0241 FAX: 905-272-3388 WWW.GC-ARCHITECTS.COM


RESIDENTIAL

ATTMARR + PALLESCHI DRIVE
BRAMPTON ONTARIO

PROJECT ARCHITECT: B. GRAZIANI
ASSISTANT DESIGNER: R. LINCOLN
DRAWN BY: G. C./F./M.B.
CHECKED BY: D. BIASE/G. COLANGELO
PLOT DATE: MAY 24 2022
JOB #: 1331.15

GROUND FLOOR PLAN
BUILDING B (PARTIAL PLAN)

1:50 A-301b2
TILEBLOCK SIZE: 915 x 1200

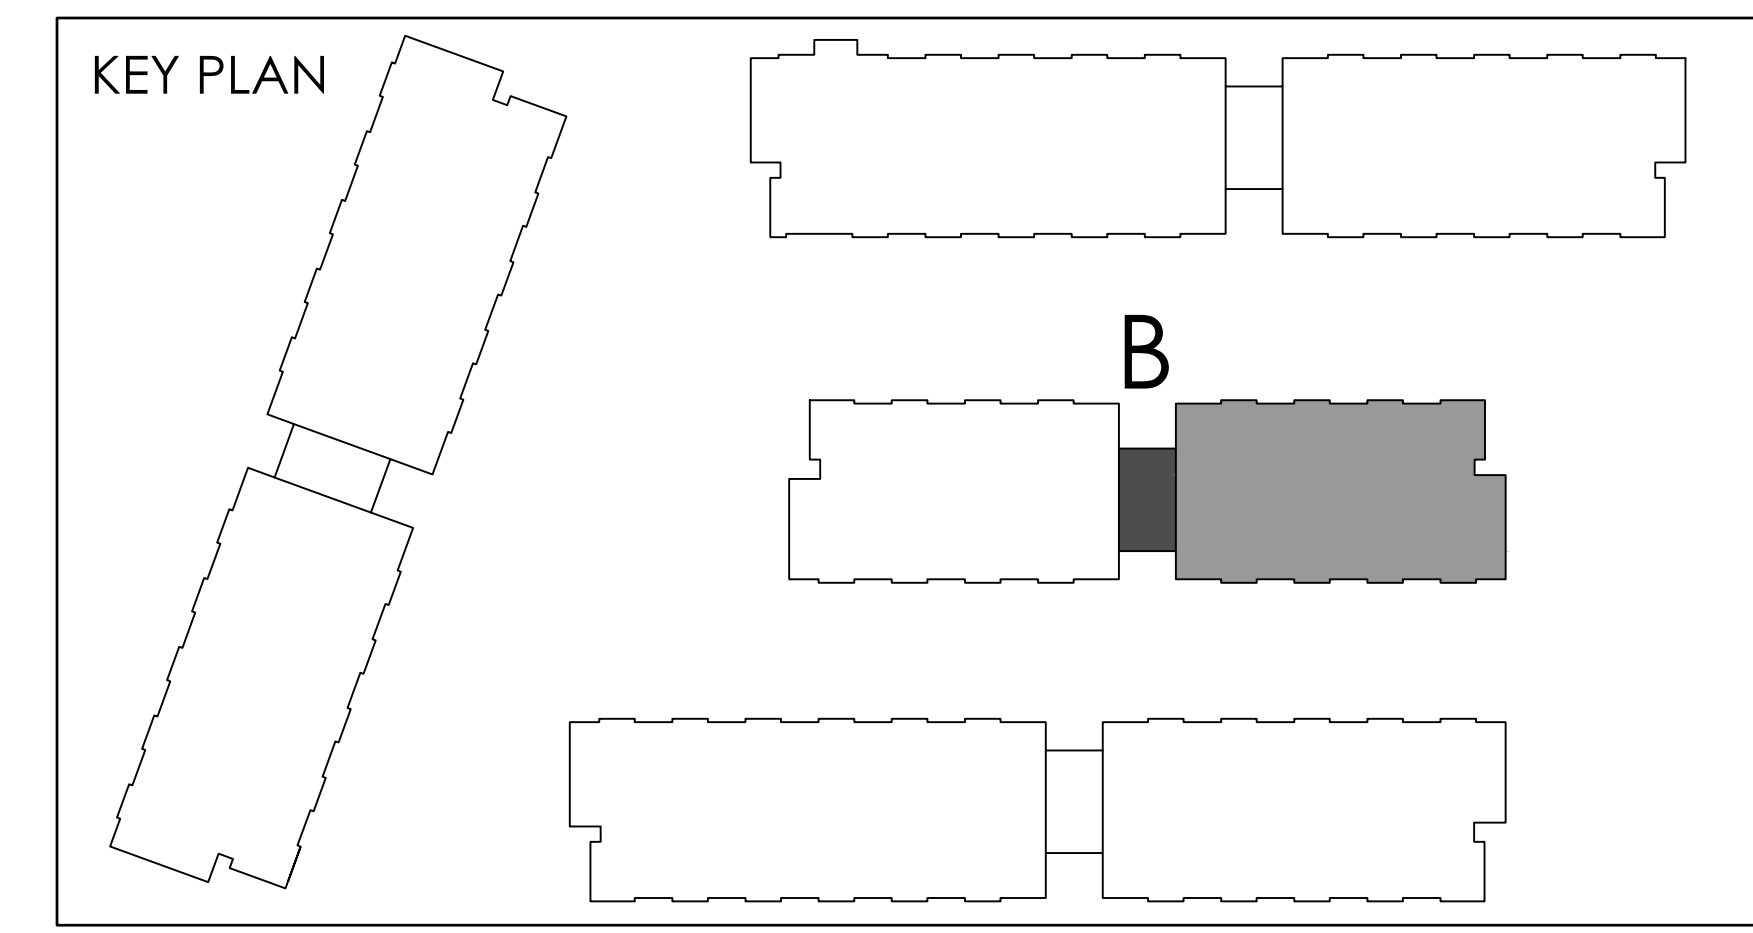

THIS DRAWING IS AN INSTRUMENT OF SERVICE, IT IS PROVIDED BY AND IS THE PROPERTY OF GRAZIANI-CORAZZA ARCHITECTS INC. THE CONTRACTOR MUST NOT REPRODUCE OR COPY THIS DRAWING OR ANY PART THEREOF FOR ANY PURPOSES WITHOUT THE WRITTEN PERMISSION OF GRAZIANI-CORAZZA ARCHITECTS INC. ANY VARIATIONS FROM THE SHOWN INFORMATION SHALL BE THE RESPONSIBILITY OF THE CONTRACTOR. THE CONTRACTOR SHALL BE RESPONSIBLE FOR THE ACCURACY OF SURVEY, STRUCTURAL, MECHANICAL, ELECTRICAL AND OTHER ENGINEERING INFORMATION SHOWN ON THIS DRAWING. REFER TO THE APPROPRIATE ENGINEERING DRAWINGS BEFORE PROCEEDING WITH THE WORK. CONSTRUCTION MUST COMPLY TO ALL APPLICABLE CODES AND REQUIREMENTS OF THE AUTHORITY HAVING JURISDICTION. UNLESS OTHERWISE NOTED, NO INVESTIGATION HAS BEEN CONDUCTED OR REPORTED BY THIS OFFICE IN RESPECT TO THE ENVIRONMENTAL CONDITION OF THIS SITE.

THIS DRAWING IS NOT TO BE SCALED. ALL ARCHITECTURAL DIMENSIONS INDICATED ON THIS DRAWING ARE GRAPHIC REPRESENTATIONS ONLY.


CONDITIONS FOR ELECTRONIC INFORMATION TRANSFER:

ELECTRONIC INFORMATION IS SUPPLIED TO THE OTHER ASSOCIATED FIRMS TO ASSIST THEM IN THE EXECUTION OF THEIR WORK. REVIEW THE RECEIVING FIRMS MUST DETERMINE THE COMPLETENESS, APPROPRIATENESS, RELIANCE OF THE INFORMATION IN RESPECT TO THEIR PARTICULAR RESPONSIBILITY.

GRAZIANI-CORAZZA ARCHITECTS INC. SHALL NOT BE RESPONSIBLE FOR:

1. ERRORS, OMISSIONS, INCOMPLETENESS DUE TO USE OF INFORMATION IN WHICH THE INFORMATION IS TRANSMITTED;
2. TRANSMISSION OF ANY VIRUS OR DAMAGE TO THE RECEIVING ELECTRONIC SYSTEM WHEN INFORMATION IS TRANSMITTED.

REF A30102 FOR CONTINUATION

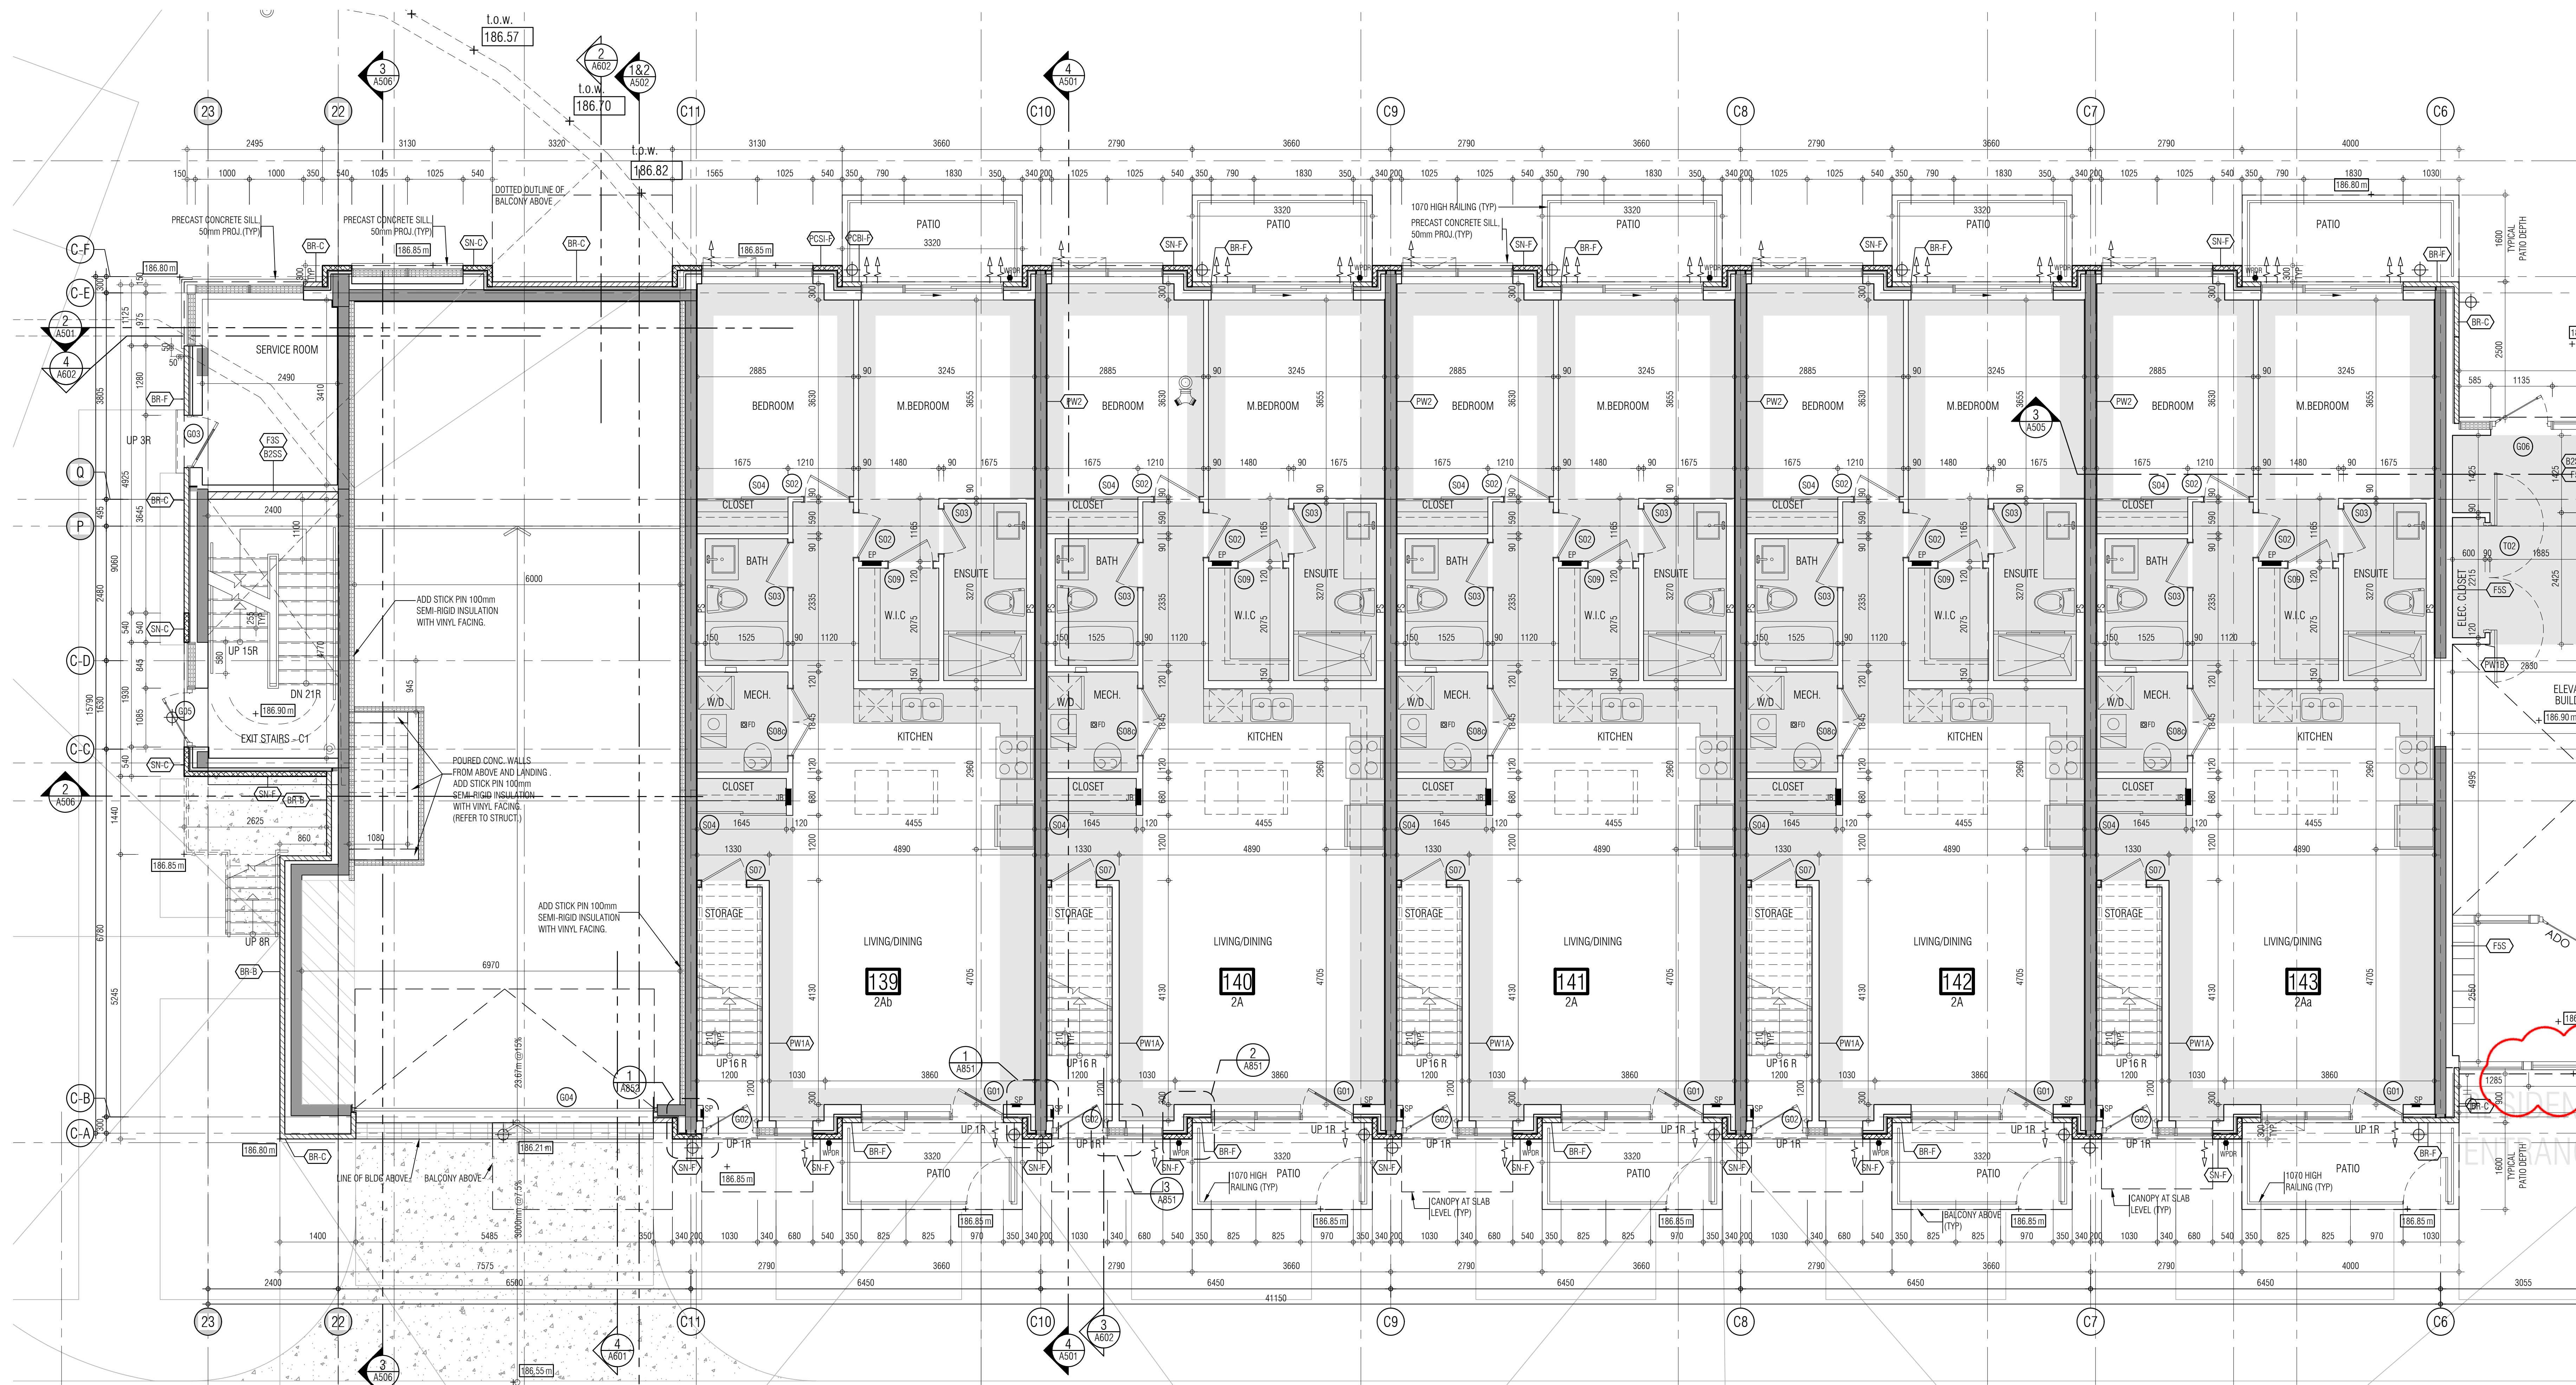

- 01. Oct.07.2019 issued for tender
- 02. Mar.13.2020 issued for design coordination #2
- 03. Mar.16.2020 issued for addendum #2
- 04. Mar.16.2020 issued for addendum #3
- 05. Aug.24.2020 issued for addendum #4
- 06. Sept. 28.2020 issued for permit
- 07. Oct.20.2020 issued for addendum #5
- 08. Nov.23.2020 issued for addendum #6
- 09. Dec.14.2020 issued for addendum #7
- 10. Jan.18.2021 issued for addendum #8
- 11. Mar. 2.2021 issued for permit
- 12. Mar.09.2021 issued for addendum #9
- 13. Mar.10.2021 issued for addendum #9R
- 14. Mar.26.2021 issued for progress
- 15. May.14.2021 issued for Site Instruction #1
- 16. June.15.2021 re-issued for Site Instruction #2
- 17. July. 7.2021 re-issued for permit
- 18. July.15.2021 issued for Site Instruction #3
- 19. July.27.2021 issued for Site Instruction #4
- 20. Aug. 3.2021 issued for Site Instruction #5
- 21. Aug.18.2021 issued for Site Instruction #6
- 22. Aug.20.2021 re-issued for permit
- 23. Sept. 07.2021 issued for Site Instruction #7
- 24. Sept. 09.2021 issued for Site Instruction #8
- 25. Sept. 16.2021 issued for Building D Permit Revisions
- 26. Sept. 22.2021 issued for Site Instruction #9
- 27. Oct. 6.2021 re-issued for permit
- 28. Oct. 8.2021 issued for Site Instruction #10
- 30. Oct.28.2021 issued for Site Instruction #11
- 31. Nov. 05.2021 issued for Site Instruction #12
- 32. Dec. 3.2021 issued for Site Instruction #13
- 33. Dec. 6.2021 issued for Site Instruction #14
- 34. Dec. 7.2021 issued for Site Instruction #15
- 35. Jan. 26.2022 issued for Site Instruction #16
- 36. Jan. 31.2022 issued for Site Instruction #17
- 37. Mar. 11.2022 issued for Site Instruction #18
- 38. Apr. 29.2022 issued for Site Instruction #19
- 39. May. 10.2022 issued for Site Instruction #20
- 40. May. 24.2022 issued for Site Instruction #21

01. SEP19/2019 issued for addendum 1

issued for revisions

GRAZIANI CORAZZA ARCHITECTS

1325 SHANAGARA DRIVE, SUITE 103 MISSISSAUGA, ONTARIO L4W 1C3
 905-881-0241 FAX: 905-881-3888 WWW.GC-ARCHITECTS.COM

RESIDENTIAL

ATTMAY + PALLESCHI DRIVE

BRAMPTON ONTARIO

PROJECT ARCHITECT: B. GRAZIANI
 ASSISTANT DESIGNER: R. LINCOLN
 DRAWN BY: G.C.F./M.B.
 CHECKED BY: D. BIASE/G. COLANGELO
 PLOT DATE: MAY 24 2022
 JOB #: 1331.15

GROUND FLOOR PLAN
BUILDING C (PARTIAL PLAN)

1:50 A-301c1

TITLEBLOCK SIZE: 915 x 1200

REF. A301b1 FOR CONTINUATION

THIS DRAWING IS AN INSTRUMENT OF SERVICE, IT IS PROVIDED BY AND IS THE PROPERTY OF GRAZIANI-CORAZZA ARCHITECTS INC. THE CONTRACTOR MUST VERIFY AND ACCEPT RESPONSIBILITY FOR ALL DIMENSIONS AND CONDITIONS ON SITE AND VERIFY WITH GRAZIANI-CORAZZA ARCHITECTS INC. IF ANY VARIATIONS FROM THE SUPPLIED INFORMATION OCCUR. GRAZIANI-CORAZZA ARCHITECTS INC. IS NOT RESPONSIBLE FOR THE ACCURACY OF SURVEY, STRUCTURAL, MECHANICAL, ELECTRICAL AND OTHER ENGINEERING INFORMATION SHOWN ON THIS DRAWING. REFER TO THE APPROPRIATE ENGINEERING DRAWINGS BEFORE PROCEEDING WITH THE WORK. CONSTRUCTION MUST COMPLY TO ALL APPLICABLE CODES AND REQUIREMENTS OF THE AUTHORITY HAVING JURISDICTION, UNLESS OTHERWISE NOTED. NO WARRANTY HAS BEEN MADE OR IS REPORTED BY THIS OFFICE IN RESPECT TO THE ENVIRONMENTAL CONDITION OF THIS SITE.


THIS DRAWING IS NOT TO BE SCALED. ALL ARCHITECTURAL DIMENSIONS INDICATED ON THIS DRAWING ARE GRAPHIC REPRESENTATIONS ONLY.

CONDITIONS FOR ELECTRONIC INFORMATION TRANSFER:

ELECTRONIC INFORMATION IS SUPPLIED TO THE OTHER ASSOCIATED FIRMS TO ASSIST THEM IN THE EXECUTION OF THEIR WORK. REVIEW THE RECEIVING FIRMS MUST DETERMINE THE COMPLETENESS, APPROPRIATENESS, RELIANCE OF THE INFORMATION IN RESPECT TO THEIR PARTICULAR RESPONSIBILITY.

GRAZIANI-CORAZZA ARCHITECTS INC. SHALL NOT BE RESPONSIBLE FOR:

1. ERROR, OMISSION, INCOMPLETENESS DUE TO LOSS OF INFORMATION IN WHOLE OR PART FROM INFORMATION TRANSFERRED;
2. TRANSMISSION OF ANY VIRUS OR DAMAGE TO THE RECEIVING ELECTRONIC SYSTEM WHEN INFORMATION IS TRANSFERRED.

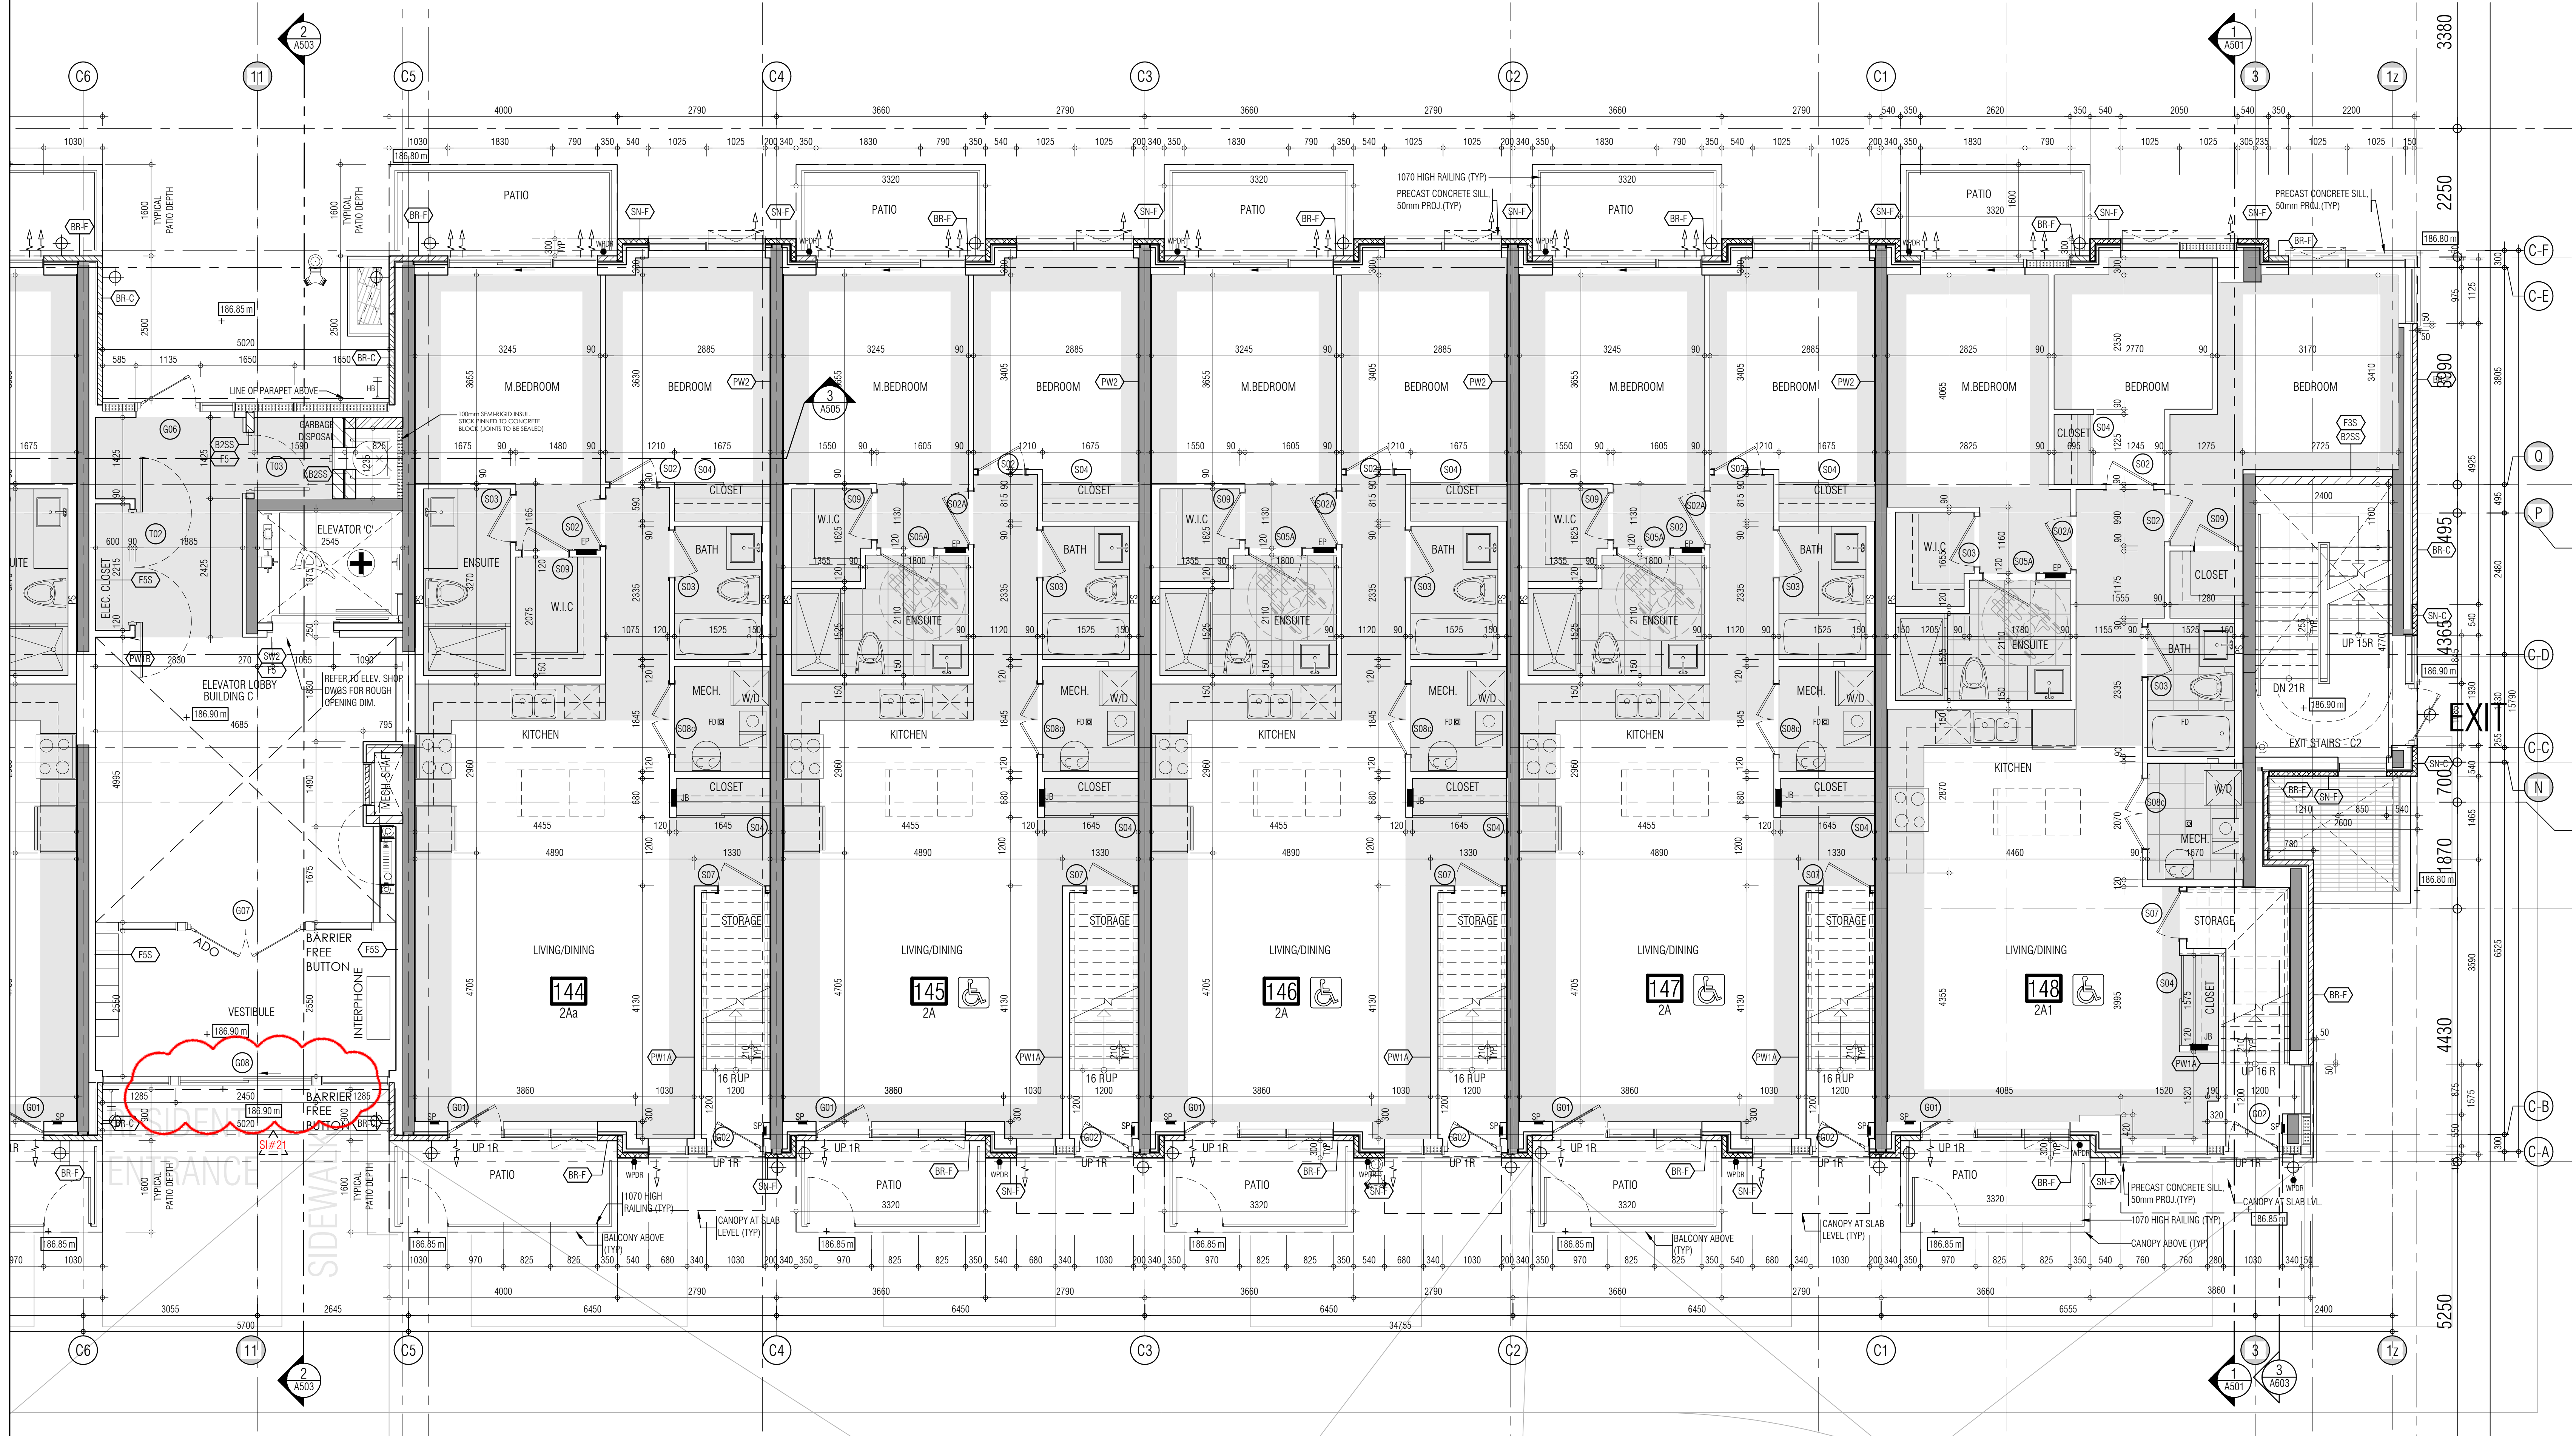

- 01. Oct.07.2019 issued for tender
- 02. Mar.13.2020 issued for design coordination #2
- 03. Mar.16.2020 issued for addendum #2
- 04. Mar.16.2020 issued for addendum #3
- 05. Aug.24.2020 issued for addendum #4
- 06. Sept. 28.2020 issued for permit
- 07. Oct.20.2020 issued for addendum #5
- 08. Nov.23.2020 issued for addendum #6
- 09. Dec.14.2020 issued for addendum #7
- 10. Jan.18.2021 issued for addendum #8
- 11. Mar. 2.2021 issued for permit
- 12. Mar.09.2021 issued for addendum #9
- 13. Mar.10.2021 issued for addendum #9R
- 14. Mar.26.2021 issued for progress
- 15. May.14.2021 issued for Site Instruction #1
- 16. June.15.2021 issued for Site Instruction #2
- 17. July. 7.2021 re-issued for permit
- 18. July.15.2021 issued for Site Instruction #3
- 19. July.27.2021 issued for Site Instruction #4
- 20. Aug. 3.2021 issued for Site Instruction #5
- 21. Aug.18.2021 issued for Site Instruction #6
- 22. Aug.30.2021 Re-issued for permit
- 23. Sept. 07.2021 issued for Site Instruction #7
- 24. Sept. 09.2021 issued for Site Instruction #8
- 25. Sept. 16.2021 issued for Building D Permit Revisions
- 26. Sept. 22.2021 issued for Site Instruction #9
- 27. Oct. 6.2021 Re-issued for permit
- 28. Oct. 8.2021 issued for Site Instruction #10
- 29. Oct.28.2021 issued for Site Instruction #11
- 30. Nov. 05.2021 issued for Site Instruction #12
- 31. Dec. 3.2021 issued for Site Instruction #13
- 32. Dec. 6.2021 issued for Site Instruction #14
- 33. Dec. 7.2021 issued for Site Instruction #15
- 34. Dec. 7.2021 issued for Site Instruction #16
- 35. Jan. 26.2022 issued for Site Instruction #18
- 36. Jan. 31.2022 issued for Site Instruction #17
- 37. Mar. 11.2022 issued for Site Instruction #18
- 38. Apr. 29.2022 issued for Site Instruction #19
- 39. May. 10.2022 issued for Site Instruction #20
- 40. May. 24.2022 issued for Site Instruction #21

01. SEP.18.2019 issued for addendum 1

GRAZIANI
CORAZZA
ARCHITECTS

1325 SHANAGOGA DRIVE, SUITE 103 MISSISSAUGA, ONTARIO L4W 1C3
905-880-0241 FAX: 905-880-3888 WWW.GC-ARCHITECTS.COM

RESIDENTIAL


ATTMAY + PALLESCHI DRIVE

BRAMPTON ONTARIO

PROJECT ARCHITECT: B. GRAZIANI
ASSISTANT DESIGNER: R. LINCOLN
DRAWN BY: G. C.F./M.B.
CHECKED BY: D. BIASE/G. COLANGELO
PLOT DATE: MAY 24, 2022
JOB #: 1331.15

GROUND FLOOR PLAN
BUILDING C (PARTIAL PLAN)

1:50 A-301c2
TITLEBLOCK SIZE: 915 x 1200

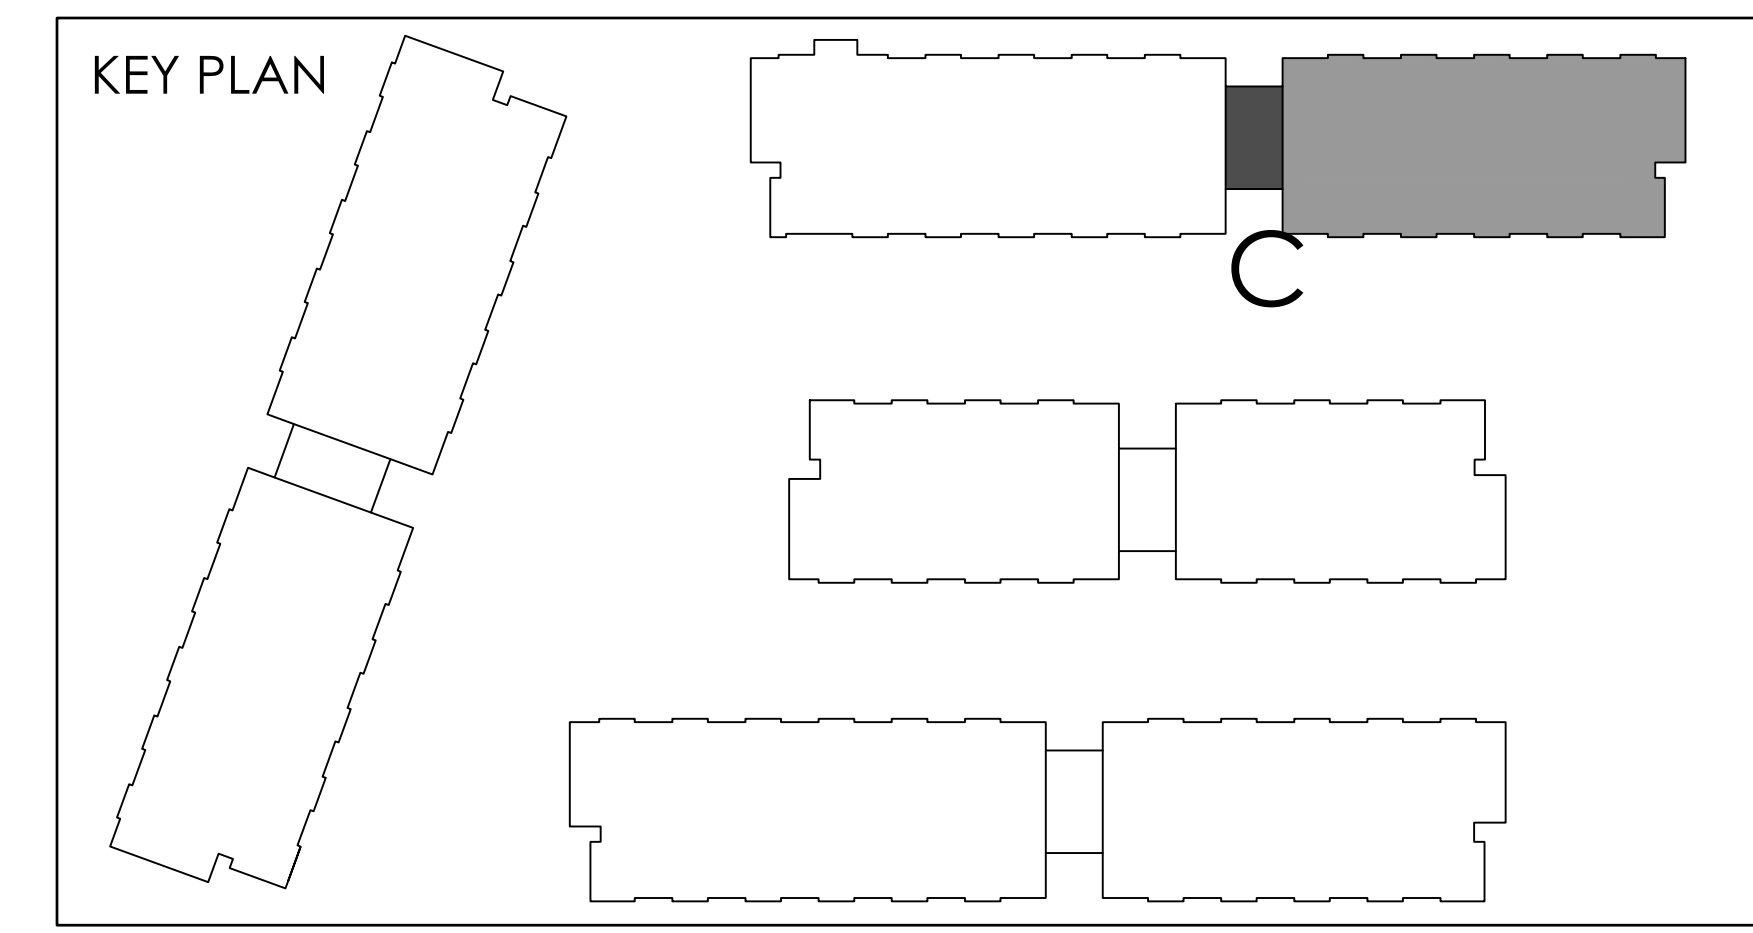

THIS DRAWING IS AN INSTRUMENT OF SERVICE, IT IS PROVIDED BY AND IS THE PROPERTY OF GRAZIANI CORAZZA ARCHITECTS INC. THE CONTRACTOR MUST NOT REPRODUCE OR COPY THIS DRAWING FOR ANY PURPOSES WITHOUT THE WRITTEN PERMISSION OF GRAZIANI CORAZZA ARCHITECTS INC. ANY VARIATIONS FROM THE SPECIFIED INFORMATION SHALL BE THE RESPONSIBILITY OF THE CONTRACTOR. GRAZIANI CORAZZA ARCHITECTS INC. IS NOT RESPONSIBLE FOR THE ACCURACY OF SURVEY, STRUCTURAL, MECHANICAL, ELECTRICAL AND OTHER ENGINEERING INFORMATION SHOWN ON THIS DRAWING. REFER TO THE APPROPRIATE ENGINEERING DRAWINGS BEFORE PROCEEDING WITH THE WORK. CONSTRUCTION MUST CONFORM TO ALL APPLICABLE CODES AND REQUIREMENTS OF THE AUTHORITY HAVING JURISDICTION, UNLESS OTHERWISE NOTED. NO WARRANTY HAS BEEN MADE OR IS INTENDED BY THIS OFFICE IN RESPECT TO THE ENVIRONMENTAL CONDITION OF THIS SITE.

THIS DRAWING IS NOT TO BE SCALED. ALL ARCHITECTURAL DIMENSIONS INDICATED ON THIS DRAWING ARE GRAPHIC REPRESENTATIONS ONLY.

CONDITIONS FOR ELECTRONIC INFORMATION TRANSFER:

ELECTRONIC INFORMATION IS SUPPLIED TO THE OTHER ASSOCIATED FIRMS TO ASSIST THEM IN THE EXECUTION OF THEIR WORK. REVIEW THE RECORDING FIRMS MUST DETERMINE THE COMPLETENESS, APPROPRIATENESS, RELIANCE OF THE INFORMATION IN RESPECT TO THEIR PARTICULAR RESPONSIBILITY.

GRAZIANI CORAZZA ARCHITECTS INC. SHALL NOT BE RESPONSIBLE FOR:

1. ERRORS, OMISSIONS, INCOMPLETENESS DUE TO USE OF INFORMATION IN WHICH THE INFORMATION IS TRANSMITTED
2. TRANSMISSION OF ANY KIND OF DAMAGE TO THE RECEIVING ELECTRONIC SYSTEM WHEN INFORMATION IS TRANSMITTED

- 01. Oct.07.2019 issued for tender
- 02. Mar.13.2020 issued for design coordination #2
- 03. Mar.16.2020 issued for addendum #2
- 04. Mar.16.2020 issued for addendum #3
- 05. Aug.24.2020 issued for addendum #4
- 06. Sept. 28.2020 issued for permit
- 07. Oct.20.2020 issued for addendum #5
- 08. Nov.23.2020 issued for addendum #6
- 09. Dec.14.2020 issued for addendum #7
- 10. Jan.18.2021 issued for addendum #8
- 11. Mar. 2.2021 issued for permit
- 12. Mar.09.2021 issued for addendum #9
- 13. Mar.10.2021 issued for addendum #9R
- 14. Mar.26.2021 issued for progress
- 15. May.14.2021 issued for Site Instruction #1
- 16. June.15.2021 issued for Site Instruction #2
- 17. July. 7.2021 re-issued for permit
- 18. July.15.2021 issued for Site Instruction #3
- 19. July.27.2021 issued for Site Instruction #4
- 20. Aug. 3.2021 issued for Site Instruction #5
- 21. Aug.18.2021 issued for Site Instruction #6
- 22. Aug.20.2021 Re-issued for permit
- 23. Sept. 07.2021 issued for Site Instruction #7
- 24. Sept. 09.2021 issued for Site Instruction #8
- 25. Sept. 16.2021 issued for Building D Permit Revisions
- 26. Sept. 22.2021 issued for Site Instruction #9
- 27. Oct. 6.2021 Re-issued for permit
- 28. Oct. 8.2021 issued for Site Instruction #10
- 30. Oct.28.2021 issued for Site Instruction #11
- 31. Nov.05.2021 issued for Site Instruction #12
- 32. Dec. 3.2021 issued for Site Instruction #13
- 33. Dec. 6.2021 issued for Site Instruction #14
- 34. Dec. 7.2021 issued for Site Instruction #15
- 35. Jan. 26.2022 issued for Site Instruction #16
- 36. Jan. 31.2022 issued for Site Instruction #17
- 37. Mar. 11.2022 issued for Site Instruction #18
- 38. Apr. 29.2022 issued for Site Instruction #19
- 39. May. 10.2022 issued for Site Instruction #20
- 40. May. 24.2022 issued for Site Instruction #21

01. SEP19/20219 issued for addendum 1

issued for revisions



RESIDENTIAL

ATTMAY + PALLESCHI DRIVE

BRAMPTON ONTARIO



PROJECT ARCHITECT: B. GRAZIANI
ASSISTANT DESIGNER: R. LINCOLN
DRAWN BY: G.C./F.C./M.B.
CHECKED BY: D. BIASE/G. COLANGELO
JOB DATE: MAY 24, 2022
JOB #: 1331.15

**GROUND FLOOR PLAN
BUILDING D (PARTIAL PLAN)**

1:50 A-301d1

TITLEBLOCK SIZE: 915 x 1200

REF-A301a2 FOR CONTINUATION

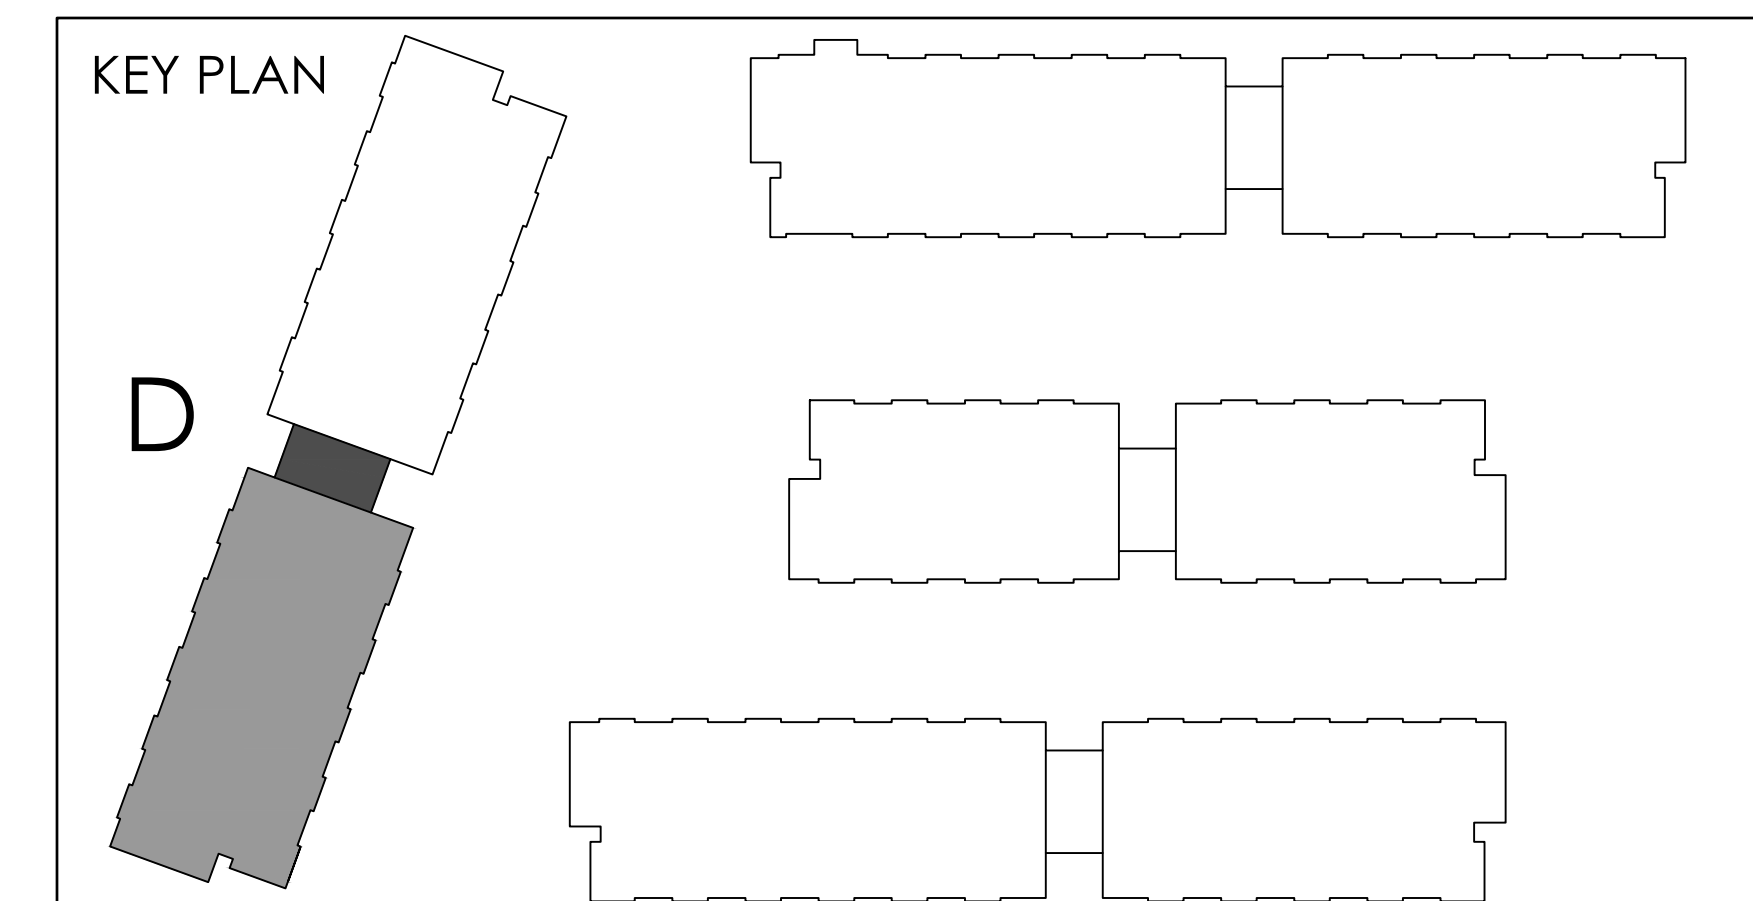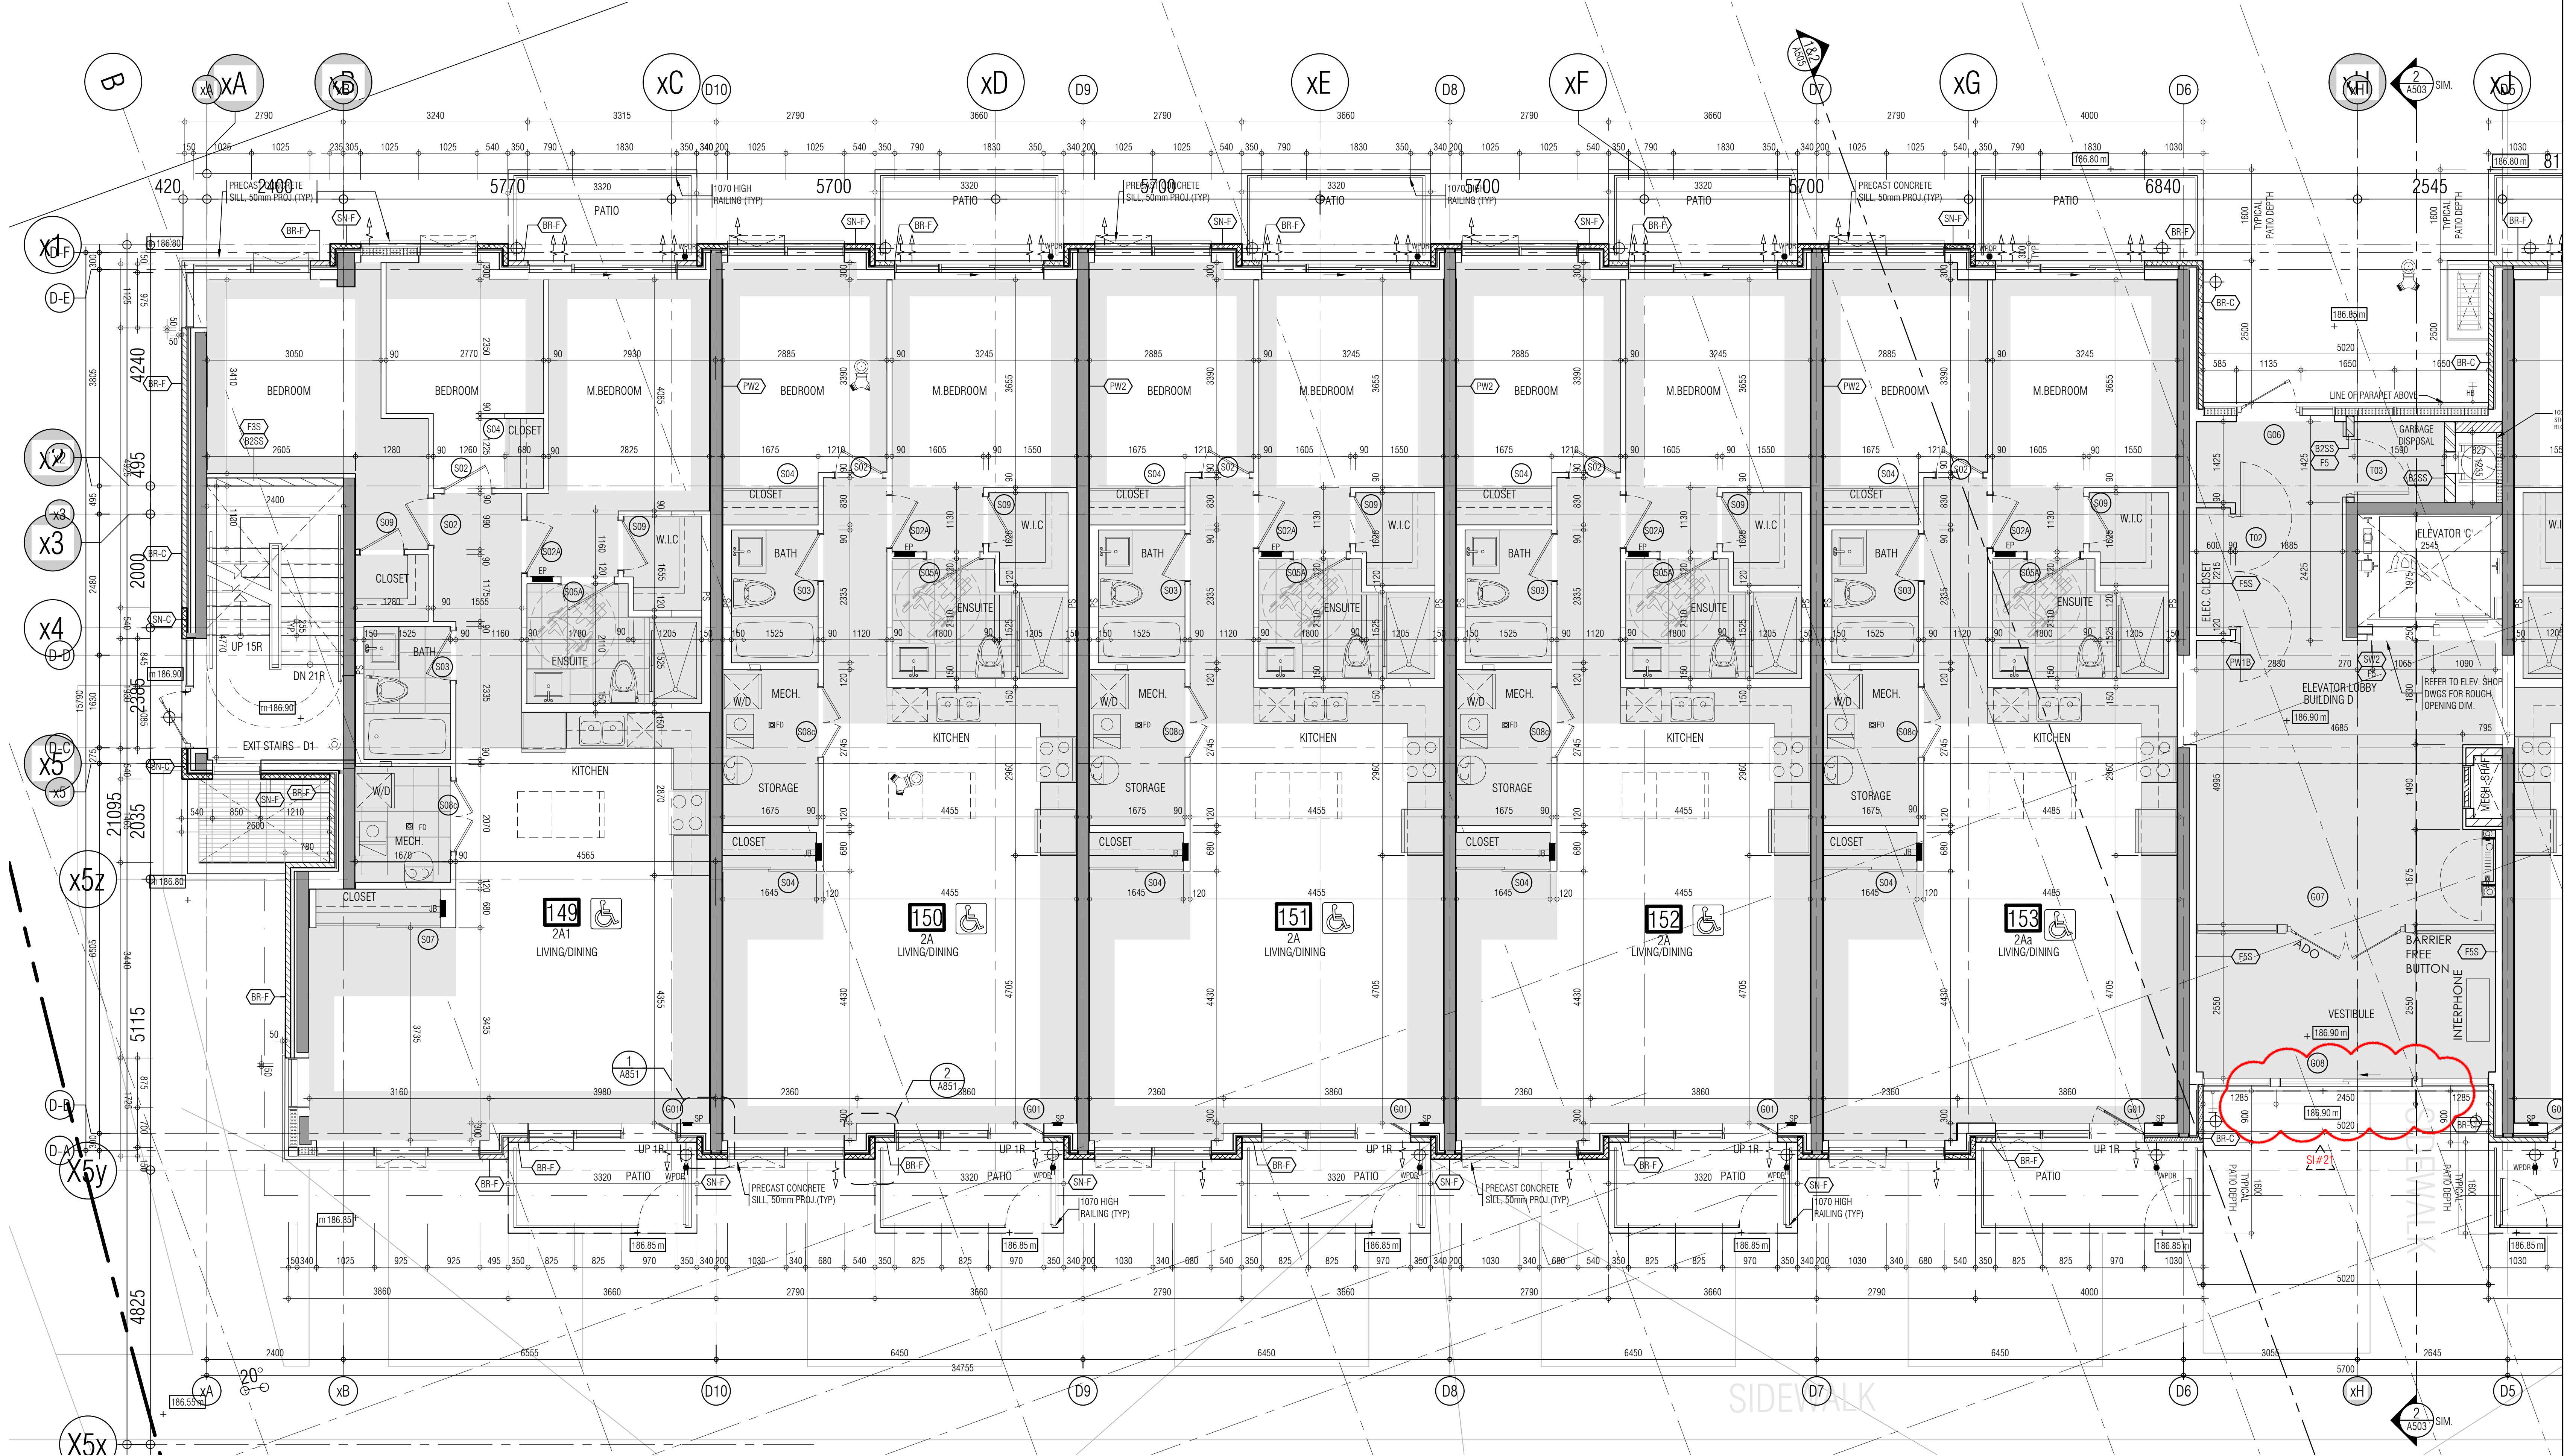

THIS DRAWING IS AN INSTRUMENT OF SERVICE, IT IS PROVIDED BY AND IS THE PROPERTY OF GRAZIANI-CORAZZA ARCHITECTS INC. THE CONTRACTOR MUST NOT REPRODUCE OR COPY THIS DRAWING OR ANY PART THEREOF FOR ANY PURPOSES WITHOUT THE WRITTEN PERMISSION OF GRAZIANI-CORAZZA ARCHITECTS INC. ANY REVISIONS TO THIS DRAWING MUST BE APPROVED BY GRAZIANI-CORAZZA ARCHITECTS INC. IT IS THE RESPONSIBILITY OF THE CONTRACTOR TO VERIFY THE ACCURACY OF SURVEY, STRUCTURAL, MECHANICAL, ELECTRICAL AND OTHER ENGINEERING INFORMATION SHOWN ON THIS DRAWING. REFER TO THE APPROPRIATE ENGINEERING DRAWINGS BEFORE PROCEEDING WITH THE WORK. CONSTRUCTION MUST CONFORM TO ALL APPLICABLE CODES AND REQUIREMENTS OF THE AUTHORITY HAVING JURISDICTION, UNLESS OTHERWISE NOTED. NO MODIFICATION HAS BEEN MADE OR IS REPORTED TO BE MADE BY THIS OFFICE IN RESPONSE TO THE ENVIRONMENTAL CONDITION OF THIS SITE.

THIS DRAWING IS NOT TO BE SCALED. ALL ARCHITECTURAL DIMENSIONS INDICATED ON THIS DRAWING ARE GRAPHIC REPRESENTATIONS ONLY.

CONFORMING FOR ELECTRONIC INFORMATION TRANSFER:

ELECTRONIC INFORMATION IS SUPPLIED TO THE OTHER ASSOCIATED FIRMS TO ASSIST THEM IN THE EXECUTION OF THEIR WORK. REVIEW THE RECEIVED FIRMS MUST DETERMINE THE COMPLETENESS, APPROPRIATENESS, RELIANCE OF THE INFORMATION IN RESPECT TO THEIR PARTICULAR RESPONSIBILITY.

GRAZIANI-CORAZZA ARCHITECTS INC. SHALL NOT BE RESPONSIBLE FOR:

1. ERRORS, OMISSIONS, INCOMPLETENESS DUE TO USE OF INFORMATION IN WHOLE OR PART INFORMATION IS TRANSMITTED OR TRANSMISSION OF ANY KIND OF DAMAGE TO THE RECEIVING ELECTRONIC SYSTEM WHEN INFORMATION IS TRANSMITTED.

- 01. Oct.07.2019 issued for tender
- 02. Mar.13.2020 issued for design coordination #2
- 03. Mar.16.2020 issued for addendum #2
- 04. Mar.16.2020 issued for addendum #3
- 05. Aug.24.2020 issued for addendum #4
- 06. Sept. 28.2020 issued for permit
- 07. Oct.20.2020 issued for addendum #5
- 08. Nov.23.2020 issued for addendum #6
- 09. Dec.14.2020 issued for addendum #7
- 10. Jan.18.2021 issued for addendum #8
- 11. Mar. 2.2021 issued for permit
- 12. Mar.09.2021 issued for addendum #9
- 13. Mar.10.2021 issued for addendum #9R
- 14. Mar.26.2021 issued for progress
- 15. May.15.2021 issued for Site Instruction #1
- 16. June.15.2021 issued for Site Instruction #2
- 17. July. 7. 2021 re-issued for permit
- 18. July.27.2021 issued for Site Instruction #3
- 19. Aug. 3. 2021 issued for Site Instruction #4
- 20. Aug. 18. 2021 issued for Site Instruction #5
- 21. Aug. 18. 2021 issued for Site Instruction #6
- 22. Aug. 20. 2021 Re-issued for permit
- 23. Sept. 07. 2021 issued for Site Instruction #7
- 24. Sept. 09. 2021 issued for Site Instruction #8
- 25. Sept. 16. 2021 issued for Building D Permit Revisions
- 26. Sept. 22. 2021 issued for Site Instruction #9
- 27. Oct. 6. 2021 Re-issued for permit
- 28. Oct. 8. 2021 issued for Site Instruction #10
- 29. Oct. 28. 2021 issued for Site Instruction #11
- 30. Nov. 05. 2021 issued for Site Instruction #12
- 31. Dec. 3. 2021 issued for Site Instruction #13
- 32. Dec. 3. 2021 issued for Site Instruction #13
- 33. Dec. 6. 2021 issued for Site Instruction #14
- 34. Dec. 7. 2021 issued for Site Instruction #15
- 35. Jan. 26. 2022 issued for Site Instruction #16
- 36. Jan. 31. 2022 issued for Site Instruction #17
- 37. Mar. 11. 2022 issued for Site Instruction #18
- 38. Apr. 29. 2022 issued for Site Instruction #19
- 39. May. 10. 2022 issued for Site Instruction #20
- 40. May. 24. 2022 issued for Site Instruction #21

01. SEP.19.2019 issued for addendum 1

issued for revisions



**GRAZIANI
CORAZZA
ARCHITECTS**

1105 SHAWANIGAN DRIVE, SUITE 100 MISSISSAUGA, ONTARIO L4W 1C3
905-270-0201 FAX: 905-270-3988 WWW.GC-ARCHITECTS.COM

RESIDENTIAL

ATTMAR + PALLESCHI DRIVE

BRAMPTON ONTARIO



PROJECT ARCHITECT: B. GRAZIANI
ASSISTANT DESIGNER: R. LINCOLN
DRAWN BY: G.C./F.C./M.B.
CHECKED BY: D. BIASE/G. COLANGELO
PLOT DATE: MAY 24 2022
JOB #: 1331.15

**GROUND FLOOR PLAN
BUILDING D (PARTIAL PLAN)**

1:50 A-301d2

TITLEBLOCK SIZE: 915 x 1200

REF_A301a1 FOR CONTINUATION

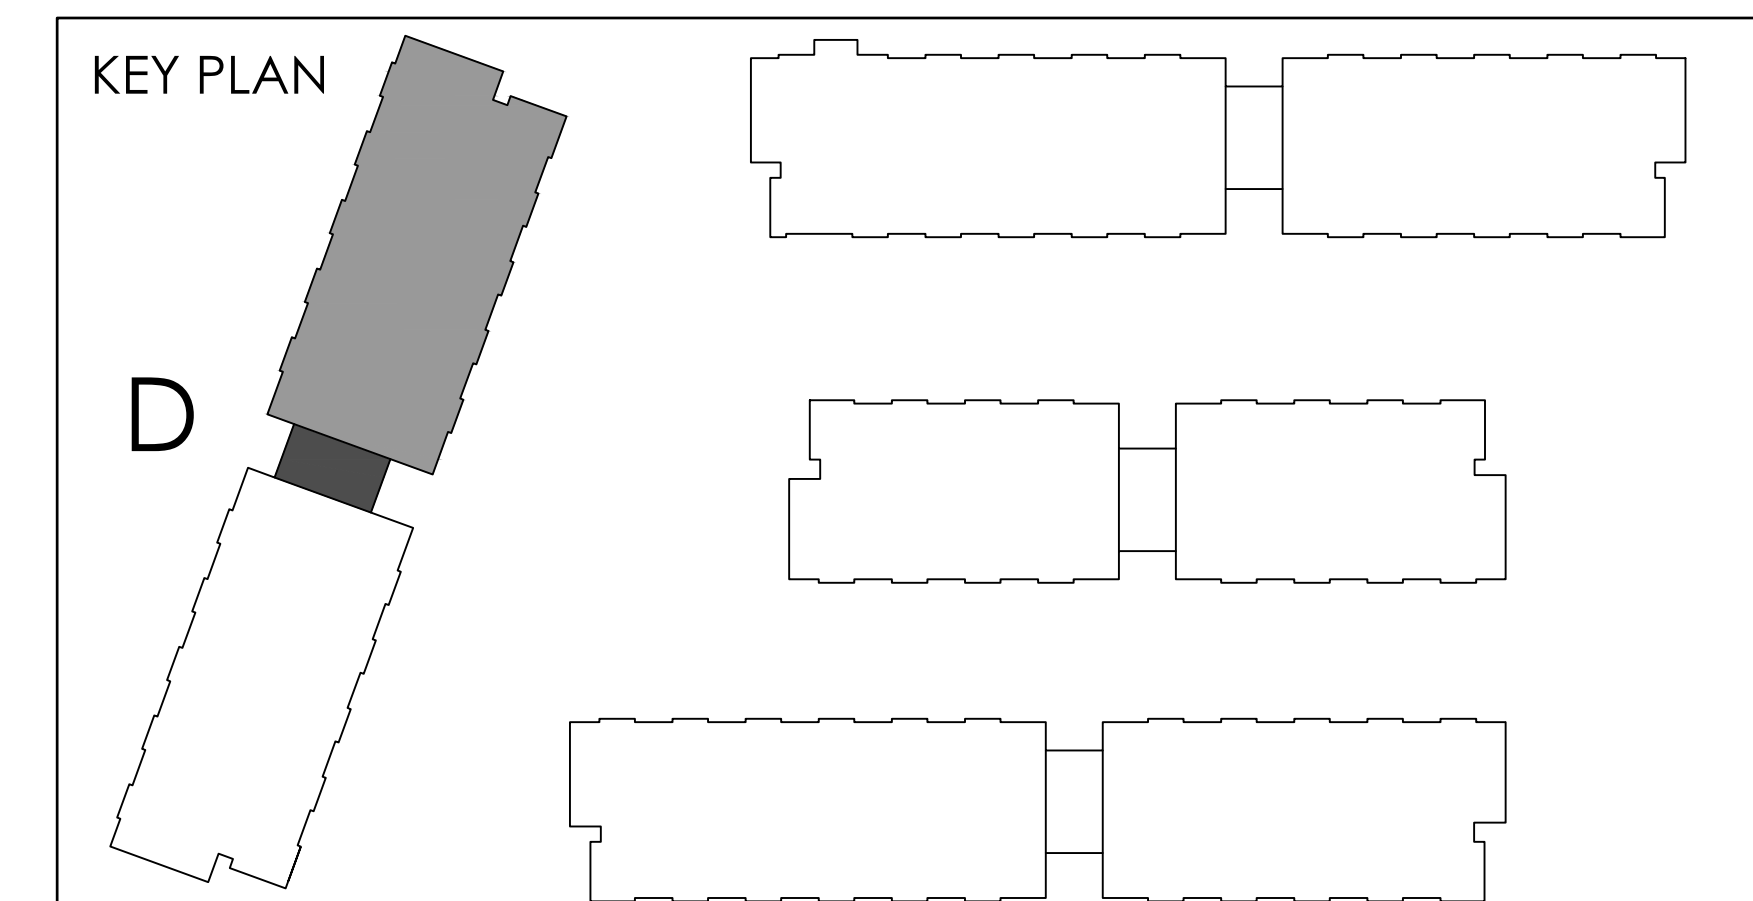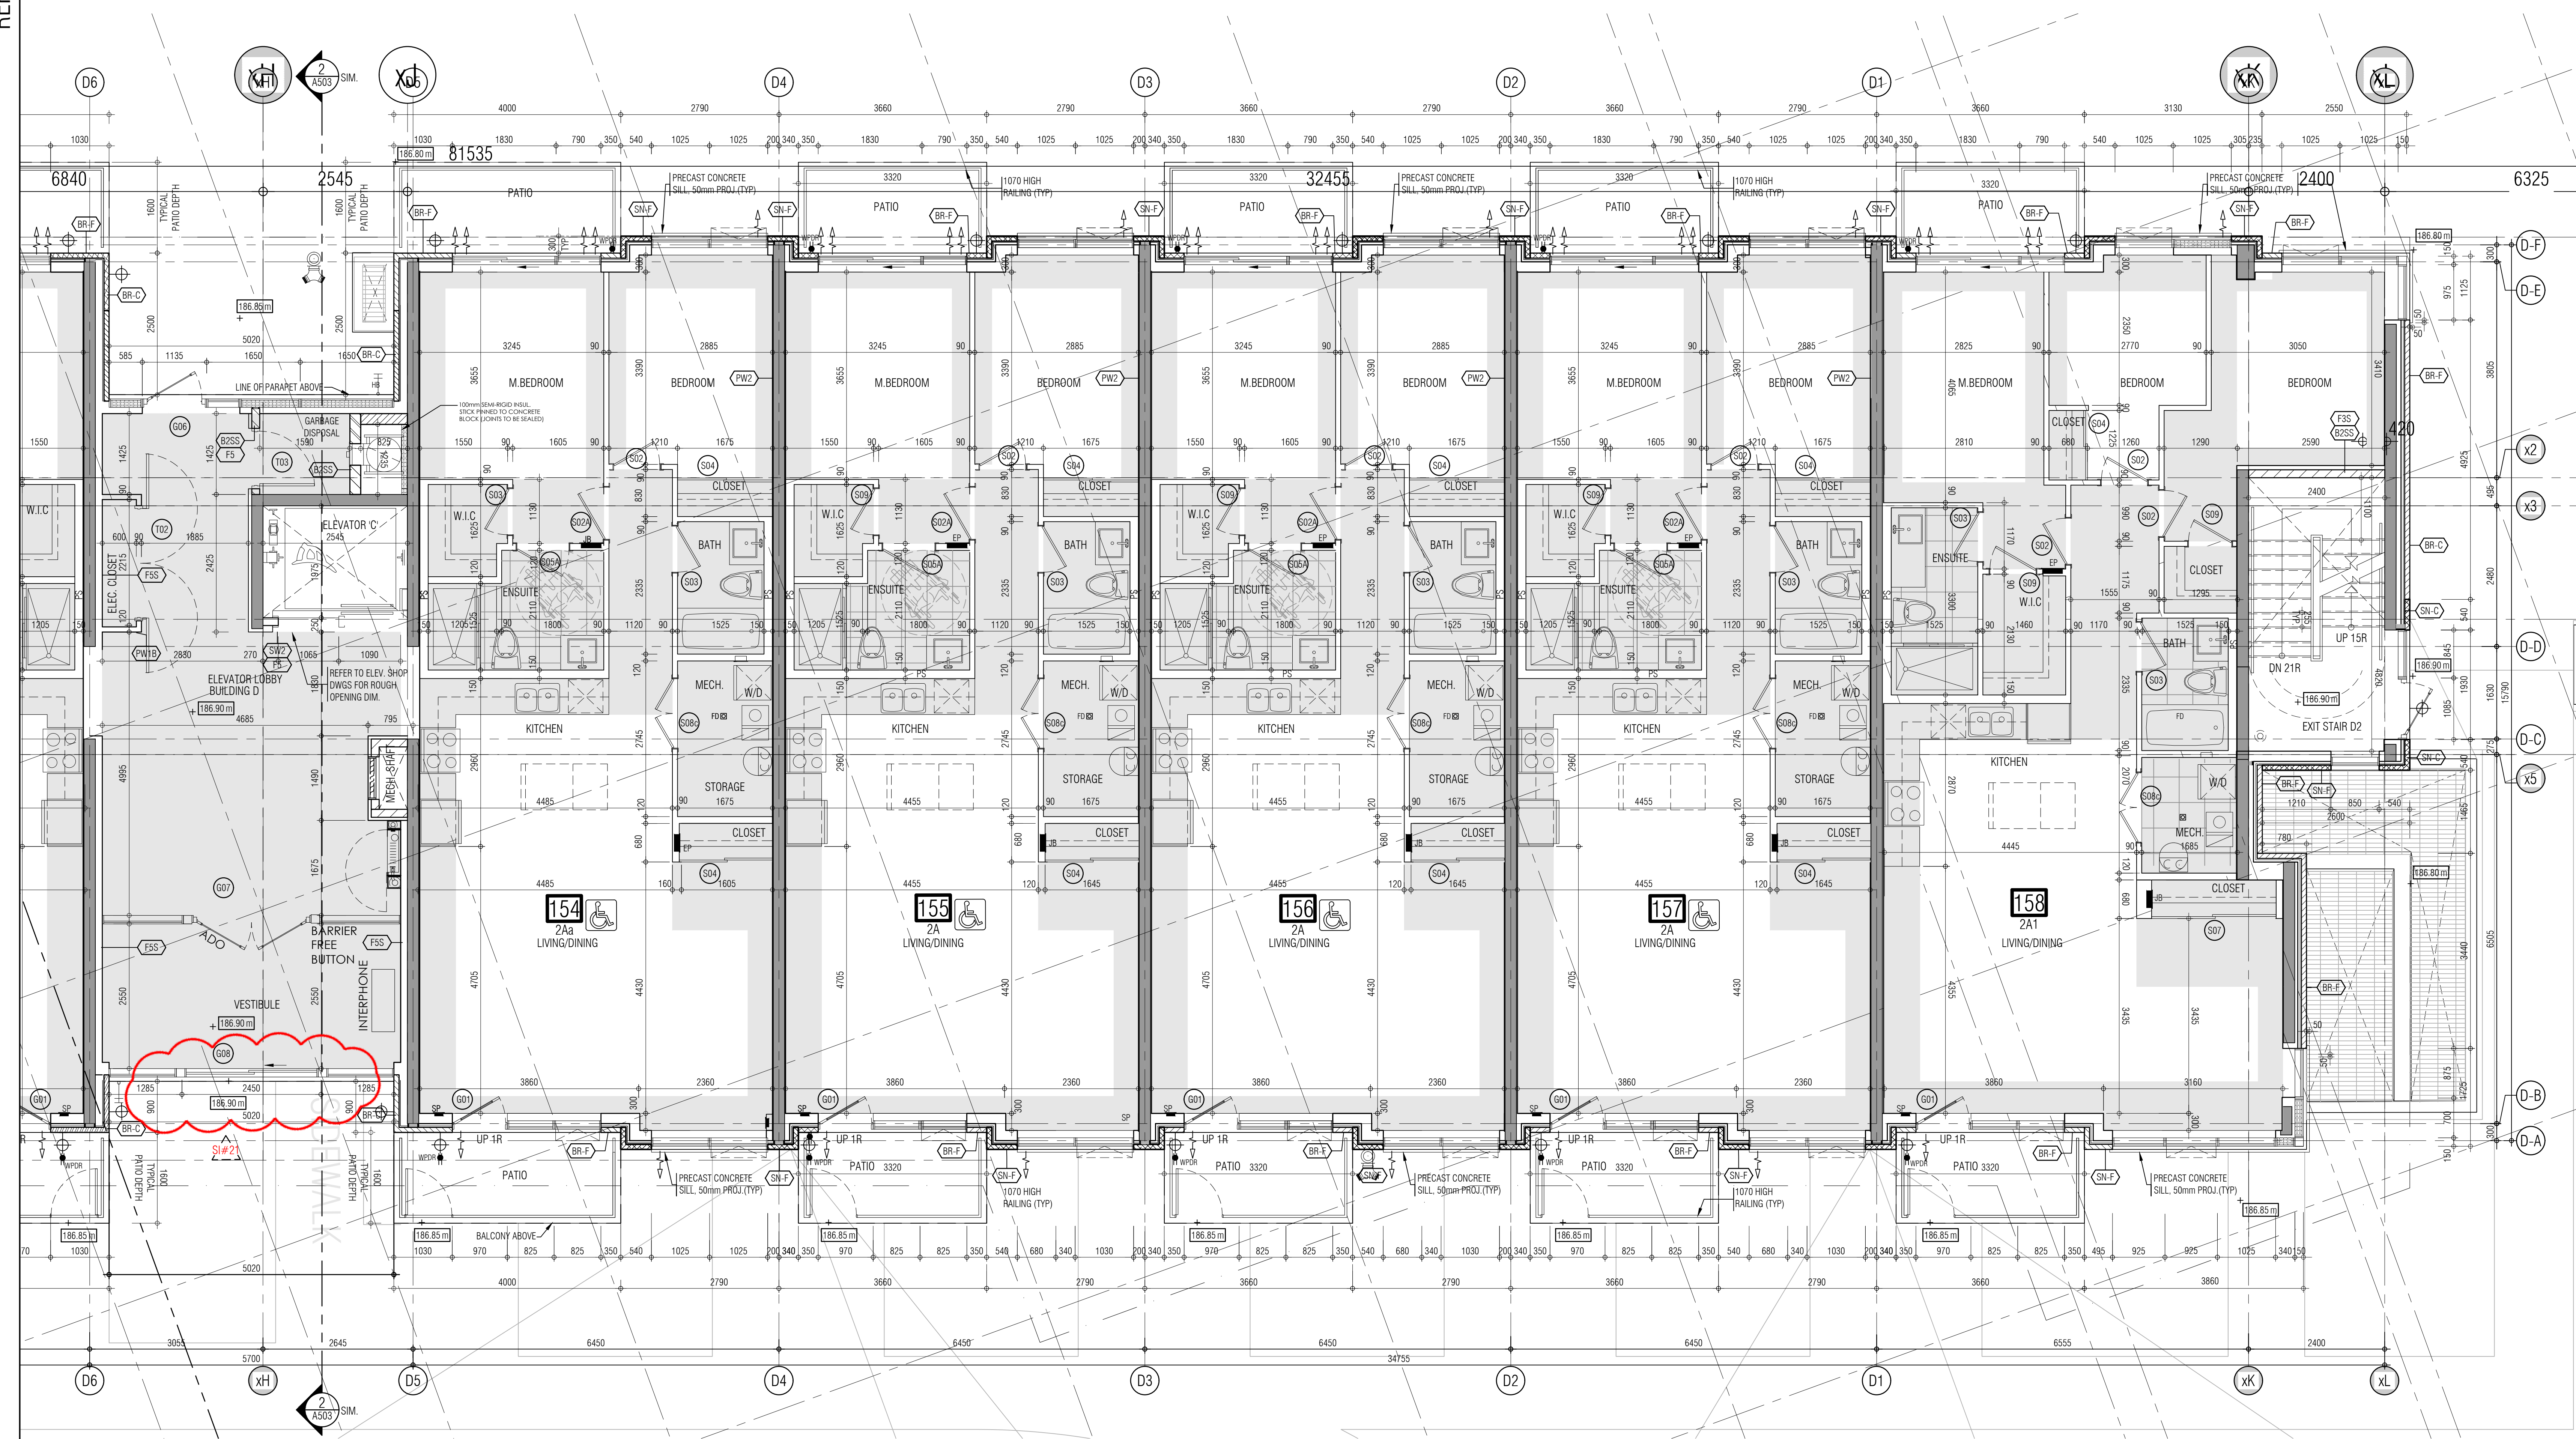

THIS DRAWING IS AN INSTRUMENT OF SERVICE, IT IS PROVIDED BY AND IS THE PROPERTY OF GRAZIANI CORAZZA ARCHITECTS INC. THE CONTRACTOR MUST NOT REPRODUCE OR COPY THIS DRAWING FOR ANY PURPOSES WITHOUT THE WRITTEN PERMISSION OF GRAZIANI CORAZZA ARCHITECTS INC. ANY REPRODUCTION OR USE OF THIS DRAWING WITHOUT THE WRITTEN PERMISSION OF GRAZIANI CORAZZA ARCHITECTS INC. IS STRICTLY PROHIBITED. THE CONTRACTOR SHALL BE RESPONSIBLE FOR THE ACCURACY OF SURVEY, STRUCTURAL, MECHANICAL, ELECTRICAL AND OTHER ENGINEERING INFORMATION SHOWN ON THIS DRAWING. REFER TO THE APPROPRIATE ENGINEERING DRAWINGS BEFORE PROCEEDING WITH THE WORK. CONSTRUCTION MUST COMPLY TO ALL APPLICABLE CODES AND REGULATIONS OF THE APPLICABLE JURISDICTION, UNLESS OTHERWISE NOTED. NO WARRANTY HAS BEEN MADE OR IS BEING MADE BY THIS OFFICE IN RESPECT TO THE ENVIRONMENTAL CONDITION OF THIS SITE.


THIS DRAWING IS NOT TO BE SCALED. ALL ARCHITECTURAL DIMENSIONS INDICATED ON THIS DRAWING ARE GRAPHIC REPRESENTATIONS ONLY.

CONDITIONS FOR ELECTRONIC INFORMATION TRANSFER:


ELECTRONIC INFORMATION IS SUPPLIED TO THE OTHER ASSOCIATED FIRMS TO ASSIST THEM IN THE EXECUTION OF THEIR WORK. REVIEW THE RECEIVED FIRMS MUST DETERMINE THE COMPLETENESS, APPROPRIATENESS, RELIANCE OF THE INFORMATION IN RESPECT TO THEIR PARTICULAR RESPONSIBILITY.

GRAZIANI CORAZZA ARCHITECTS INC. SHALL NOT BE RESPONSIBLE FOR ERRORS, OMISSIONS, INCOMPLETENESS DUE TO USE OF INFORMATION IN WHICH OF WHICH INFORMATION IS TRANSMITTED.

1. TRANSMISSION OF ANY KIND OF DAMAGE TO THE RECEIVING ELECTRONIC SYSTEM WHEN INFORMATION IS TRANSMITTED.

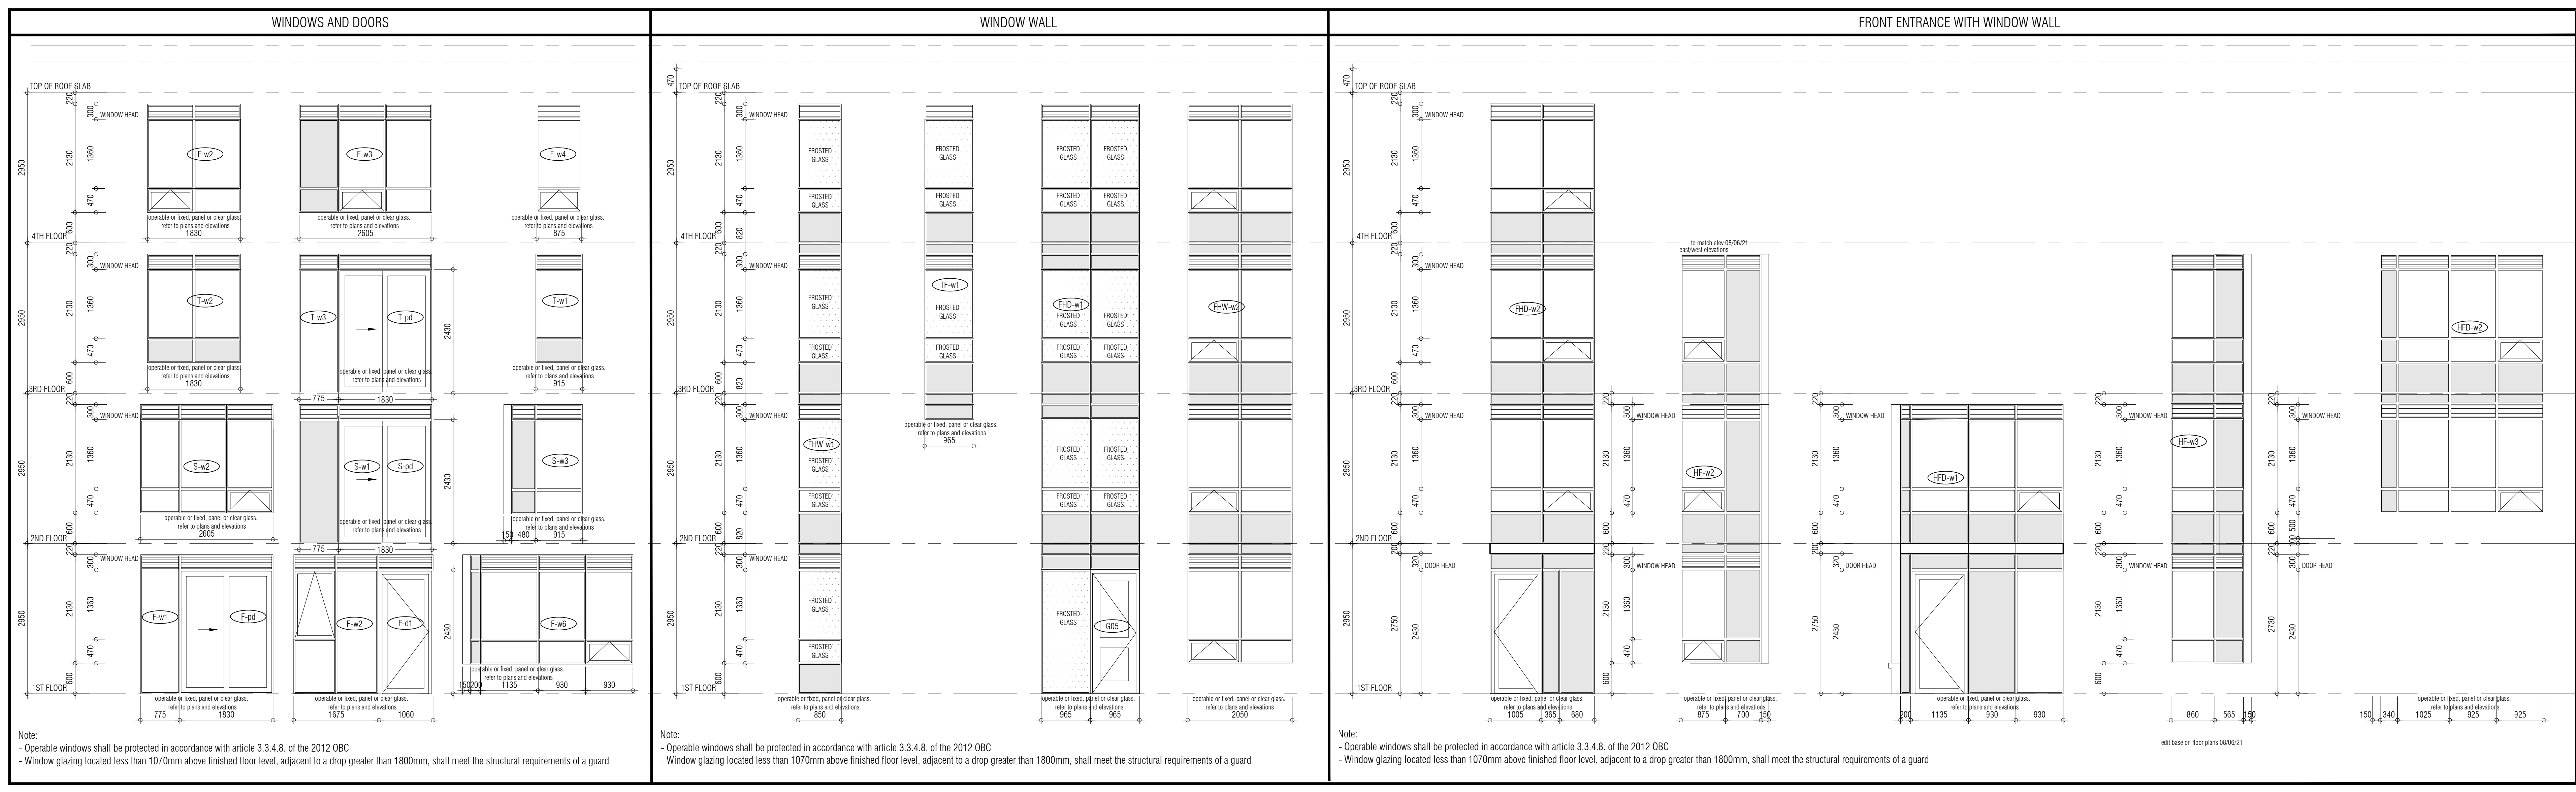

- 01. Oct.07.2019 issued for tender
- 02. Mar.13.2020 issued for design coordination #2
- 03. Mar.16.2020 issued for addendum #2
- 04. Mar.16.2020 issued for addendum #3
- 05. Aug.24.2020 issued for addendum #4
- 06. Sept.28.2020 issued for permit
- 07. Oct.20.2020 issued for addendum #5
- 08. Nov.23.2020 issued for addendum #6
- 09. Dec.14.2020 issued for addendum #7
- 10. Jan.18.2021 issued for addendum #8
- 11. Mar.2.2021 issued for permit
- 12. Mar.09.2021 issued for addendum #9
- 13. Mar.10.2021 issued for addendum #9R
- 14. Mar.26.2021 issued for progress
- 15. May.14.2021 issued for Site Instruction #1
- 16. June.15.2021 issued for Site Instruction #2
- 17. July.7.2021 re-issued for permit
- 18. July.15.2021 issued for Site Instruction #3
- 19. July.27.2021 issued for Site Instruction #4
- 20. Aug.3.2021 issued for Site Instruction #5
- 21. Aug.18.2021 issued for Site Instruction #6
- 22. Aug.20.2021 Re-issued for permit
- 23. Sept.07.2021 issued for Site Instruction #7
- 24. Sept.09.2021 issued for Site Instruction #8
- 25. Sept.16.2021 issued for Building D Permit Revisions
- 26. Sept.22.2021 issued for Site Instruction #9
- 27. Oct.6.2021 Re-issued for permit
- 28. Oct.8.2021 issued for Site Instruction #10
- 29. Oct.28.2021 issued for Site Instruction #11
- 30. Nov.05.2021 issued for Site Instruction #12
- 31. Nov.05.2021 issued for Site Instruction #13
- 32. Dec.3.2021 issued for Site Instruction #13
- 33. Dec.6.2021 issued for Site Instruction #14
- 34. Dec.7.2021 issued for Site Instruction #15
- 35. Jan.26.2022 issued for Site Instruction #16
- 36. Jan.31.2022 issued for Site Instruction #17
- 37. Mar.11.2022 issued for Site Instruction #18
- 38. Apr.29.2022 issued for Site Instruction #19
- 39. May.10.2022 issued for Site Instruction #20
- 40. May.24.2022 issued for Site Instruction #21

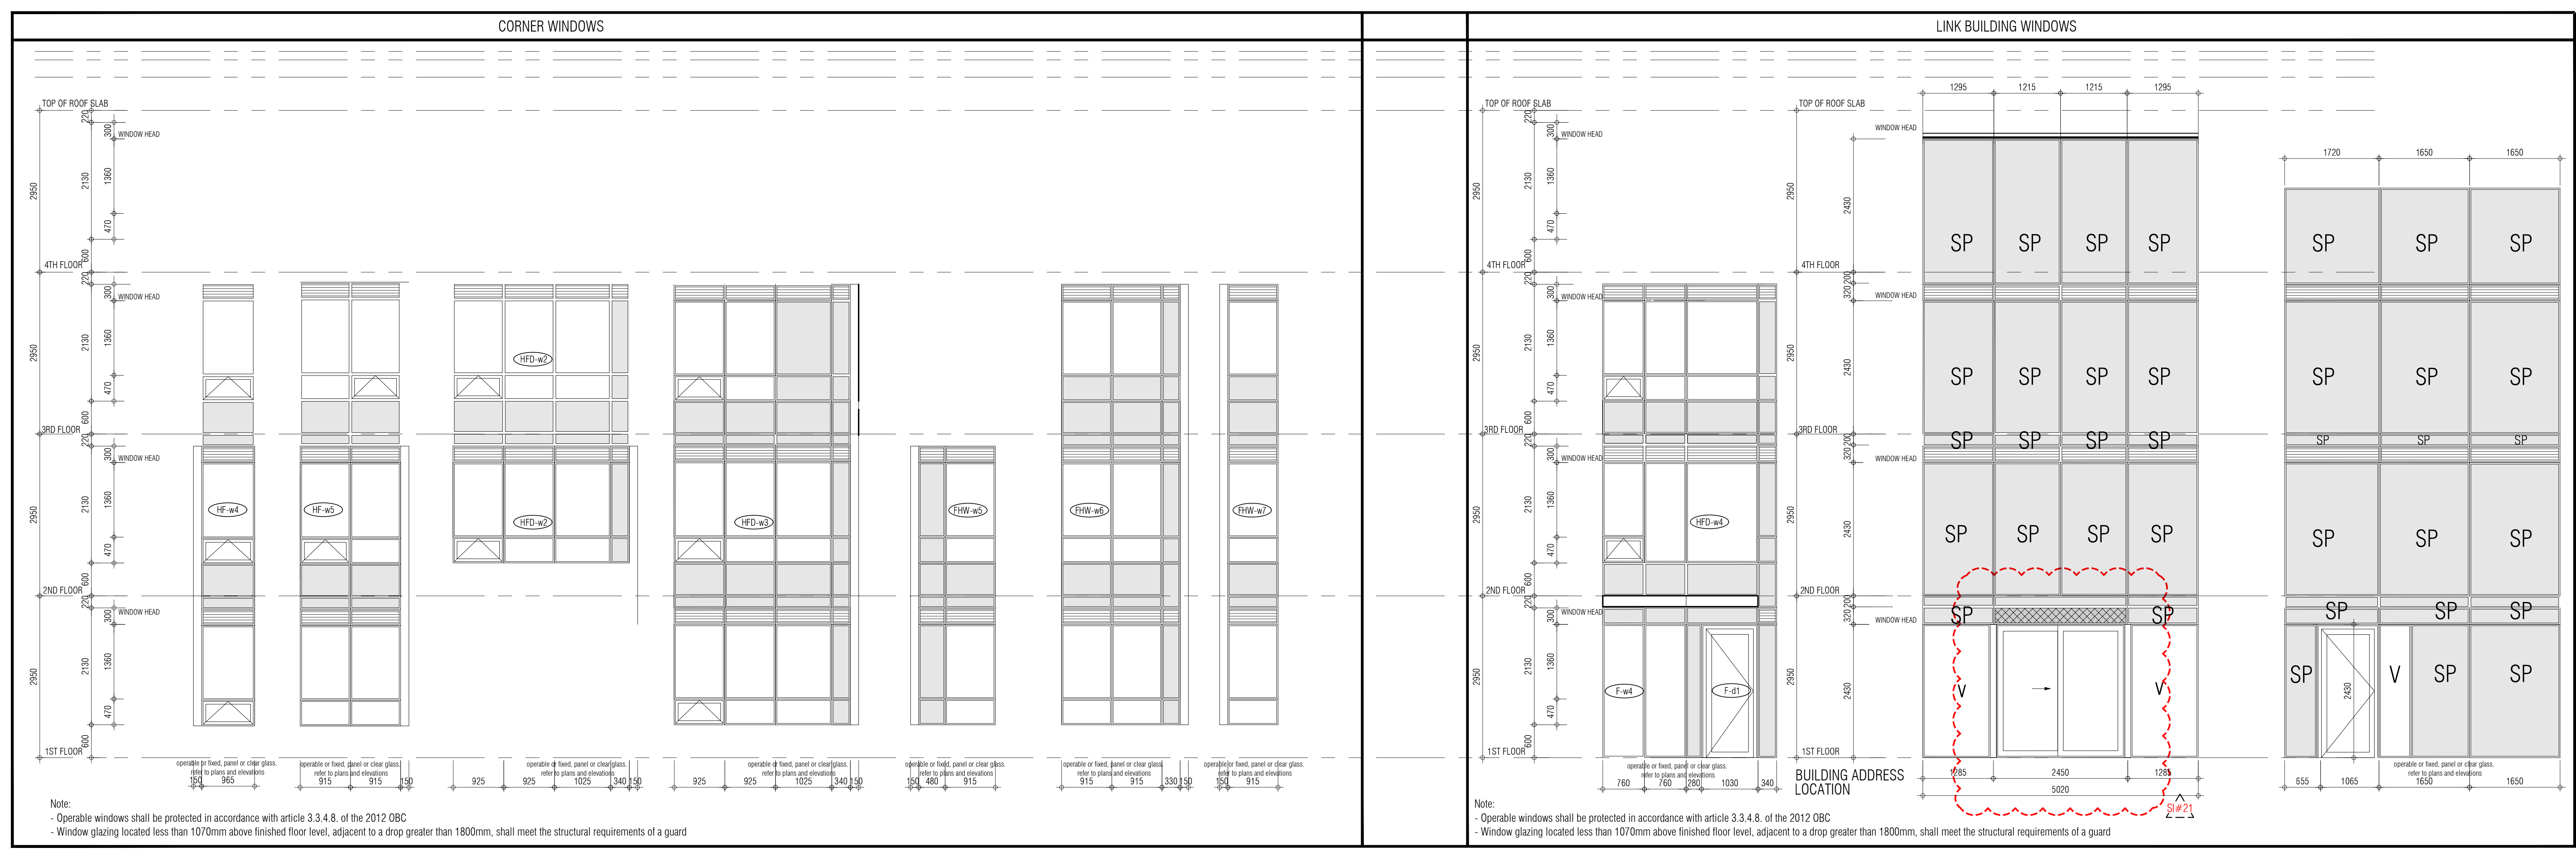

01. Apr.19.2021 issued to client

issued for revisions

GRAZIANI CORAZZA ARCHITECTS

1105 SHAWANIGAN DRIVE, SUITE 100 MISSISSAUGA, ONTARIO L4W 1C3
 905-881-0241 FAX: 905-881-3888 WWW.GC-ARCHITECTS.COM

RESIDENTIAL

ATTAR + PALLESCHI DRIVE

BRAMPTON ONTARIO

PROJECT ARCHITECT: B. GRAZIANI
 ASSISTANT DESIGNER: R. LINCOLN
 DRAWN BY: G. C./F. C./M. B.
 CHECKED BY: D. BIASE/G. COLANGELO
 PLOT DATE: MAY 24 2022
 JOB # 1331.15

Window Schedule