


Energy Efficiency Design Summary: Performance & Other Acceptable Compliance Methods

(Building Code Part 9, Residential)

This form is used by a designer to demonstrate that the energy efficiency design of a house complies with the building code using the Performance or Other Acceptable Compliance Methods described in Subsections 3.1.2. and 3.1.3. of SB-12,

This form must accurately reflect the information contained on the drawings and specifications being submitted. Refer to Supplementary Standard SB-12 for details about building code compliance requirements. Further information about energy efficiency requirements for new buildings is available from the provincial building code website or the municipal building department.

Application No:	 City of Richmond Hill Building Division	Model/Certification Number
<div style="display: flex; justify-content: space-around; align-items: center;"> <div style="border: 2px solid purple; padding: 5px; text-align: center;"> HVAC REVIEWED Initials: PXV </div> <div style="border: 2px solid purple; padding: 5px; text-align: center;"> FORM CHECKED FOR COMPLIANCE TO SB-12 MINIMUM REQUIREMENTS ONLY </div> </div>		
A. Project Information Building number, street name: _____ Model Type 38-14 Municipality: Richmond Hill Postal code: _____ Reg. Plan number / other description: _____		

B. Compliance Option [indicate the building code compliance option being employed in this house design]

<input checked="" type="checkbox"/> SB-12 Performance* [SB-12 - 3.1.2.]	* Attach energy performance results using an approved software (see guide)
<input type="checkbox"/> ENERGY STAR®* [SB-12 - 3.1.3.]	* Attach Builder Option Package [BOP] form
<input type="checkbox"/> R-2000®* [SB-12 - 3.1.3.]	* Attach R-2000 HOT2000 Report

C. Project Building Design Conditions

Climatic Zone (SB-1):	Heating Equipment Efficiency	Space Heating Fuel Source
<input checked="" type="checkbox"/> Zone 1 (< 5000 degree days) <input type="checkbox"/> Zone 2 (≥ 5000 degree days)	<input checked="" type="checkbox"/> ≥ 92% AFUE <input type="checkbox"/> ≥ 84% < 92% AFUE	<input checked="" type="checkbox"/> Gas <input type="checkbox"/> Propane <input type="checkbox"/> Solid Fuel <input type="checkbox"/> Oil <input type="checkbox"/> Electric <input type="checkbox"/> Earth Energy
Ratio of Windows, Skylights & Glass (W, S & G) to Wall Area	Other Building Characteristics	
Area of walls = 332.50 m ² or _____ ft ² Area of W, S & G = 38.69 m ² or _____ ft ²	W, S & G % = 11.63	
<input type="checkbox"/> Log/Post&Beam <input type="checkbox"/> ICF Above Grade <input type="checkbox"/> ICF Basement <input type="checkbox"/> Slab-on-ground <input type="checkbox"/> Walkout Basement <input type="checkbox"/> Air Conditioning <input type="checkbox"/> Combo Unit <input type="checkbox"/> Air Source Heat Pump (ASHP) <input type="checkbox"/> Ground Source Heat Pump (GSHP)		
SB-12 Performance Reference Building Design Package indicating the prescriptive package to be compared for compliance		
SB-12 Referenced Building Package (input design package): Package: <u>A1</u> Table: <u>3.1.1.2.A</u>		

D. Building Specifications [provide values and ratings of the energy efficiency components proposed, or attach ENERGY STAR BOP form]

Building Component	Minimum RSI / R values or Maximum U-Value ⁽¹⁾	Building Component	Efficiency Ratings
Thermal Insulation	Nominal Effective	Windows & Doors Provide U-Value ⁽¹⁾ or ER rating	
Ceiling with Attic Space	R60	Windows/Sliding Glass Doors	U=1.6
Ceiling without Attic Space	R31	Skylights/Glazed Roofs	N/A
Exposed Floor	R31	Mechanicals	
Walls Above Grade	R22+R1.5ci	Heating Equip.(AFUE)	96% AFUE
Basement Walls	R20ci	HRV Efficiency (SRE% at 0°C)	75%
Slab (all >600mm below grade)	N/A	DHW Heater (EF)	0.90 EF
Slab (edge only ≤600mm below grade)	N/A	DWHR (CSA B55.1 (min. 42% efficiency))	42 # Showers <u>2</u>
Slab (all ≤600mm below grade, or heated)	N/A	Combined Space / Dom. Water Heating	N/A

(1) U value to be provided in either W/(m²•K) or Btu/(h•ft²•F) but not both.

E. Performance Design Verification [Subsection 3.1.2. Performance Compliance]

The annual energy consumption using Subsection 3.1.1. SB-12 Reference Building Package is 156.08 GJ (1 GJ =1000MJ)

The annual energy consumption of this house as designed is 121.97 GJ

The software used to simulate the annual energy use of the building is: REM RATE 16.0.2 Canada

The building is being designed using an air tightness baseline of:

- ☐ OBC reference ACH, NLA or NLR default values (no depressurization test required)
☒ Targeted ACH, NLA or NLR. Depressurization test to meet 2.5 ACH50 or NLR or NLA

- ☒ Reduction of overall thermal performance of the proposed building envelope is not more than 25% of the envelope of the compliance package it is compared against (3.1.2.1.(6)).
☐ Standard Operating Conditions Applied (A-3.1.2.1 - 4.6.2)
☐ Reduced Operating Conditions for Zero-rated homes Applied (A-3.1.2.1 - 4.6.2.5)

- ☐ On Site Renewable(s): Solar: _____
Other Types: _____

F. ENERGY STAR or R-2000 Performance Design Verification [Subsection 3.1.3. Other Acceptable Compliance Methods]

- ☐ The NRCan "ENERGY STAR for New Homes Standard Version 12.6" technical requirements, applied to this building design result in the building performance meeting or exceeding the prescriptive performance requirements of the Supplementary Standard SB12 (A-3.1.3.1).
☐ The NRCan, "2012 R-2000 Standard" technical requirements, applied to this building design result in the building performance meeting or exceeding the prescriptive performance requirements of the Supplementary Standard SB12 (A-3.1.3.1).

Performance Energy Modeling Professional

Energy Evaluator/Advisor/Rater/CEM Name and company:

Accreditation or Evaluator/Advisor/Rater License #

John B Godden/Clearsphere Consulting

08


ENERGY STAR or R-2000

Energy Evaluator/Advisor/Rater/ Name and company:

Evaluator/Advisor/Rater License #

G. Designer(s) [name(s) & BCIN(s), if applicable, of person(s) providing information herein to substantiate that design meets the building code]

Qualified Designer: Declaration of designer to have reviewed and take responsibility for the design work.

Name	BCIN	Signature
MARTHA SANDOVAL	103017	

Guide to the Energy Efficiency Design Summary Form for Performance & Other Acceptable Compliance Methods

COMPLETING THE FORM

B. Compliance Options

Indicate the compliance option being used.

- SB-12 Performance refers to the method of compliance in Subsection 3.1.2. of SB-12. Using this approach the designer must use recognized energy simulation software (such as HOT2000 V10.51 or newer), and submit documents which show that the annual energy use of the proposed building is equal to or less than a prescriptive (referenced) building package.
- ENERGY STAR houses must be designed to ENERGY STAR requirements and verified on completion by a licensed energy evaluator and/or service organization. The ENERGY STAR BOP form must be submitted with the permit documents.
- R-2000 houses must be designed to the R-2000 Standard and verified on completion by a licensed energy evaluator and/or service organization. The HOT2000 report must be submitted with the permit documents.

C. Project Design Conditions

Climatic Zone: The number of degree days for Ontario cities is contained in Supplementary Standard SB-1 *Windows, Skylights and Glass Doors:* If the ratio of the total gross area of windows, sidelights, skylights, glazing in doors and sliding glass doors to the total gross area of walls is more than 17%, higher efficiency glazing is required. The total area is the sum of all the structural rough openings. Some exceptions apply. Refer to 3.1.1.1. of SB-12 for further details.

Fuel Source and Heating Equipment Efficiency: The fuel source and efficiency of the proposed heating equipment must be specified in order to determine which SB-12 Prescriptive compliance package table applies.

Other Building Conditions: These construction conditions affect SB-12 Prescriptive compliance requirements.

D. Building Specifications

Thermal Insulation: Indicate the RSI or R-value being proposed where they apply to the house design. Refer to SB-12 for further details.

E. Performance Design Summary

A summary of the performance design applicable only to the SB-12 Performance option.

F. ENERGY STAR or R-2000 Performance Method

Design to ENERGY STAR or R-2000 Standards.

G. House Designer

The building code requires designers providing information about whether a building complies with the building code to have a BCIN. Exemptions apply to architects, engineers and owners designing their own house.

BUILDING CODE REQUIREMENTS FOR AIRTIGHTNESS IN NEW HOUSES

All houses must comply with increased air barrier requirements in the building code. Notice of air barrier completion must be provided and an inspection conducted prior to it being covered.

The air leakage rates in Table 3.1.2.1. are not requirements. The Table is not intended to require or suggest that the building meet those airtightness targets. They are provided only as default or reference values for the purpose of annual energy simulations, should the builder/owner decide to perform such simulations. They are given in three different metrics; ACH, NLA, NLR. Any one of them can be used. They can be used as a default values for both a reference and proposed building or, where an air leakage test is conducted and credit for airtightness is claimed, the airtightness values in Table 3.1.2.1. can be used for the reference building and the actual leakage rates obtained from the air leakage test can be used as inputs for the proposed building.

OBC Reference Default Air Leakage Rates (Table 3.1.2.1.)

Detached dwelling	3.0 ACH50	NLA 2.12 cm ² /m ²	NLR 1.32 L/s/m ²
Attached dwelling	3.5 ACH50	NLA 2.27 cm ² /m ²	NLR 1.44 L/s/m ²

The building code requires that a blower door test be conducted to verify the air tightness of the house during construction if the SB-12 Performance option is used and an air tightness of less than 3.0 ACH @ 50 Pa (or NLA or NLR equivalent) in the case of detached houses, or 3.5 ACH @ 50 Pa (or NLA or NLR equivalent) in the case of attached houses is necessary to meet the required energy efficiency standard.

ENERGY EFFICIENCY LABELING FOR NEW HOUSES

ENERGY STAR and R-2000 may issue labels for new homes constructed under their energy efficiency programs. The building code does not currently regulate or require new home labeling.

Code Compliance Certificate

Project Title: Model 38-14 - Proposed

Report Date June 21, 2021
Data Filename Model 38-14 - Proposed.blg

Energy Code OBC SB-12 Performance Compliance Ontario 2017
Location Toronto, ON_CAN
Construction Type Single-family detached
Heating Type Natural Gas
Heating Degree Days <5000 HDD-Zone 1
Conditioned Area (sq ft) 3841
Conditioned Volume (cubic ft) 37119
Insulated Shell Area (sq ft) 8512

Construction Site	Owner	Builder	HERS Rater
Model 38-14 - Proposed	Royal Pine Homes	Royal Pine Homes	Clearsphere Consulting
Richmond Hill,	Model 38-14 - Proposed	3550 Langstaff Road, Suite 200	John Godden
	Richmond Hill,	Woodbridge, Ontario L4L 9G3	416-481-4218

Annual Energy Consumption	KWH	GJ
Reference Home Package A1	43356.53	156.08
Proposed House	33879.25	121.97
Better Than Code	21.9%	

SB-12 Performance Compliance: PASS

The Design Home total annual consumption is less than or equal to the Reference Home.

Building Summary Assembly	Gross Area or Perimeter	Cavity R-Value	Continuous R-Value
Ceilings			
Roof 1: Std-R60, Attic G2*****	1623	20.0	40.0
Above-Grade Walls			
AG Wall 1: Std R22 G2 + 1.5 @16*****	3148	22.0	1.5
Joist 1: Cond -> ambient	344	22.0	1.5
Window 1: U=0.282, SHGC 0.45*****	403		3.5
Door 1: R6*****	21		6.0
Door 2: Code	18		4.0
Floors Over Garage			
Floor 1: Std-R31 G2*****	537	31.0	0.0
Basement Walls			

Code Compliance Certificate

Building Summary

Assembly

Wall 1: Std-R-20 Blanket G2*****
 Window 2: U=0.282, SHGC 0.45*****
 Door 3

Gross Area or Perimeter

1720
 13
 17

Cavity R-Value

0.0

Continuous R-Value

20.0
 3.5
 4.0

Mechanical Equipment

Heating: Fuel-fired air distribution

Name/Type

96 AFUE Gas ECM
 64k*****

Size/Input

64.0 kBtuh

Efficiency

96.0 AFUE

Water Heating: Conventional, Gas

50 gal. 0.90 EF
 Gas*****

50 gal

0.90 EF

HRV/ERV

66.0 CFM

75.0% sen/ 0.0% tot

Drain Water Heat Recovery

2 of 2 Showers connected and 42.0% unit efficiency

Air Exchange

2.50 ACH50 or: 0.18 CFM50/sf

Efficient Lighting

90.0% Interior, 90.0% Exterior, 0.0% Garage

Renewables

N/A

Building Summary

Property

Royal Pine Homes
Model 38-14 - Proposed
Richmond Hill,

Organization

Clearsphere Consulting
416-481-4218
John Godden

HERS

Projected Rating
June 21, 2021
Rating No:N/A
Rater ID:0001

Weather:Toronto, ON_CAN
Model 38-14 - Proposed
Model 38-14 - Proposed.blg

Builder

Royal Pine Homes

Property/Builder Information

Building Name	Model 38-14 - Proposed
Owner's Name	Royal Pine Homes
Property Address	Model 38-14 - Proposed
City, St, Zip	Richmond Hill,
Phone Number	

Builder's Name	Royal Pine Homes
Phone Number	
Email Address	
Plan/Model Name	Model
Community/Development	Centerfiled
Identifier/Other	

Organization Information

Organization Name	Clearsphere Consulting
Address	1632 O'Connor Dr.
City, St, Zip	Toronto, ON_CAN M4B 3P4
Phone Number	416-481-4218
Website	www.clearsphere.ca

Rating/RESNET Information

Provider ID	2006-001
Sample Set ID	00000000
Registry ID	
Registry Date Registered	
Rater's Name	John Godden
Rater's ID	0001
Rater's Email	howard@clearsphere.ca
Last Field Insp	June 21, 2021
Rating Type	Projected Rating
Reason for Rating	New Home
Rating Number	N/A
Rating Permit Date	11/22/2019

REM/Rate - Residential Energy Analysis and Rating Software v16.0.2 Canada

This information does not constitute any warranty of energy costs or savings.

© 1985-2020 NORESCO, Boulder, Colorado.

Building Summary

Property

Royal Pine Homes
Model 38-14 - Proposed
Richmond Hill,

Organization

Clearsphere Consulting
416-481-4218
John Godden

HERS

Projected Rating
June 21, 2021
Rating No:N/A
Rater ID:0001

Weather:Toronto, ON_CAN

Model 38-14 - Proposed
Model 38-14 - Proposed.blg

Builder

Royal Pine Homes

General Building Information

Area of Conditioned. Space(sq ft)	3841
Volume of Conditioned. Space	37119
Year Built	2021
Housing Type	Single-family detached
Level Type(Apartments Only)	None
Floors on or Above-Grade	2
Number of Bedrooms	4
Foundation Type	Conditioned basement
Foundation is w/in Infiltration Volume:	N/A
Enclosed Crawl Space Type	N/A
Number of Stories Including Conditioned Basement	3
Thermal Boundary Location	N/A

Foundation Wall Information

Name	Library Entry	Location	Length(ft)	Total Height(ft)	Depth Below Grade(ft)	Height Above Grade(ft)	Uo Value Combo*	Uo Value (wall only)
Foundation Wall	Std-R-20 Blanket G2*****	Cond->ambient/grr	173.67	10.08	9.08	1.00	0.034	0.048

* Uo Value Combo combines wall, airfilm, and soil path

Foundation Wall Library List

Foundation Wall: Std-R-20 Blanket G2*****

Type	Solid concrete or stone
Thickness(in)	8.0
Studs	None
Interior Insulation	
Continuous R-Value	20.0
Frame Cavity R-Value	0.0
Cavity Insulation Grade	2
Ins top	0.00 ft from top of wall
Ins Bottom	0.00 ft from bottom of wall
Exterior Insulation	

Building Summary

Property

Royal Pine Homes
Model 38-14 - Proposed
Richmond Hill,

Organization

Clearsphere Consulting
416-481-4218
John Godden

HERS

Projected Rating
June 21, 2021
Rating No:N/A
Rater ID:0001

Weather:Toronto, ON_CAN

Model 38-14 - Proposed
Model 38-14 - Proposed.blg

Builder

Royal Pine Homes

Foundation Wall Library List

R-Value	0.0
Ins top	0.00 ft from top of wall
Ins bottom	0.00 ft below grade

Note

Slab Floor Information

Name	Library Entry	Area(sq ft)	Depth Below Grade(ft)	Full Perimeter(ft)	Exposed Perimeter(ft)	On-Grade Perimeter(ft)
Slab	Uninsulated*****	1109	9.08	174	174	0

Slab Floor Library List

Slab Floor: Uninsulated*****

Slab Covering	Carpet
Perimeter Insulation (R-Value)	0.0
Perimeter Insulation Depth (ft)	0.0
Under-Slab Insulation (R-Value)	0.0
Under-Slab Insulation Width (ft)	0.0
Slab Insulation Grade	3
Radiant Slab	No

Note

Frame Floor Information

Name	Library Entry	Location	Area(sq ft)	Uo Value
Exposed Floor	Std-R31 G2*****	Btwn cond & garage	537	0.039

Frame Floor Library List

Floor: Std-R31 G2*****

Information From Quick Fill Screen

Continous Insulation R-Value	0.0
Cavity Insulation R-Value	31.0
Cavity Insulation Thickness (in.)	9.5
Cavity Insulation Grade	2
Joist Size (w x h, in)	1.5 x 9.5
Joist Spacing (in oc)	16.0

REM/Rate - Residential Energy Analysis and Rating Software v16.0.2 Canada

This information does not constitute any warranty of energy costs or savings.

© 1985-2020 NORESCO, Boulder, Colorado.

Building Summary

Property

Royal Pine Homes
Model 38-14 - Proposed
Richmond Hill,

Organization

Clearsphere Consulting
416-481-4218
John Godden

HERS

Projected Rating
June 21, 2021
Rating No:N/A
Rater ID:0001

Weather:Toronto, ON_CAN

Model 38-14 - Proposed
Model 38-14 - Proposed.blg

Builder

Royal Pine Homes

Frame Floor Library List

Framing Factor - (default)	0.1300
Floor Covering	CARPET
Note	

Rim and Band Joist Information

Name	Location	Area(sq ft)	Continuous Ins	Framed Cavity Ins	Cavity Ins Thk(in)	Joist Spacing	Insulation Grade	Uo Value
Rim Band Joist	Cond -> ambient	344.20	1.5	22.0	5.5	16.0	2	0.049

Above-Grade Wall

Name	Library Entry	Location	Exterior Color	Area(sq ft)	Uo Value
AGW	Std R22 G2 + 1.5 @16*****	Cond -> ambient	Medium	3148.10	0.053

Above-Grade Wall Library List

Above-Grade Wall: Std R22 G2 + 1.5 @16*****

Information From Quick Fill Screen

Wall Construction Type	Std Frame w/Brick Veneer
Continuous Insulation (R-Value)	1.5
Frame Cavity Insulation (R-Value)	22.0
Frame Cavity Insulation Thickness (in)	5.5
Frame Cavity Insulation Grade	2
Stud Size (w x d, in)	1.5 x 5.5
Stud Spacing (in o.c.)	16.0
Framing Factor - (default)	0.2300
Gypsum Thickness (in)	0.5
Note	

Window Information

Name	Wall Assignment	Orient	U-Value	SHGC	Area (sqft)	Overhang Depth (ft)	To Top (ft)	To Btm (ft)	Interior Winter Shading	Summer Shading	Adjacent Winter Shading	Summer Shading
------	-----------------	--------	---------	------	-------------	---------------------	-------------	-------------	-------------------------	----------------	-------------------------	----------------

Building Summary

Property

Royal Pine Homes
Model 38-14 - Proposed
Richmond Hill,

Organization

Clearsphere Consulting
416-481-4218
John Godden

HERS

Projected Rating
June 21, 2021
Rating No:N/A
Rater ID:0001

Weather:Toronto, ON_CAN

Model 38-14 - Proposed
Model 38-14 - Proposed.blg

Builder

Royal Pine Homes

Window Information

Name	Wall Assignment	Orient	U-Value	SHGC	Area (sqft)	Overhang			Interior		Adjacent	
						Depth (ft)	To Top (ft)	To Btm (ft)	Winter Shading	Summer Shading	Winter Shading	Summer Shading
front	AGWall 1	South	0.282	0.450	5.50	5.0	1.5	2.5	0.85	0.70	None	None
front	AGWall 1	South	0.282	0.450	18.70	5.0	2.5	9.5	0.85	0.70	None	None
front	AGWall 1	South	0.282	0.450	45.00	1.3	1.0	7.0	0.85	0.70	None	None
front	AGWall 1	South	0.282	0.450	15.00	1.3	1.0	7.0	0.85	0.70	None	None
front	AGWall 1	South	0.282	0.450	56.30	0.3	3.0	10.3	0.85	0.70	None	None
Left	FndWall 1	West	0.282	0.450	3.30	0.0	0.0	0.0	0.85	0.70	None	None
Left	AGWall 1	West	0.282	0.450	8.00	1.3	1.8	5.8	0.85	0.70	None	None
Left	AGWall 1	West	0.282	0.450	9.30	1.3	1.8	6.4	0.85	0.70	None	None
Left	AGWall 1	West	0.282	0.450	17.30	1.3	1.8	6.1	0.85	0.70	None	None
back	FndWall 1	North	0.282	0.450	3.33	0.0	0.0	0.0	0.85	0.70	None	None
back	AGWall 1	North	0.282	0.450	60.00	0.0	0.0	0.0	0.85	0.70	None	None
back Sliding	AGWall 1	North	0.282	0.450	72.00	0.0	0.0	0.0	0.85	0.70	None	None
back	AGWall 1	North	0.282	0.450	56.00	1.3	1.8	6.4	0.85	0.70	None	None
Right	FndWall 1	East	0.282	0.450	6.70	0.0	0.0	0.0	0.85	0.70	None	None
Right	AGWall 1	East	0.282	0.450	8.70	0.0	0.0	0.0	0.85	0.70	None	None
Right	AGWall 1	East	0.282	0.450	8.70	1.3	1.8	6.1	0.85	0.70	None	None
Right	AGWall 1	East	0.282	0.450	22.70	1.3	1.8	7.4	0.85	0.70	None	None

Door Information

Name	Library Entry	Wall Assignment	Opaque Area(sq ft)	Uo Value	R-Value of Opaque Area	Storm Door
Front	R6*****	AGWall 1	20.5	0.144	6.0	No
garage	Code*	AGWall 1	18.2	0.203	4.0	No
Cold Cellar	Code*	FndWall 1	17.1	0.203	4.0	No

Roof Information

Name	Library Entry	Ceiling Area(sq ft)	Roof Area(sq ft)	Exterior Color	Radiant Barrier	Type	Uo Value	Cement or Clay Tiles	Roof Tile Ventilation
Ceiling-with attic	Std-R60, Attic G2*****	1623.00	2028.75	Medium	No	Attic	0.017	No	No

Building Summary

Property

Royal Pine Homes
Model 38-14 - Proposed
Richmond Hill,

Organization

Clearsphere Consulting
416-481-4218
John Godden

HERS

Projected Rating
June 21, 2021
Rating No:N/A
Rater ID:0001

Weather:Toronto, ON_CAN

Model 38-14 - Proposed
Model 38-14 - Proposed.blg

Builder

Royal Pine Homes

Roof Library List

Ceiling: Std-R60, Attic G2*****

Information From Quick Fill Screen

Continuous Insulation (R-Value)	40.0
Cavity Insulation (R-Value)	20.0
Cavity Insulation Thickness (in)	9.5
Cavity Insulation Grade	2
Gypsum Thickness (in)	0.500
Insulated Framing Size(w x h, in)	1.5 x 3.5
Insulated Framing Spacing (in o.c.)	24.0
Framing Factor - (default)	0.1100
Ceiling Type	Attic
Note	

Building Summary

Property

Royal Pine Homes
Model 38-14 - Proposed
Richmond Hill,

Organization

Clearsphere Consulting
416-481-4218
John Godden

HERS

Projected Rating
June 21, 2021
Rating No:N/A
Rater ID:0001

Weather:Toronto, ON_CAN

Model 38-14 - Proposed
Model 38-14 - Proposed.blg

Builder

Royal Pine Homes

Mechanical Equipment

Number of Mechanical Systems	2
Heating SetPoint(F)	72.0
Heating Setback Thermostat	Present
Cooling SetPoint(F)	75.0
Cooling Setup Thermostat	Present
DHW SetPoint(F)	125.0

Heat: 96 AFUE Gas ECM 64k*****

SystemType	Fuel-fired air distribution
Fuel Type	Natural gas
Rated Output Capacity (kBtuh)	64.0
Seasonal Equipment Efficiency	96.0 AFUE
Auxiliary Electric	200 Watts
Note	
Number Of Units	1
Location	Conditioned area
Performance Adjustment	100
Percent Load Served	100

DHW: 50 gal. 0.90 EF Gas*****

Water Heater Type	Conventional
Fuel Type	Natural gas
Energy Factor	0.90
Recovery Efficiency	0.90
Water Tank Size (gallons)	50
Extra Tank Insulation (R-Value)	0.0
Note	
Number Of Units	1
Location	Conditioned area
Performance Adjustment	100
Percent Load Served	100

Building Summary

Property

Royal Pine Homes
Model 38-14 - Proposed
Richmond Hill,

Organization

Clearsphere Consulting
416-481-4218
John Godden

HERS

Projected Rating
June 21, 2021
Rating No:N/A
Rater ID:0001

Weather:Toronto, ON_CAN

Model 38-14 - Proposed
Model 38-14 - Proposed.blg

Builder

Royal Pine Homes

DHW Efficiencies

All bath faucets & showers <= 2gpm	false
All DHW pipes fully insulated >= R-3	false
Recirculation type	None (standard system)
Farthest fixture to DHW heater	72
TOTAL Pipelength for longest DHW run	102
DWHR unit present?	true
DWHR unit efficiency per CSA 55.1	42.00
DWHR preheats cold supply for shower	false
DWHR preheats hot supply for shower	true
Number showerheads in home	2
Number showers connected to DWHR	2

DHW Diagnostics

dhwGpd	58.83
peRatio	1.00
dishwasherGpd	5.10
clothesWasherHotWaterGPD	4.48
EDef	1.00
ewaste	32.00
tmains	54.00
dwhrWhInletTempAdj	8.44
pumpConsKwh	0.00
pumpConsMmbtu	0.00

Building Summary

Property

Royal Pine Homes
Model 38-14 - Proposed
Richmond Hill,

Organization

Clearsphere Consulting
416-481-4218
John Godden

HERS

Projected Rating
June 21, 2021
Rating No:N/A
Rater ID:0001

Weather:Toronto, ON_CAN

Model 38-14 - Proposed
Model 38-14 - Proposed.blg

Builder

Royal Pine Homes

Duct Systems

Name

Conditioned Floor Area(sq ft)	3841.0
# of Returns	6
Heating System	96 AFUE Gas ECM 64k*****
Cooling System	N/A
Supply Duct Surface Area(sq ft)	777.8
Return Duct Surface Area(sq ft)	720.2
No bldg cavities used as ducts	FALSE

Type	Location	Percent Location	R-Value
Supply	Conditioned space	100.0	0.0
Return	Conditioned space	100.0	0.0

Test Exemptions

IECC	TRUE
RESNET 2019	TRUE
ENERGY STAR LtO	TRUE

Duct Leakage

Input Type	Measured
Test Type	Total Duct Leakage
Duct Test Stage	Postconstruction Test

	LtO (based on Total DL)	Total Duct Leakage
Supply & Return	Not Applicable	0.00 CFM @ 25 Pascals
Supply Only	0.00 CFM @ 25 Pascals	
Return Only	0.00 CFM @ 25 Pascals	

Building Summary

Property

Royal Pine Homes
Model 38-14 - Proposed
Richmond Hill,

Organization

Clearsphere Consulting
416-481-4218
John Godden

HERS

Projected Rating
June 21, 2021
Rating No:N/A
Rater ID:0001

Weather:Toronto, ON_CAN

Model 38-14 - Proposed
Model 38-14 - Proposed.blg

Builder

Royal Pine Homes

Infiltration and Mechanical Ventilation

Whole Dwelling Infiltration

Input Type	Blower door
Heating Season Infiltration Value	2.50 ACH @ 50 Pascals
Cooling Season Infiltration Value	2.50 ACH @ 50 Pascals
Shelter Class	4
Code Verification	Tested

Mechanical Ventilation for IAQ

Type	Balanced
Unable to Measure Mechanical Ventilation	FALSE
Rate(cfm)	66
Adjusted Sensible Recovery Efficiency(%)	75.00
Adjusted Total Recovery Efficiency(%)	0.00
Hours per Day	24.0
Fan Power (watts)	64.00
ECM Fan Motor	false

Ventilation Strategy for Cooling

Cooling Season Ventilation	Natural Ventilation
----------------------------	---------------------

Good Air Exchange for Multi-Family	NA
------------------------------------	----

Building Summary

Property

Royal Pine Homes
Model 38-14 - Proposed
Richmond Hill,

Organization

Clearsphere Consulting
416-481-4218
John Godden

HERS

Projected Rating
June 21, 2021
Rating No:N/A
Rater ID:0001

Weather:Toronto, ON_CAN

Model 38-14 - Proposed
Model 38-14 - Proposed.blg

Builder

Royal Pine Homes

Lights and Appliances

Rating/RESNET audit

Ceiling Fan CFM / Watt	0.00
Refrigerator kWh/yr	691
Refrigerator Location	Conditioned
Range/Oven Fuel Type	Electric
Induction Range	No
Convection Oven	No

Dishwasher

Energy Factor	0.46
Dishwasher kWh/yr	0
Place Setting Capacity	12

Clothes Dryer

Fuel Type	Electric
Location	Conditioned
Moisture Sensing	No
CEF	2.62

Clothes Washer


Location	Conditioned
LER (kWh/yr)	704
IMEF	0.331
Capacity (CU.Ft)	2.874
Electricity Rate	0.08
Gas Rate	0.58
Annual Gas Cost	23.00

Qualifying Light Fixtures

Interior Lights %	0.0
Exterior Lights %	0.0
Garage Lights %	0.0
Interior LEDs %	90.0
Exterior LEDs %	90.0
Garage LEDs %	0.0

Schedule 1: Designer Information

Use one form for each individual who reviews and takes responsibility for design activities with respect to the project.

A. Project Information			
Building number, street name		Unit no.	Lot/con.
Municipality RICHMOND HILL	Postal code	Plan number/ other description	
B. Individual who reviews and takes responsibility for design activities			
Name MICHAEL O'ROURKE		Firm HVAC DESIGNS LTD.	
Street address 375 FINLEY AVE		Unit no. 202	Lot/con. N/A
Municipality AJAX	Postal code L1S 2E2	Province ONTARIO	E-mail info@hvacdesigns.ca
Telephone number (905) 619-2300	Fax number (905) 619-2375	Cell number ()	
C. Design activities undertaken by individual identified in Section B. [Building Code Table 3.5.2.1 OF Division C]			
<input type="checkbox"/> House <input type="checkbox"/> Small Buildings <input type="checkbox"/> Large Buildings <input type="checkbox"/> Complex Buildings <input checked="" type="checkbox"/> HVAC – House <input type="checkbox"/> Building Services <input type="checkbox"/> Detection, Lighting and Power <input type="checkbox"/> Fire Protection <input type="checkbox"/> Building Structural <input type="checkbox"/> Plumbing – House <input type="checkbox"/> Plumbing – All Buildings <input type="checkbox"/> On-site Sewage Systems			
Description of designer's work HEAT LOSS / GAIN CALCULATIONS DUCT SIZING RESIDENTIAL MECHANICAL VENTILATION DESIGN SUMMARY RESIDENTIAL SYSTEM DESIGN per CSA-F280-12		Model: 38-14 Project: CENTREFIELD (WEST GORMLEY)	
D. Declaration of Designer			
I, <u>MICHAEL O'ROURKE</u> (print name)		declare that (choose one as appropriate):	
<input type="checkbox"/> I review and take responsibility for the design work on behalf of a firm registered under subsection 3.2.4. of Division C, of the Building Code. I am qualified, and the firm is registered, in the classes/categories. Individual BCIN: _____ Firm BCIN: _____		appropriate Building Division HVAC REVIEWED Initials: <u>PXV</u>	
<input checked="" type="checkbox"/> I review and take responsibility for the design and am qualified in the appropriate category as an "other designer" under subsection 3.2.5. of Division C, of the Building Code. Individual BCIN: <u>19669</u> Basis for exemption from registration and qualification: <u>O.B.C SENTENCE 3.2.4.1 (4)</u>			
<input type="checkbox"/> The design work is exempt from the registration and qualification requirements of the Building Code. Basis for exemption from registration and qualification: _____			
I certify that:			
1. The information contained in this schedule is true to the best of my knowledge. 2. I have submitted this application with the knowledge and consent of the firm.			
June 21, 2021 Date		 Signature of Designer	

NOTE:

- For the purposes of this form, "individual" means the "person" referred to in Clause 3.2.4.7(1) d) of Division C, Article 3.2.5.1. of Division C, and all other persons who are exempt from qualification under Subsections 3.2.4. and 3.2.5. of Division C.
- Schedule 1 is not required to be completed by a holder of a license, temporary license, or a certificate of authorization, issued by the Ontario Association of Architects. Schedule 1 is also not required to be completed by a holder of a license to practise, a limited license to practise, or a certificate of authorization, issued by the Association of Professional Engineers of Ontario.

Application for a Permit Construct or Demolish – Effective January 1, 2015

HVAC REVIEWED

Initials:

PXV

SITE NAME: CENTREFIELD (WEST) HOMES

BUILDER: ROYAL PINE HOMES

TYPE: 38-14

GFA: 2724

DATE: Jun-21

LO# 91284

WINTER NATURAL AIR CHANGE RATE 0.227

SUMMER NATURAL AIR CHANGE RATE 0.071

HEAT LOSS ΔT °F. 78

HEAT GAIN ΔT °F. 13

CSA-F280-12

SB-12 PERFORMANCE

ROOM USE	EXP. WALL	CLG. HT.	MBR	ENS	W/C	BED-2	BED-3	BED-4	ENS-2	S-BATH
	37	22	8	33	31	11	6	5	9	
	9	9	9	9	9	9	9	9	9	
GRS.WALL AREA	333	198	72	297	279	99	54	45		
GLAZING	LOSS GAIN	LOSS GAIN	LOSS GAIN	LOSS GAIN	LOSS GAIN	LOSS GAIN	LOSS GAIN	LOSS GAIN		
NORTH	21.8 16.0	0 0 0	8 174 128	0 0 0	0 0 0	0 0 0	0 0 0	8 174 128	0 0 0	
EAST	21.8 41.6	0 0 0	0 0 0	0 0 0	0 0 0	0 0 0	0 0 0	0 0 0	0 0 0	
SOUTH	21.8 24.9	0 0 0	0 0 0	0 0 0	0 0 0	0 0 0	17 370 423	0 0 0	0 0 0	
WEST	21.8 41.6	38 828 1579	19 414 789	0 0 0	56 1220 2327	50 1089 2078	0 0 0	0 0 0	18 392 748	
SKYLT.	35.8 101.2	0 0 0	0 0 0	0 0 0	0 0 0	0 0 0	0 0 0	0 0 0	0 0 0	
DOORS	25.8 4.3	0 0 0	0 0 0	0 0 0	0 0 0	0 0 0	0 0 0	0 0 0	0 0 0	
NET EXPOSED WALL	4.2 0.7	295 1241 204	171 719 118	72 303 50	241 1014 167	229 963 158	82 345 57	46 193 32	27 114 19	
NET EXPOSED BSMT WALL ABOVE GR	3.7 0.6	0 0 0	0 0 0	0 0 0	0 0 0	0 0 0	0 0 0	0 0 0	0 0 0	
EXPOSED CLG	1.3 0.6	346 455 203	124 163 73	105 138 62	170 223 100	206 271 121	195 256 115	75 99 44	85 112 50	
NO ATTIC EXPOSED CLG	2.8 1.3	0 0 0	0 0 0	0 0 0	45 126 57	45 126 57	0 0 0	0 0 0	0 0 0	
EXPOSED FLOOR	2.6 0.4	0 0 0	0 0 0	0 0 0	0 0 0	251 655 108	175 457 75	75 196 32	50 131 21	
BASEMENT/CRAWL HEAT LOSS		0	0	0	0	0	0	0	0	
SLAB ON GRADE HEAT LOSS		0	0	0	0	0	0	0	0	
SUBTOTAL HT LOSS		2523	1470	441	2583	3105	1428	662	748	
SUB TOTAL HT GAIN		1986	1108	112	2650	2521	670	236	838	
LEVEL FACTOR / MULTIPLIER	0.20 0.16	0.20 0.16	0.20 0.16	0.20 0.16	0.20 0.16	0.20 0.16	0.20 0.16	0.20 0.16	0.20 0.16	
AIR CHANGE HEAT LOSS	410	239	72	420	505	232	108	122	39	
AIR CHANGE HEAT GAIN	92	51	5	123	117	31	11	87	88	
DUCT LOSS	0	0	0	0	361	166	77	87	88	
DUCT GAIN	0	0	0	0	0	357	163	25	88	
HEAT GAIN PEOPLE	240	2	480	0	0	1	240	1	240	0
HEAT GAIN APPLIANCES/LIGHTS		693	0	0	693	693	693	0	0	
TOTAL HT LOSS BTU/H		2933	1709	512	3003	3970	1827	847	956	
TOTAL HT GAIN x 1.3 BTU/H		4227	1508	152	4818	5107	2336	353	1254	

ROOM USE	EXP. WALL	CLG. HT.	GRT	KIT	LAUN	PWD	FOY	MUD	BAS
	61	52	61	52	15	12	29	7	168
	10	10	10	10	9	10	11	11	10
GRS.WALL AREA	616	525	135	121	322	78	1176		
GLAZING	LOSS GAIN	LOSS GAIN	LOSS GAIN	LOSS GAIN	LOSS GAIN	LOSS GAIN	LOSS GAIN		
NORTH	21.8 16.0	0 0 0	0 0 0	0 0 0	0 0 0	0 0 0	0 0 0	3 65 48	
EAST	21.8 41.6	60 1307 2493	71 1547 2950	0 0 0	0 0 0	0 0 0	0 0 0	3 65 125	
SOUTH	21.8 24.9	0 0 0	0 0 0	32 697 797	9 196 224	0 0 0	0 0 0	6 131 149	
WEST	21.8 41.6	0 0 0	0 0 0	0 0 0	0 0 0	0 0 0	0 0 0	0 0 0	
SKYLT.	35.8 101.2	0 0 0	0 0 0	0 0 0	0 0 0	0 0 0	0 0 0	0 0 0	
DOORS	25.8 4.3	0 0 0	0 0 0	0 0 0	0 0 0	40 1034 170	20 517 85	20 517 85	
NET EXPOSED WALL	4.2 0.7	556 2339 385	454 1910 314	103 433 71	112 472 78	282 1186 195	58 243 40	0 0 0	
NET EXPOSED BSMT WALL ABOVE GR	3.7 0.6	0 0 0	0 0 0	0 0 0	0 0 0	0 0 0	0 0 0	504 1857 305	
EXPOSED CLG	1.3 0.6	0 0 0	0 0 0	115 151 68	0 0 0	0 0 0	0 0 0	0 0 0	
NO ATTIC EXPOSED CLG	2.8 1.3	0 0 0	0 0 0	0 0 0	0 0 0	0 0 0	0 0 0	0 0 0	
EXPOSED FLOOR	2.6 0.4	0 0 0	0 0 0	0 0 0	0 0 0	0 0 0	0 0 0	0 0 0	
BASEMENT/CRAWL HEAT LOSS		0	0	0	0	0	0	0	
SLAB ON GRADE HEAT LOSS		0	0	0	0	0	0	0	
SUBTOTAL HT LOSS		3646	3457	1281	668	2219	760	8342	
SUB TOTAL HT GAIN		2878	3264	936	302	365	125	712	
LEVEL FACTOR / MULTIPLIER	0.30 0.32	0.30 0.32	0.30 0.32	0.20 0.16	0.30 0.32	0.30 0.32	0.30 0.32	0.50 0.69	
AIR CHANGE HEAT LOSS	1178	1117	208	43	216	717	245	5787	
AIR CHANGE HEAT GAIN	134	152	0	0	14	17	6	33	
DUCT LOSS	0	0	0	0	0	0	0	0	
DUCT GAIN	0	0	0	0	0	0	0	0	
HEAT GAIN PEOPLE	240	0	0	0	0	0	0	0	
HEAT GAIN APPLIANCES/LIGHTS		693	693	693	693	0	0	693	
TOTAL HT LOSS BTU/H		4823	4573	1490	884	2936	1005	14130	
TOTAL HT GAIN x 1.3 BTU/H		4816	5341	2173	410	497	170	1870	

TOTAL HEAT GAIN BTU/H:

35307

TONS: 2.94

LOSS DUE TO VENTILATION LOAD BTU/H: 1670

STRUCTURAL HEAT LOSS: 45599

TOTAL COMBINED HEAT LOSS BTU/H: 47269

SITE NAME: CENTREFIELD (WEST GORMLEY)
BUILDER: ROYAL PINE HOMES

TYPE: 38-14

DATE: Jun-21

GFA: 2724

LO# 91284

HEATING CFM 1115 COOLING CFM 1115
TOTAL HEAT LOSS 45,599 TOTAL HEAT GAIN 35,032
AIR FLOW RATE CFM 24.45 AIR FLOW RATE CFM 31.83

furnace pressure 0.6
furnace filter 0.05
a/c coil pressure 0.2
available pressure
for s/a & r/a 0.35

****CARRIER**
59TN6B-060-14V
FAN SPEED 60

AFUE = 97 %
INPUT (BTU/H) = 60,000
OUTPUT (BTU/H) = **58,000**

RUN COUNT	4th	3rd	2nd	1st	Bas
S/A	0	0	13	7	4
R/A	0	0	5	1	1

plenum pressure s/a 0.18 r/a pressure 0.17
max s/a dif press. loss 0.02 r/a grille press. Loss 0.02
min adjusted pressure s/a 0.16 adjusted pressure r/a 0.15

LOW 930
MEDLOW 1050
MEDIUM 1115
MEDIUM HIGH 1245
HIGH 1520

DESIGN CFM = **1115**
CFM @ .6" E.S.P.

TEMPERATURE RISE 48 °F

All S/A diffusers 4"x10" unless noted otherwise on layout.

All S/A runs 5"Ø unless noted otherwise on layout.

RUN #	1	2	3	4	5	6	7	8	9	10	11	12	13	14	15	16	17	18	19	20	21	22	23	24
ROOM NAME	MBR	ENS	WIC	BED-2	BED-3	BED-4	ENS-2	BED-2	BED-3	MBR	S-BATH	GRT	GRT	KIT	KIT	S-BATH	LAUN	PWD	FOY	MUD	BAS	BAS	BAS	BAS
RM LOSS MBH.	1.47	1.71	0.51	1.50	1.99	1.83	0.85	1.50	1.99	1.47	0.48	2.41	2.41	2.29	2.29	0.48	1.49	0.88	2.94	1.00	3.53	3.53	3.53	3.53
CFM PER RUN HEAT	36	42	13	37	49	45	21	37	49	36	12	59	59	56	56	12	36	22	72	25	86	86	86	86
RM GAIN MBH.	2.11	1.51	0.15	2.41	2.55	2.34	0.35	2.41	2.55	2.11	0.63	2.41	2.41	2.67	2.67	0.63	2.17	0.41	0.50	0.17	0.47	0.47	0.47	0.47
CFM PER RUN COOLING	67	48	5	77	81	74	11	77	81	67	20	77	77	85	85	20	69	13	16	5	15	15	15	15
ADJUSTED PRESSURE	0.17	0.17	0.17	0.17	0.16	0.17	0.17	0.17	0.16	0.17	0.17	0.17	0.17	0.16	0.16	0.17	0.17	0.17	0.17	0.17	0.16	0.16	0.16	0.16
ACTUAL DUCT LGH.	37	51	39	69	66	51	26	71	72	46	52	30	39	38	28	58	30	47	55	9	34	25	19	43
EQUIVALENT LENGTH	150	190	130	190	160	170	190	180	170	180	150	160	170	160	130	140	150	150	140	110	170	180	160	160
TOTAL EFFECTIVE LENGTH	187	241	169	259	226	221	216	251	242	226	202	190	209	198	158	198	180	197	195	119	204	205	179	203
ADJUSTED PRESSURE	0.09	0.07	0.1	0.07	0.07	0.08	0.08	0.07	0.07	0.08	0.09	0.09	0.08	0.08	0.1	0.09	0.1	0.09	0.09	0.14	0.08	0.08	0.09	0.08
ROUND DUCT SIZE	5	5	4	6	6	6	4	6	6	5	4	6	6	6	6	4	5	4	5	4	6	6	6	6
HEATING VELOCITY (ft/min)	264	308	149	189	250	229	241	189	250	264	138	301	301	286	286	138	264	252	529	287	438	438	438	438
COOLING VELOCITY (ft/min)	492	352	57	393	413	377	126	393	413	492	229	393	393	433	433	229	507	149	117	57	76	76	76	76
OUTLET GRILL SIZE	3X10	3X10	3X10	4X10	4X10	4X10	3X10	4X10	4X10	3X10	3X10	4X10	4X10	4X10	4X10	3X10	3X10	3X10	3X10	3X10	4X10	4X10	4X10	4X10
TRUNK	A	A	D	B	C	C	D	B	C	A	C	A	A	A	A	C	D	B	B	D	A	A	C	B

RUN #	
ROOM NAME	
RM LOSS MBH.	
CFM PER RUN HEAT	
RM GAIN MBH.	
CFM PER RUN COOLING	
ADJUSTED PRESSURE	
ACTUAL DUCT LGH.	
EQUIVALENT LENGTH	
TOTAL EFFECTIVE LENGTH	
ADJUSTED PRESSURE	
ROUND DUCT SIZE	
HEATING VELOCITY (ft/min)	
COOLING VELOCITY (ft/min)	
OUTLET GRILL SIZE	
TRUNK	

SUPPLY AIR TRUNK SIZE																RETURN AIR TRUNK SIZE							
	TRUNK CFM	STATIC PRESS.	ROUND DUCT	RECT DUCT		VELOCITY (ft/min)		TRUNK CFM	STATIC PRESS.	ROUND DUCT	RECT DUCT		VELOCITY (ft/min)			TRUNK CFM	STATIC PRESS.	ROUND DUCT	RECT DUCT		VELOCITY (ft/min)		
TRUNK A	516	0.07	11.3	14	x	8	663	TRUNK G	0	0.00	0	0	x	8	0	TRUNK O	0	0.05	0	0	x	8	0
TRUNK B	254	0.07	8.7	10	x	8	457	TRUNK H	0	0.00	0	0	x	8	0	TRUNK P	0	0.05	0	0	x	8	0
TRUNK C	507	0.07	11.2	14	x	8	652	TRUNK I	0	0.00	0	0	x	8	0	TRUNK Q	0	0.05	0	0	x	8	0
TRUNK D	1118	0.07	15.1	26	x	8	774	TRUNK J	0	0.00	0	0	x	8	0	TRUNK R	0	0.05	0	0	x	8	0
TRUNK E	0	0.00	0	0	x	8	0	TRUNK K	0	0.00	0	0	x	8	0	TRUNK S	0	0.05	0	0	x	8	0
TRUNK F	0	0.00	0	0	x	8	0	TRUNK L	0	0.00	0	0	x	8	0	TRUNK T	0	0.05	0	0	x	8	0
																TRUNK U	0	0.05	0	0	x	8	0
																TRUNK V	0	0.05	0	0	x	8	0
																TRUNK W	0	0.05	0	0	x	8	0
RETURN AIR #	1	2	3	4	5	6									BR	TRUNK X	1115	0.05	16.4	32	x	8	627
AIR VOLUME	145	115	115	115	105	360	0	0	0	0	0	0	0	0	160	TRUNK Y	345	0.05	10.6	14	x	8	444
PLENUM PRESSURE	0.15	0.15	0.15	0.15	0.15	0.15	0.15	0.15	0.15	0.15	0.15	0.15	0.15	0.15	0.15	TRUNK Z	0	0.05	0	0	x	8	0
ACTUAL DUCT LGH.	34	62	71	65	30	25	1	1	1	1	1	1	1	1	14	DROP	1115	0.05	16.4	24	x	10	669
EQUIVALENT LENGTH	175	250	245	205	155	175	0	0	0	0	0	0	0	0	135								
TOTAL EFFECTIVE LH	209	312	316	270	185	200	1	1	1	1	1	1	1	1	149								
ADJUSTED PRESSURE	0.07	0.05	0.05	0.05	0.08	0.07	14.80	14.80	14.80	14.80	14.80	14.80	14.80	14.80	0.10								
ROUND DUCT SIZE	7	7	7	7	6	9.9	0	0	0	0	0	0	0	0	6.7								
INLET GRILL SIZE	8	8	8	8	8	8	0	0	0	0	0	0	0	0	8								
	X	X	X	X	X	X	X	X	X	X	X	X	X	X	X								
INLET GRILL SIZE	14	14	14	14	14	30	0	0	0	0	0	0	0	0	14								

TYPE: 38-14
SITE NAME: CENTREFIELD (WEST GORMLEY)

LO # 91284

RESIDENTIAL MECHANICAL VENTILATION DESIGN SUMMARY

COMBUSTION APPLIANCES		9.32.3.1(1)
a)	<input checked="" type="checkbox"/> Direct vent (sealed combustion) only	
b)	<input type="checkbox"/> Positive venting induced draft (except fireplaces)	
c)	<input type="checkbox"/> Natural draft, B-vent or induced draft gas fireplace	
d)	<input type="checkbox"/> Solid Fuel (including fireplaces)	
e)	<input type="checkbox"/> No Combustion Appliances	

HEATING SYSTEM	
<input checked="" type="checkbox"/> Forced Air	<input type="checkbox"/> Non Forced Air
<input type="checkbox"/> Electric Space Heat	

HOUSE TYPE		9.32.1(2)
<input checked="" type="checkbox"/> I	Type a) or b) appliance only, no solid fuel	
<input type="checkbox"/> II	Type I except with solid fuel (including fireplaces)	
<input type="checkbox"/> III	Any Type c) appliance	
<input type="checkbox"/> IV	Type I, or II with electric space heat	
<input type="checkbox"/>	Other: Type I, II or IV no forced air	

SYSTEM DESIGN OPTIONS		O.N.H.W.P.
<input type="checkbox"/> 1	Exhaust only/Forced Air System	
<input type="checkbox"/> 2	HRV with Ducting/Forced Air System	
<input checked="" type="checkbox"/> 3	HRV Simplified/connected to forced air system	
<input type="checkbox"/> 4	HRV with Ducting/non forced air system	
<input type="checkbox"/>	Part 6 Design	

TOTAL VENTILATION CAPACITY		9.32.3.3(1)
Basement + Master Bedroom	<u>2</u> @ 21.2 cfm <u>42.4</u> cfm	
Other Bedrooms	<u>3</u> @ 10.6 cfm <u>31.8</u> cfm	
Kitchen & Bathrooms	<u>5</u> @ 10.6 cfm <u>53</u> cfm	
Other Rooms	<u>3</u> @ 10.6 cfm <u>31.8</u> cfm	
Table 9.32.3.A.	TOTAL <u>159.0</u> cfm	

PRINCIPAL VENTILATION CAPACITY REQUIRED		9.32.3.4.(1)
1 Bedroom	31.8 cfm	
2 Bedroom	47.7 cfm	
3 Bedroom	63.6 cfm	
4 Bedroom	79.5 cfm	
5 Bedroom	95.4 cfm	
TOTAL <u>79.5</u> cfm		

SUPPLEMENTAL VENTILATION CAPACITY		9.32.3.5.
Total Ventilation Capacity	<u>159</u> cfm	
Less Principal Ventil. Capacity	<u>79.5</u> cfm	
Required Supplemental Capacity	<u>79.5</u> cfm	

PRINCIPAL EXHAUST FAN CAPACITY	
Model: VANEE 65H	Location: BSMT
<u>79.5</u> cfm	<input checked="" type="checkbox"/> HVI Approved

PRINCIPAL EXHAUST HEAT LOSS CALCULATION				
CFM	ΔT °F	FACTOR	% LOSS	
79.5 CFM	X 78 F	X 1.08	X	0.25

SUPPLEMENTAL FANS		BY INSTALLING CONTRACTOR		
Location	Model	cfm	HVI	Sones
ENS	BY INSTALLING CONTRACTOR	50	<input checked="" type="checkbox"/>	3.5
ENS-2	BY INSTALLING CONTRACTOR	50	<input checked="" type="checkbox"/>	3.5
S-BATH	BY INSTALLING CONTRACTOR	50	<input checked="" type="checkbox"/>	3.5
PWD	BY INSTALLING CONTRACTOR	50	<input checked="" type="checkbox"/>	3.5

HEAT RECOVERY VENTILATOR		9.32.3.11.
Model: VANEE 65H		
<u>155</u> cfm high	<u>64</u> cfm low	
<u>75</u> % Sensible Efficiency @ 32 deg F (0 deg C)	<input checked="" type="checkbox"/> HVI Approved	

LOCATION OF INSTALLATION	
Lot:	City of Richmond Hill Building Division
Township	Richmond Hill
Address	HVAC REVIEWED
Roll #	Initials: <u>PXV</u>

BUILDER: ROYAL PINE HOMES	
Name:	
Address:	
City:	
Telephone #:	Fax #:

INSTALLING CONTRACTOR	
Name:	
Address:	
City:	
Telephone #:	Fax #:

DESIGNER CERTIFICATION	
I hereby certify that this ventilation system has been designed in accordance with the Ontario Building Code.	
Name:	HVAC Designs Ltd.
Signature:	<i>Michael O'Rourke</i>
HRAI #	001820
Date:	June-21

I REVIEW AND TAKE RESPONSIBILITY FOR THE DESIGN WORK AND AM QUALIFIED IN THE APPROPRIATE CATEGORY AS AN "OTHER DESIGNER" UNDER DIVISION C, 3.2.5 OF THE BUILDING CODE.

INDIVIDUAL BCIN: 19669

MICHAEL O'ROURKE

CSA F280-12 Residential Heat Loss and Heat Gain Calculations	
Formula Sheet (For Air Leakage / Ventilation Calculation)	
LO#: 91284	Model: 38-14	Builder: ROYAL PINE HOMES	Date: 2021-06-21	
Volume Calculation			Air Change & Delta T Data	
House Volume <table border="1" style="width: 100%; border-collapse: collapse;"> <thead> <tr> <th>Level</th> <th>Floor Area (ft²)</th> <th>Floor Height (ft)</th> <th>Volume (ft³)</th> </tr> </thead> <tbody> <tr> <td>Bsmt</td> <td>1098</td> <td>10</td> <td>10980</td> </tr> <tr> <td>First</td> <td>1098</td> <td>10</td> <td>11089.8</td> </tr> <tr> <td>Second</td> <td>1626</td> <td>9</td> <td>14634</td> </tr> <tr> <td>Third</td> <td>0</td> <td>9</td> <td>0</td> </tr> <tr> <td>Fourth</td> <td>0</td> <td>9</td> <td>0</td> </tr> <tr> <td colspan="2" style="text-align: right;">Total:</td> <td></td> <td>36,703.8 ft³</td> </tr> <tr> <td colspan="2" style="text-align: right;">Total:</td> <td></td> <td>1039.3 m³</td> </tr> </tbody> </table>			Level	Floor Area (ft²)	Floor Height (ft)	Volume (ft³)	Bsmt	1098	10	10980	First	1098	10	11089.8	Second	1626	9	14634	Third	0	9	0	Fourth	0	9	0	Total:			36,703.8 ft³	Total:			1039.3 m³	<table border="1" style="width: 100%; border-collapse: collapse;"> <tr> <td style="width: 80%;">WINTER NATURAL AIR CHANGE RATE</td> <td style="width: 20%;">0.227</td> </tr> <tr> <td>SUMMER NATURAL AIR CHANGE RATE</td> <td>0.071</td> </tr> </table> <table border="1" style="width: 100%; border-collapse: collapse;"> <tr> <th colspan="5" style="text-align: center;">Design Temperature Difference</th> </tr> <tr> <th></th> <th>Tin °C</th> <th>Tout °C</th> <th>ΔT °C</th> <th>ΔT °F</th> </tr> <tr> <td>Winter DTDh</td> <td>22</td> <td>-21</td> <td>43</td> <td>78</td> </tr> <tr> <td>Summer DTDc</td> <td>24</td> <td>31</td> <td>7</td> <td>13</td> </tr> </table>		WINTER NATURAL AIR CHANGE RATE	0.227	SUMMER NATURAL AIR CHANGE RATE	0.071	Design Temperature Difference						Tin °C	Tout °C	ΔT °C	ΔT °F	Winter DTDh	22	-21	43	78	Summer DTDc	24	31	7	13
Level	Floor Area (ft²)	Floor Height (ft)	Volume (ft³)	
Bsmt	1098	10	10980	
First	1098	10	11089.8	
Second	1626	9	14634	
Third	0	9	0	
Fourth	0	9	0	
Total:			36,703.8 ft³	
Total:			1039.3 m³	
WINTER NATURAL AIR CHANGE RATE	0.227	
SUMMER NATURAL AIR CHANGE RATE	0.071	
Design Temperature Difference	
	Tin °C	Tout °C	ΔT °C	ΔT °F	
Winter DTDh	22	-21	43	78	
Summer DTDc	24	31	7	13	
5.2.3.1 Heat Loss due to Air Leakage			6.2.6 Sensible Gain due to Air Leakage	
$HL_{airb} = LR_{airh} \times \frac{V_b}{3.6} \times DTD_h \times 1.2$ <p>0.227 x 288.70 x 43 °C x 1.2 = 3392 W</p> <p>= 11574 Btu/h</p>			$HG_{salb} = LR_{airc} \times \frac{V_b}{3.6} \times DTD_c \times 1.2$ <p>= 0.071 x 288.70 x 7 °C x 1.2 = 174 W</p> <p>= 594 Btu/h</p>	
5.2.3.2 Heat Loss due to Mechanical Ventilation			6.2.7 Sensible heat Gain due to Ventilation	
$HL_{vairb} = PVC \times DTD_h \times 1.08 \times (1 - E)$ <p>80 CFM x 78 °F x 1.08 x 0.25 = 1670 Btu/h</p>			$HL_{vairb} = PVC \times DTD_h \times 1.08 \times (1 - E)$ <p>80 CFM x 13 °F x 1.08 x 0.25 = 275 Btu/h</p>	
5.2.3.3 Calculation of Air Change Heat Loss for Each Room (Floor Multiplier Section)	
$HL_{airr} = Level\ Factor \times HL_{airbv} \times \{(HL_{agcr} + HL_{bgcr}) \div (HL_{agclevel} + HL_{bgclevel})\}$ <table border="1" style="width: 100%; border-collapse: collapse;"> <thead> <tr> <th>Level</th> <th>Level Factor (LF)</th> <th>HLairve Air Leakage + Ventilation Heat Loss (Btu/h)</th> <th>Level Conductive Heat Loss: (HL_{clevel})</th> <th>Air Leakage Heat Loss Multiplier (LF x HLairbv / HLlevel)</th> </tr> </thead> <tbody> <tr> <td>1</td> <td>0.5</td> <td rowspan="5" style="text-align: center; vertical-align: middle;">11,574</td> <td>8,342</td> <td>0.694</td> </tr> <tr> <td>2</td> <td>0.3</td> <td>10,749</td> <td>0.323</td> </tr> <tr> <td>3</td> <td>0.2</td> <td>14,242</td> <td>0.163</td> </tr> <tr> <td>4</td> <td>0</td> <td>0</td> <td>0.000</td> </tr> <tr> <td>5</td> <td>0</td> <td>0</td> <td>0.000</td> </tr> </tbody> </table> <p>*HLairbv = Air leakage heat loss + ventilation heat loss *For a balanced or supply only ventilation system HLairve = 0</p>					Level	Level Factor (LF)	HLairve Air Leakage + Ventilation Heat Loss (Btu/h)	Level Conductive Heat Loss: (HL _{clevel})	Air Leakage Heat Loss Multiplier (LF x HLairbv / HLlevel)	1	0.5	11,574	8,342	0.694	2	0.3	10,749	0.323	3	0.2	14,242	0.163	4	0	0	0.000	5	0	0	0.000																														
Level	Level Factor (LF)	HLairve Air Leakage + Ventilation Heat Loss (Btu/h)	Level Conductive Heat Loss: (HL _{clevel})	Air Leakage Heat Loss Multiplier (LF x HLairbv / HLlevel)	
1	0.5	11,574	8,342	0.694	
2	0.3		10,749	0.323	
3	0.2		14,242	0.163	
4	0		0	0.000	
5	0		0	0.000	

HEAT LOSS AND GAIN SUMMARY SHEET**MODEL:** 38-14**BUILDER:** ROYAL PINE HOMES**SFQT:** 2724**LO#** 91284**SITE:** CENTREFIELD (WEST GORMLEY)**DESIGN ASSUMPTIONS**

HEATING	°F	COOLING	°F
OUTDOOR DESIGN TEMP.	-6	OUTDOOR DESIGN TEMP.	88
INDOOR DESIGN TEMP.	72	INDOOR DESIGN TEMP. (MAX 75°F)	75

BUILDING DATA

ATTACHMENT:	DETACHED	# OF STORIES (+BASEMENT):	3
FRONT FACES:	EAST	ASSUMED (Y/N):	Y
AIR CHANGES PER HOUR:	2.50	ASSUMED (Y/N):	Y
AIR TIGHTNESS CATEGORY:	TIGHT	ASSUMED (Y/N):	Y
WIND EXPOSURE:	SHELTERED	ASSUMED (Y/N):	Y
HOUSE VOLUME (ft ³):	36703.8	ASSUMED (Y/N):	Y
INTERNAL SHADING:	BLINDS/CURTAINS	ASSUMED OCCUPANTS:	5
INTERIOR LIGHTING LOAD (Btu/h/ft ²):	1.45	DC BRUSHLESS MOTOR (Y/N):	Y
FOUNDATION CONFIGURATION	BCIN_1	DEPTH BELOW GRADE:	7.0 ft
LENGTH: 53.0 ft	WIDTH: 31.0 ft	EXPOSED PERIMETER:	168.0 ft

2012 OBC - COMPLIANCE PACKAGE**Component****Compliance Package
SB-12 PERFORMANCE****Nominal Min. Eff.**

Ceiling with Attic Space Minimum RSI (R)-Value	60	59.20
Ceiling Without Attic Space Minimum RSI (R)-Value	31	27.70
Exposed Floor Minimum RSI (R)-Value	31	29.80
Walls Above Grade Minimum RSI (R)-Value	22+1.5	18.50
Basement Walls Minimum RSI (R)-Value	20	21.12
Below Grade Slab Entire surface > 600 mm below grade Minimum RSI (R)-Value	-	-
Edge of Below Grade Slab ≤ 600 mm Below Grade Minimum RSI (R)-Value	10	10
Heated Slab or Slab ≤ 600 mm below grade Minimum RSI (R)-Value	10	11.13
Windows and Sliding Glass Doors Maximum U-Value	1.6	-
Skylights Maximum U-Value	2.6	-
Space Heating Equipment Minimum AFUE	0.96	-
HRV Minimum Efficiency	75%	-
Domestic Hot Water Heater Minimum EF	TE=94%	-


INDIVIDUAL BCIN: 19669

MICHAEL O'ROURKE



Residential Foundation Thermal Load Calculator

Supplemental tool for CAN/CSA-F280

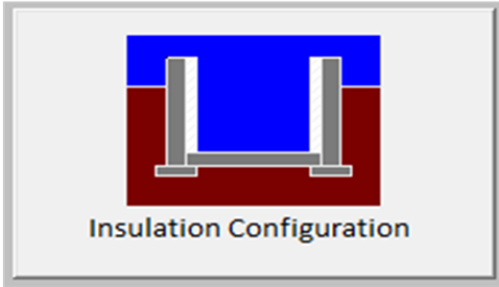Weather Station Description		
Province:	Ontario	
Region:	Richmond Hill	
Site Description		
Soil Conductivity:	Normal conductivity: dry sand, loam, clay	
Water Table:	Normal (7-10 m, 23-33 ft)	
Foundation Dimensions		
Floor Length (m):	16.2	
Floor Width (m):	9.4	
Exposed Perimeter (m):	0.0	
Wall Height (m):	3.0	
Depth Below Grade (m):	2.13	
Window Area (m ²):	1.1	
Door Area (m ²):	1.9	
Radiant Slab		
Heated Fraction of the Slab:	0	
Fluid Temperature (°C):	33	
Design Months		
Heating Month	1	
Foundation Loads		
Heating Load (Watts):		1672

TYPE: 38-14

LO# 91284


Air Infiltration Residential Load Calculator

Supplemental tool for CAN/CSA-F280


Weather Station Description				
Province:	Ontario			
Region:	Richmond Hill			
Weather Station Location:	Open flat terrain, grass			
Anemometer height (m):	10			
Local Shielding				
Building Site:	Suburban, forest			
Walls:	Heavy			
Flue:	Heavy			
Highest Ceiling Height (m):	6.74			
Building Configuration				
Type:	Detached			
Number of Stories:	Two			
Foundation:	Full			
House Volume (m ³):	1039.3			
Air Leakage/Ventilation				
Air Tightness Type:	Energy Star Detached (2.5 ACH)			
Custom BDT Data:	ELA @ 10 Pa. 2.50		970.2 cm ² ACH @ 50 Pa	
Mechanical Ventilation (L/s):	Total Supply 37.5		Total Exhaust 37.5	
Flue Size				
Flue #:	#1	#2	#3	#4
Diameter (mm):	0	0	0	0
Natural Infiltration Rates				
Heating Air Leakage Rate (ACH/H):	0.227			
Cooling Air Leakage Rate (ACH/H):	0.071			

TYPE: 38-14
LO# 91284

DEPRESSURIZATION TEST REQUIRED
BEFORE FINAL OCCUPANCY STAGE TO MEET
TARGETTED ACH
2.5 ach

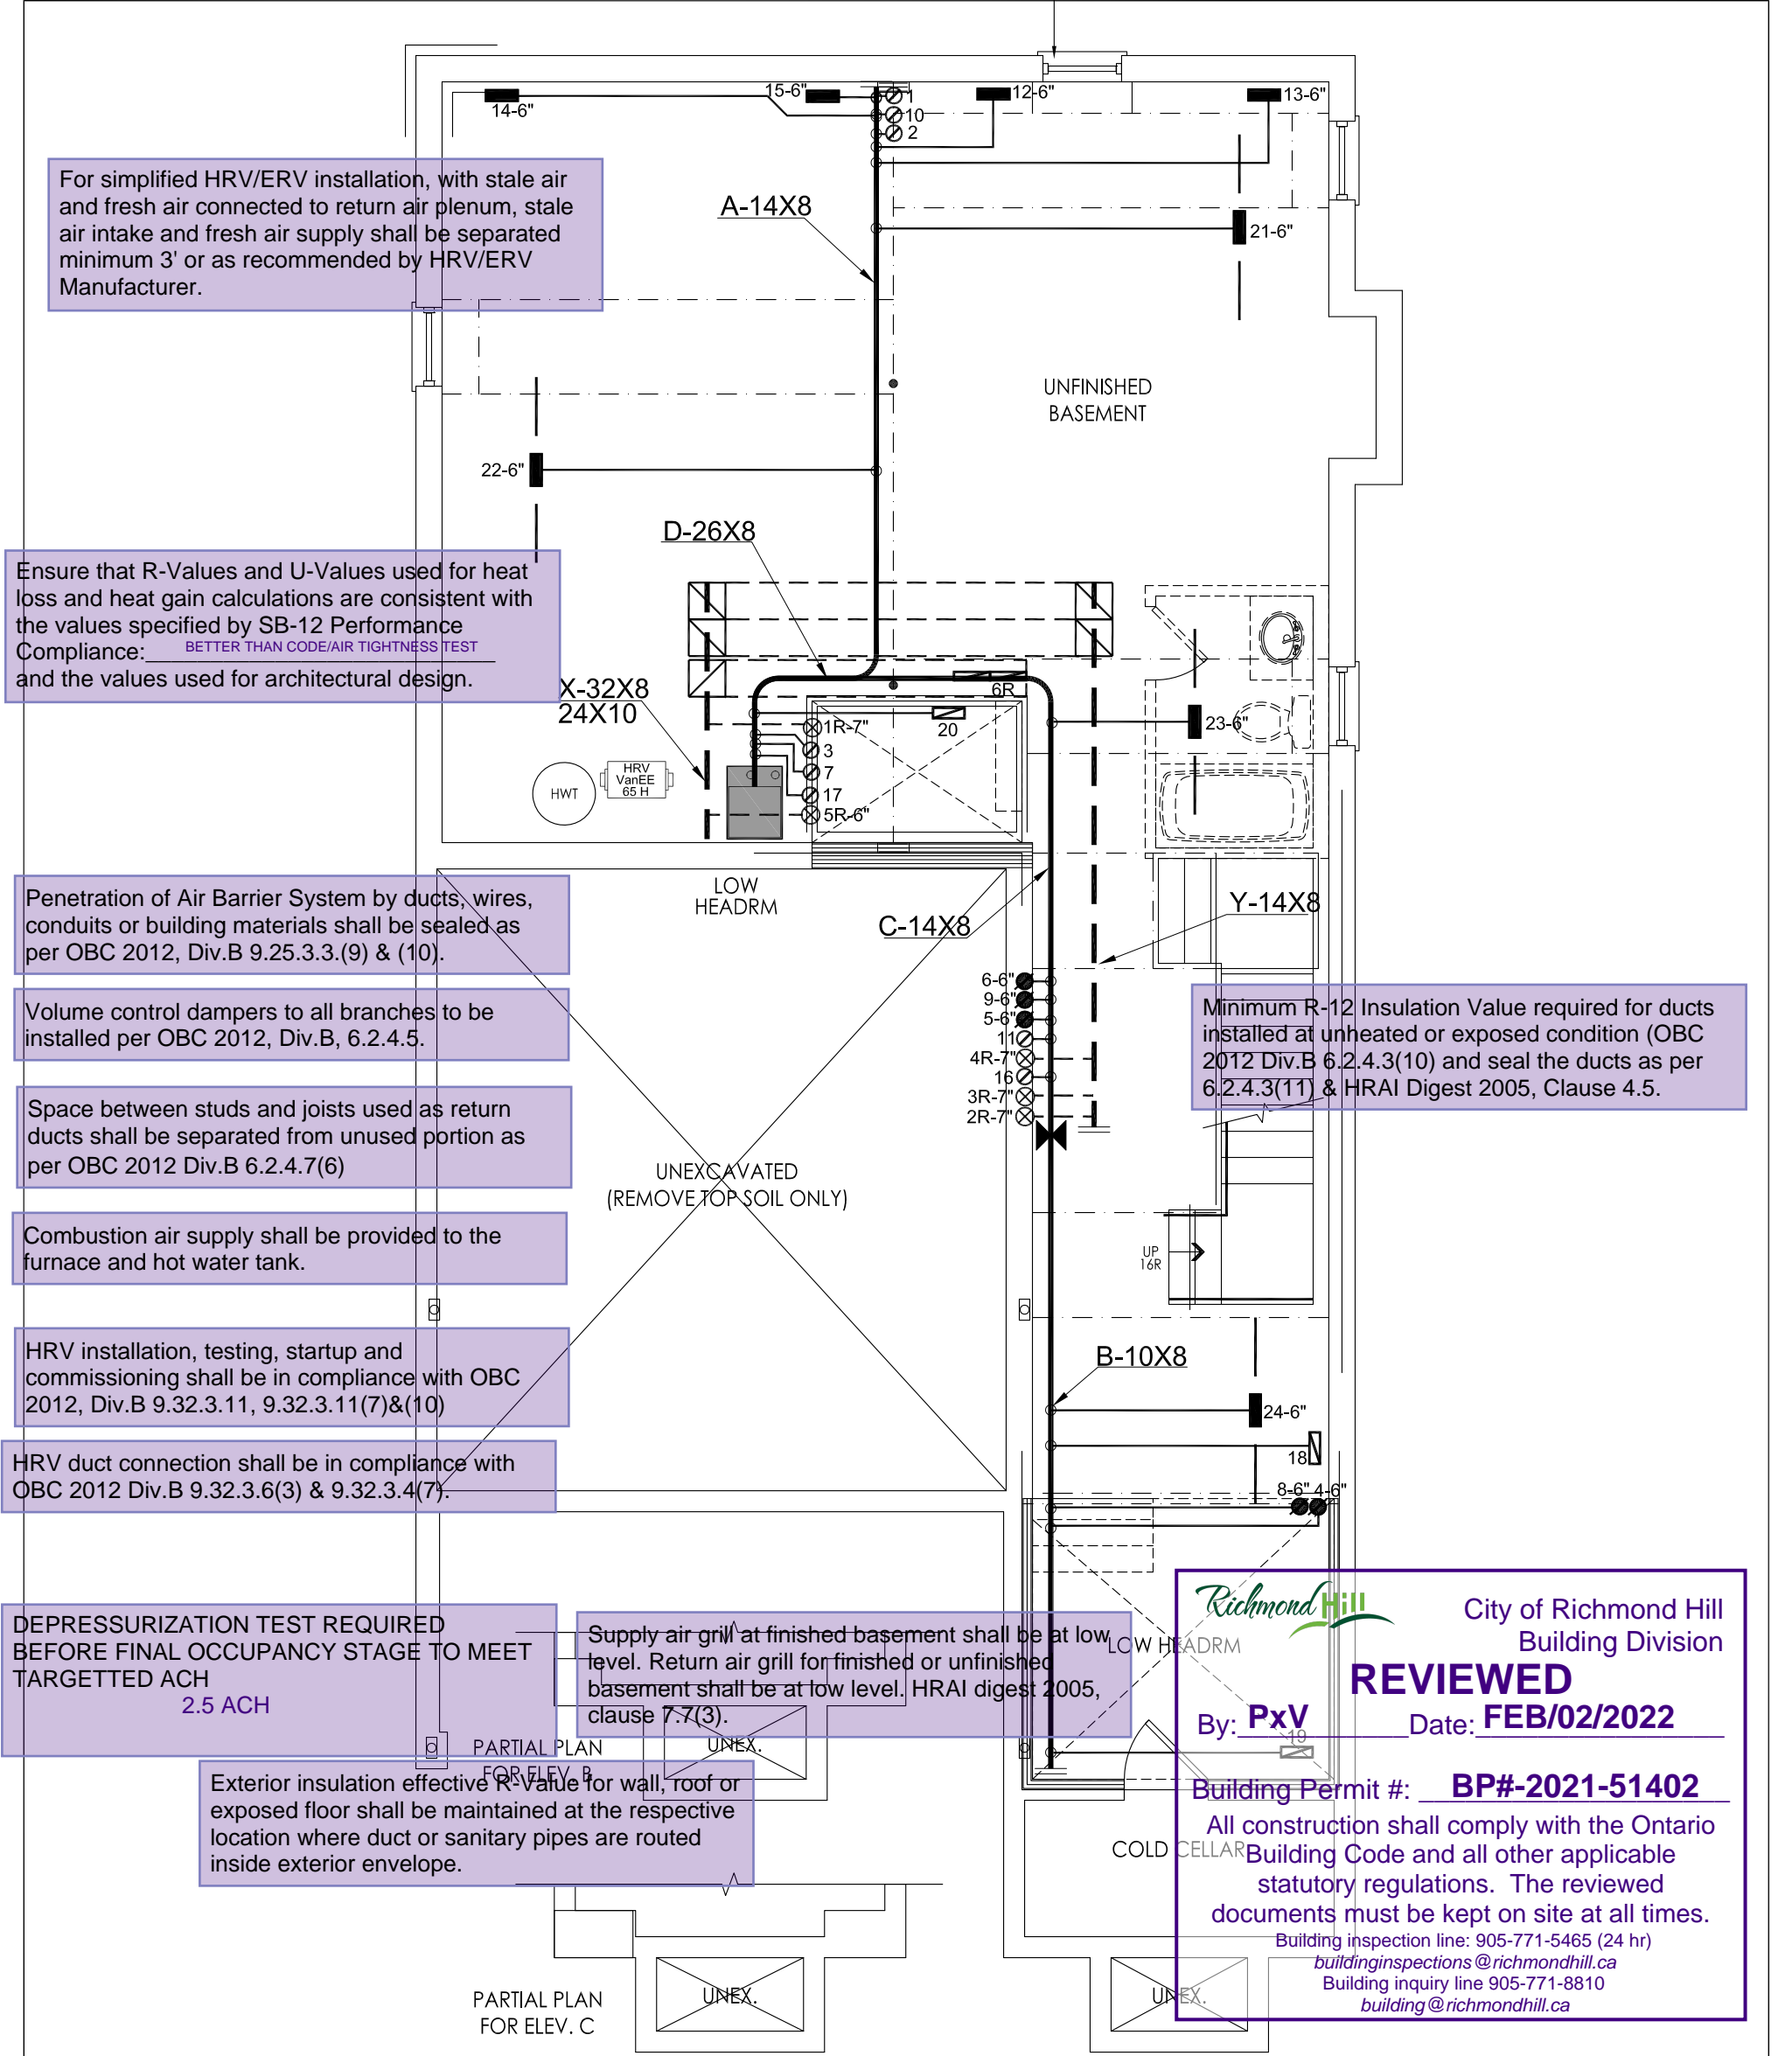

BASEMENT FLOOR PLAN ELEV 'A','B',&,'C'



City of Richmond Hill
Building Division

REVIEWED

By: **PxV**

Date: **FEB/02/2022**

Building Permit #: **BP#-2021-51402**

All construction shall comply with the Ontario Building Code and all other applicable statutory regulations. The reviewed documents must be kept on site at all times.










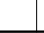


Building inspection line: 905-771-5465 (24 hr)
buildinginspections@richmondhill.ca
Building inquiry line 905-771-8810
building@richmondhill.ca

I MICHAEL O'ROURKE HAVE REVIEWED AND TAKE RESPONSIBILITY FOR THE DESIGN WORK AND AM QUALIFIED UNDER DIVISION C, 3.2.5 OF THE BUILDING CODE.

Michael O'Rourke
Michael O'Rourke, BCIN# 19669
HVAC DESIGNS LTD.

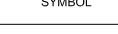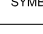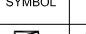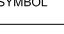
CSA-F280-12

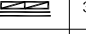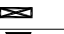SB-12 PERFORMANCE


HVAC LEGEND							3.		
SYMBOL	DESCRIPTION	SYMBOL	DESCRIPTION	SYMBOL	DESCRIPTION	SYMBOL	DESCRIPTION	2.	
	SUPPLY AIR GRILLE		6" SUPPLY AIR BOOT ABOVE		14"x8" RETURN AIR GRILLE		RETURN AIR STACK ABOVE	1.	
	SUPPLY AIR GRILLE 6" BOOT		SUPPLY AIR STACK FROM 2nd FLOOR		30"x8" RETURN AIR GRILLE		RETURN AIR STACK 2nd FLOOR	No.	Description Date
	SUPPLY AIR BOOT ABOVE		6" SUPPLY AIR STACK 2nd FLOOR		FRA- FLOOR RETURN AIR GRILLE		REDUCER	REVISIONS	

ALL DRAWINGS, CALCULATIONS AND SPECIFICATIONS ARE THE PROPERTY OF HVAC DESIGNS LTD.© AND MAY NOT BE REPRODUCED, MODIFIED OR ALTERED WITHOUT EXPRESSED WRITTEN CONSENT. THE DRAWINGS ARE DATED AND USE OF THESE DRAWINGS AFTER ONE YEAR FROM THE DATED NOTED IS NOT AUTHORIZED. CONTRACTOR SHALL CHECK ALL CONDITIONS BEFORE PROCEEDING WITH WORK. LATEST MUNICIPAL APPROVED DRAWINGS ONLY TO BE USED DURING INSTALLATION OF HEATING SYSTEM. HVAC DESIGNS LTD. IS NOT LIABLE FOR ANY CLAIMS ARISING FROM UNAUTHORIZED USE OF THE DRAWINGS OR FROM ANY CHANGES TO ACCEPTED STANDARDS AND/OR THE ONTARIO BUILDING CODE.


Client	<div><div>375 Finley Ave. Suite 202 - Ajax, Ontario L1S 2E2 Tel. 905.619.2300 - 905.420.5300 Fax 905.619.2375 Email: info@hvacdesigns.ca Web: www.hvacdesigns.ca Specializing in Residential Mechanical Design Services</div></div> <div>Installation to comply with the latest Ontario Building Code. All supply branch outlets shall be equipped with a manual balancing damper. Ductwork which passes through the garage or unheated spaces shall be adequately insulated and be gas-proofed.</div>	HEAT LOSS 47269 BTU/H UNIT DATA		# OF RUNS S/A R/A FANS			Sheet Title		
ROYAL PINE HOMES		MAKE CARRIER	3RD FLOOR					BASEMENT HEATING LAYOUT	
Project Name CENTREFIELD (WEST GORMLEY) RICHMOND HILL, ONTARIO		MODEL 59TN6B-060-14V	2ND FLOOR			13	5	3	
		INPUT 60 MBTU/H	1ST FLOOR			7	1	2	Date JUNE/2021
		OUTPUT 58 MBTU/H	BASEMENT			4	1	0	Scale 3/16" = 1'-0"
	COOLING 3.0 TONS	ALL S/A DIFFUSERS 4 "x10" UNLESS NOTED OTHERWISE ON LAYOUT. ALL S/A RUNS 5"Ø UNLESS NOTED OTHERWISE ON LAYOUT. UNDERCUT DOORS 1" min. FOR R/A						BCIN# 19669	
38-14	2724 sqft	FAN SPEED 1115 cfm @ 0.6" w.c.	LO# 91284						

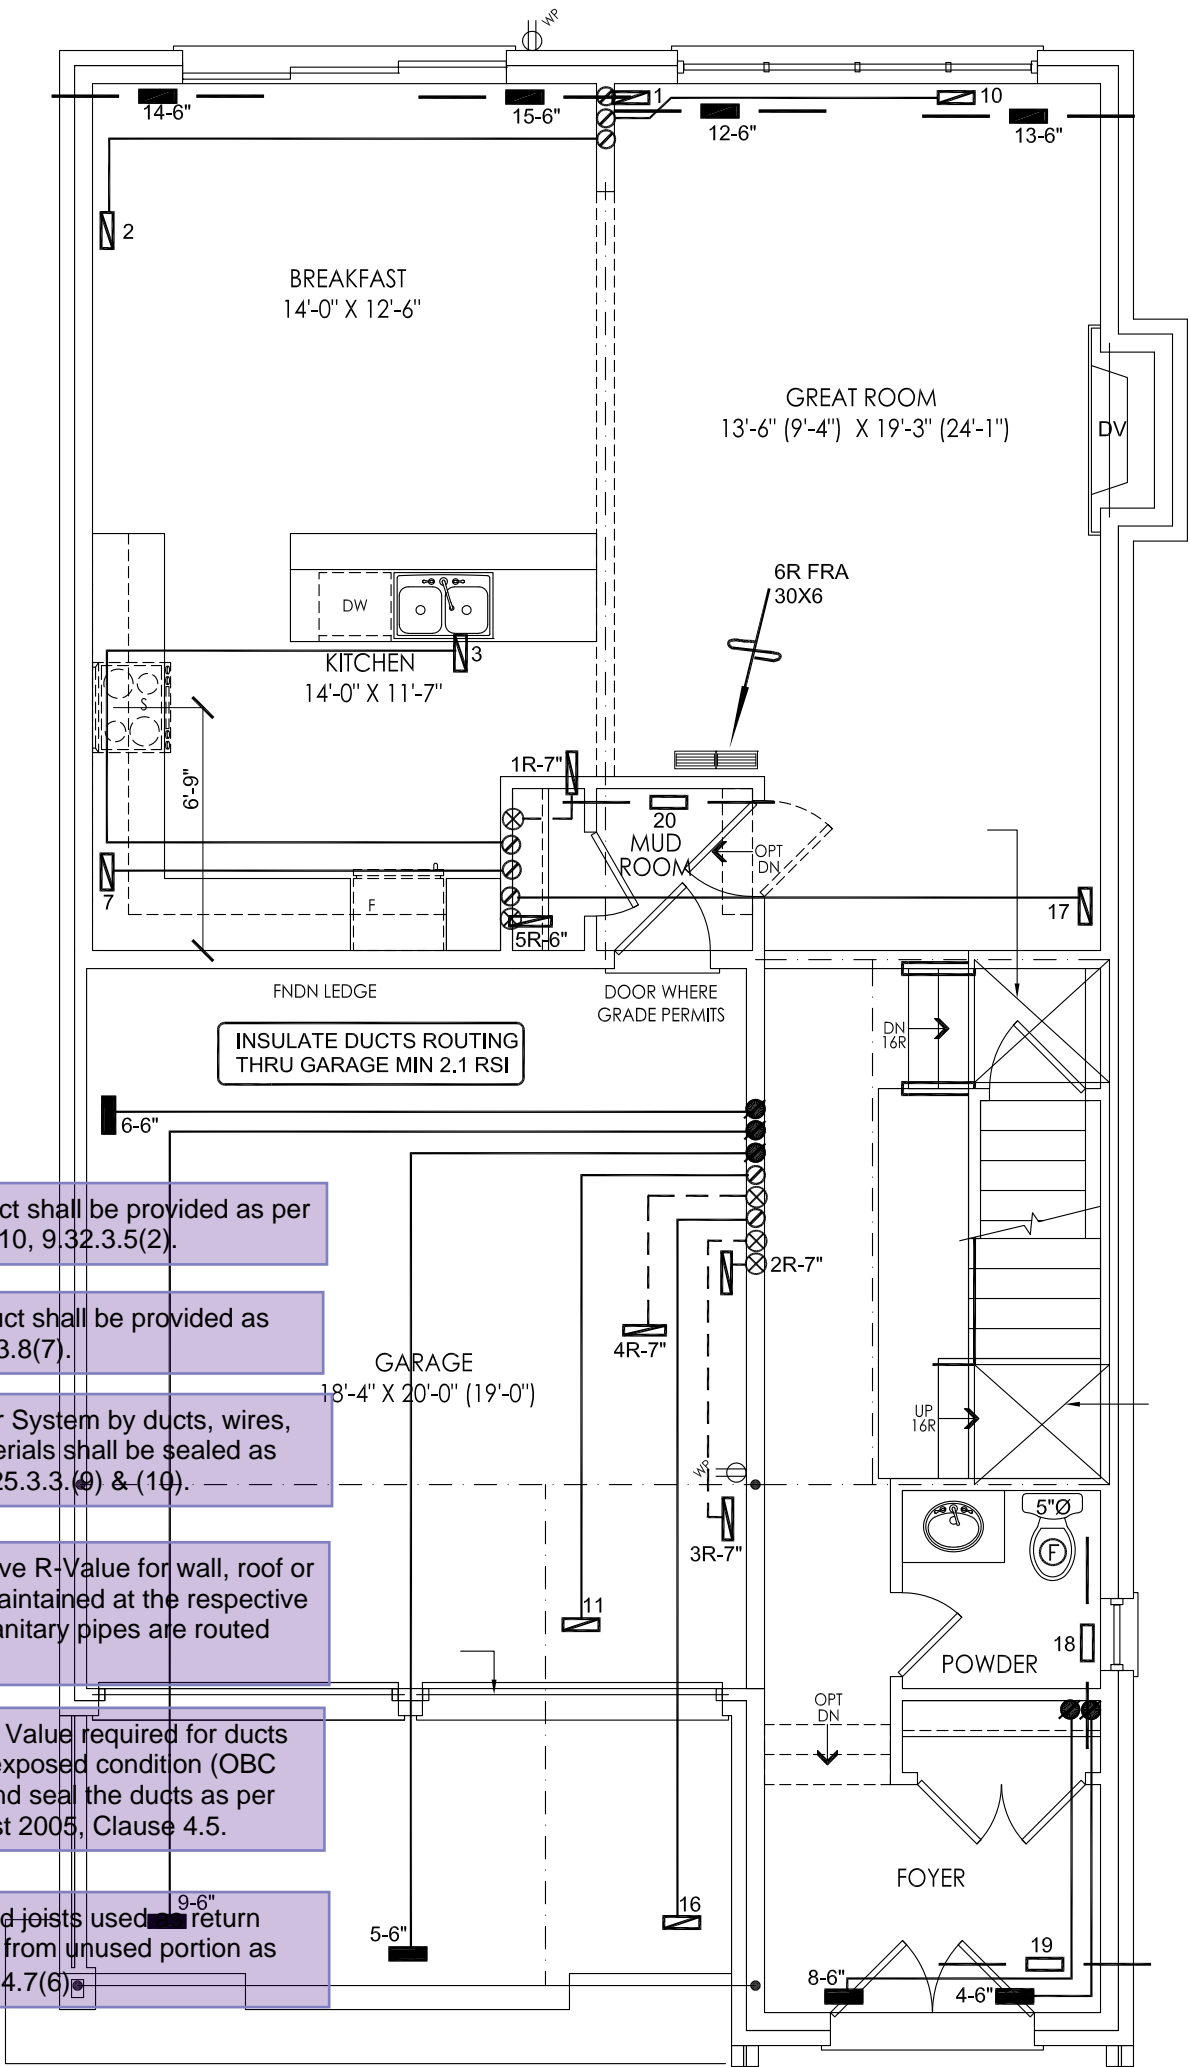

GROUND FLOOR PLAN ELEV 'A'

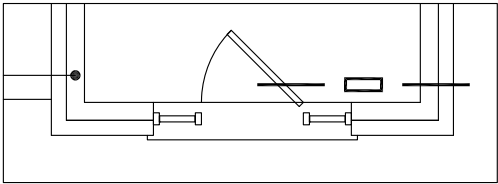

GROUND FLOOR PLAN ELEV 'B'

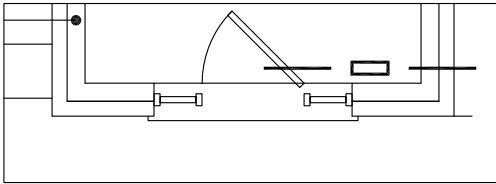

GROUND FLOOR PLAN ELEV 'C'

I MICHAEL O'ROURKE HAVE REVIEWED AND TAKE RESPONSIBILITY FOR THE DESIGN WORK AND AM QUALIFIED UNDER DIVISION C, 3.2.5 OF THE BUILDING CODE.

Michael O'Rourke
Michael O'Rourke, BCIN# 19669
HVAC DESIGNS LTD.


CSA-F280-12

SB-12 PERFORMANCE

HVAC LEGEND							3.		
SYMBOL	DESCRIPTION	SYMBOL	DESCRIPTION	SYMBOL	DESCRIPTION	SYMBOL	DESCRIPTION	2.	
	SUPPLY AIR GRILLE		6" SUPPLY AIR BOOT ABOVE		14"x8" RETURN AIR GRILLE		RETURN AIR STACK ABOVE	1.	
	SUPPLY AIR GRILLE 6" BOOT		SUPPLY AIR STACK FROM 2nd FLOOR		30"x8" RETURN AIR GRILLE		RETURN AIR STACK 2nd FLOOR	No.	Description Date
	SUPPLY AIR BOOT ABOVE		6" SUPPLY AIR STACK 2nd FLOOR		FRA- FLOOR RETURN AIR GRILLE		REDUCER	REVISIONS	

ALL DRAWINGS, CALCULATIONS AND SPECIFICATIONS ARE THE PROPERTY OF HVAC DESIGNS LTD.© AND MAY NOT BE REPRODUCED, MODIFIED OR ALTERED WITHOUT EXPRESSED WRITTEN CONSENT. THE DRAWINGS ARE DATED AND USE OF THESE DRAWINGS AFTER ONE YEAR FROM THE DATED NOTED IS NOT AUTHORIZED. CONTRACTOR SHALL CHECK ALL CONDITIONS BEFORE PROCEEDING WITH WORK. LATEST MUNICIPAL APPROVED DRAWINGS ONLY TO BE USED DURING INSTALLATION OF HEATING SYSTEM. HVAC DESIGNS LTD. IS NOT LIABLE FOR ANY CLAIMS ARISING FROM UNAUTHORIZED USE OF THE DRAWINGS OR FROM ANY CHANGES TO ACCEPTED STANDARDS AND/OR THE ONTARIO BUILDING CODE.

Client		<div></div> <div>375 Finley Ave. Suite 202 - Ajax, Ontario L1S 2E2 Tel. 905.619.2300 - 905.420.5300 Fax 905.619.2375 Email: info@hvacdesigns.ca Web: www.hvacdesigns.ca Specializing in Residential Mechanical Design Services</div>	Sheet Title	
ROYAL PINE HOMES			FIRST FLOOR HEATING LAYOUT	
Project Name		Installation to comply with the latest Ontario Building Code. All supply branch outlets shall be equipped with a manual balancing damper. Ductwork which passes through the garage or unheated spaces shall be adequately insulated and be gas-proofed.	Date	JUNE/2021
CENTREFIELD (WEST GORMLEY) RICHMOND HILL, ONTARIO			Scale	3/16" = 1'-0"
			BCIN# 19669	
38-14	2724 sqft		LO#	91284

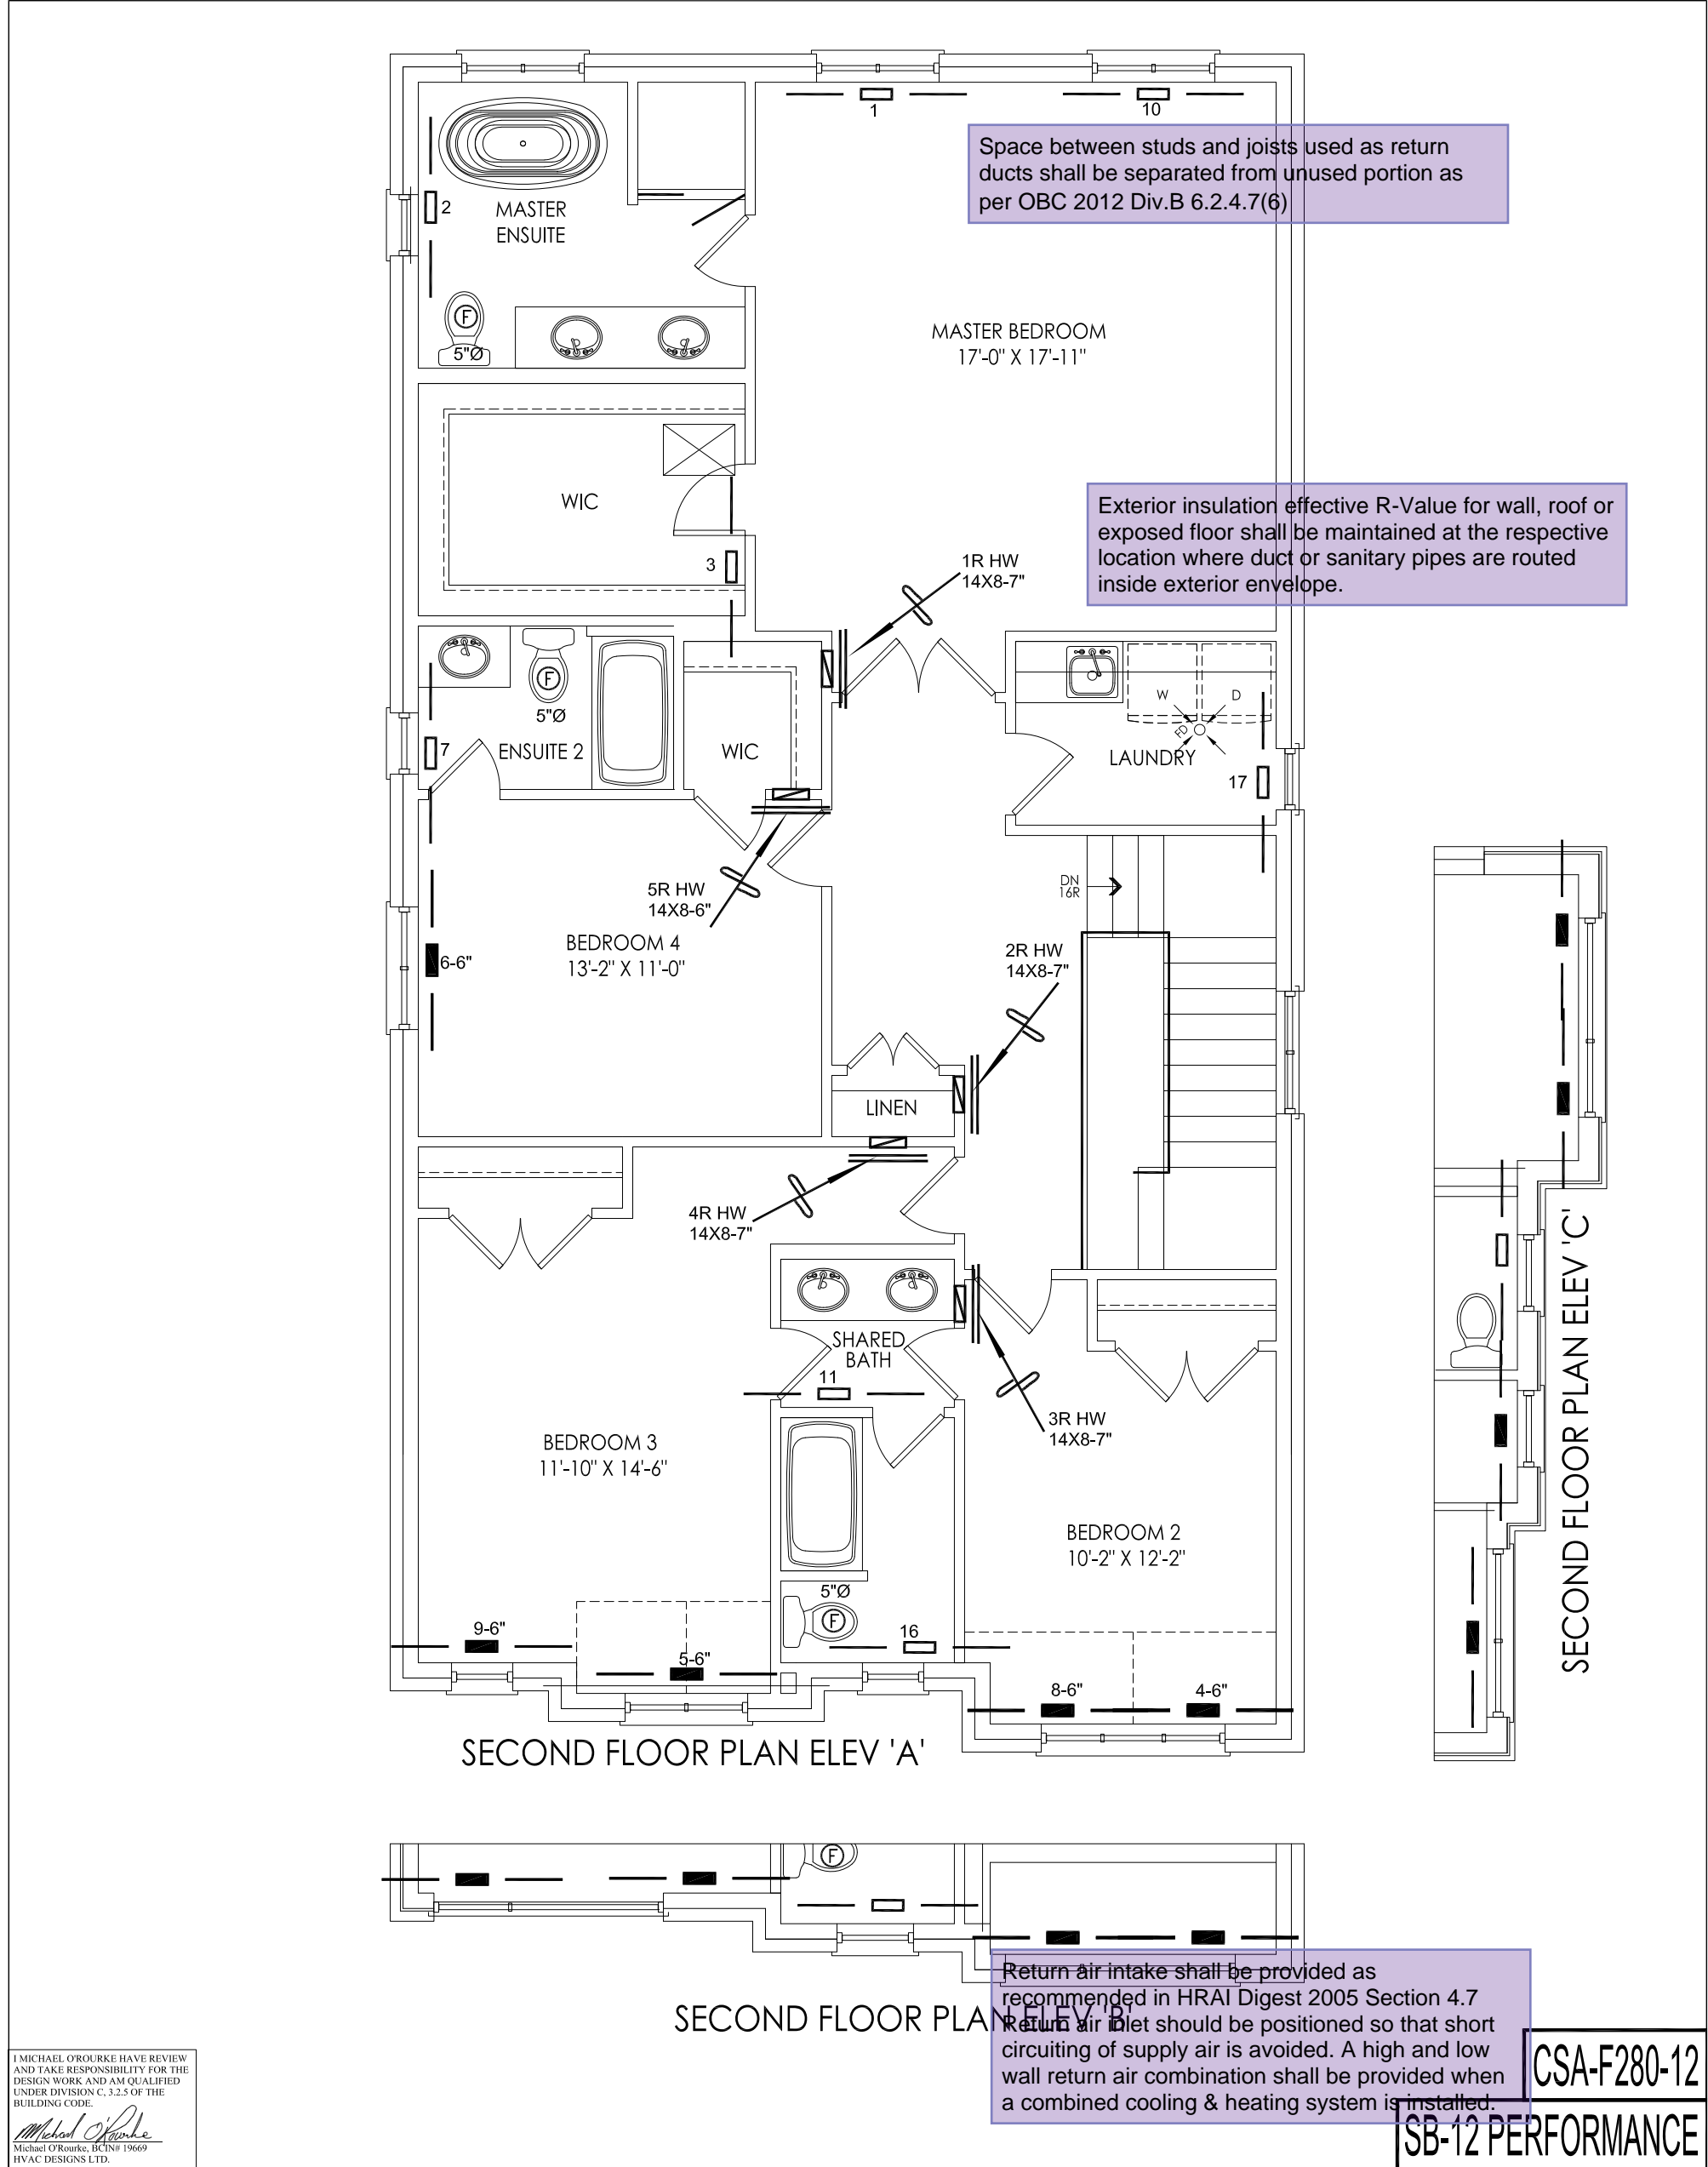

I MICHAEL O'ROURKE HAVE REVIEW AND TAKE RESPONSIBILITY FOR THE DESIGN WORK AND AM QUALIFIED UNDER DIVISION C, 3.2.5 OF THE BUILDING CODE.

Michael O'Rourke
Michael O'Rourke, BCIN# 19669
HVAC DESIGNS LTD.

CSA-F280-12
SB-12 PERFORMANCE

HVAC LEGEND							3.		
SYMBOL	DESCRIPTION	SYMBOL	DESCRIPTION	SYMBOL	DESCRIPTION	SYMBOL	DESCRIPTION	2.	
	SUPPLY AIR GRILLE		6" SUPPLY AIR BOOT ABOVE		14"x8" RETURN AIR GRILLE		RETURN AIR STACK ABOVE	1.	
	SUPPLY AIR GRILLE 6" BOOT		SUPPLY AIR STACK FROM 2nd FLOOR		30"x8" RETURN AIR GRILLE		RETURN AIR STACK 2nd FLOOR	No.	Description Date
	SUPPLY AIR BOOT ABOVE		6" SUPPLY AIR STACK 2nd FLOOR		FRA- FLOOR RETURN AIR GRILLE		REDUCER	REVISIONS	

ALL DRAWINGS, CALCULATIONS AND SPECIFICATIONS ARE THE PROPERTY OF HVAC DESIGNS LTD.© AND MAY NOT BE REPRODUCED, MODIFIED OR ALTERED WITHOUT EXPRESSED WRITTEN CONSENT. THE DRAWINGS ARE DATED AND USE OF THESE DRAWINGS AFTER ONE YEAR FROM THE DATED NOTED IS NOT AUTHORIZED. CONTRACTOR SHALL CHECK ALL CONDITIONS BEFORE PROCEEDING WITH WORK. LATEST MUNICIPAL APPROVED DRAWINGS ONLY TO BE USED DURING INSTALLATION OF HEATING SYSTEM. HVAC DESIGNS LTD. IS NOT LIABLE FOR ANY CLAIMS ARISING FROM UNAUTHORIZED USE OF THE DRAWINGS OR FROM ANY CHANGES TO ACCEPTED STANDARDS AND/OR THE ONTARIO BUILDING CODE.


Client		<div><p>375 Finley Ave. Suite 202 - Ajax, Ontario L1S 2E2 Tel. 905.619.2300 - 905.420.5300 Fax 905.619.2375 Email: info@hvacdesigns.ca Web: www.hvacdesigns.ca Specializing in Residential Mechanical Design Services</p></div>	Sheet Title	
ROYAL PINE HOMES			SECOND FLOOR HEATING LAYOUT	
Project Name		Installation to comply with the latest Ontario Building Code. All supply branch outlets shall be equipped with a manual balancing damper. Ductwork which passes through the garage or unheated spaces shall be adequately insulated and be gas-proofed.	Date	JUNE/2021
CENTREFIELD (WEST GORMLEY) RICHMOND HILL, ONTARIO			Scale	3/16" = 1'-0"
			BCIN# 19669	
38-14		2724 sqft	LO#	91284

Schedule 1: Designer Information

Use one form for each individual who reviews and takes responsibility for design activities with respect to the project.

HVAC REVIEWED

Initials: **PXV**

A. Project Information			
Building number, street name			
Municipality RICHMOND HILL	Postal code	Plan number/ other description	
B. Individual who reviews and takes responsibility for design activities			
Name MICHAEL O'ROURKE		Firm HVAC DESIGNS LTD.	
Street address 375 FINLEY AVE		Unit no. 202	Lot/con. N/A
Municipality AJAX	Postal code L1S 2E2	Province ONTARIO	E-mail info@hvacdesigns.ca
Telephone number (905) 619-2300	Fax number (905) 619-2375	Cell number ()	
C. Design activities undertaken by individual identified in Section B. [Building Code Table 3.5.2.1 OF Division C]			
<input type="checkbox"/> House <input type="checkbox"/> Small Buildings <input type="checkbox"/> Large Buildings <input type="checkbox"/> Complex Buildings <input checked="" type="checkbox"/> HVAC – House <input type="checkbox"/> Building Services <input type="checkbox"/> Detection, Lighting and Power <input type="checkbox"/> Fire Protection <input type="checkbox"/> Building Structural <input type="checkbox"/> Plumbing – House <input type="checkbox"/> Plumbing – All Buildings <input type="checkbox"/> On-site Sewage Systems			
Description of designer's work HEAT LOSS / GAIN CALCULATIONS DUCT SIZING RESIDENTIAL MECHANICAL VENTILATION DESIGN SUMMARY RESIDENTIAL SYSTEM DESIGN per CSA-F280-12		Model: 38-14 Coventry OPT 2ND Project: CENTREFIELD (WEST GORMLEY)	
D. Declaration of Designer			
I, MICHAEL O'ROURKE (print name) declare that (choose one as appropriate):			
<input type="checkbox"/> I review and take responsibility for the design work on behalf of a firm registered under subsection 3.2.4. of Division C, of the Building Code. I am qualified, and the firm is registered, in the appropriate classes/categories. Individual BCIN: _____ Firm BCIN: _____			
<input checked="" type="checkbox"/> I review and take responsibility for the design and am qualified in the appropriate category as an "other designer" under subsection 3.2.5. of Division C, of the Building Code. Individual BCIN: <u>19669</u> Basis for exemption from registration and qualification: <u>O.B.C SENTENCE 3.2.4.1 (4)</u>			
<input type="checkbox"/> The design work is exempt from the registration and qualification requirements of the Building Code. Basis for exemption from registration and qualification: _____			
I certify that:			
1. The information contained in this schedule is true to the best of my knowledge. 2. I have submitted this application with the knowledge and consent of the firm.			
June 21, 2021		 Signature of Designer	
Date			

NOTE:

- For the purposes of this form, "individual" means the "person" referred to in Clause 3.2.4.7(1) d) of Division C, Article 3.2.5.1. of Division C, and all other persons who are exempt from qualification under Subsections 3.2.4. and 3.2.5. of Division C.
- Schedule 1 is not required to be completed by a holder of a license, temporary license, or a certificate of authorization, issued by the Ontario Association of Architects. Schedule 1 is also not required to be completed by a holder of a license to practise, a limited license to practise, or a certificate of authorization, issued by the Association of Professional Engineers of Ontario.

Application for a Permit Construct or Demolish – Effective January 1, 2015

SITE NAME: CENTREFIELD (WEST GORMLEY)										OPT 2ND					DATE: Jun-21					WINTER NATURAL AIR CHANGE RATE 0.227					HEAT LOSS ΔT °F. 78					CSA-F280-12	
BUILDER: ROYAL PINE HOMES										TYPE: 38-14					GFA: 2724					LO# 91285					SUMMER NATURAL AIR CHANGE RATE 0.071					HEAT GAIN ΔT °F. 13					SB-12 PERFORMANCE	
ROOM USE					MBR						ENS						WIC						BED-2						BED-3						BED-4									ENS-3						ENS-4						ENS-2	
EXP. WALL					37						22						6						33						29						11									6						6						5	
CLG. HT.					9						9						9						9						9						9									9						9	
FACTORS	
GRS.WALL AREA		LOSS GAIN			333						198						54						297						261						99						54						54						45	
GLAZING					LOSS GAIN						LOSS GAIN						LOSS GAIN						LOSS GAIN						LOSS GAIN						LOSS GAIN						LOSS GAIN						LOSS GAIN	
NORTH		21.8	16.0	0	0	0	8	174	128	0	0	SITE NAME: CENTREFIELD (WEST GORMLEY)
BUILDER: ROYAL PINE HOMES

OPT 2ND
TYPE: 38-14

DATE: Jun-21

GFA: 2724 LO# 91285

HEATING CFM 1115 COOLING CFM 1115
TOTAL HEAT LOSS 45,708 TOTAL HEAT GAIN 35,469
AIR FLOW RATE CFM 24.39 AIR FLOW RATE CFM 31.44

furnace pressure 0.6
furnace filter 0.05
a/c coil pressure 0.2
available pressure
for s/a & r/a 0.35

**CARRIER
59TN6B-060-14V
FAN SPEED 60

AFUE = 97 %
INPUT (BTU/H) = 60,000
OUTPUT (BTU/H) = 58,000

RUN COUNT	4th	3rd	2nd	1st	Bas
S/A	0	0	13	7	4
R/A	0	0	5	1	1

plenium pressure s/a 0.18
max s/a dif press. loss 0.02
min adjusted pressure s/a 0.16
r/a pressure 0.17
r/a grille press. Loss 0.02
adjusted pressure r/a 0.15

LOW 930
MEDLOW 1050
MEDIUM 1115
MEDIUM HIGH 1245
HIGH 1520

DESIGN CFM = 1115
CFM @ .6" E.S.P.

TEMPERATURE RISE 48 °F

All S/A diffusers 4"x10" unless noted otherwise on layout.

All S/A runs 5"Ø unless noted otherwise on layout.

RUN #	1	2	3	4	5	6	7	8	9	10	11	12	13	14	15	16	17	18	19	20	21	22	23	24
ROOM NAME	MBR	ENS	WIC	BED-2	BED-3	BED-4	ENS-4	BED-2	BED-3	MBR	ENS-3	GRT	GRT	KIT	KIT	ENS-2	DEN	PWD	FOY	MUD	BAS	BAS	BAS	BAS
RM LOSS MBH.	1.46	1.71	0.42	1.50	1.93	1.82	0.54	1.50	1.93	1.46	0.54	2.41	2.41	2.29	2.29	0.95	1.58	0.88	2.94	1.00	3.53	3.53	3.53	3.53
CFM PER RUN HEAT	36	42	10	37	47	44	13	37	47	36	13	59	59	56	56	23	39	22	72	25	86	86	86	86
RM GAIN MBH.	2.11	1.51	0.13	2.41	2.54	2.34	0.39	2.41	2.54	2.11	0.39	2.41	2.41	2.67	2.67	1.25	2.23	0.41	0.50	0.17	0.47	0.47	0.47	0.47
CFM PER RUN COOLING	66	47	4	76	80	73	12	76	80	66	12	76	76	84	84	39	70	13	16	5	15	15	15	15
ADJUSTED PRESSURE	0.17	0.17	0.17	0.17	0.17	0.17	0.17	0.17	0.17	0.17	0.17	0.17	0.17	0.17	0.16	0.16	0.17	0.17	0.17	0.17	0.16	0.16	0.16	0.16
ACTUAL DUCT LGH.	37	51	39	69	66	51	26	71	72	46	52	30	39	38	28	58	30	47	55	9	34	25	19	43
EQUIVALENT LENGTH	150	190	130	190	160	170	190	180	170	180	150	160	170	160	130	140	150	150	140	110	170	180	160	160
TOTAL EFFECTIVE LENGTH	187	241	169	259	226	221	216	251	242	226	202	190	209	198	158	198	180	197	195	119	204	205	179	203
ADJUSTED PRESSURE	0.09	0.07	0.1	0.07	0.08	0.08	0.08	0.07	0.07	0.08	0.09	0.09	0.08	0.08	0.1	0.09	0.1	0.09	0.09	0.14	0.08	0.08	0.09	0.08
ROUND DUCT SIZE	5	5	4	6	6	6	4	6	6	5	4	6	6	6	6	4	5	4	5	4	6	6	6	6
HEATING VELOCITY (ft/min)	264	308	115	189	240	224	149	189	240	264	149	301	301	286	286	264	286	252	529	287	438	438	438	438
COOLING VELOCITY (ft/min)	485	345	46	388	408	372	138	388	408	485	138	388	388	428	428	447	514	149	117	57	76	76	76	76
OUTLET GRILL SIZE	3X10	3X10	3X10	4X10	4X10	4X10	3X10	4X10	4X10	3X10	3X10	4X10	4X10	4X10	4X10	3X10	3X10	3X10	3X10	3X10	4X10	4X10	4X10	4X10
TRUNK	A	A	D	B	C	C	D	B	C	A	C	A	A	A	A	C	D	B	B	D	A	A	C	B

RUN #	
ROOM NAME	
RM LOSS MBH.	
CFM PER RUN HEAT	
RM GAIN MBH.	
CFM PER RUN COOLING	
ADJUSTED PRESSURE	
ACTUAL DUCT LGH.	
EQUIVALENT LENGTH	
TOTAL EFFECTIVE LENGTH	
ADJUSTED PRESSURE	
ROUND DUCT SIZE	
HEATING VELOCITY (ft/min)	
COOLING VELOCITY (ft/min)	
OUTLET GRILL SIZE	
TRUNK	

SUPPLY AIR TRUNK SIZE												RETURN AIR TRUNK SIZE											
TRUNK		STATIC	ROUND	RECT	VELOCITY			TRUNK		STATIC	ROUND	RECT	VELOCITY			TRUNK		STATIC	ROUND	RECT	VELOCITY		
	CFM	PRESS.	DUCT	DUCT			(ft/min)		CFM	PRESS.	DUCT	DUCT			(ft/min)		CFM	PRESS.	DUCT	DUCT			(ft/min)
TRUNK A	516	0.07	11.3	14	x	8	663	TRUNK G	0	0.00	0	0	x	8	0	TRUNK O	0	0.05	0	0	x	8	0
TRUNK B	254	0.07	8.7	10	x	8	457	TRUNK H	0	0.00	0	0	x	8	0	TRUNK P	0	0.05	0	0	x	8	0
TRUNK C	514	0.07	11.3	14	x	8	661	TRUNK I	0	0.00	0	0	x	8	0	TRUNK Q	0	0.05	0	0	x	8	0
TRUNK D	1117	0.07	15.1	26	x	8	773	TRUNK J	0	0.00	0	0	x	8	0	TRUNK R	0	0.05	0	0	x	8	0
TRUNK E	0	0.00	0	0	x	8	0	TRUNK K	0	0.00	0	0	x	8	0	TRUNK S	0	0.05	0	0	x	8	0
TRUNK F	0	0.00	0	0	x	8	0	TRUNK L	0	0.00	0	0	x	8	0	TRUNK T	0	0.05	0	0	x	8	0

RETURN AIR #	1	2	3	4	5	6	7	8	9	10	11	12	13	14	15	16	17	18	19	20	21	22	23	24
AIR VOLUME	145	115	115	115	105	360	0	0	0	0	0	0	0	0	0	0	0	0	0	0	0	0	0	0
PLENUM PRESSURE	0.15	0.15	0.15	0.15	0.15	0.15	0.15	0.15	0.15	0.15	0.15	0.15	0.15	0.15	0.15	0.15	0.15	0.15	0.15	0.15	0.15	0.15	0.15	0.15
ACTUAL DUCT LGH.	34	62	71	65	30	25	1	1	1	1	1	1	1	1	1	1	1	1	1	1	1	1	1	1
EQUIVALENT LENGTH	175	250	245	205	155	175	0	0	0	0	0	0	0	0	0	0	0	0	0	0	0	0	0	0
TOTAL EFFECTIVE LH	209	312	316	270	185	200	1	1	1	1	1	1	1	1	1	1	1	1	1	1	1	1	1	1
ADJUSTED PRESSURE	0.07	0.05	0.05	0.05	0.08	0.07	14.80	14.80	14.80	14.80	14.80	14.80	14.80	14.80	14.80	14.80	14.80	14.80	14.80	14.80	14.80	14.80	14.80	14.80
ROUND DUCT SIZE	7	7	7	7	6	9.9	0	0	0	0	0	0	0	0	0	0	0	0	0	0	0	0	0	0
INLET GRILL SIZE	8	8	8	8	8	8	0	0	0	0	0	0	0	0	0	0	0	0	0	0	0	0	0	0
	X	X	X	X	X	X	X	X	X	X	X	X	X	X	X	X	X	X	X	X	X	X	X	X
INLET GRILL SIZE	14	14	14	14	14	30	0	0	0	0	0	0	0	0	0	0	0	0	0	0	0	0	0	0

TYPE: 38-14
SITE NAME: CENTREFIELD (WEST GORMLEY)

LO # 91285
OPT 2ND

RESIDENTIAL MECHANICAL VENTILATION DESIGN SUMMARY

COMBUSTION APPLIANCES		9.32.3.1(1)
a)	<input checked="" type="checkbox"/> Direct vent (sealed combustion) only	
b)	<input type="checkbox"/> Positive venting induced draft (except fireplaces)	
c)	<input type="checkbox"/> Natural draft, B-vent or induced draft gas fireplace	
d)	<input type="checkbox"/> Solid Fuel (including fireplaces)	
e)	<input type="checkbox"/> No Combustion Appliances	

HEATING SYSTEM	
<input checked="" type="checkbox"/> Forced Air	<input type="checkbox"/> Non Forced Air
<input type="checkbox"/> Electric Space Heat	

HOUSE TYPE		9.32.1(2)
<input checked="" type="checkbox"/> I	Type a) or b) appliance only, no solid fuel	
<input type="checkbox"/> II	Type I except with solid fuel (including fireplaces)	
<input type="checkbox"/> III	Any Type c) appliance	
<input type="checkbox"/> IV	Type I, or II with electric space heat	
<input type="checkbox"/> Other:	Type I, II or IV no forced air	

SYSTEM DESIGN OPTIONS		O.N.H.W.P.
<input type="checkbox"/> 1	Exhaust only/Forced Air System	
<input type="checkbox"/> 2	HRV with Ducting/Forced Air System	
<input checked="" type="checkbox"/> 3	HRV Simplified/connected to forced air system	
<input type="checkbox"/> 4	HRV with Ducting/non forced air system	
<input type="checkbox"/>	Part 6 Design	

TOTAL VENTILATION CAPACITY		9.32.3.3(1)
Basement + Master Bedroom	<u>2</u> @ 21.2 cfm	<u>42.4</u> cfm
Other Bedrooms	<u>3</u> @ 10.6 cfm	<u>31.8</u> cfm
Kitchen & Bathrooms	<u>6</u> @ 10.6 cfm	<u>63.6</u> cfm
Other Rooms	<u>3</u> @ 10.6 cfm	<u>31.8</u> cfm
Table 9.32.3.A.	TOTAL	<u>169.6</u> cfm

PRINCIPAL VENTILATION CAPACITY REQUIRED		9.32.3.4.(1)
1 Bedroom	31.8	cfm
2 Bedroom	47.7	cfm
3 Bedroom	63.6	cfm
4 Bedroom	79.5	cfm
5 Bedroom	95.4	cfm
TOTAL		<u>79.5</u> cfm

SUPPLEMENTAL VENTILATION CAPACITY		9.32.3.5.
Total Ventilation Capacity	<u>169.6</u>	cfm
Less Principal Ventil. Capacity	<u>79.5</u>	cfm
Required Supplemental Capacity	<u>90.1</u>	cfm

PRINCIPAL EXHAUST FAN CAPACITY	
Model:	VANEE 65H
Location:	BSMT
<u>79.5</u> cfm	<input checked="" type="checkbox"/> HVI Approved

PRINCIPAL EXHAUST HEAT LOSS CALCULATION			
CFM	ΔT °F	FACTOR	% LOSS
79.5 CFM	X 78 F	X 1.08	X 0.25

SUPPLEMENTAL FANS		BY INSTALLING CONTRACTOR	
Location	Model	cfm	HVI
ENS	BY INSTALLING CONTRACTOR	50	<input checked="" type="checkbox"/>
ENS-2	BY INSTALLING CONTRACTOR	50	<input checked="" type="checkbox"/>
PWD	BY INSTALLING CONTRACTOR	50	<input checked="" type="checkbox"/>

HEAT RECOVERY VENTILATOR		9.32.3.11.
Model:	VANEE 65H	
<u>155</u> cfm high	<u>64</u> cfm low	
<u>75</u> % Sensible Efficiency @ 32 deg F (0 deg C)	<input checked="" type="checkbox"/> HVI Approved	


LOCATION OF INSTALLATION	
Lot:	Concession
Township	Plan:
Address	
Roll #	Building Permit #

BUILDER:	
ROYAL PINE HOMES	
Name:	
Address:	
City:	
Telephone #:	Fax #:

INSTALLING CONTRACTOR	
Name:	
Address:	
City:	
Telephone #:	Fax #:

DESIGNER CERTIFICATION	
I hereby certify that this ventilation system has been designed in accordance with the Ontario Building Code.	
Name:	HVAC Designs Ltd.
Signature:	<i>Michael O'Rourke</i>
HRAI #	01420
Date:	

I REVIEW AND TAKE RESPONSIBILITY FOR THE DESIGN WORK AND AM QUALIFIED IN THE APPROPRIATE CATEGORY AS AN "OTHER DESIGNER" UNDER DIVISION C.2.2.5 OF THE BUILDING CODE.
INDIVIDUAL BCIN: 19669 MICHAEL O'ROURKE

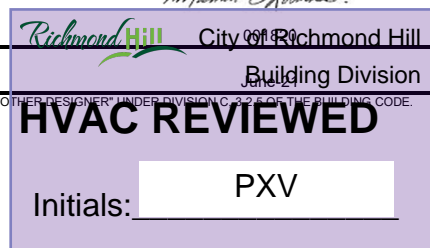Michael O'Rourke


CSA F280-12 Residential Heat Loss and Heat Gain Calculations	
Formula Sheet (For Air Leakage / Ventilation Calculation)	
LO#: 91285	Model: 38-14	Builder: ROYAL PINE HOMES	Date: 2021-06-21	
Volume Calculation			Air Change & Delta T Data	
House Volume <table border="1" style="width: 100%; border-collapse: collapse;"> <thead> <tr> <th>Level</th> <th>Floor Area (ft²)</th> <th>Floor Height (ft)</th> <th>Volume (ft³)</th> </tr> </thead> <tbody> <tr> <td>Bsmt</td> <td>1098</td> <td>10</td> <td>10980</td> </tr> <tr> <td>First</td> <td>1098</td> <td>10</td> <td>11089.8</td> </tr> <tr> <td>Second</td> <td>1626</td> <td>9</td> <td>14634</td> </tr> <tr> <td>Third</td> <td>0</td> <td>9</td> <td>0</td> </tr> <tr> <td>Fourth</td> <td>0</td> <td>9</td> <td>0</td> </tr> <tr> <td colspan="3" style="text-align: right;">Total:</td> <td>36,703.8 ft³</td> </tr> <tr> <td colspan="3" style="text-align: right;">Total:</td> <td>1039.3 m³</td> </tr> </tbody> </table>			Level	Floor Area (ft²)	Floor Height (ft)	Volume (ft³)	Bsmt	1098	10	10980	First	1098	10	11089.8	Second	1626	9	14634	Third	0	9	0	Fourth	0	9	0	Total:			36,703.8 ft³	Total:			1039.3 m³	<table border="1" style="width: 100%; border-collapse: collapse;"> <tr> <td style="width: 80%;">WINTER NATURAL AIR CHANGE RATE</td> <td style="width: 20%;">0.227</td> </tr> <tr> <td>SUMMER NATURAL AIR CHANGE RATE</td> <td>0.071</td> </tr> </table> <table border="1" style="width: 100%; border-collapse: collapse;"> <tr> <th colspan="5" style="text-align: center;">Design Temperature Difference</th> </tr> <tr> <th></th> <th>Tin °C</th> <th>Tout °C</th> <th>ΔT °C</th> <th>ΔT °F</th> </tr> <tr> <td>Winter DTDh</td> <td>22</td> <td>-21</td> <td>43</td> <td>78</td> </tr> <tr> <td>Summer DTDc</td> <td>24</td> <td>31</td> <td>7</td> <td>13</td> </tr> </table>		WINTER NATURAL AIR CHANGE RATE	0.227	SUMMER NATURAL AIR CHANGE RATE	0.071	Design Temperature Difference						Tin °C	Tout °C	ΔT °C	ΔT °F	Winter DTDh	22	-21	43	78	Summer DTDc	24	31	7	13
Level	Floor Area (ft²)	Floor Height (ft)	Volume (ft³)	
Bsmt	1098	10	10980	
First	1098	10	11089.8	
Second	1626	9	14634	
Third	0	9	0	
Fourth	0	9	0	
Total:			36,703.8 ft³	
Total:			1039.3 m³	
WINTER NATURAL AIR CHANGE RATE	0.227	
SUMMER NATURAL AIR CHANGE RATE	0.071	
Design Temperature Difference	
	Tin °C	Tout °C	ΔT °C	ΔT °F	
Winter DTDh	22	-21	43	78	
Summer DTDc	24	31	7	13	
5.2.3.1 Heat Loss due to Air Leakage			6.2.6 Sensible Gain due to Air Leakage	
$HL_{airb} = LR_{airh} \times \frac{V_b}{3.6} \times DTD_h \times 1.2$ <p>0.227 x 288.70 x 43 °C x 1.2 = 3392 W</p> <p>= 11574 Btu/h</p>			$HG_{salb} = LR_{airc} \times \frac{V_b}{3.6} \times DTD_c \times 1.2$ <p>= 0.071 x 288.70 x 7 °C x 1.2 = 174 W</p> <p>= 594 Btu/h</p>	
5.2.3.2 Heat Loss due to Mechanical Ventilation			6.2.7 Sensible heat Gain due to Ventilation	
$HL_{vairb} = PVC \times DTD_h \times 1.08 \times (1 - E)$ <p>80 CFM x 78 °F x 1.08 x 0.25 = 1670 Btu/h</p>			$HL_{vairb} = PVC \times DTD_h \times 1.08 \times (1 - E)$ <p>80 CFM x 13 °F x 1.08 x 0.25 = 275 Btu/h</p>	
5.2.3.3 Calculation of Air Change Heat Loss for Each Room (Floor Multiplier Section)	
$HL_{airr} = Level\ Factor \times HL_{airbv} \times \{(HL_{agcr} + HL_{bgcr}) \div (HL_{agclevel} + HL_{bgclevel})\}$ <table border="1" style="width: 100%; border-collapse: collapse;"> <thead> <tr> <th>Level</th> <th>Level Factor (LF)</th> <th>HLairve Air Leakage + Ventilation Heat Loss (Btu/h)</th> <th>Level Conductive Heat Loss: (HL_{clevel})</th> <th>Air Leakage Heat Loss Multiplier (LF x HLairbv / HLlevel)</th> </tr> </thead> <tbody> <tr> <td>1</td> <td>0.5</td> <td rowspan="5" style="text-align: center; vertical-align: middle;">11,574</td> <td>8,342</td> <td>0.694</td> </tr> <tr> <td>2</td> <td>0.3</td> <td>10,749</td> <td>0.323</td> </tr> <tr> <td>3</td> <td>0.2</td> <td>14,438</td> <td>0.160</td> </tr> <tr> <td>4</td> <td>0</td> <td>0</td> <td>0.000</td> </tr> <tr> <td>5</td> <td>0</td> <td>0</td> <td>0.000</td> </tr> </tbody> </table> <p>*HLairbv = Air leakage heat loss + ventilation heat loss *For a balanced or supply only ventilation system HLairve = 0</p>					Level	Level Factor (LF)	HLairve Air Leakage + Ventilation Heat Loss (Btu/h)	Level Conductive Heat Loss: (HL _{clevel})	Air Leakage Heat Loss Multiplier (LF x HLairbv / HLlevel)	1	0.5	11,574	8,342	0.694	2	0.3	10,749	0.323	3	0.2	14,438	0.160	4	0	0	0.000	5	0	0	0.000																														
Level	Level Factor (LF)	HLairve Air Leakage + Ventilation Heat Loss (Btu/h)	Level Conductive Heat Loss: (HL _{clevel})	Air Leakage Heat Loss Multiplier (LF x HLairbv / HLlevel)	
1	0.5	11,574	8,342	0.694	
2	0.3		10,749	0.323	
3	0.2		14,438	0.160	
4	0		0	0.000	
5	0		0	0.000	

HEAT LOSS AND GAIN SUMMARY SHEET

MODEL: 38-14	OPT 2ND	BUILDER: ROYAL PINE HOMES
SFQT: 2724	LO# 91285	SITE: CENTREFIELD (WEST GORMLEY)

DESIGN ASSUMPTIONS

HEATING	°F	COOLING	°F
OUTDOOR DESIGN TEMP.	-6	OUTDOOR DESIGN TEMP.	88
INDOOR DESIGN TEMP.	72	INDOOR DESIGN TEMP. (MAX 75°F)	75

BUILDING DATA

ATTACHMENT:	DETACHED	# OF STORIES (+BASEMENT):	3
FRONT FACES:	EAST	ASSUMED (Y/N):	Y
AIR CHANGES PER HOUR:	2.50	ASSUMED (Y/N):	Y
AIR TIGHTNESS CATEGORY:	TIGHT	ASSUMED (Y/N):	Y
WIND EXPOSURE:	SHELTERED	ASSUMED (Y/N):	Y
HOUSE VOLUME (ft ³):	36703.8	ASSUMED (Y/N):	Y
INTERNAL SHADING:	BLINDS/CURTAINS	ASSUMED OCCUPANTS:	5
INTERIOR LIGHTING LOAD (Btu/h/ft ²):	1.45	DC BRUSHLESS MOTOR (Y/N):	Y
FOUNDATION CONFIGURATION	BCIN_1	DEPTH BELOW GRADE:	7.0 ft
LENGTH: 53.0 ft	WIDTH: 31.0 ft	EXPOSED PERIMETER:	168.0 ft


2012 OBC - COMPLIANCE PACKAGE		Compliance Package	
Component		SB-12 PERFORMANCE	
		Nominal	Min. Eff.
Ceiling with Attic Space Minimum RSI (R)-Value		60	59.20
Ceiling Without Attic Space Minimum RSI (R)-Value		31	27.70
Exposed Floor Minimum RSI (R)-Value		31	29.80
Walls Above Grade Minimum RSI (R)-Value		22+1.5	18.50
Basement Walls Minimum RSI (R)-Value		20	21.12
Below Grade Slab Entire surface > 600 mm below grade Minimum RSI (R)-Value		-	-
Edge of Below Grade Slab ≤ 600 mm Below Grade Minimum RSI (R)-Value		10	10
Heated Slab or Slab ≤ 600 mm below grade Minimum RSI (R)-Value		10	11.13
Windows and Sliding Glass Doors Maximum U-Value		1.6	-
Skylights Maximum U-Value		2.6	-
Space Heating Equipment Minimum AFUE		0.96	-
HRV Minimum Efficiency		75%	-
Domestic Hot Water Heater Minimum EF		TE=94%	-

INDIVIDUAL BCIN: 19669
MICHAEL O'ROURKE



Residential Foundation Thermal Load Calculator

Supplemental tool for CAN/CSA-F280

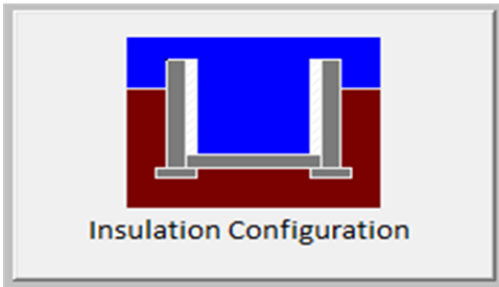Weather Station Description		
Province:	Ontario	
Region:	Richmond Hill	
Site Description		
Soil Conductivity:	Normal conductivity: dry sand, loam, clay	
Water Table:	Normal (7-10 m, 23-33 ft)	
Foundation Dimensions		
Floor Length (m):	16.2	 Insulation Configuration
Floor Width (m):	9.4	
Exposed Perimeter (m):	0.0	
Wall Height (m):	3.0	
Depth Below Grade (m):	2.13	
Window Area (m ²):	1.1	
Door Area (m ²):	1.9	
Radiant Slab		
Heated Fraction of the Slab:	0	
Fluid Temperature (°C):	33	
Design Months		
Heating Month	1	
Foundation Loads		
Heating Load (Watts):		1672

TYPE: 38-14
LO# 91285

OPT 2ND

Air Infiltration Residential Load Calculator

Supplemental tool for CAN/CSA-F280

Weather Station Description			
Province:	Ontario		
Region:	Richmond Hill		
Weather Station Location:	Open flat terrain, grass		
Anemometer height (m):	10		
Local Shielding			
Building Site:	Suburban, forest		
Walls:	Heavy		
Flue:	Heavy		
Highest Ceiling Height (m):	6.74		
Building Configuration			
Type:	Detached		
Number of Stories:	Two		
Foundation:	Full		
House Volume (m ³):	1039.3		
Air Leakage/Ventilation			
Air Tightness Type:	Energy Star Detached (2.5 ACH)		
Custom BDT Data:	ELA @ 10 Pa. 2.50	970.2 cm ² ACH @ 50 Pa	
Mechanical Ventilation (L/s):	Total Supply 37.5	Total Exhaust 37.5	
Flue Size			
Flue #:	#1	#2	#3 #4
Diameter (mm):	0	0	0 0
Natural Infiltration Rates			
Heating Air Leakage Rate (ACH/H):		0.227	
Cooling Air Leakage Rate (ACH/H):		0.071	

TYPE: 38-14
LO# 91285

DEPRESSURIZATION TEST REQUIRED
BEFORE FINAL OCCUPANCY STAGE TO MEET
TARGETTED ACH
2.5 ach



City of Richmond Hill
Building Division

REVIEWED


By: PxV Date: FEB/02/2022

Building Permit #: BP#-2021-51402

All construction shall comply with the Ontario Building Code and all other applicable statutory regulations. The reviewed documents must be kept on site at all times.

Building inspection line: 905-771-5465 (24 hr)
buildinginspections@richmondhill.ca
Building inquiry line 905-771-8810
building@richmondhill.ca

Ensure that R-Values and U-Values used for heat loss and heat gain calculations are consistent with the values specified by SB-12 Performance Compliance: BETTER THAN CODE/AIR TIGHTNESS TEST and the values used for architectural design.

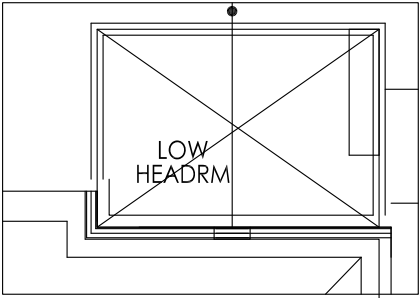

BASEMENT FLOOR PLAN
ELEV 'A','B',&,'C' w/
LAUNDRY FOR PARTIAL
GROUND FLOOR

Penetration of Air Barrier System by ducts, wires, conduits or building materials shall be sealed as per OBC 2012, Div.B 9.25.3.3.(9) & (10).

Volume control dampers to all branches to be installed per OBC 2012, Div.B, 6.2.4.5.

Space between studs and joists used as return ducts shall be separated from unused portion as per OBC 2012 Div.B 6.2.4.7(6)

Combustion air supply shall be provided to the furnace and hot water tank.


HRV installation, testing, startup and commissioning shall be in compliance with OBC 2012, Div.B 9.32.3.11, 9.32.3.11(7)&(10)

For simplified HRV/ERV installation, with stale air and fresh air connected to return air plenum, stale air intake and fresh air supply shall be separated minimum 3' or as recommended by HRV/ERV Manufacturer.

HRV duct connection shall be in compliance with OBC 2012 Div.B 9.32.3.6(3) & 9.32.3.4(7).

Supply air grill at finished basement shall be at low level. Return air grill for finished or unfinished basement shall be at low level. HRAI digest 2005, clause 7.7(3).

DEPRESSURIZATION TEST REQUIRED
BEFORE FINAL OCCUPANCY STAGE TO MEET
TARGETTED ACH
2.5 ACH

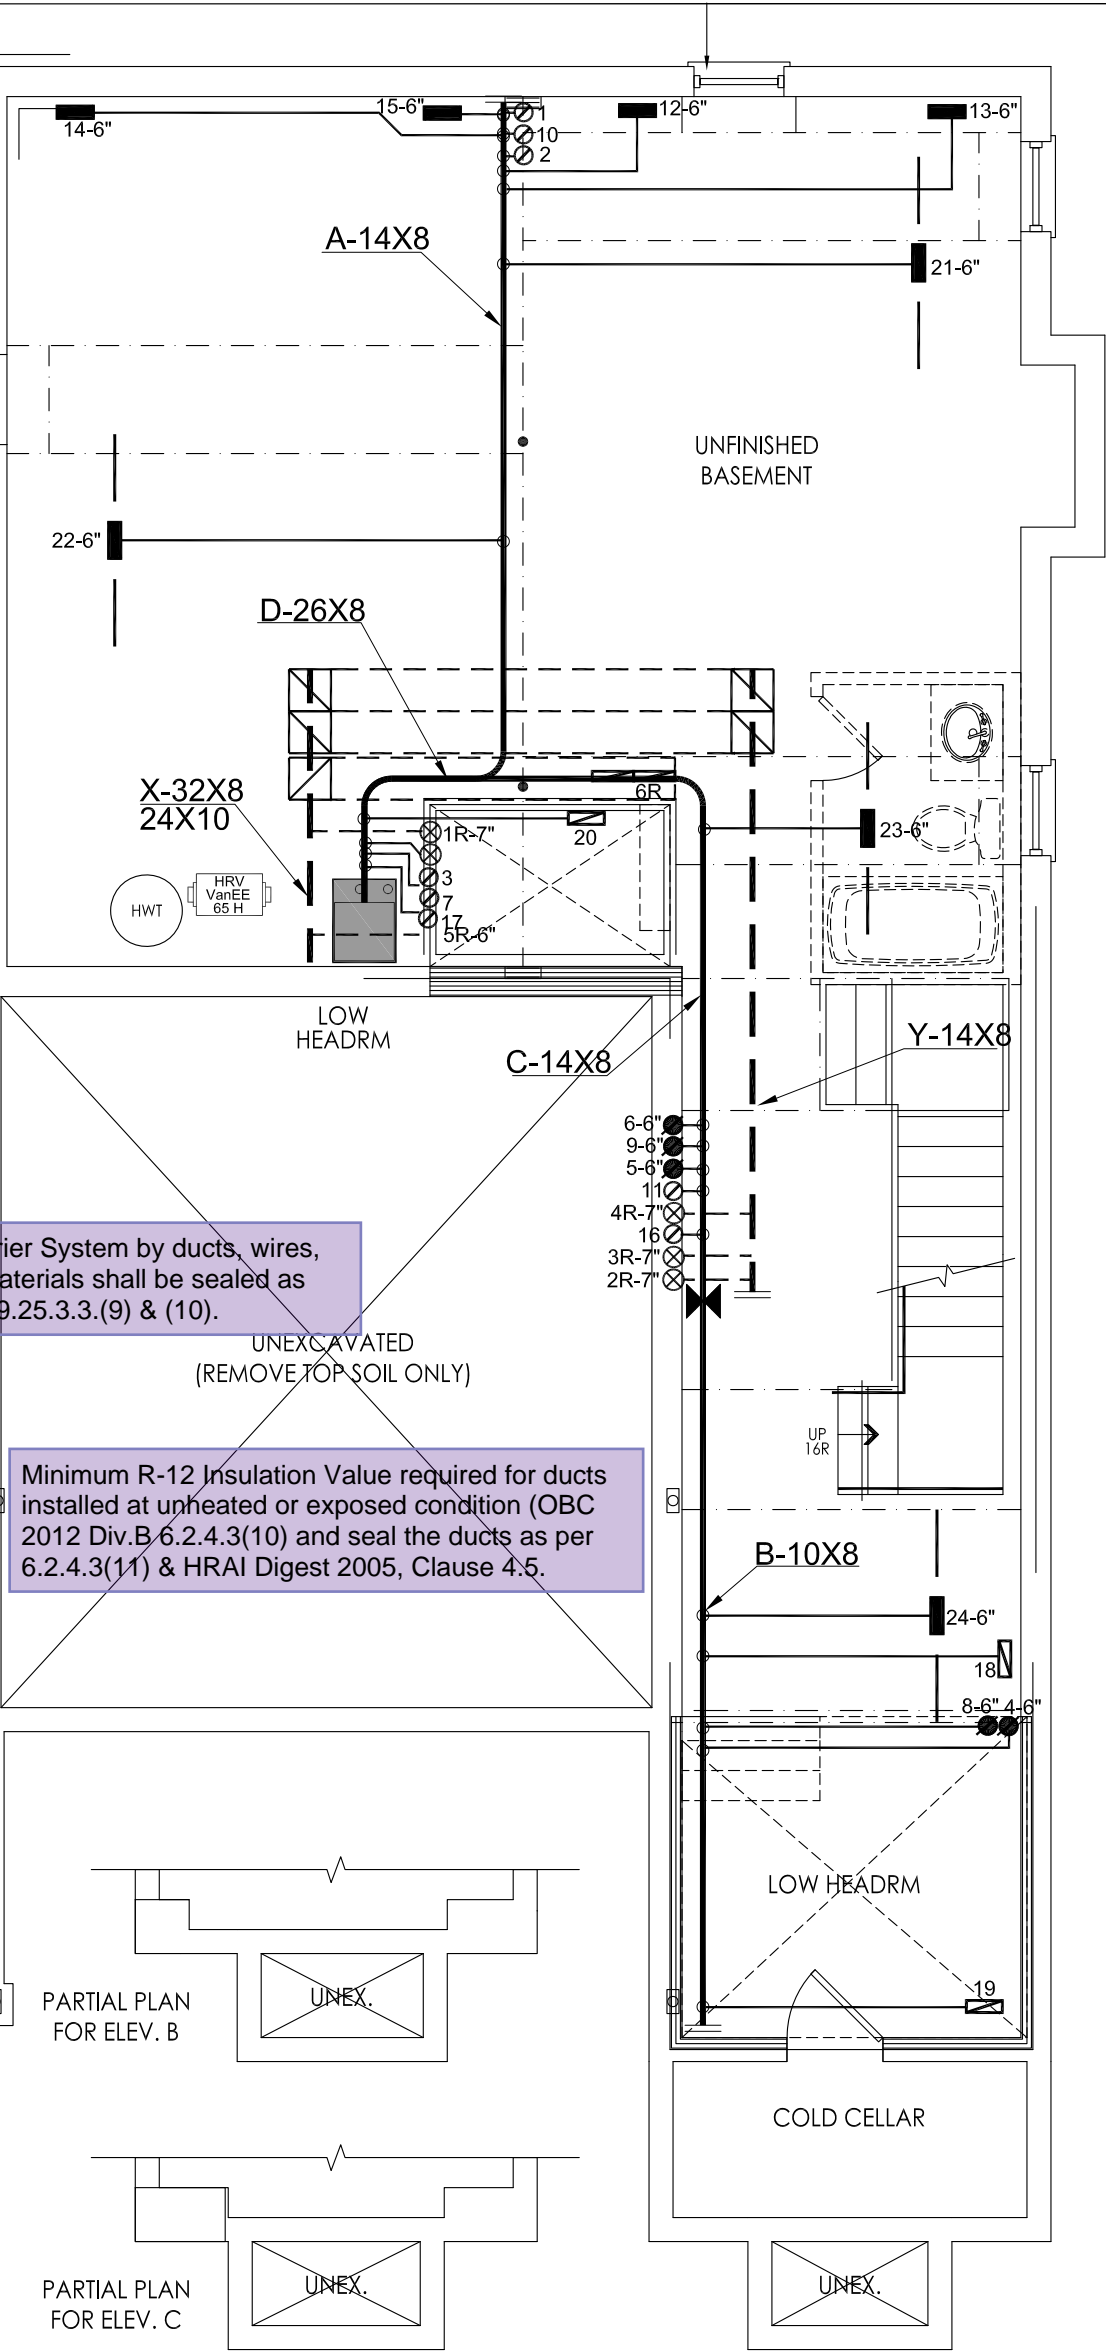

PARTIAL PLAN
FOR ELEV. B

PARTIAL PLAN
FOR ELEV. C

BASEMENT FLOOR PLAN ELEV 'A','B',&,'C'

I MICHAEL O'ROURKE HAVE REVIEWED AND TAKE RESPONSIBILITY FOR THE DESIGN WORK AND AM QUALIFIED UNDER DIVISION C, 3.2.5 OF THE BUILDING CODE.

Michael O'Rourke, BCIN# 19669
HVAC DESIGNS LTD.

Exterior insulation effective R-Value for wall, roof or exposed floor shall be maintained at the respective location where duct or sanitary pipes are routed inside exterior envelope.

HVAC LEGEND

SYMBOL	DESCRIPTION	SYMBOL	DESCRIPTION	SYMBOL	DESCRIPTION	SYMBOL	DESCRIPTION
	SUPPLY AIR GRILLE		6" SUPPLY AIR BOOT ABOVE		14"x8" RETURN AIR GRILLE		RETURN AIR STACK ABOVE
	SUPPLY AIR GRILLE 6" BOOT		SUPPLY AIR STACK FROM 2nd FLOOR		30"x8" RETURN AIR GRILLE		RETURN AIR STACK 2nd FLOOR
	SUPPLY AIR BOOT ABOVE		6" SUPPLY AIR STACK 2nd FLOOR		FRA- FLOOR RETURN AIR GRILLE		REDUCER

3.		
2.		
1.		
No.	Description	Date
REVISIONS		

ALL DRAWINGS, CALCULATIONS AND SPECIFICATIONS ARE THE PROPERTY OF HVAC DESIGNS LTD.© AND MAY NOT BE REPRODUCED, MODIFIED OR ALTERED WITHOUT EXPRESSED WRITTEN CONSENT. THE DRAWINGS ARE DATED AND USE OF THESE DRAWINGS AFTER ONE YEAR FROM THE DATED NOTED IS NOT AUTHORIZED. CONTRACTOR SHALL CHECK ALL CONDITIONS BEFORE PROCEEDING WITH WORK. LATEST MUNICIPAL APPROVED DRAWINGS ONLY TO BE USED DURING INSTALLATION OF HEATING SYSTEM. HVAC DESIGNS LTD. IS NOT LIABLE FOR ANY CLAIMS ARISING FROM UNAUTHORIZED USE OF THE DRAWINGS OR FROM ANY CHANGES TO ACCEPTED STANDARDS AND/OR THE ONTARIO BUILDING CODE.

Client
ROYAL PINE HOMES
Project Name
CENTREFIELD (WEST GORMLEY)
RICHMOND HILL, ONTARIO
38-14 - OPT 2ND 2724 sqft




375 Finley Ave. Suite 202 - Ajax, Ontario
L1S 2E2 Tel. 905.619.2300 - 905.420.5300 Fax 905.619.2375
Email: info@hvacdsgns.ca
Web: www.hvacdsgns.ca
Specializing in Residential Mechanical Design Services

Installation to comply with the latest Ontario Building Code. All supply branch outlets shall be equipped with a manual balancing damper. Ductwork which passes through the garage or unheated spaces shall be adequately insulated and be gas-proofed.

HEAT LOSS 47378 BTU/H UNIT DATA		# OF RUNS	S/A	R/A	FANS
MAKE	CARRIER	3RD FLOOR			
MODEL	59TN6B-060-14V	2ND FLOOR	13	5	4
INPUT	60 MBTU/H	1ST FLOOR	7	1	2
OUTPUT	58 MBTU/H	BASEMENT	4	1	0
COOLING	3.0 TONS	ALL S/A DIFFUSERS 4 "x10" UNLESS NOTED OTHERWISE ON LAYOUT. ALL S/A RUNS 5"Ø UNLESS NOTED OTHERWISE ON LAYOUT. UNDERCUT DOORS 1" min. FOR R/A			
FAN SPEED	1115 cfm @ 0.6" w.c.				

Sheet Title	
BASEMENT HEATING LAYOUT	
Date	JUNE/2021
Scale	3/16" = 1'-0"
BCIN# 19669	
LO#	91285

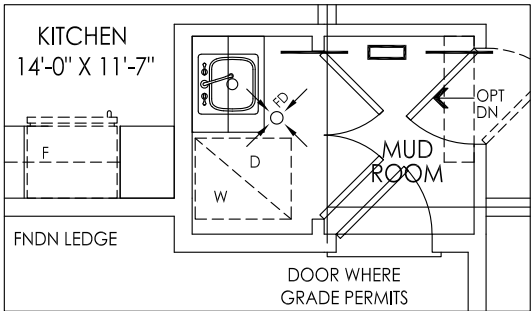

PARTIAL GROUND FLOOR PLAN
ELEV. 'A','B'.'&'C' w/ LAUNDRY

Kitchen hood exhaust duct shall be provided as per OBC 2012, Div.B 9.32.3.10, 9.32.3.5(2).


Laundry dryer exhaust duct shall be provided as per OBC 2012 Div.B 6.2.3.8(7).

Penetration of Air Barrier System by ducts, wires, conduits or building materials shall be sealed as per OBC 2012, Div.B 9.25.3.3.(9) & (10).


Exterior insulation effective R-Value for wall, roof or exposed floor shall be maintained at the respective location where duct or sanitary pipes are routed inside exterior envelope.

Minimum R-12 Insulation Value required for ducts installed at unheated or exposed condition (OBC 2012 Div.B 6.2.4.3(10) and seal the ducts as per 6.2.4.3(11) & HRAI Digest 2005, Clause 4.5.


Space between studs and joists used as return ducts shall be separated from unused portion as per OBC 2012 Div.B 6.2.4.7(6)

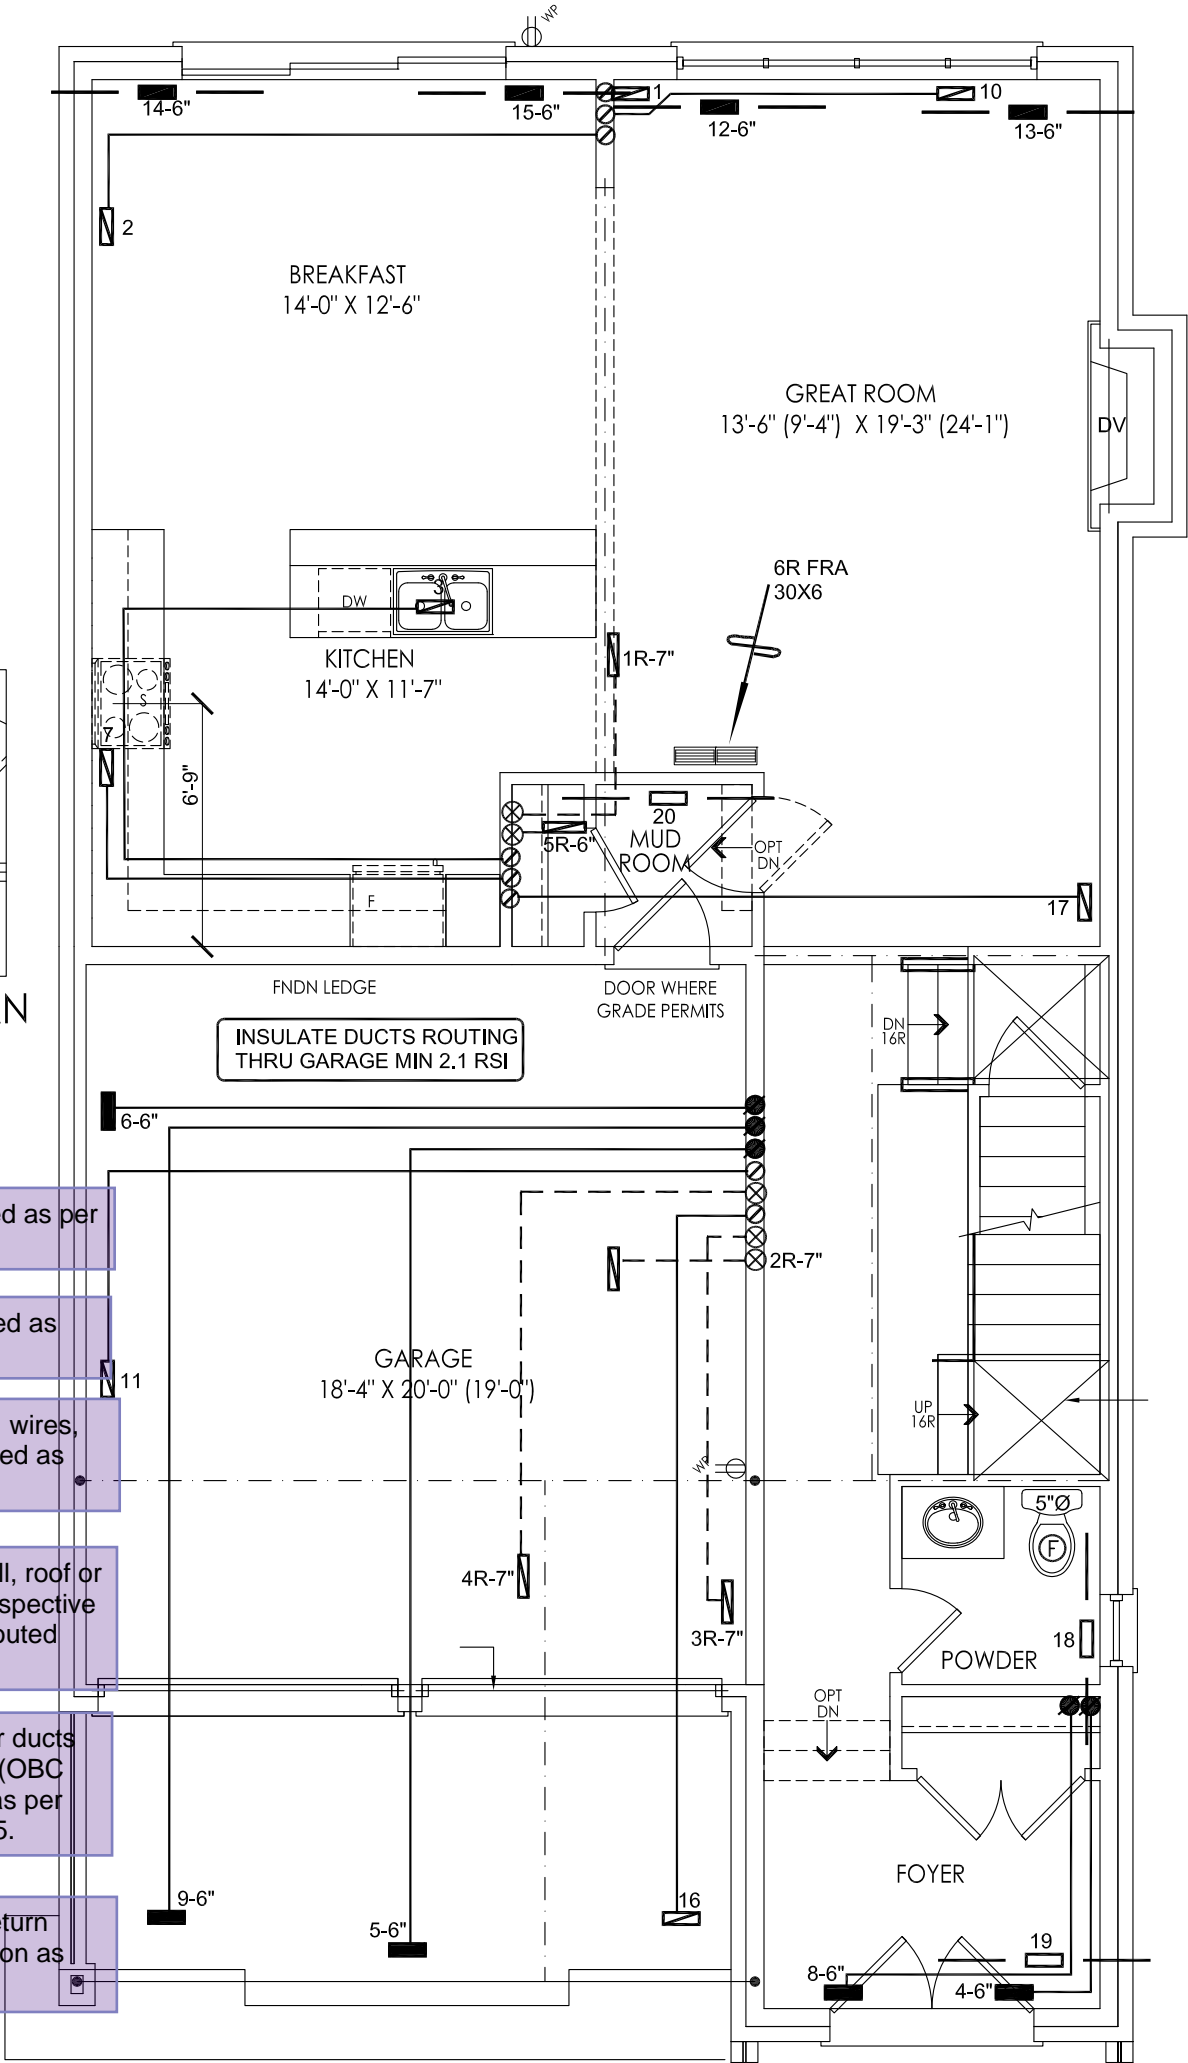

GROUND FLOOR PLAN ELEV 'A'

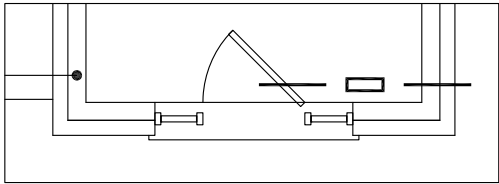

GROUND FLOOR PLAN ELEV 'B'

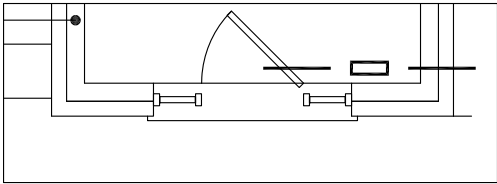

GROUND FLOOR PLAN ELEV 'C'

I MICHAEL O'ROURKE HAVE REVIEWED AND TAKE RESPONSIBILITY FOR THE DESIGN WORK AND AM QUALIFIED UNDER DIVISION C, 3.2.5 OF THE BUILDING CODE.
Michael O'Rourke
Michael O'Rourke, BCIN# 19669
HVAC DESIGNS LTD.

CSA-F280-12

SB-12 PERFORMANCE


HVAC LEGEND								3.		
SYMBOL	DESCRIPTION	SYMBOL	DESCRIPTION	SYMBOL	DESCRIPTION	SYMBOL	DESCRIPTION	2.		
	SUPPLY AIR GRILLE		6" SUPPLY AIR BOOT ABOVE		14"x8" RETURN AIR GRILLE		RETURN AIR STACK ABOVE	1.		
	SUPPLY AIR GRILLE 6" BOOT		SUPPLY AIR STACK FROM 2nd FLOOR		30"x8" RETURN AIR GRILLE		RETURN AIR STACK 2nd FLOOR	No.	Description	Date
	SUPPLY AIR BOOT ABOVE		6" SUPPLY AIR STACK 2nd FLOOR		FRA- FLOOR RETURN AIR GRILLE		REDUCER	REVISIONS		

ALL DRAWINGS, CALCULATIONS AND SPECIFICATIONS ARE THE PROPERTY OF HVAC DESIGNS LTD.© AND MAY NOT BE REPRODUCED, MODIFIED OR ALTERED WITHOUT EXPRESSED WRITTEN CONSENT. THE DRAWINGS ARE DATED AND USE OF THESE DRAWINGS AFTER ONE YEAR FROM THE DATED NOTED IS NOT AUTHORIZED. CONTRACTOR SHALL CHECK ALL CONDITIONS BEFORE PROCEEDING WITH WORK. LATEST MUNICIPAL APPROVED DRAWINGS ONLY TO BE USED DURING INSTALLATION OF HEATING SYSTEM. HVAC DESIGNS LTD. IS NOT LIABLE FOR ANY CLAIMS ARISING FROM UNAUTHORIZED USE OF THE DRAWINGS OR FROM ANY CHANGES TO ACCEPTED STANDARDS AND/OR THE ONTARIO BUILDING CODE.


Client		<div></div> <div>375 Finley Ave. Suite 202 - Ajax, Ontario L1S 2E2 Tel. 905.619.2300 - 905.420.5300 Fax 905.619.2375 Email: info@hvacdesigns.ca Web: www.hvacdesigns.ca Specializing in Residential Mechanical Design Services</div>	Sheet Title	
ROYAL PINE HOMES			FIRST FLOOR HEATING LAYOUT	
Project Name CENTREFIELD (WEST GORMLEY) RICHMOND HILL, ONTARIO			Date	JUNE/2021
38-14 - OPT 2ND 2724 sqft		Scale	3/16" = 1'-0"	
		BCIN# 19669		
		LO#	91285	
		Installation to comply with the latest Ontario Building Code. All supply branch outlets shall be equipped with a manual balancing damper. Ductwork which passes through the garage or unheated spaces shall be adequately insulated and be gas-proofed.		

Space between studs and joists used as return ducts shall be separated from unused portion as per OBC 2012 Div.B 6.2.4.7(6)


Exterior insulation effective R-Value for wall, roof or exposed floor shall be maintained at the respective location where duct or sanitary pipes are routed inside exterior envelope.

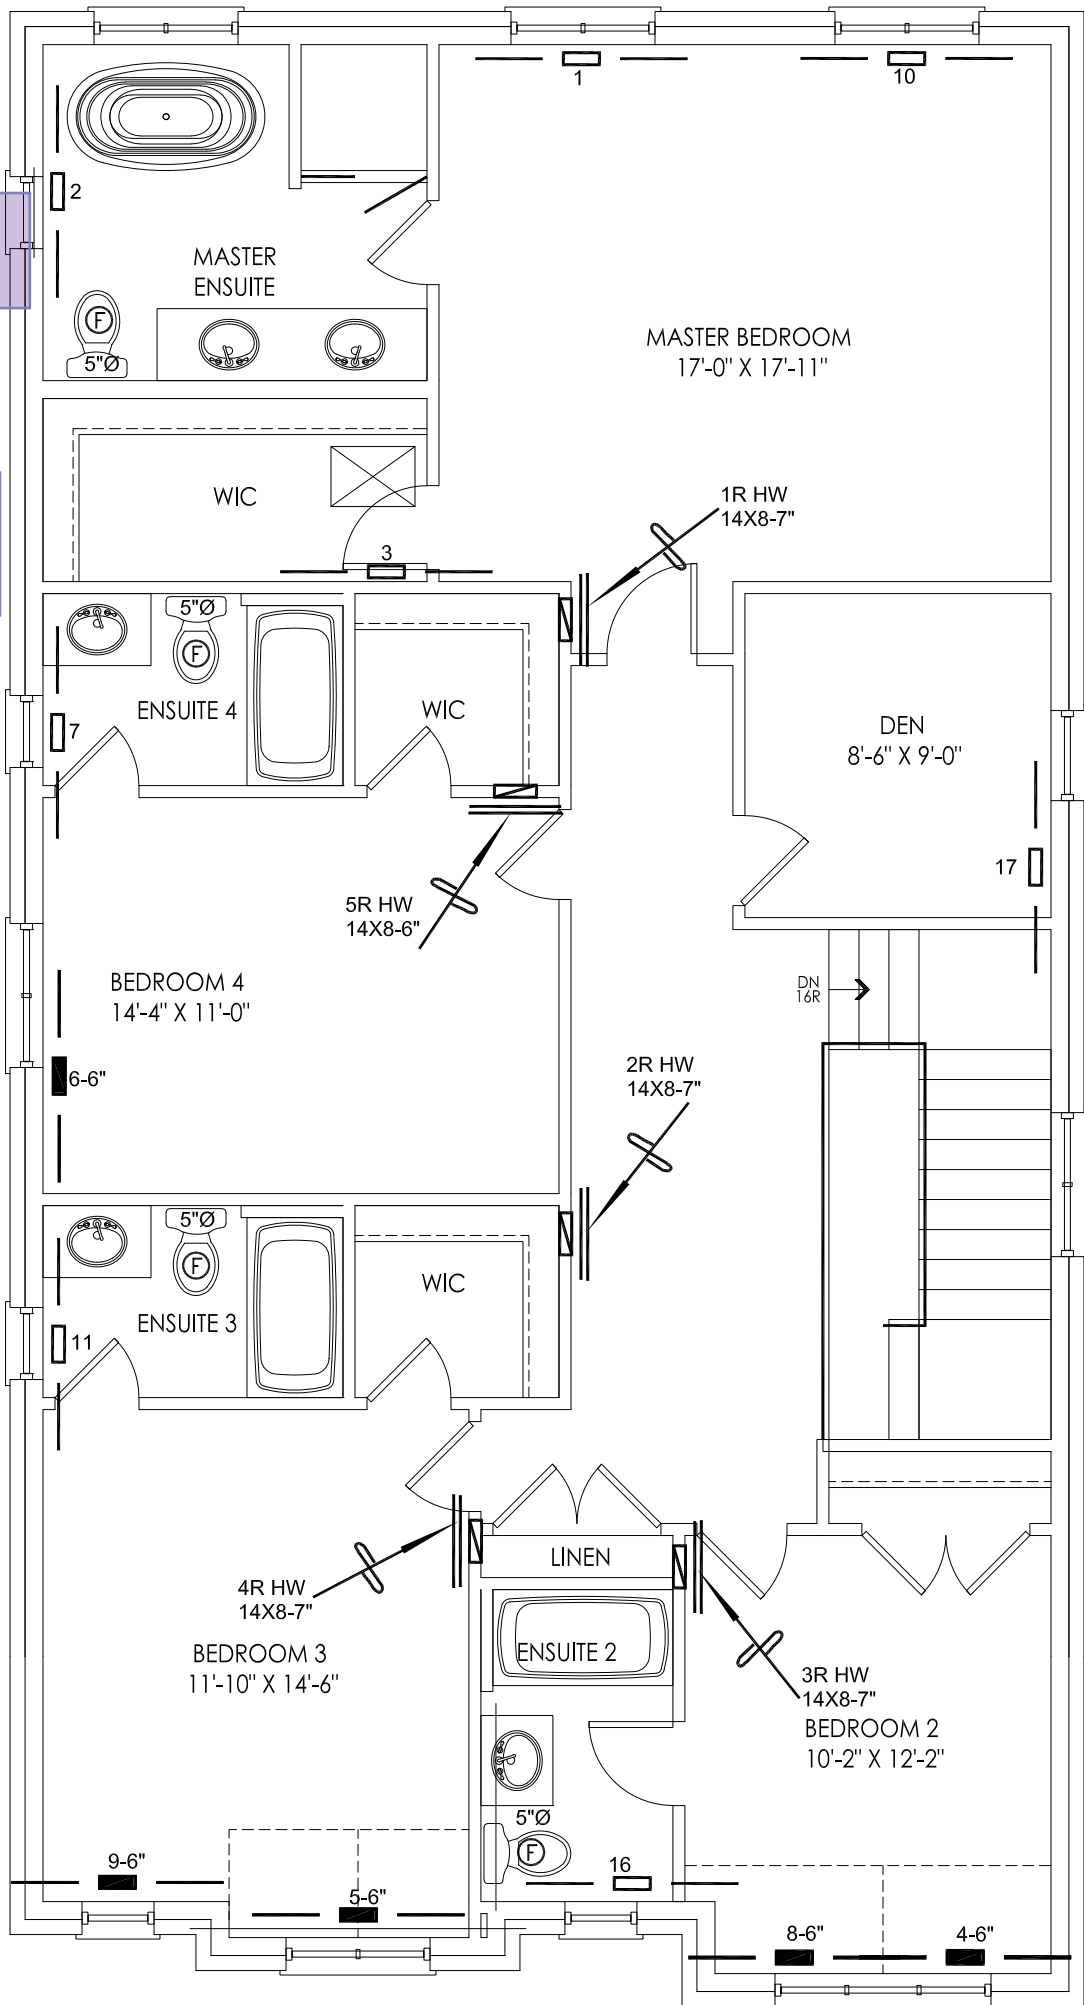

OPT SECOND FLOOR PLAN ELEV 'A'

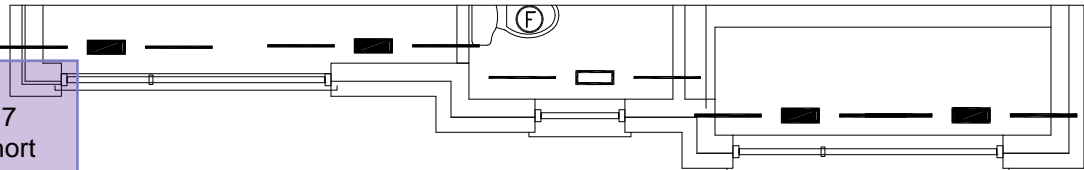

SECOND FLOOR PLAN ELEV 'B'

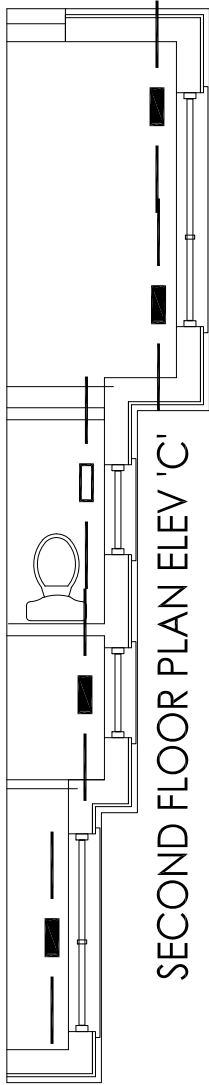

SECOND FLOOR PLAN ELEV 'C'

Return air intake shall be provided as recommended in HRAI Digest 2005 Section 4.7 Return air inlet should be positioned so that short circuiting of supply air is avoided. A high and low wall return air combination shall be provided when a combined cooling & heating system is installed.

I MICHAEL O'ROURKE HAVE REVIEWED AND TAKE RESPONSIBILITY FOR THE DESIGN WORK AND AM QUALIFIED UNDER DIVISION C, 3.2.5 OF THE BUILDING CODE.
Michael O'Rourke
Michael O'Rourke, BCIN# 19669
HVAC DESIGNS LTD.

CSA-F280-12

SB-12 PERFORMANCE

HVAC LEGEND								3.		
SYMBOL	DESCRIPTION	SYMBOL	DESCRIPTION	SYMBOL	DESCRIPTION	SYMBOL	DESCRIPTION	2.		
	SUPPLY AIR GRILLE		6" SUPPLY AIR BOOT ABOVE		14"x8" RETURN AIR GRILLE		RETURN AIR STACK ABOVE	1.		
	SUPPLY AIR GRILLE 6" BOOT		SUPPLY AIR STACK FROM 2nd FLOOR		30"x8" RETURN AIR GRILLE		RETURN AIR STACK 2nd FLOOR	No.	Description	Date
	SUPPLY AIR BOOT ABOVE		6" SUPPLY AIR STACK 2nd FLOOR		FRA- FLOOR RETURN AIR GRILLE		REDUCER	REVISIONS		

ALL DRAWINGS, CALCULATIONS AND SPECIFICATIONS ARE THE PROPERTY OF HVAC DESIGNS LTD.© AND MAY NOT BE REPRODUCED, MODIFIED OR ALTERED WITHOUT EXPRESSED WRITTEN CONSENT. THE DRAWINGS ARE DATED AND USE OF THESE DRAWINGS AFTER ONE YEAR FROM THE DATED NOTED IS NOT AUTHORIZED. CONTRACTOR SHALL CHECK ALL CONDITIONS BEFORE PROCEEDING WITH WORK. LATEST MUNICIPAL APPROVED DRAWINGS ONLY TO BE USED DURING INSTALLATION OF HEATING SYSTEM. HVAC DESIGNS LTD. IS NOT LIABLE FOR ANY CLAIMS ARISING FROM UNAUTHORIZED USE OF THE DRAWINGS OR FROM ANY CHANGES TO ACCEPTED STANDARDS AND/OR THE ONTARIO BUILDING CODE.

Client		<div></div> <div>375 Finley Ave. Suite 202 - Ajax, Ontario L1S 2E2 Tel. 905.619.2300 - 905.420.5300 Fax 905.619.2375 Email: info@hvacdesigns.ca Web: www.hvacdesigns.ca Specializing in Residential Mechanical Design Services</div> <div>Installation to comply with the latest Ontario Building Code. All supply branch outlets shall be equipped with a manual balancing damper. Ductwork which passes through the garage or unheated spaces shall be adequately insulated and be gas-proofed.</div>	Sheet Title	
ROYAL PINE HOMES			SECOND FLOOR HEATING LAYOUT	
Project Name			Date	JUNE/2021
CENTREFIELD (WEST GORMLEY) RICHMOND HILL, ONTARIO			Scale	3/16" = 1'-0"
38-14 - OPT 2ND 2724 sqft			BCIN# 19669	
			LO#	91285