



## SITE INSTRUCTION

**Forestside Estates**  
 Attmar & Palleschi Drive  
 Brampton, Ontario  
 Attn: **Vince Staffieri**

### SI #27

**PROJECT** : Forestside  
**PROJECT #** : 1331.15  
**DATE** : Apr. 4, 2023

Site instructions/memos and Addendums are issued only for the purpose of recording any clarification or interpretation of the contract documents or giving direction on problems resulting from field conditions. These memos are subject to the provisions of the contract documents and unless reviewed with and authorized by the Client, will not affect the contract. Should the Contractor require a change in the contract price or project schedule, he shall submit to the Client, prior to commencement of work outlined in this memo, an itemized proposal for approval.

**Title:** Revisions to plans as itemized.

| Reference:    |                  | Changes:   |
|---------------|------------------|--|
| A302c1-A302c2 | 2nd Floor Plans  | <ul style="list-style-type: none"> <li>Revised wall tags at upper lobby from PW1B to F5 and F5S as noted.</li> </ul> |
| A503          | Building Section |  |

**Reason:** Revisions to plans as per site comments and architectural review of approved wall types.

If you have any questions or require any further clarification, please email or call.

Yours truly,

**Gino Colangelo**  
 Associate Principal, Director of Contract Documents

**Distribution:**

|                               |   |  |
|-------------------------------|---|--|
| Royal Pine Homes              | Vince Staffieri<br>Cinzia Caruzo                            | <a href="mailto:vince@royalpinehomes.com">vince@royalpinehomes.com</a><br><a href="mailto:Cinzia@royalpinehomes.com">Cinzia@royalpinehomes.com</a>   |
| Jablonski Engineering         | Kevin Deonaraine  | <a href="mailto:kdeonaraine@astint.on.ca">kdeonaraine@astint.on.ca</a>   |
| United Engineering            | Rene Cuales<br>Leonard Matthews<br>Susan Pan<br>Mark Giorgi | <a href="mailto:rene@u-eng.ca">rene@u-eng.ca</a><br><a href="mailto:Lenard@u-eng.ca">Lenard@u-eng.ca</a><br><a href="mailto:susan@u-eng.ca">susan@u-eng.ca</a><br><a href="mailto:mark@u-eng.ca">mark@u-eng.ca</a>                     |
| Candevcon Limited             | Diarmund Hogan<br>Dudister Damnaraigh                       | <a href="mailto:dhorgan@candevcon.com">dhorgan@candevcon.com</a><br><a href="mailto:dude@candevcon.com">dude@candevcon.com</a>   |
| Starfire Sprinkler Systems    | Elite Novosselova<br>Peter Adrian                           | <a href="mailto:elitecanada@hotmail.com">elitecanada@hotmail.com</a><br><a href="mailto:Peter@starfiresystems.biz">Peter@starfiresystems.biz</a>   |
| Strybos Barron King Ltd.      | Bryn Barron<br>Kaleigh Gills<br>Sydney Martel               | <a href="mailto:bbarron@strybos.com">bbarron@strybos.com</a><br><a href="mailto:kgillis@strybos.com">kgillis@strybos.com</a><br><a href="mailto:smartel@strybos.com">smartel@strybos.com</a>   |
| Graziani + Corazza Architects | Domenic Biase<br>Gino Colangelo<br>Fernando Croatto         | <a href="mailto:dbiase@gc-architects.com">dbiase@gc-architects.com</a><br><a href="mailto:gcolangelo@gc-architects.com">gcolangelo@gc-architects.com</a><br><a href="mailto:FCroatto@gc-architects.com">FCroatto@gc-architects.com</a> |



THIS DRAWING IS AN INSTRUMENT OF SERVICE, IT IS PROVIDED BY AND IS THE PROPERTY OF GRAZIANI CORAZZA ARCHITECTS INC. THE CONTRACTOR MUST VERIFY AND ACCEPT RESPONSIBILITY FOR ALL DIMENSIONS AND COORDINATE WITH ALL OTHER INFORMATION. GRAZIANI CORAZZA ARCHITECTS INC. IS NOT RESPONSIBLE FOR THE ACCURACY OF SURVEY, STRUCTURAL, MECHANICAL, ELECTRICAL AND OTHER ENGINEERING INFORMATION SHOWN ON THIS DRAWING. REFER TO THE APPROPRIATE ENGINEERING DRAWINGS BEFORE PROCEEDING WITH THE WORK. CONSTRUCTION MUST COMPLY TO ALL APPLICABLE CODES AND REQUIREMENTS OF THE AUTHORITIES HAVING JURISDICTION, UNLESS OTHERWISE NOTED. NO MODIFICATION AND/OR ADDITIONS TO BE MADE ON THIS OFFICE IN REGARDS TO THE ENVIRONMENTAL CONDITION OF THIS SITE.

THIS DRAWING IS NOT TO BE SCALED. ALL ARCHITECTURAL SYMBOLS INDICATED ON THIS DRAWING ARE GRAPHIC REPRESENTATIONS ONLY.

CONDITIONS FOR ELECTRONIC INFORMATION TRANSFER:

ELECTRONIC INFORMATION IS SUPPLIED TO THE OTHER ASSOCIATED FIRMS TO ASSIST THEM IN THE EXECUTION OF THEIR WORK. REVIEW THE RECEIVED FIRMS MUST DETERMINE THE COMPLETENESS, APPROPRIATENESS, RELIANCE OF THE INFORMATION IN RESPECT TO THEIR PARTICULAR RESPONSIBILITY.

GRAZIANI CORAZZA ARCHITECTS INC. SHALL NOT BE RESPONSIBLE FOR ERRORS, OMISSIONS, INCOMPLETENESS DUE TO LOSS OF INFORMATION IN WHICH BY PART INFORMATION IS TRANSMITTED.

1. TRANSMISSION OF ANY LOSS OF DAMAGE TO THE RECEIVING ELECTRONIC SYSTEM WHEN INFORMATION IS TRANSMITTED.

REF A30262 FOR CONTINUATION

- |     |              |  |    |
|-----|--------------|--|----|
| 01. | Oct.07.2019  | Issued for tender                      | tg |
| 02. | Mar.13.2020  | Issued for design coordination #2      | tg |
| 03. | Mar.16.2020  | Issued for addendum #2                 | tg |
| 04. | Mar.16.2020  | Issued for addendum #3                 | tg |
| 05. | Aug.24.2020  | Issued for addendum #4                 | tg |
| 06. | Sept.28.2020 | Issued for permit                      | tg |
| 07. | Oct.20.2020  | Issued for addendum #5                 | tg |
| 08. | Nov.23.2020  | Issued for addendum #6                 | tg |
| 09. | Dec.14.2020  | Issued for addendum #7                 | tg |
| 10. | Jan.18.2021  | Issued for addendum #8                 | tg |
| 11. | Mar.2.2021   | Issued for permit                      | tg |
| 12. | Mar.09.2021  | Issued for addendum #9                 | tg |
| 13. | Mar.10.2021  | Issued for addendum #9R                | tg |
| 14. | Mar.26.2021  | Issued for progress                    | tg |
| 15. | May.14.2021  | Issued for Site Instruction #1         | tg |
| 16. | June.15.2021 | Issued for Site Instruction #2         | tg |
| 17. | July.7.2021  | Re-issued for permit                   | tg |
| 18. | July.15.2021 | Issued for Site Instruction #3         | tg |
| 19. | July.27.2021 | Issued for Site Instruction #4         | tg |
| 20. | Aug.3.2021   | Issued for Site Instruction #5         | tg |
| 21. | Aug.18.2021  | Issued for Site Instruction #6         | tg |
| 22. | Aug.20.2021  | Re-issued for permit                   | tg |
| 23. | Sept.07.2021 | Issued for Site Instruction #7         | tg |
| 24. | Sept.09.2021 | Issued for Site Instruction #8         | tg |
| 25. | Sept.16.2021 | Issued for Building O Permit Revisions | tg |
| 26. | Sept.22.2021 | Issued for Site Instruction #9         | tg |
| 27. | Oct.6.2021   | Re-issued for permit                   | tg |
| 28. | Oct.8.2021   | Issued for Site Instruction #10        | tg |
| 30. | Oct.28.2021  | Issued for Site Instruction #11        | tg |
| 31. | Nov.05.2021  | Issued for Site Instruction #12        | tg |
| 32. | Dec.3.2021   | Issued for Site Instruction #13        | tg |
| 33. | Dec.6.2021   | Issued for Site Instruction #14        | tg |
| 34. | Dec.7.2021   | Issued for Site Instruction #15        | tg |
| 35. | Jan.26.2022  | Issued for Site Instruction #16        | tg |
| 36. | Jan.31.2022  | Issued for Site Instruction #17        | tg |
| 37. | Mar.1.2022   | Issued for Site Instruction #18        | tg |
| 38. | Apr.29.2022  | Issued for Site Instruction #19        | tg |
| 39. | May.10.2022  | Issued for Site Instruction #20        | tg |
| 40. | May.24.2022  | Issued for Site Instruction #21        | tg |
| 41. | Aug.05.2022  | Issued for I.F.C.                      | tg |
| 42. | Aug.18.2022  | Issued for Site Instruction #22        | tg |
| 43. | Aug.23.2022  | Issued for Site Instruction #23        | tg |
| 44. | Oct.12.2022  | Issued for Site Instruction #24        | tg |
| 45. | Feb.6.2023   | Issued for Site Instruction #25        | tg |
| 46. | Mar.22.2023  | Issued for Site Instruction #26        | tg |
| 47. | Mar.24.2023  | Issued for Site Instruction #25R       | tg |
| 48. | Apr.4.2023   | Issued for Site Instruction #27        | tg |

01. 8/27/2021 19 Issued for addendum 1  
Issued for revisions



1320 SHANESHA DRIVE, SUITE 100 MISSISSAUGA, ONTARIO L4W 1C3  
905.760.7001 P:905.760.7000 WWW.GC-ARCHITECTS.COM





BRAMPTON ATTAR + PALLESCI DRIVE ONTARIO

PROJECT ARCHITECT: B. GRAZIANI  
ASSISTANT DESIGNER: R. LINCOLN  
DRAWN BY: G.C./F.C./M.B.  
CHECKED BY: D. BIASE/G. COLANGELO  
PLOT DATE: APR. 04. 2023  
JOB #: 1331.15



SECOND FLOOR PLAN  
BUILDING C (PARTIAL PLAN)

1:50 A-302c1  
TITLE BLOCK SIZE: 915 x 1200

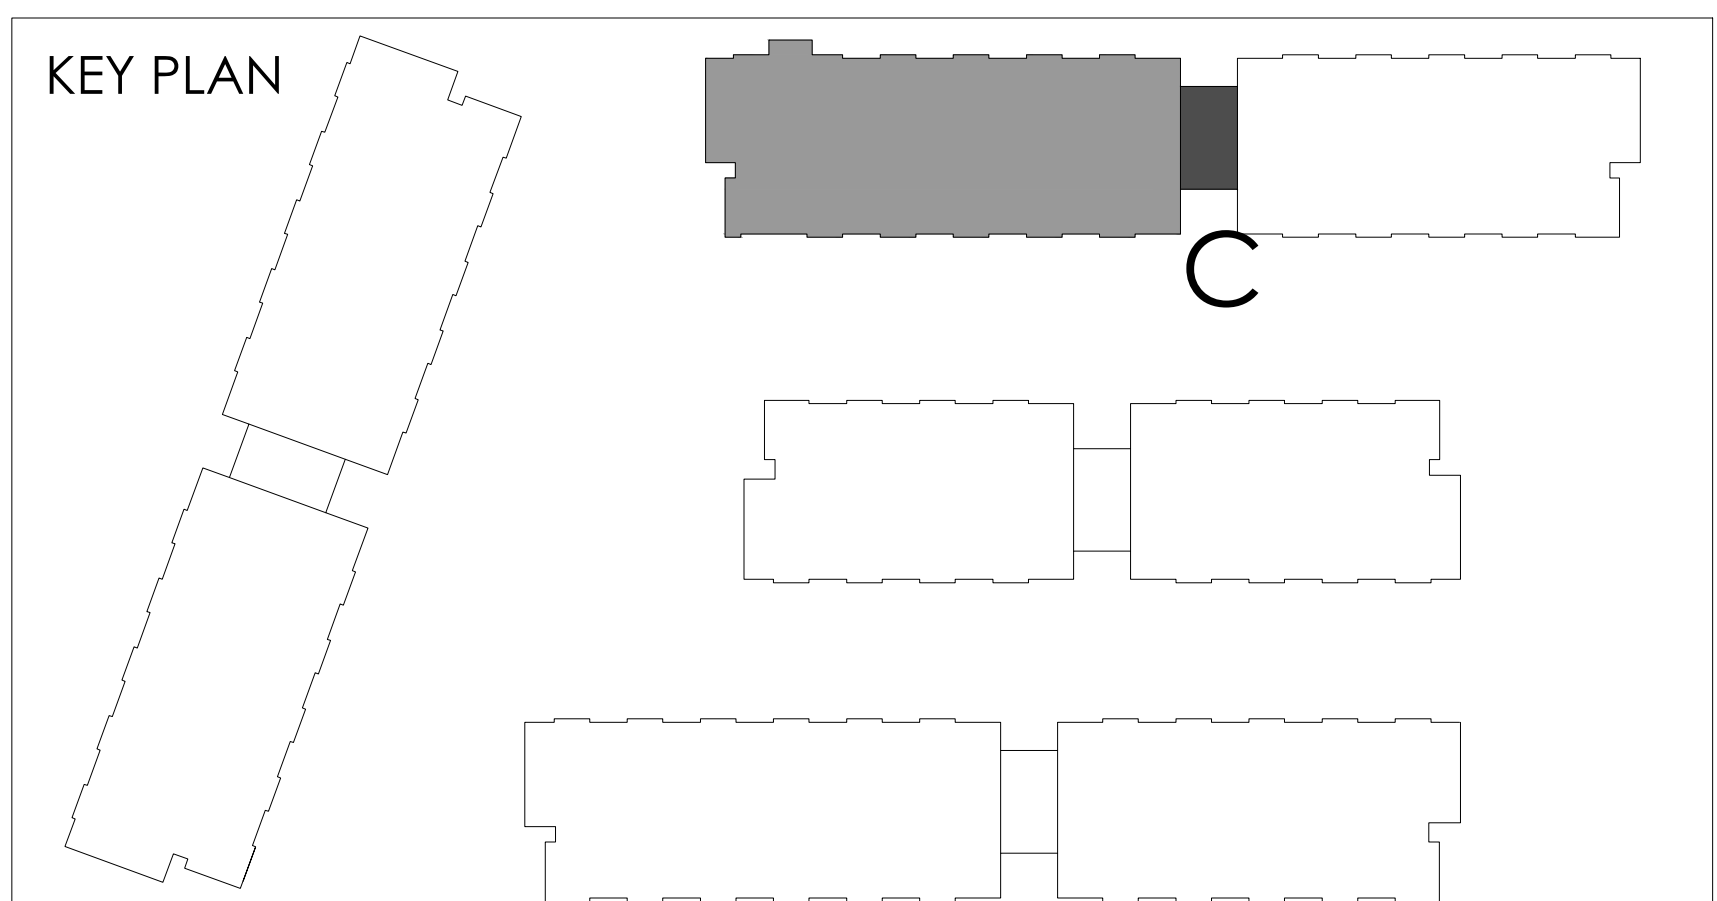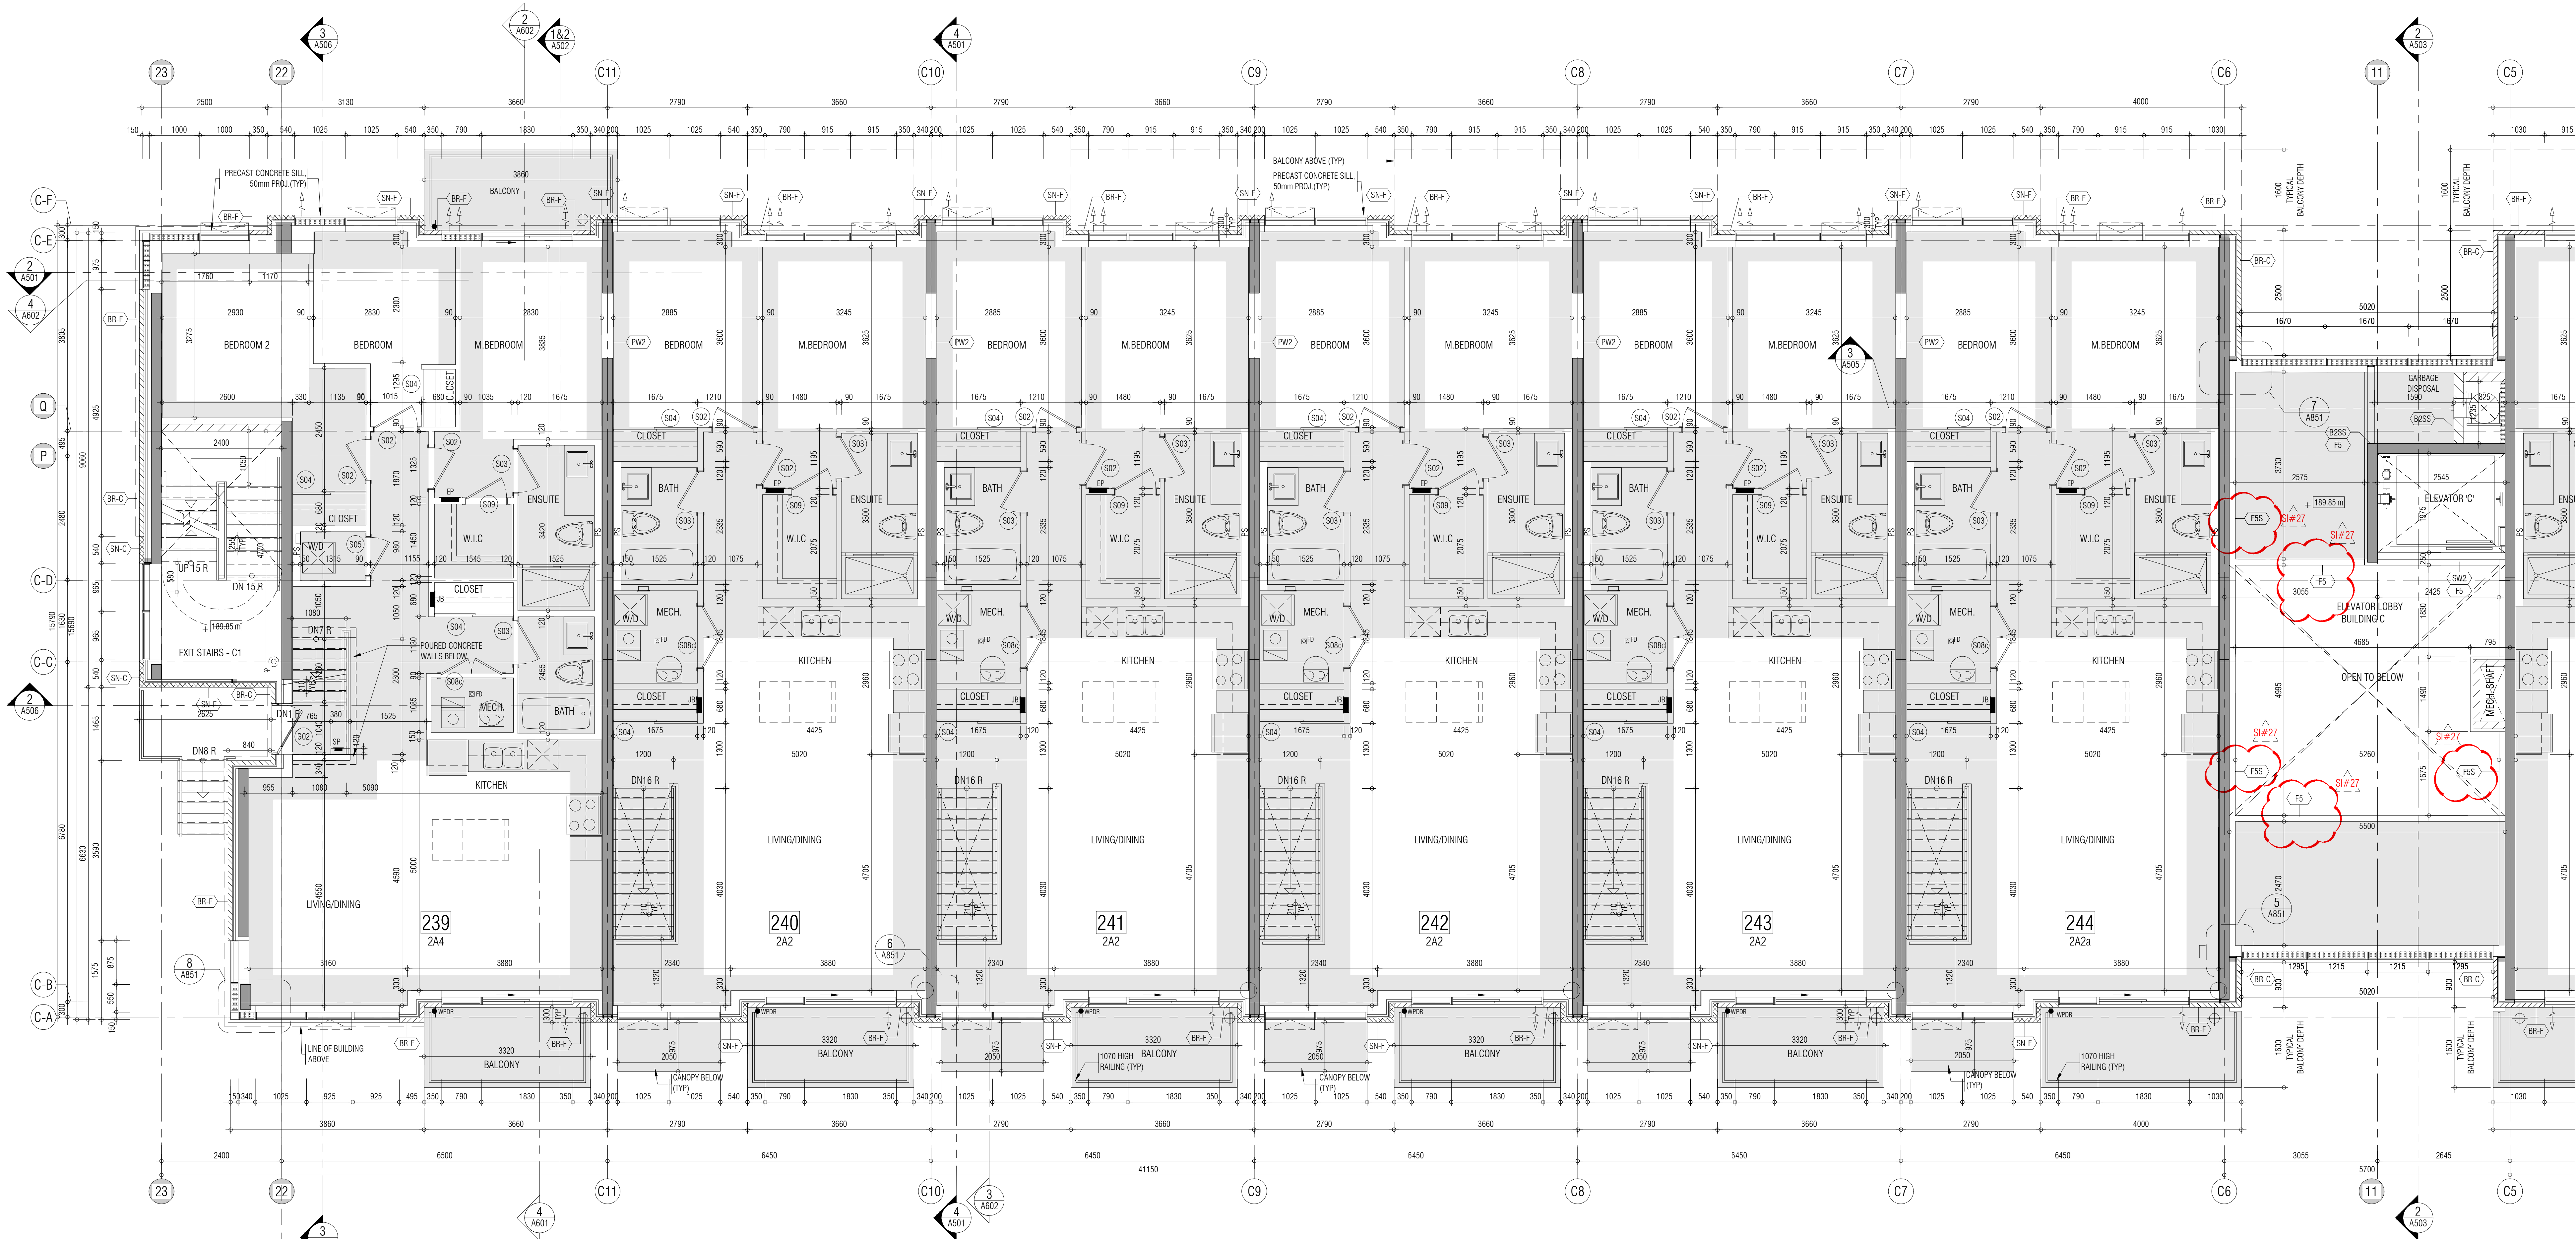



REF. A302b1 FOR CONTINUATION

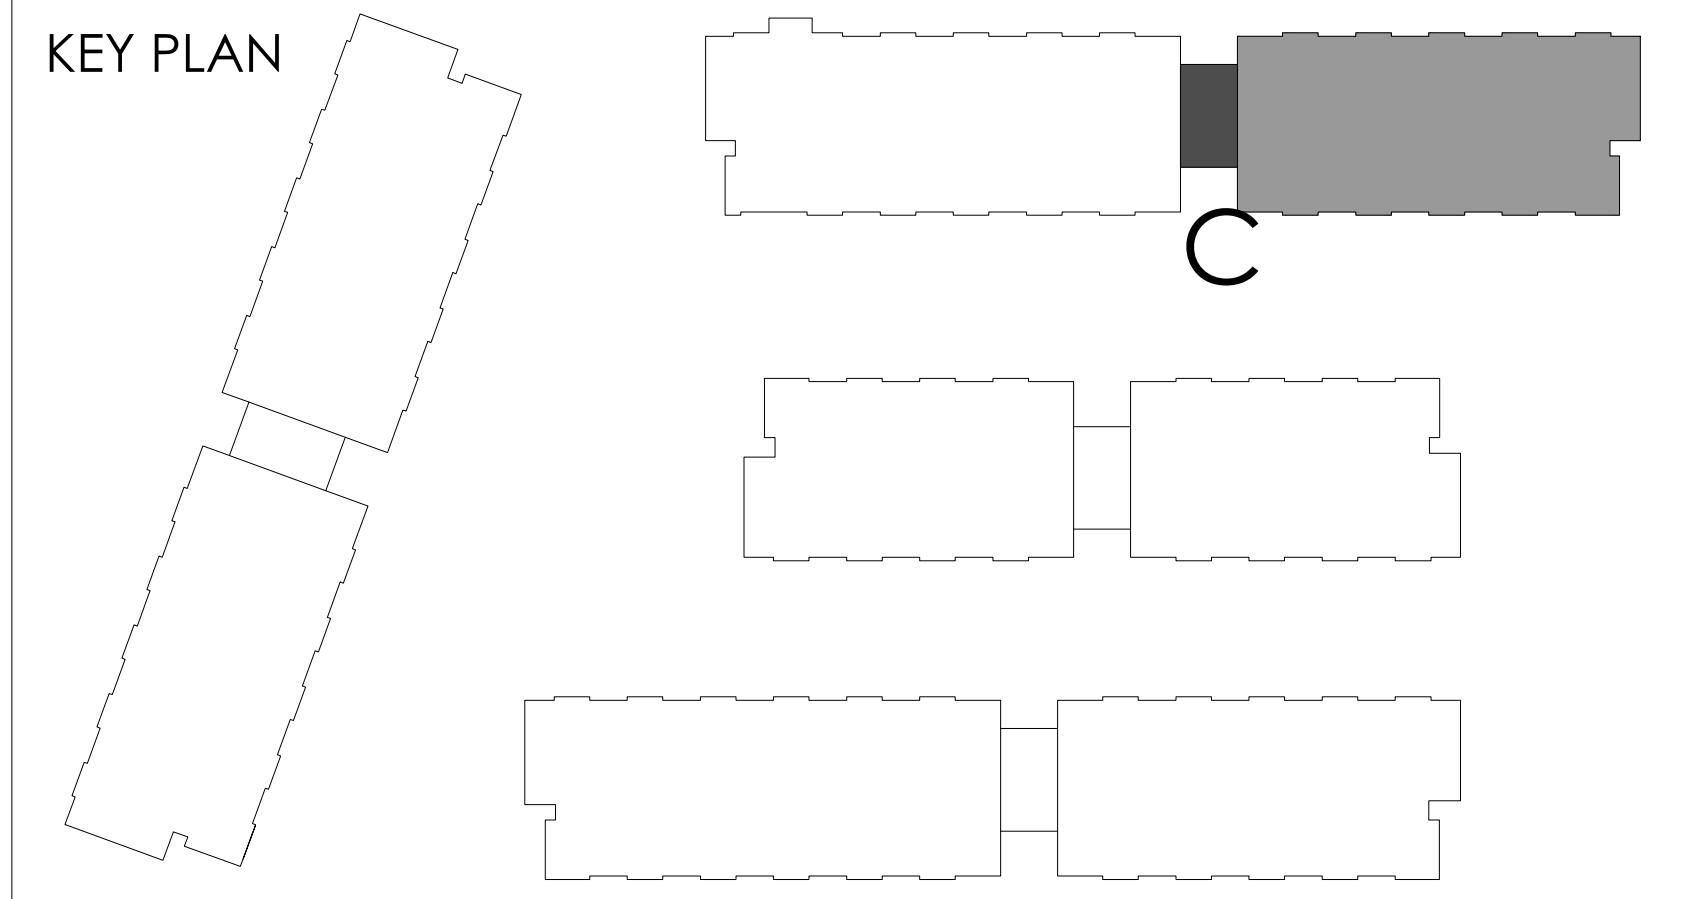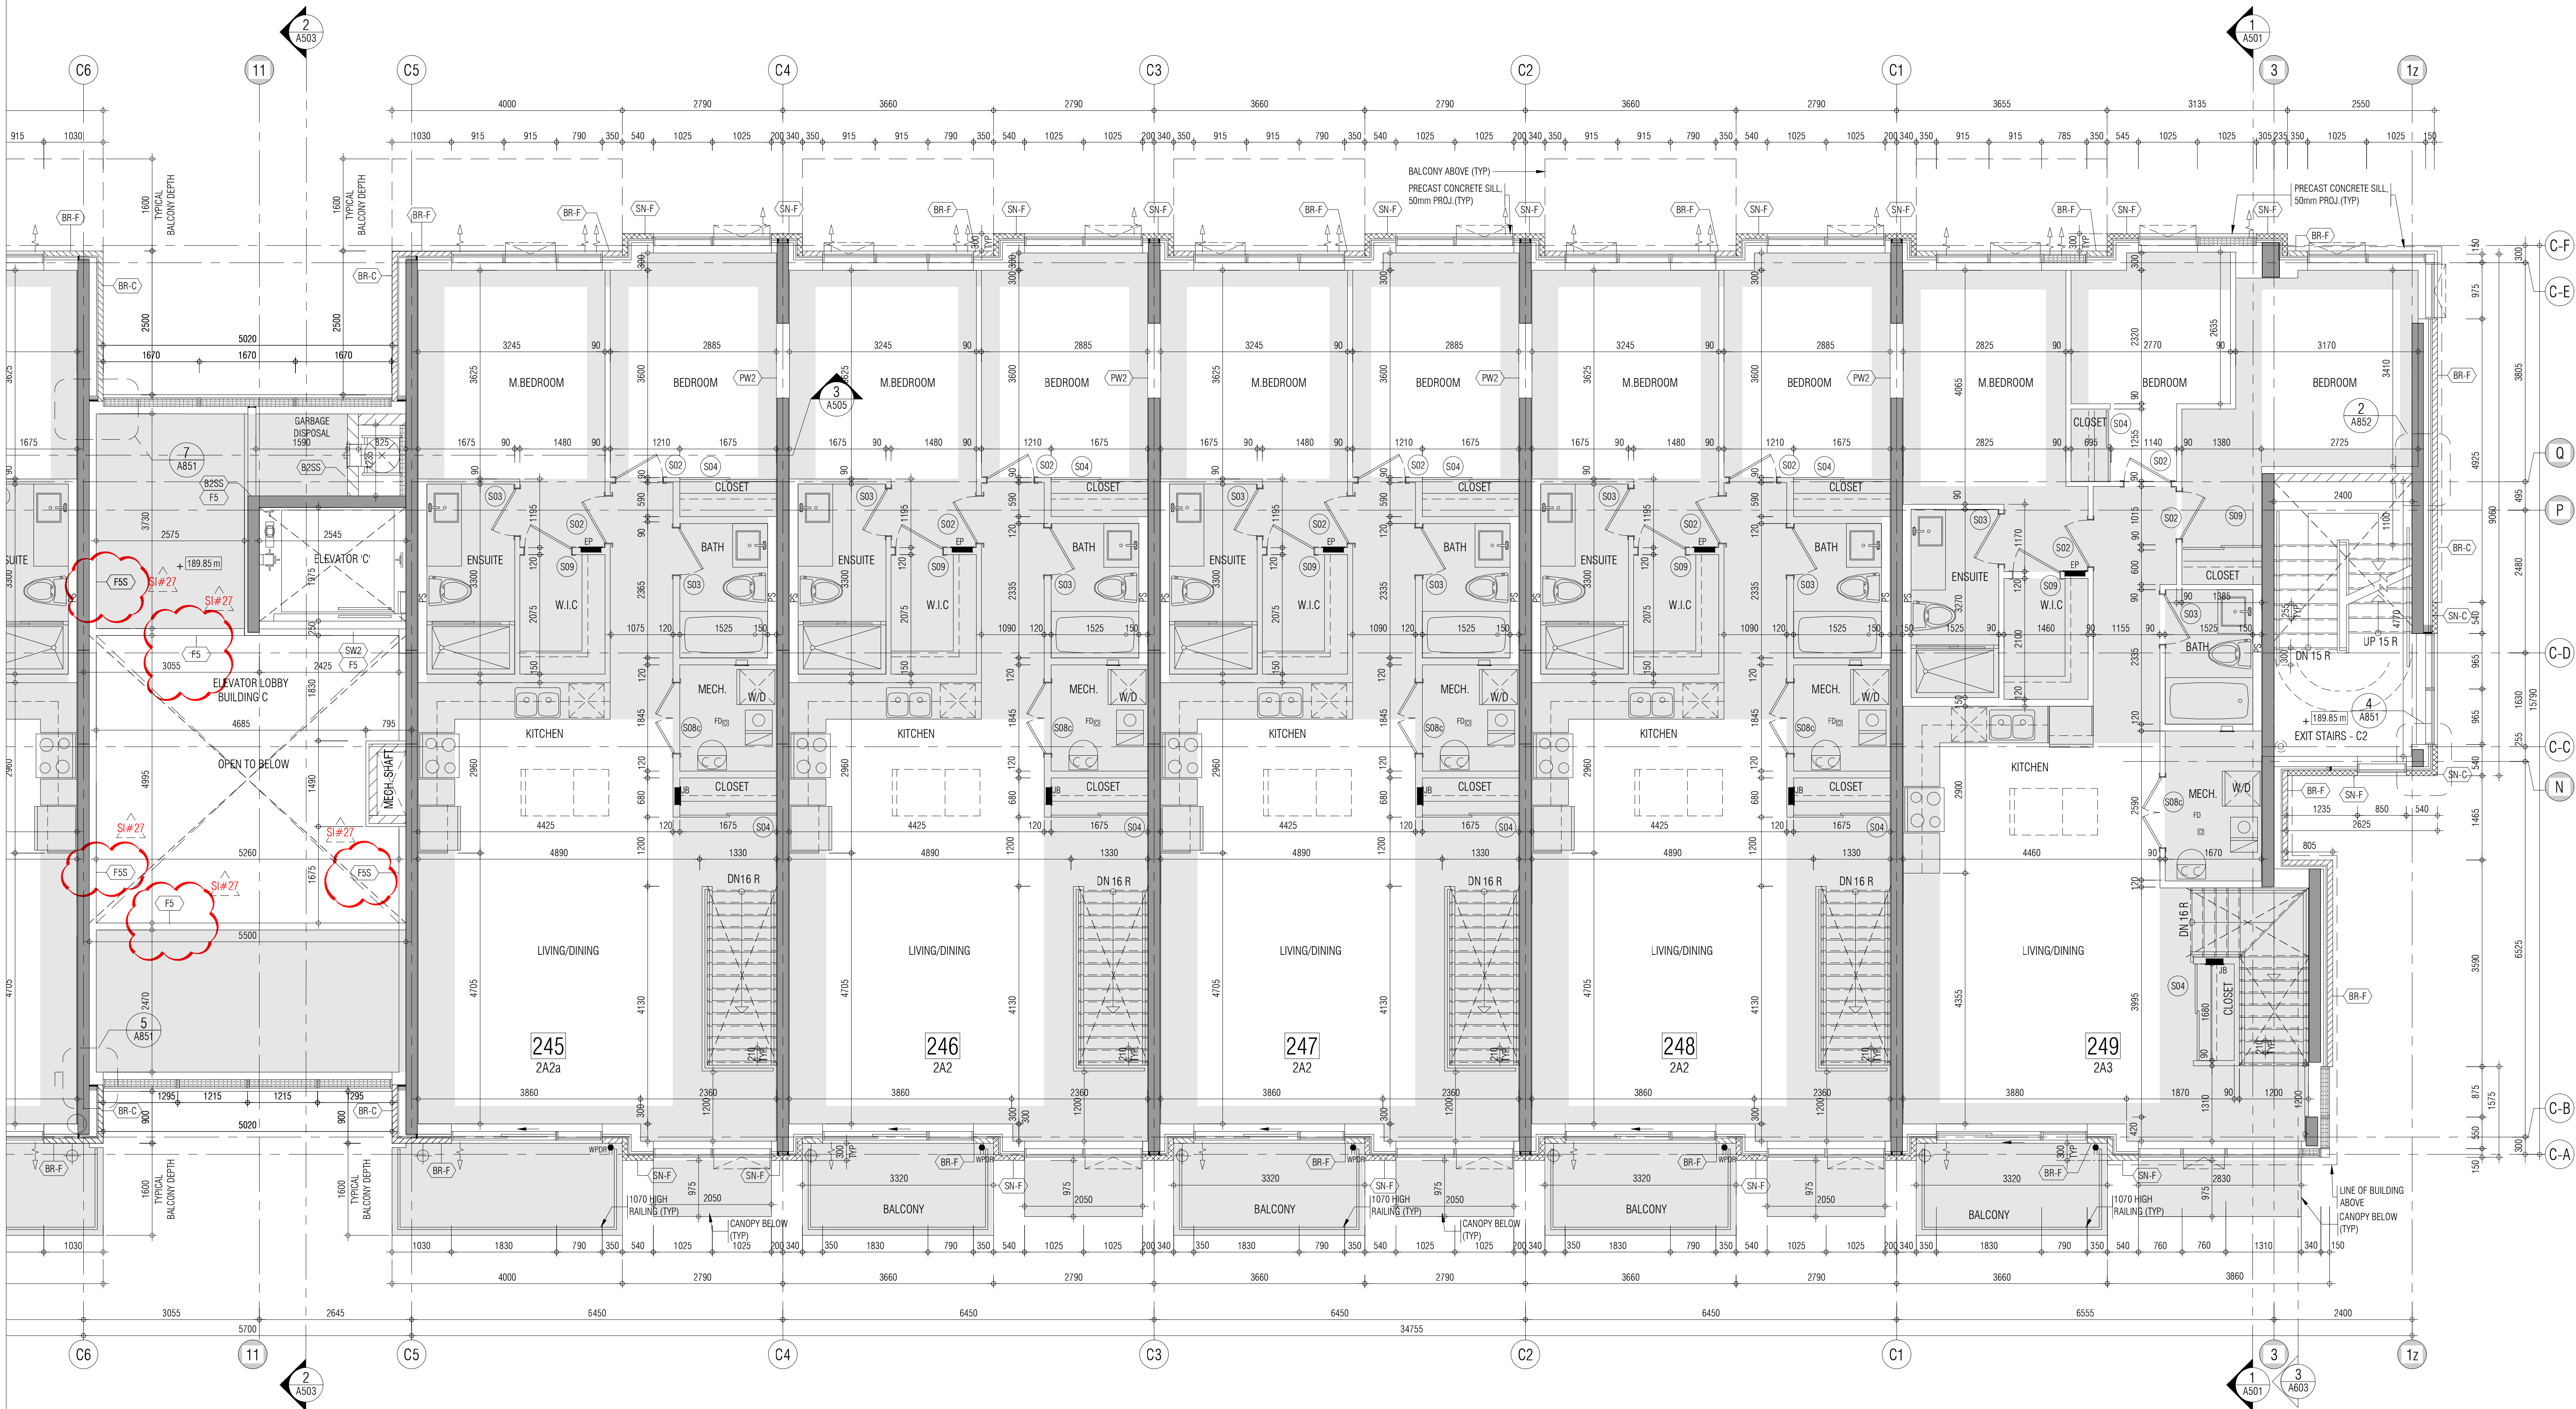

THIS DRAWING IS AN INSTRUMENT OF SERVICE, IT IS PROVIDED BY AND IS THE PROPERTY OF GRAZIANI CORAZZA ARCHITECTS INC. THE CONTRACTOR MUST HAVE AND ACCEPT RESPONSIBILITY FOR ALL DIMENSIONS AND COORDINATIONS. THE CONTRACTOR MUST VERIFY ALL DIMENSIONS AND COORDINATIONS WITH THE SURVEYOR. GRAZIANI CORAZZA ARCHITECTS INC. IS NOT RESPONSIBLE FOR THE ACCURACY OF SURVEY, STRUCTURAL, MECHANICAL, ELECTRICAL, AND OTHER ENGINEERING INFORMATION SHOWN ON THIS DRAWING. REFER TO THE APPROPRIATE ENGINEERING DRAWINGS BEFORE PROCEEDING WITH THE WORK. CONSTRUCTION MUST COMPLY TO ALL APPLICABLE CODES AND REQUIREMENTS OF THE AUTHORITY HAVING JURISDICTION. UNLESS OTHERWISE NOTED, NO MODIFICATION HAS BEEN MADE TO OR REPORTED ON BY THIS OFFICE IN REGARD TO THE ENVIRONMENTAL CONDITION OF THIS SITE. THIS DRAWING IS NOT TO BE SCALED. ALL ARCHITECTURAL SYMBOLS INDICATED ON THIS DRAWING ARE GRAPHIC REPRESENTATIONS ONLY.

CONDITIONS FOR ELECTRONIC INFORMATION TRANSFER

ELECTRONIC INFORMATION IS SUPPLIED TO THE OTHER ASSOCIATED FIRMS TO ASSIST THEM IN THE EXECUTION OF THEIR WORK. REVIEW THE RECEIPT FROM FIRMS TO DETERMINE THE COMPLETENESS, APPROPRIATENESS, RELIABILITY OF THE INFORMATION IN RESPECT TO THEIR PARTICULAR RESPONSIBILITY.

GRAZIANI CORAZZA ARCHITECTS INC. SHALL NOT BE RESPONSIBLE FOR ERRORS, OMISSIONS, INCOMPLETENESS DUE TO LOSS OF INFORMATION IN WHOLE OR PART WHEN INFORMATION IS TRANSMITTED.

1. TRANSMISSION OF ANY FILES OR DAMAGE TO THE RECEIVING ELECTRONIC SYSTEM WHEN INFORMATION IS TRANSMITTED.

- 01. Oct.07.2019 issued for tender
- 02. Mar.13.2020 issued for design coordination #2
- 03. Mar.16.2020 issued for addendum #2
- 04. Mar.16.2020 issued for addendum #3
- 05. Aug.24.2020 issued for addendum #4
- 06. Sept.28.2020 issued for permit
- 07. Oct.20.2020 issued for addendum #5
- 08. Nov.23.2020 issued for addendum #6
- 09. Dec.14.2020 issued for addendum #7
- 10. Jan.18.2021 issued for addendum #8
- 11. Mar.2.2021 issued for permit
- 12. Mar.09.2021 issued for addendum #9
- 13. Mar.10.2021 issued for addendum #9R
- 14. Mar.26.2021 issued for progress
- 15. May.14.2021 issued for Site Instruction #1
- 16. June.15.2021 issued for Site Instruction #2
- 17. July.7.2021 re-issued for permit
- 18. July.15.2021 issued for Site Instruction #3
- 19. July.27.2021 issued for Site Instruction #4
- 20. Aug.3.2021 issued for Site Instruction #5
- 21. Aug.18.2021 issued for Site Instruction #6
- 22. Aug.20.2021 re-issued for permit
- 23. Sept.07.2021 issued for Site Instruction #7
- 24. Sept.09.2021 issued for Site Instruction #8
- 25. Sept.16.2021 issued for Building O Permit Revisions
- 26. Sept.22.2021 issued for Site Instruction #9
- 27. Oct.6.2021 re-issued for permit
- 28. Oct.8.2021 issued for Site Instruction #10
- 29. Oct.28.2021 issued for Site Instruction #11
- 30. Nov.05.2021 issued for Site Instruction #12
- 31. Dec.3.2021 issued for Site Instruction #13
- 32. Dec.6.2021 issued for Site Instruction #14
- 33. Dec.7.2021 issued for Site Instruction #15
- 34. Jan.26.2022 issued for Site Instruction #16
- 35. Jan.31.2022 issued for Site Instruction #17
- 36. Mar.11.2022 issued for Site Instruction #18
- 37. Apr.29.2022 issued for Site Instruction #19
- 38. May.10.2022 issued for Site Instruction #20
- 39. May.24.2022 issued for Site Instruction #21
- 40. Aug.05.2022 issued for I.F.C.
- 41. Aug.18.2022 issued for Site Instruction #22
- 42. Aug.23.2022 issued for Site Instruction #23
- 43. Oct.12.2022 issued for Site Instruction #24
- 44. Feb.6.2023 issued for Site Instruction #25
- 45. Mar.22.2023 issued for Site Instruction #26
- 46. Mar.22.2023 issued for Site Instruction #25r
- 47. Apr.4.2023 issued for Site Instruction #27

01. 08/10/2019 issued for addendum 1

issued for revisions

**GRAZIANI CORAZZA ARCHITECTS**

1320 SHAWANAGA DRIVE, SUITE 100 MISSISSAUGA, ONTARIO L4W 1C3  
905.760.7001 P.905.760.7000 WWW.GC-ARCHITECTS.COM

**RESIDENTIAL**

ATTMOR + PALLESCHI DRIVE

BRAMPTON ONTARIO

PROJECT ARCHITECT: B. GRAZIANI  
ASSISTANT DESIGNER: R. LINCOLN  
DRAWN BY: G.C./F.C./M.B.  
CHECKED BY: D. BIASI/G. COLANGELO  
PLOT DATE: APR. 04. 2023  
JOB #: 1331.15

**SECOND FLOOR PLAN  
BUILDING C (PARTIAL PLAN)**

1:50 A-302c2

TITLEBLOCK SIZE: 915 x 1200



THIS DRAWING IS AN INSTRUMENT OF SERVICE. IT IS PROVIDED BY W&O IS THE PROPERTY OF GRAZIANI-CORAZZA ARCHITECTS INC. THE CONTRACTOR MUST VERIFY AND ACCEPT RESPONSIBILITY FOR ALL DIMENSIONS AND COORDINATE THE SITE AND MUST NOTIFY GRAZIANI-CORAZZA ARCHITECTS INC. OF ANY DISCREPANCIES FROM THE SUPPLIED INFORMATION. GRAZIANI-CORAZZA ARCHITECTS INC. IS NOT RESPONSIBLE FOR THE ACCURACY OF SURVEY, STRUCTURAL, MECHANICAL, ELECTRICAL, AND OTHER ENGINEERING INFORMATION SHOWN ON THIS DRAWING. REFER TO THE APPROPRIATE ENGINEERING DRAWINGS BEFORE PROCEEDING WITH THE WORK. CONSTRUCTION MUST CONFORM TO ALL APPLICABLE CODES AND REQUIREMENTS OF THE AUTHORITIES HAVING JURISDICTION. UNLESS OTHERWISE NOTED, NO INVESTIGATION HAS BEEN UNDERTAKEN OR REPORTED ON BY THIS OFFICE IN REGARD TO THE ENVIRONMENTAL CONDITION OF THIS SITE.


THIS DRAWING IS NOT TO BE SCALED. ALL ARCHITECTURAL SYMBOLS INDICATED ON THIS DRAWING ARE GRAPHIC REPRESENTATIONS ONLY.

CONDITIONS FOR ELECTRONIC INFORMATION TRANSFER


ELECTRONIC INFORMATION IS SUPPLIED TO THE OTHER ASSOCIATED FIRMS TO ASSIST THEM IN THE EXECUTION OF THEIR WORK. REVIEW THE RECIPIENT FIRMS MUST DETERMINE THE COMPLETENESS, APPROPRIATENESS, RELIANCE OF THE INFORMATION IN RESPECT TO THEIR PARTICULAR RESPONSIBILITY.

GRAZIANI-CORAZZA ARCHITECTS INC. SHALL NOT BE RESPONSIBLE FOR ERRORS, OMISSIONS, INCOMPLETENESS DUE TO LOSS OF INFORMATION IN 1. WHOLE OR PART WHEN INFORMATION IS TRANSMITTED.

2. TRANSMISSION OF ANY VIRUS OR DAMAGE TO THE RECEIVING ELECTRONIC SYSTEM WHEN INFORMATION IS TRANSMITTED.

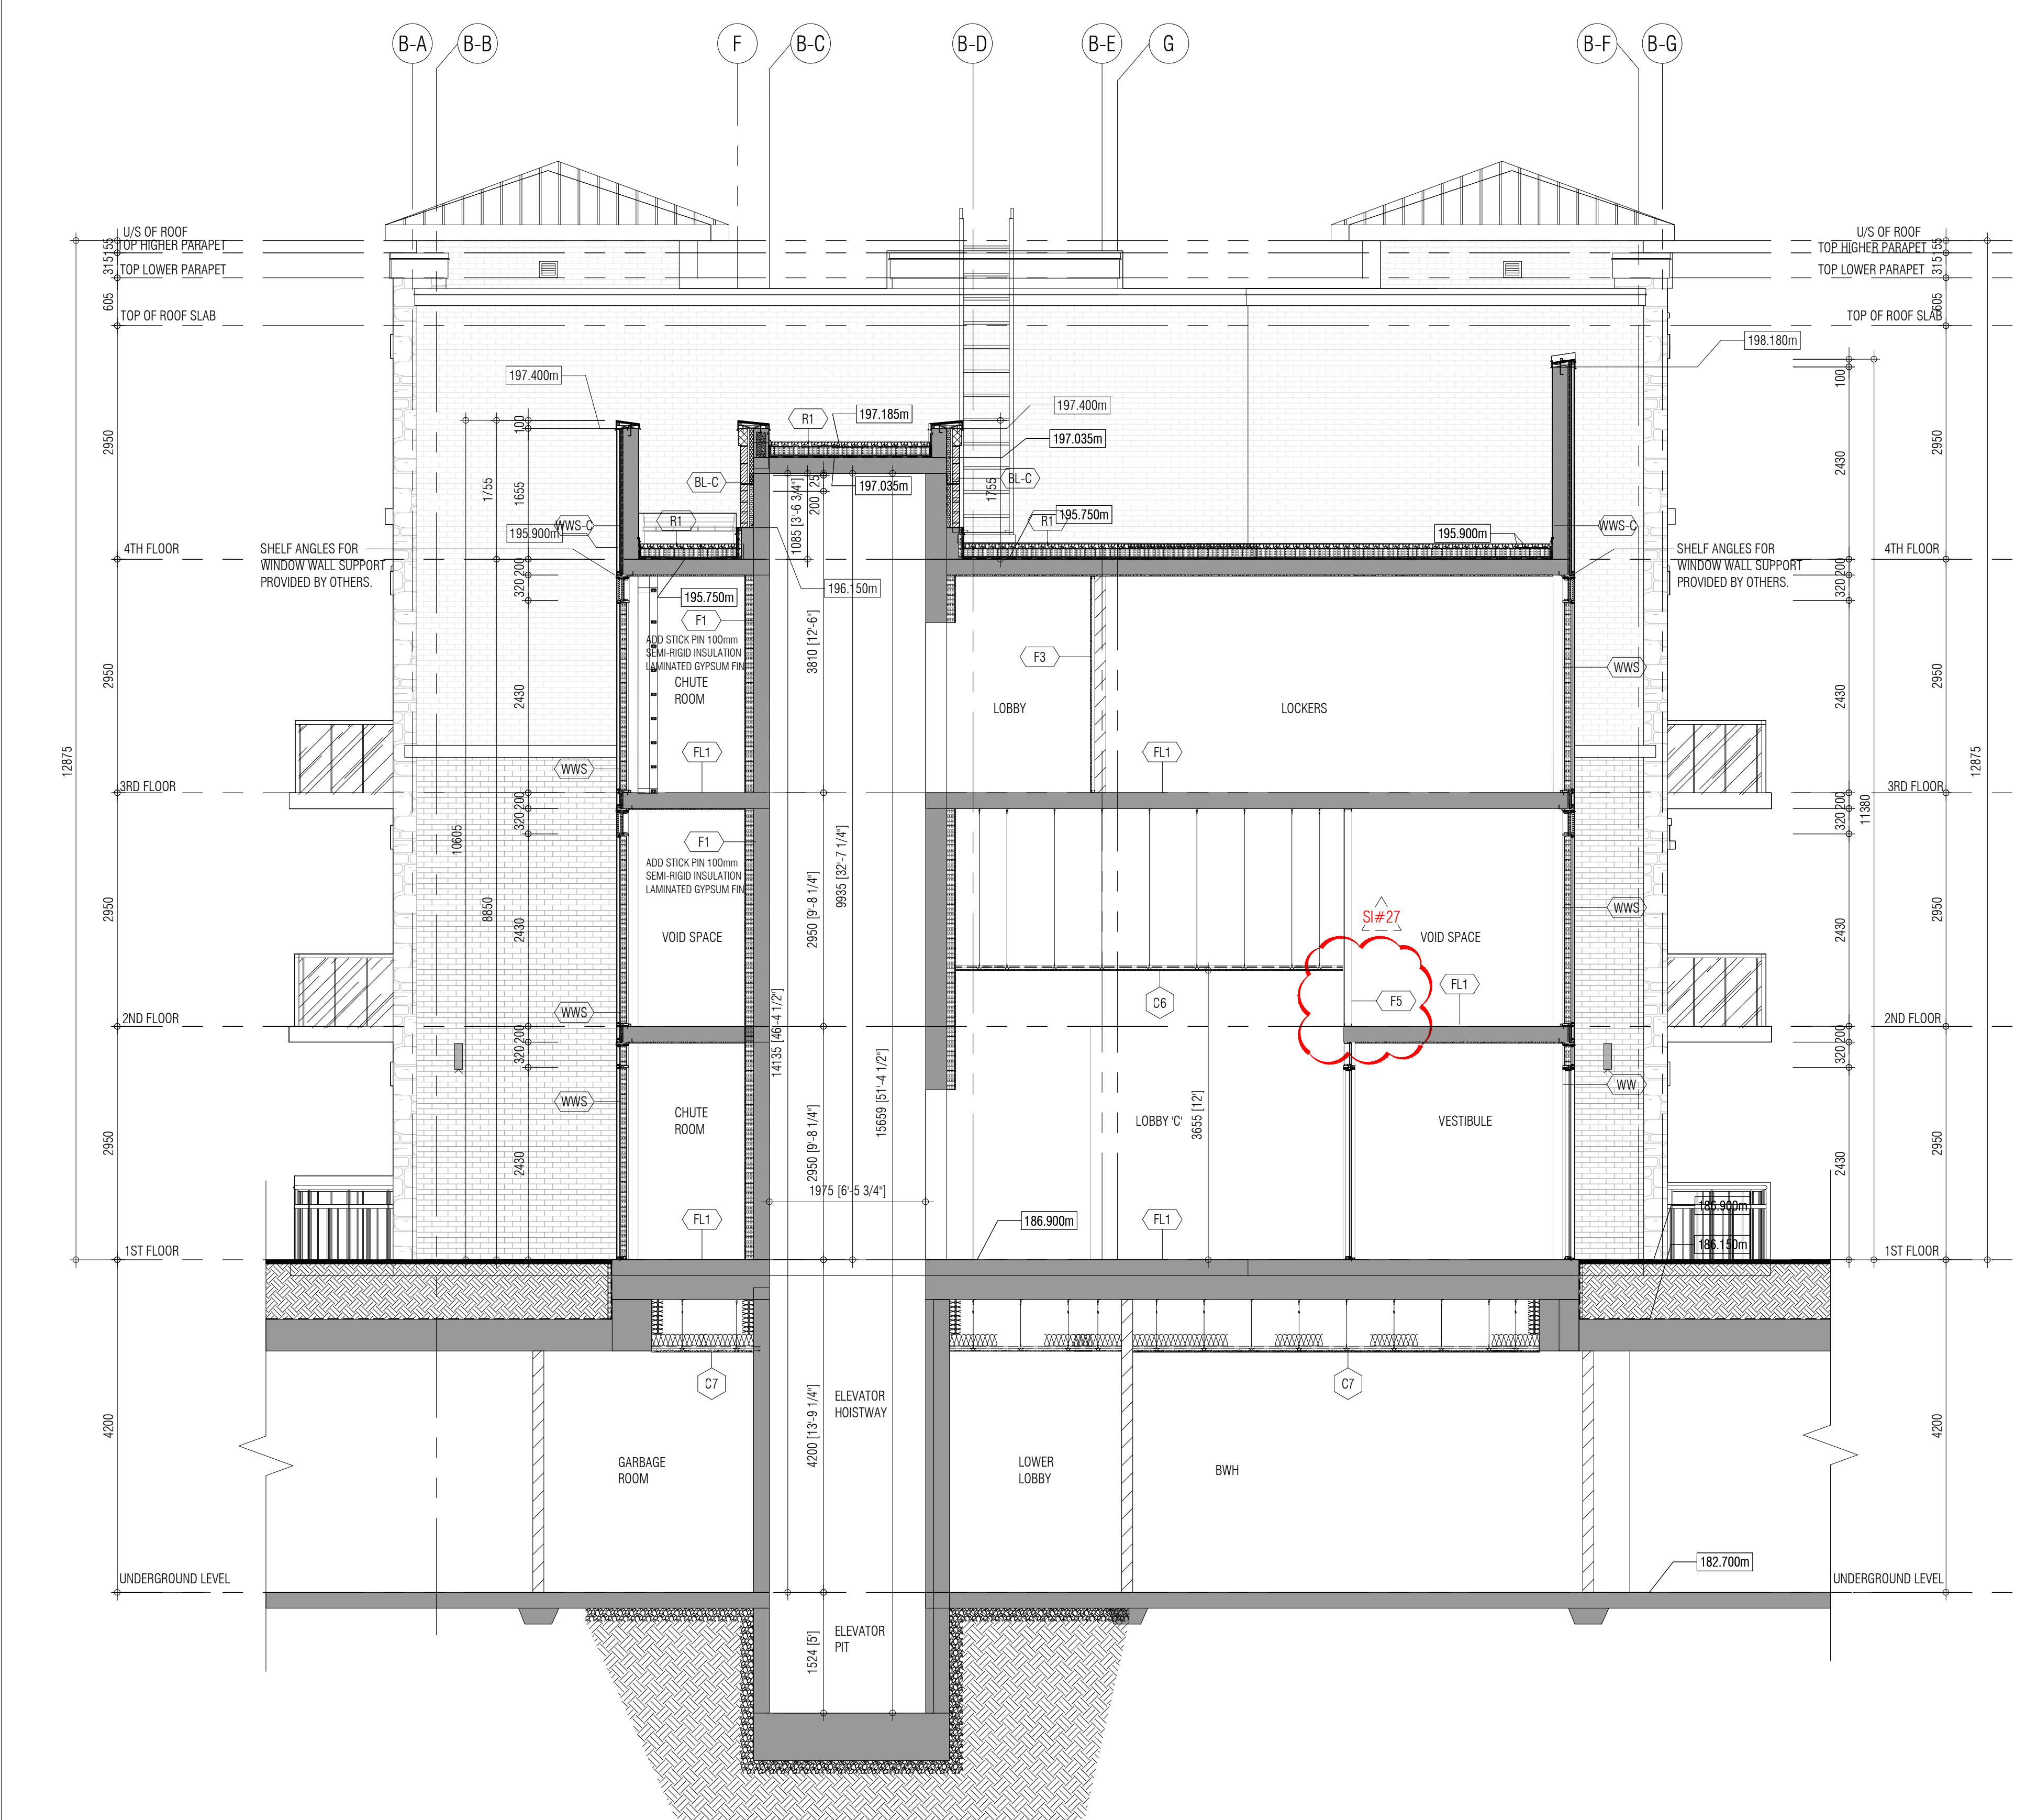

BUILDING SECTION 2  
1:50 A503

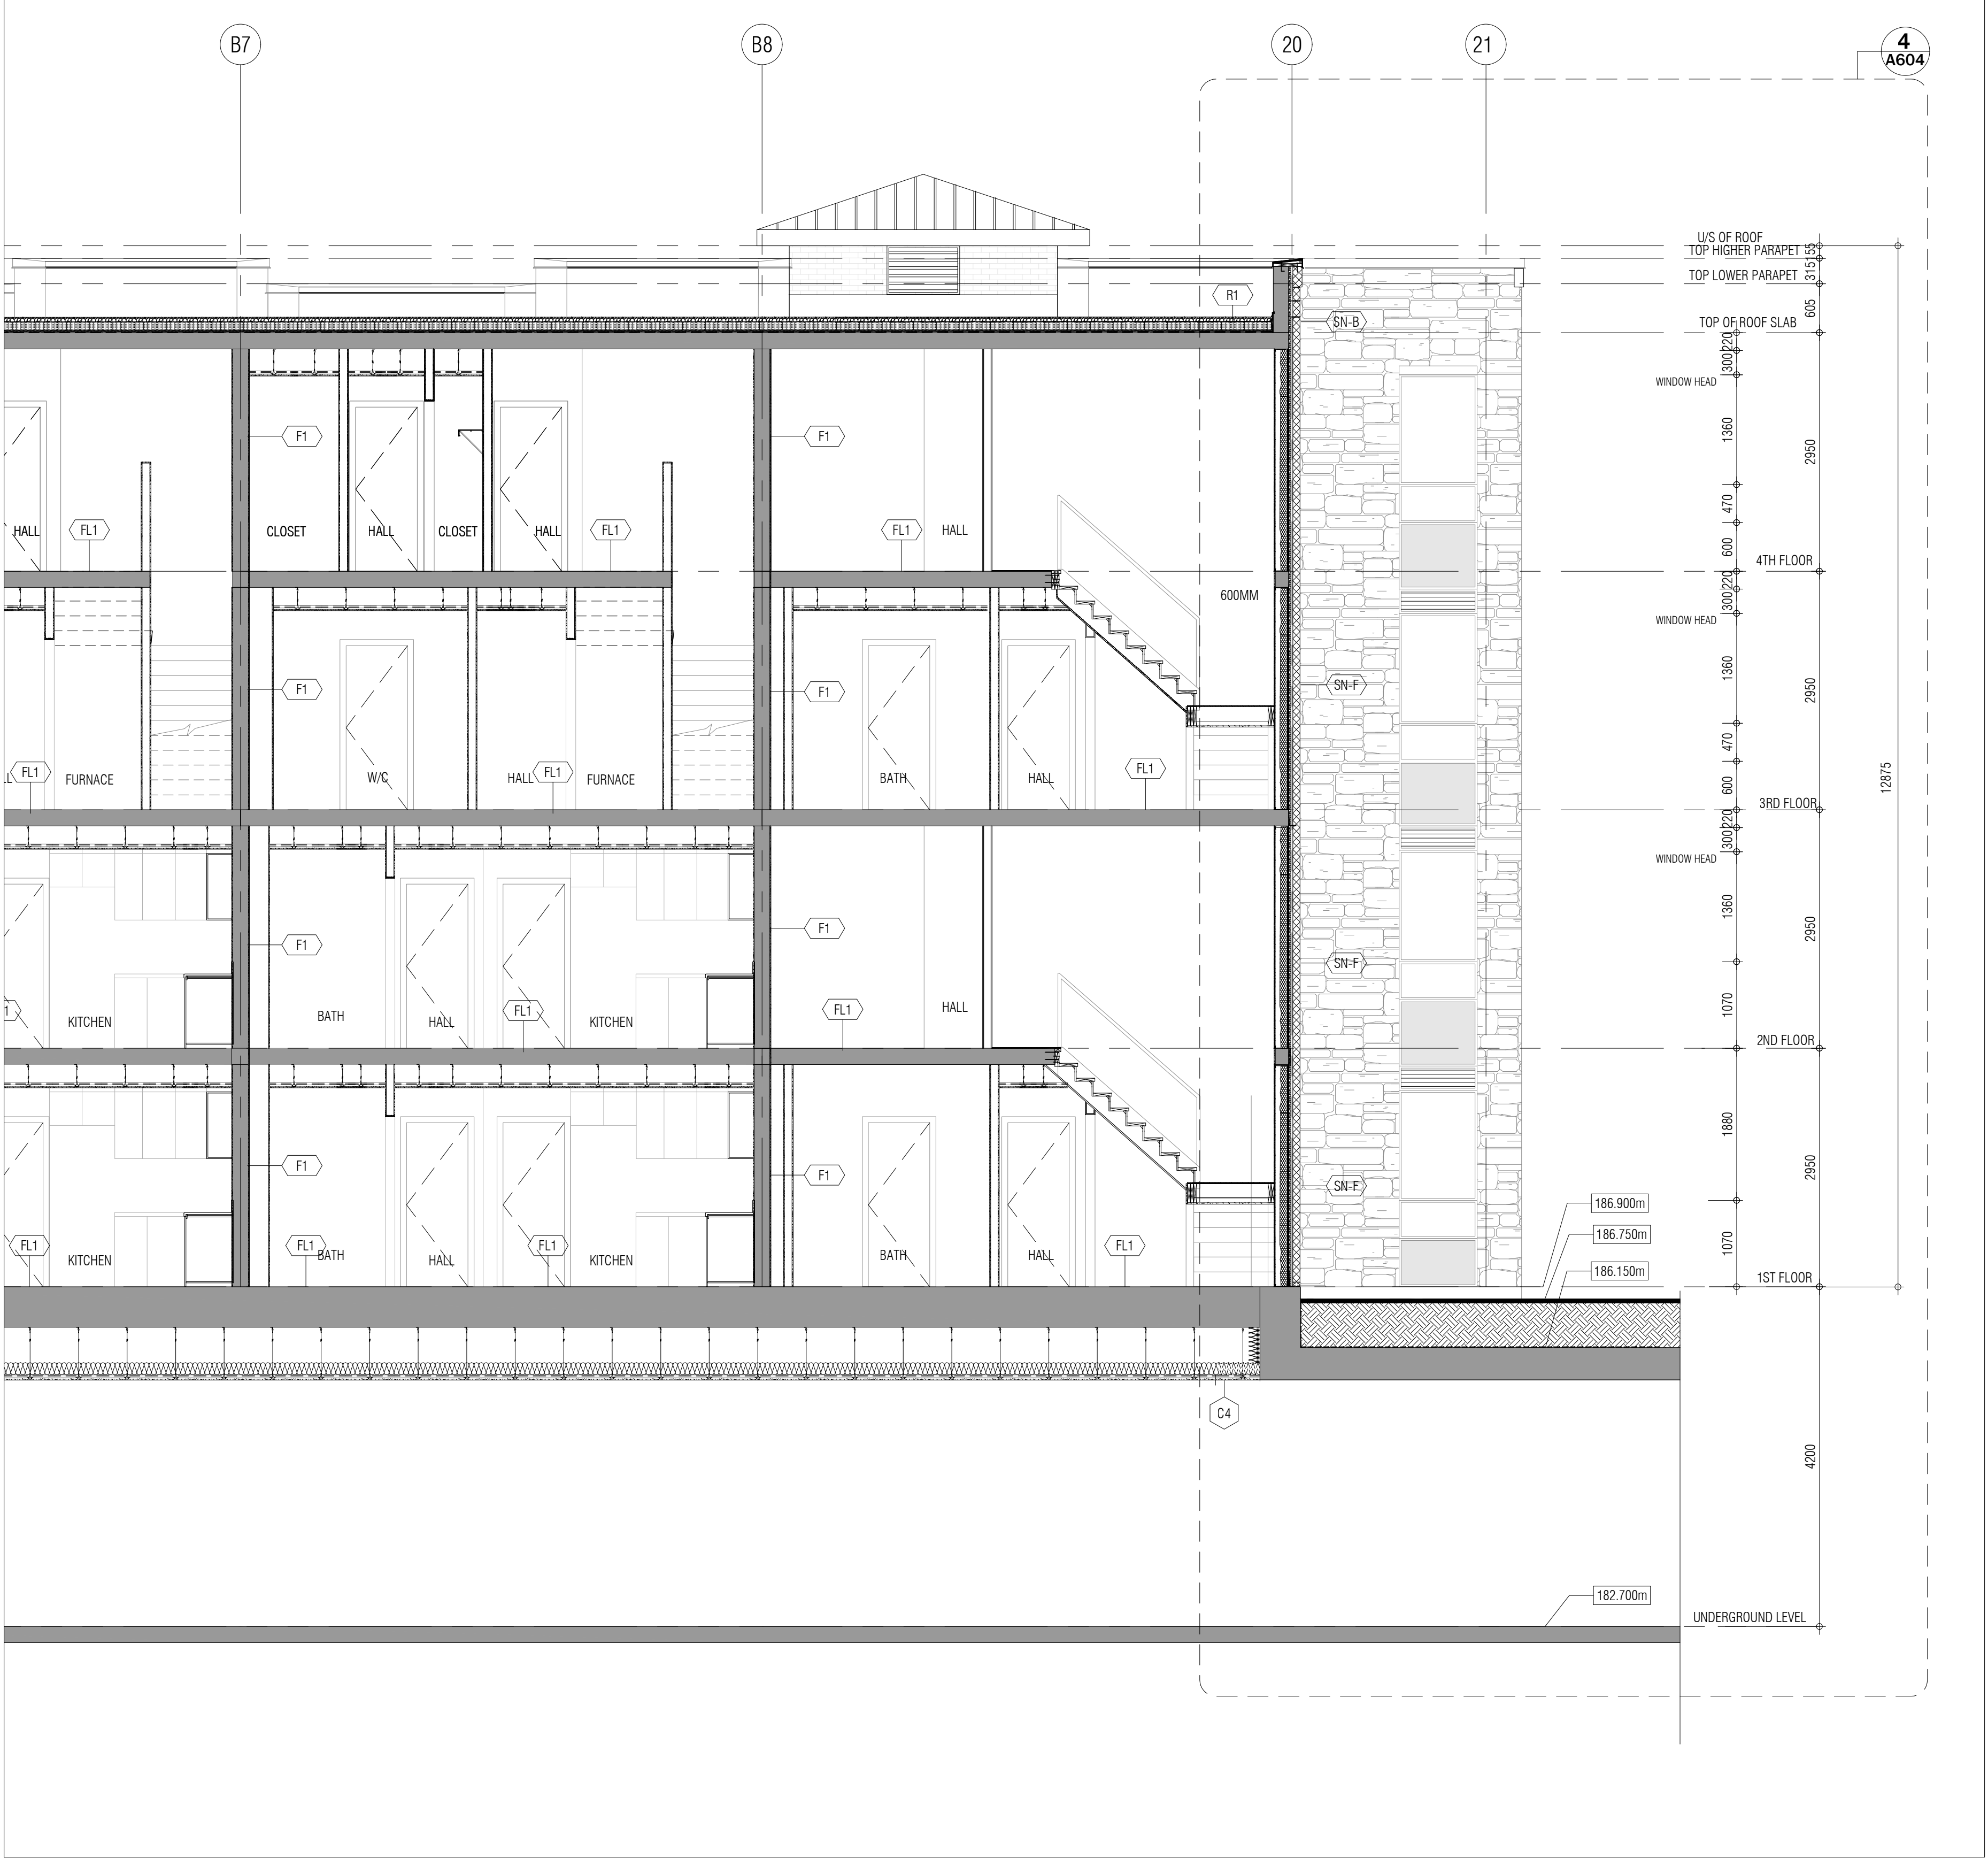

BUILDING SECTION 1  
1:50 A604

- 01. Oct.07.2019 issued for tender
- 02. Mar.13.2020 issued for design coordination #2
- 03. Mar.16.2020 issued for addendum #2
- 04. Mar.16.2020 issued for addendum #3
- 05. Aug.24.2020 issued for addendum #4
- 06. Sept.28.2020 issued for permit
- 07. Oct.20.2020 issued for addendum #5
- 08. Nov.23.2020 issued for addendum #6
- 09. Dec.14.2020 issued for addendum #7
- 10. Jan.18.2021 issued for addendum #8
- 11. Mar.2.2021 issued for permit
- 12. Mar.09.2021 issued for addendum #9
- 13. Mar.10.2021 issued for addendum #9R
- 14. Mar.26.2021 issued for progress
- 15. May.14.2021 issued for Site Instruction #1
- 16. June.15.2021 issued for Site Instruction #2
- 17. July.7.2021 re-issued for permit
- 18. July.15.2021 issued for Site Instruction #3
- 19. July.27.2021 issued for Site Instruction #4
- 20. Aug.3.2021 issued for Site Instruction #5
- 21. Aug.16.2021 issued for Site Instruction #6
- 22. Aug.20.2021 re-issued for permit
- 23. Sept.07.2021 issued for Site Instruction #7
- 24. Sept.09.2021 issued for Site Instruction #8
- 25. Sept.16.2021 issued for Building D Permit Revisions
- 26. Sept.22.2021 issued for Site Instruction #9
- 27. Oct.6.2021 re-issued for permit
- 28. Oct.8.2021 issued for Site Instruction #10
- 29. Oct.28.2021 issued for Site Instruction #11
- 30. Nov.05.2021 issued for Site Instruction #12
- 31. Dec.3.2021 issued for Site Instruction #13
- 32. Dec.6.2021 issued for Site Instruction #14
- 33. Dec.7.2021 issued for Site Instruction #15
- 34. Jan.26.2022 issued for Site Instruction #16
- 35. Jan.31.2022 issued for Site Instruction #17
- 36. Mar.11.2022 issued for Site Instruction #18
- 37. Apr.29.2022 issued for Site Instruction #19
- 38. May.10.2022 issued for Site Instruction #20
- 39. May.24.2022 issued for Site Instruction #21
- 40. Aug.05.2022 issued for I.F.C.
- 41. Aug.18.2022 issued for Site Instruction #22
- 42. Aug.23.2022 issued for Site Instruction #23
- 43. Oct.12.2022 issued for Site Instruction #24
- 44. Feb.6.2023 issued for Site Instruction #25
- 45. Mar.22.2023 issued for Site Instruction #26
- 46. Mar.24.2023 issued for Site Instruction #25r
- 47. Apr.4.2023 issued for Site Instruction #27

- 01. Apr.19.2021 issued to client
- issued for revisions

**GRAZIANI CORAZZA ARCHITECTS**

1370 SHEARWATER DRIVE, SUITE 100 MISSISSAUGA, ONTARIO L4W 1C3  
905.760.2001 P.905.760.2000 WWW.GC-ARCHITECTS.COM

**ATTM&R + PALLESCI DRIVE**

BRAMPTON ONTARIO

PROJECT ARCHITECT: B.GRAZIANI  
ASSISTANT DESIGNER: R.LINCOLN  
DRAWN BY: G.C./F.C./M.B.  
CHECKED BY: D.BIASSE/G.COLANGELO  
PLOT DATE: APR.04.2023  
JOB # 1331.15

BUILDING SECTION