


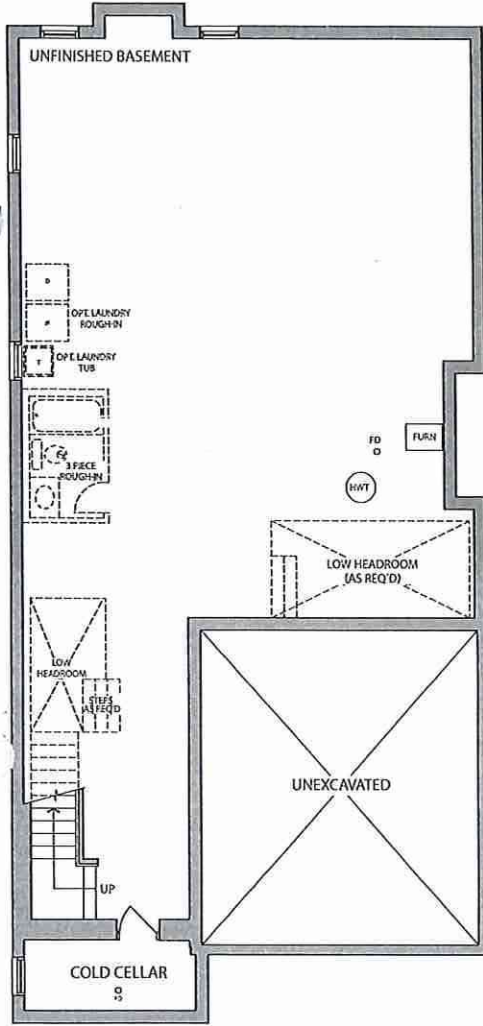


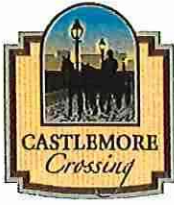

**BASEMENT
ELEV. A**

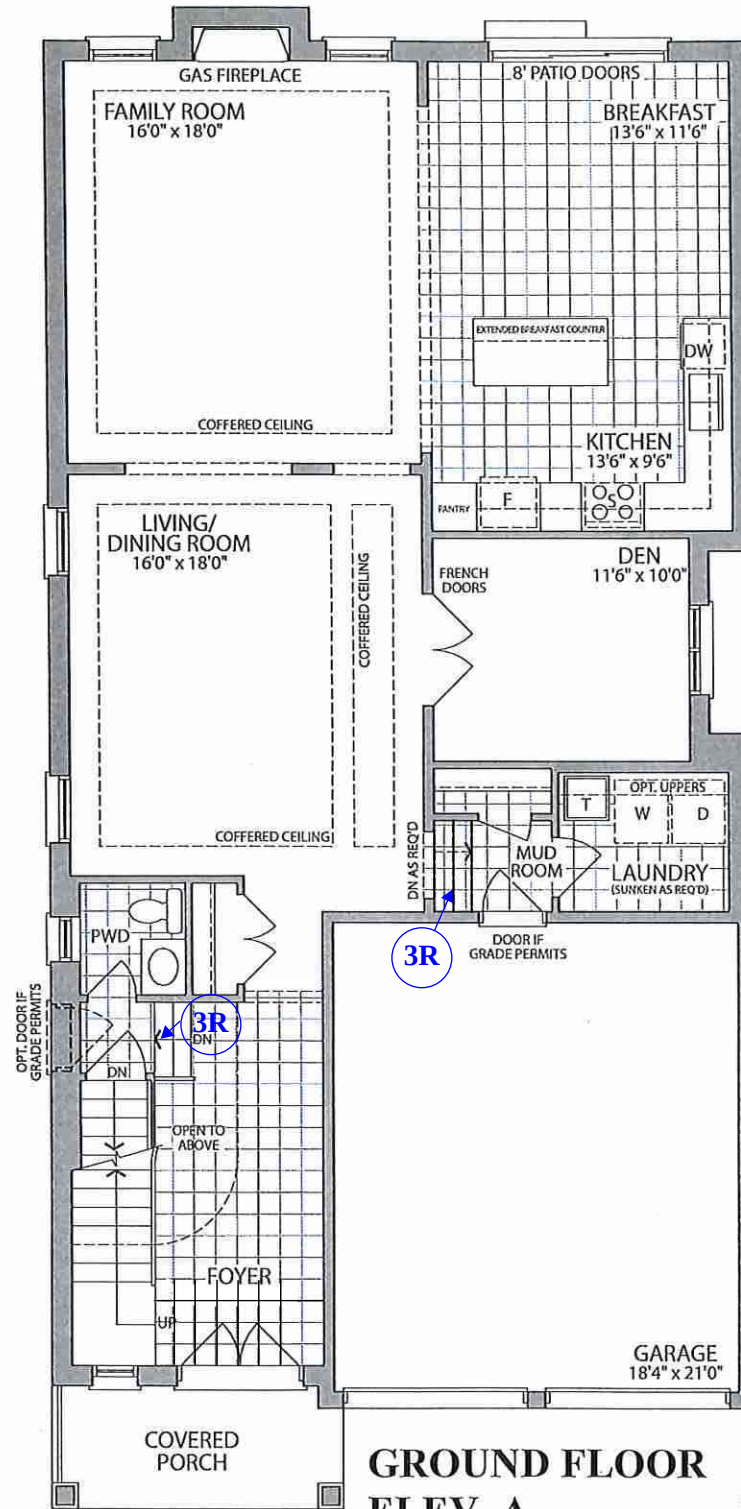

**GROUND FLOOR
ELEV. A**

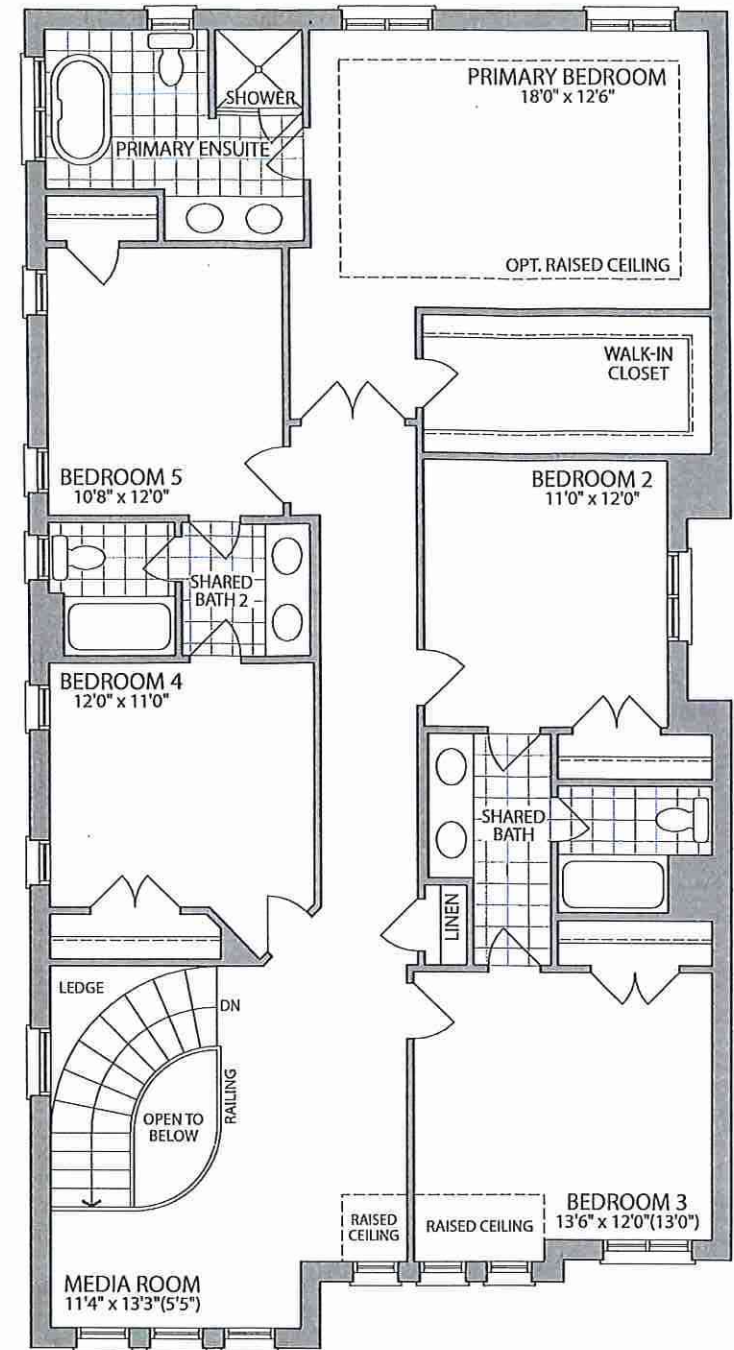

**OPT. SECOND FLOOR
W/ 5 BEDROOMS
ELEV. A**

* Black exterior windows *
added to brick package

Materials, specifications and floor plans are subject to change without notice. All renderings are artist's concept. All floor plans are approximate dimensions. Actual usable floor space may vary from the stated floor area. E.&O.E.

LOT 2 . 38-04 . The Blue Elm . El. A . 5 Bedroom . 3355 SQ. FT.



ELEVATION A
3355
SQUARE FEET

LOT 2

SCHEDULE "B"

Purchaser

DAWOOD DENKHA D DAWOOD

Purchaser

LIDA KHOUSHABA

And

Vendor

Forestside Estates Inc.

Lot Number

2 DOLOMITE DR, Phase 8, Plan as per schedule C
in the CITY of BRAMPTON

Date of Offer

May 25, 2023

Dated Required:

August 08, 2024

Model:

BLUE ELM (38-04A5) - ELEV A - 5 BEDRM ()

Description - Vendor to Supply and Install the Following as Per Purchase Price

- BONUS PACKAGE -PURCHASER TO RECEIVE \$20,000 (INCLUSIVE OF TAXES) WORTH OF UPGRADES AT DECOR CENTRE AT TIME OF COLOUR CHART