


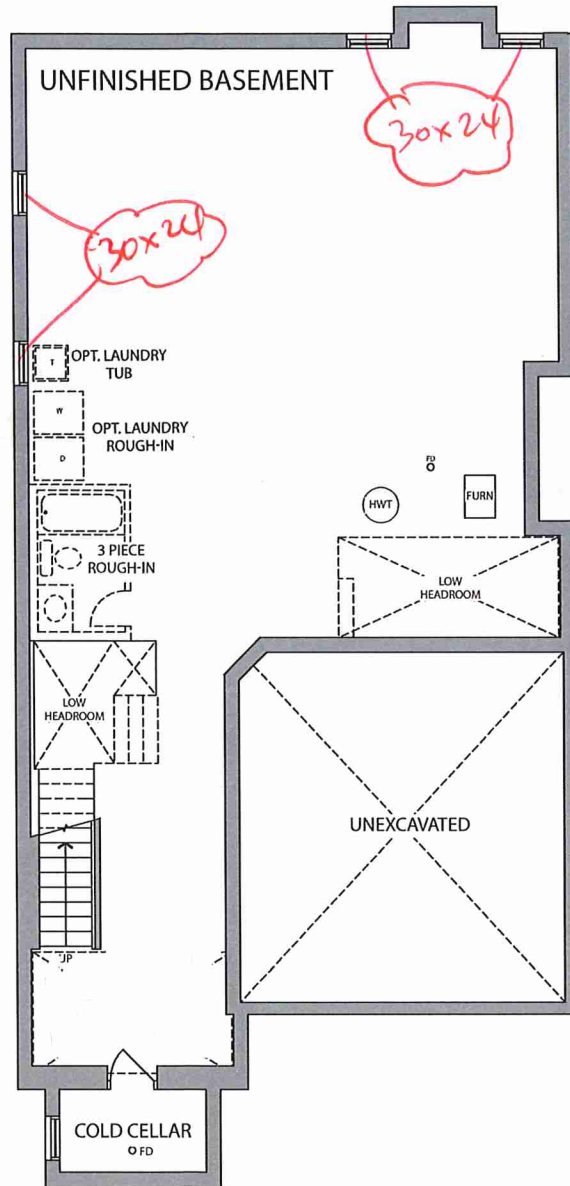


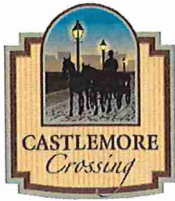

BASEMENT ELEV. B

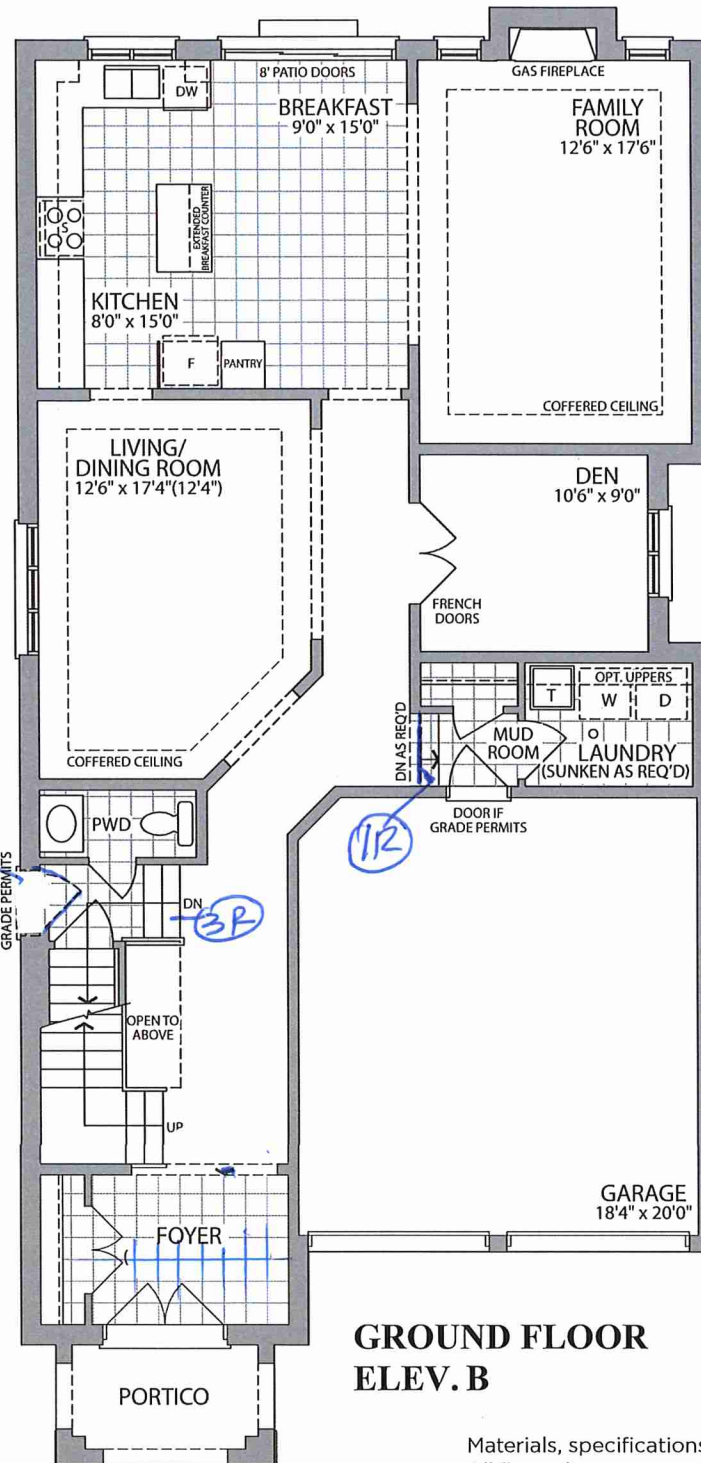

**GROUND FLOOR
ELEV. B**

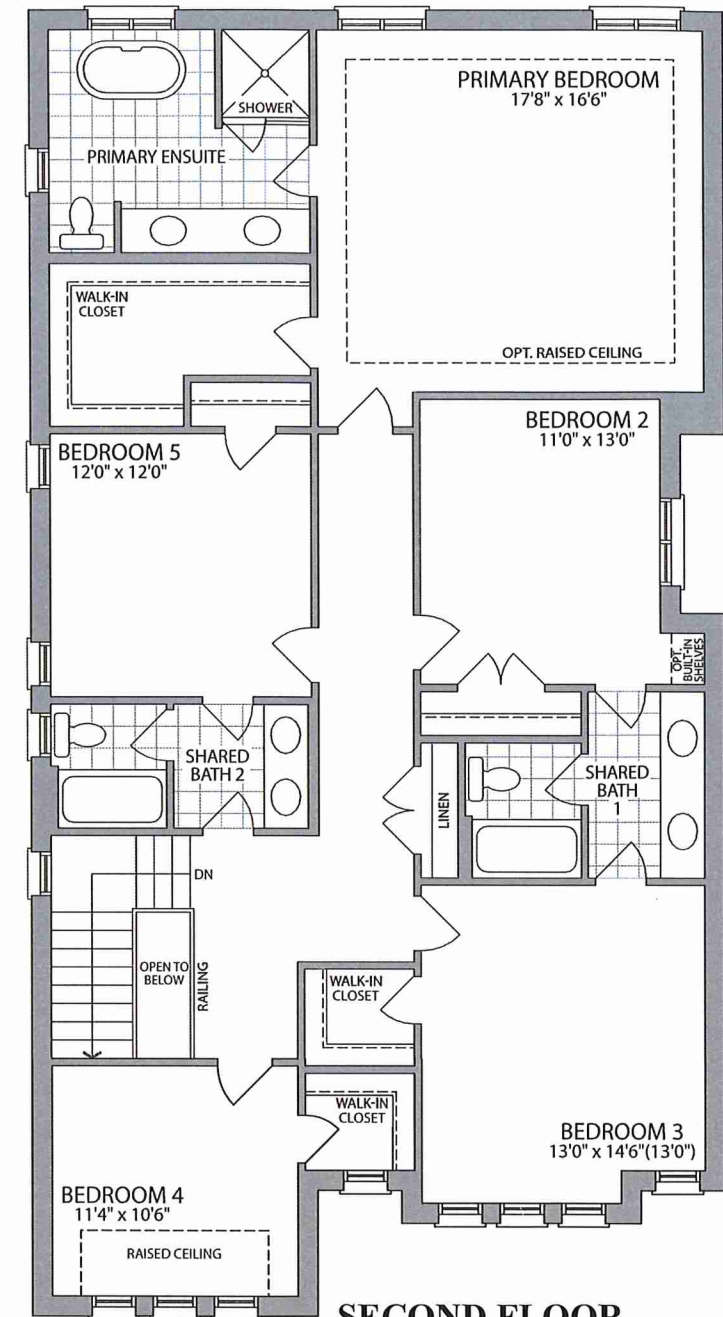


**SECOND FLOOR
ELEV. B**

Materials, specifications and floor plans are subject to change without notice. All renderings are artist's concept. All floor plans are approximate dimensions. Actual usable floor space may vary from the stated floor area. E.&O.E.

LOT 12. 38-03 . The Blue Elder. EL. B. 5 Bedroom . 3210 .SQ. FT.



THE BLUE ELDER (38-03)

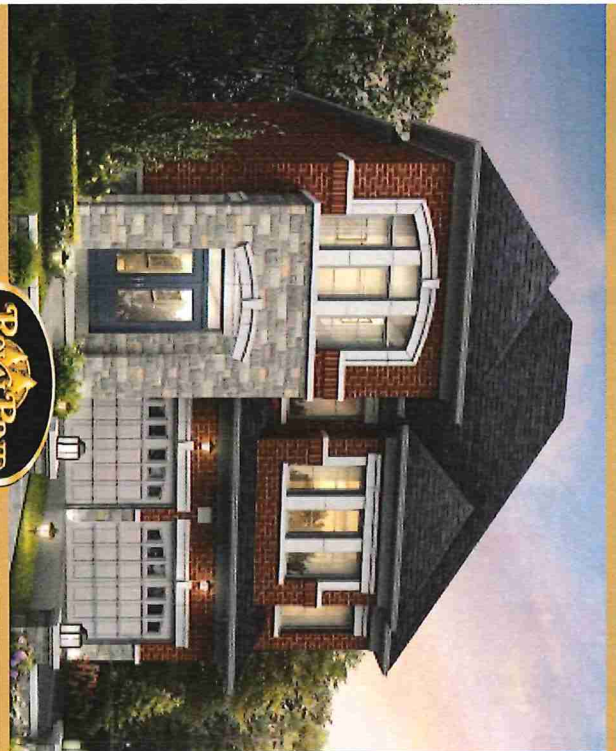

ELEVATION B

38' LOT 12 3210 SQUARE FEET

LOT 12 . 38-03 . The Blue Elder. El. B. 5 Bedroom .3210 . SQ.FT.