

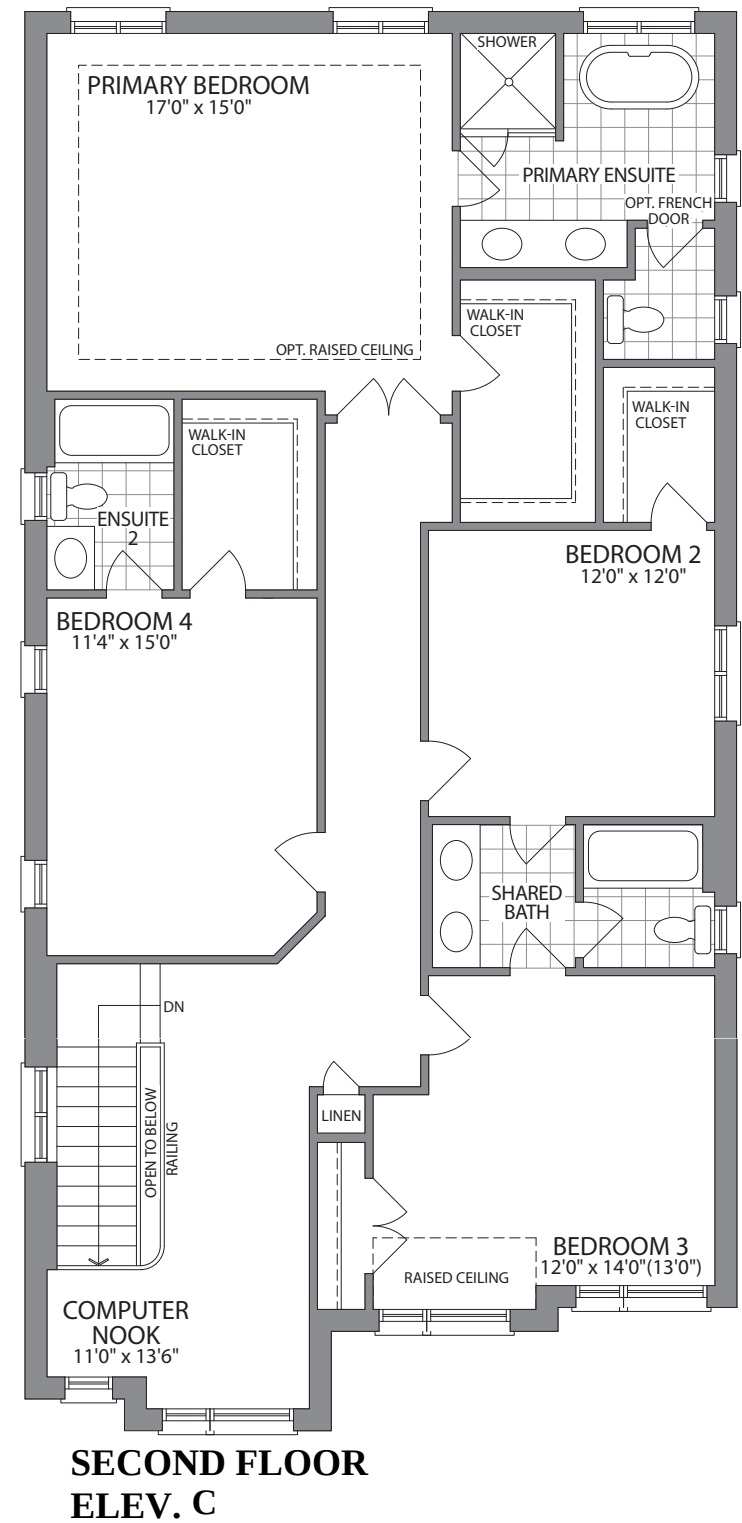
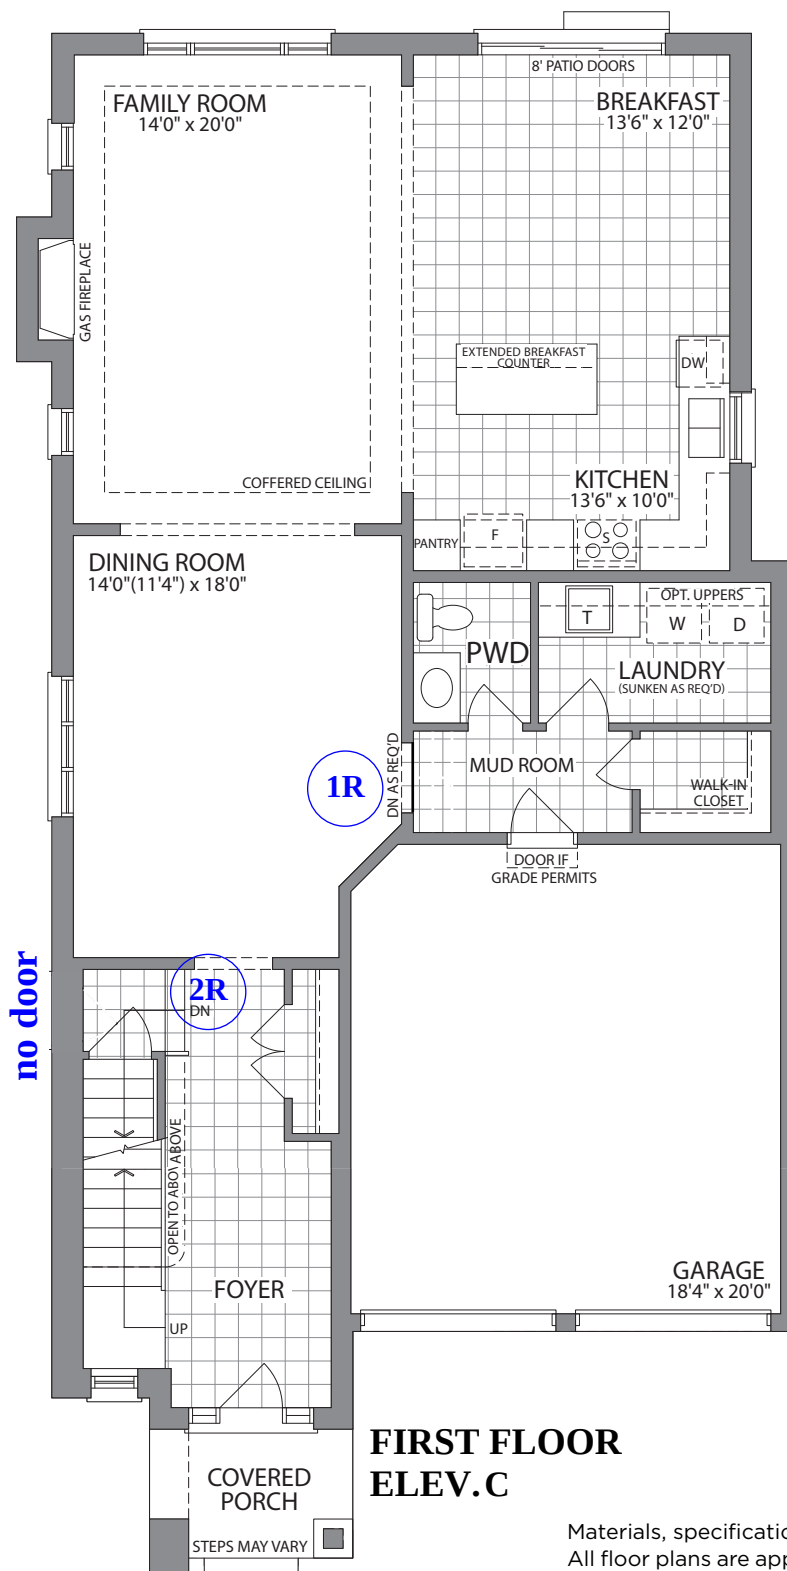


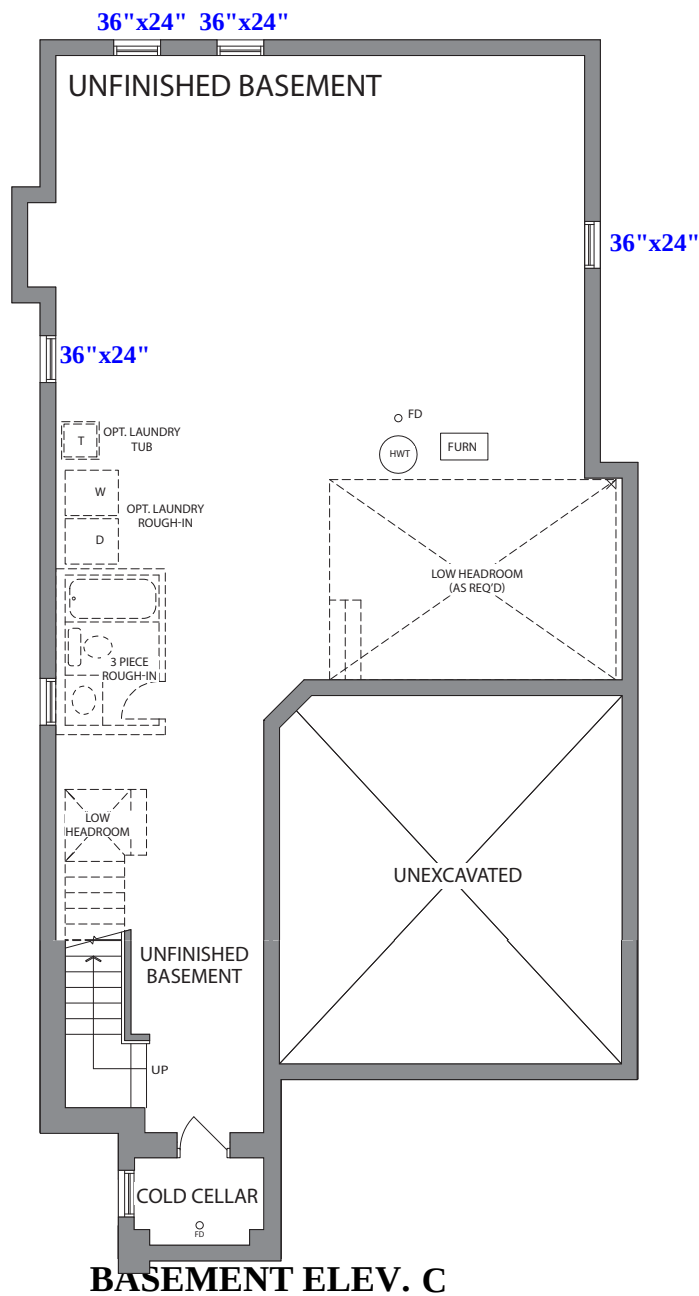

Materials, specifications and floor plans are subject to change without notice. All renderings are artist's concept. All floor plans are approximate dimensions. Actual usable floor space may vary from the stated floor area. E.&O.E.

LOT 12. 38-02. The Blue Dawn . El. C. 4 Bedroom . 3075 SQ. FT.

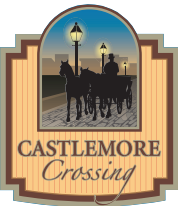

THE BLUE DAWN (38-02)



ELEVATION C

38'

LOT 12

3075

SQUARE FEET

LOT 12. 38-02 . The Blue Dawn . El. C. 4 Bedroom . 3075 SQ. FT. .