



3550 LANGSTAFF ROAD, SUITE 200
WOODBIDGE, ONTARIO L4L 9G3
TEL: (905) 856-2150 • (416) 213-7181
FAX: (905) 856-6543

RELEASE ORDER

DATE: JUNE 26 24

TO:

PENEAL TRIM

SHIP TO:

GROVERAIL PH.#2



LOT NUMBER #144

PLEASE RELEASE CONTRACT ITEMS:	QUANTITY	PRICE	AMOUNT
DESCRIPTION: Lot# 144			
*DELETE @ CREDIT *			
① DEN - DELETE TRIMMED ARCH			
② FOYER TO MAIN HALL DELETE TRIMMED ARCH			
③ DINING TO KITCHEN DELETE TRIMMED ARCH			
④ MASTER BEDROOM BOTH. W.I.C			
DELETE DOORS/TRIM			
⑤ Livingrm - Delete Trimmed Arch			

No 000320

DO NOT INVOICE SEPARATELY;
INCLUDED IN CONTRACT AMOUNT

Authorized Signature

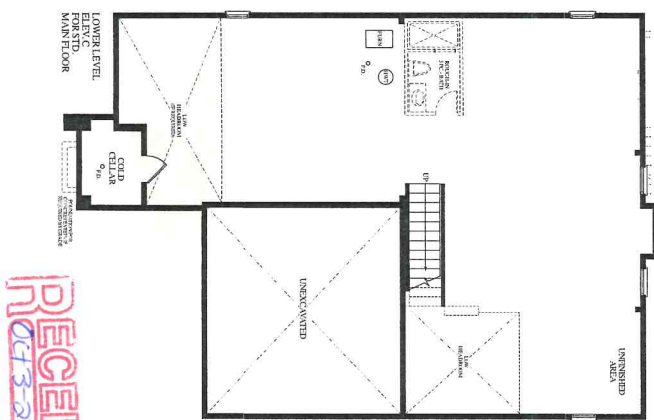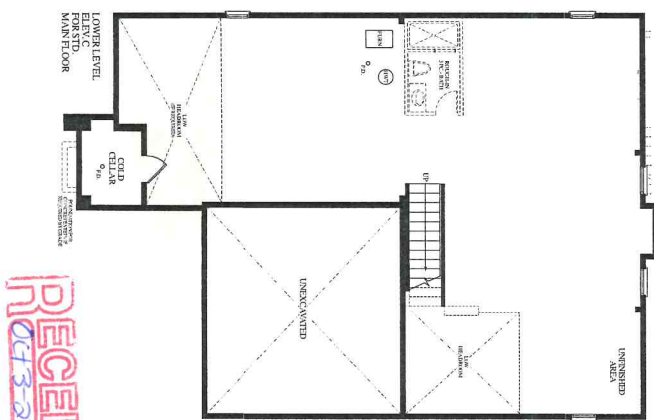

**LOT 144 . 45-04 - DUNCAN .STD. MAIN / 4 BEDROOM
EL C . 3225 Sq. Ft.**