



Structural

PURCHASER'S EXTRAS QUOTATION

Oak Ridge Meadows - Phase 3

PURCHASER: CHENGBO LIANG

TEL:

LOT NUMBER	PHASE	HOUSE TYPE
57 BLOCK 232	3	2007 LAWRENCE-OPTIONAL 2ND LEVEL-ELEV B1

ITEM	EXTRA / CHANGE	QTY	UNIT PRICE	EXTENDED
1	PURCHASER HAS ATTENDED A STRUCTURAL APPOINTMENT AT THE DESIGN STUDIO ON JANUARY 22, 2025 AND HAS DECLINED ANY ADDITIONAL UPGRADES	1		
230665				

Sub Total

HST

Total

- In the event the work on the house has progressed beyond the point where the items covered by this extra cannot be installed without entailing any unusual expense, then this order is to be cancelled and any deposit paid in connection with the same is to be refunded to the Purchaser.
- The Vendor will undertake to incorporate the work covered by the sales extra in the construction of the house but will not be liable to the purchaser in any way, if for any reason the work covered by the extra is not carried out. In that event, any monies paid in connection with the same shall be returned to the Purchaser.
- It is understood and agreed that if for any reason whatsoever the transaction of Purchase and Sale is not completed, the total cost of extras ordered are not refundable to the Purchaser(s).
- Extras or changes will not be processed unless signed by the Vendor.
- These extras may not be amended without the written consent of Grovetrail Developments Inc..
- The Purchaser(s) and the Vendor acknowledge and agree that this form shall not be deemed to be part of the Agreement of Purchase and Sale entered into between them, nor an addendum thereto.
- No Estimates or orders will be accepted once construction has commenced.
- Prices are estimates only and guaranteed for a period of 5 days only.
- Any cancellations to this order, providing they can be cancelled, are subject to a \$500 minimum administration charge and a 10% cancellation charge for the total amount being cancelled.
- For Visa, Mastercard and Debit payments, transactions are identified on you statement as "SHERWAY CONSTRUCTION LTD", an Authorized Visa /Mastercard/Debit Merchant and authorized Royal Pine Homes company.

Payment Summary

<u>Paid By</u>	<u>Amount</u>
<u>Total Payment:</u>	

Bonus Summary

Bonus Package offering (includes taxes) from Royal Pine Homes Décor Centre is being applied to this order.

Any remaining balance(s) will be applied accordingly to extras purchased.

Bonus Package Offering

<u>Invoice Number</u>	<u>Date</u>	<u>Amount</u>
-----------------------	-------------	---------------

Total Bonus Used:

Remaining Balance:

PURCHASER:

CHENGBO LIANG

22-Jan-25
DATE

VENDOR:

PER: Grovetrail Developments Inc.


TAX#:1

PREPARED BY: Laura Di Pede
PRINTED: 22-Jan-25 at 10:06 am
RoyInvoiceSQL.rpt 07aug20

CONSTRUCTION SCHEDULING APPROVAL


PER: _____

DATE: _____

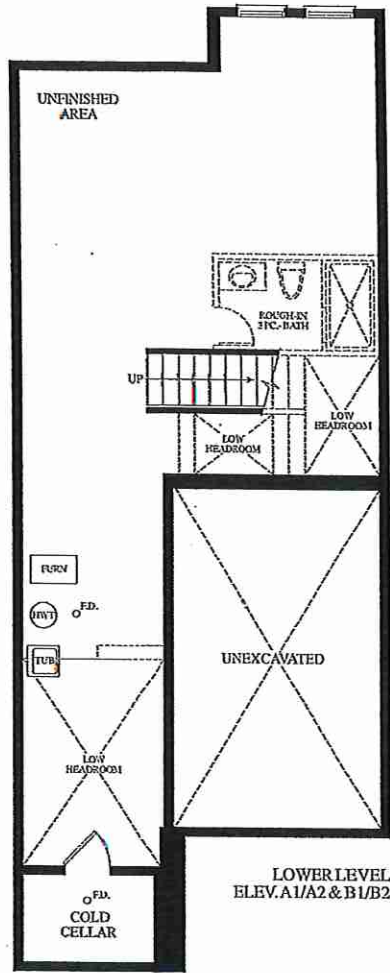

28" FLOATING VANITY

42"

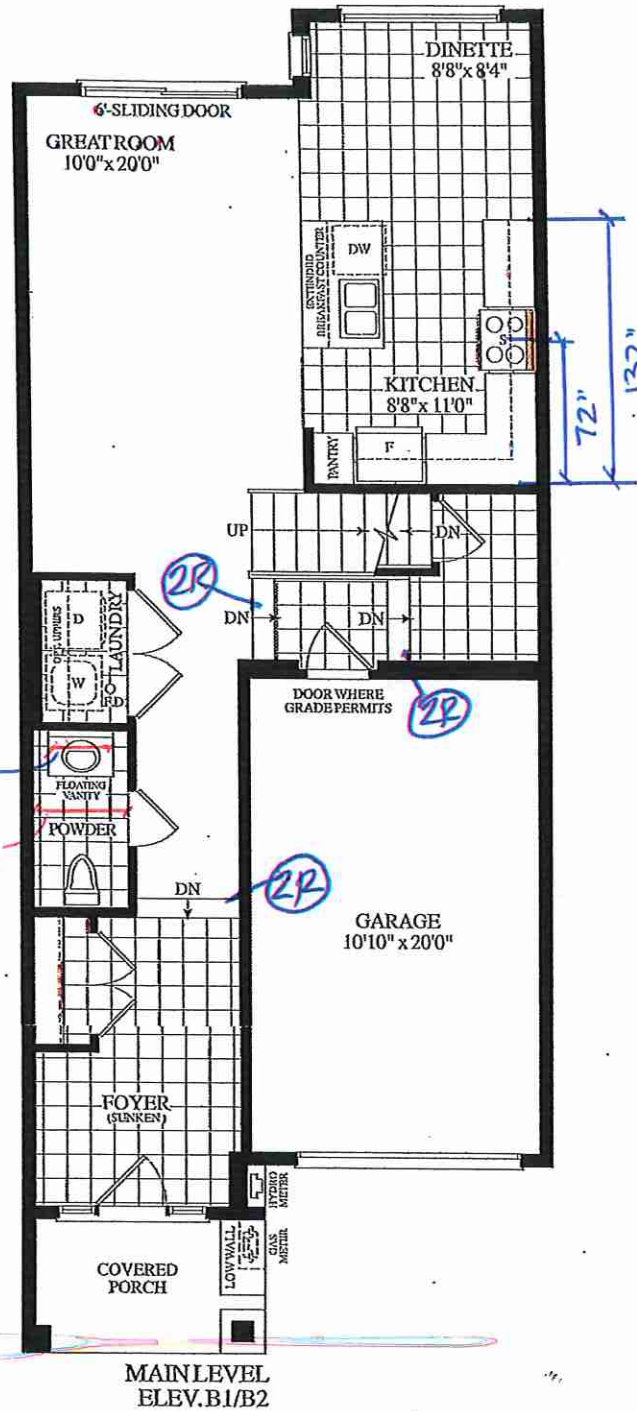


8"

40"

34"

34"

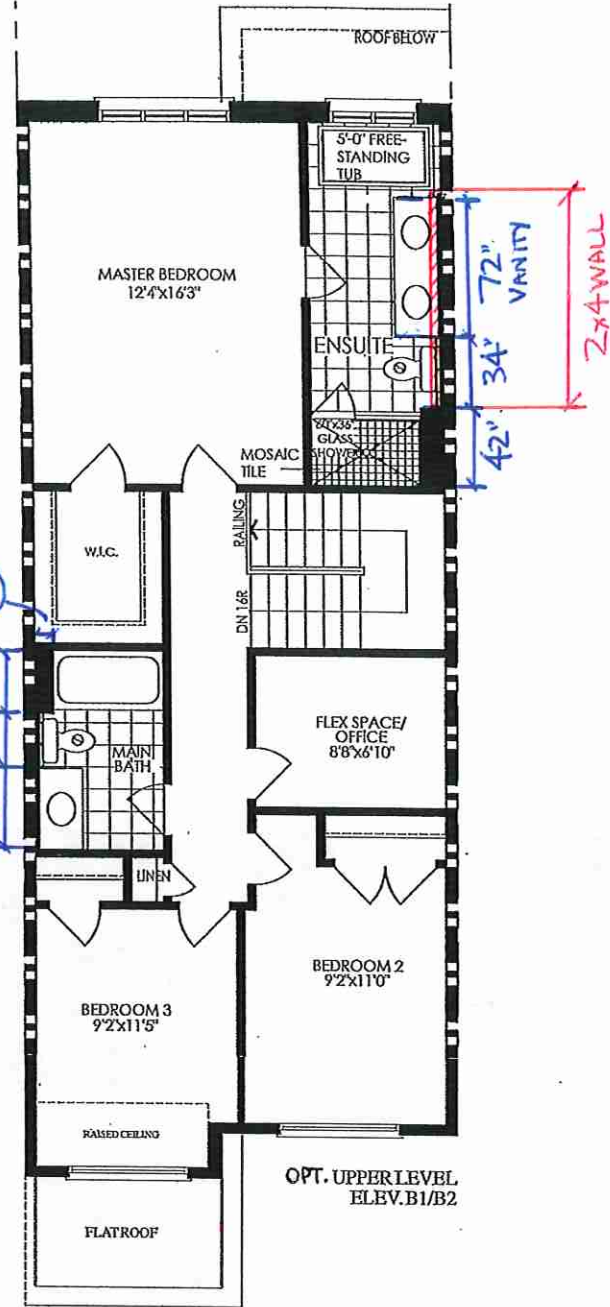

72" VANITY

34"

42"

2' x 4' WALL

1'08"