



Structural

PURCHASER'S EXTRAS QUOTATION

Mayfield Village - Phase 1

PURCHASERS: JASVINDER SINGH KHAIRA and SIMARDEEP KAUR KHAIRA

TEL: RES.: 778-552-0245

LOT NUMBER		PHASE	HOUSE TYPE
022 BLOCK 292		1	DESERT ROSE (25-01-A1) ELEV A1
ITEM EXTRA / CHANGE			
		QTY	UNIT PRICE EXTENDED
1	BASEMENT - Install UPGRADE 200 AMP SERVICE in lieu of builders standard 100 Amp Service (See Sketch)	1	
231036	**Remaining Bonus Package of \$8,135.50 (Includes Taxes) will be applied to upgrades completed during decor appointment**		
2	BONUS PACKAGE - PURCHASER HAS APPLIED \$10,000.00 (Includes Taxes) WORTH OF UPGRADE PROMOTIONAL PACKAGE TOWARDS THE PURCHASE OF STRUCTURAL UPGRADES COMPLETED AT THE DECOR CENTRE	1	
231037			
3	PURCHASER HAS ATTENDED A STRUCTURAL APPOINTMENT AT THE DESIGN STUDIO & HAS DECLINED ANY ADDITIONAL UPGRADES. Purchaser accepts & acknowledges that there will be no further structural changes/additions/deletions to be made upon signing on FEBRUARY 4, 2025	1	
231038			
4	PURCHASER AWARE AND ACCEPTS THAT ANY CHANGES MADE TO UPGRADES AFTER SIGNING THIS PURCHASERS EXTRA FORM ARE SUBJECT TO A MINIMUM ADMINISTRATION FEE OF \$1,000	1	
231039			



Sub Total
HST
Total

1. In the event the work on the house has progressed beyond the point where the items covered by this extra cannot be installed without entailing any unusual expense, then this order is to be cancelled and any deposit paid in connection with the same is to be refunded to the Purchaser.
2. The Vendor will undertake to incorporate the work covered by the sales extra in the construction of the house but will not be liable to the purchaser in any way, if for any reason the work covered by the extra is not carried out. In that event, any monies paid in connection with the same shall be returned to the Purchaser. It is understood and agreed that if for any reason whatsoever the transaction of Purchase and Sale is not completed, the total cost of extras ordered are not refundable to the Purchaser(s).
3. Extras or changes will not be processed unless signed by the Vendor.
4. These extras may not be amended without the written consent of Summer Ridge Estates Inc..
5. The Purchaser(s) and the Vendor acknowledge and agree that this form shall not be deemed to be part of the Agreement of Purchase and Sale entered into between them, nor an addendum thereto.
6. No Estimates or orders will be accepted once construction has commenced.
7. Prices are estimates only and guaranteed for a period of 5 days only.
8. Any cancellations to this order, providing they can be cancelled, are subject to a \$500 minimum administration charge and a 10% cancellation charge for the total amount being cancelled.
9. For Visa, Mastercard and Debit payments, transactions are identified on you statement as "SHERWAY CONSTRUCTION LTD", an Authorized Visa /Mastercard/Debit Merchant and authorized Royal Pine Homes company.
- 10.

Payment Summary	
Paid By	Amount
Bonus from Sales Cc:	
Bonus from Sales Cc:	
Total Payment:	

Bonus Summary	
Bonus Package offering (includes taxes) from Royal Pine Homes Décor Centre is being applied to this order.	
Any remaining balance(s) will be applied accordingly to extras purchased.	
Bonus Package Offering	
Invoice Number	Date
8720	Amount
8720	
Total Bonus Used:	
Remaining Balance:	

TAX# 1




PREPARED BY: Melissa Di Marino
PRINTED: 4-Feb-25 at 2:24 pm
Roy/InvoicesSQL-rpt 07aug20

Initials: DS JS SK Initial JS SK

CONSTRUCTION SCHEDULING APPROVAL	
PER:	
DATE:	



Materials, specifications and floor plans are subject to change without notice. All renderings are artist's concept. All floor plans are approximate dimensions. Actual usable floor space may vary from the stated floor area. E.&O.E.

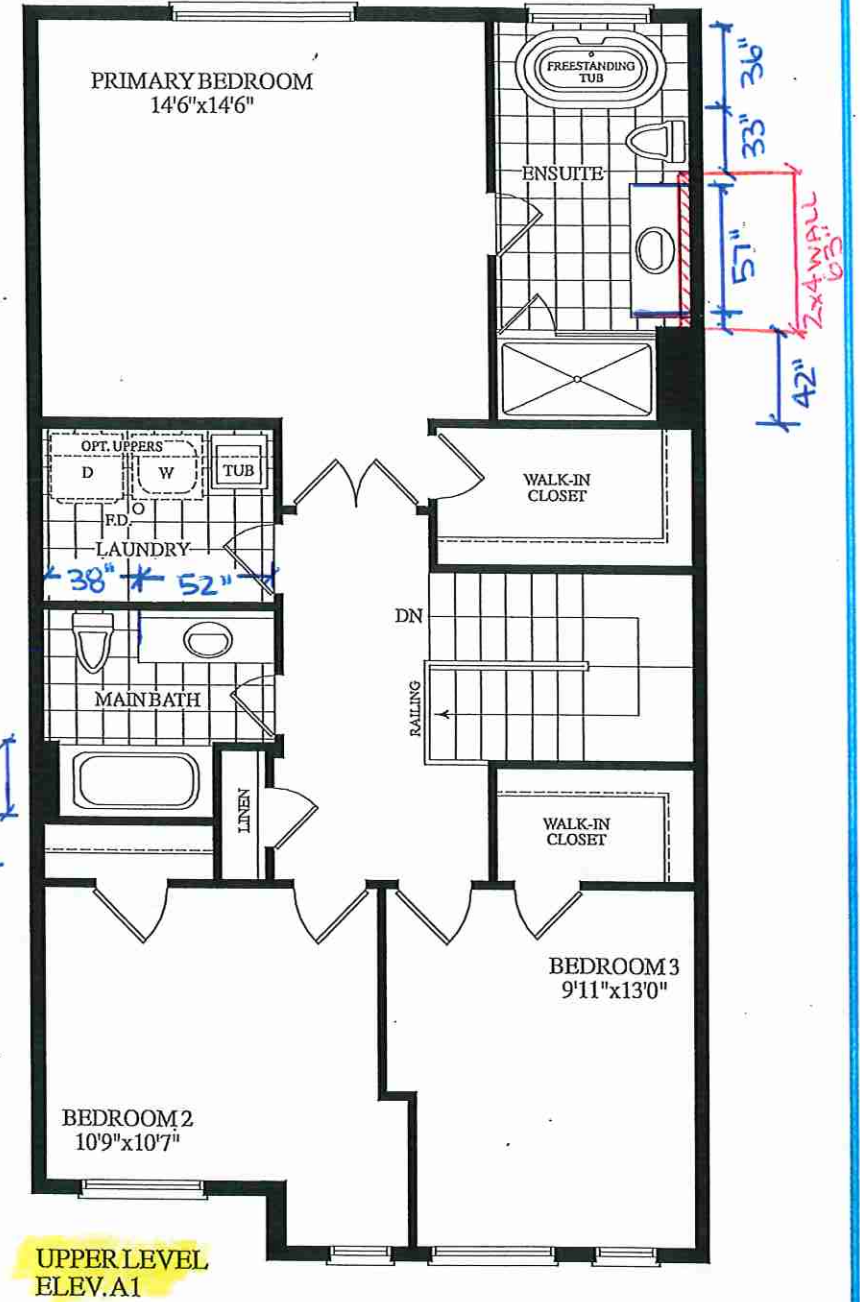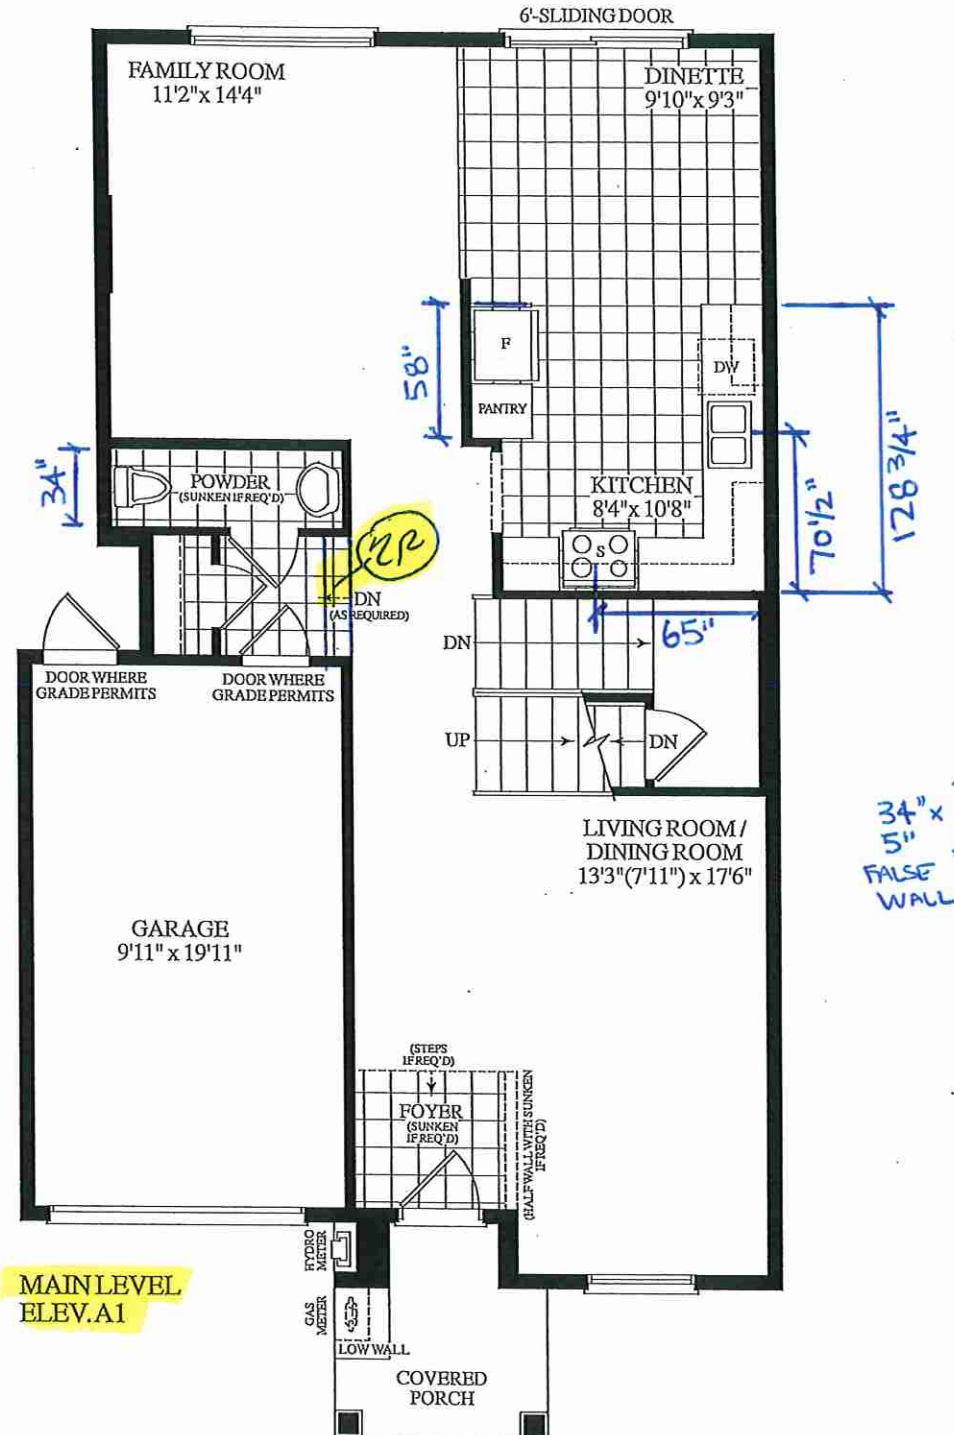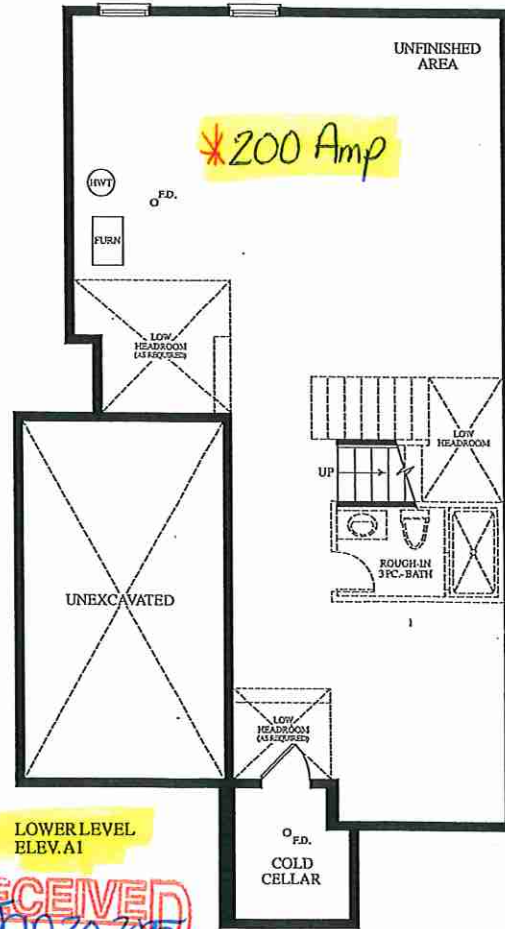

BLOCK 292 - TH.22 25-01 DESERT ROSE EL.A1 3 BEDROOM 2045 SQ. FT.