

## PURCHASER'S EXTRAS QUOTATION Oak Ridge Meadows - Phase 3

PURCHASER: CASSANDRA CHLOE FLOROFF

TEL:

LOT NUMBER	PHASE	HOUSE TYPE
70 BLOCK 235	3	LAWSON-OPTIONAL 2ND LEVEL-A2

ITEM	EXTRA / CHANGE	OTY	UNIT PRICE	EXTENDED
1	BASEMENT- Install 200Amp service in lieu of the standard	1		
232602				
2	PURCHASER AWARE AND ACCEPTS THAT ANY CHANGES MADE TO UPGRADES AFTER SIGNING THIS PURCHASERS EXTRA FORM ARE SUBJECT TO A MINIMUM ADMINISTRATION FEE OF \$1,000	1	-	
232603				
3	PURCHASER HAS ATTENDED A STRUCTURAL APPOINTMENT AT THE DESIGN STUDIO AND HAS DECLINED ANY ADDITIONAL UPGRADES	1		
232604				
4 232605	BONUS PACKAGE-PURCHASER TO RECEIVE \$7,500 (INCLUSIVE OF TAXES) WORTH OF UPGRADES AT THE DESIGN STUDIO AT TIME OF COLOUR CHART BONUS PACKAGE-PURCHASER HAS A REMAINING \$5,635.50 (INCLUSIVE OF TAXES	1	***	
	WORTH OF UPGRADES AT THE DESIGN STUDIO AT TIME OF COLOUR CHART			



Sub Total HST Total

- In the event the work on the house has progressed beyond the point where the items covered by this extra cannot be installed without entailing any unusual
- expense, then this order is to be cancelled and any deposit paid in connection with the same is to be refunded to the Purchaser.

  The Vendor will undertake to incorporate the work covered by the sales extra in the construction of the house but will not be liable to the purchaser in any way, if for any reason the work covered by the extra is not carried out. In that event, any monies paid in connection with the same shall be returned to the Purchaser.

  It is understood and agreed that if for any reason whatsoever the transaction of Purchase and Sale is not completed, the total cost of extras ordered are not
- refundable to the Purchaser(s).
- Extras or changes will not be processed unless signed by the Vendor.
- These extras may not be amended without the written consent of Grovetrail Developments Inc.
- The Purchaser(s) and the Vendor acknowledge and agree that this form shall not be deemed to be part of the Agreement of Purchase and Sale entered into between them, nor an addendum thereto.
- No Estimates or orders will be accepted once construction has commenced.
- Prices are estimates only and guaranteed for a period of 5 days only.
- Any cancellations to this order, providing they can be cancelled, are subject to a \$500 minimum administration charge and a 10% cancellation charge for the total amount being cancelled.
- For Visa, Mastercard and Debit paments, transactions are identified on you statement as "SHERWAY CONSTRUCTION LTD", an Authorized Visa /Mastercard/Debit Merchant and authorized Royal Pine Homes company.

ount

## Bonus Package offering (includes taxes) from Royal Pine Homes Décor Centre is being applied to this order.

Any remaining balance(s) will be applied accordingly to extras purchased.

Bonus Package Offering

Invoice Number

Bonus Summary

Date

Amount

8745


Total Bonus Used:


Remaining Balance:


TAX#:1


PREPARED BY: Laura Di Pede PRINTED: 3-Mar-25 at 2:21 pm

RoyInvoiceSQL.rpt 07aug20

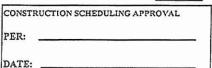

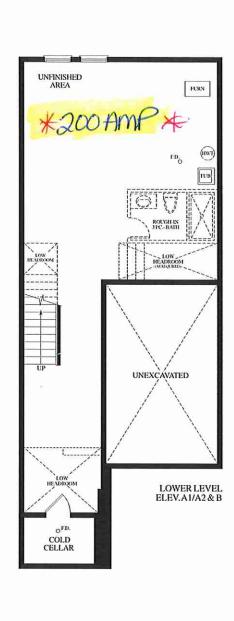

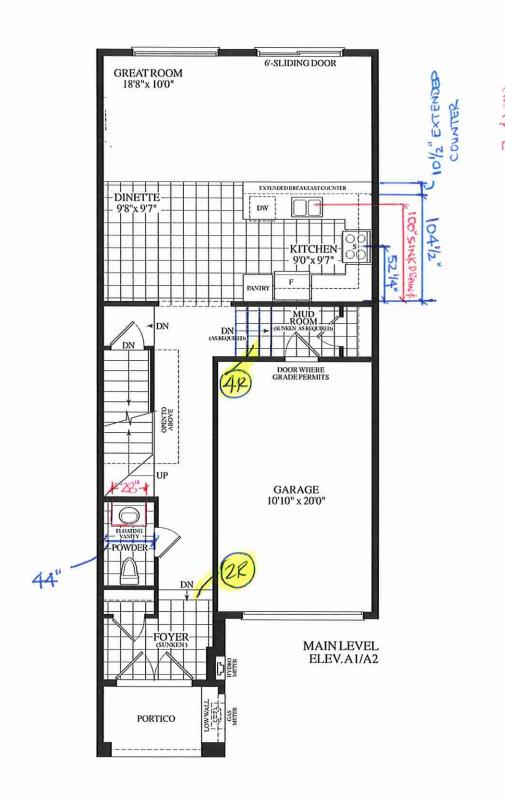

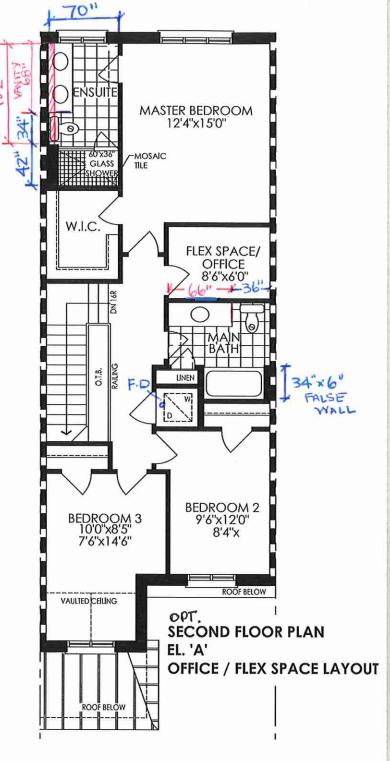

©AKRIDGE MEADOWS