


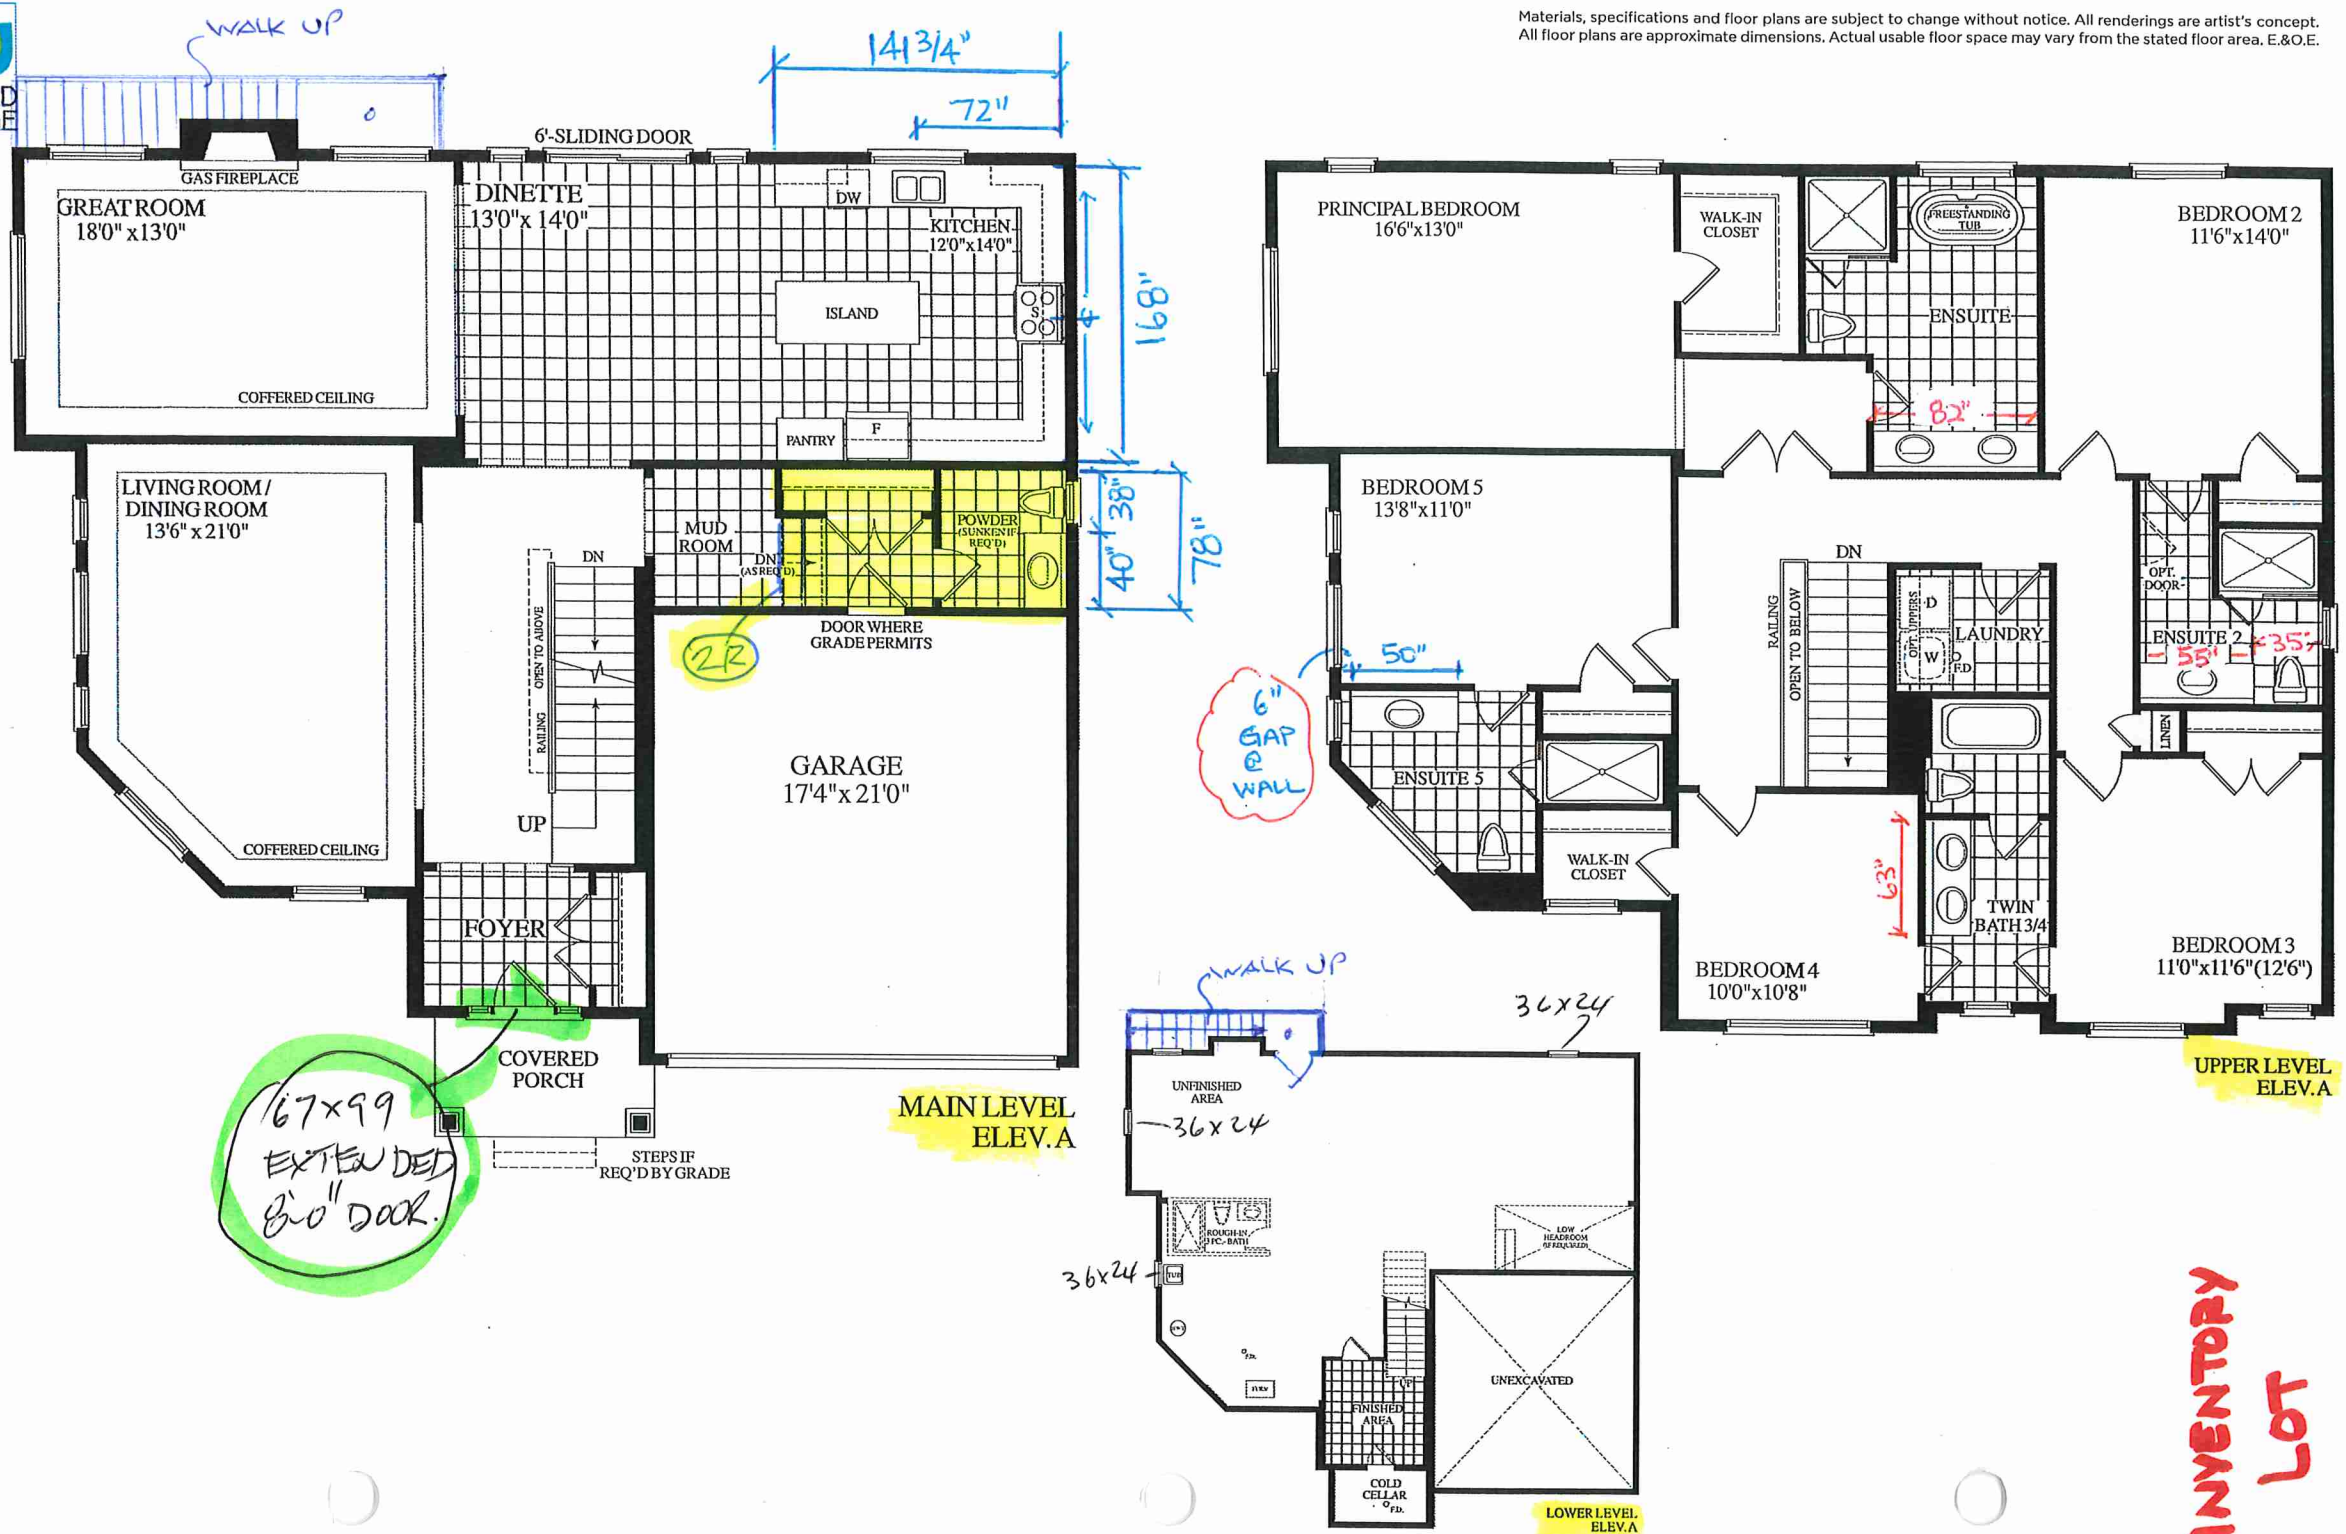

Materials, specifications and floor plans are subject to change without notice. All renderings are artist's concept. All floor plans are approximate dimensions. Actual usable floor space may vary from the stated floor area. E.&O.E.




Inventory Lot

LOT 100 41-00 THE WISTERIA EL. A 5 BEDROOM 2165 SQ.FT.

40' LOTS

THE WISTERIA

(41-00)

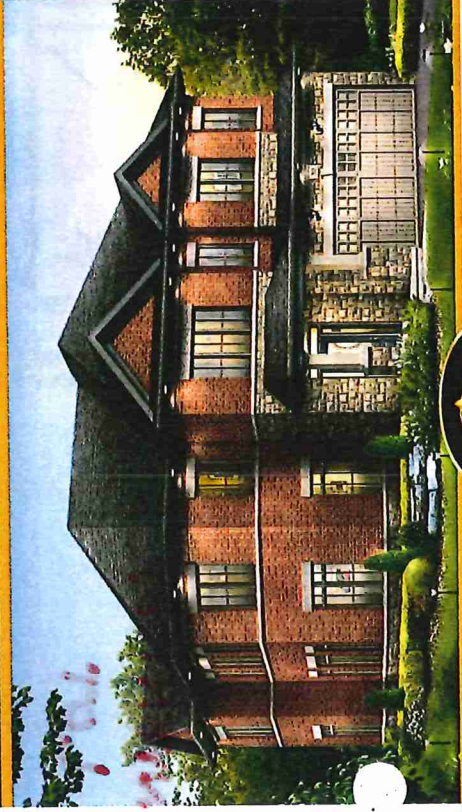

ELEVATION A

3210

SQUARE FEET