


GROUND TO SECOND
122" HT 11-7/8" JOIST

BASEMENT TO GROUND
BSMT 11-7/8" JOIST

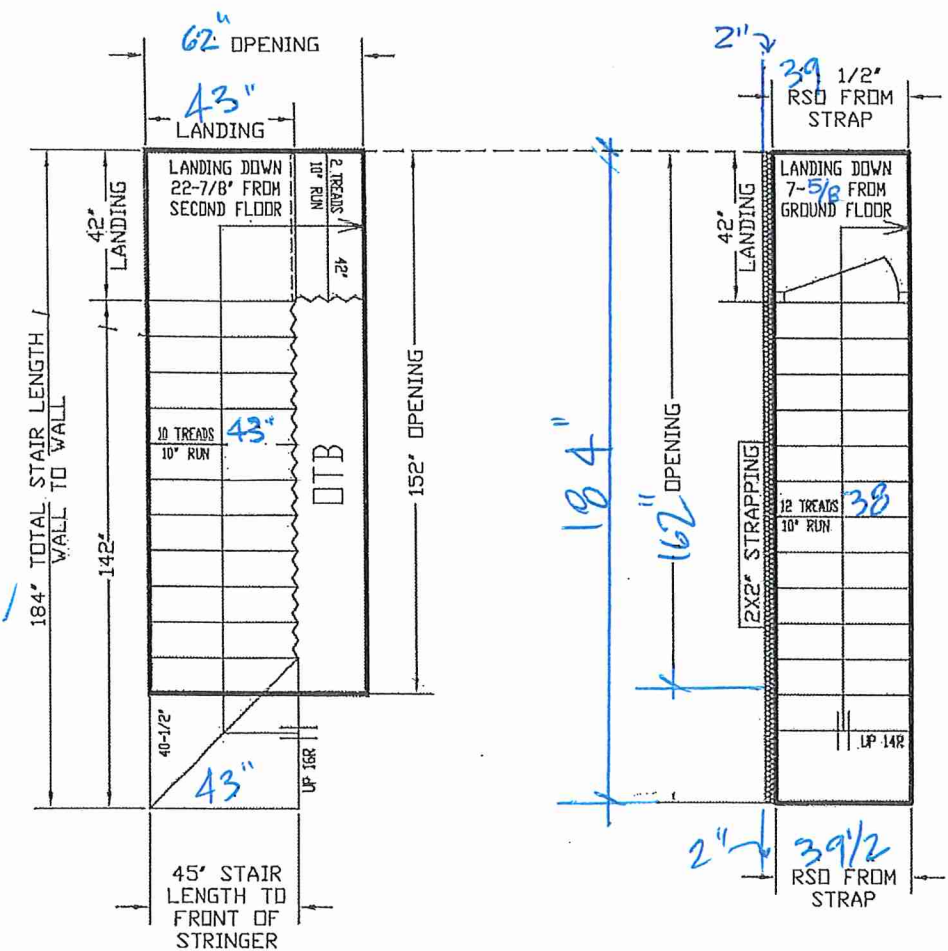

STAIRS LINE UP BY
PARTY WALL


ALL OPENINGS ARE ALLOWED
FOR 1 LAYER OF DRY WALL
ANY ADDITIONAL LAYERS MUST
BE ALLOWED BY CARPENTERS

NO WALLS UNTIL
STAIRS INSTALLED

GARAGE RIGHT >

 ALPA STAIRS AND RAILINGS INC. Quality To Step Up To	ALL LANDINGS TO BE SUPPLIED AND SUPPORTED BY OTHERS UNLESS SPECIFIED ABOVE ANY STRAPPING ALLOWANCES TO BE COMPENSATED BY CARPENTERS ALL STAIR DIMENSIONS MAY BE MODIFIED FROM ORIGINAL BLUE PRINTS OR SPECS AS SUPPLIED TO ALPA STAIRS AND RAILINGS INC. MEASUREMENTS SHOWN ON LAYOUTS ARE REQUIRED TO INSTALL OUR STAIRS. ANY PATTERNS WITH HEADROOM OR STRAPPING ALLOWANCES, ALPA STAIRS AND RAILINGS INC. WILL NOT BE RESPONSIBLE. STAIR LAYOUTS SHOULD BE CHECKED BY CARPENTERS OR SITE SUPERS TO MAKE SURE THERE ARE NO DISCREPANCIES BEFORE PROCEEDING WITH CONSTRUCTION!		SITE CENTREFIELD	NAME PARAJEET	DATE APRIL 9, 2025
	LOT #		CLIENT ROYAL PINE HOMES		
	Model 20-8 W/UNFIN. BSMT		LAYOUT #	SCALE: 1/32	
	ALPA STAIRS AND RAILINGS INC. 3770 NASHUA DRIVE, UNIT 3 MISSISSAUGA, ONTARIO L4V 1H6 TEL: (905) 694-9556 www.alpastairs.com				

BK 234 - TH #64.

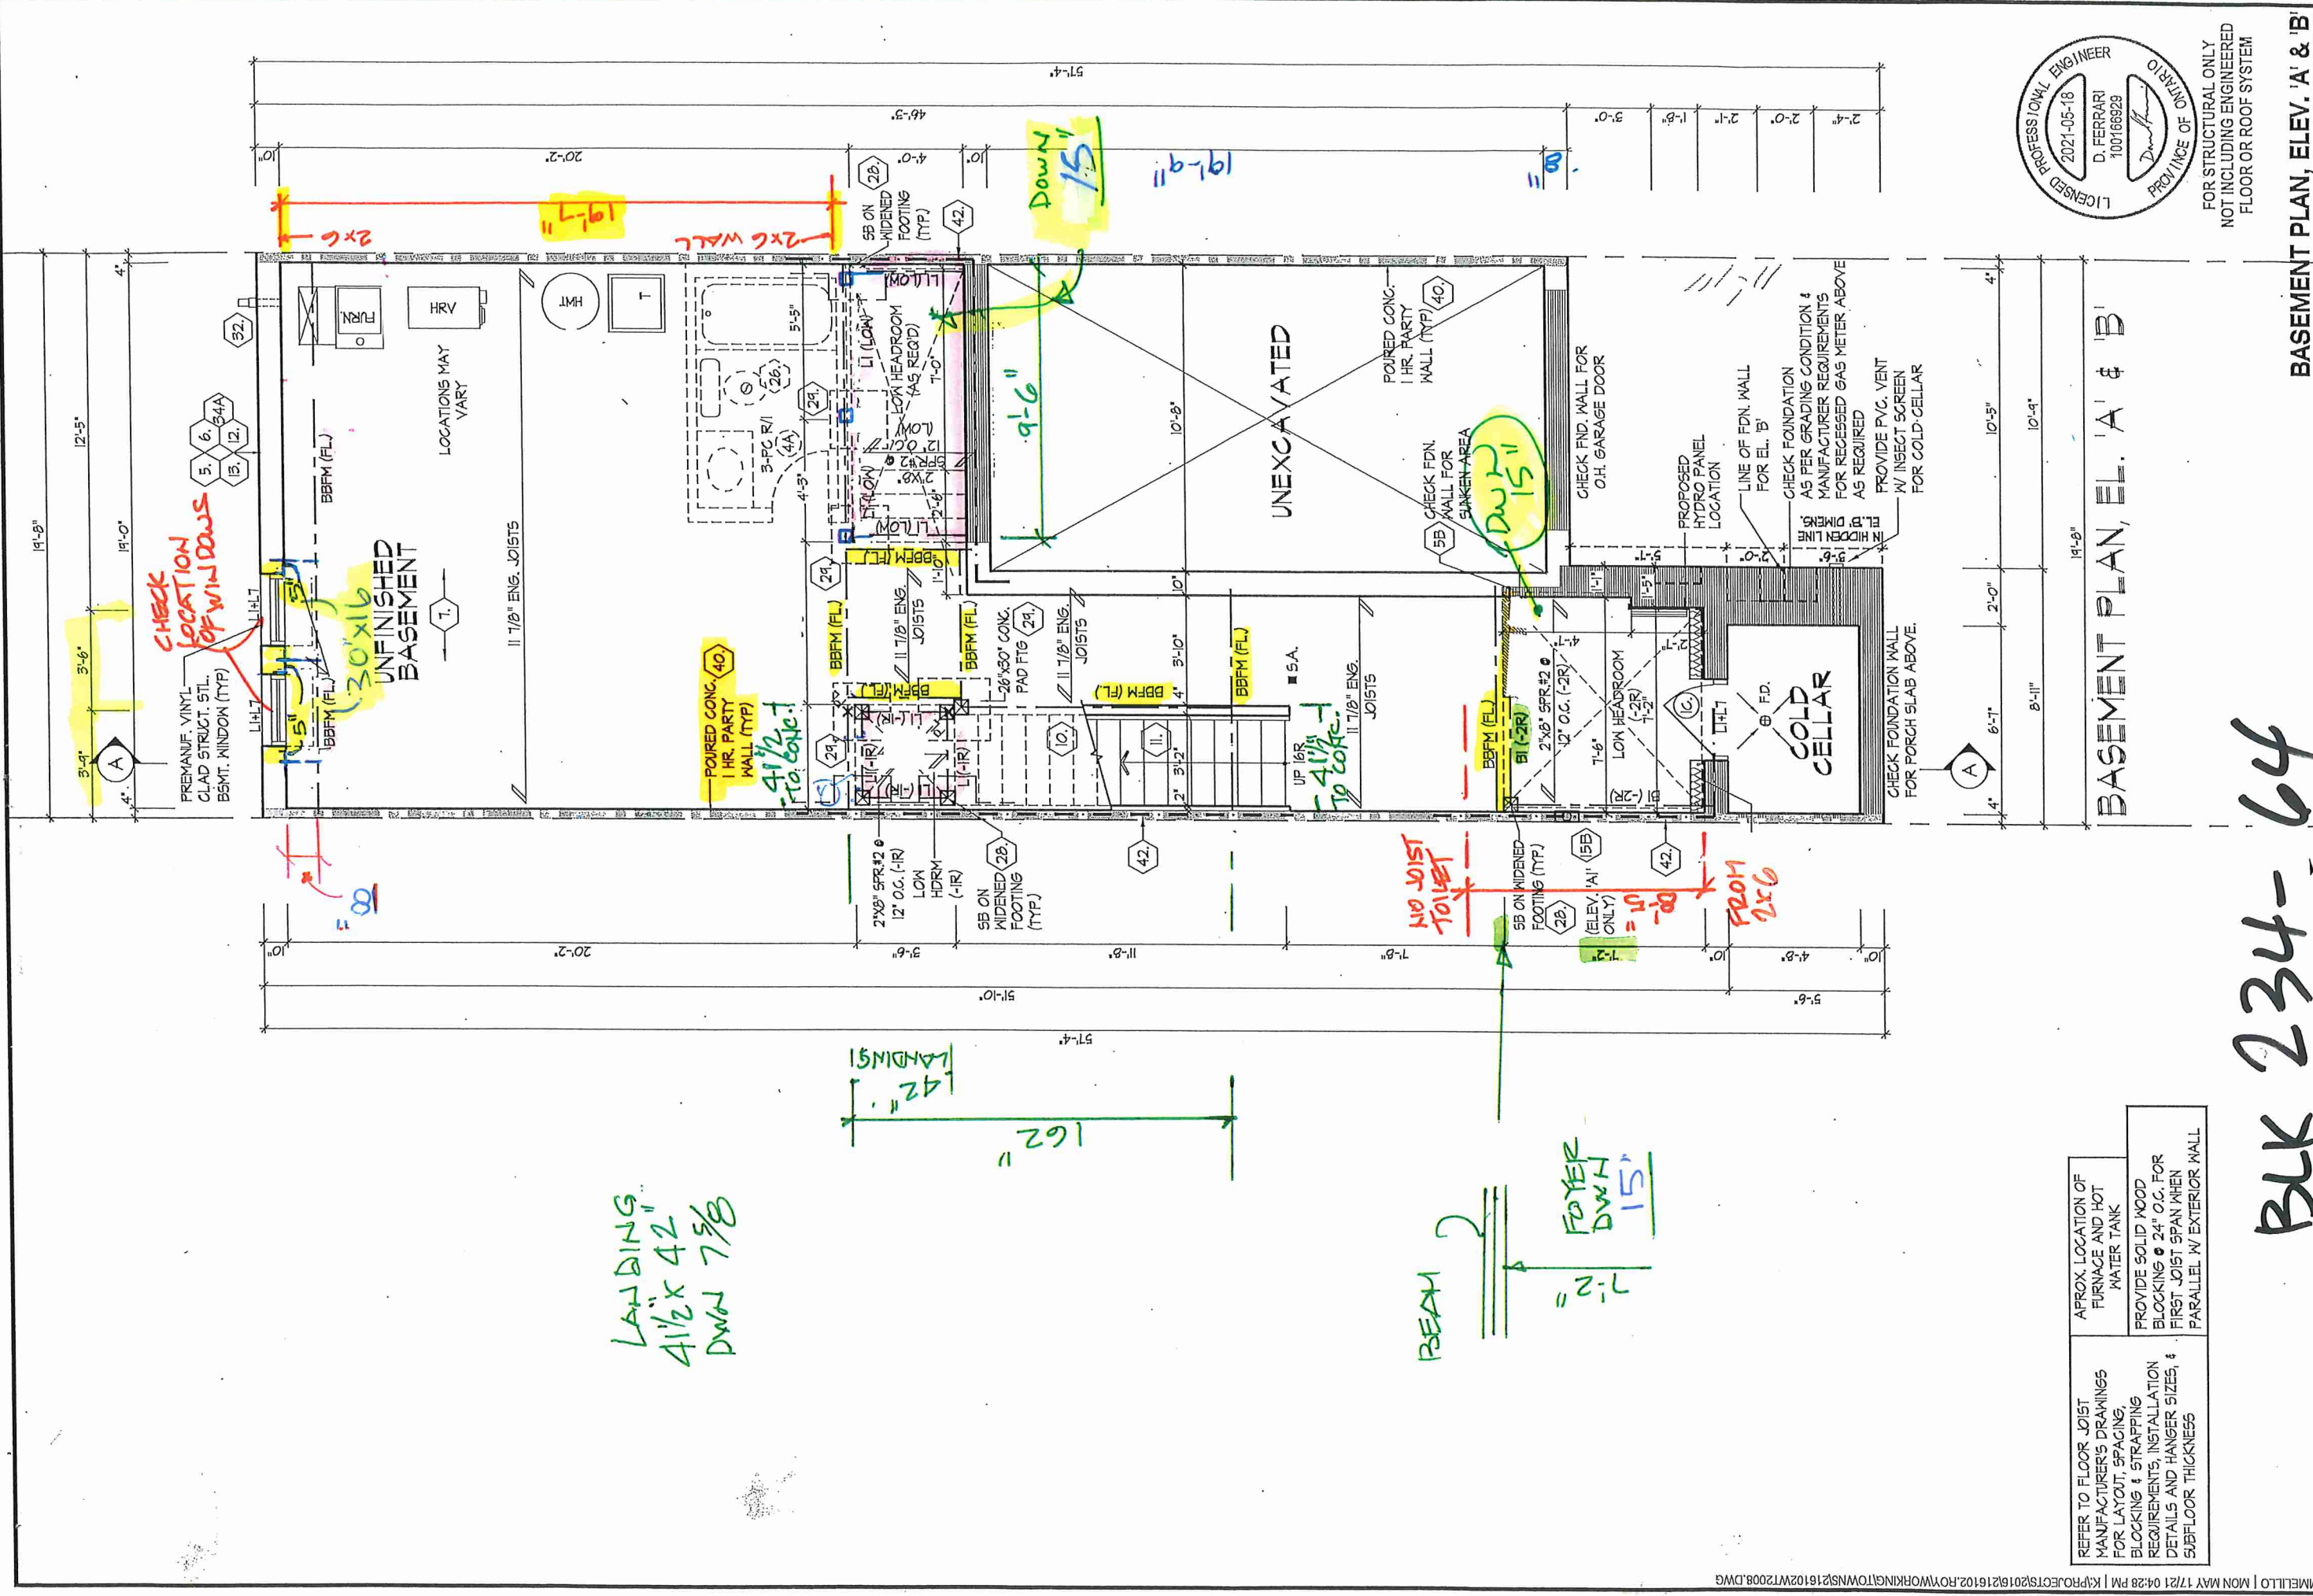

REFER TO FLOOR JOIST MANUFACTURER'S DRAWINGS FOR LAYOUT, SPACING, BLOCKING & STRAPPING REQUIREMENTS, INSTALLATION DETAILS AND HANGER SIZES, & SUBFLOOR THICKNESS	APPROX. LOCATION OF FURNACE AND HOT WATER TANK
	PROVIDE SOLID WOOD BLOCKING @ 24" O.C. FOR FIRST JOIST SPAN WHEN PARALLEL W/ EXTERIOR WALL

BLK 234-64

BASMENT PLAN.

BASEMENT PLAN, ELEV. 'A' & 'B'


ROYAL PINE HOMES - 216102
 'CENTREFIELD', WEST GORMLEY, RICHMOND HILL, ON.
 UNIT 2008
 REV.2021.03.24




HUNT
DESIGN ASSOCIATES INC.
www.huntdesign.ca

[illegible]

All drawings specifications related documents and design are the copyright property of Hunt Design Associates (H.D.A.). Reproduction of this property in whole or in part is strictly prohibited without H.D.A.'s written permission. H.D.A. assumes no responsibility or liability for this property unless it bears the appropriate ECIN number and original signature.

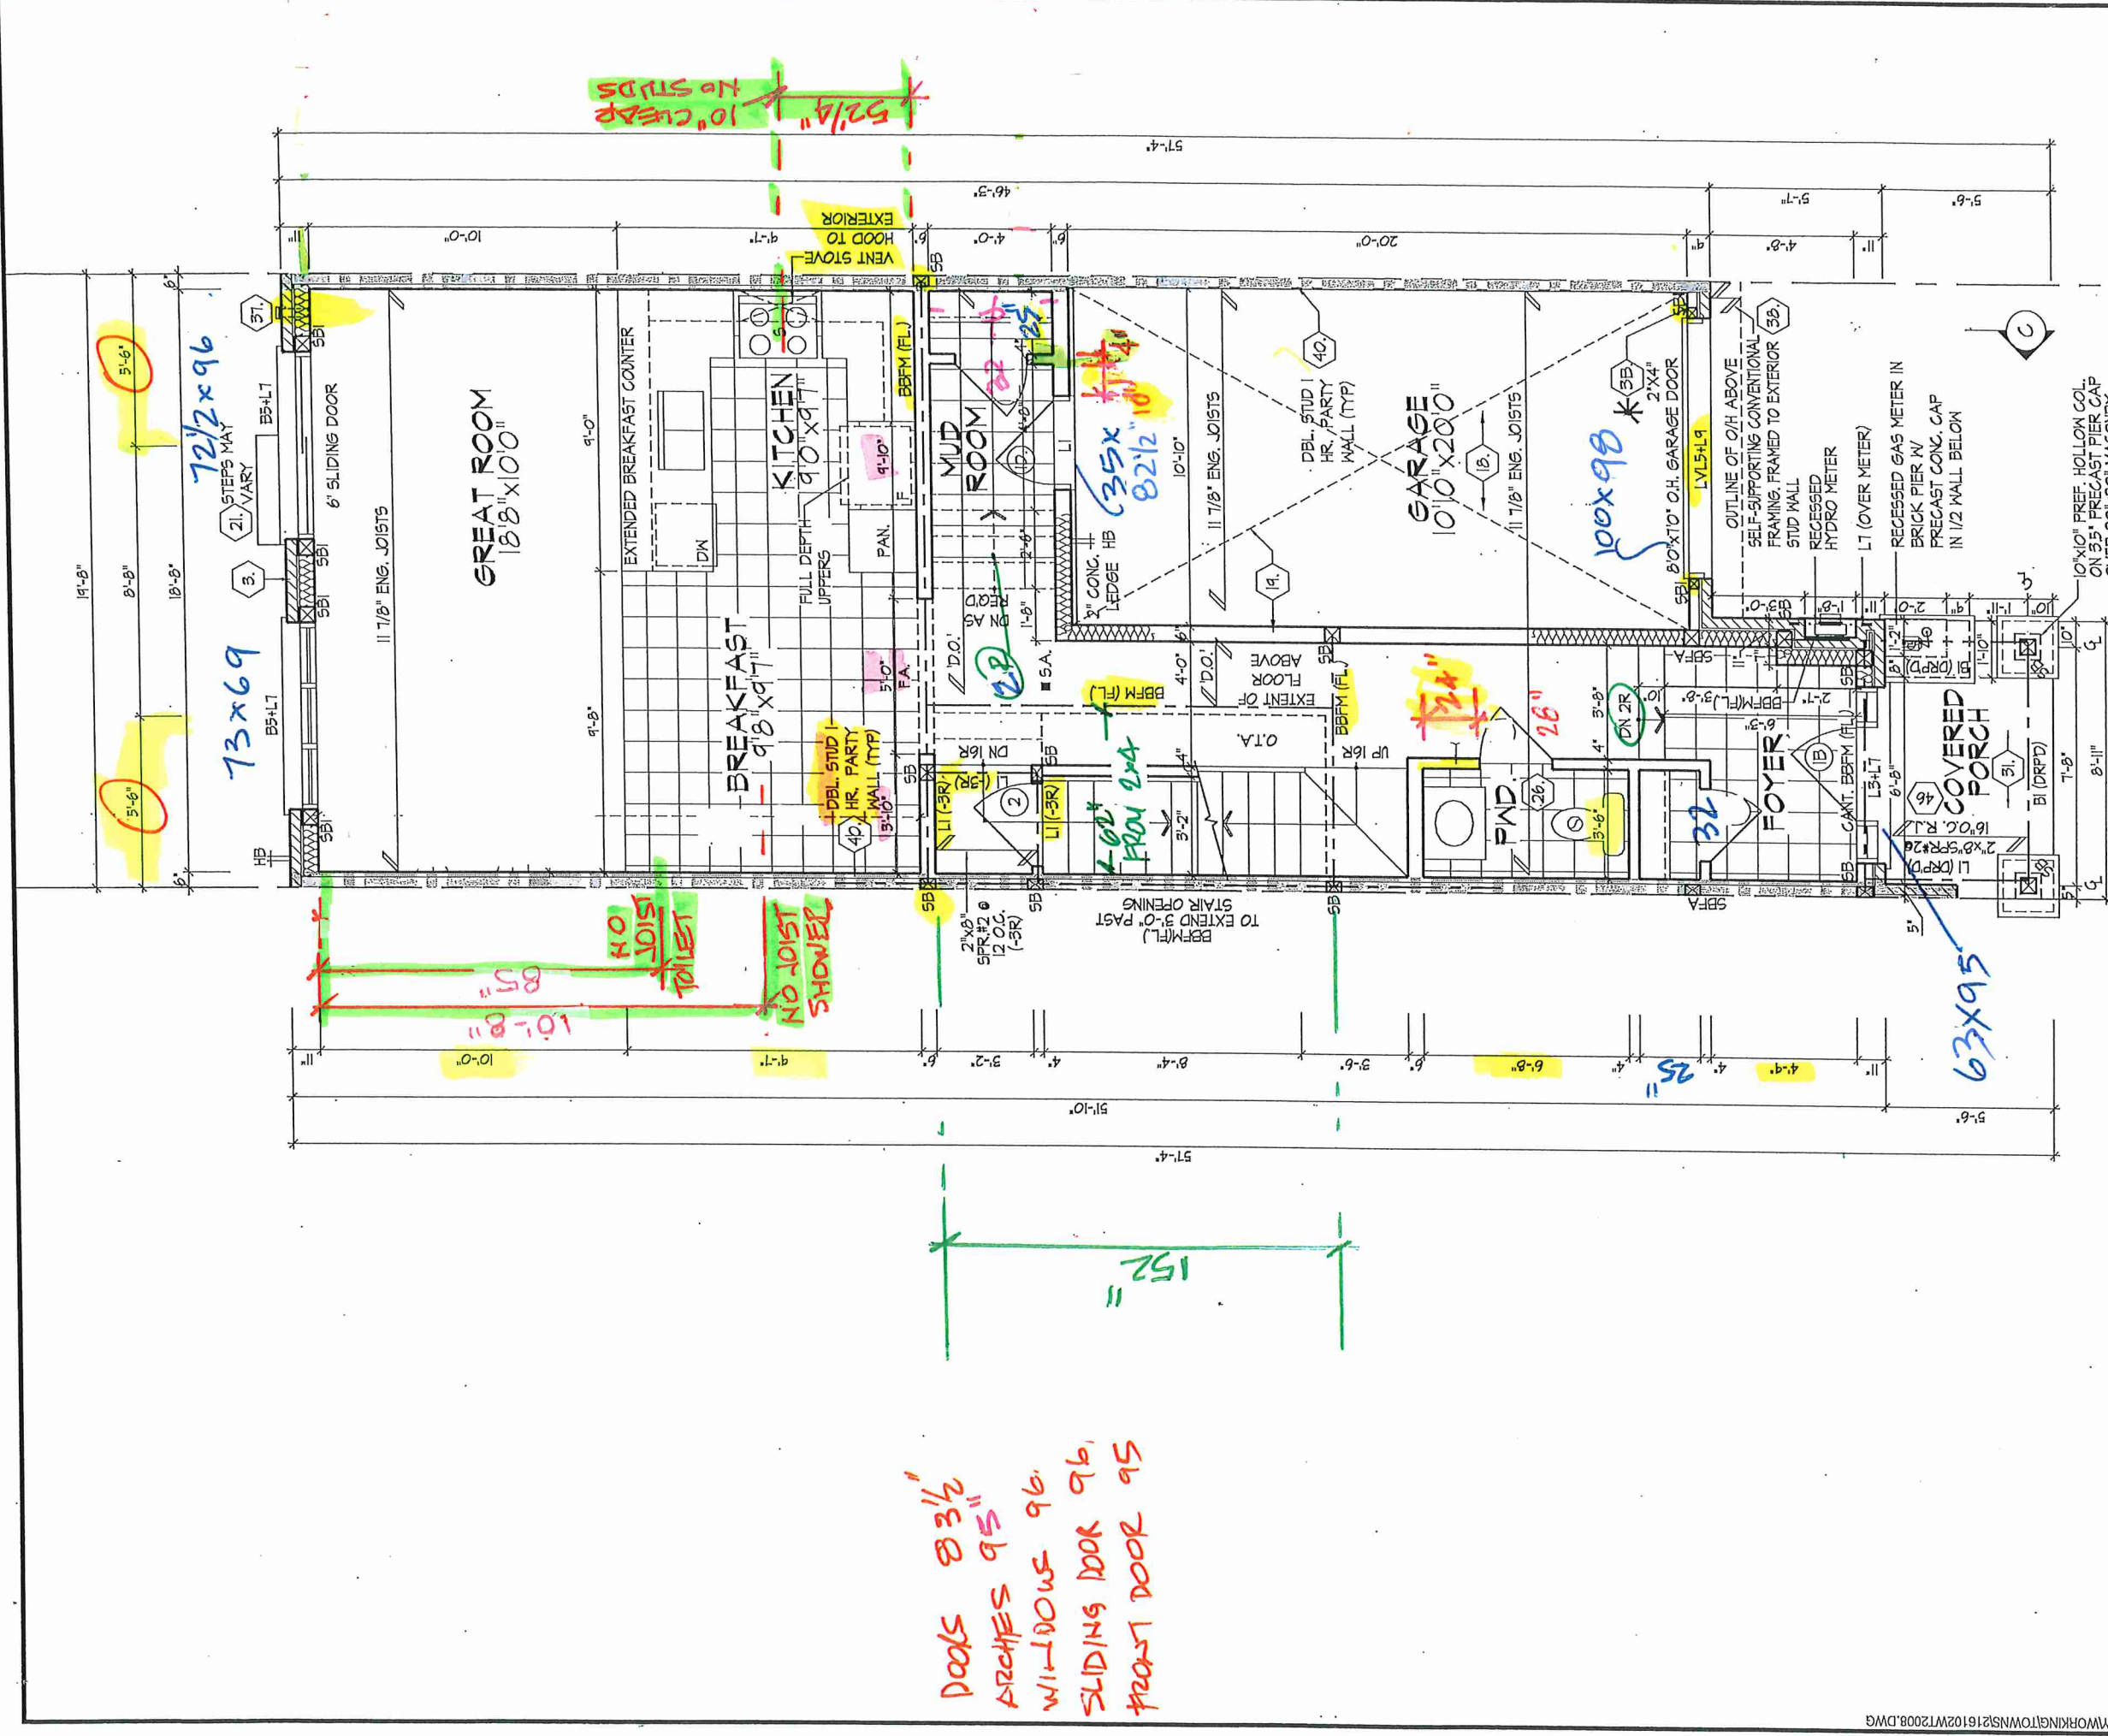

* 2"x4" STUD WALL ASSEMBLY EXCEEDING MAX UNSUPPORTED HEIGHT FOR WALLS GREATER THAN 9'-10" TO MAX 12'-0" HIGH, - W/O FLOOR LOAD, DOUBLE UP EVERY STUD @ 16" O.C. - W/ FLOOR LOAD DOUBLE UP EVERY STUD @ 12" O.C. PROVIDE BLOCKING EVERY 4'-0" O.C. VERTICAL.	REFER TO FLOOR JOIST MANUFACTURER'S DRAWINGS FOR LAYOUT, SPACING, BLOCKING & STRAPPING REQUIREMENTS, INSTALLATION DETAILS AND HANGER SIZES, & SUBFLOOR THICKNESS
ALL DOORS ON PLAN ARE 1'-10" HIGH TOP OF FRAME UNLESS LABELED OTHERWISE.	PROVIDE SOLID WOOD BLOCKING @ 24" O.C. FOR FIRST JOIST SPAN WHEN PARALLEL W/ EXTERIOR WALL

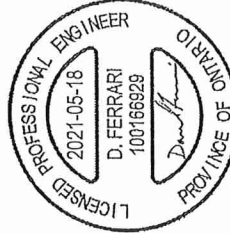

FOR STRUCTURAL ONLY
NOT INCLUDING ENGINEERED
FLOOR OR ROOF SYSTEM

GROUND FLOOR PLAN, EL. 'B'

BK 234-64

GROUND FLOOR PLAN, EL. 'B'



HE UNDERSIGNED HAS REVIEWED AND TAKES RESPONSIBILITY FOR THIS DESIGN AND HAS THE QUALIFICATIONS AND WEETS THE REQUIREMENTS SET OUT IN THE ONTARIO BUILDING CODE TO BE A DESIGNER.
DESIGNER'S SIGNATURE: *Greg R. Santos*
NAME: Greg R. Santos
SIGNATURE: *Greg R. Santos*
BOCN: 37308
19885
DESIGN ASSOCIATES INC.
19885
DESIGN ASSOCIATES INC.

DESIGN ASSOCIATES INC.
HUNT
www.hunt-design.ca
8866 Woodbine Ave, Markham, ON L3R 0U7
T 905.737.5133 F 905.737.7326

ROYAL PINE HOMES - 216102
CENTREFIELD, WEST GORMLEY, RICHMOND HILL, ON.
REV. 2021.03.24
UNIT 2008
10 of 14

PXK 234-64

CROSS SECTION 'A-A'

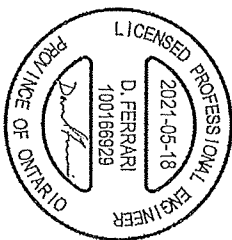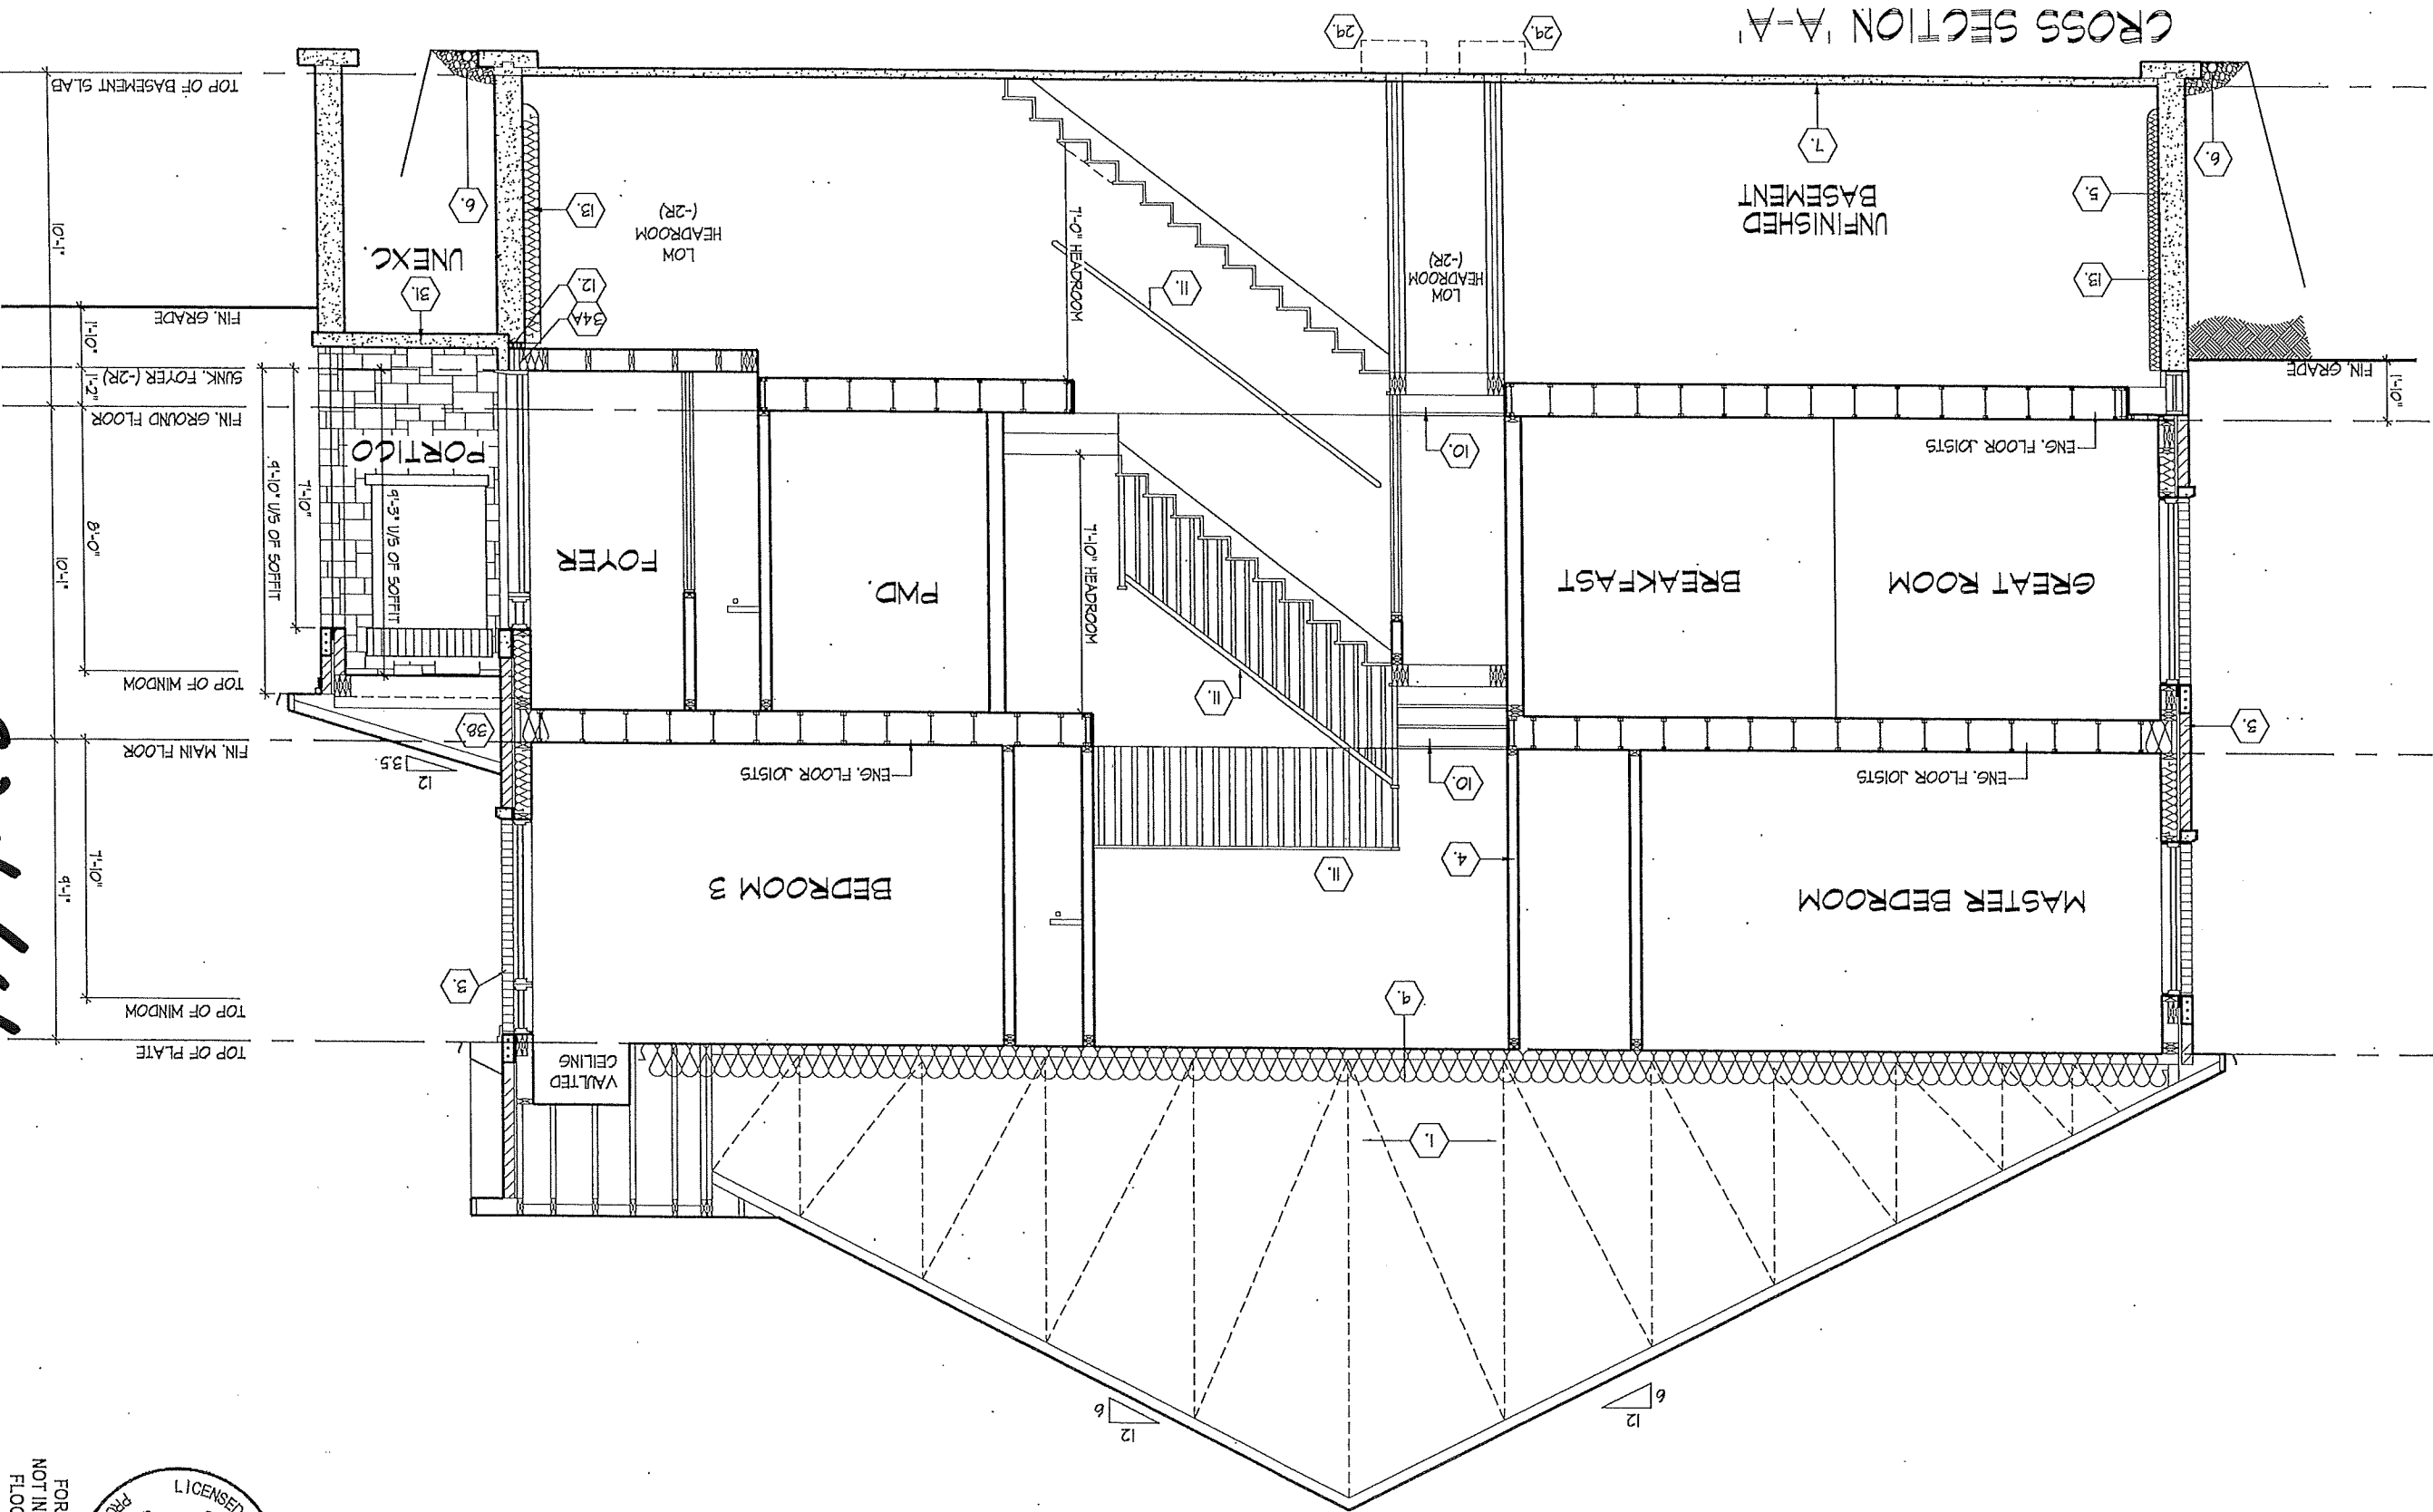

FOR STRUCTURAL ONLY
NOT INCLUDING ENGINEERED
FLOOR OR ROOF SYSTEM

SECTION 1.0. CONSTRUCTION NOTES

1 ROOF CONSTRUCTION (9.19, 9.23.13., 9.23.15.)

NO. 210 (10.25 KG/M2) ASPHALT SHINGLES, 3/8" (9.5) PLYWOOD SHEATHING WITH #4 CLIPS, APPROVED WOOD TRUSSES @ 24" (610) O.C. MAX. APPROVED EAVES PROTECTION TO EXTEND 2'-11" (600) FROM EDGE OF ROOF AND MIN. 12" (305) BEYOND INNER FACE OF EXTERIOR WALL, 2"x4" (38x89) TRUSS BRACING @ 6'-0" (1830) O.C. AT BOTTOM CHORD, PREFIN. ALUM. EAVESTROUGH, FASCIA, RVL & VENTED SOFFIT. ATTIC VENTILATION 1:300 OF INSULATED CEILING AREA WITH MIN. 25% OF REQUIRED OPENINGS LOCATED AT TOP OF SPACE & MIN. 25% OF REQUIRED OPENINGS LOCATED AT BOTTOM OF SPACE. EAVESTROUGH TO BE 4" MIN. WITH RVL DISCHARGING ONTO CONCRETE SPLASH PADS OR PER MUNICIPAL REQUIREMENTS. TOWNHOUSES TO HAVE 5" MIN. EAVESTROUGH WITH ELEC. TRACED HEATER CABLE ALONG EAVESTROUGH AND DOWN RVL.

1A ICE AND WATER SHIELD

PROVIDE ICE AND WATER SHIELD IN THE AREAS INDICATED. THE ICE AND WATER SHIELD SHALL BE A SELF-ADHERING AND SELF-SEALING MEMBRANE. SIDE LAPS MUST BE A MINIMUM 3 1/2" (90) AND END LAPS A MINIMUM 6" (152). AND TO EXTEND UP DORMER WALLS A MINIMUM 12" (305).

1B PROFILED ROOF TRUSSES

ROOF TRUSSES SHALL BE PROFILED AND/OR STEPPED AT RAISED COFFER/TRAY CEILINGS. ANGLED TRAY CEILINGS WILL BE SHEATHED W/ 3/8" (9.5) PLYWOOD.

2 SIDING WALL CONSTRUCTION (2"x6")

SIDING MATERIAL AS PER ELEVATION ATTACHED TO FRAMING MEMBERS. FURRING MEMBERS OR BLOCKING BETWEEN THE FRAMING MEMBERS ON APPROVED SHEATHING PAPER ON 3/8" (9.5) EXT. GRADE SHEATHING ON STUDS CONFORMING TO O.B.C (9.23.10.1.1) & SECTION 1.1. INSULATION, APPROVED 6 MIL POLYETHYLENE AIRVAPOUR BARRIER, ON 1/2" (12.7) GYPSUM WALLBOARD INT. FIN. (GYPSUM SHEATHING, RIGID INSULATION, AND FIBERBOARD SHALL NOT BE USED FOR THE ATTACHMENT OF SIDING (9.23.16.3.(1.1)) (REFER TO 35 NOTE AS REQ.)

2A SIDING WALL CONSTRUCTION (2"x6") W/ CONTIN. INSULATION

SIDING MATERIAL AS PER ELEVATION ATTACHED TO FRAMING MEMBERS ON APPROVED AIRWATER BARRIER AS PER O.B.C. 9.27.3. ON EXTERIOR TYPE RIGID INSULATION (JOINTS UNTAPED) MECHANICALLY FASTENED AS PER MANUFACTURERS SPECIFICATIONS ON 3/8" (9.5) EXT. GRADE SHEATHING ON STUDS CONFORMING TO O.B.C (9.23.10.1.1) & SECTION 1.1. INSULATION, APPROVED 6 MIL POLYETHYLENE AIRVAPOUR BARRIER, ON 1/2" (12.7) GYPSUM WALLBOARD INT. FIN. (GYPSUM SHEATHING, RIGID INSULATION, AND FIBERBOARD SHALL NOT BE USED FOR THE ATTACHMENT OF SIDING (9.23.16.3.(1.1)) (REFER TO 35 NOTE AS REQ.)

2B SIDING WALL @ GARAGE CONSTRUCTION

SIDING MATERIAL AS PER ELEVATION ATTACHED TO FRAMING MEMBERS. FURRING MEMBERS OR BLOCKING BETWEEN THE FRAMING MEMBERS ON APPROVED SHEATHING PAPER ON 3/8" (9.5) EXTERIOR TYPE SHEATHING ON STUDS CONFORMING TO O.B.C (9.23.10.1.1) & SECTION 1.1. 1/2" (12.7) GYPSUM WALLBOARD INTERIOR FINISH, (GYPSUM SHEATHING, RIGID INSULATION AND FIBERBOARD SHALL NOT BE USED FOR THE ATTACHMENT OF SIDING (9.23.16.3.(1.1)) (REFER TO 35 NOTE AS REQ.)

3 BRICK VENEER WALL CONSTRUCTION (2"x6")

3 1/2" (90) BRICK VENEER 1" (25) AIR SPACE, 7/8"x7"x0.03" (22x180x0.76) GALV. METAL TIES @ 16" (400) O.C. HORIZ. 24" (600) O.C. VERT. BONDING AND FASTENING FOR TIES TO CONFORM WITH 9.20.9. ON APPROVED SHEATHING PAPER, 3/8" (9.5) EXTERIOR TYPE SHEATHING WITH 9.20.9. ON APPROVED SHEATHING PAPER, 3/8" (9.5) EXTERIOR TYPE CONFORMING TO O.B.C (9.23.10.1.1) & SECTION 1.1. INSULATION AND 6 MIL POLYETHYLENE VAPOUR BARRIER WITH APPROVED CONTIN. AIR BARRIER, 1/2" (12.7) GYPSUM WALLBOARD INTERIOR FINISH. PROVIDE WEEP HOLES @ 32" (800) O.C. BOTTOM COURSE AND OVER OPENINGS. PROVIDE BASE FLASHING UP MIN. 6" (150) BEHIND BUILDING PAPER (9.20.13.6.) (REFER TO 35 NOTE AS REQ.)

3A BRICK VENEER WALL CONSTRUCTION (2"x6") W/ CONTIN. INSULATION

3 1/2" (90) BRICK VENEER 1" (25) AIR SPACE, 7/8"x7"x0.03" (22x180x0.76) GALV. METAL TIES @ 16" (400) O.C. HORIZ. 24" (600) O.C. VERT. BONDING AND FASTENING FOR TIES TO CONFORM WITH 9.20.9. ON APPROVED AIRWATER BARRIER AS PER O.B.C. 9.27.3. ON EXTERIOR TYPE RIGID INSULATION (JOINTS UNTAPED) MECHANICALLY FASTENED AS PER MANUFACTURERS SPECIFICATIONS, ON 3/8" (9.5) EXTERIOR TYPE SHEATHING, STUDS CONFORMING TO O.B.C (9.23.10.1.1) & SECTION 1.1. INSULATION AND 6 MIL POLYETHYLENE VAPOUR BARRIER WITH APPROVED CONTIN. AIR BARRIER, 1/2" (12.7) GYPSUM WALLBOARD INTERIOR FINISH. PROVIDE WEEP HOLES @ 32" (800) O.C. BOTTOM COURSE AND OVER OPENINGS. PROVIDE BASE FLASHING UP MIN. 6" (150) BEHIND BUILDING PAPER (9.20.13.6.) (REFER TO 35 NOTE AS REQ.)

3B BRICK VENEER WALL @ GARAGE CONSTRUCTION

3 1/2" (90) BRICK VENEER, MIN. 1" (25) AIR SPACE, 7/8"x7"x0.03" (22x180x0.76) GALV. METAL TIES @ 16" (400) O.C. HORIZ. 24" (600) O.C. VERT. BONDING AND FASTENING FOR TIES TO CONFORM WITH 9.20.9. ON APPROVED SHEATHING PAPER, 3/8" (9.5) EXTERIOR TYPE SHEATHING ON STUDS CONFORMING TO O.B.C (9.23.10.1.1) & SECTION 1.1. INSULATION AND 6 MIL POLYETHYLENE VAPOUR BARRIER WITH APPROVED CONTIN. AIR BARRIER, 1/2" (12.7) GYPSUM WALLBOARD INTERIOR FINISH. PROVIDE WEEP HOLES @ 32" (800) O.C. AT BOTTOM COURSE AND OVER OPENINGS. PROVIDE BASE FLASHING UP 6" (150) MIN. BEHIND BUILDING PAPER (9.20.13.6.) (REFER TO 35 NOTE AS REQ.)

4 INTERIOR STUD PARTITIONS (9.23.9.8., 9.23.10)

BEARING PARTITIONS SHALL BE A MINIMUM 2"x4" (38x89) @ 16" (406) O.C. FOR 2 STOREY AND 12" (305) O.C. FOR 3 STOREY. NON-BEARING PARTITIONS 2"x4" (38x89) @ 24" (610) O.C. PROVIDE 2"x4" (38x89) BOTTOM PLATE AND 2"x4" (38x89) TOP PLATE, 1/2" (12.7) INT. DRYWALL BOTH SIDES OF STUDS, PROVIDE 2"x6" (38x140) STUDS WHERE NOTED. PROVIDE 2"x4" (38x89) @ 24" (610) O.C. LADDER FRAMING WHERE WALLS INTERSECT PERPENDICULAR TO ONE ANOTHER. PROVIDE 2"x4" (38x89) WOOD BLOCKING ON FLAT @ 3'-11" (1194) O.C. MAX. BETWEEN FLOOR JOISTS WHEN NON-LOADBEARING WALLS ARE PARALLEL TO FLOOR JOISTS.

4A EXT. LOFT WALL CONSTRUCTION (2"x6") - NO CLADDING

3/8" (9.5) EXTERIOR TYPE SHEATHING, STUDS CONFORMING TO O.B.C (9.23.10.1.1) & SECTION 1.1. INSULATION AND 6 MIL POLYETHYLENE VAPOUR BARRIER WITH APPROVED CONT. AIR BARRIER, 1/2" (12.7) GYPSUM WALLBOARD INT. FINISH. (9.23.)

4B EXT. LOFT WALL CONSTRUCTION (2"x6")

APPROVED AIRWATER BARRIER AS PER O.B.C. 9.27.3. ON EXTERIOR TYPE RIGID. INSULATION (JOINTS UNTAPED) MECHANICALLY FASTENED AS PER MANUFACTURERS SPECIFICATIONS, ON 3/8" (9.5) EXTERIOR TYPE SHEATHING, STUDS CONFORMING TO O.B.C (9.23.10.1.1) & SECTION 1.1. INSULATION AND 6 MIL POLYETHYLENE VAPOUR BARRIER WITH APPROVED CONT. AIR BARRIER, 1/2" (12.7) GYPSUM WALLBOARD INT. FINISH. (9.23.)

5 FOUNDATION WALL/FOOTINGS

POURED CONC. FOUNDATION WALL AS PER CHART BELOW ON CONTINUOUS KEYED CONCRETE FOOTING. FOUNDATION WALLS SHALL EXTEND NOT LESS THAN 6" (160) ABOVE FINISHED GRADE. THE OUTSIDE OF THE FOUNDATION SHALL BE DAMPROOFED FROM THE TOP OF THE FOOTING TO FINISHED GRADE AND BRUSH COAT FROM THE TOP TO 2" BELOW GRADE. PROVIDE A DRAINAGE LAYER ON THE OUTSIDE OF THE FOUNDATION WALL. SEAL THE DRAINAGE LAYER AT THE TOP. THE TOP OF THE CONC. FOOTING SHALL BE DAMPROOFED. CONCRETE FOOTINGS SUPPORTING JOIST SPANS GREATER THAN 16'-1" (4900) SHALL BE SIZED IN ACCORDANCE WITH 8.15.3.4 (1),(2) OF THE O.B.C. (REFER TO CHART BELOW FOR RESPECTIVE SIZES). BRACE FOUNDATION WALL PRIOR TO BACKFILLING. ALL FOOTINGS SHALL REST ON NATURAL UNDISTURBED SOIL OF 75kPa OR COMPACTED ENGINEERED FILL WITH MIN. BEARING CAPACITY OF 150kPa. IF SOIL BEARING DOES NOT MEET MINIMUM CAPACITY, ENGINEERED FOOTINGS ARE REQUIRED. ACTUAL SOIL BEARING CAPACITY TO BE VERIFIED WITH SOIL ENGINEERING REPORT.

REFER TO CONSTRUCTION DRAWINGS AND DETAILS FOR FOUNDATION WALL STRENGTH AND THICKNESS AND 9.15.4. FOUNDATION WALLS SHALL NOT EXCEED 9'-10" (3.0m) IN UNSUPPORTED HEIGHT UNLESS OTHERWISE NOTED. (9.15.4.2.(1.1))

HEIGHTS	SECTION	MAX. HEIGHT FROM FIN. SLAB TO GRADE	
		UNSUPPORTED	SUPPORTED AT TOP

1	8"	≤2.5m	>2.5m & ≤2.75m & ≤3.0m
2	10"	3'-11" (1.20m)	7'-0" (2.15m)
3	12"	4'-7" (1.40m)	7'-6" (2.30m)
4	14"	4'-11" (1.50m)	8'-6" (2.60m)
5	16"	5'-7" (1.70m)	9'-3" (2.85m)
6	18"	6'-3" (1.90m)	10'-0" (3.05m)
7	20"	7'-0" (2.10m)	10'-6" (3.20m)
8	22"	7'-6" (2.30m)	11'-0" (3.35m)
9	24"	8'-0" (2.40m)	11'-6" (3.50m)
10	26"	8'-6" (2.60m)	12'-0" (3.65m)
11	28"	9'-0" (2.70m)	12'-6" (3.80m)
12	30"	9'-6" (2.90m)	13'-0" (3.95m)

*9" MIN. THICK FOUNDATION WALL IS REQUIRED FOR MASONRY VENEER FINISHED EXTERIOR WALLS WITH CONTINUOUS INSULATION CONDITION, TO PROVIDE MIN. BEARING FOR SILL PLATES, BEAMS AND FLOOR JOIST AS PER 9.23.7.2., 9.23.8.1., & 9.23.8.1.1. OF THE O.B.C.

MINIMUM STRIP FOOTING SIZES (9.15.3.)			
NUMBER FLOORS SUPPORTED	SUPPORTING INT. LOAD BEARING MASONRY WALLS	SUPPORTING EXTERIOR MASONRY WALLS	SUPPORTING PARTIAL WALLS
1	16" WIDE x 8" THICK	16" WIDE x 6" THICK	16" WIDE x 6" THICK
2	24" WIDE x 8" THICK	20" WIDE x 6" THICK	24" WIDE x 8" THICK
3	36" WIDE x 14" THICK	28" WIDE x 8" THICK	36" WIDE x 14" THICK

THE UNDERSIGNED HAS REVIEWED AND TAKES RESPONSIBILITY FOR THIS DESIGN AND HAS THE QUALIFICATIONS AND MEETS THE REQUIREMENTS SET OUT IN THE ONTARIO BUILDING CODE TO BE A DESIGNER.

NAME: Derek R. Santos
SIGNATURE: [Signature]
BOB: 37308
19695

HUNT DESIGN ASSOCIATES INC.

HUNT DESIGN ASSOCIATES INC.
www.huntdesign.ca

ROYAL PINE HOMES - 216102
'CENTREFIELD, WEST GORMLEY, RICHMOND HILL, ON.
DESIGN ASSOCIATES INC.
KWM
DS
3/16"=1'-0"

8966 Woodbine Ave, Markham, ON L3R 0J7
T 905.737.5133 F 905.737.7326

UNIT 2008
REV.2021.03.24
Page Number
13 of 14

REFER TO SB-12 ENERGY EFFICIENCY DESIGN MATRIX ON THE TITLE PAGE FOR ALL VALUES AS REQUIRED PER 3.1.1., 3.1.2., 3.1.3. OF THE OBC.

5A

FOUNDATION REDUCTION IN THICKNESS FOR MASONRY WHERE THE TOP OF THE FOUNDATION WALL IS REDUCED IN THICKNESS TO PERMIT THE INSTALLATION OF MASONRY EXTERIOR FACING, THE REDUCED SECTION SHALL BE NOT LESS THAN 3 1/2" (90) THICK. THE BRICK VENEER SHALL BE TIED TO THE FOUNDATION WALL WITH CORROSION RESISTANT METAL TIES @ 7 7/8" (200) VERTICAL AND 2'-11" (549) HORIZONTAL. FILL VOID WITH MORTAR BETWEEN WALL AND BRICK VENEER (9.15.4.7(2)(g) & 9.20.9.4(3))

5B FOUNDATION REDUCTION IN THICKNESS FOR JOISTS

WHERE THE TOP OF THE FOUNDATION WALL IS REDUCED IN THICKNESS TO PERMIT THE INSTALLATION OF FLOOR JOISTS, THE REDUCED SECTION SHALL BE NOT MORE THAN 13 3/4" (360) HIGH & NOT LESS THAN 3 1/2" (90) THICK (9.15.4.7(1))

6 WEEPING TILE (9.14.3.)

4" (100) Ø WEEPING TILE W/ FILTER CLOTH WRAP & 8" (162) CRUSHED STONE COVER

7 BASEMENT SLAB OR SLAB ON GRADE (9.16.4.3.)

3" (60) MIN. 25MPa (3600psi) CONC. SLAB ON 4" (100) COARSE GRANULAR FILL, OR 20MPa (2900psi) CONC. WITH DAMPROOFING BELOW SLAB, PROVIDE 1/2" (12.7) IMPERVIOUS BOARD FOR BOND BREAK AT EDGE. (9.13.) WHERE A BASEMENT SLAB IS WITHIN 24" (610) OF THE EXTERIOR GRADE, PROVIDE RIGID INSUL. AROUND THE PERIMETER EXTENDING MIN. 24" (610) BELOW GRADE. FOR SLAB ON GRADE CONDITIONS RIGID INSULATION SHALL BE APPLIED TO THE UNDERSIDE OF THE ENTIRE SLAB. (9.8-12 (3.1.1.7.(9) & (6))

8 EXPOSED FLOOR TO EXTERIOR (9.10.17.10, & CANULC-S705.2)

PROVIDE SPRAY FOAM INSULATION BETWEEN CANT. JOIST AND INSTALL FIN. SOFFIT OR CLADDING AS PER ELEVATION TO US OF EXPOSED CANT. JOIST.

9 EXPOSED CEILING TO EXTERIOR w/ ATTIC (9.25.2.4)

INSULATION, 6 mil POLYETHYLENE VAPOUR BARRIER, 1/2" (12.7) GYPSUM BOARD INTERIOR FINISH OR APPROVED EQ.

EXPOSED CEILING TO EXTERIOR w/o ATTIC

JOISTS/TRUSSES AS PER PLANS W/ 2"x2" (38x38) PURLINS @ 16" (406) O.C. PERPENDICULAR TO JOISTS. PURLINS NOT REQ. W/ SPRAY FOAM OR ROOF TRUSSES) W/ INSULATION BETWEEN JOIST, 6 mil POLYETHYLENE VAPOUR BARRIER, 1/2" (12.7) GYPSUM BOARD INT. FINISH OR APPROVED EQ. (CANULC-S705.2, 9.19.1., 9.10.17.1)

10 ALL STAIRS/EXTERIOR STAIRS (9.8.1.2., 9.8.2., 9.8.4.)

	MAX. RISE	MIN. RISE	MAX. RUN	MIN. RUN	MAX. TREAD	MIN. TREAD
PRIVATE	7 7/8" (200)	5" (125)	14" (355)	8 1/4" (210)	14" (355)	9 1/4" (235)
PUBLIC	7" (180)	5" (125)	NO LIMIT	11" (280)	NO LIMIT	11" (280)
PRIVATE	2'-10" (660)	MIN. RUN	5 7/8" (150)	MAX. NOSING	1" (25)	ALL STAIRS
PUBLIC	2'-11" (600)	MIN. AVG. RUN	7 7/8" (200)			

** HEIGHT OVER STAIRS (HEADROOM) IS MEASURED VERTICALLY ACROSS WIDTH OF STAIRS FROM A STRAIGHT LINE TO THE TREAD & LANDING NOSING TO LOWEST POINT ABOVE AND NOT LESS THAN 6'-5" (1950) FOR SINGLE DWELLING UNIT & 6'-8 3/4" (2060) FOR EVERYTHING ELSE. (9.8.2.2.) REQUIRED LANDING IN GARAGE - O.B.C. 9.8.6.2.(3.) FOR AN EXTERIOR STAIR SERVING A GARAGE, W/ MORE THAN 3 RISERS. GUARDS, HANDRAILS & STEPS AS PER CONSTRUCTION HEX NOTE 10 & 11.

11 GUARDS/RAILINGS (9.8.7., 9.8.8.)

GUARDS TO BE DESIGNED NOT TO FACILITATE CLIMBING AND PROVIDING MAX. OPENING CONFORMING TO O.B.C. 9.8.8.5. & 9.8.8.6. AND BE ABLE TO RESIST LOADS AS PER TABLE 9.8.8.2. GUARD HEIGHTS - O.B.C. 9.8.8. INTERIOR GUARDS: 2'-11" (600) MIN. EXTERIOR GUARDS: 2'-11" (600) MIN. LESS THAN 5'-11" (1800) TO GRADE 3'-5" (1070) MIN. MORE THAN 5'-11" (1800) TO GRADE GUARDS FOR EXIT STAIRS: 3'-0" (920) MIN. GUARDS FOR LANDINGS @ EXIT STAIRS: 3'-6" (1070) MIN. GUARDS FOR FLOORS & RAMPS IN GARAGES (SERVICE STAIRS) FLOOR OR RAMP W/O EXTERIOR WALLS THAT IS 23 5/8" (600) OR MORE ABOVE ADJACENT SURFACE REQUIRES CONT. CURB MIN. 6" (160) HIGH, AND GUARD MIN. 3'-6" (1070) HIGH. REQUIRED GUARDS BETWEEN WALKING SURFACE & ADJACENT SURFACE WITH A DIFFERENCE IN ELEVATION MORE THAN 23 5/8" (600) OR ADJACENT SURFACE WITHIN 3'-11" (1200) & WALKING SURFACE W/ A SLOPE MORE THAN 1 IN 12 SHALL BE PROTECTED WITH GUARDS PER CONSTRUCTION HEX NOTE 11. HANDRAIL HEIGHTS - O.B.C. 9.8.7. - REQUIRED AS PER 9.8.7.1.(3) MIN. HEIGHT AT STAIRS OR RAMP: 2'-10" (665) MAX. HEIGHT AT STAIRS OR RAMP: 3'-2" (965) MAX. HEIGHT AT LANDING: 3'-6" (1070) STAIRS OR RAMP MIN. 7'-3" (2200) WIDE: 2'-9" (865) MIN. HEIGHT

12 SILL PLATES

2"x4" (38x89) SILL PLATE WITH 1/2" (12.7) Ø ANCHOR BOLTS 8" (200) LONG, EMBEDDED MIN. 4" (100) INTO CONC. @ 7'-10" (2388) O.C., CAULKING OR GASKET BETWEEN PLATE AND TOP OF FOUNDATION WALL. USE NON-SHRINK GROUT TO LEVEL SILL PLATE WHEN REQUIRED (9.23.7.)

13 BASEMENT INSULATION (9.8-12 (3.1.1.7.)

PROVIDE CONTINUOUS BLANKET INSULATION W/ BUILT IN 6 mil POLYETHYLENE VAPOUR BARRIER INSULATION TO EXTEND NO MORE THAN 8" (200) ABOVE FINISHED BASEMENT FLOOR. DAMPROOFED WITH BUILDING PAPER BETWEEN THE FOUNDATION WALL AND INSULATION UP TO GRADE LEVEL.

BEARING STUD PARTITION IN BASEMENT (9.15.3.6, 9.23.10.1) 2"x4" (38x89) STUDS @ 16" (406) O.C., 2"x4" (38x89) SILL PLATE (2"x6" (38x140) AS REQUIRED) ON DAMPROOFING MATERIAL OR 2 mil POLYETHYLENE FILM, 1/2" (12.7) Ø ANCHOR BOLTS 8" (200) LONG, EMBEDDED 4" (100) MIN. INTO CONC. @ 7'-10" (2390) O.C. 4" (100) HIGH CONC. CURB ON CONC. FOOTING. FOR SIZE REFER TO HEX NOTE 5. ADD HORIZ. BLOCKING AT MID-HEIGHT IF WALL IS UNFINISHED.

ADJUSTABLE STEEL BASEMENT COLUMN (9.15.3.4.)

9'-10" (3000) MAX. SPAN BETWEEN COLUMNS, 3 1/2" (90)Ø SINGLE TUBE ADJUSTABLE STEEL COLUMN CONFORMING TO CAN/CGSB-7.2M, AND WITH 6"x6"x3/8" (152x152x9.5) STEEL PLATE TOP & BOTTOM. FIELD WELD BASEMENT COLUMN CONNECTION. POURED CONCRETE FOOTING ON NATURAL UNDISTURBED SOIL OF 75kPa OR COMPACTED ENGINEERED FILL WITH MIN. BEARING CAPACITY OF 150kPa AS PER SOILS REPORT.

SUPPORTING 2 STOREY FLR. LOAD PROVIDE 4"x4"x4"x16" (1070x1070x460) CONC. FOOTING SUPPORTING 3 STOREY FLR. LOAD PROVIDE 48"x48"x24" (1220x1220x610) CONC. FOOTING

15A NON-ADJUSTABLE STEEL BASEMENT COLUMN

3 1/2" (90)Ø x 0.188" (4.78) NON-ADJUSTABLE STEEL COLUMN WITH 6"x6"x3/8" (152x152x9.5) STEEL PLATE TOP & BOTTOM. FIELD WELD BASEMENT COLUMN CONNECTION. POURED CONCRETE FOOTING ON NATURAL UNDISTURBED SOIL OF 75kPa OR COMPACTED ENGINEERED FILL WITH MIN. BEARING CAPACITY OF 150kPa AS PER SOILS REPORT.

SUPPORTING 2 STOREY FLR. LOAD PROVIDE 4"x4"x4"x16" (1070x1070x460) CONC. FOOTING SUPPORTING 3 STOREY FLR. LOAD PROVIDE 48"x48"x24" (1220x1220x610) CONC. FOOTING



21 EXTERIOR AND GARAGE STEPS

PRECAST CONC. STEP OR WOOD STEP WHERE NOT EXPOSED TO WEATHER. MAX RISE 7 7/8" (200) MIN. TREAD 9 1/4" (235). FOR THE REQUIRED NUMBER OF STEPS REFER TO SITING AND GRADING DRAWINGS. EXTERIOR CONCRETE STAIRS WITH MORE THAN 2 RISERS AND 2 TREADS SHALL BE PROVIDED WITH FOUNDATION AS REQUIRED BY ARTICLE 9.8.8.2. OR SHALL BE CANTILEVERED AS PER SUBSECTION 9.8.10.

22 DRYER EXHAUST

CAPPED DRYER EXHAUST VENTED TO EXT. CONFORMING TO PART 6, OBC 9.9.2.

ATTIC ACCESS (9.19.2.1.)

ATTIC ACCESS HATCH WITH MIN. AREA OF 0.32m² AND NO DIM. LESS THAN 21 1/2" (545) WITH WEATHER STRIPPING. HATCH COVERS TO THE ATTIC OR ROOF SPACE WILL BE FITTED WITH DOORS OR CHAIRS AND WILL BE INSULATED WITH MIN. R20 (RSI 3.52) (9.8-12 (3.1.1.8.(1))

24 FIREPLACE CHIMNEYS (9.21.)

TOP OF FIREPLACE CHIMNEY SHALL BE 2'-11" (669) ABOVE THE HIGHEST POINT AT WHICH IT COMES IN CONTACT WITH THE ROOF AND 2'-0" (610) ABOVE THE ROOF SURFACE WITHIN A HORIZ. DISTANCE OF 10'-0" (3048) FROM THE CHIMNEY.

25 LINEN CLOSET

PROVIDE 4 SHELVES MIN. 14" (366) DEEP.

cont. SECTION 1.0. CONSTRUCTION NOTES

- 40

1 HR. PARTY WALL (CONC. BLOCK) (SB-3) WALL TYPE B6a & B1b)
1/2" (12.7) GYPSUM SHEATHING ON EACH SIDE ON 2"x2" (38x38) VERTICAL WD. STRAPPING @ 24" (610) O.C. ON 8" (200) CONC. BLOCK FILL STRAPPING CAVITY EACH SIDE WITH AT LEAST 90% OF ABSORPTIVE MATERIAL PROCESSED FROM ROCK, SLAG OR GLASS. TAPE, FILL & SAND ALL GYPSUM JOINTS. EXPOSED BLOCK MUST BE SEALED W/ 2 COATS OF PAINT OR FURRED WITH 2"x2" (38x38) WD. STRAPPING & 1/2" (12.7) GYPSUM SHEATHING.
- 40

1 HR. PARTY WALL (DOUBLE STUD) (SB-3) WALL TYPE W13c)
5/8" (15.9) TYPE X GYPSUM SHEATHING ON EXTERIOR SIDE OF 2 ROWS OF 2"x4" (38x89) STUDS @ 16" (406) O.C., MIN. 1" (25) APART ON SEPARATE 2"x4" (38x89) SILL PLATES. (2"x6" (38x140) AS REQUIRED) FILL ONE SIDE OF STUD CAVITY WITH AT LEAST 90% OF ABSORPTIVE MATERIAL PROCESSED FROM ROCK, SLAG OR GLASS. TAPE FILL AND SAND ALL GYPSUM JOINTS.
- 40A

2 HR. FIREWALL (SB-3) WALL TYPE B6a & B1b)
1/2" (12.7) GYPSUM SHEATHING ON EACH SIDE ON 2"x2" (38x38) VERTICAL WOOD STRAPPING @ 24" (610) O.C. ON 8" (200) CONC. BLOCK 75% SOLID FILL STRAPPING CAVITY EACH SIDE WITH AT LEAST 90% OF ABSORPTIVE MATERIAL PROCESSED FROM ROCK, SLAG OF GLASS. TAPE, FILL & SAND ALL GYPSUM JOINTS. AT UNFINISHED AREAS, EXTERIOR FACE OF CONC. BLOCK TO BE SEALED WITH 2 COATS OF PAINT. GYPSUM SHEATHING TO BE ATTACHED TO CONC. BLOCK. (REFER TO DETAILS)
- 41

STUCCO WALL CONSTRUCTION (2"x6")
STUCCO FINISH CONFORMING TO O.B.C. SECTION 9.28. AND APPLIED PER MANUFACTURERS SPECIFICATIONS OVER 1 1/2" (38) E.F.F.S. (MINIMUM) ON APPROVED DRAINAGE MAT ON 1/2" (12.7) DENSGLASS GOLD GYPSUM BOARD ON STUDS CONFORMING TO O.B.C (9.23.10.1.) & SECTION 1.1., INSULATION, APPROVED 6 MIL. POLYETHYLENE VAPOUR BARRIER, 1/2" (12.7) GYPSUM WALLBOARD INT. FINISH. (REFER TO 35 NOTE AS REQUIRED)
- 41A

STUCCO WALL CONSTRUCTION (2"x6") W/ CONTIN. INSUL.
STUCCO FINISH CONFORMING TO O.B.C. SECTION 9.28. AND APPLIED PER MANUFACTURERS SPECIFICATIONS OVER 1 1/2" (38) E.F.F.S. (MINIMUM) ON APPROVED DRAINAGE MAT ON APPROVED AIRWATER BARRIER AS PER O.B.C. 9.27.3. ON EXTERIOR TYPE RIGID INSULATION (JOINTS UNTAPED) MECHANICALLY FASTENED AS PER MANUFACTURERS SPECIFICATIONS. ON 7/16" EXTERIOR TYPE SHEATHING ON STUDS CONFORMING TO O.B.C (9.23.10.1.) & SECTION 1.1., INSULATION, APPROVED 6 MIL. POLYETHYLENE VAPOUR BARRIER, 1/2" (12.7) GYPSUM WALLBOARD INT. FINISH. (REFER TO 35 NOTE AS REQUIRED)
- 41B

STUCCO WALL @ GARAGE CONST.
STUCCO FINISH CONFORMING TO O.B.C. SECTION 9.28. AND APPLIED PER MANUFACTURERS SPECIFICATIONS OVER 1 1/2" (38) E.F.F.S. (MINIMUM) ON APPROVED DRAINAGE MAT ON 1/2" (12.7) DENSGLASS GOLD GYPSUM BRD. ON STUDS CONFORMING TO O.B.C (9.23.10.1.) & SECTION 1.1., 1/2" (12.7) GYPSUM WALLBOARD INT. FINISH. (REFER TO 35 NOTE AS REQ.)
*** FOR DWELLINGS USING CONTIN. INSULATION CONSTRUCTION, PROVIDE APPROVED DRAINAGE MAT ON 7/16" (11) EXTERIOR TYPE SHEATHING OVER FURRING (AS REQ.) AND STUDS IN LIEU OF 1 1/2" (38) E.F.F.S (MINIMUM) ON APPROVED DRAINAGE MAT ON 1/2" (12.7) DENSGLASS GOLD GYPSUM BRD.
- 42

UNSPROUTED FOUNDATION WALLS (9.15.4.2.)
REINFORCING AT STAIRS AND SUNKEN FLOOR AREAS
2-20M BARS IN TOP PORTION OF WALL (UP TO 9'-0" OPENING)
3-20M BARS IN TOP PORTION OF WALL (9'-0" TO 10'-0" OPENING)
4-20M BARS IN TOP PORTION OF WALL (10'-0" TO 15'-0" OPENING)
- BARS STACKED VERTICALLY AT INTERIOR FACE OF WALL
REINFORCING AT BASEMENT WINDOWS
2-15M HORIZ. REINFORCING ON THE INSIDE AND OUTSIDE FACE OF THE FOUNDATION WALL BELOW THE WIN. SILL. EXTEND BARS 24" (610) BEYOND THE OPENING. 2'-15M VERTICAL REINFORCING ON THE INSIDE AND OUTSIDE FACE OF THE FOUNDATION WALL ON EACH SIDE OF THE WINDOW OPENING.
- BARS TO HAVE MIN. 1" (25) CONC. COVER
- BARS TO EXTEND 2'-0" (610) BEYOND BOTH SIDES OF OPENING
- 43

STUD WALL REINFORCEMENT
PROVIDE STUD WALL REINFORCEMENT IN MAIN BATHROOM CONFORMING TO O.B.C. (9.5.2.3.1) AND 3.8.3.8.(3) (REFER TO DETAILS)
- 44

WINDOW WELLS
WHERE A WINDOW OPENS INTO A WINDOW WELL, A CLEARANCE OF NOT LESS THAN 21 5/8" (550) SHALL BE PROVIDED IN FRONT OF THE WINDOW. EVERY WINDOW WELL SHALL BE DRAINED TO THE FOOTING LEVEL OR OTHER SUITABLE LOCATION WITH A 4" (100) WEEPING TILE C/W A FILTER CLOTH WRAP AND FILLED WITH CRUSHED STONE. (9.3.10.1.15), 9.14.6.3.)
- 45

SLOPED CEILING CONSTRUCTION (SSB-12) 21.1.7, 9.23.4.2.)
2x12" (38x286) ROOF JOISTS @ 16" (406) O.C. MAX. (UNLESS OTHERWISE NOTED) W/ 2"x2" (38x89) PURLINS @ 16" (406) O.C. PERPENDICULAR TO ROOF JOIST (PURLINS NOT REQ. W/ SPRAY FOAM). W/ INSULATION BETWEEN JOIST, 6 mil POLYETHYLENE VAPOUR BARRIER, 1/2" (12.7) GYPSUM WALLBOARD INT. FINISH OR APPROVED EQ. INSULATION VALUE DIRECTLY ABOVE THE INNER SURFACE OF EXTERIOR WALLS SHALL NOT BE LESS THAN R20 (3.52 RS).
- 46

FLAT ROOF/BALCONY CONSTRUCTION
WATERPROOFING MEMBRANE (9.26.11, 9.26.15, 9.26.16) FULLY ADHERED TO 5/8" (15.9) T&G EXTERIOR GRADE PL WOOD SHEATHING ON 2"x2" (38x89) PURLIN ANGLED TOWARDS SCUPPER @ 2% MINIMUM LAID PERPENDICULAR TO 2"x6" (38x184) FLOOR JOISTS @ 16" (406) O.C. (UNLESS OTHERWISE NOTED). BUILT UP CURB TO BE 4" (100) MIN. ABOVE FINISHED BALCONY FLOOR. CONTINUOUS 1" THIN DRIP EDGE TO BE PROVIDED ON OUTSIDE FACE OF CURB. SCUPPER DRAIN TO BE LOCATED 24" (610) MIN. AWAY FROM HOUSE. PREFINISHED ALUMINUM OR PANEL FOR UNDERSIDE OF SOFFT (9.23.2.3). REMOVE CURB WHERE REQ.
- 47

BALCONY CONDITION
SEE FLAT ROOF/BALCONY CONSTRUCTION NOTE, INCLUDE 2"x4" (38x89) PT. DECKING W/ 1/4" (6.4) GAPS LAID FLAT PARALLEL TO JOISTS ON 2"x4" (38x89) PT. SLEEPERS @ 12" (305) O.C. LAID FLAT PERPENDICULAR TO JOISTS
BALCONY OVER HEATED SPACE CONDITION
SEE FLAT ROOF/BALCONY CONSTRUCTION NOTE FOR ASSEMBLY. REFER TO PLANS FOR FLOOR JOIST SIZE & REFER TO HEX NOTE 9 FOR INSULATION AND INTERIOR FINISH
- 47

BARREL VAULT CONSTRUCTION
CANTILEVERED 2"x4" (38x89) SPACERS LAID FLAT ON 2"x10" (38x235) SPR. #2 ROOF JOIST NAILED TO BUILT-UP 3-3/4" (19) PLYWOOD HEADER PROFILED FOR BARREL. SPRAY FOAM INSULATION BETWEEN JOISTS W/ GYPSUM BOARD. INTERIOR FIN. (REFER TO DETAILS)
- SECTION 1.1. WALL STUDS
- REFER TO THIS CHART FOR STUD SIZE & SPACING AS REQUIRED FOR EXTERIOR WALLS ONLY. REFER TO SITING & GRADING PLAN OF THIS UNIT FOR CONFIRMATION OF TOP OF FOUNDATION WALL AND ADDITIONAL INFORMATION.
- IF STUD WALL HEIGHT EXCEEDS MAX. UNSUPPORTED HEIGHT, WALL NEEDS TO BE REVIEWED AND APPROVED BY ENGINEER.
- | SIZE & SPACING OF STUDS: (OBC REFERENCE - TABLE 9.23.10.1.) | |
|---|---|
| SUPPORTED LOADS (EXTERIOR) | |
| MIN. STUD W/6 ATTIC | ROOF W/ OR W/O ROOF W/ OR W/O ATTIC & 2 FLOOR/ATTIC & 3 FLOOR |
| in (mm) | MAX. UNSUPPORTED HT. (ft-in) O.C. |
| 2"x4" (38x89) | 24" (610) 16" (406) 12" (305) N/A |
| 2"x6" (38x140) | 9'-10" (3.0) 9'-10" (3.0) 16" (406) 12" (305) N/A |
| | MAX. STUD SPACING, in (mm) O.C. |
| | 24" (610) 16" (406) 12" (305) 5'-11" (1.8) |
- SECTION 2.0. GENERAL NOTES
- 2.1. WINDOWS
- EXCEPT WHERE A DOOR ON THE SAME FLOOR LEVEL AS THE BEDROOM PROVIDES DIRECT ACCESS TO THE EXTERIOR, EVERY FLOOR LEVEL CONTAINING A BEDROOM IS TO HAVE AT LEAST ONE OUTSIDE WINDOW W/ MIN. 0.35m² UNOBSTRUCTED OPEN PORTION W/ NO DIMENSION LESS THAN 1'-3" (380), CAPABLE OF MAINTAINING THE OPENING WITHOUT THE NEED FOR ADDITIONAL SUPPORT. CONFORM TO 9.9.10.
 - WINDOW GUARDS: A GUARD OR A WINDOW WITH A MAXIMUM RESTRICTED OPENING WIDTH OF 4" (100) IS REQUIRED WHERE THE TOP OF THE WINDOW SILL IS LOCATED LESS THAN 1'-7" (480) ABOVE FIN. FLOOR AND THE DISTANCE FROM THE FINISHED FLOOR TO THE ADJACENT GRADE IS GREATER THAN 5'-11" (1800). (9.8.8.1.)
 - WINDOWS IN EXIT STAIRWAYS THAT EXTEND TO LESS THAN 2'-11" (600) [3'-6" (1070) FOR ALL OTHER BUILDINGS] SHALL BE PROTECTED BY GUARDS IN ACCORDANCE WITH NOTE #2 (ABOVE). OR THE WINDOW SHALL BE NON-OPERABLE AND DESIGNED TO WITHSTAND THE SPECIFIED LOADS FOR BALCONY GUARDS AS PROVIDED IN 4.1.15.15 OR 9.8.8.2
 - REFER TO TITLE PAGE FOR MAX. U-VALUE REQUIREMENTS
- 2.2. CEILING HEIGHTS
- THE CEILING HEIGHTS OF ROOMS AND SPACES SHALL CONFORM TO TABLE 9.5.3.1.
- | ROOM OR SPACE | MINIMUM HEIGHTS |
|--------------------------------------|--|
| LIVING ROOM, DINING ROOM AND KITCHEN | 7'-7" OVER 75% OF REQUIRED FLOOR AREA WITH A CLEAR HEIGHT OF 6'-11" AT ANY POINT |
| BEDROOM | 7'-7" OVER 50% OF REQUIRED FLOOR AREA OR 6'-11" OVER ALL OF THE REQUIRED FLOOR AREA |
| BASEMENT | 6'-11" OVER AT LEAST 75% OF THE BASEMENT AREA EXCEPT THAT UNDER BEAMS AND DUCTS THE CLEARANCE IS PERMITTED TO BE REDUCED TO 6'-5". |
| BATHROOM, LAUNDRY AREA ABOVE GRADE | 6'-11" IN AREA WHERE A PERSON WOULD NORMALLY BE STANDING |
| FINISHED ROOM NOT MENTIONED ABOVE | 6'-11" |
| MEZZANINES | 6'-11" ABOVE & BELOW FLOOR ASSEMBLY (9.5.3.2.) |
| STORAGE GARAGE | 6'-7" (9.5.3.3.) |
- 2.3. MECHANICAL / PLUMBING
- Mechanical ventilation is required to provide 0.7 air change per hour if not air conditioned 1 per hour if air conditioned averaged over 24 hours. When a ventilation fan (principal exhaust) is required, conform to OBC 9.32.3.4. When a HRV is required, conform to 9.32.3.11. Refer to mechanical drawings.
- REFER TO HOT WATER TANK MANUFACTURER SPECS. CONFORM TO OBC 9.31.6.
 - REFER TO TITLE PAGE FOR SPACE HEATING EQUIPMENT, HRV AND DOMESTIC HOT WATER HEATER MINIMUM EFFICIENCIES.
 - DRAIN WATER HEAT RECOVERY UNITS) WILL BE INSTALLED CONFORMING TO THE REQUIREMENTS OF 3.1.12. OF THE O.B.C.
- 2.4. LUMBER
- ALL LUMBER SHALL BE SPRUCE No.2 GRADE OR BETTER, UNLESS NOTED OTHERWISE.
 - STUDS SHALL BE STUD GRADE SPRUCE, UNLESS NOTED OTHERWISE.
 - LUMBER EXPOSED TO THE EXTERIOR TO BE SPRUCE No. 2 GRADE PRESSURE TREATED OR CEDAR, UNLESS NOTED OTHERWISE.
 - ALL LAMINATED VENEER LUMBER (LVL) BEAMS, GIRDER TRUSSES, AND METAL HANGER CONNECTIONS SUPPORTING ROOF FRAMING TO BE DESIGNED & CERTIFIED BY FLOOR AND ROOF TRUSS MANUFACTURER.
 - JOIST HANGERS: PROVIDE APPROVED METAL HANGERS FOR ALL JOISTS AND BUILT-UP WOOD MEMBERS INTERSECTING WITH FLUSH BUILT-UP WOOD MEMBERS.
 - WOOD FRAMING NOT TREATED WITH A WOOD PRESERVATIVE, IN CONTACT WITH CONCRETE, SHALL BE SEPARATED FROM THE CONC. BY AT LEAST 2 mil POLYETHYLENE FILM. No.50 (45lbs) ROLL ROOFING OR OTHER DAMPROOFING MATERIAL, EXCEPT WHERE THE WOOD MEMBER IS AT LEAST 6" (152) ABOVE THE GROUND.
- 2.5. STEEL
- STRUCTURAL STEEL SHALL CONFORM TO CAN/CSA-G40-21 GRADE 300W. HOLLOW STRUCT. SECTIONS SHALL CONFORM TO CAN/CSA-G40-21 GRADE 350W CLASS "H".
 - REINFORCING STEEL SHALL CONFORM TO CSA-G30-18M GRADE 400R.
- 2.6. FLAT ARCHES
- FOR 8'-0" (2440) CEILINGS, FLAT ARCHES SHALL BE 8'-10" (2080) A.F.F.
 - FOR 9'-0" (2740) CEILINGS, FLAT ARCHES SHALL BE 7'-10" (2400) A.F.F.
 - FOR 10'-0" (3040) CEILINGS, FLAT ARCHES SHALL BE 8'-6" (2600) A.F.F..
- 2.7. ROOF OVERHANGS
- ALL ROOF OVERHANGS SHALL BE 1'-0" (305), UNLESS NOTED OTHERWISE.
- 2.8. FLASHING
- FLASHING MATERIALS & INSTALLATION SHALL CONFORM TO O.B.C.
- 2.9. GRADING
- THE BUILDING SHALL BE LOCATED OR THE BUILDING SITE GRADED SO THE WATER WILL NOT ACCUMULATE AT OR NEAR THE BUILDING AND WILL NOT ADVERSELY AFFECT ADJACENT PROPERTIES. CONFORM TO 8.14.6.
- 2.10. ULC SPECIFIED ASSEMBLIES
- ALL REQUIRED INDIVIDUAL COMPONENTS THAT FORM PART OF ANY ULC LISTED ASSEMBLY, SPECIFIED WITHIN THESE DRAWINGS, CANNOT BE ALTERED OR SUBSTITUTED FOR ANY OTHER MATERIAL/PRODUCT OR SPECIFIED MANUFACTURER THAT IS IDENTIFIED IN THE SPECIFIED ULC LISTING. THERE SHALL BE NO DEVIATIONS UNDER ANY CIRCUMSTANCES IN ANY ULC LISTED ASSEMBLY IDENTIFIED IN THESE DRAWINGS.
- SECTION 3.0. LEGEND
- 3.1. WOOD LITELS AND BUILT-UP WOOD
(DIVISION B PART 9, TABLES A8 TO A10 AND A12, A15 & A16)
FORMING PART OF SENTENCE 9.23.4.2.(3), 9.23.4.2.(4), 9.23.12.3.(1),(3), 9.23.13.8.(2), 9.37.3.1.(1)
- | 2"x8" SPRUCE #2 | 2"x10" SPRUCE #2 | 2"x12" SPRUCE #2 |
|-----------------------|------------------------|------------------------|
| L1 2/2"x8" (2/38x184) | L3 2/2"x10" (2/38x235) | L5 2/2"x12" (2/38x286) |
| B1 3/2"x8" (3/38x184) | B3 3/2"x10" (3/38x235) | B5 3/2"x12" (3/38x286) |
| B2 4/2"x8" (4/38x184) | B4 4/2"x10" (4/38x235) | B6 4/2"x12" (4/38x286) |
| B7 5/2"x8" (5/38x184) | B8 5/2"x10" (5/38x235) | B9 5/2"x12" (5/38x286) |
- ENGINEERED LUMBER SCHEDULE
- | 1 3/4" x 9 1/2" LVL | 1 3/4" x 11 7/8" LVL | 1 3/4" x 14" LVL |
|----------------------|-----------------------|--------------------|
| LVL2 1-1 3/4"x9 1/2" | LVL3 1-1 3/4"x11 7/8" | LVL10 1-1 3/4"x14" |
| LVL4 2-1 3/4"x9 1/2" | LVL6 2-1 3/4"x11 7/8" | LVL11 2-1 3/4"x14" |
| LVL5 3-1 3/4"x9 1/2" | LVL7 3-1 3/4"x11 7/8" | LVL12 3-1 3/4"x14" |
| LVL8 4-1 3/4"x9 1/2" | LVL9 4-1 3/4"x11 7/8" | LVL13 4-1 3/4"x14" |
- 3.2. STEEL LITELS SUPPORTING MASONRY VENEER
(DIVISION B PART 9, TABLE 9.20.5.2.B.)
FORMING PART OF SENTENCE 9.20.5.2.(2) & 9.20.5.2.(3)
- | CODE | SIZE | BRICK | STONE |
|------|--|----------------|---------------|
| L7 | 3 1/2" x 3 1/2" x 1 1/4" (89 x 89 x 6.4) | 8-1" (2.47m) | 7-6" (2.30m) |
| L8 | 4" x 3 1/2" x 1 1/4" (102 x 89 x 6.4) | 8-9" (2.66m) | 8-1" (2.48m) |
| L9 | 4 7/8" x 3 1/2" x 5/16" (127 x 89 x 7.9) | 10-10" (3.31m) | 10-1" (3.03m) |
| L10 | 4 7/8" x 3 1/2" x 3/8" (127 x 89 x 11) | 11-5" (3.48m) | 10-7" (3.24m) |
| L11 | 5 7/8" x 3 1/2" x 3/8" (152 x 89 x 11) | 12-6" (3.82m) | 11-7" (3.54m) |
| L12 | 7 1/8" x 4" x 3/8" (178 x 102 x 11) | 14-1" (4.30m) | 13-1" (3.99m) |
- REFER TO SB-12 ENERGY EFFICIENCY DESIGN MATRIX ON THE TITLE PAGE FOR ALL VALUES AS REQUIRED PER 3.1.1., 3.1.2., 3.1.3. OF THE OBC.
- 3.3. DOOR SCHEDULE
- | CONFORMING TO SECTIONS 9.5.11, 9.6., 9.7.2.1, 9.7.5.2, & 9.10.13.10 | |
|---|---|
| 1 EXTERIOR | 2'-8" x 6'-8" x 1-3/4" (815 x 2030 x 45) INSULATED MIN. R4 (RSI 0.7) |
| 1A EXTERIOR | 2'-10" x 6'-8" x 1-3/4" (865 x 2030 x 45) INSULATED MIN. R4 (RSI 0.7) |
| 1B EXTERIOR | 3'-0" x 6'-8" x 1-3/4" (915 x 2030 x 45) INSULATED MIN. R4 (RSI 0.7) |
| 1C EXTERIOR | 3'-6" x 6'-8" x 1-3/4" (965 x 2030 x 45) INSULATED MIN. R4 (RSI 0.7) |
| 1D EXTERIOR | 2'-8" x 6'-8" x 1-3/4" (815 x 2030 x 45) INS. MIN. R4 (RSI 0.7) [SEE HEX NOTE 20] |
| 1E EXTERIOR | 3'-0" x 8'-0" x 1-3/4" (915 x 2440 x 45) INSULATED MIN. R4 (RSI 0.7) |
| 1F EXTERIOR | 2'-8" x 8'-0" x 1-3/4" (815 x 2440 x 45) INSULATED MIN. R4 (RSI 0.7) |
| 2A EXTERIOR | 2'-8" x 6'-8" x 1-3/4" (815 x 2030 x 45) 20 MIN. F.R.R. DOORFRAME WITH APP. SELF CLOSING DEVICE |
| 2 INTERIOR | 2'-8" x 6'-8" x 1-3/8" (815 x 2030 x 35) |
| 3 INTERIOR | 2'-6" x 6'-8" x 1-3/8" (760 x 2030 x 35) |
| 3A INTERIOR | 2'-4" x 6'-8" x 1-3/8" (710 x 2030 x 35) |
| 4 INTERIOR | 2'-0" x 6'-8" x 1-3/8" (610 x 2030 x 35) |
| 4A INTERIOR | 2'-2" x 6'-8" x 1-3/8" (660 x 2030 x 35) |
| 5 INTERIOR | 1'-6" x 6'-8" x 1-3/8" (460 x 2030 x 35) |
- 3.4. ACRONYMS
- | | | | |
|-------|------------------------------|------|-------------------------|
| AFF | ABOVE FINISHED FLOOR | JST | JOIST |
| BBFM | BEAM BY FLOOR MANUFACTURER | LIN | LINEN CLOSET |
| BG | FIXED GLASS W/ BLACK BACKING | LVL | LAMINATED VENEER LUMBER |
| BM | BEAM | OTBA | OPEN TO BELOW/ABOVE |
| BBFM | BEAM BY ROOF MANUFACTURER | PL | POINT LOAD |
| CRF | CONVENTIONAL ROOF FRAMING | PLT | PLATE |
| C/W | COMPLETE WITH | PT | PRESSURE TREATED |
| DJ/TJ | DOUBLE JOIST/ TRIPLE JOIST | PTD | PAINTED |
| DO | DO OVER. | PWD | POWDER ROOM |
| DRP | DROPPED | FWL | RAIN WATER LEADER |
| ENG | ENGINEERED | SB | SOLID BEARING WOOD POST |
| EST | ESTIMATED | SBFA | SB FROM ABOVE |
| FA | FLAT ARCH | SJ | SINGLE JOIST |
| FD | FLOOR DRAIN. | SPR | SPRUCE |
| FG | FIXED GLASS | STL | STEEL |
| FL | FLUSH | T/O | TOP OF |
| FLR | FLOOR | TYP | TYPICAL |
| GT | GIRDER TRUSS | UIS | UNDERSIDE |
| HB | HOSE BIB | WD | WOOD |
| HRV | HEAT RETURN VENTILATION UNIT | WIC | WALK IN CLOSET |
| HWT | HOT WATER TANK | WP | WEATHER PROOF |
- 3.5. SYMBOLS
- | | | |
|---|--|--------------|
| ALL ELECTRICAL FACILITIES SHALL BE INSTALLED IN ACCORDANCE WITH SECTION 9.34. | CLASS 'B' VENT | EXHAUST VENT |
| DUPLEX OUTLET (12" HIGH) | DUPLEX OUTLET (HEIGHT AS NOTED A.F.F.) | |
| HEAVY DUTY OUTLET | SWITCH (2/8/4 WAY) | |
| POT LIGHT | LIGHT FIXTURE (CEILING MOUNTED) | |
| LIGHT FIXTURE (PULL CHAIN) | LIGHT FIXTURE (WALL MOUNTED) | |
| CABLE T.V. JACK | TELEPHONE JACK | |
| CENTRAL VACUUM OUTLET | CHANDELER (CEILING MOUNTED) | |
- SA SMOKE ALARM (9.10.19.)
- PROVIDE ONE PER FLOOR, NEAR THE STAIRS CONNECTING THE FLOOR LEVEL. ALARMS ARE TO BE INSTALLED IN EACH SLEEPING ROOM AND IN A LOCATION BETWEEN SLEEPING ROOMS AND CONNECTING HALLWAYS AND WIRED TO BE INTERCONNECTED TO ACTIVATE ALL ALARMS IF ONE SOUNDS. ALARMS ARE TO BE CONNECTED TO AN ELECTRICAL CIRCUIT AND WITH A BATTERY BACKUP. ALARM SIGNAL SHALL MEET TEMPORAL SOUND PATTERNS MIN. ALARMS SHALL HAVE A VISUAL SIGNALLING COMPONENT AS PER THE NATIONAL FIRE ALARM AND SIGNALING CODE 72.
- CMD CARBON MONOXIDE ALARM (9.33.4.)
- **CHECK LOCAL BY-LAWS FOR REQUIREMENTS ** A CARBON MONOXIDE ALARM(S) CONFORMING TO CAN/CSA-6.19 SHALL BE INSTALLED ON OR NEAR THE CEILING IN EACH DWELLING UNIT ADJACENT TO EACH SLEEPING AREA. CARBON MONOXIDE ALARM(S) SHALL BE PERMANENTLY WIRED WITH NO DISCONNECT SWITCH, WITH AN ALARM THAT IS AUDIBLE WITHIN SLEEPING ROOMS WHEN THE INTERVENING DOORS ARE CLOSED.
- SB SOLID BEARING (BUILT-UP WOOD COLUMNS AND STUD POSTS)
THE WIDTH OF A WOOD COLUMN SHALL NOT BE LESS THAN THE WIDTH OF SUPPORTED MEMBER. BUILT-UP WOOD COLUMNS SHALL BE NAILED TOGETHER WITH NOT LESS THAN 3" (76) NAILS SPACED NOT MORE THAN 11 3/4" (300) O.C. THE NUMBER OF STUDS IN A WALL DIRECTLY BELOW A GIRDER TRUSS OR ROOF BEAM SHALL CONFORM TO TABLE A-34 TO A-37. (9.17.4., 9.23.10.7.)
- TWO STOREY VOLUME SPACE. SEE CONSTRUCTION NOTE 39.
- VARYING PLATES, BUILT-OUT FLOORS, BEARING WALLS, ICE & WATER SHIELD
- EXPOSED BUILDING FACE -O.B.C. 9.10.14. OR 9.10.15.
REFER TO HEX NOTE 35, & DETAILS FOR TYPE AND SPECIFICATIONS.
- 1 HR. PARTY WALL
REFER TO HEX NOTE 40.
- 2 HR. FIREWALL
REFER TO HEX NOTE 40A.
- SECTION 4.0. CLIMATIC DATA
- DESIGN SNOW LOAD (9.4.2.2.): 1.23 kPa
- WIND LOAD (q50) (SB-1.2.): 0.44 kPa
- STAMP
-
- FOR STRUCTURAL ONLY
NOT INCLUDING ENGINEERED
FLOOR OR ROOF SYSTEM
- CONTRACTOR MUST VERIFY ALL DIMENSIONS ON THE JOB. REPORT ANY DISCREPANCIES TO HUNT DESIGN ASSOCIATES INC. (H.D.A.) BEFORE PROCEEDING WITH THE WORK. ALL THE DRAWINGS & SPECIFICATIONS ARE THE INSTRUMENTS OF SERVICE AND ARE THE PROPERTY OF H.D.A.I. CONSULTING ENGINEERING. NO PARTS OF THESE PLANS AND SPECIFICATIONS ARE TO BE REPRODUCED OR COPIED WITHOUT THE WRITTEN PERMISSION OF H.D.A.I. THESE REQUIREMENTS ARE TO BE TAKEN AS MINIMUM SPECIFICATIONS. ONT. REG. 32972.
- CONSTRUCTION NOTE REVISION DATE: MAY 9, 2019
- CONSTRUCTION NOTES 2
- UNITS

ROYAL PINE HOMES - 216102

'CENTREFIELD', WEST GORMLEY, RICHMOND HILL, ON.

DESIGN ASSOCIATES INC.

www.huntdesign.ca

37308

BDN

19695

erep R. Santos

SIGNATURE

UNITS

UNIT 2008

REV.2021.03.24

File Number

216102WT2008

Page Number

14 of 14

Drawn By

DS

Checked By

DS

Scale

3/16"=1'-0"

I, UNDERSIGNED HAS REVIEWED AND TAKES RESPONSIBILITY FOR THIS DESIGN AND HAS THE QUALIFICATIONS AND MEETS THE REQUIREMENTS SET OUT IN THE ONTARIO BUILDING CODE TO BE A DESIGNER.

erep R. Santos

37308

BDN

19695

UNITS

UNIT 2008

REV.2021.03.24

File Number

216102WT2008

Page Number

14 of 14

Drawn By

DS

Checked By

DS

Scale

3/16"=1'-0"

ROYAL PINE HOMES - 216102

'CENTREFIELD', WEST GORMLEY, RICHMOND HILL, ON.

DESIGN ASSOCIATES INC.

www.huntdesign.ca

37308

BDN

19695

erep R. Santos

SIGNATURE

FIRE RATINGS - PARTY WALL TRUSS SPACE (OBC REF. - SB-2.3)		
COMPONENT	FIRE RATING	CODE REFERENCE
5/8" (15.9mm) TYPE X GYPSUM WALL BOARD	40 min.	O.B.C. SB-2.3.4.(2) (TABLE 2.3.4.A)
WOOD TRUSSES	NO RATING ASSIGNED	
5/8" (15.9mm) TYPE X GYPSUM WALL BOARD	40 min.	O.B.C. SB-2.3.4.(2) (TABLE 2.3.4.A)
TOTAL FIRE RATING	80 min.	O.B.C. SB-2.3.4.(1)

FIRE & SOUND RATINGS - PARTY WALL		
WALL TYPE	CODE REFERENCE	RATING
MISC	O.B.C. SB-3	54 STC D IR FRR

FILL ANY VOID TO UNDERSIDE OF ROOF DECK AND TOP OF WALL WITH MINERAL WOOL WHEN ROOF JOISTS SPACING EXCEEDS 24" O.C. PROVIDE H-CLIPS @ 12" O.C.

TYPICAL ROOF & EAVES CONSTRUCTION

5/8" TYPE 'X' GYPSUM SHTG'S ON PREMANUFACTURED ROOF TRUSS ON 5/8" TYPE 'X' GYPSUM SHTG'S. PREMANUFACTURED ROOF TRUSS ON 5/8" TYPE 'X' GYPSUM SHTG'S. TAPE FILL AND SAND ALL GYPSUM JOINTS TO PREVENT SOUND LEAKAGE. ALL DRYWALL EDGES TO BE SUPPORTED

PROVIDE 2 LAYERS 1/2" TYPE 'X' GYPSUM BOARD FIRESTOP. (SEPARATELY FASTEN 1 LAYER TO EACH HEADER BEFORE INSTALLATION OF HEADER)

5/8" TYPE 'X' GYPSUM SHTG'S ON BLOCKING ON CONTINUOUS HEADER BOARD, EACH SIDE

FURR OUT BOXING FROM FACE OF GYPSUM SHTG'S TO ENCLOSE ANY MECHANICAL'S

PROVIDE 2 LAYERS 1/2" TYPE 'X' GYPSUM BOARD FIRESTOP. (SEPARATELY FASTEN 1 LAYER TO EACH HEADER BEFORE INSTALLATION OF HEADER)

5/8" TYPE 'X' GYPSUM SHTG'S ON BLOCKING ON CONTINUOUS HEADER BOARD, EACH SIDE

FURR OUT BOXING FROM FACE OF GYPSUM SHTG'S TO ENCLOSE ANY MECHANICAL'S

5/8" TYPE 'X' GYPSUM SHTG'S ON APPROVED AIR BARRIER ON EACH EXTERIOR SIDE OF 2 ROWS OF 2"x4" STUDS @ 16" O.C., 1" APART AND ON SEPARATE 2"x4" SILL PLATES TIED TO TOP OF FOUNDATION WALL. FILL ONE SIDE OF STUD CAVITY WITH AT LEAST 40% OF ABSORPTIVE MATERIAL PROCESSED FROM ROCK, SLAG OR GLASS. TAPE FILL AND SAND ALL GYPSUM JOINTS TO PREVENT SOUND LEAKAGE. ALL DRYWALL EDGES TO BE SUPPORTED

NOTE:
TO HOLD INSULATION PROVIDE 4" WIDE 1/2" GYPSUM SHEATHING OR 4" WIDE 1/4" PLYWOOD SHEATHING @ 24" O.C. VERT. ON EXTERIOR FACE OF STUD (IN AIR SPACE)

5/8" TYPE 'X' GYPSUM SHTG'S ON BLOCKING ON CONTINUOUS HEADER BOARD, EACH SIDE

PROVIDE 2 LAYERS 1/2" TYPE 'X' GYPSUM BOARD FIRESTOP. (SEPARATELY FASTEN 1 LAYER TO EACH HEADER BEFORE INSTALLATION OF HEADER)

UNFINISHED BASEMENT
8" POURED IS MPa CONCRETE FOUNDATION WALL ON POURED CONC. FOOTING

3" MIN. 25 MPa CONC. SLAB ON 4" COARSE CLEAN GRANULAR FILL OR 20 MPa CONC. WITH DAMPROOFING BELOW SLAB.

CONTINUOUS KEY IN CONCRETE
POURED CONC. FOOTINGS. SEE MINIMUM STRIP FOOTING SIZES FOR EXTERIOR WALLS' CHART

NOTE: POURED CONC. FOOTING ON NATURAL UNDISTURBED SOIL OF 15MPa OR COMPACTED ENGINEERED FILL WITH MIN. BEARING CAPACITY OF 150KPa. FOOTING SIZE SHOWN FOR 16'-0" (4.9m) MAXIMUM JOIST SPAN ONLY. JOIST SPAN EXCEEDING 16'-0" (4.9m) SHALL BE ENGINEERED. IF SOIL BEARING DOES NOT MEET MINIMUM CAPACITY, ENGINEERED FOOTINGS ARE REQUIRED. ACTUAL SOIL BEARING CAPACITY TO BE VERIFIED WITH SOIL ENGINEERING REPORT.

MINIMUM STRIP FOOTING SIZES (4.15.3)			
NUMBER FLOORS SUPPORTED	SUPPORTING INT. LOAD BEARING MASONRY WALL	SUPPORTING EXTERIOR PARTYWALL	SUPPORTING PARTYWALL
1	16" W x 8" D	16" W x 8" D	16" W x 8" D
2	24" W x 8" D	20" W x 8" D	24" W x 8" D
3	36" W x 14" D	26" W x 14" D	36" W x 14" D
NOTE: FOOTING SIZE SUBJECT TO CERTIFICATION BY A SOIL CONSULTANT			

TYPICAL 1 HR PARTY WALL SECTION, PARALLEL ROOF TRUSSES, 2"x4" DOUBLE STUDS - 3 STOREY

1/2" = 1'-0"

SB-12 EN

PRESCRIPTIVE COMPL

PAC

BUILDING COMPONE

INSULATION RES (R1V)

CEILING W/ ATTIC SP

CEILING W/O ATTIC S

EXPOSED FLOOR

WALLS ABOVE GRADI

BASEMENT WALLS

* PROPOSED VALUES

BELOW GRADE SLAB

EDGE OF BELOW GRA

HEATED SLAB OR SL

WINDOWS & DOORS

WINDOWS/SLIDING G

SKYLIGHTS (MAX. UV

APPLIANCE EFFICIEN

SPACE HEATING EQ

HRV EFFICIENCY (%)

DHW HEATER (EF)

AREA CALCULATIONS

GROUND FLOOR AREA

MAIN FLOOR AREA

THIRD FLOOR AREA

SUBTOTAL

DEDUCT ALL OPEN AREAS

TOTAL NET AREA

COVERAGE
W/O UT PORCH

COVERAGE
W/ PORCH

WINDOW / WALL AREA
CALCULATIONS

GROSS WALL AREA

GROSS WINDOW AREA
(INCL. GLASS DOORS & SKYLIGHTS)

TOTAL WINDOW %

