

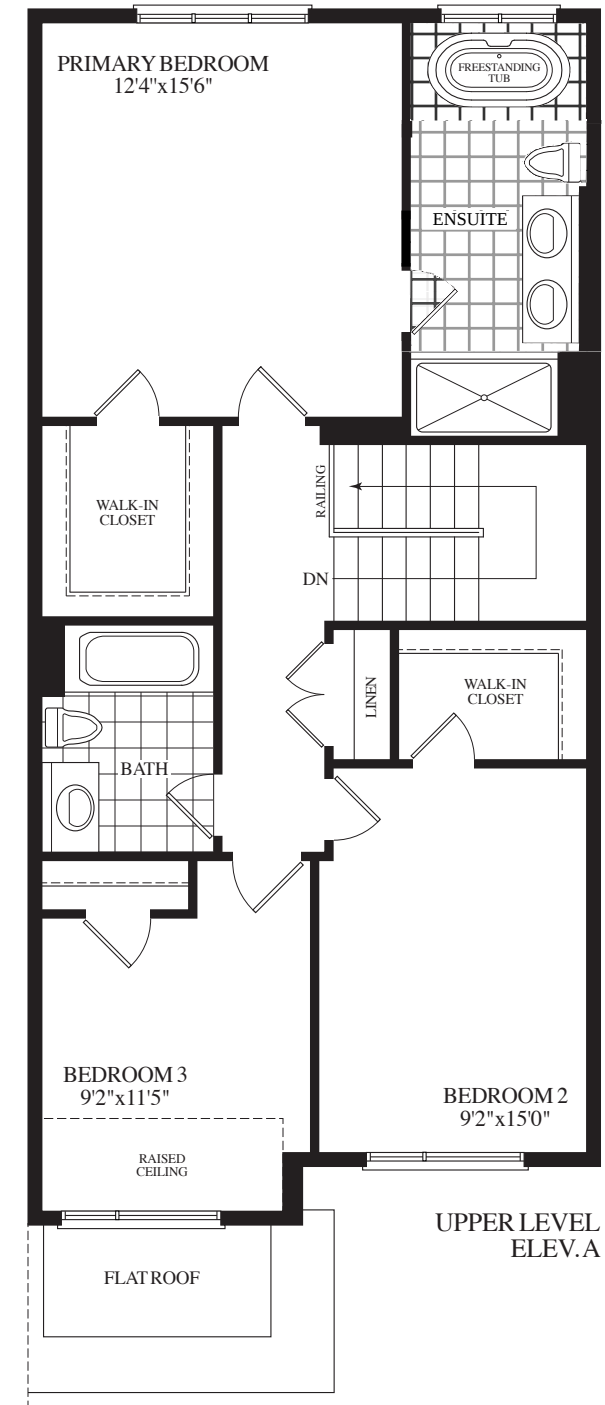


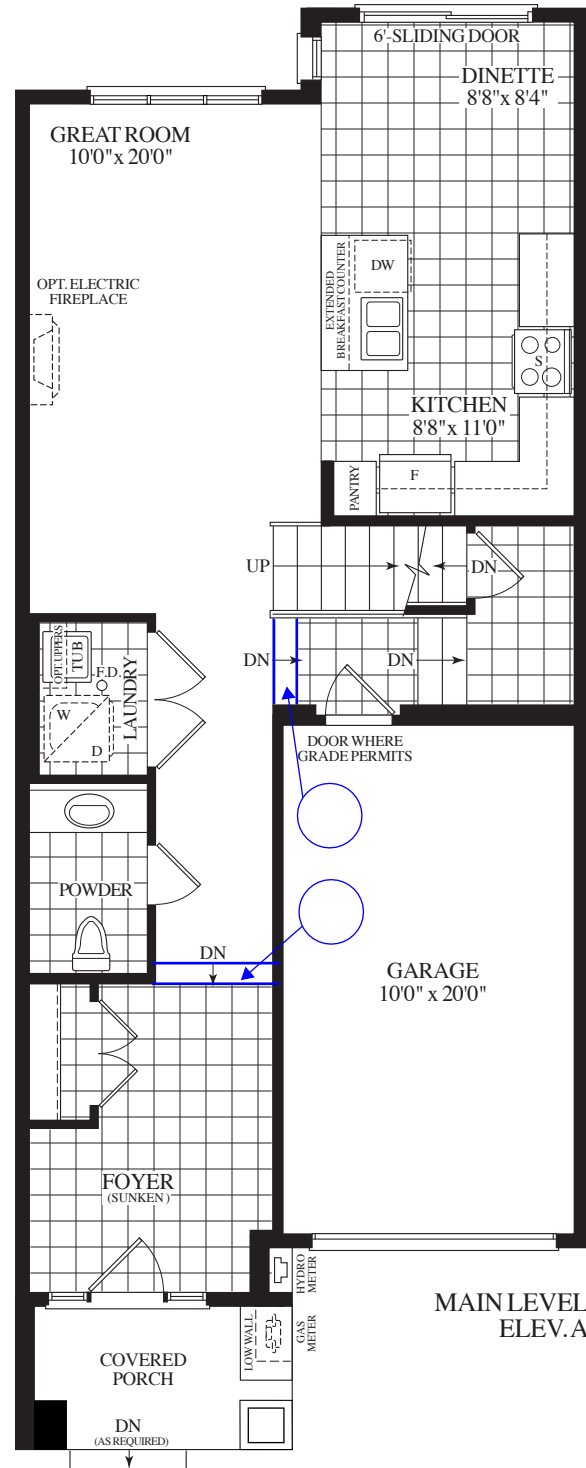

Materials, specifications and floor plans are subject to change without notice. All renderings are artist's concept. All floor plans are approximate dimensions. Actual usable floor space may vary from the stated floor area. E.&O.E.

BLK. 17 TH. 107	20-15 THE ANNE	EL. A	3 BDRM 2 BATH	1685 SQ.FT.
-----------------	----------------	-------	---------------	-------------

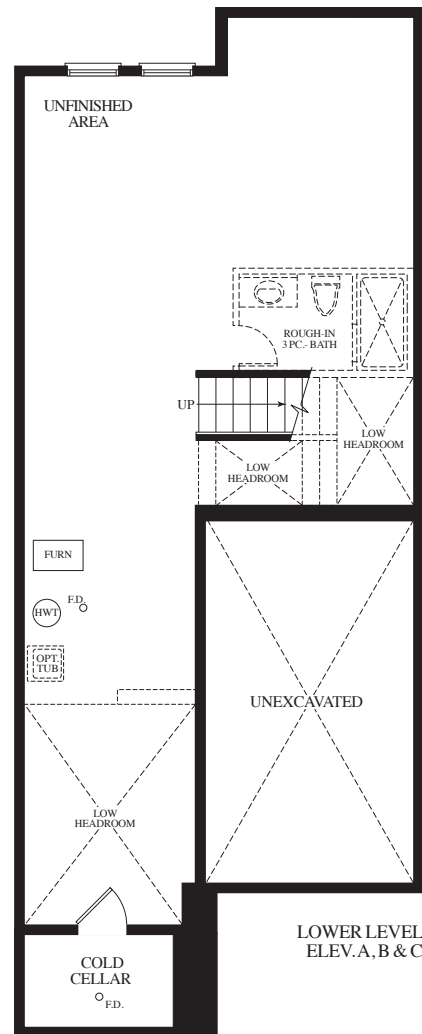

THE ANNE

20-15

1,685 SQ. FT.

BLK. 17 TH. 107

