

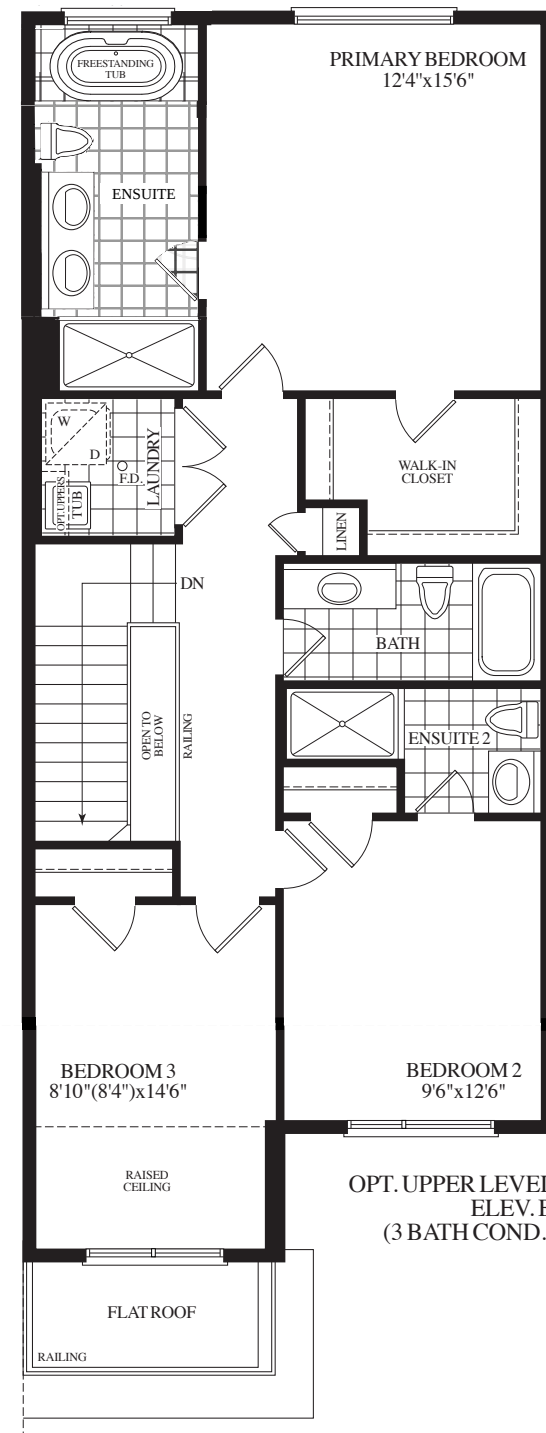


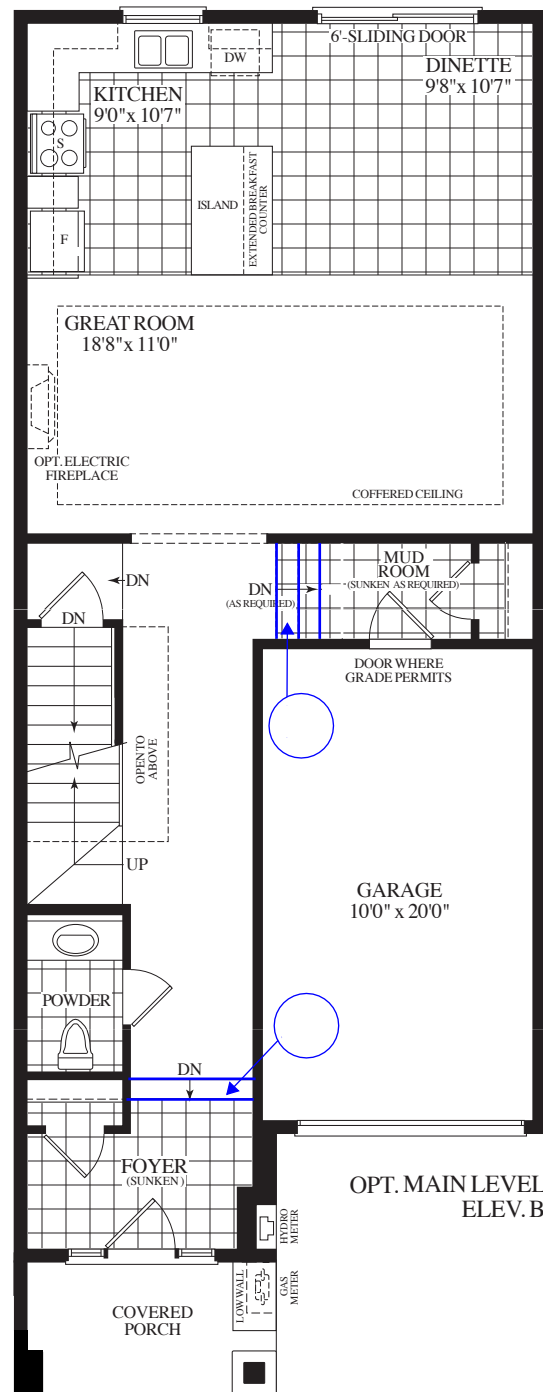

Materials, specifications and floor plans are subject to change without notice. All renderings are artist's concept. All floor plans are approximate dimensions. Actual usable floor space may vary from the stated floor area. E.&O.E.

BLK. 18 TH. 115 20-16 THE CHARLOTTE EL. B OPT. MAIN 3 BDRM 3 BATH 1795 SQ.FT.

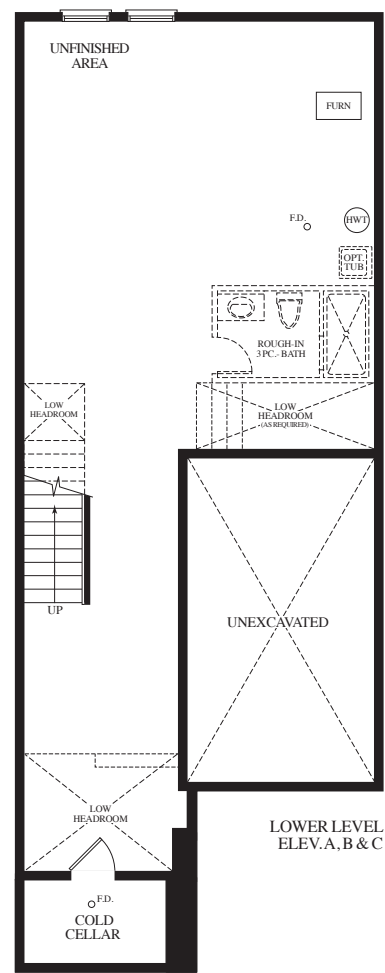

THE CHARLOTTE
20-16
1,795 SQ.FT.

BLK. 18 TH.115

