


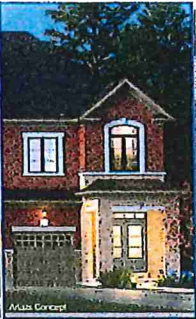


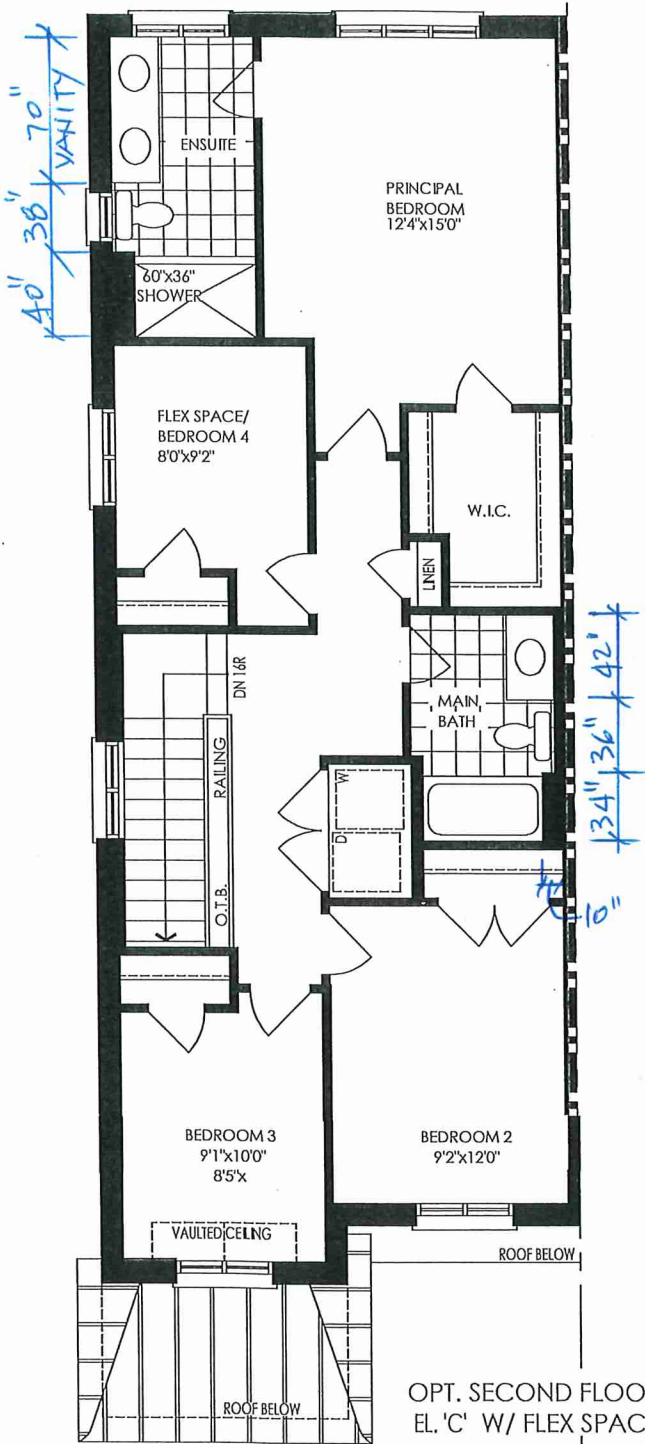

BAYVIEW HEIGHTS
RICHMOND HILL

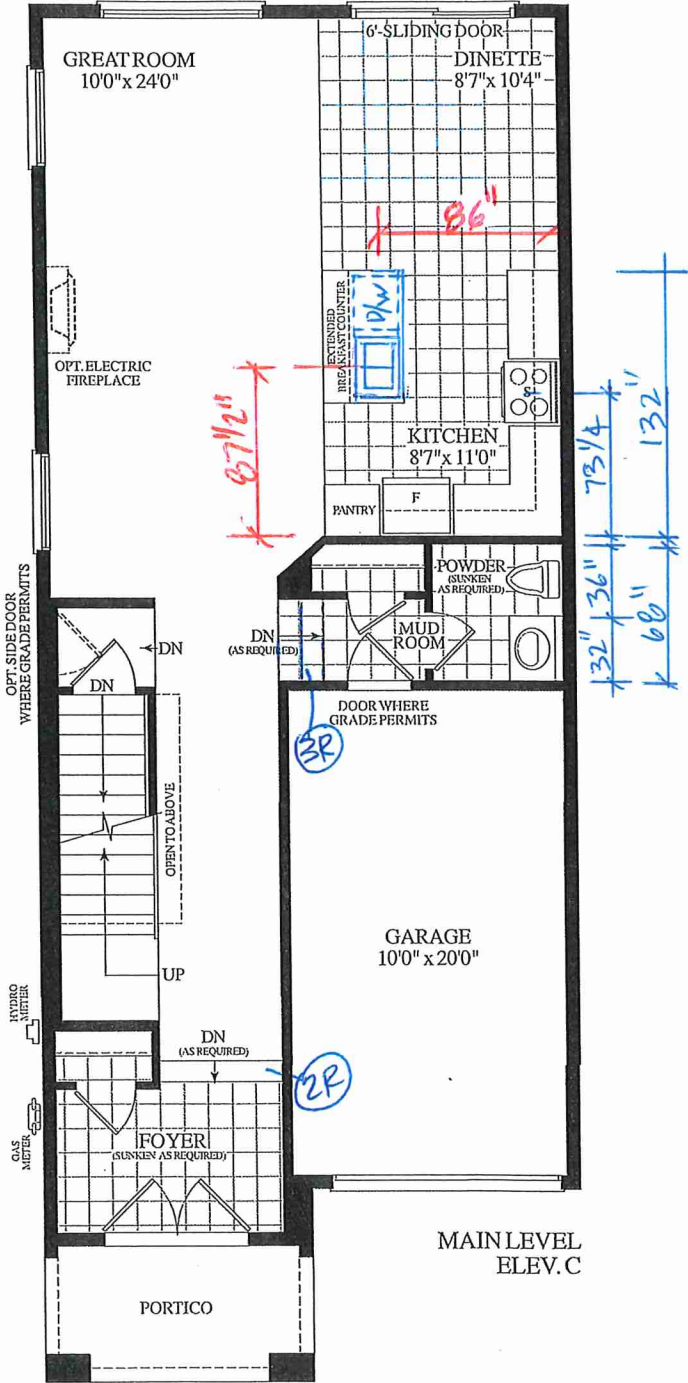

ELEVATION C

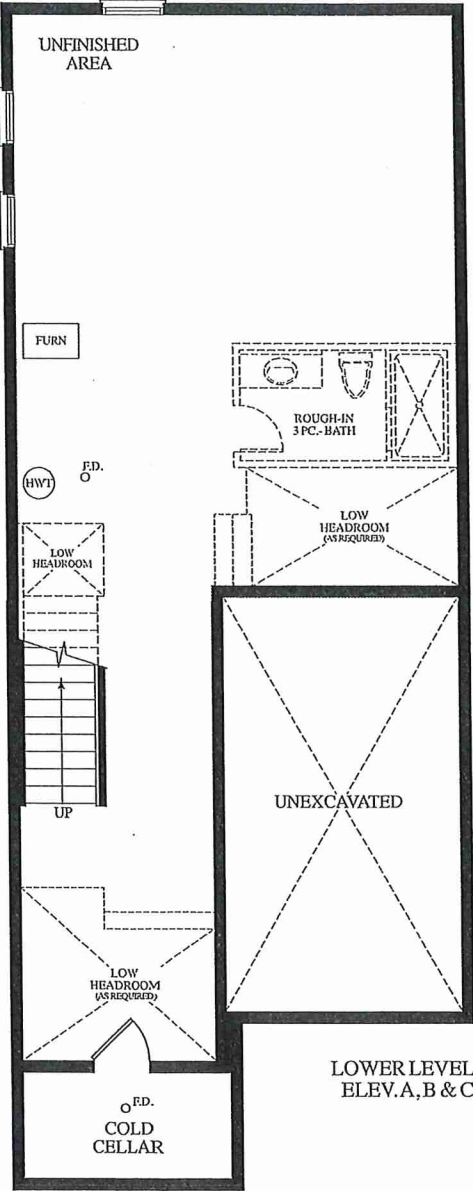

Materials, specifications and floor plans are subject to change without notice. All renderings are artist's concept. All floor plans are approximate dimensions. Actual usable floor space may vary from the stated floor area. E.&O.E.

BLK. 2 TH. 12 20-18 THE KATHERINE (END) EL. C OPT. 2ND FLR. 1815 SQ.FT.