





DECK CONDITION

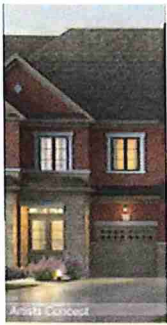


ELEVATION C

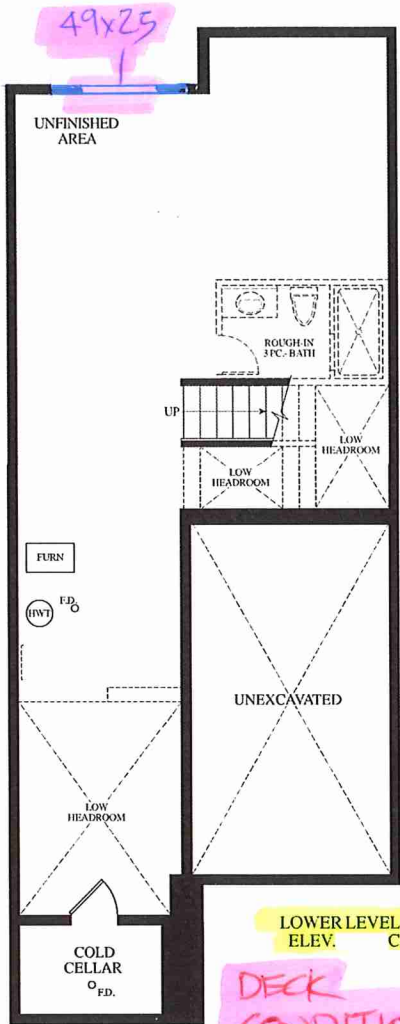


LOWER LEVEL ELEV. C

DECK CONDITION

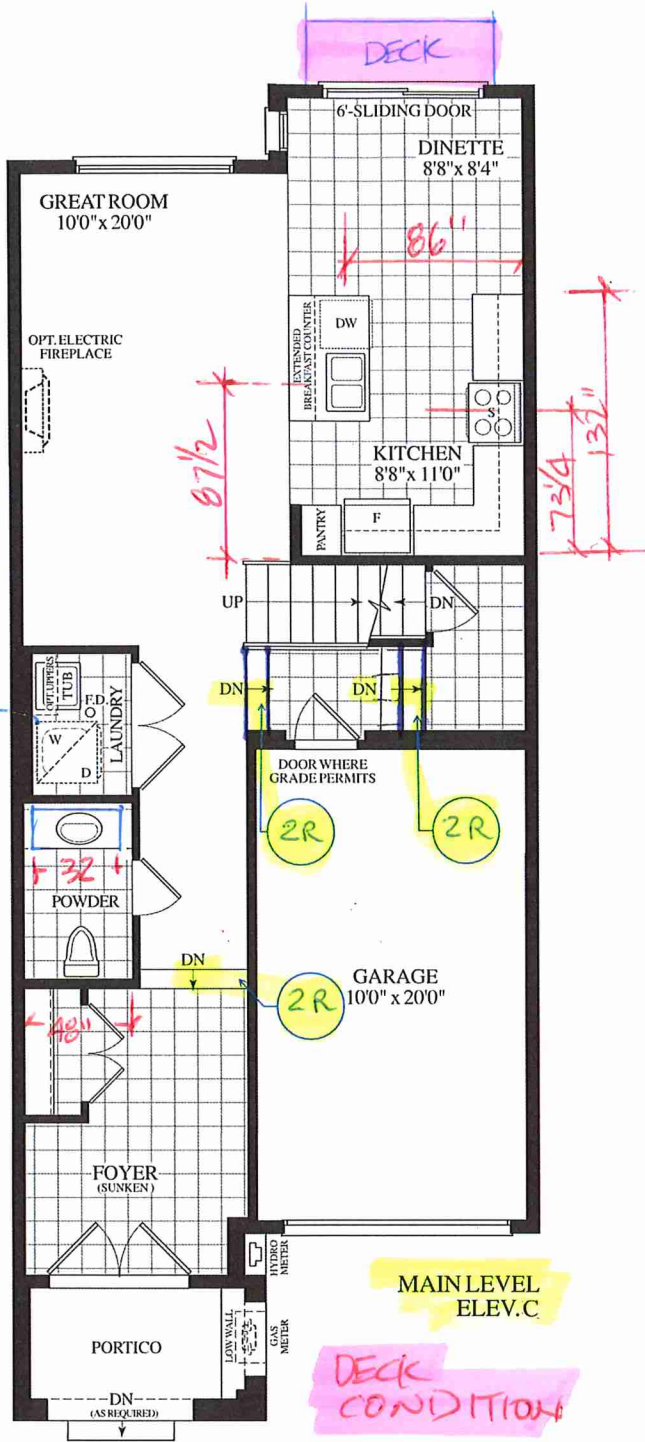

MAIN LEVEL ELEV. C

DECK CONDITION

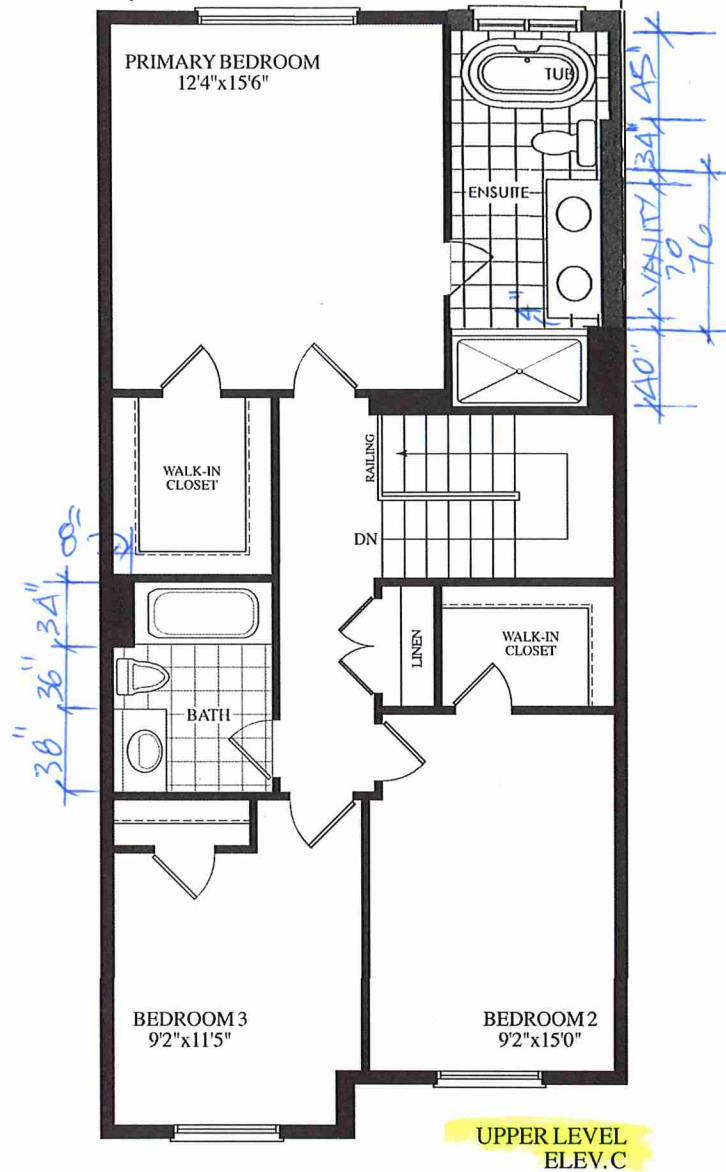

UPPER LEVEL ELEV. C

Materials, specifications and floor plans are subject to change without notice. All renderings are artist's concept. All floor plans are approximate dimensions. Actual usable floor space may vary from the stated floor area. E.&O.E.

INVENTORY

DECK CONDITION
3 BDRM. 2 BATH.

20-15 THE ANNE EL. C

BLK.8 TH. 47

1780 SQ.FT.